

16

OD (D-2)

10 OPERATIONS 3-2-81

1988 TWO-LANE RESURFACING PROGRAM

PRIORITY NO. 3

PART OF

SHEET OF

COUNTY Lucas

ROUTE SR2

SECTION 20.49

BEGIN LOG (SLM) 20.49

TERMINII Toledo ECL (Butt)

END LOG (SLM) 22.52

TERMINII Coy Rd. (Butt)

TOTAL LENGTH 2.03

MILES

MUNICIPALITY Oregon

BEGIN LOG (SLM) 20.49

END LOG (SLM) 22.52

MUNICIPALITY Toledo

BEGIN LOG (SLM) 20.49

END LOG (SLM) 21.02

PROPOSED WORK: 1 1/2" 402, 1" 404

PAVEMENT SHOULDER

OTHER Mill (5' wide (to remove Asph in gutter pan))

Approach I280 & Wheeling St.

EXISTING DATA:

SLM 20.49 TO 21.15	PAV'T	WIDTH 24' (type 404)	SHLD WIDTH (type)
SLM 21.15 TO 21.34	PAV'T	WIDTH 56' (type 404)	SHLD WIDTH (type)
SLM 21.34 TO 22.52	PAV'T	WIDTH 50' (type 404)	SHLD WIDTH (type)
SLM TO	PAV'T	WIDTH (type)	SHLD WIDTH (type)
SLM TO	PAV'T	WIDTH (type)	SHLD WIDTH (type)
STRUCTURES:

STR. NO.	WIDTH	LENGTH	PROP. WORK
STR. NO.	WIDTH	LENGTH	PROP. WORK
RAILROAD CROSSING:

NAME	STATION	NO. TRACKS	LENGTH ALONG C L (no work) ft
NAME	STATION	NO. TRACKS	LENGTH ALONG C L ft
NAME	STATION	NO. TRACKS	LENGTH ALONG C L ft

MISCELLANEOUS:


NO. RAISED PAVEMENT MARKERS; EDGE OF PAVEMENT, CENTERLINE

NO. MAILBOX APPROACHES, AVERAGE AREA

REMARKS:

PERSONNEL	TITLE	PERSONNEL	TITLE	COUNTY	DATE
Stone				Lucas	24 June 86
				S. R. # 2	WEATHER Fair
Crew				SEC. 20.49-22.52	TEMP. 67°

DESCRIPTION	LEFT	CENTER LINE	RIGHT	JOB NO.
-------------	------	-------------	-------	---------

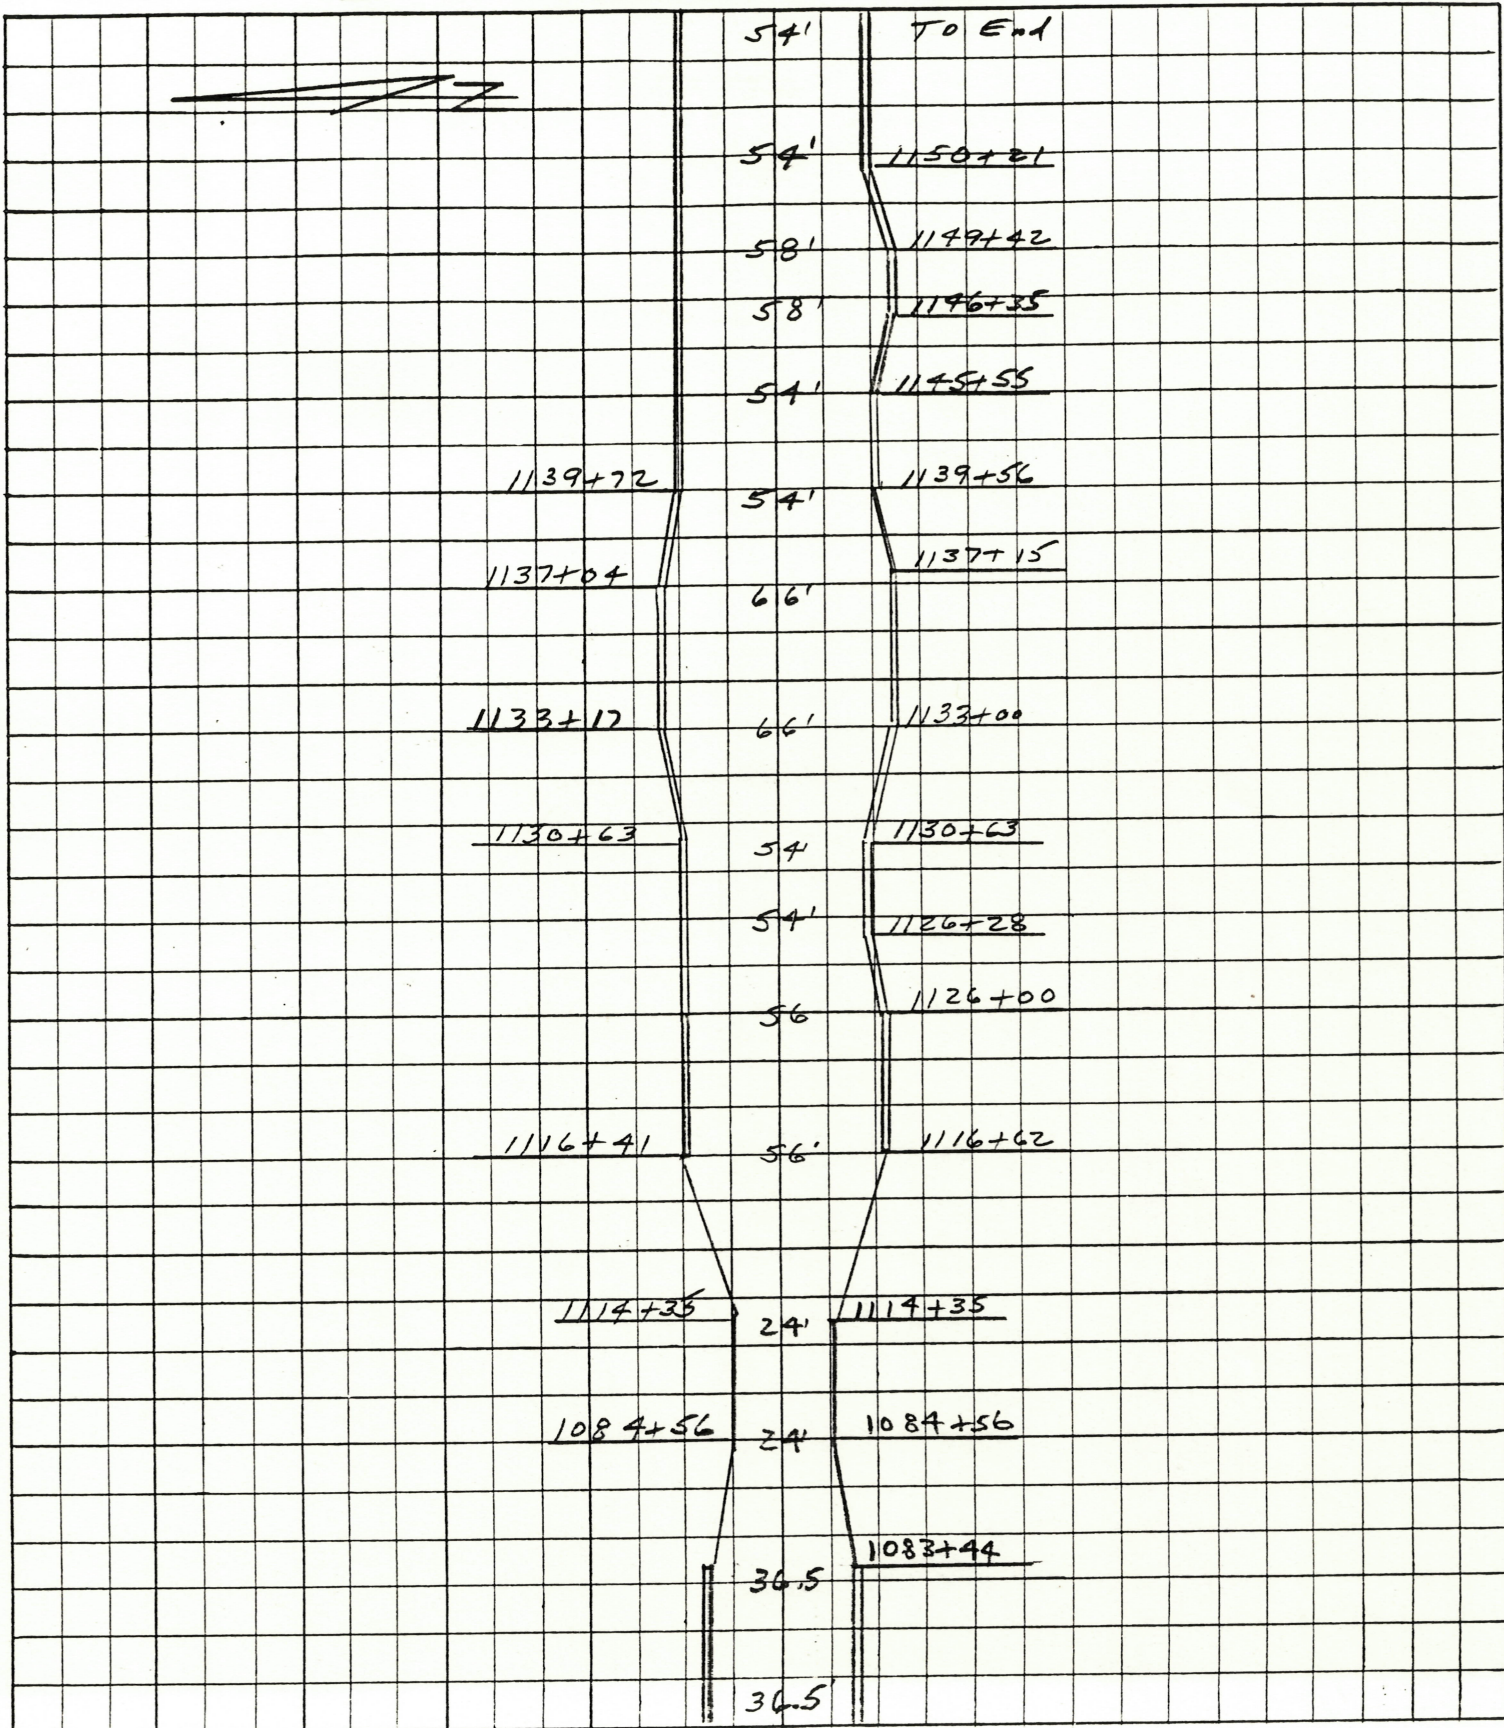

PERSONNEL	TITLE	PERSONNEL	TITLE	COUNTY	DATE
				S. R.	WEATHER
				SEC.	TEMP.
DESCRIPTION				JOB NO.	
LEFT		CENTER LINE		RIGHT	

STATION	OUT Rt.-Lt.	CB	TYPE 1,2,3	MH	TYPE San. Storm	MONU	TYPE Box Other	WV	CASTING		Remarks
									Raise	Feather	
1083+38	Lt	✓	3							✓	
1083+38	Rt	✓	3							✓	
1085+17	14' Lt			✓	OHIO BELL					✓	
1085+40	21 Lt	✓	2							✓	
1091+76	10' Lt			✓	Storm				✓		
1092+18	14' Rt				OHIO BELL					✓	
1094+58	10' Lt			✓	Storm				✓		
1097+82	10' Lt			✓	Storm				✓		
1100+82	10' Lt			✓	11				✓		
1100+62	16' Lt			✓				✓	✓		
1100+62	20' Lt	✓	2							✓	
1100+89	28' Lt			✓	Storm					✓	
1101+02	21 Lt	✓	3							✓	
1103+34	25 Lt			✓	Storm					✓	
1103+42	10' Lt			✓	Storm				✓		
1105+90	17 Lt			✓	1			✓		✓	
1106+03	10' Lt			✓	Storm				✓		
1106+32	14' Lt			✓				✓		✓	
1107+18	11' Rt			✓	OHIO BELL					✓	
1107+47	10 Lt			✓				✓	✓		
1108+39	10' Lt			✓	San.				✓		
1108+60	11' Rt				OHIO BELL				✓		
1116+13	31 Rt			✓				✓		✓	
1116+42	24' Lt			✓	Storm					✓	
1116+62	Lt	✓	1							✓	
1116+62	Rt	✓	1							✓	
1120+02	21' Lt			✓	San.				✓		
1120+23	40' Rt			✓	OHIO Bell					✓	
1120+34	33' Rt			✓	OHIO Bell					✓	
1123+96	20' Lt			✓	Storm				✓		
1125+88	Lt	✓	2							✓	
1125+88	Rt	✓	1							✓	
1126+85	22' Rt			✓				✓			
1126+88	18' Rt			✓				✓			
1127+83	±					✓			✓		
1128+07	20' Rt			✓				✓	✓		
+11	20' Lt			✓				✓	✓		
+24	30' Rt			✓	DBT				✓		
+35	22 Rt			✓				✓	✓		
+49	20' Lt			✓	San.				✓		
+52	34 Rt			✓	San.					✓	
+61	Rt	✓	1							✓	
+63	26' Rt			✓	Storm				✓		
+65	15' Rt			✓	OHIO Bell					✓	

PERSONNEL TITLE PERSONNEL TITLE COUNTY DATE

S. R. WEATHER

SEC. TEMP.

DESCRIPTION LEFT CENTER LINE RIGHT JOB NO.

STATION	OUT Rt-Lt	CB	TYPE 1,2,3	MH	TYPE San. Storm	MONU	TYPE Box Other	WV	CASTING		Remarks
									Raise	Feather	
1128+92	Lt	✓	1							✓	double
1129+12	Rt	✓	2							✓	"
1129+39	23' Rt			✓			Gas Value		✓		
1130+75	24' Rt						11		✓		
1130+83	24' Rt						11		✓		
1131+07	24' Rt			✓	Storm				✓		
1131+07	24' Lt			✓	"				✓		
1131+44	Rt			✓	OB				✓		
1131+51	20' Lt			✓	San.				✓		
1131+87	Rt	✓	1							✓	
1132+19	Lt	✓	1							✓	
1132+19	Rt	✓	1							✓	
1133+51	19' Rt			✓	San.				✓		
1134+71	26' Lt			✓	Storm				✓		
+72	24' Rt			✓	San.				✓		
+74	21' Rt			✓				✓	✓		
+79	20' Lt			✓				✓	✓		
+81	36' Lt			✓	San.				✓		
+79	54' Rt			✓	Storm					✓	
1135+11	43' Lt			✓				✓		✓	
1135+25	47' Lt			✓	OB					✓	
1135+00	E					✓			✓		
1135+47	25' Lt			✓				✓	✓		
1135+10	31' Rt							✓	✓		
+18	13' Rt			✓	OB				✓		
+21	13' Rt			✓				✓	✓		
+22	25' Rt			✓	Storm				✓		
+29	18' Rt			✓	San.				✓		
+30	22' Rt			✓	OB				✓		
+32	35' Rt			✓				✓	✓		
+38	50' Rt			✓	Storm				✓		
1136+21	18' Rt			✓	OB				✓		
+49	18' Lt			✓	Storm				✓		
+49	20' Rt			✓	"				✓		
1139+06	Rt	✓	1							✓	
+12	Lt	✓	1							✓	
1140+08	25' Rt			✓				✓	✓		
1141+34	25' Rt			✓				✓	✓		
+43	24' Rt			✓				✓	✓		
+73	24' Rt			✓				✓	✓		
+87	14' Rt			✓	OB				✓		
+94	14' Rt			✓	OB				✓		
1142+26	Lt	✓	1							✓	
+26	Rt	✓	1							✓	

STATION	OUT RT LT	C.B.	TYPE 1, 2, 3	M.H.	TYPE STORM	MON.	TYPE OTHER	N.W. V.	CHRYL K.WISE	FEATHER	REMARKS
142+57	14 RT			✓	OBT				✓		
+63	14 RT			✓	OBT				✓		
143+39	23' LT			✓	San				✓		
+39	23' RT			✓	San				✓		
+67	22' LT			✓	Storm				✓		
144+89	24' LT			✓	"				✓		
145+45	LT	✓	1							✓	
+45	RT	✓	2							✓	
146+28	36 RT			✓	San					✓	
147+22	24' LT			✓	Storm				✓		
+38	14' RT			✓	OBT				✓		
148+92	LT	✓	2		"					✓	
+94	23' RT			✓	San				✓		
149+88	24' LT			✓	"				✓		
148+94	RT	✓	2							✓	
151+45	LT	✓	1							✓	
+45	RT	✓	1							✓	
152+39	23 LT			✓				✓	✓		
+38	15' RT			✓	OBT				✓		
154+44	LT	✓	1							✓	
+44	RT	✓	1							✓	
155+12	24' LT			✓	San				✓		
+12	24' RT			✓	Storm				✓		
157+38	15' RT			✓	OBT				✓		
+44	LT	✓	1							✓	
+44	RT	✓	1							✓	
159+84	22 RT			✓	Storm				✓		
161+08	19 LT			✓	"				✓		
162+44	24 LT			✓	San				✓		
+50	14 RT			✓	OBT					✓	
161+59	E					✓			✓		
164+96	LT	✓	1							✓	
+96	RT	✓	1							✓	
165+37	23' RT			✓	San				✓		
167+50	14' RT			✓	OBT				✓		
+66	24' LT			✓	San				✓		
+66	24' RT			✓	Storm				✓		
168+20	LT	✓	1							✓	
+20	RT	✓	1							✓	
+29	14' RT			✓	OBT				✓		

STATION	RT LT	CIG.	1, 2, 3	M.H.	STAND	MON	OTHER	W.V.	RAISE	FEATHER	REMARKS
1168+63	19 LT			✓				✓		✓	
+74	19 LT			✓				✓	✓		
1169+88	23 LT			✓	Seni.				✓		
1168+63	22 RT			✓	?				✓		→ Covered Up
1171+60	LT	✓	1							✓	
+60	RT	✓	1							✓	
+60	20 RT			✓	Storm				✓		
1171+77	14 RT			✓	OBT				✓		
1174+45	LT	✓	1							✓	
+45	RT	✓	1							✓	
+45	20 RT			✓	Storm				✓		
1174+85	23 RT			✓	Seni.				✓		
+85	24 LT			✓	Storm				✓		
1176+00	14 RT			✓	OBT				✓		
+44	LT	✓	1							✓	
+44	RT	✓	1							✓	
+44	20 RT			✓	Storm				✓		
1177+60	18 LT			✓	"				✓		
1178+41	18 LT			✓	"				✓		
1180+80	23 LT			✓	"				✓		
+80	22 RT			✓	Seni.				✓		
+99	14 RT			✓	OBT				✓		
1182+64	LT	✓	2							✓	
+64	RT	✓	1							✓	
+64	21 RT			✓	Storm				✓		
1183+28	23 LT			✓				✓	✓		
1183+99	14 RT			✓	OBT				✓		
1184+95	LT	✓	1							✓	
+95	RT	✓	1							✓	
1187+81	21 LT			✓				✓	✓		
+97	15 RT			✓	OBT				✓		
+97	16 LT			✓	Seni.				✓		
1188+11	Φ					✓			✓		
+27	15 RT			✓	OBT				✓		
+35	27 LT			✓				✓	✓		
+35	30 RT			✓	Seni.				✓		
+42	22 LT			✓				✓	✓		
+51	14 LT			✓				✓	✓		

STONE

Needs info
LUC 2-20.49

FROM TONY CADY

- ① Need curb height SLM 20.49 to SLM 20.52 and from SLM 21.15 to SLM 22.52
- ② Need representative sections curb to curb for above limits
- ③ Need rutting limits and intersection measurements to calculate said limits at Wheeling St. North & South and also at Isaac St.
- ④ Need length of no work area at Toledo Terminal Railroad SLM being 20.99 140'
- ⑤ Check end work SLM point at Coy Rd. 1198+53
- ⑥ Is there paved shoulders SLM 20.52 to SLM 21.15. If so need width. No
Spillovers - patchwork

PERSONNEL	TITLE	PERSONNEL	TITLE
<u>Stark</u>			
<u>Craw</u>			


COUNTY Lucas DATE 16 March 87

S. R. #2 WEATHER Sunny

SEC. 20.49-22.52 TEMP. 37°

DESCRIPTION Pavement Rutting areas JOB NO. _____

LEFT CENTER LINE RIGHT

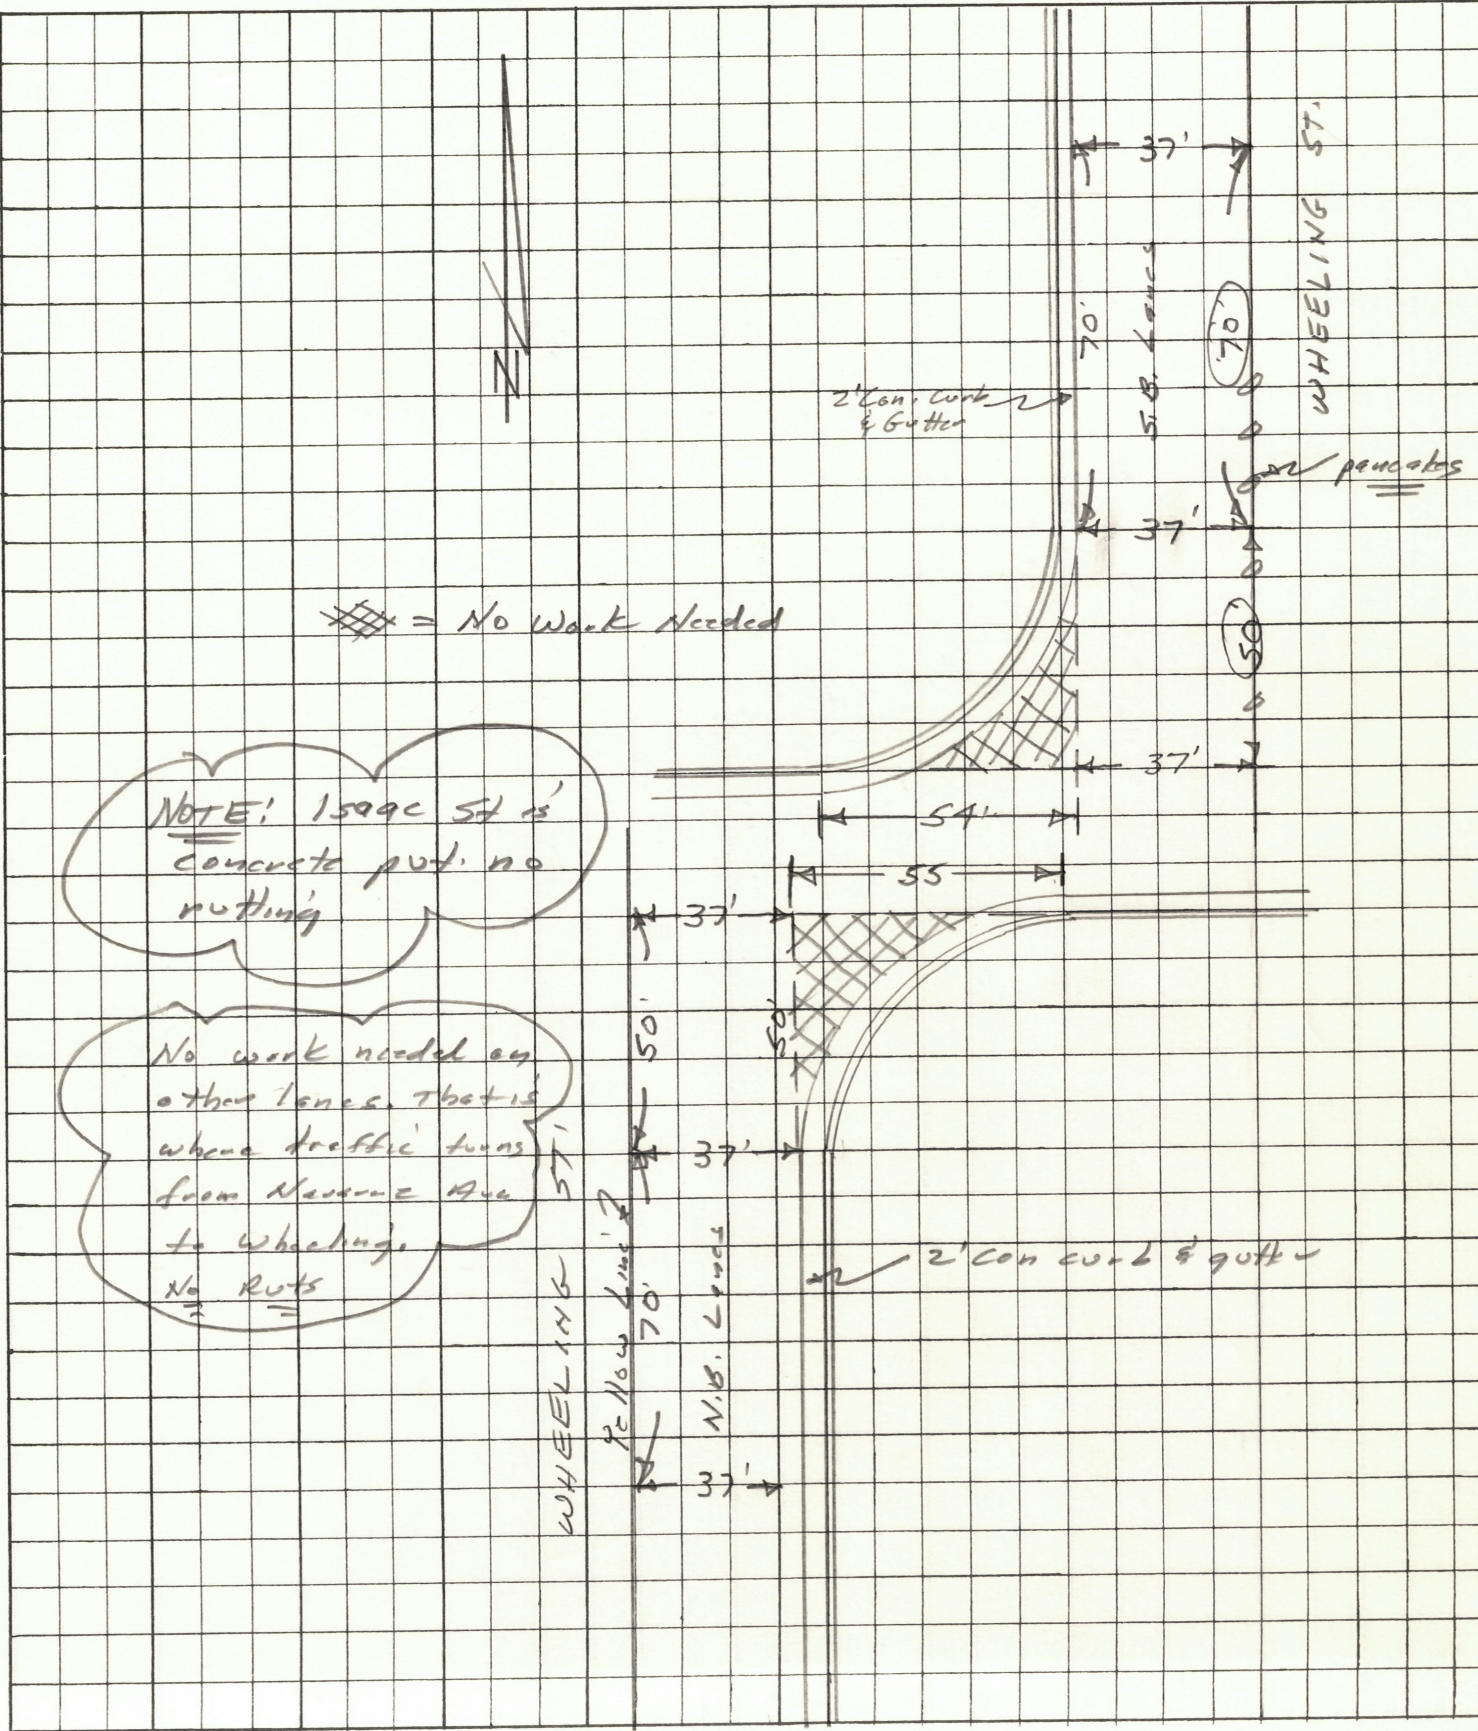

PERSONNEL	TITLE	PERSONNEL	TITLE	COUNTY	<u>Lucas</u>	DATE	<u>16 March 87</u>
<u>Stane</u>				S. R.	<u>#2</u>	WEATHER	<u>Sunny</u>
<u>Crew</u>				SEC.	<u>20.49-22.52</u>	TEMP.	<u>35°</u>
DESCRIPTION				JOB NO.			

LEFT

CENTER LINE

RIGHT

NOTE: In all cases Top curb Lt. Side = "0"

1082+50±	4.92 0 TC	5.16 0 EP	4.82 12	4.69 19 CR	4.90 26	5.20 36.5 EP	4.92 36.5 TC
1118+00	4.89 0 TC	5.12 0 EP	4.84 14	4.70 28 CR	4.89 42	5.15 56 EP	4.82 56 TC
1125+60	5.60 0 TC	5.94 0 EP	5.67 14	5.44 28 CR	5.66 42	5.93 56 EP	5.66 56 TC
1134+0	5.24 0 TC	5.52 0 EP	5.17 14	5.07 33 CR	5.13 52	5.32 66 EP	5.12 66 TC
1136+0	5.14 0 TC	5.50 0 EP	5.20 14	5.14 33 CR	5.37 52	5.39 66 EP	5.19 66 TC
1142+0	5.16 0 TC	5.50 0 EP	5.00 14	4.76 27 CR	5.04 42	5.45 54 EP	5.17 54 TC
1152+0	5.50 0 TC	5.74 0 EP	5.26 14	5.05 27 CR	5.40 42	5.70 54 EP	5.40 54 TC
1162+0	5.40 0 TC	5.59 0 EP	5.18 14	4.96 27 CR	5.22 42	5.58 54 EP	5.30 54 TC
1172+0	4.19 0 TC	4.43 0 EP	4.00 14	3.83 27 CR	4.09 42	4.43 54 EP	4.14 54 TC
1182+0	4.92 0 TC	5.22 0 EP	4.85 14	4.62 27 CR	4.89 42	5.23 54 EP	4.94 54 TC
1187+00	4.91 0 TC	5.17 0 EP	5.05 14	4.94 27 CR	5.03 42	5.20 54 EP	4.88 54 TC

PERSONNEL	TITLE	PERSONNEL	TITLE	COUNTY	DATE
Stone				Lucas	6 April 87
Crow				#2	Cloudy
				SEC. 20.49-22.52	TEMP. 45°

DESCRIPTION Pavement & Rutting Areas JOB NO. _____

LEFT CENTER LINE RIGHT

