LD-5—(25M—2-59)

SHEET NO. 12-26

PERSONNEL	TITLE	PERSONNEL	TITLE
Stone	Notes		
Michalak	Tape		
Schroder	Tape		

COUNTY Lucas DATE 1 July 68

S. R. 24-25 Bypass WEATHER Warm

SEC. Alexis Rd. TEMP. 85°

DESCRIPTION References to Control Points JOB NO.

LEFT CENTER LINE RIGHT

7/12/71
checked ok
Tomsic + Crown

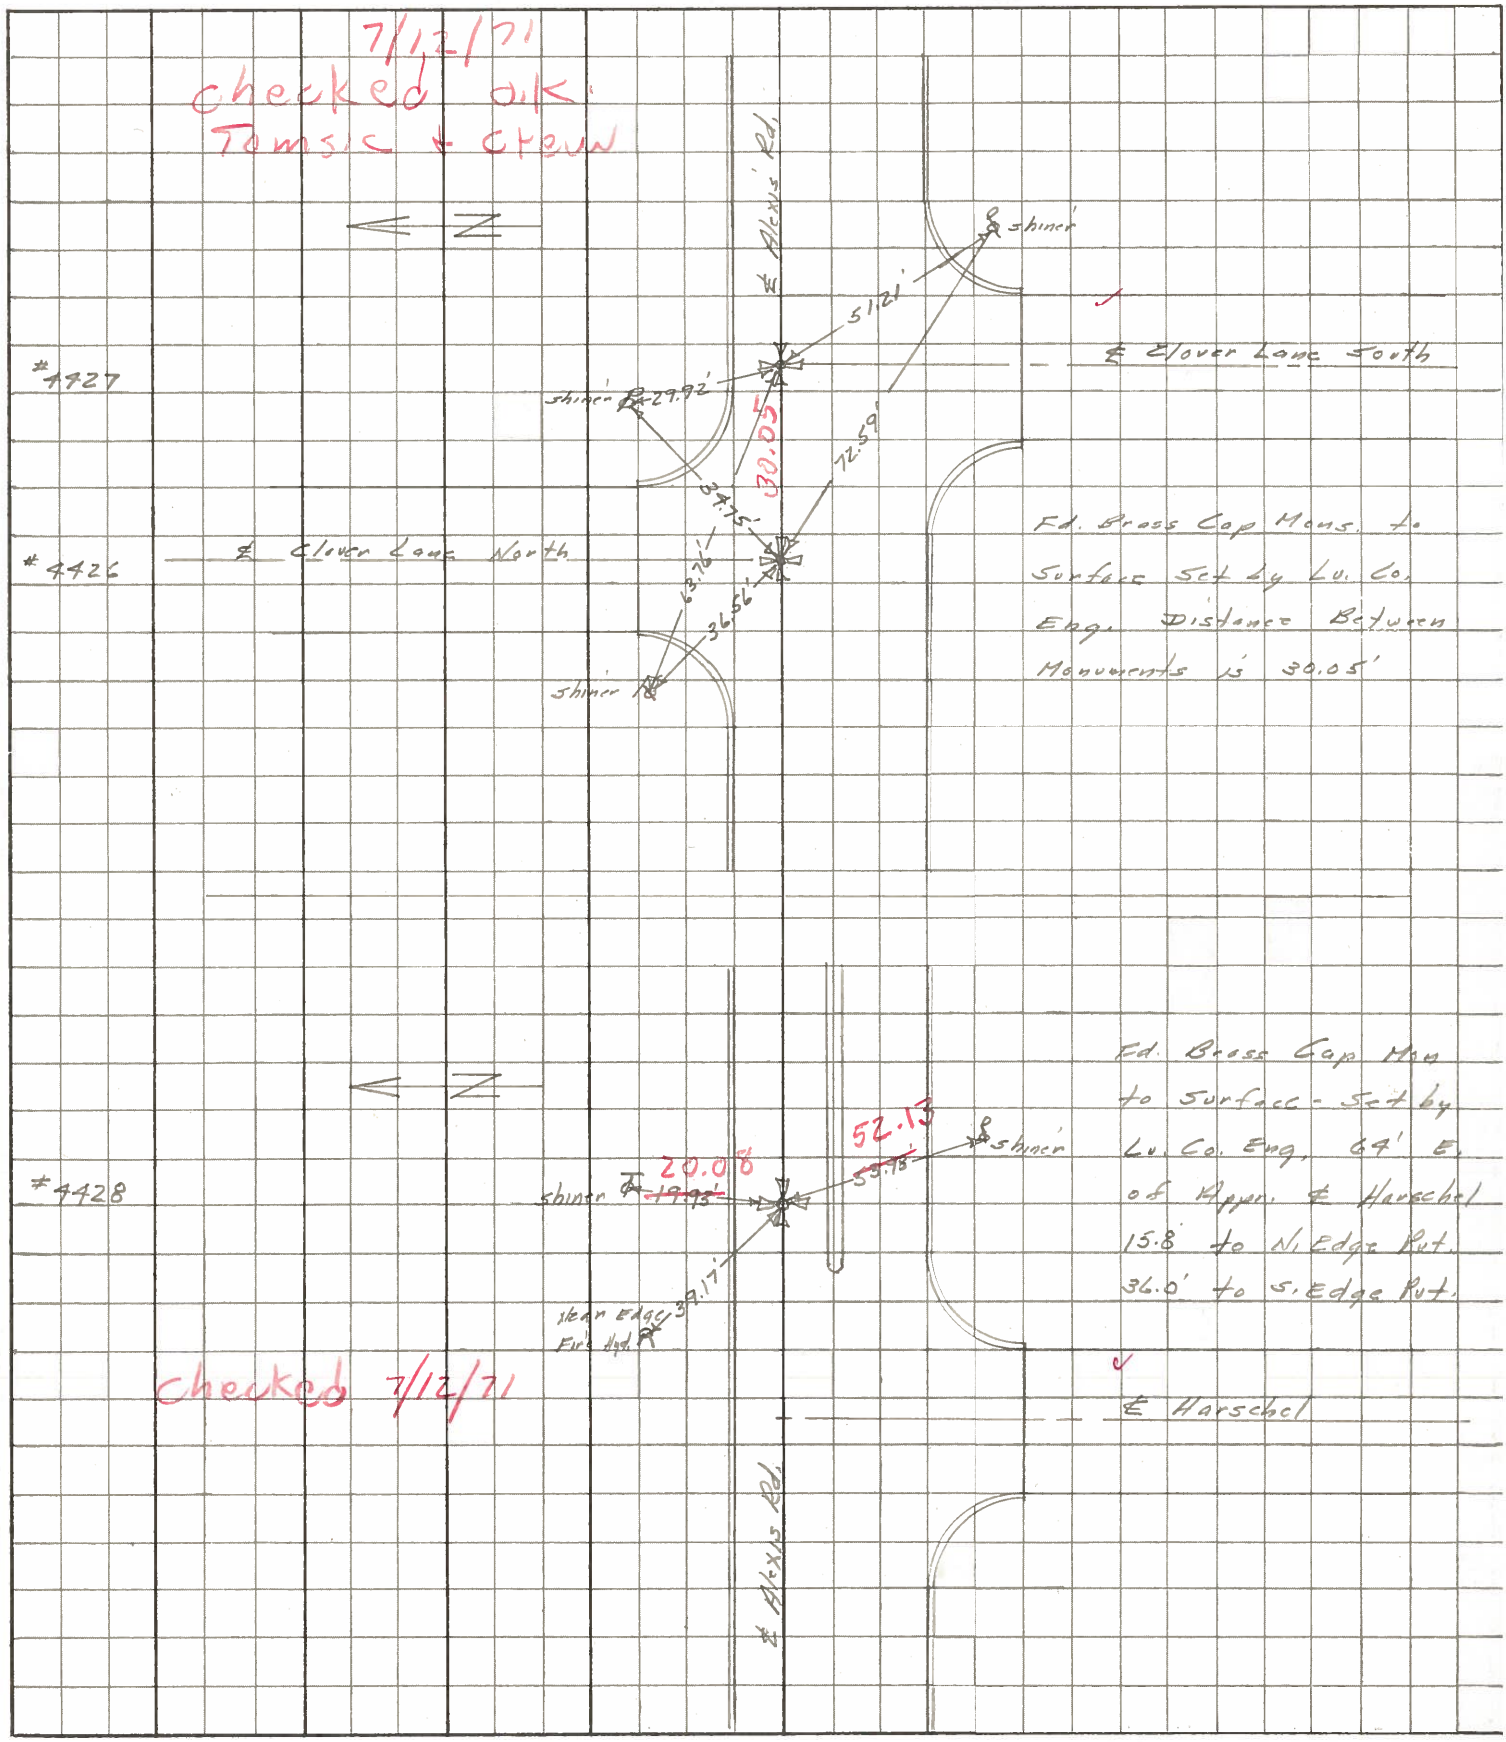

checked 7/12/71