O.D.O.T. DISTRICT 2 SURVEY OFFICE (USE ONLY)

PERSONNEL

NOTES WESTFALL
H.C. ROUSOS
R.C. WESTFALL
KEFFER

REFERENCE NO. 28 CB SHEET 2 OF 9

DATE 8/2/13
WEATHER SUNNY
TEMP. 70°

ROUTE SR 295
COUNTY LUCAS
TOWNSHIP SWANTON
SECTION 9
T 7 N R 9 E

TYPE MONUMENT MONBOX W/ 5/8" IPIN
ON SURFACE - ~~BELOW~~ ON
LEFT - ℄ PAV'T - RIGHT -
- TO - EDGE PAVEMENT
S.L.M. 537+37.4
GRID: NORTHING: 697963.543 EASTING: 1603432.044

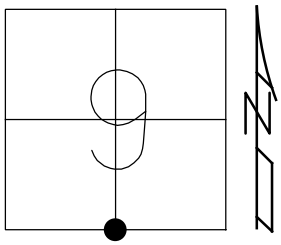

RECORD:
FD MONBOX
W/1 1/2" SQ BOLT
SET BY LUCAS CO
6/28/85, IS
FD MONBOX
REF9
12/6/11, DCH
FD MONBOX
W/ 5/8" IPIN
NEWREF9
8/2/13, EBW
4/11/14, DCH
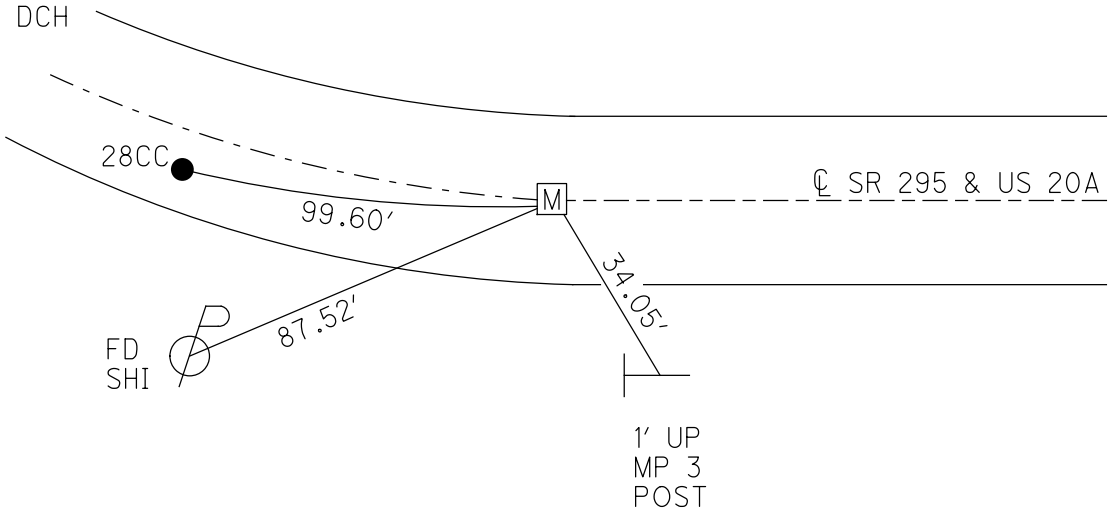
NOTE: REF 12A US 20A