O.D.O.T. DISTRICT 2 SURVEY OFFICE (USE ONLY)

PERSONNEL

REFERENCE NO. 28 CF SHEET 6 OF 9

NOTES WESTFALL
H.C. ROUSOS
R.C. WESTFALL
KEFFER

DATE 8/2/13
WEATHER SUNNY
TEMP. 70°

ROUTE SR 295
COUNTY LUCAS
TOWNSHIP SWANTON
SECTION 9
T 7 N R 9 E

TYPE MONUMENT 2" SQ. BOLT
~~ON SURFACE~~ - BELOW 2"
LEFT - ℄ PAV'T - RIGHT -
- TO - EDGE PAVEMENT
S.L.M. 571+54.85
GRID: NORTHING: 700580.729 EASTING: 1602019.061

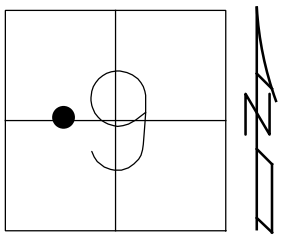

NOTE: REF 7 US 20A

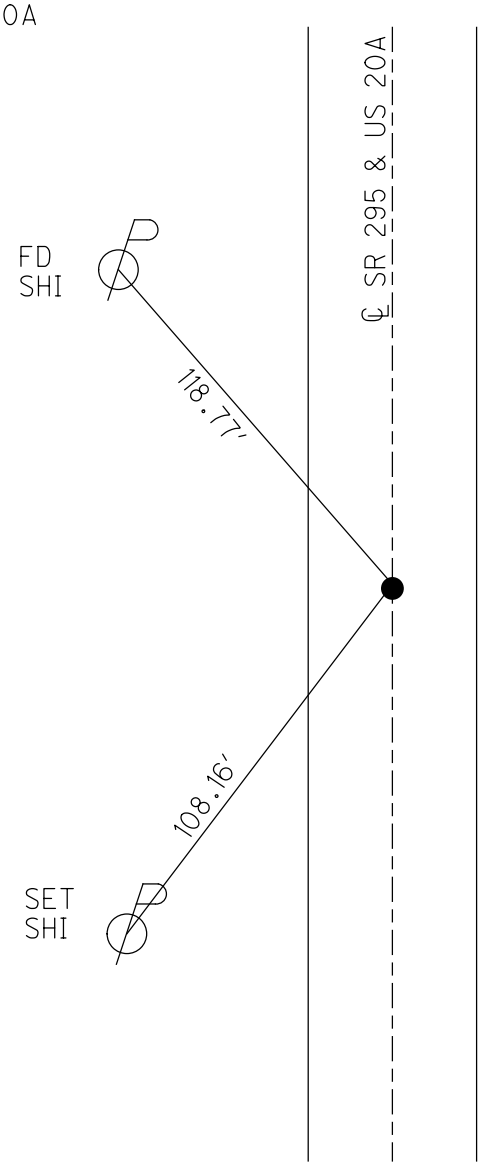

RECORD:
FD SQ BOLT
3" DEEP
6/28/85, IRS
FD SQ BOLT
REF7
12/6/11, DCH
SET MAG/WASHER
NEWREF7
8/2/13, EBW
4/11/14, DCH