

DATE 9-7-1993  
PERSONNEL CAENEY  
RAPPLE  
BARBOUR  
GEYMAN

NOTES TO B. ROSSBACK 9-10-93  
1994 TWO-LANE RESURFACING PROGRAM  
1995  
9

PRIORITY NO. 21  
COUNTY OTTAWA  
BEGIN LOG (SLM) 0.00  
END LOG (SLM) 2.71  
TOTAL LENGTH 2.71  
MUNICIPALITY Elmore  
MUNICIPALITY  
PART 4 OF 4  
ROUTE SR 105  
TERMINII Sandusky Co Line  
TERMINII SR 51  
MILES  
BEGIN LOG (SLM) 2.48  
END LOG (SLM) 2.50  
SECTION 00.00  
END LOG (SLM)  
END LOG (SLM)

PROPOSED WORK: Resurface, minor patch repairs @ SR 51  
PAVEMENT 1 1/2" 404  
SHOULDER 1 1/2" 404 & 617  
OTHER

STATION ESTABLISHED FROM: REFERENCE L. CONTROL POINT @ STA. 0+00  
C.R. #44 @ SANDUSKY - OTTAWA CO. LINE. 0+00 OTTAWA CO. =  
267+69.6 SANDUSKY CO.

STRUCTURES:

| NUMBER | STATION | WIDTH | LENGTH | PROPOSED WORK |
|--------|---------|-------|--------|---------------|
| 01.00  | 53+18   | 28'   | 289'   |               |
|        |         |       |        |               |
|        |         |       |        |               |
|        |         |       |        |               |

RAILROAD CROSSING: (NO WORK)  
NAME STATION NO. TRACKS LENGTH ALONG C L FT

COUNTY OTAWA ROUTE S.E. #105 SECTION 0.00

L - PROP PAVT DEPTH (IN) X 10; W - WIDTH @ MOUTH; W-I - WIDTH @ THROAT

[illegible]

COUNTY OTTAWA ROUTE SE #105 SECTION 0.00

[illegible]

\* = STATION LOCATION

[illegible]

COUNTY OTAWA ROUTE SR #105 SECTION 0.00


[illegible]

State of Ohio Department of Transportation  
Field Notes

SHEET NO. 5-5  
DATE 9-8-1993

| PERSONNEL | TITLE      | PERSONNEL | TITLE | COUNTY      | DATE           | 9-8-1993 |
|-----------|------------|-----------|-------|-------------|----------------|----------|
| CHEWY     | Q. R. TAPE |           |       |             |                |          |
| BARBOUR   | A. TAPE    |           |       | S. R. # 105 | WEATHER CLOUDY |          |
|           |            |           |       | SEC. 0.00   | TEMP 70°       |          |

| DESCRIPTION                            | JOB NO. |
|----------------------------------------|---------|
| INTERSECTION DETAIL S.C.#105 & S.P.#51 |         |

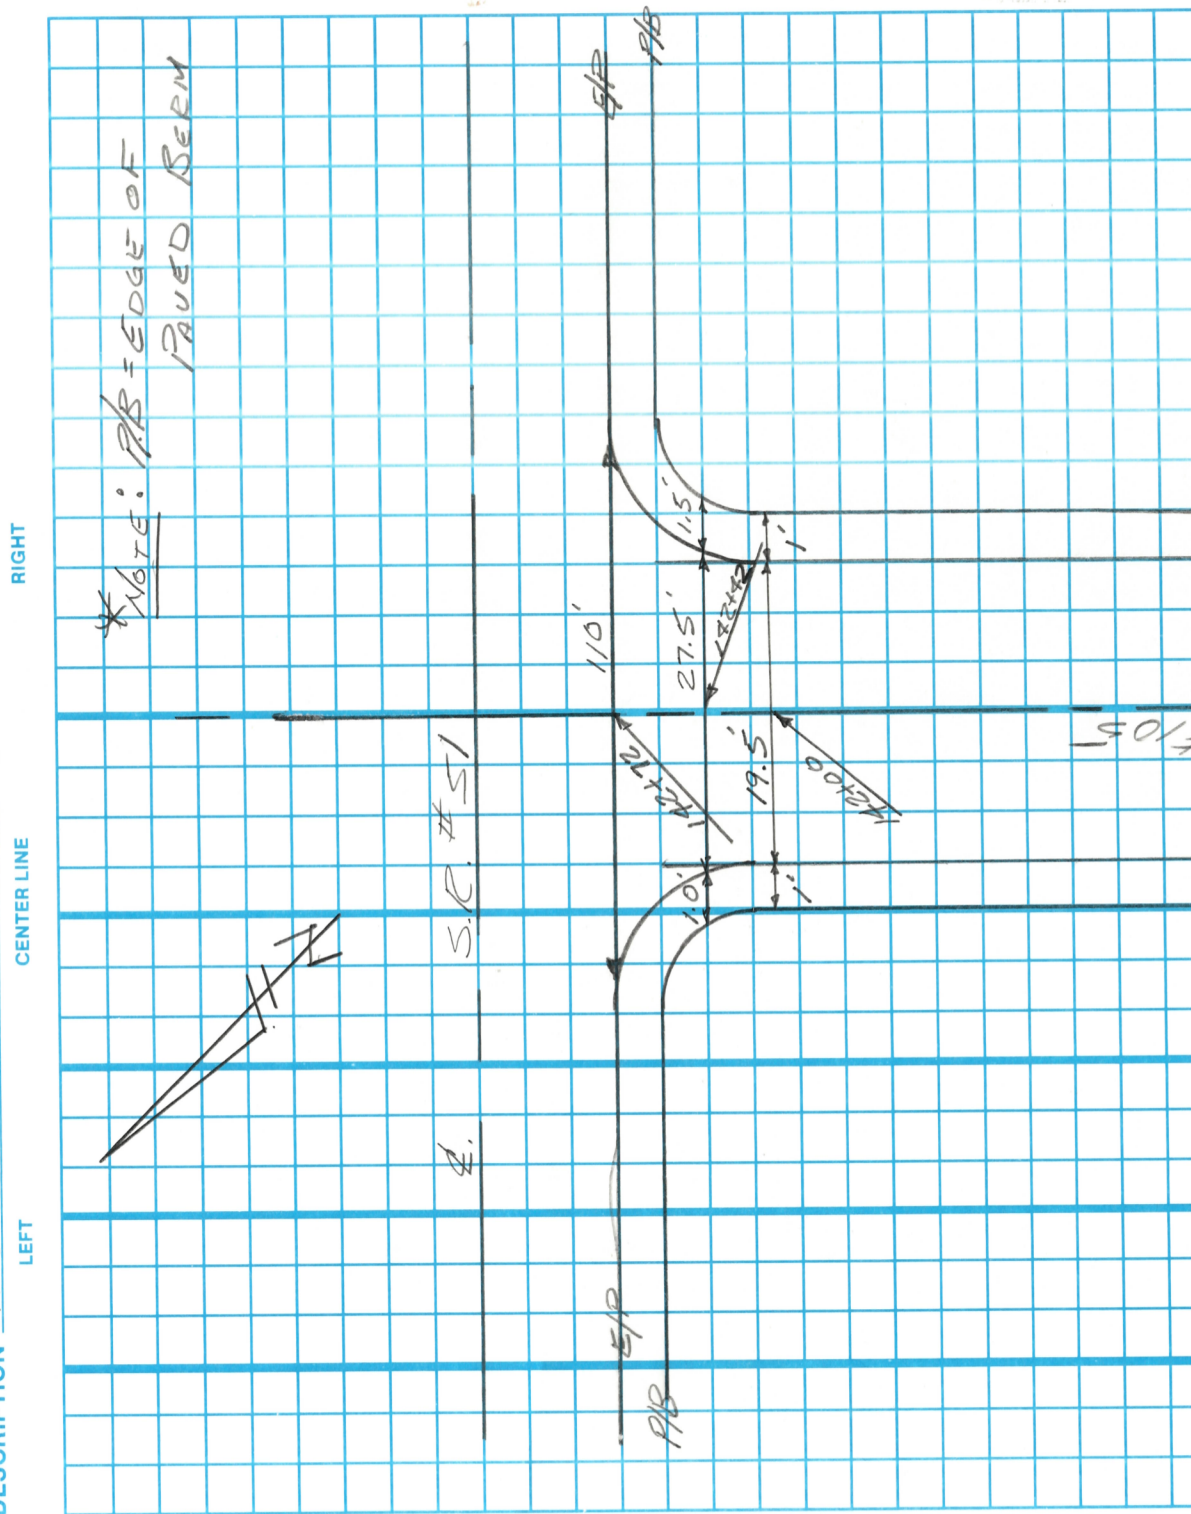

**1994 TWO-LANE RESURFACING PROGRAM  
DEFECTIVE PAVEMENT AREAS**

COUNTY \_\_\_\_\_ ROUTE \_\_\_\_\_ SECTION \_\_\_\_\_

[illegible]