SCHNEIDER

MAINTENANCE PROGRAM 1981

PART 1
OF 2

(TOP) TYPE 404 THICKNESS 1½" _____ PRIORITY

(BASE) TYPE _____ THICKNESS _____ _____ PENETRATION

END LOG S.L.M. 0.96 (SR 2 construction joint 16.172)

BEGIN LOG S.L.M. 0.00 (SR 163 Construction Joint)

TOTAL LENGTH 0.96

				BERM	CURBED
COUNTY OTTAWA	SECTION 0.00	WIDTH (20)		( )	( )
ROUTE SR 358	SECTION 0.96	WIDTH ( )		( )	( )
	SECTION	WIDTH ( )		( )	( )
ORDINANCE	SECTION	WIDTH ( )		( )	( )
END LOG	SECTION	WIDTH ( )		( )	( )
BEGIN LOG	SECTION	WIDTH ( )		( )	( )

EXISTING BERM TYPE Aggr. (PAVED, STABILIZED, AGGREGATE)

EXISTING BERM WIDTH 1½'±

MAILBOX APPROACHES No. 0

MANHOLES 0

PROPOSED BERM TYPE 405

PROPOSED BERM WIDTH 2" X

INLETS CATCH BASINS 2

INTERSECTIONS 0

ASPHALT DRIVEWAYS 1

CONCRETE DRIVEWAYS 1

STRUCTURES

STRUCTURE NO.	WIDTH	LENGTH	APPR. SLABS
01-358-0079	24'	43'	20'D25
	No no	previous	topping

RAILROAD CROSSINGS

NAME R. R.	STATION	(*)	No. ( )	TRACKS
Conrail	7489.5	(34.5)	3	TRACKS
" Spur	12+75	(140')	1	TRACKS
		( )		TRACKS
		( )		TRACKS
		( )		TRACKS

*Indicate length of crossing along ℄ Pav't.

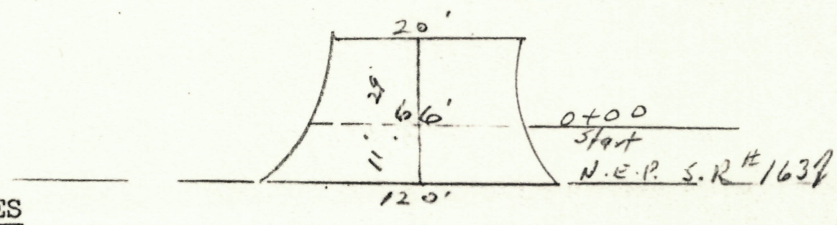

NOTES

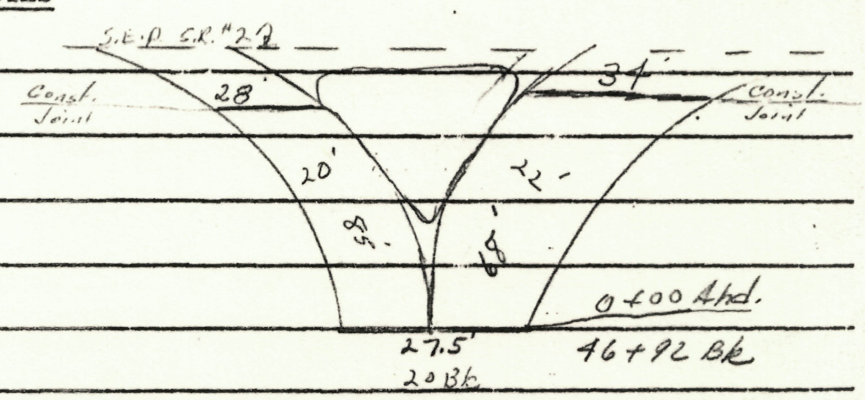

MGR 02-701

SHEET NO.

PERSONNEL	TITLE	PERSONNEL	TITLE
Lois			
Lynn			
Francis			

COUNTY Ottawa DATE 11/12/82

S. R. #358 WEATHER overcast

SEC. 0.00 - 0.96 TEMP. 35°

DESCRIPTION Maintenance Program 1981 JOB NO.

LEFT CENTER LINE RIGHT

STATION	OUT Rt.-Lt.	CB	TYPE 1,2,3	MH	TYPE San. Storm	MONU	TYPE Box Other	WV	CASTING Raise	CASTING Feather		Remarks
8+04 on Lod #5 S.P. #2	Lt.	✓	#1						✓			
8+55 on Lod #5 S.P. #2	Lt.	✓	#1						✓			

M&R 02-752

SHEET NO. 1

PERSONNEL	TITLE	PERSONNEL	TITLE
[illegible]			
[illegible]			
[illegible]			

COUNTY Ottawa DATE 11/17/80

S. R. #358 WEATHER [illegible]

SEC. 0.00 - 0.96 TEMP. 35°

DESCRIPTION Maintenance Program 1981 JOB NO.

LEFT CENTER LINE RIGHT

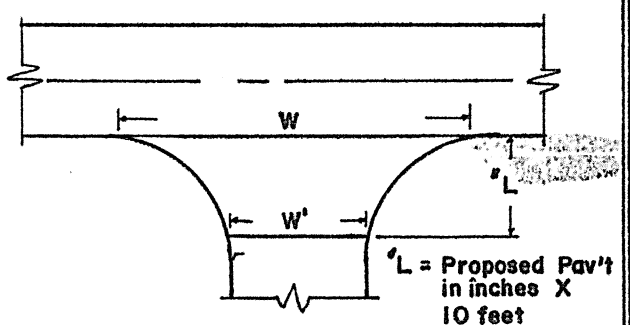

INTERSECTION TYPICAL

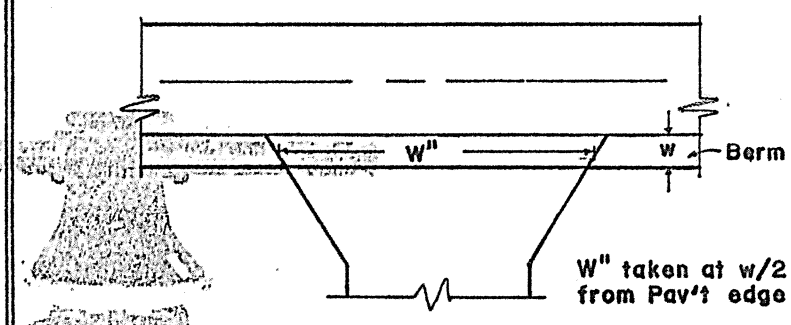

DRIVEWAY TYPICAL

STATION	RT. LT.	L	W	W'	Asph	Conc	

STATION	RT. LT.	w	W"	Asph	Conc	Aggr	Dropped Curb Feather NOT Req'd	
21+22	Lt.	2'	78	✓				
46+41	Rt.	2'	62.5'		✓		Feather To conc approach, to Gac Sh.	