For any Questions Please Contact ODOT District 2 Real estate at 419-353-8131

Scanned July 1997

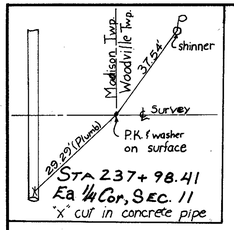

STA 237+98.41
Ea ¼ Cor, SEC. 11
"X" cut in concrete pipe

LOCATION MAP

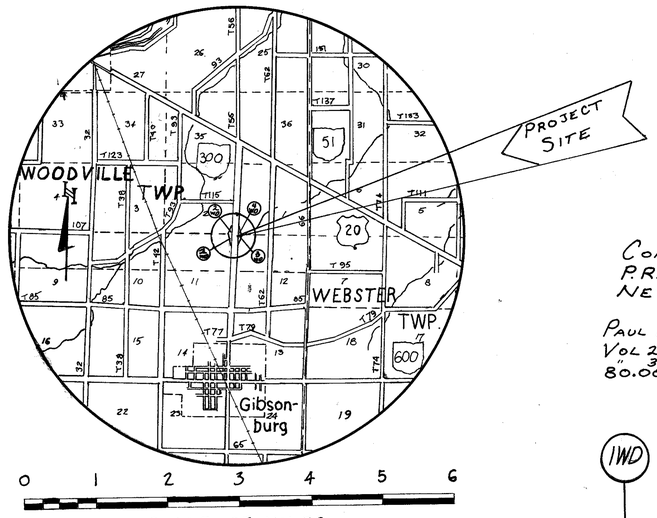

N½, NE. ¼, SEC. 11, T5N, R13E, WOODVILLE TWP.

E ½, SE. ¼, SEC 2, T5N R13E WOODVILLE TWP.

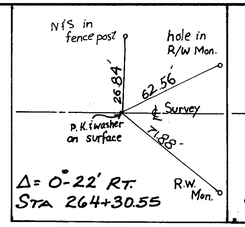

Δ = 0°-22' RT.
STA 264+30.55

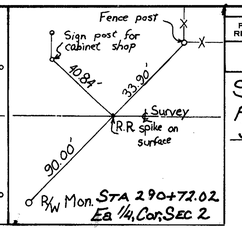

STA 290+72.02
Ea ¼ Cor. SEC 2

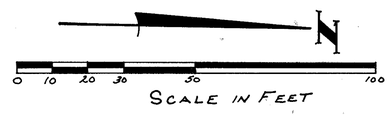

FHWA REGION	STATE	PROJECT	
5	OHIO		

18/19
1/2
5/11

SAN 300-5.00
PART 1
JOB NUMBER 625163

CONT. 0.184 Ac
P.R.O. 0.089 Ac
NET. 0.095 Ac.

PAUL W. & LOIS A. GERWIN
VOL 262, PG. 342
" 305 " 676
80.00 Ac

LEROY H. & OLETA GERWIN
VOL. 166, PG 155
71.56 Ac

CONT 0.086 Ac.
P.R.O. 0.057 Ac.
NET 0.029 Ac.

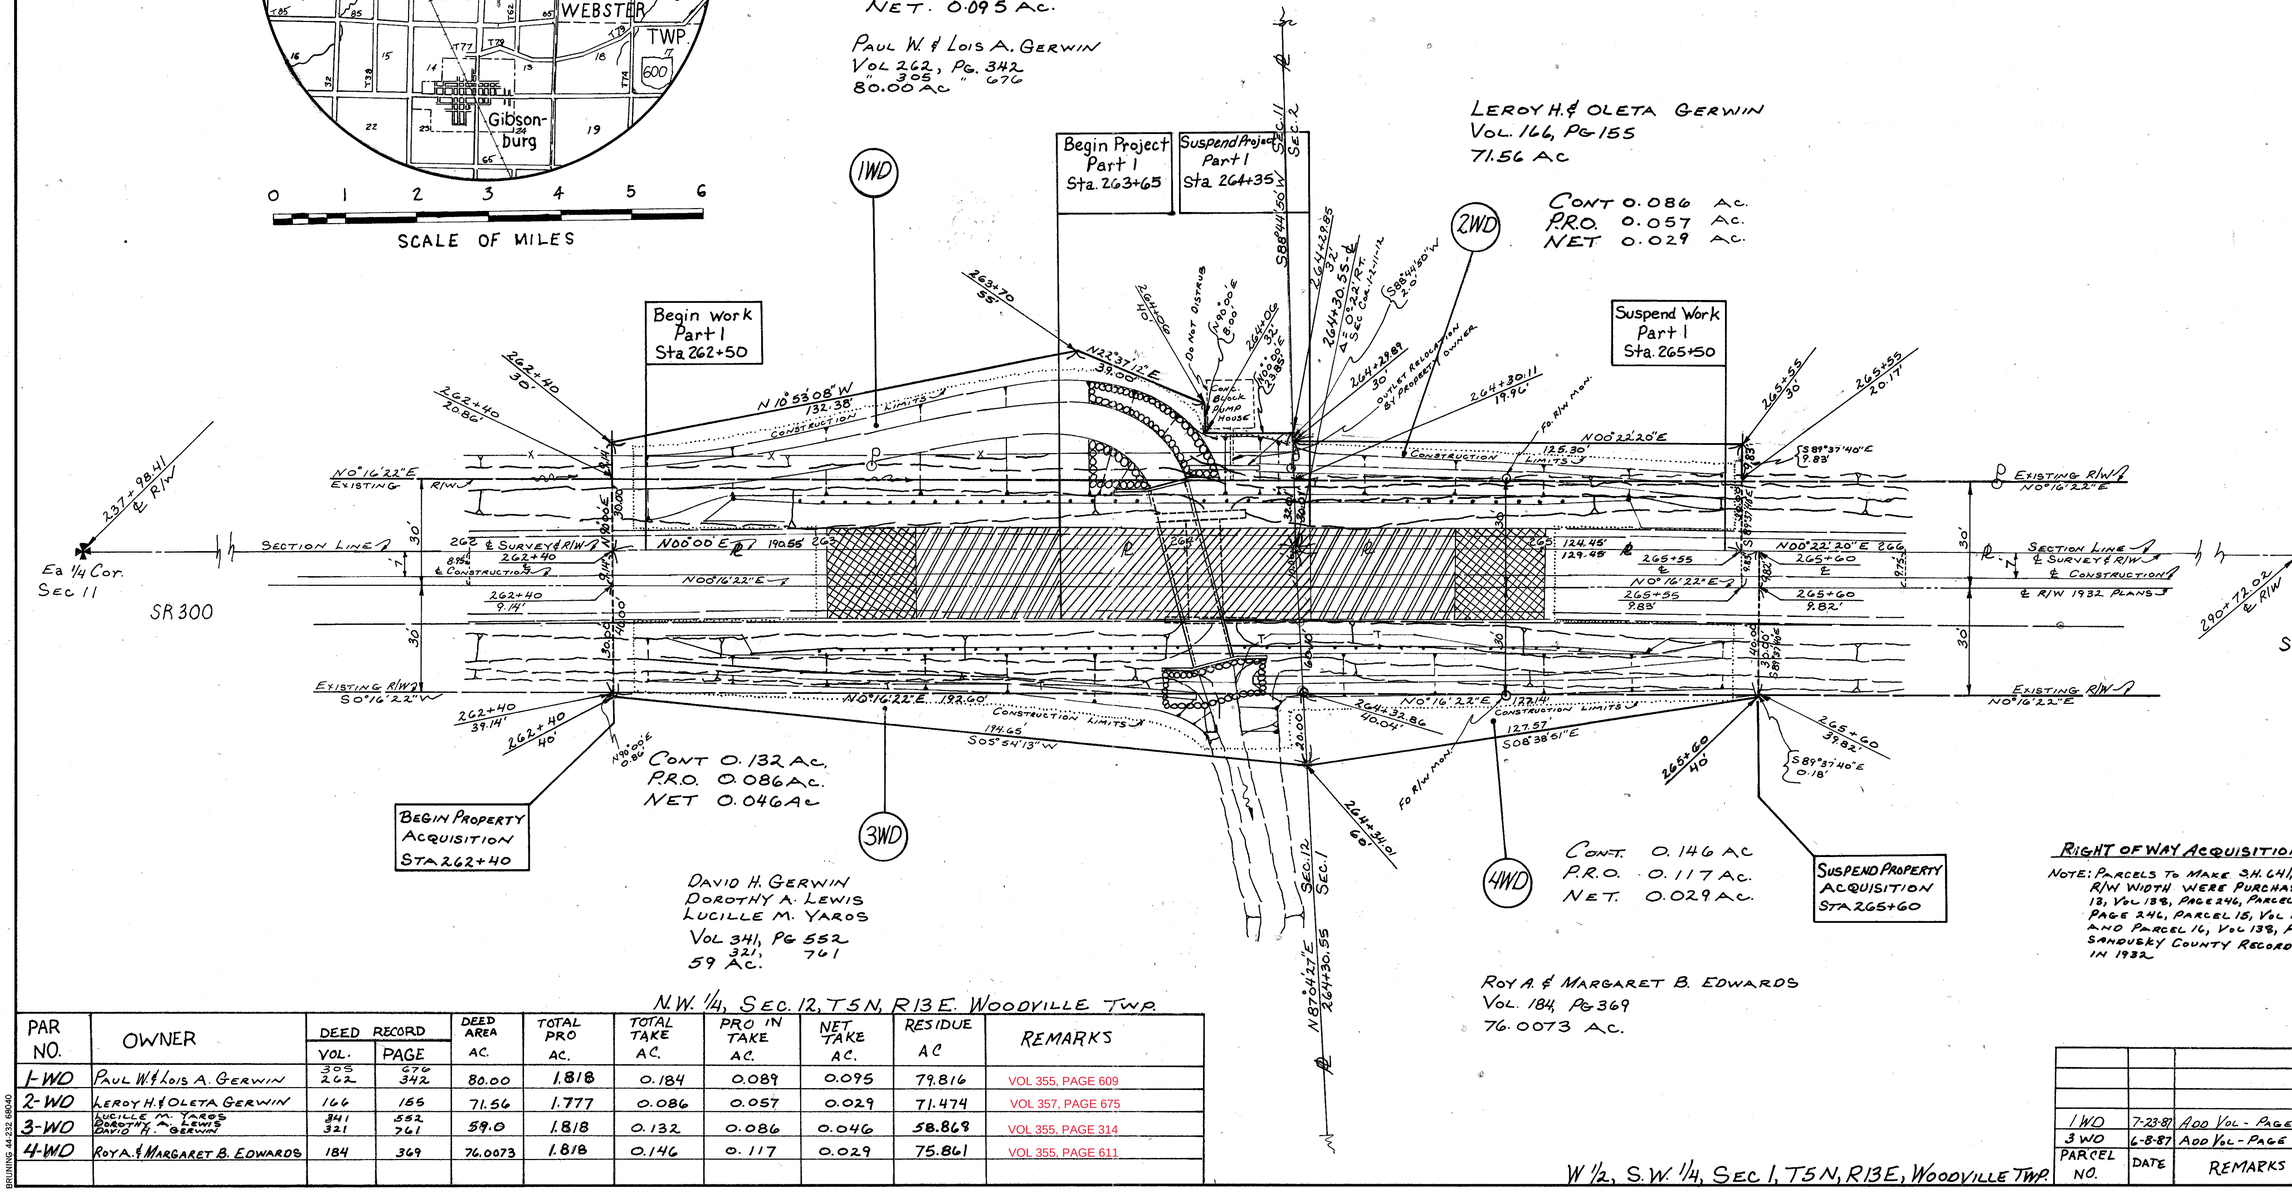

CONT 0.132 Ac.
P.R.O. 0.086 Ac.
NET 0.046 Ac

DAVID H. GERWIN
DOROTHY A. LEWIS
LUCILLE M. YAROS
VOL 341, PG 552
321, 761
59 Ac.

CONT. 0.146 Ac
P.R.O. 0.117 Ac.
NET. 0.029 Ac.

ROY A. & MARGARET B. EDWARDS
VOL. 184, PG 369
76.0073 Ac.

RIGHT OF WAY ACQUISITION – 1932

NOTE: PARCELS TO MAKE 3H. 641, SEC A 60 FT R/W WIDTH WERE PURCHASED AS PARCELS 13, VOL 138, PAGE 246, PARCEL 14, VOL 139 PAGE 246, PARCEL 15, VOL 139, PAGE 241 AND PARCEL 16, VOL 138, PAGE 243 SANDUSKY COUNTY RECORDER'S OFFICE IN 1932.

N.W. ¼, SEC. 12, T5N, R13E. WOODVILLE TWP.

PAR NO.	OWNER	DEED RECORD VOL.	DEED RECORD PAGE	DEED AREA AC.	TOTAL PRO AC.	TOTAL TAKE AC.	PRO IN TAKE AC.	NET TAKE AC.	RESIDUE AC	REMARKS
1-WD	PAUL W. & LOIS A. GERWIN	305 262	676 342	80.00	1.818	0.184	0.089	0.095	79.816	VOL 355, PAGE 609
2-WD	LEROY H. & OLETA GERWIN	166	155	71.56	1.777	0.086	0.057	0.029	71.474	VOL 357, PAGE 675
3-WD	LUCILLE M. YAROS DOROTHY A. LEWIS DAVID H. GERWIN	341 321	552 761	59.0	1.818	0.132	0.086	0.046	58.869	VOL 355, PAGE 314
4-WD	ROY A. & MARGARET B. EDWARDS	184	369	76.0073	1.818	0.146	0. 117	0.029	75.861	VOL 355, PAGE 611

W ½, S.W. ¼, SEC 1, T5N, R13E, WOODVILLE TWP.

PARCEL NO.	DATE	REMARKS
1 WD	7-23-87	ADD VOL - PAGE
3 WD	6-8-87	ADD VOL - PAGE

SAN 300-5.00

R330 #2 F66
0490 22 22 SHINRIB