

NOTES TO: B. ROSEBROCK 4-25-96

CORDS

CANTERBURY

PRIORITY NO. 11 PART 3 OF 4 SHEET 1 OF 8

COUNTY Seneca ROUTE SR 12 SECTION D.00

BEGIN LOG (SLM) 0.00 METRIC 0+000 TERMINII Hancock County Line

END LOG (SLM) 0.29 JOINT 0+420 TERMINII US 23

TOTAL LENGTH 0.29 0+420 METRIC MILES

MUNICIPALITY Fostoria BEGIN LOG (SLM) _____ END LOG (SLM) _____

MUNICIPALITY _____ BEGIN LOG (SLM) _____ END LOG (SLM) _____

PROPOSED WORK: Grind full width; outside lanes 3 1/4" and middle lanes 1 1/2"

PAVEMENT 1 3/4" 402 & 1 1/2" 404 outside lanes, 1 1/2" 404 middle lanes SHOULDER —

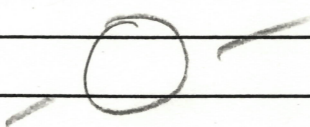
OTHER locate all rutted areas and bad pavement joints

STATION ESTABLISHED FROM:

By splitting the pav't at S. County Line St. and
calling it 0+000 in metric.

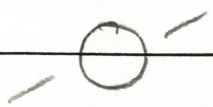
NO OBVIOUS JOINT, but we measured back west
to the Seneca Co. & Hancock Co. Line Sign & m.m. "0".

STRUCTURES: STATION 0 - 045

NUMBER	STATION	WIDTH	LENGTH	PROPOSED WORK
				

RAILROAD CROSSING:

(NO WORK)

NAME  STATION _____ NO. TRACKS _____ LENGTH ALONG C L _____ FT

NAME _____ STATION _____ NO. TRACKS _____ LENGTH ALONG C L _____ FT

MISCELLANEOUS:

NO RAISED PAVEMENT MARKERS; EDGE OF PAVEMENT - 0 - CENTERLINE - 0 -

NO. MAILBOX APPROACHES N/A MAILBOX SUPPORTS N/A

REMARKS: _____

DATE 4-24-96

SHEET 2 OF 8

1997
TWO-LANE RESURFACING PROGRAM
PAVEMENT DATA

NOTE: LOCATE ALL
CHANGES IN PVMT WIDTH

COUNTY Seneca ROUTE 12 SECTION 0.00-0.29 S4m

[illegible]

DATE 4-24-96

1997 TWO-LANE RESURFACING PROGRAM
INTERSECTIONS

SHEET 3 OF 8

COUNTY Seneca ROUTE 12 SECTION 0.00-0.29 SUM

L = PROP PAVT DEPTH (IN) X 10; W = WIDTH @ MOUTH; $W-I$ = WIDTH @ THROAT

[illegible]

DATE 4-24-96

SHEET 4 OF 8

SHEET 4 OF 8

UTILITIES (CATCH BASIN, MANHOLE, INLET, WATER VALVE, BOX AND MONUMENT BOX)

COUNTY Seneca ROUTE 12 SECTION 0.00-0.29 SLM

R = RAISE F = FEATHER

[illegible]

SHEET 5 OF 8

SHEET 5 OF 8

COUNTY Seneca ROUTE 12 SECTION 0.00 - 0.29 SLM

[illegible]

SHEET 6 OF 8

COUNTY Seneca ROUTE 12 SECTION 0.00 - 0.29 SLR

[illegible]

NOTE: LOCATE ALL
CHANGES IN PVMT WIDTH

1997
TWO-LANE RESURFACING PROGRAM
PAVEMENT DATA

DATE 4-24-96
SHEET 7 OF 8

COUNTY Seneca ROUTE 12 SECTION 0.00 - 0.29 SLM

PAVEMENT MARKINGS:

* = STATION LOCATION

[illegible]

SHEET 8 OF 8

SHEET 8 OF 8

COUNTY Seneca ROUTE 12 SECTION 0.00 - 0.29 SLM

[illegible]