LD-5—(25M—7-57)

SHEET NO. 9

PERSONNEL	TITLE	PERSONNEL	TITLE
Fish			
Cronin			
Leemaster		Lahr	
		John K.	

COUNTY Seneca DATE Dec. 18, '58

S. R. #18 Fostoria-Bascom Rd. WEATHER Cloudy

SEC. Sec. 18 (1.79 - 8.60) TEMP. 20°

DESCRIPTION Control Point Ties - & Survey & Const. JOB NO.

LEFT CENTER LINE Survey RIGHT

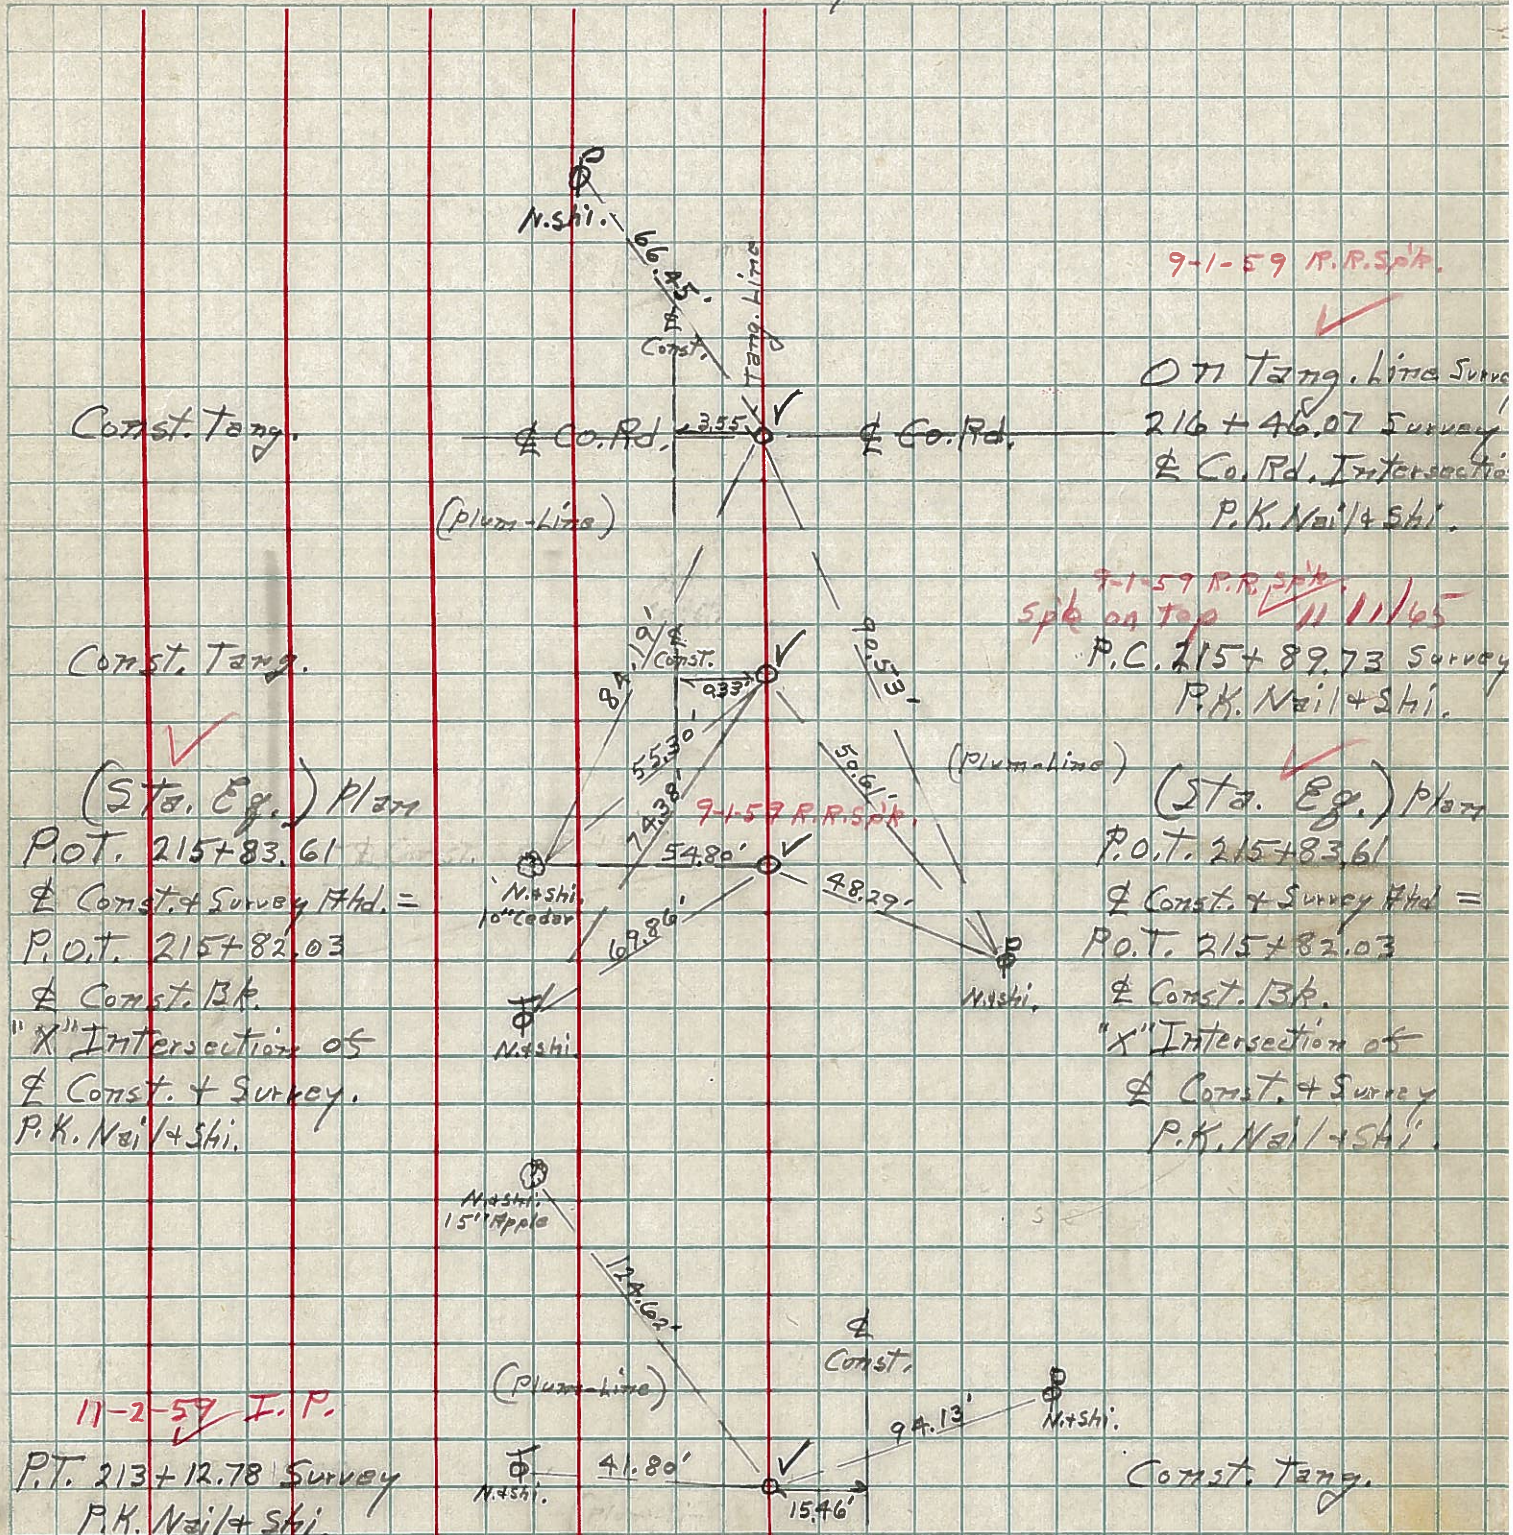

Const. Tang.

(Sta. ℄ Sta.) Plan
P.O.T. 215+83.61
℄ Const. & Survey Fwd. =
P.O.T. 215+82.03
℄ Const. Bk.
"X" Intersection of
℄ Const. & Survey.
P.K. Nail + Shi.

11-2-59 I.P.
P.T. 213+12.78 Survey
P.K. Nail + Shi.

9-1-59 R.R. Spk.
On Tang. Line Survey
216+46.07 Survey
℄ Co. Rd. Intersection
P.K. Nail + Shi.

9-1-59 R.R. Spk. spk on top 11/16"
P.C. 215+89.73 Survey
P.K. Nail + Shi.

(Sta. ℄ Sta.) Plan
P.O.T. 215+83.61
℄ Const. & Survey Fwd. =
P.O.T. 215+82.03
℄ Const. Bk.
"X" Intersection of
℄ Const. & Survey
P.K. Nail + Shi.

Const. Tang.