

(DOT 10-2) 1995 1996-97
 TWO-LANE RESURFACING PROGRAM
 Notes to: B. Ross ¹⁰⁻¹¹⁻⁹⁷
 PERSONNEL RIPPLE
BARBOUR
GEYMAN

PRIORITY NO. 18 PART 1 OF 4 SHEET 1 OF 10
 COUNTY Seneca ROUTE SR 19 SECTION 15.19
 BEGIN LOG (SLM) 15.19 (802+03.2) (BEGIN 801+36) TERMINII SR 228
 END LOG (SLM) 20.05 TERMINII Const joint in Green Springs
 TOTAL LENGTH 4.86 MILES
 MUNICIPALITY Green Springs BEGIN LOG (SLM) 19.75 END LOG (SLM) —
 MUNICIPALITY — BEGIN LOG (SLM) — END LOG (SLM) —

PROPOSED WORK: Resurface existing pavement & shoulder
 PAVEMENT 1 1/2" 404 SHOULDER 1 1/2" 404, 617
 OTHER Repair bad pavement areas

STATION ESTABLISHED FROM: BRIDGE STRUCTURE SEN. 19 1560 = 823+68
INTERSECTION SEN. 19, SR 228 & CR. #32 = 801+36 (REF. POINT)

NOTE: "NO CONST. JOINT VISIBLE 1000± NORTH OR SOUTH OF SLM 20.05"

STRUCTURES:

NUMBER	STATION	WIDTH	LENGTH	PROPOSED WORK
SEN. 19 15.60	823+68	30.2'	36.8'	
SEN. 19 16.39	880+96	13'	30.5'	
SEN. 19 17.72	936+45	41.2'	23.5'	
SEN. 19 18.25	963+24	39.7'	103'	

RAILROAD CROSSING: (NO WORK)
 NAME Norfolk Western STATION 1042+67 NO. TRACKS 2 LENGTH ALONG C L 20.5 FT
 STATION — NO. TRACKS — LENGTH ALONG C L — FT

COUNTY Seneca ROUTE 19 SECTION 15.19

R = RAISE F = FEATHER

[illegible]

DATE 7-5-1994

SHEET 4 OF 16

TWO-LANE RESURFACING PROGRAM
PAVEMENT DATA

1995

NOTE: LOCATE ALL
CHANGES IN PVMT WIDTH

SECTION 15.19 - 20.05

19

ROUTE

COUNTY SENECA

[illegible]

DATE 10-14-94

1995 TWO-LANE RESURFACING PROGRAM
DEFECTIVE PAVEMENT AREAS

SHEET 5 OF 10

COUNTY Seneca

ROUTE

19

SECTION

15.19

STATION		LT BERM	LT LANE	RT LANE	RT BERM	SIZE (WIDTH)	EXISTING PAVEMENT CONDITIONS	
FROM	TO						RUTTED	CRACKED BASE FAILURE
801+55	802+50		✓	✓		5'	X	X
801+55	807+20			✓		4'	X	X
806+00	810+00	✓				3'	X	X
808+60	810+00			✓	✓	5'	X	X
812+30	817+80			✓	✓	4'	X	X
818+30	818+80	✓				4'	X	X
821+50	822+45	✓	✓			5'	X	X
824+10	824+35				✓	3'	X	X
824+10	827+00	✓				3'	X	X
828+00	829+00			✓	✓	4'	X	X
828+00	832+30	✓	✓			4'	X	X
838+10	842+35	✓	✓			4'	X	X
847+00	854+45			✓	✓	4'	X	X
858+25	861+25	✓				3'	X	X
865+75	869+70			✓	✓	4'	X	X
870+45	875+85	✓	✓			3'	X	X
880+00	881+85			✓	✓	4'	X	X
889+00	890+70			✓	✓	5'	X	X
891+75	901+83			✓		4'	X	X
906+20	907+25	✓	✓			3'	X	X

X = STATION LOCATION										
STATION	LANE LT/RT	OTHERS (SKETCH)	X	X	X ^{RR} X	X ^{SCHOOL}	X ^{ONLY}	X	X	X
1038+48	RT				✓					
1046+67	LT				✓					

COUNTY	Seneca	ROUTE	19	SECTION	15.19
--------	--------	-------	----	---------	-------


[illegible]

State of Ohio Department of Transportation
Field Notes

PERSONNEL CHENEY TITLE _____ PERSONNEL _____ TITLE _____
RIPPLE _____
BARBOUR _____
GEYMAN _____

SHEET NO. 8 of 10
COUNTY SENECA DATE 8-11-94
S. R. # 19 WEATHER RAIN
SEC. 15, 19 TEMP. 70°
PA. 026112-74
JOB NO. _____

DESCRIPTION RESURFACING

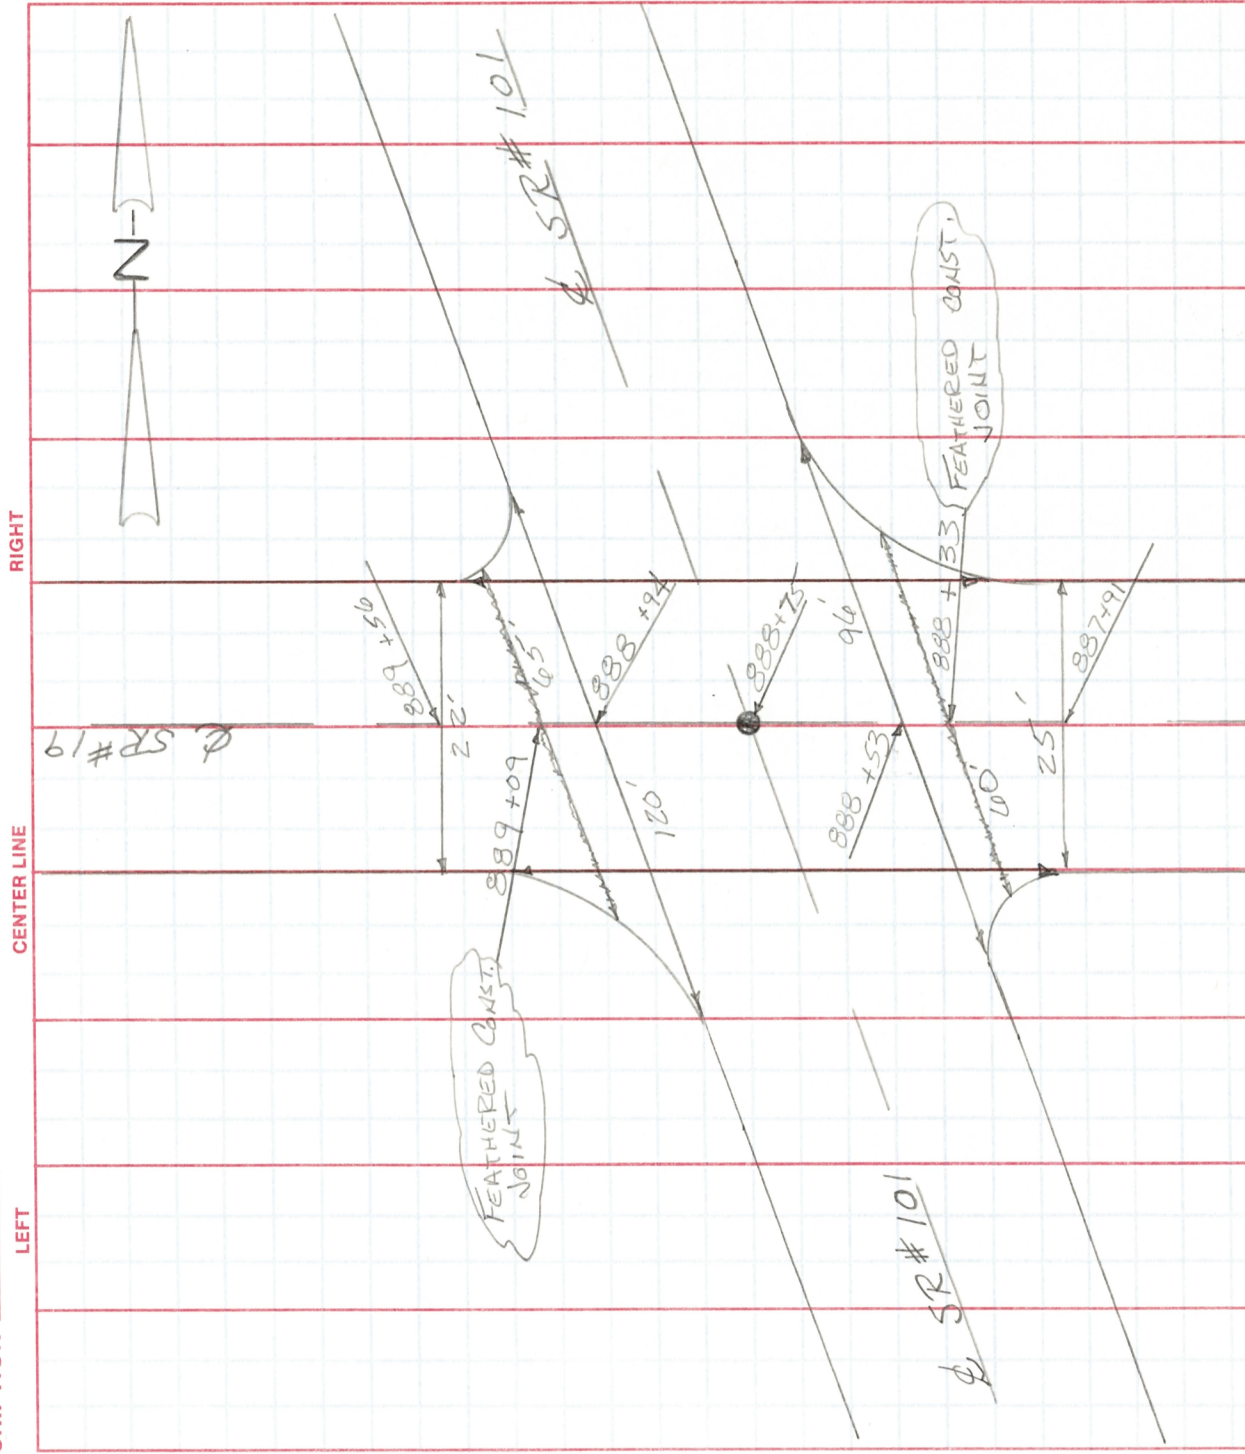

OHIO DEPARTMENT OF TRANSPORTATION

SHEET NO. 9 of 10
 COUNTY SENECA DATE 8-11-1994
 PERSONNEL CHENEY TITLE _____
RIPPLE TITLE _____
BARBOUR TITLE _____
GEYMAN TITLE _____
 S. R. # 19 WEATHER RAIN
 SEC. 15.19 TEMP. 70°
 DESCRIPTION RESURFACING JOB NO. PA 026112-74

