FOR ANY QUESTIONS PLEASE CONTACT ODOT DISTRICT 2 REAL ESTATE AT 419-353-8131

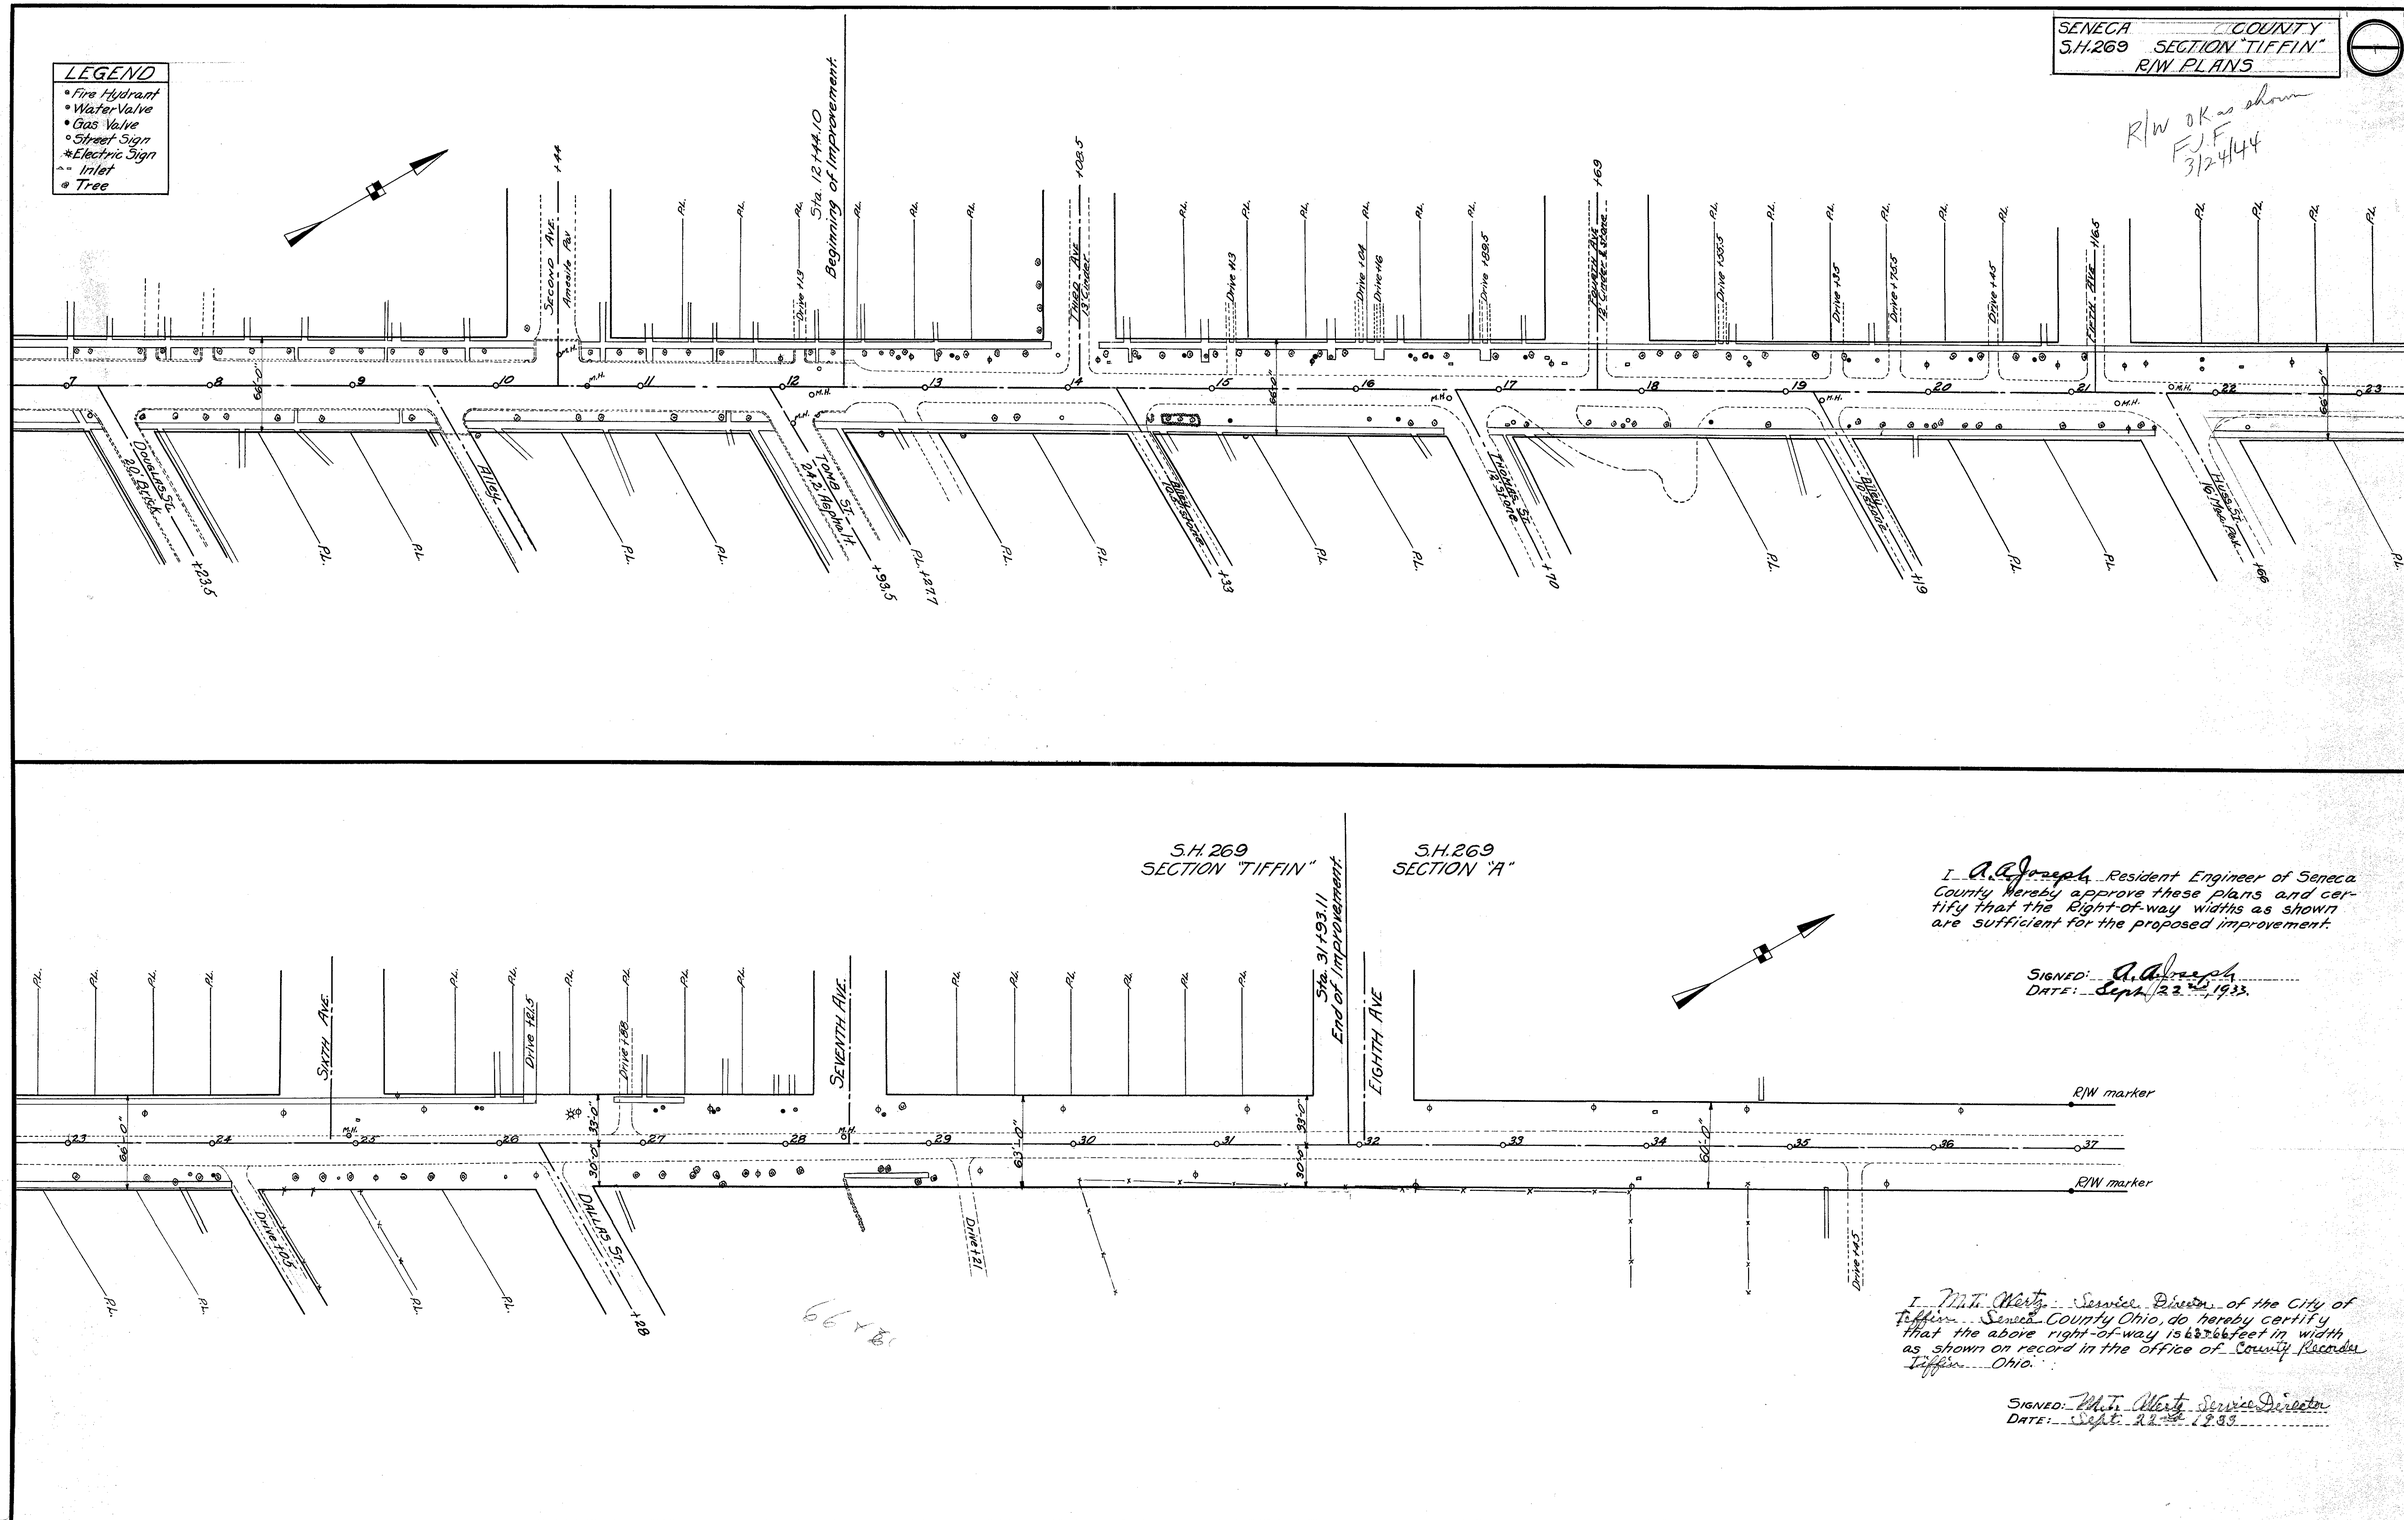

I A. A. Joseph Resident Engineer of Seneca County hereby approve these plans and certify that the Right-of-way widths as shown are sufficient for the proposed improvement.

SIGNED: A. A. Joseph
DATE: Sept. 22nd 1933.

I M. T. Wertz Service Director of the City of Tiffin Seneca County Ohio, do hereby certify that the above right-of-way is 63+66 feet in width as shown on record in the office of County Recorder Tiffin Ohio.

SIGNED: M. T. Wertz Service Director
DATE: Sept. 22nd 1933