

ODOT (D-2)

TO OPERATION 12-7-88

1990 TWO-LANE RESURFACING PROGRAM

PRIORITY NO. _____ PART _____ OF _____ SHEET _____ OF _____

COUNTY Seneca ROUTE USR 224 SECTION 6.19

326+83.20

BEGIN LOG (SLM) 6.19 TERMINII Str. No. SEN-224-0619=327+65 MEAS

561+79.20

END LOG (SLM) 10.64 TERMINII SR 18 (PREVIOUS SECTION)

TOTAL LENGTH 4.45 MILES

MUNICIPALITY _____ BEGIN LOG (SLM) _____ END LOG (SLM) _____

MUNICIPALITY _____ BEGIN LOG (SLM) _____ END LOG (SLM) _____

PROPOSED WORK:
PAVEMENT 1 1/2" 404 SHOULDER 1 1/2" 404, 617

OTHER _____

EXISTING DATA:

SLM <u>326+83.2</u> TO <u>556+67</u> ;	PAV'T	WIDTH <u>24'</u> (type _____),	SHLD	WIDTH <u>4'</u> (type <u>STR 43</u>)
SLM _____ TO _____ ;	PAV'T	WIDTH _____ (type _____),	SHLD	WIDTH _____ (type _____)
SLM _____ TO _____ ;	PAV'T	WIDTH _____ (type _____),	SHLD	WIDTH _____ (type _____)
STRUCTURES:

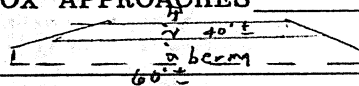
STR. NO. <u>6.19 - 326+83.20</u> ,	WIDTH <u>40'</u> ,	LENGTH <u>43'</u> ,	PROP. WORK _____
STR. NO. <u>6.75 - 356+38</u> ,	WIDTH <u>40'</u> ,	LENGTH <u>14'</u> ,	PROP. WORK _____
STR. NO. <u>7.78 - 410+79</u> ,	WIDTH <u>40.5'</u> ,	LENGTH <u>21'</u> ,	PROP. WORK _____
STR. NO. <u>9.48 - 500+82</u> ,	WIDTH <u>29'</u> ,	LENGTH <u>43'</u> ,	PROP. WORK _____
STR. NO. _____ ,	WIDTH _____ ,	LENGTH _____ ,	PROP. WORK _____
STR. NO. _____ ,	WIDTH _____ ,	LENGTH _____ ,	PROP. WORK _____

RAILROAD CROSSING:

NAME _____	STATION _____	NO. TRACKS _____	LENGTH ALONG C L _____ ft	(no work)
NAME _____	STATION _____	NO. TRACKS _____	LENGTH ALONG C L _____ ft	
NAME _____	STATION _____	NO. TRACKS _____	LENGTH ALONG C L _____ ft	

MISCELLANEOUS:

NO. RAISED PAVEMENT MARKERS; EDGE OF PAVEMENT 91 , CENTERLINE 349
NO. MAILBOX APPROACHES _____ , MAILBOX SUPPORTS _____

REMARKS:  Most M.B.A.s.

1990 TWO-LANE RESURFACING PROGRAM

SHEET 1 OF

APPROACHES (INTERSECTIONS & DRIVES)

COUNTY SENECA

ROUTE U.S. # 224

SECTION 6.19 - 10.64

L = Prop Pav't Depth (in.) x 10; W = Width @ Mouth; W-1 = Width @ Throat

INTERSECTIONS								DRIVES				
STATION	SIDE	L	W	W-1	ASPH	CONC	NAME / NO.	STATION	SIDE	W	ASPH	CONC
379+82	RT	15	97	58	✓		Co. Rd	330+84	LT	38	✓	APRON
379+82	LT	15	92	49	✓		# 7	331+02	RT	6x60	✓	MBA
427+04	LT	15	96	46	✓		Twp Rd #109	344+51	RT	6x50	✓	MBA
433+84	RT	25	90	30	✓		Twp Rd #109	346+10	RT	37	✓	APRON
488+12	RT	29	93	27	✓	Butt Twp Rd	Twp Rd	373+51	LT	37	✓	APRON
488+12	LT	40	98	22	✓	Butt Twp Rd	# 113	374+77	RT	6x60	✓	MBA
541+72	RT	15	107	52	✓		Co. Rd #591	382+29	LT	33	✓	APRON
								382+32	RT	5x60	✓	MBA
								395+48	RT	6x60	✓	MBA
								397+70	RT	42	✓	APRON
								413+29	RT	6x60	✓	MBA
								413+40	LT	33	✓	APRON
								426+17	RT	6x70	✓	MBA
								426+94	RT	42	✓	APRON
								438+49	RT	6x60	✓	MBA
								439+68	LT	51	✓	DRIVE
								465+96	RT	44	✓	APRON
								466+91	RT	43	✓	DRIVE
								468+61	RT	34	✓	DRIVE
								473+57	RT	23	DRIVE	✓
								486+76	RT	6x60	✓	MBA
								496+49	LT	35	✓	APRON
								531+35	RT	36	✓	APRON
								533+68	RT	38	✓	DRIVE
								542+28	LT	53	✓	DRIVE
								543+10	RT	47	✓	"
								543+58	RT	47	✓	"
								543+95	LT	61	✓	"
								545+67	RT	24	✓	APRON
								545+95	LT	47	✓	DRIVE
								546+49	RT	33	✓	"
								547+15	RT	22	✓	"
								547+65	LT	22	✓	APRON
								548+09	RT	29	✓	DRIVE
								548+79	LT	37	✓	APRON
								548+97	MBA	8' DEEP	✓	APRON
								549+05	RT	31	✓	DRIVE
								550+13	LT	25	✓	DRIVE
								550+29	MBA	8' DEEP	✓	
								550+42	LT	35	✓	DRIVE
								550+59	RT	27	✓	"

APPROACHES (INTERSECTIONS & DRIVES)

COUNTY SENeca

ROUTE U.S. 22 ✓

SECTION 6.19 - 10 64

L = Prop Pav't Depth (in.) x 10; W = Width @ Mouth; W-1 = Width @ Throat

[illegible]

PERSONNEL

TITLE

PERSONNEL

TITLE

COUNTY SENECA

DATE

12/06/88S. R. U.S. #224WEATHER SUNNYSEC. 6.19 - 10.64TEMP. 35° - 49°DESCRIPTION 1990 - RESURFACING

JOB NO.

LEFT

CENTER LINE

RIGHT

