

1095 1996-8
 TWO-LANE RESURFACING PROGRAM
 PERSONNEL CHENEY
R. PRE
BACBOOR
GERMAN
 Notes to: B. Ross 10-14-98

PRIORITY NO. 10 PART 2 OF 4 SHEET 1 OF 6
 COUNTY Seneca ROUTE SR 228 SECTION 0.00
 BEGIN LOG (SLM) 0.00 TERMINII SR 107
 END LOG (SLM) 1.20 TERMINII SR 101 68+16
 TOTAL LENGTH 1.20 MILES
 MUNICIPALITY _____ BEGIN LOG (SLM) _____ END LOG (SLM) _____
 MUNICIPALITY _____ BEGIN LOG (SLM) _____ END LOG (SLM) _____

PROPOSED WORK: Resurface existing pavement & shoulder
 PAVEMENT 1 1/2" 404 SHOULDER 1 1/2" 404, 617
 OTHER Repair bad pavement areas

STATION ESTABLISHED FROM: 0+00 @ REF. POINT @ INTERSECTION SR # 228
SR # 19 & C.R. # 32

STRUCTURES:

NUMBER	STATION	WIDTH	LENGTH	PROPOSED WORK
<u>SR 228</u>				
<u>0104</u>	<u>54+95</u>	<u>21.7'</u>	<u>49'</u>	

RAILROAD CROSSING: N/A (NO WORK)
 NAME _____ STATION _____ NO. TRACKS _____ LENGTH ALONG C L _____ FT
 STATION _____ NO. TRACKS _____ LENGTH ALONG C L _____ FT

[illegible]

COUNTY SENECA ROUTE 228 SECTION 0.00

[illegible]

State of Ohio Department of Transportation
Field Notes

LD-5
5-92

SHEET NO. 5-6

COUNTY SENECA DATE 8-11-1994

TITLE

PERSONNEL

TITLE

PERSONNEL

S.R. # 19 & SR#228 WEATHER RAIN

TITLE

PERSONNEL

CHENEY
RIPPLE
BARBOUR
GEYMAN

SEC. 15.19 0.00 TEMP. 70°


TITLE

PERSONNEL

CHENEY
RIPPLE
BARBOUR
GEYMAN

PA 026112-74
JOB NO.

DESCRIPTION RESURFACING

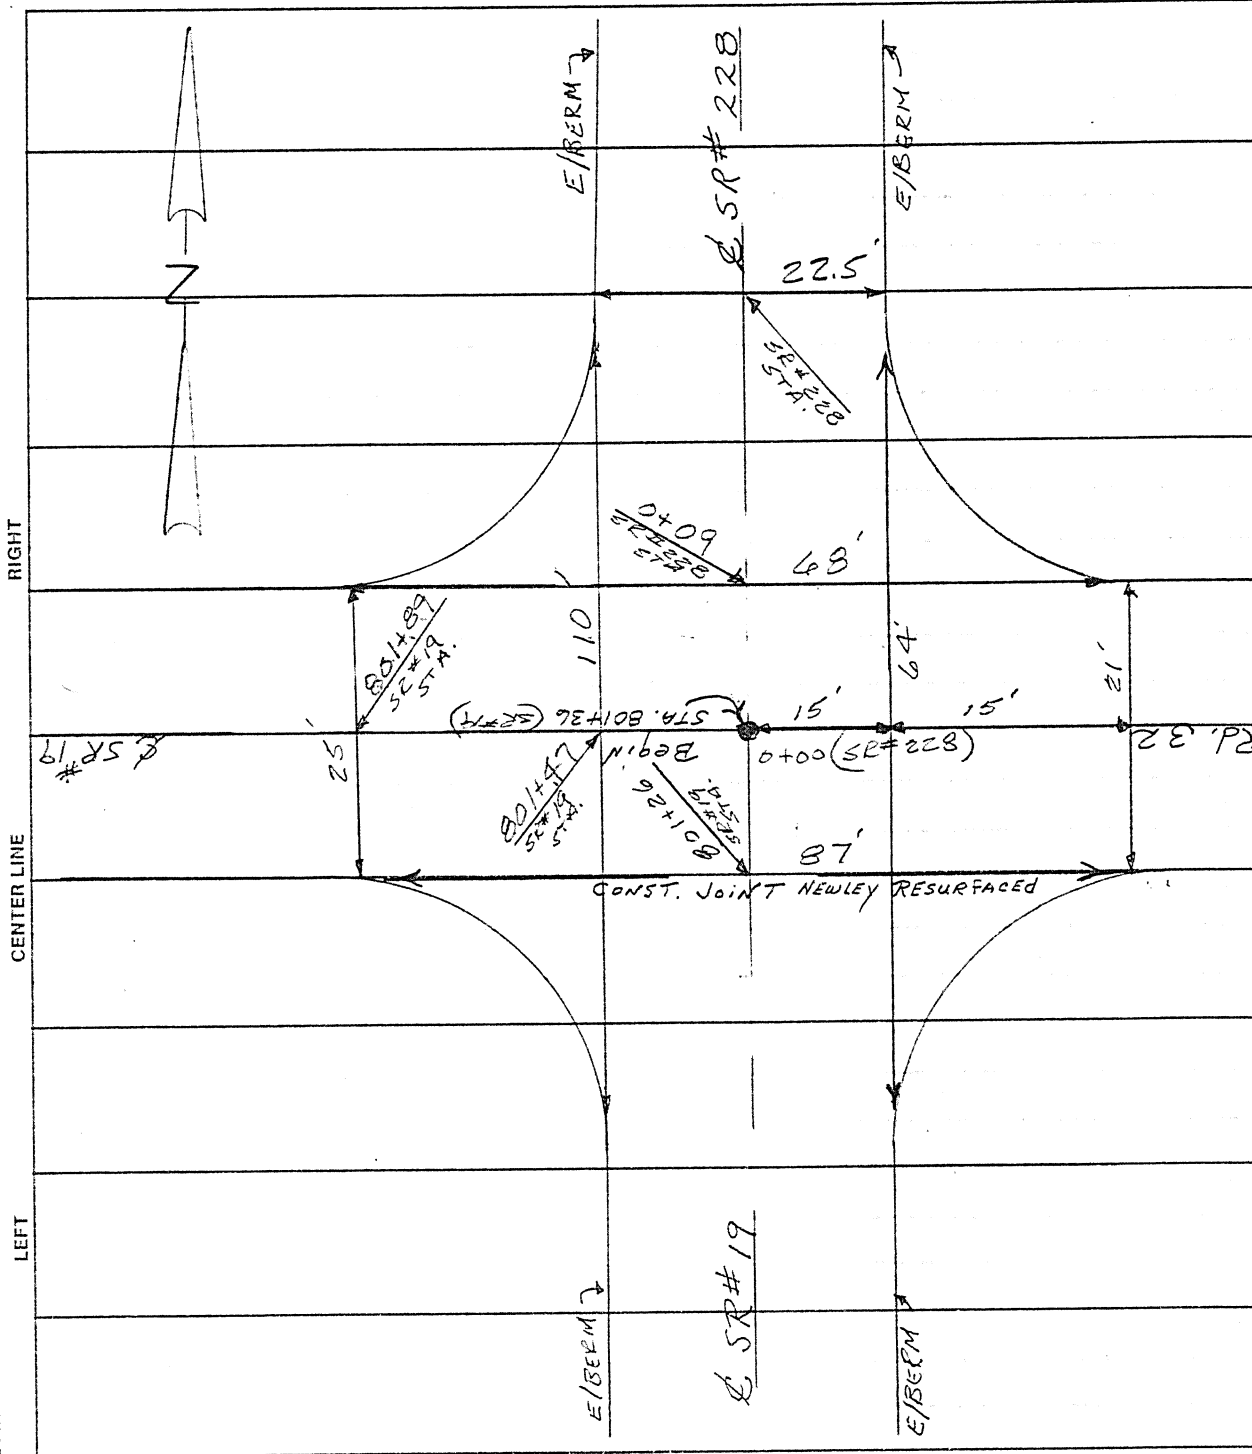


RIGHT

