O.D.O.T. DISTRICT 2 SURVEY OFFICE (USE ONLY)

PERSONNEL

REFERENCE NO. 0


NOTES BARRIERE
H.C. MILLER
R.C. JENDRUCH

DATE 9/30/25
WEATHER BREEZY
TEMP. 75°

ROUTE SR 590
COUNTY SENECA
TOWNSHIP LIBERTY
SECTION 3
T 3 N R 14 E

DWG BY BARRIERE
PID 101280

TYPE MONUMENT MAG NAIL/WASHER
ON SURFACE - BELOW ON
OFFSET ℄ PAVEMENT 1' RT

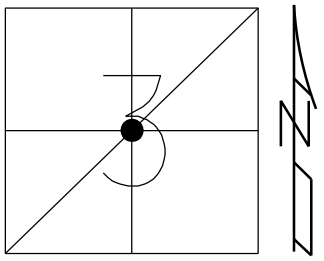

STATION: 0+00

HORZ.DATUM: NAD83 (2011)
GEOID: 18

GRID: NORTHING:
EASTING:

LDP: NORTHING: 345140.655
EASTING: 140968.267

RECORD:
SET MAG/WASHER,
07-17-03, DCH
FD PK/WASHER
GPS, REF61
2/5/13
5-4-15, DBW
SET MAG/WASHER
GPS, NEWREF61
9-27-16, JLL
FD MAG/WASHER
REF61
6/12/23, JAM
FD MAG / WASHER
REF0
12-29-23, TDN
5/15/25, JAM
SET MAG/WASHER
NEWREF61
9/30/25, JAM

*A.K.A REF61 SEN SR12

