O.D.O.T. DISTRICT 2 SURVEY OFFICE (USE ONLY)

PERSONNEL

REFERENCE NO. 7

SHEET 7 OF 8

NOTES JENDRUCH
H.C. NIESE
R.C. JENDRUCH


DATE 11/1/26
WEATHER CLOUDY
TEMP. 58°

ROUTE SR 590
COUNTY SENECA
TOWNSHIP LIBERTY
SECTION 3

DWG BY JENDRUCH
PID 95772

T 3 N R 14 E

TYPE MONUMENT MAG / WASHER
ON SURFACE - ~~BELOW~~ ON
OFFSET ℄ PAVEMENT 2.5' LT : ~~RT~~
- TO - EDGE PAVEMENT
STATION: 25+34.4

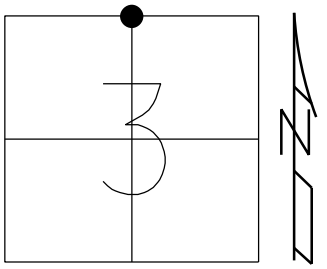

HORZ.DATUM: NAD83 (2011)
GEOID: GEOID 18
GRID: NORTHING: 578778.081
EASTING: 1766185.606
LDP: NORTHING: 347390.845
EASTING: 140446.906

RECORD:
FD P.K.NAIL
4/1/68
7/28/71, BARBOUR
FD P.K.SHANK
0.34' DOWN
5/5/82, CL
FD P.K.NAIL
10/15/99, MB
FD MAG / WASHER
REF7
12/29/23, TDN
FD MAG/WASHER
REF7
4/13/26, TDN
SET MAG/WASHER
REF7
11/1/26, TDN

DIST. REF6 - REF7 =11.76'

