LD-5—(25M—2-59)

SHEET NO. 8

PERSONNEL	TITLE	PERSONNEL	TITLE
Red Beach			
Newcomb			
Knope			
Wise			

COUNTY Williams DATE Dec '68

S. R. 107 WEATHER

SEC. 8.96 – 11.05 TEMP.

DESCRIPTION ALIGNMENT JOB NO. 02734

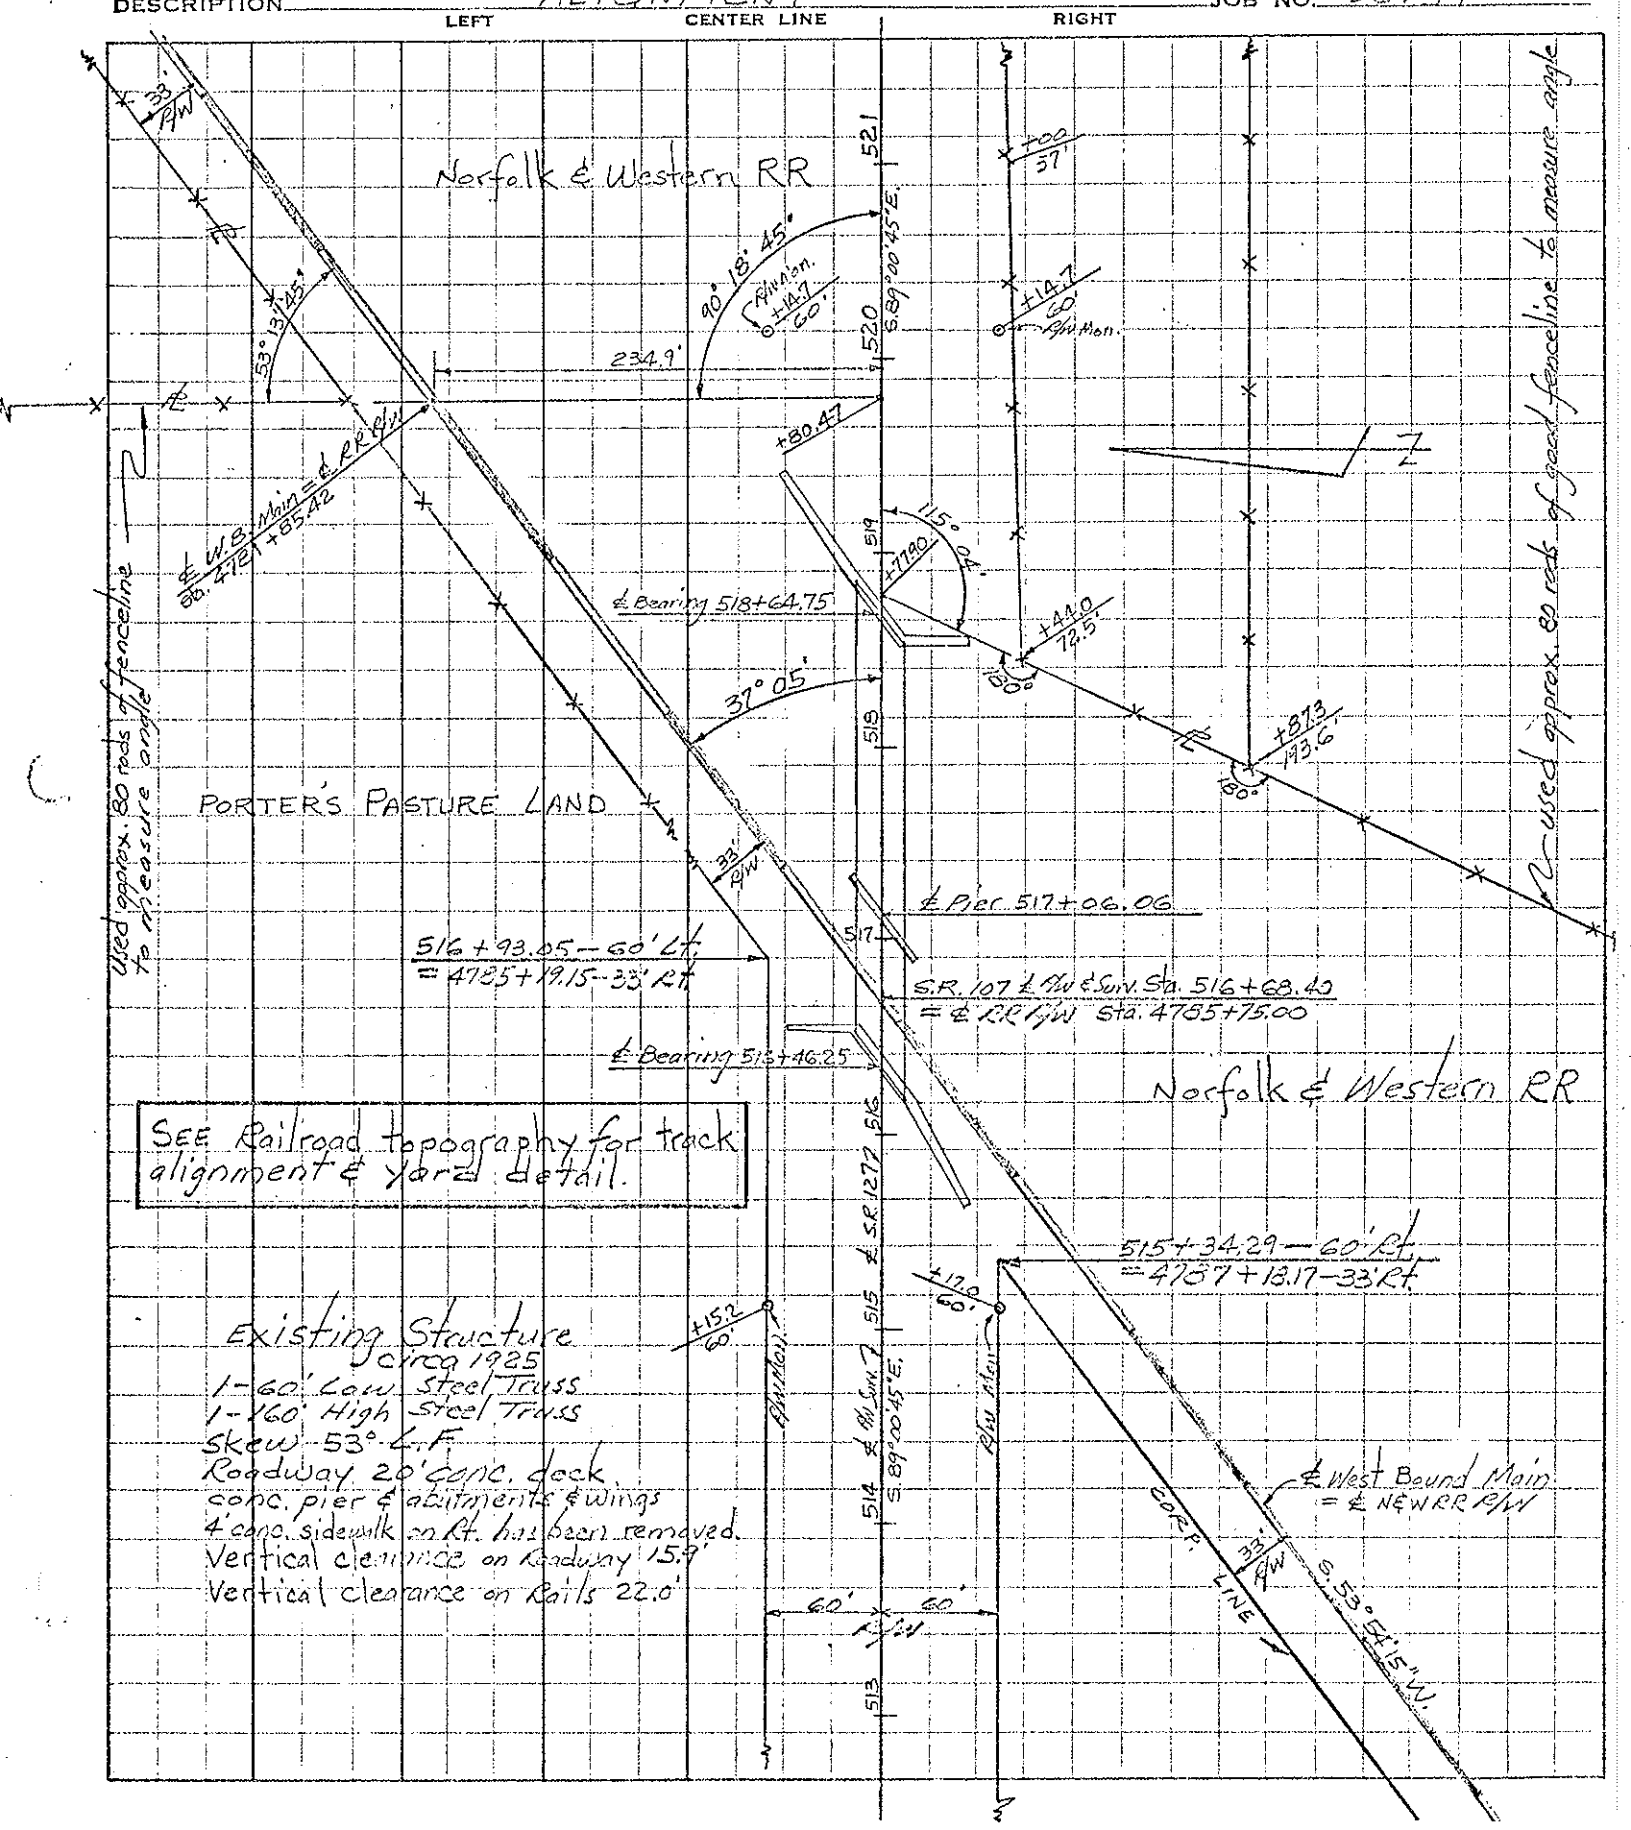

Existing Structure
circa 1925
1-60' Conv. Steel Truss
1-160' High Steel Truss
Skew 53° L.F.
Roadway 20' conc. deck
conc. pier & abutments & wings
4' conc. sidewalk on Rt. has been removed.
Vertical clearance on Roadway 15.9'
Vertical clearance on Rails 22.0'