O.D.O.T. DISTRICT 2 SURVEY OFFICE (USE ONLY)

PERSONNEL

NOTES CANTERBURY
H.C. BARNHISEL
R.C. MALINSKI
MACHALAK

REFERENCE NO. 18
DATE 6/4/02
WEATHER CLOUDY
TEMP. 68°

SHEET 13 OF 56
ROUTE US 127
COUNTY WILLIAMS
TOWNSHIP PULASKI
SECTION 10
T 6 N R 3 E

TYPE MONUMENT 3/4" IPIPE
~~ON SURFACE~~ - BELOW 3"
~~LEFT~~ - ℄ PAV'T - RIGHT -
22.6' RT TO RT EDGE PAVEMENT
S.L.M. 345+30
Grid: Northing: - Easting: -

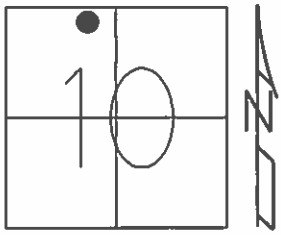
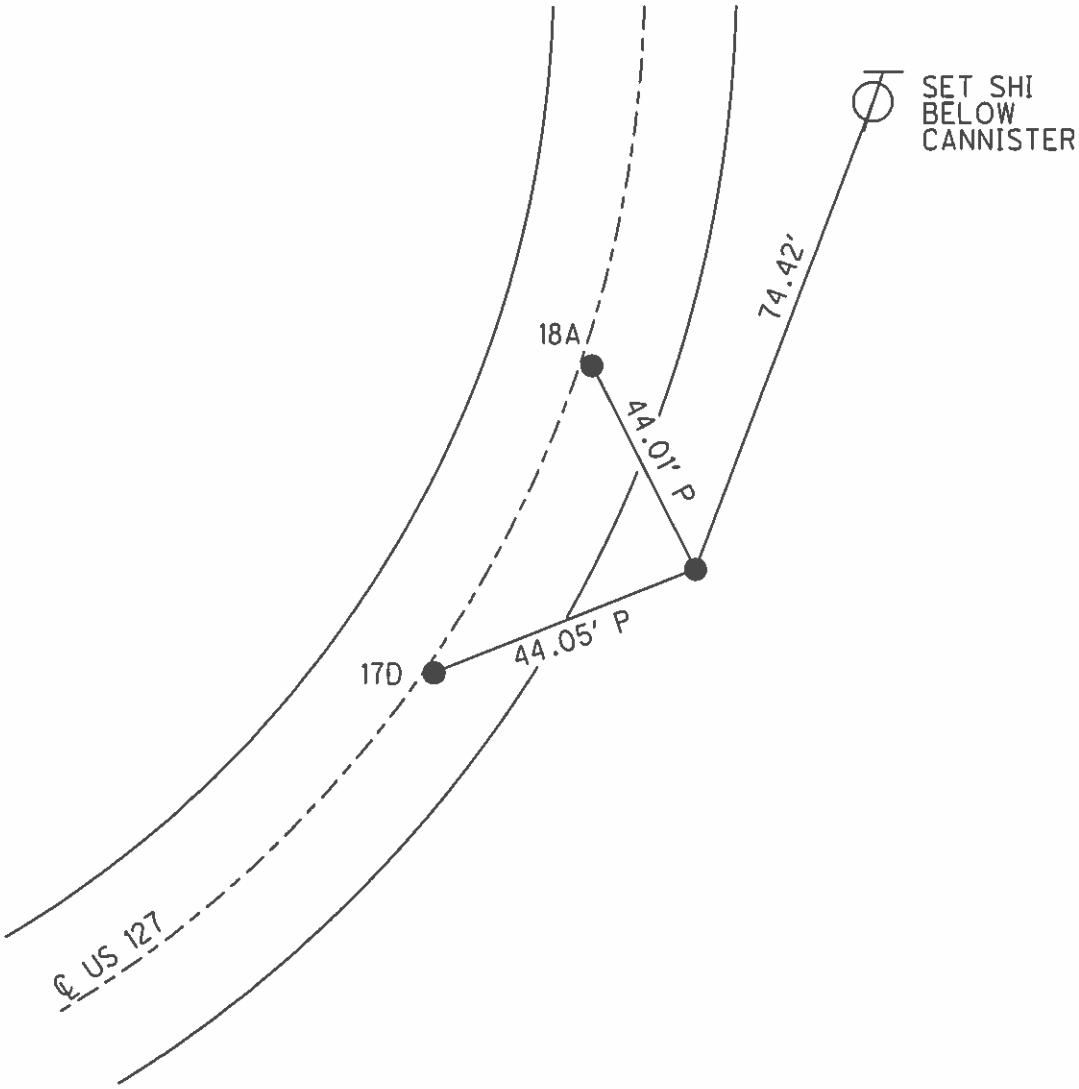
RECORD: P.I.