DANSARD • GROHNKE • LONG Limited
110 Arco Drive Toledo, Ohio 43607

SHEET NO. 1 OF 1 SHEETS

DESIGN BY KEO, JEW, JTN DATE 12/7/88 CHECKED BY _____ DATE _____

SUBJECT WIL 191- 1.43 ~ Alignment & & Witnesses

REFERENCE _____ NOTE FILE NO _____ COMM. NO 8838

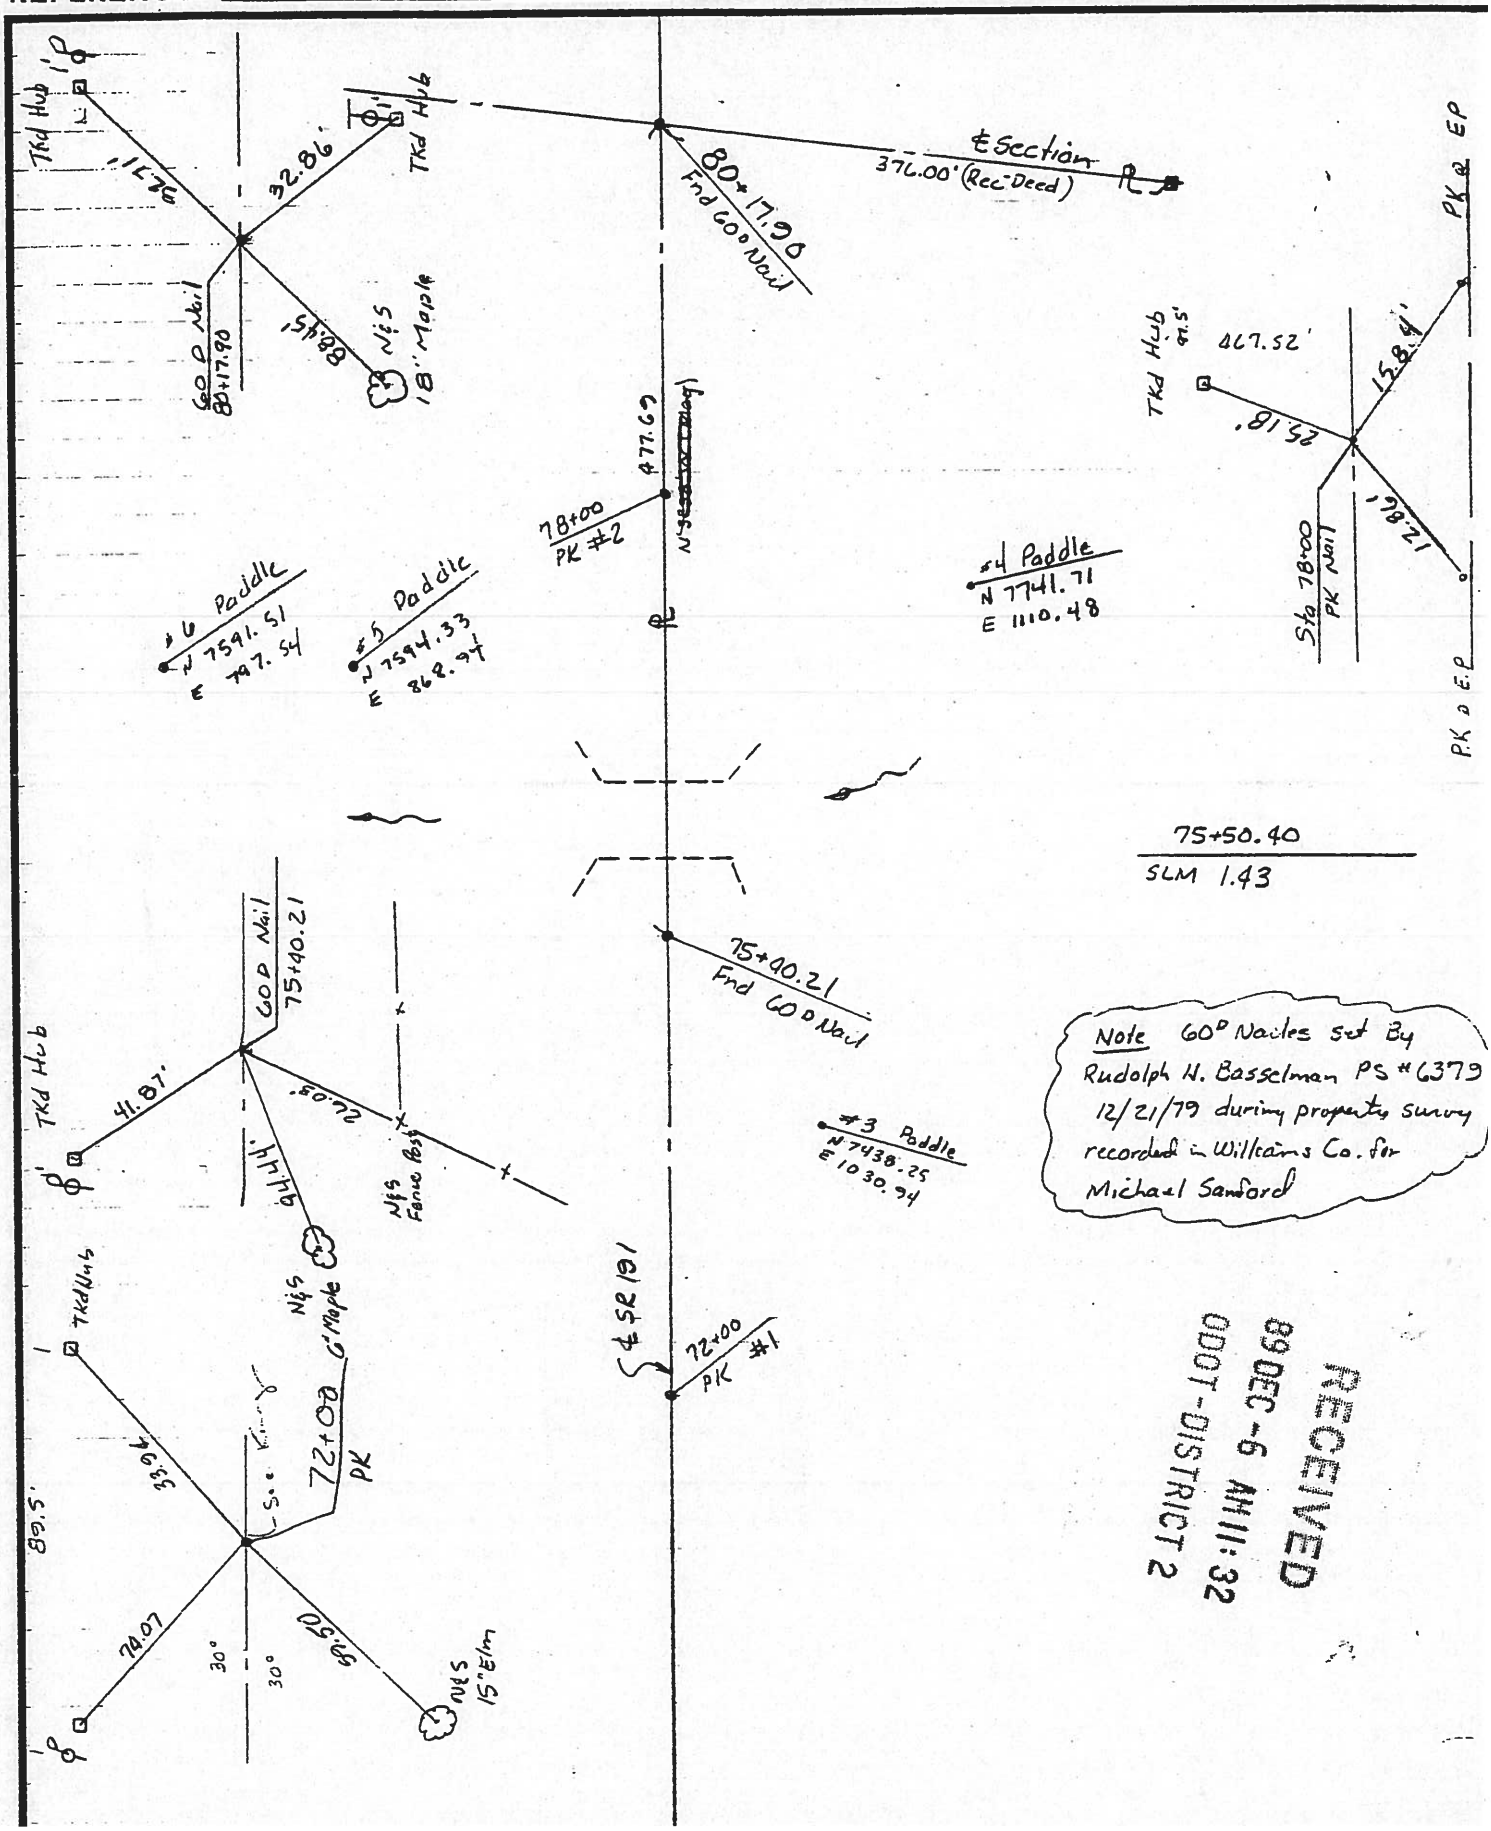

RECEIVED
88 DEC -6 AM 11:32
ODOT-DISTRICT 2