

ODOT (D-2)

1998 TWO-LANE RESURFACING PROGRAM

DATE 5-6-97

PERSONNEL VAN DOSSER

HUSS

MOSE

PRIORITY NO. 3 PART 3 OF 3 SHEET 1 OF 7

COUNTY WILLIAMS ROUTE 45.20-A SECTION 0.000

BEGIN LOG (SLM) 0.000 TERMINI

END LOG (SLM) 1.11 TERMINI CONST. JOINT @ 5.8.15

TOTAL LENGTH 1.11 MILES

MUNICIPALITY BEGIN LOG (SLM) END LOG (SLM)

MUNICIPALITY BEGIN LOG (SLM) END LOG (SLM)

PROPOSED WORK:

PAVEMENT SHOULDER

OTHER

STATION ESTABLISHED FROM: STA. NO 0.22

STRUCTURES:

NUMBER	STATION	WIDTH	LENGTH	PROPOSED WORK
WIL-30A-0022	0 + 353.39	13.41 m	56.18 m	

RAILROAD CROSSING:

(NO WORK)

NAME N/A STATION NO. TRACKS LENGTH ALONG C L FT

194SWH

OHIO DEPARTMENT OF TRANSPORTATION

SHEET NO. 2 OF 7


PERSONNEL	TITLE	PERSONNEL	TITLE	COUNTY	DATE	WEATHER	TEMP.
VAUGHAN				WILLIAMS	5-6-97		
MOSE				S.R. U.S. 20-A			
HUSS				SEC. 0.000			

DESCRIPTION INT. OF US 20 & US 20-A JOB NO. _____

LEFT

CENTER LINE

RIGHT

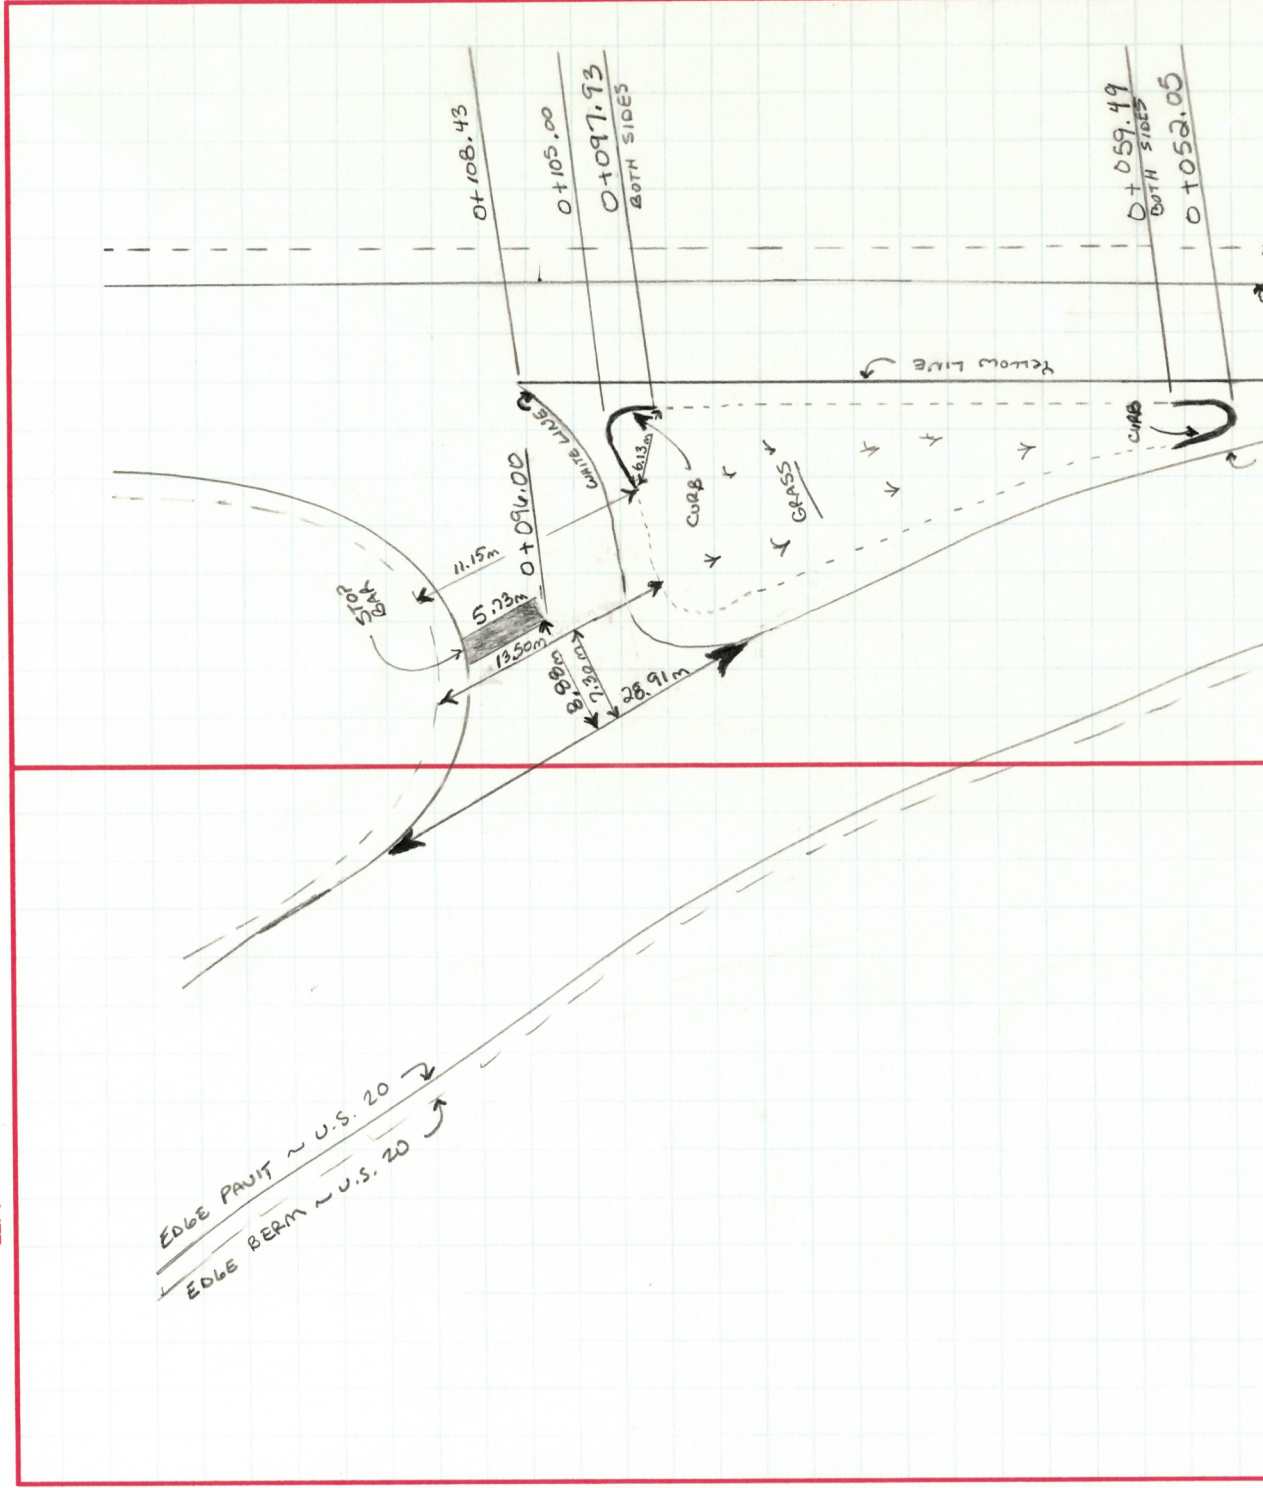

NOTE: LOCATE ALL
CHANGES IN PVMT WIDTH

COUNTY Williams ROUTE 20 A SECTION 0.00

[illegible]

DATE 05 - 06 - 97

SHEET 4 OF 7

COUNTY	ROUTE	SECTION	0.00
Williams	20 A.		

[illegible]

05-06-97

SHEET 5 OF 7

0.00

L = PROP PAWT DEPTH (IN) X IQ; W = WIDTH @ MOUTH; W-I = WIDTH @ THROAT

[illegible]

DATE 05-06-97

SHEET 6 OF 7

COUNTY Williams ROUTE 20A SECTION 0.00

[illegible]

**TWO-LANE RESURFACING PROGRAM
CROSSWALKS AND STOP BARS**

SHEET 7 OF 7

COUNTY Williams ROUTE 20-A SECTION 0.00

[illegible]

SHEET NO. 1071

COUNTY

S.F. U.S. 20-A

520

SEC. 0.000

PAVEMENT X-SECTIONS

JOB NO.

STA.	BS	HI	FS	ELEV.
0+150	1.12 4.57	1.09 4.02	0.99 0	1.09 4.02 1.15 4.29
1+000	1.12 4.57	1.06 3.72	0.99 0	1.09 3.72 1.17 4.75
1+700	1.12 4.39	1.05 3.72	0.96 0	1.04 3.72 1.11 4.23
				EDGE BERM WHITE LINE PAVEMENT

DATE 09-17-97

**TWO-LANE RESURFACING PROGRAM
GUARDRAIL LOCATIONS**

PERSONNEL

1050

55

WEATHER Cloudy - Rain - +72°F 024530 1 OF 2

COUNTY W.J., 11, 10, 15 ROUTE 26^A SECTION 0.000

[illegible]

**TWO-LANE RESURFACING PROGRAM
MAILBOX LOCATIONS**

STATION	LT	RT	STANDARD POST #4# (OR LESS) WOOD 2 1/2" DIA (OR LESS) STEEL	NON-STANDARD POST ANY OTHER TYPE GIVE DESCRIPTION	STONE OR DIRT	ASPHALT GIVE SKETCH WITH DIMENSIONS
0 + 214	X		X		Stone	
1 + 210	X		X		Stone	Paper Box
1 + 211	X		X		Stone	
1 + 265	X		X		Stone	Paper Box
1 + 510	X		X		Stone	Paper Box
1 + 511	X		X		Stone	

[illegible]