FOR ANY QUESTIONS PLEASE CONTACT ODOT DISTRICT 2 REAL ESTATE AT 419-353-8131

SR-576

WILLIAMS COUNTY

S.H. 581 Sec. Montpelier (P.) & E.A. (P.) 1/1

R/W PLANS

DATE - 8/15/41 Drawn by T.K.

REVISED 8/28/41 9/26/41

LENGTH OF PROJECT

R/W OK as shown FJF 3/29/44

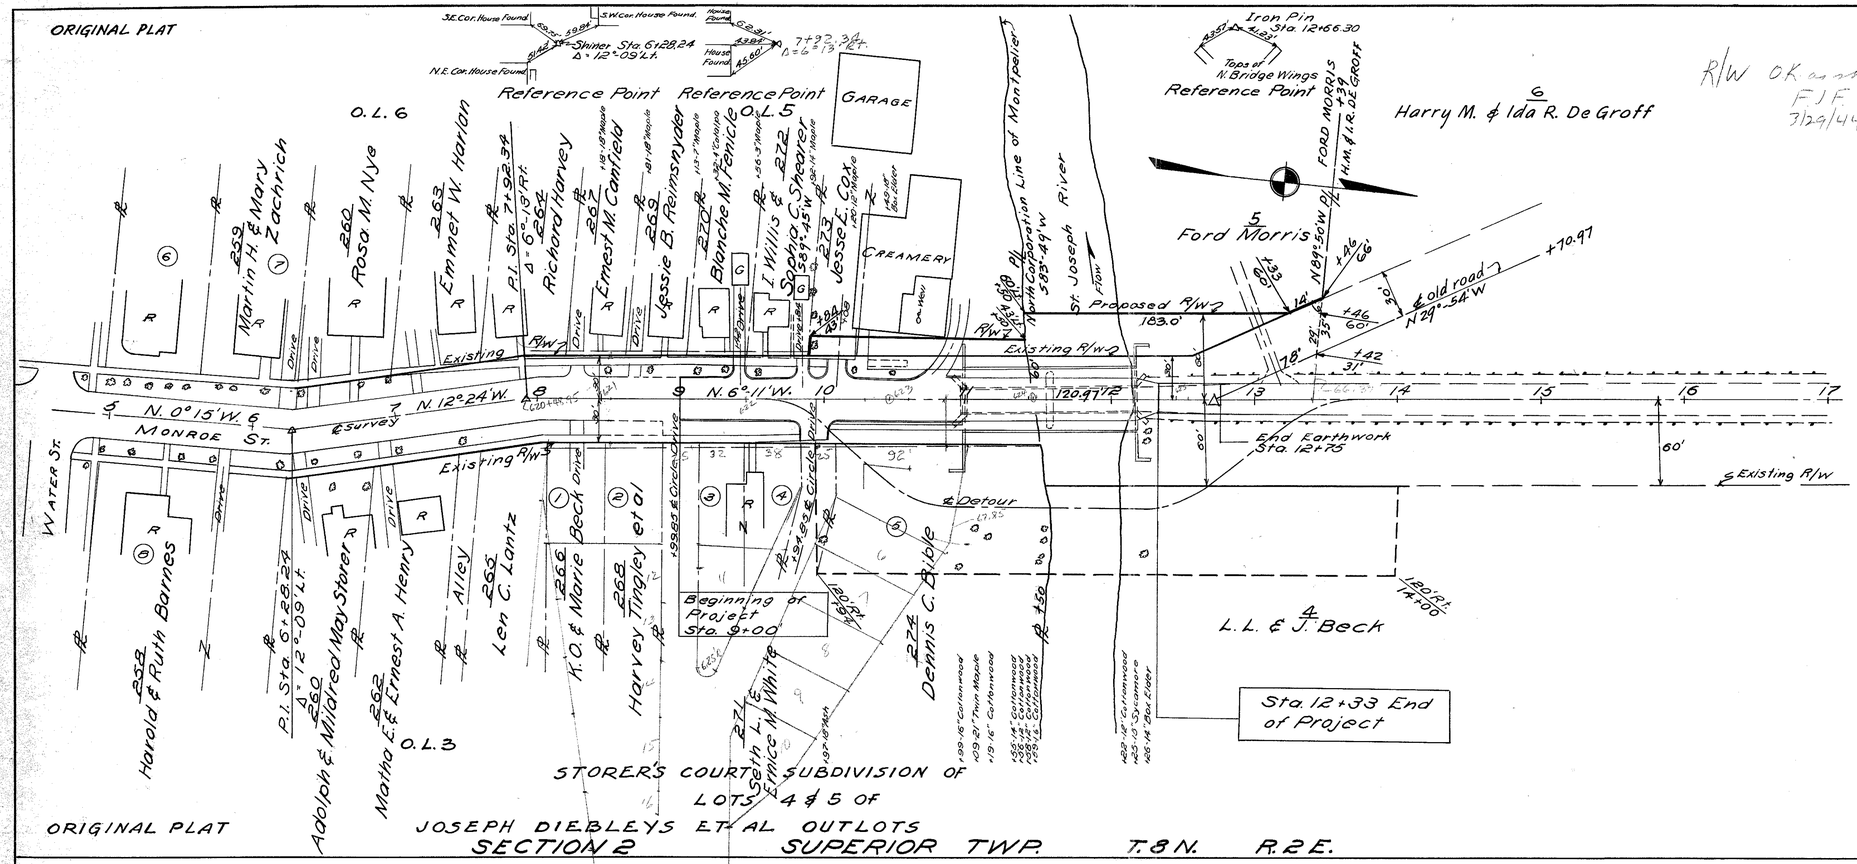

H-28