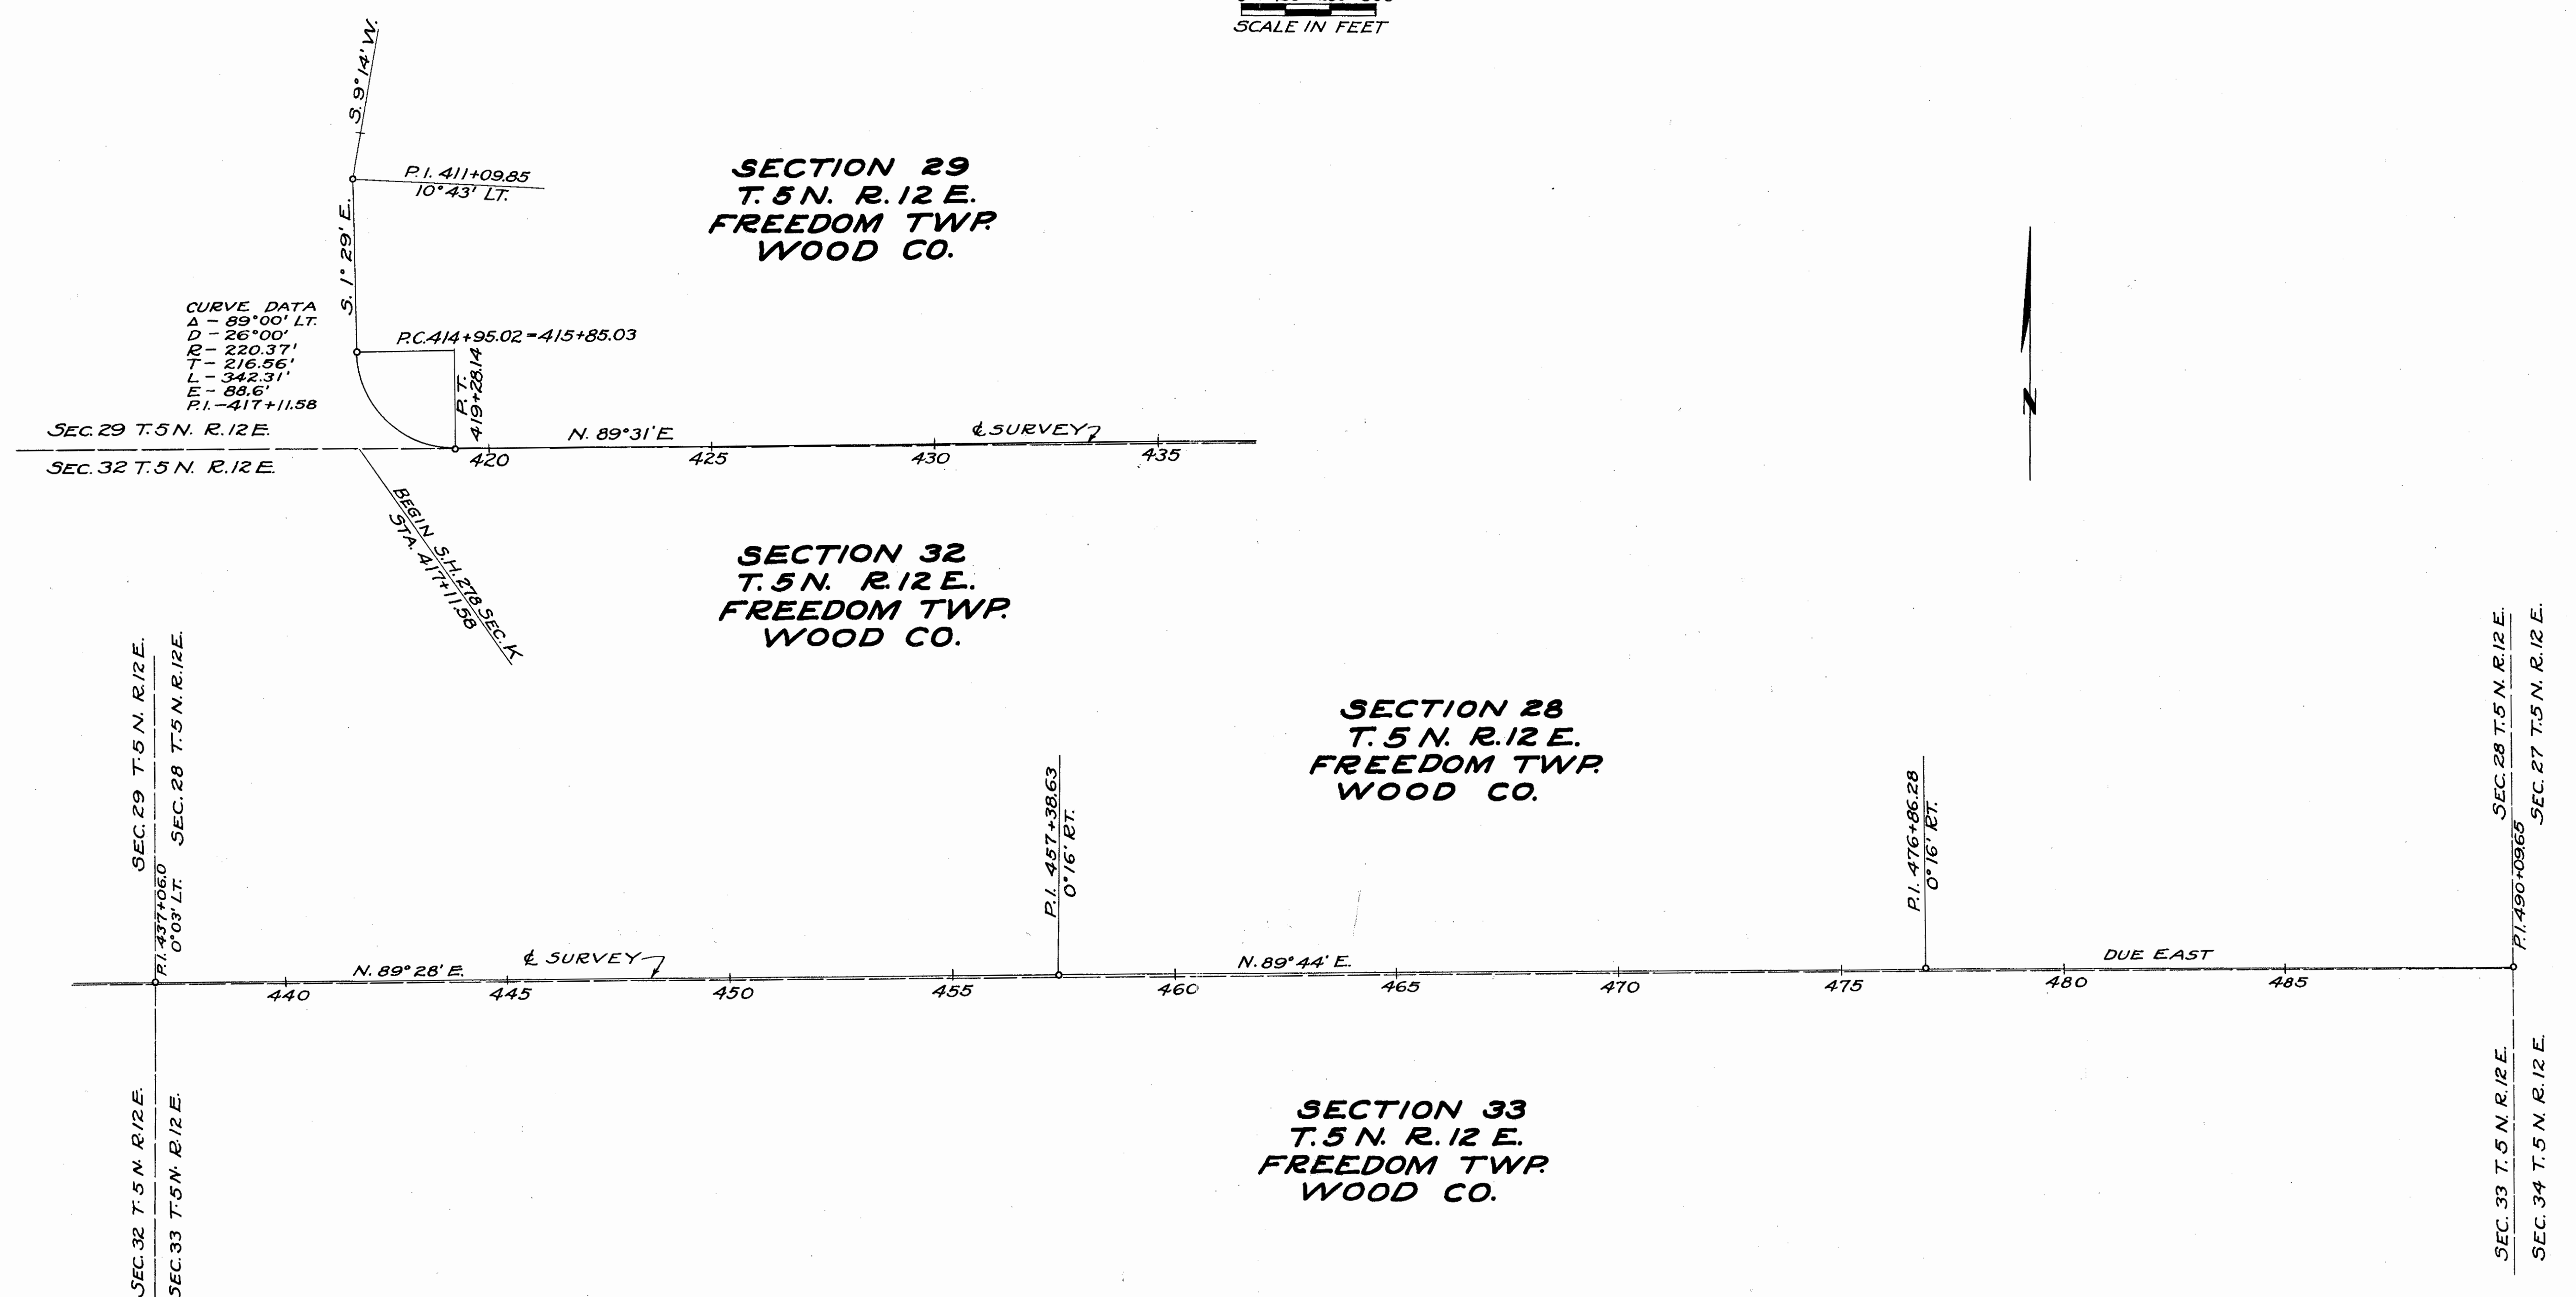
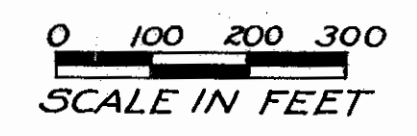


# LOCATION PLAN S. H. 278, SEC. K (PT.) FREMONT-BOWLING GREEN ROAD 1947



CENTER LINE REFERENCE MONUMENTS WILL BE SET BEFORE OR AFTER CONSTRUCTION




Survey July 1977

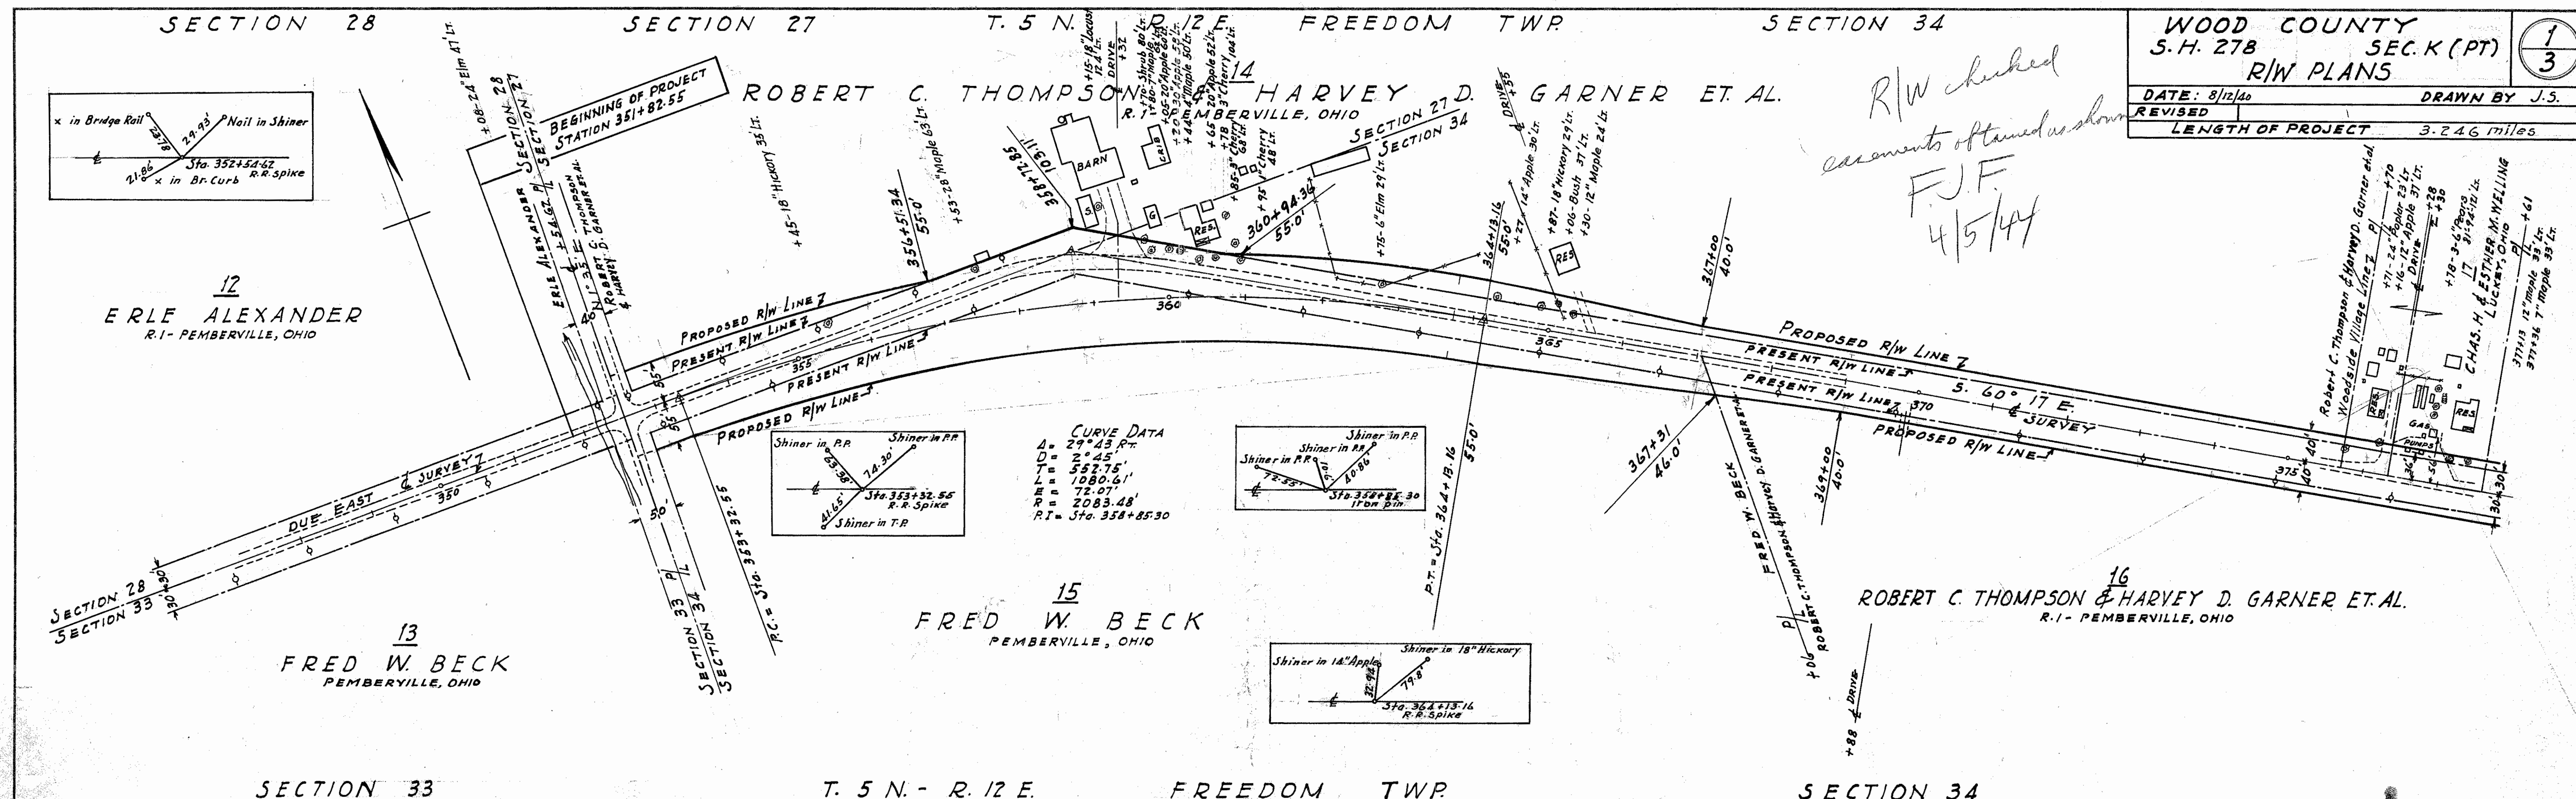
WOOD COUNTY  
S.H. 278 SEC. K (PT)  
R/W PLANS

DATE: 8/12/40  
REVISIONS: \_\_\_\_\_  
LENGTH OF PROJECT: 3.246 miles

DRAWN BY: J.S.


1/3

*R/W checked  
easements obtained as shown  
F.J.F.  
4/5/44*



CURVE DATA  
 $\Delta = 29^{\circ} 43' 17''$   
 $D = 2^{\circ} 45'$   
 $T = 552.75'$   
 $L = 1080.61'$   
 $R.I. = Sta. 358+85.30$

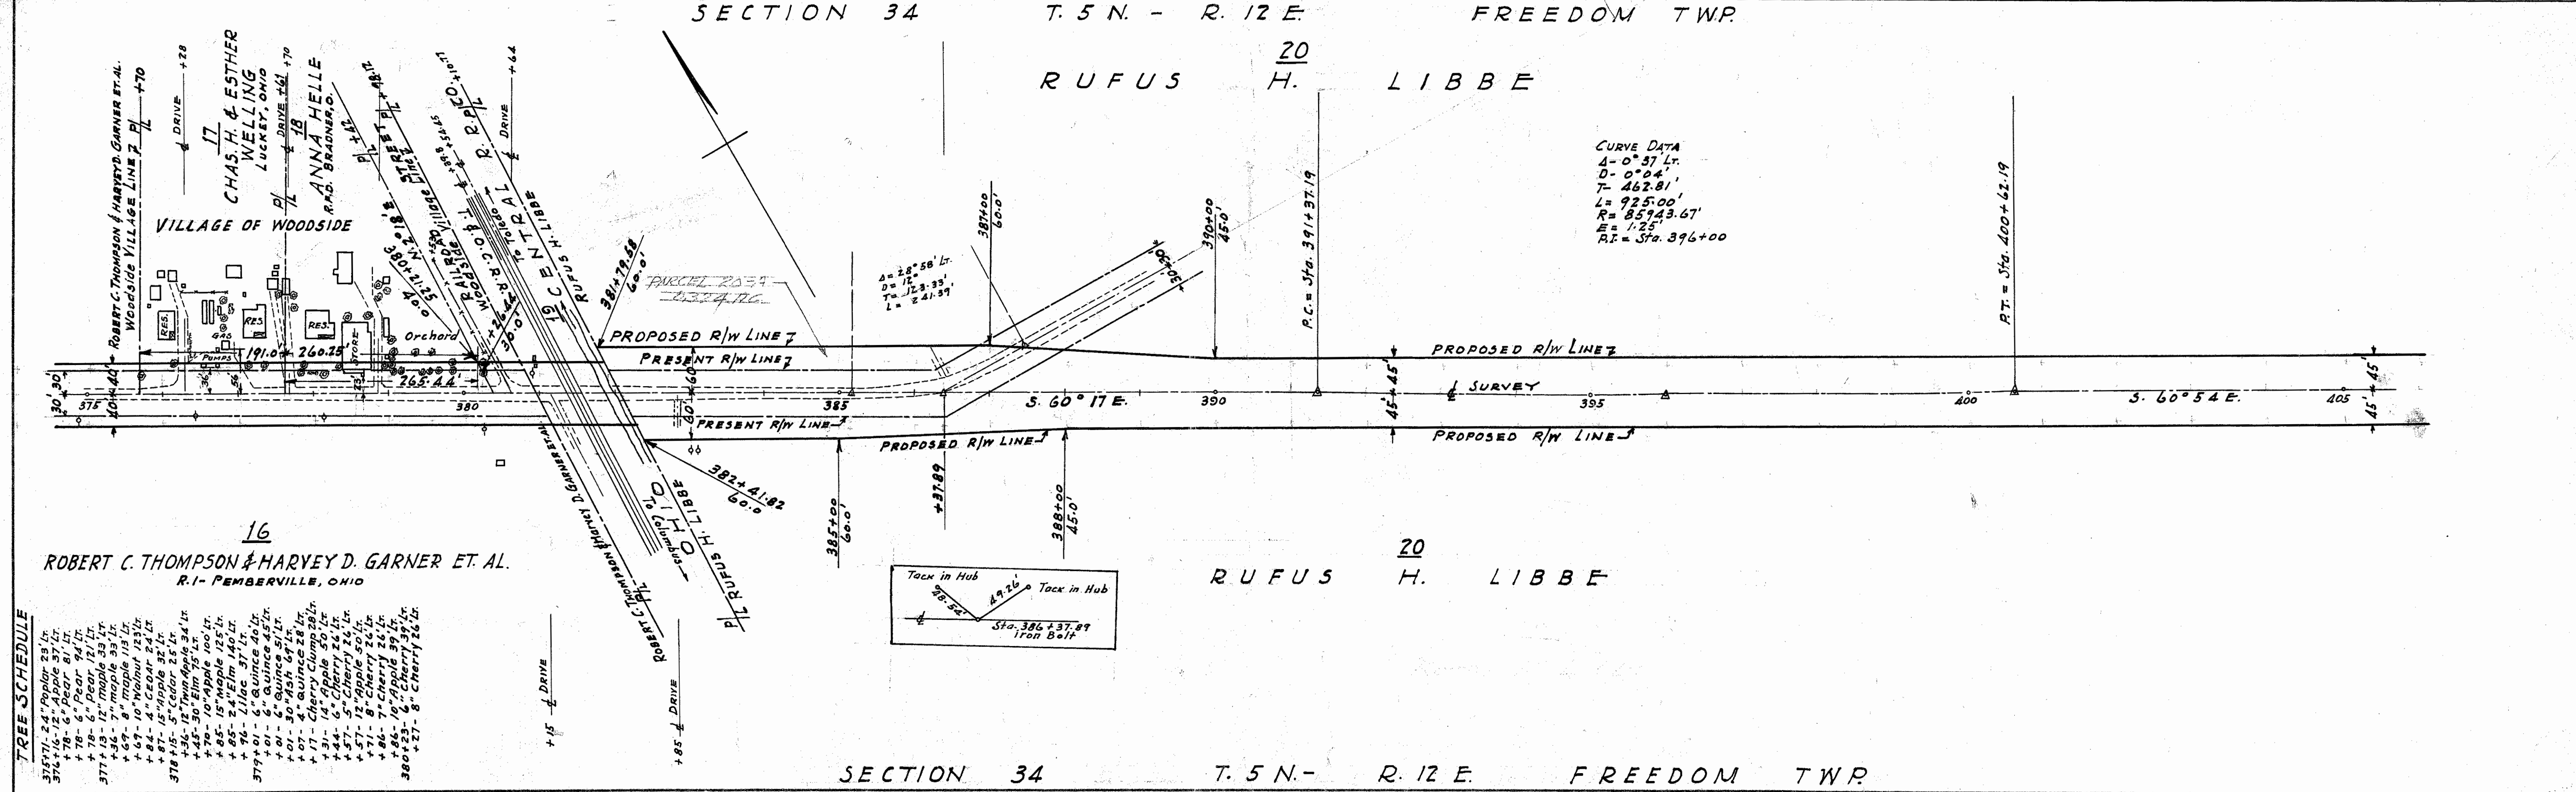CURVE DATA  
 $D = 0^{\circ} 04'$   
 $T = 462.81'$   
 $L = 925.00'$   
 $E = 1.25'$   
 $R.I. = Sta. 396+00$



Tack in Hub  
 $R.I. = Sta. 386+37.89$   
 Iron Bolt

16  
ROBERT C. THOMPSON & HARVEY D. GARNER ET AL.  
R.I. - PEMBERVILLE, OHIO

17  
CHAS. H. & ESTHER WELING  
LUCKEY, OHIO

18  
ANNA HELLE  
RFD. BRADNER, OHIO

19  
RUFUS H. LIBBE  

20  
RUFUS H. LIBBE  

Examined  
July 1997

SECTION 34

T. 5 N. - R. 12 E. FREEDOM TWP. SECTION 35

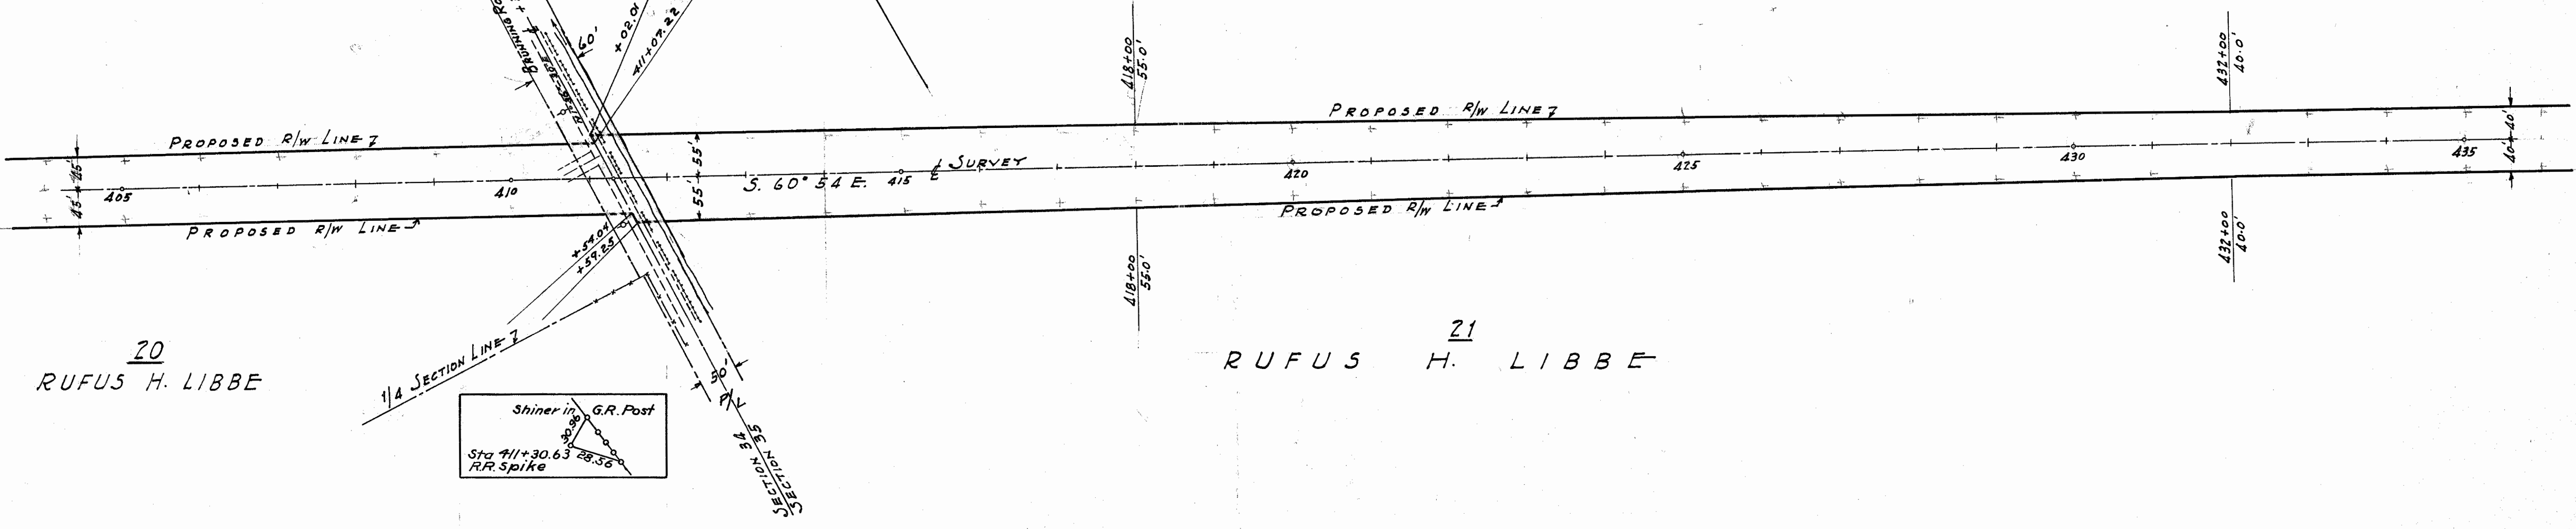
WOOD COUNTY  
S.H. 278 SEC. K (PT)  
R/W PLANS

DATE: 8/12/40 DRAWN BY J.S.  
REVISED 1/17/41  
LENGTH OF PROJECT 3.246 miles

2  
3

20  
RUFUS H. LIBBE

21  
RUFUS H. LIBBE



SECTION 34


T. 5 N. - R. 12 E. FREEDOM TWP.

SECTION 35

21  
RUFUS H. LIBBE

23  
CHARLES N. BELL ET AL.  
c/o R.M. BELL, GENOA, OHIO

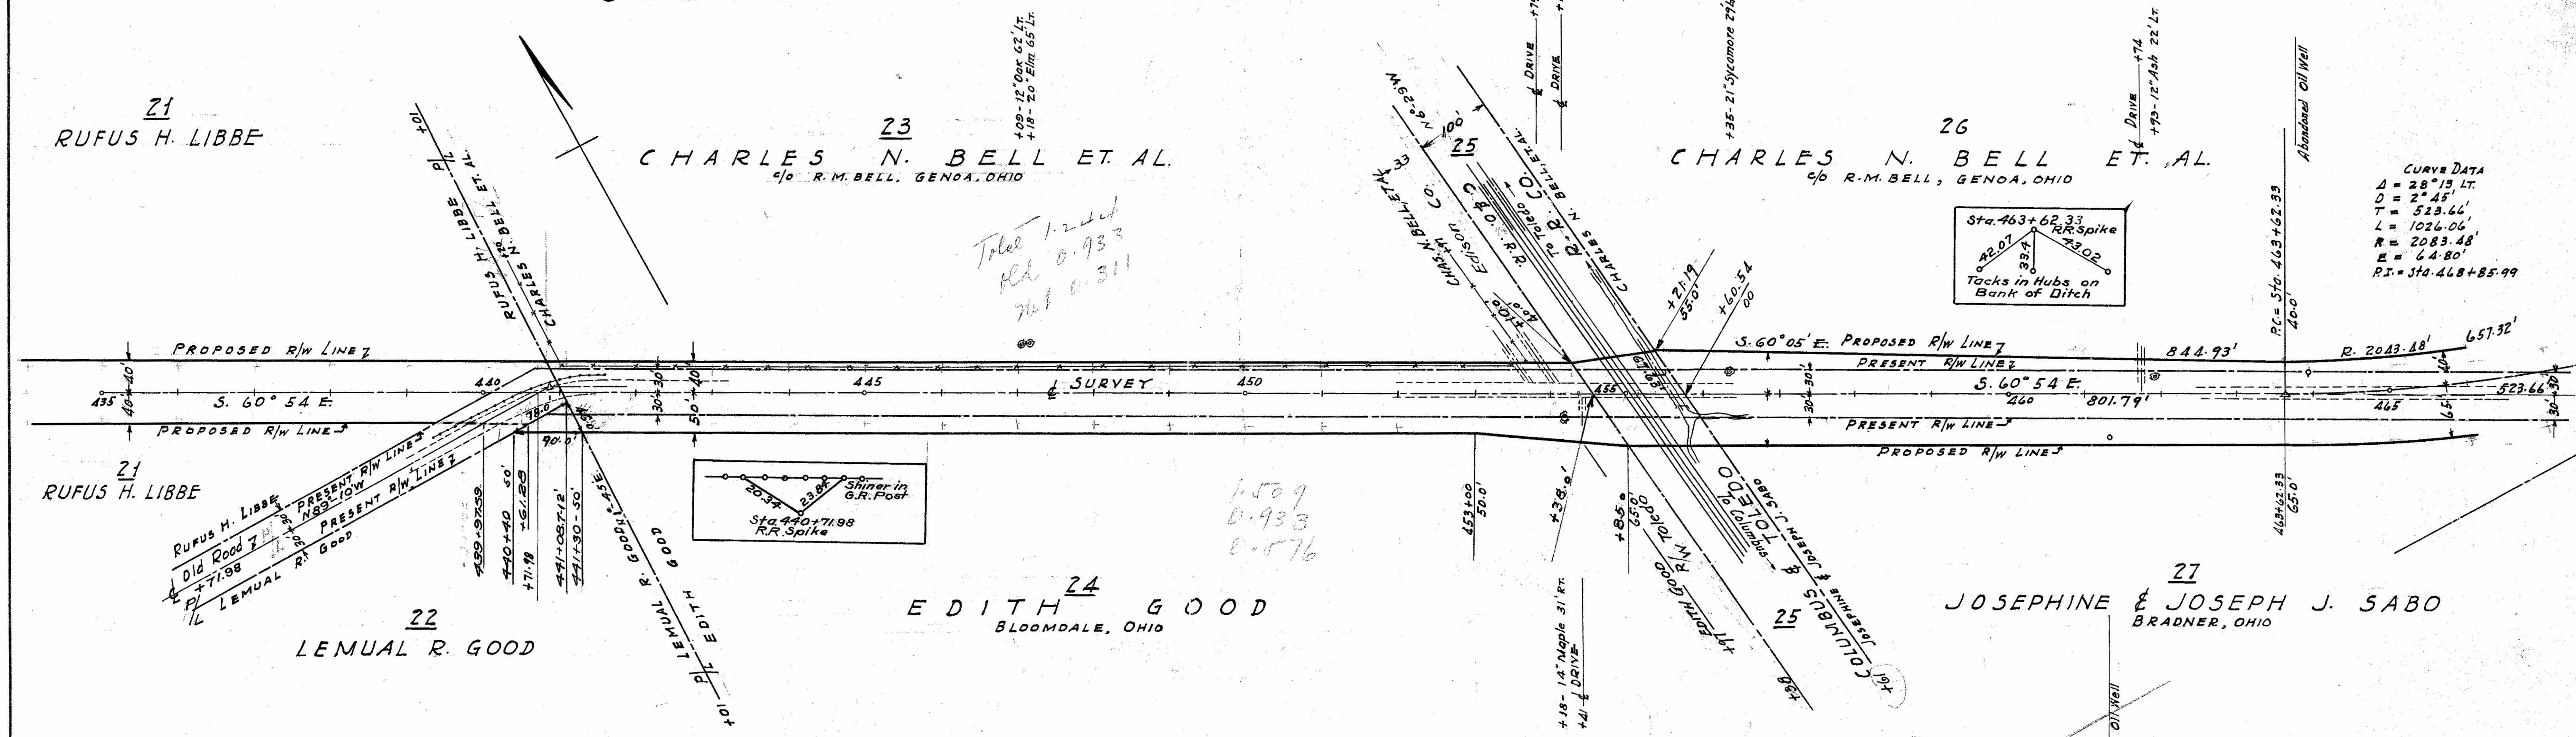26  
CHARLES N. BELL ET AL.  
c/o R.M. BELL, GENOA, OHIO



SECTION 34

SECTION 35

T. 5 N. - R. 12 E.

SECTION 35


SECTION 35

T. 5 N. - R. 12 E.

FREEDOM TWP.



WOOD COUNTY		3 3
S.H. 278 SEC. K (PT.)		
R/W PLANS		
DATE: 8/12/40	DRAWN BY J.S.	
REVISED: 4/9/41		
LENGTH OF PROJECT 3.246 miles		

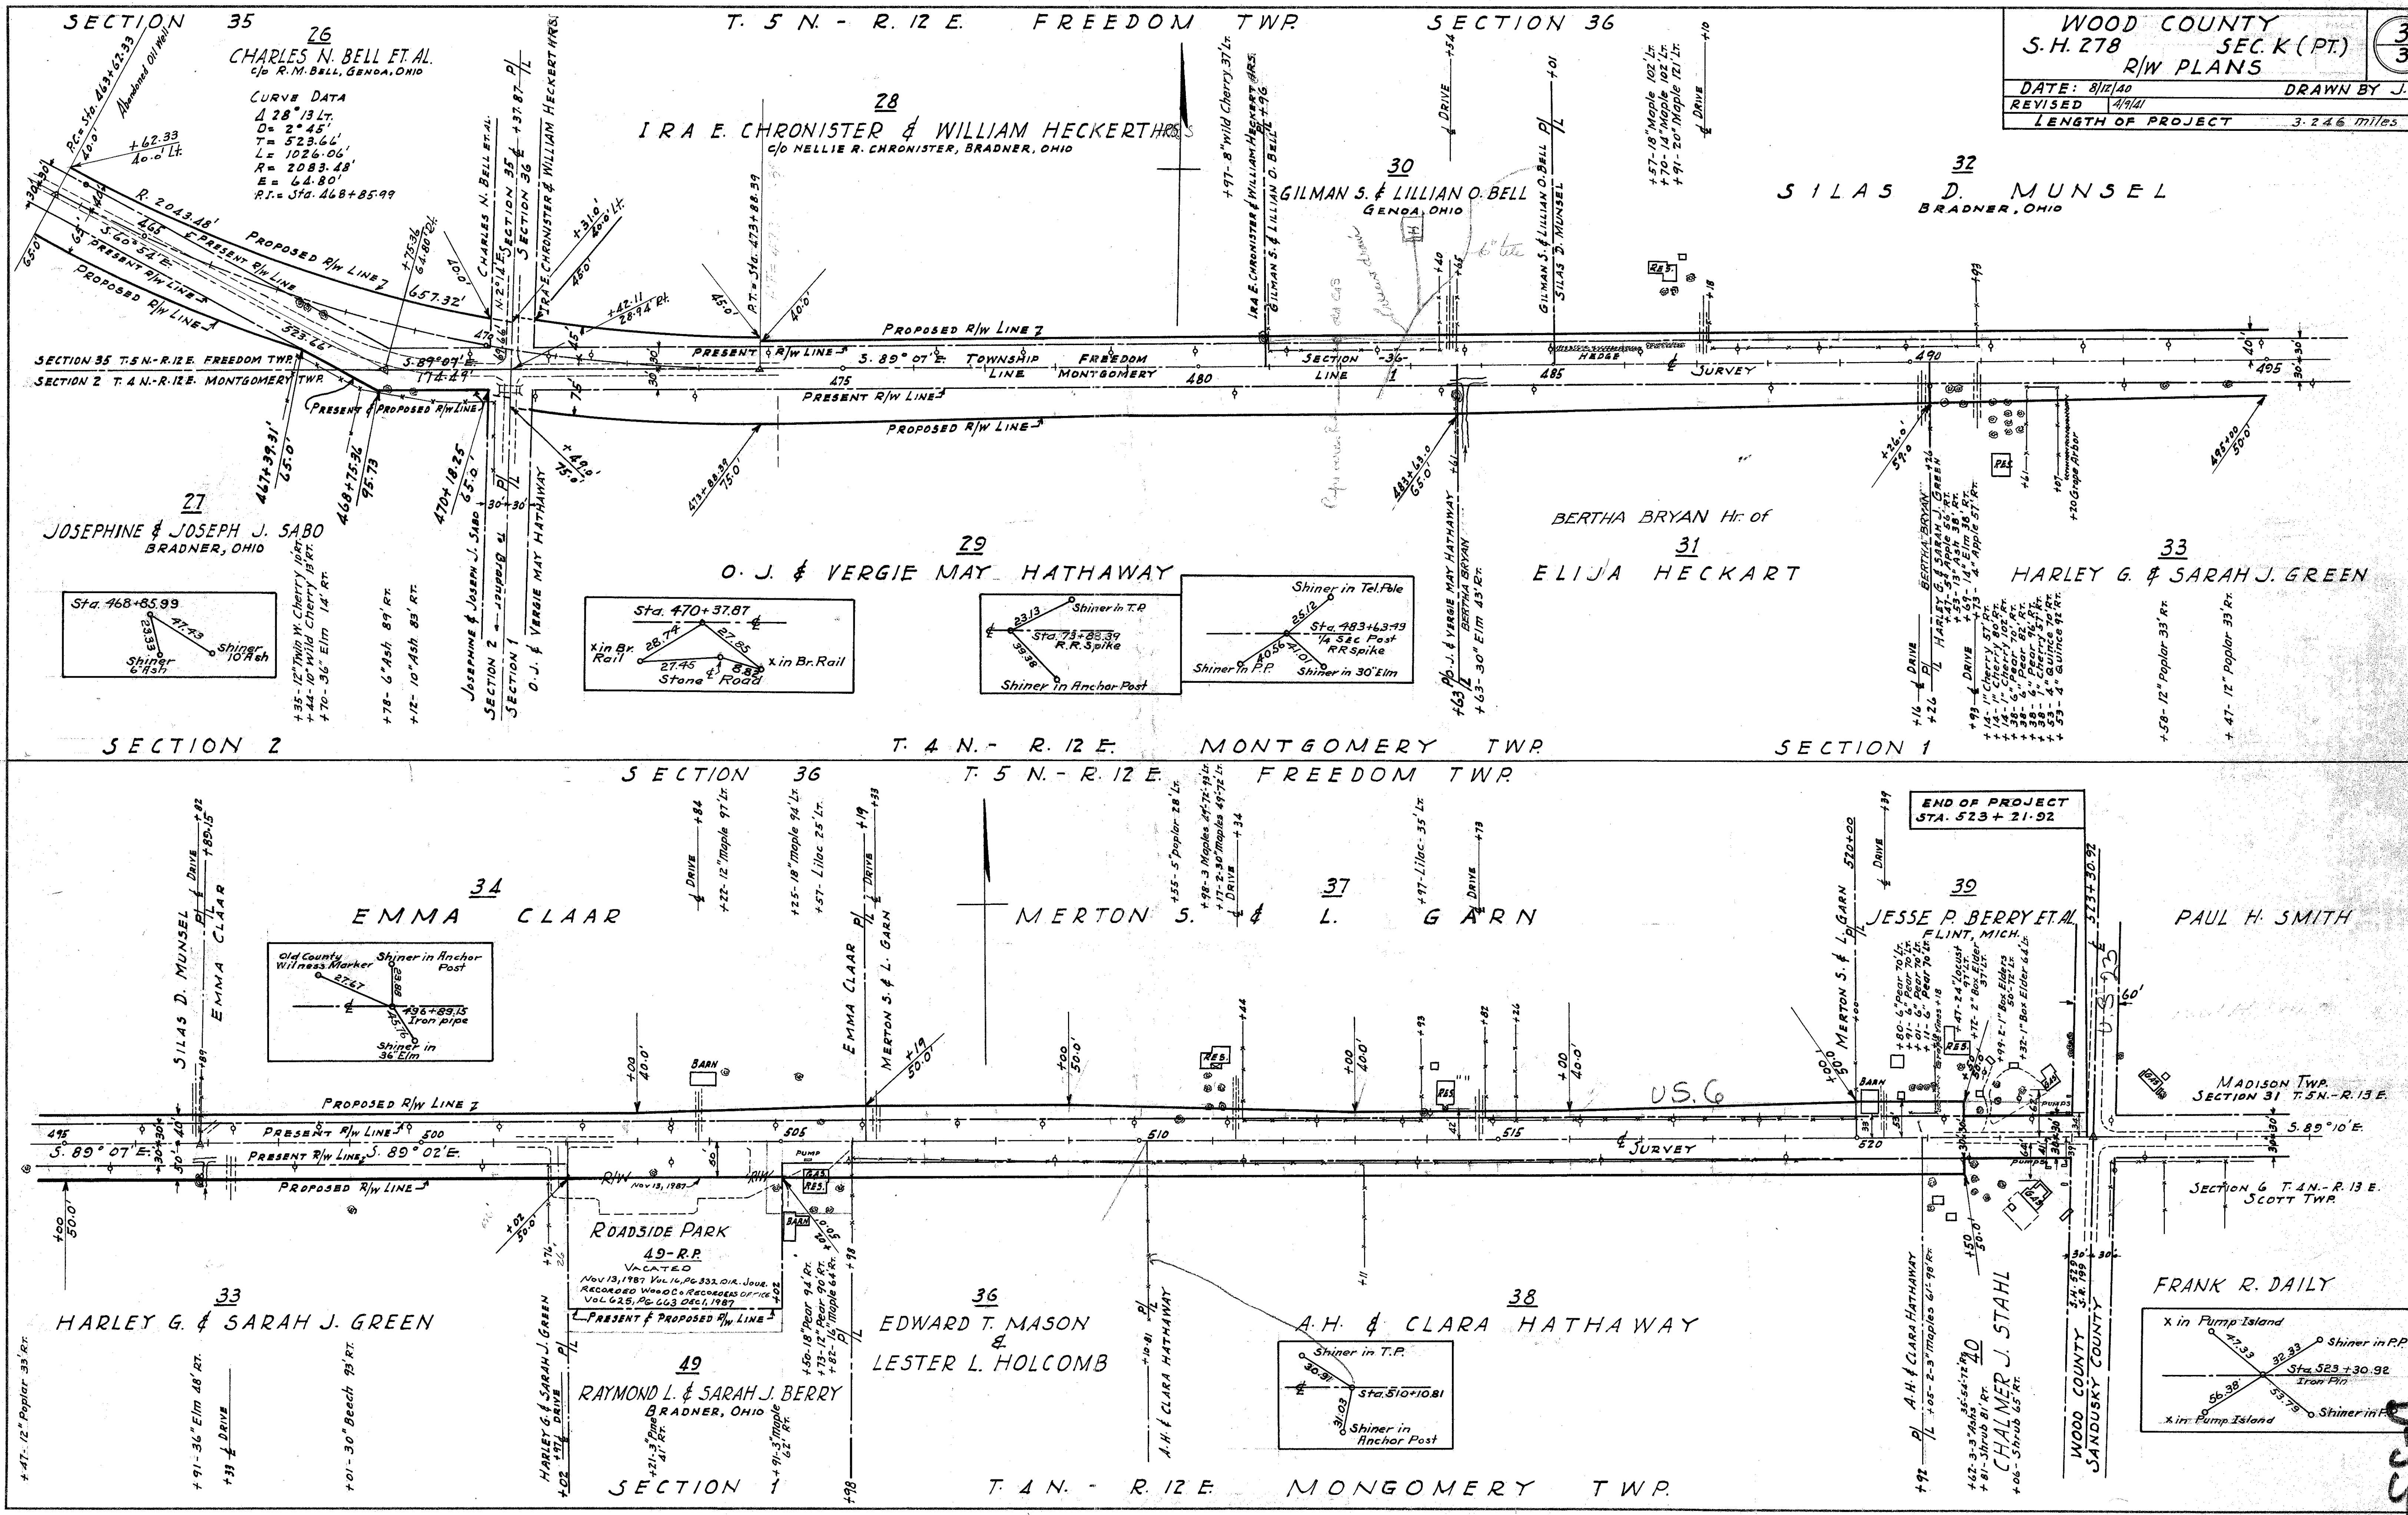


Surveyed July 1947

Scanned  
5/17/17  
5:43 PM


add R/W as shown 278 K  
R/W of line as shown  
F.J.F.  
4/5/44

WOOD COUNTY		①   ①
S.H. 278- SEC. K PT.		
R/W PLAN		
DATE: JUNE 30, 1938. DRAWN BY AP		
REVISED	5-14-69	F.T.H.
LENGTH OF PROJECT	0.06 MI.	

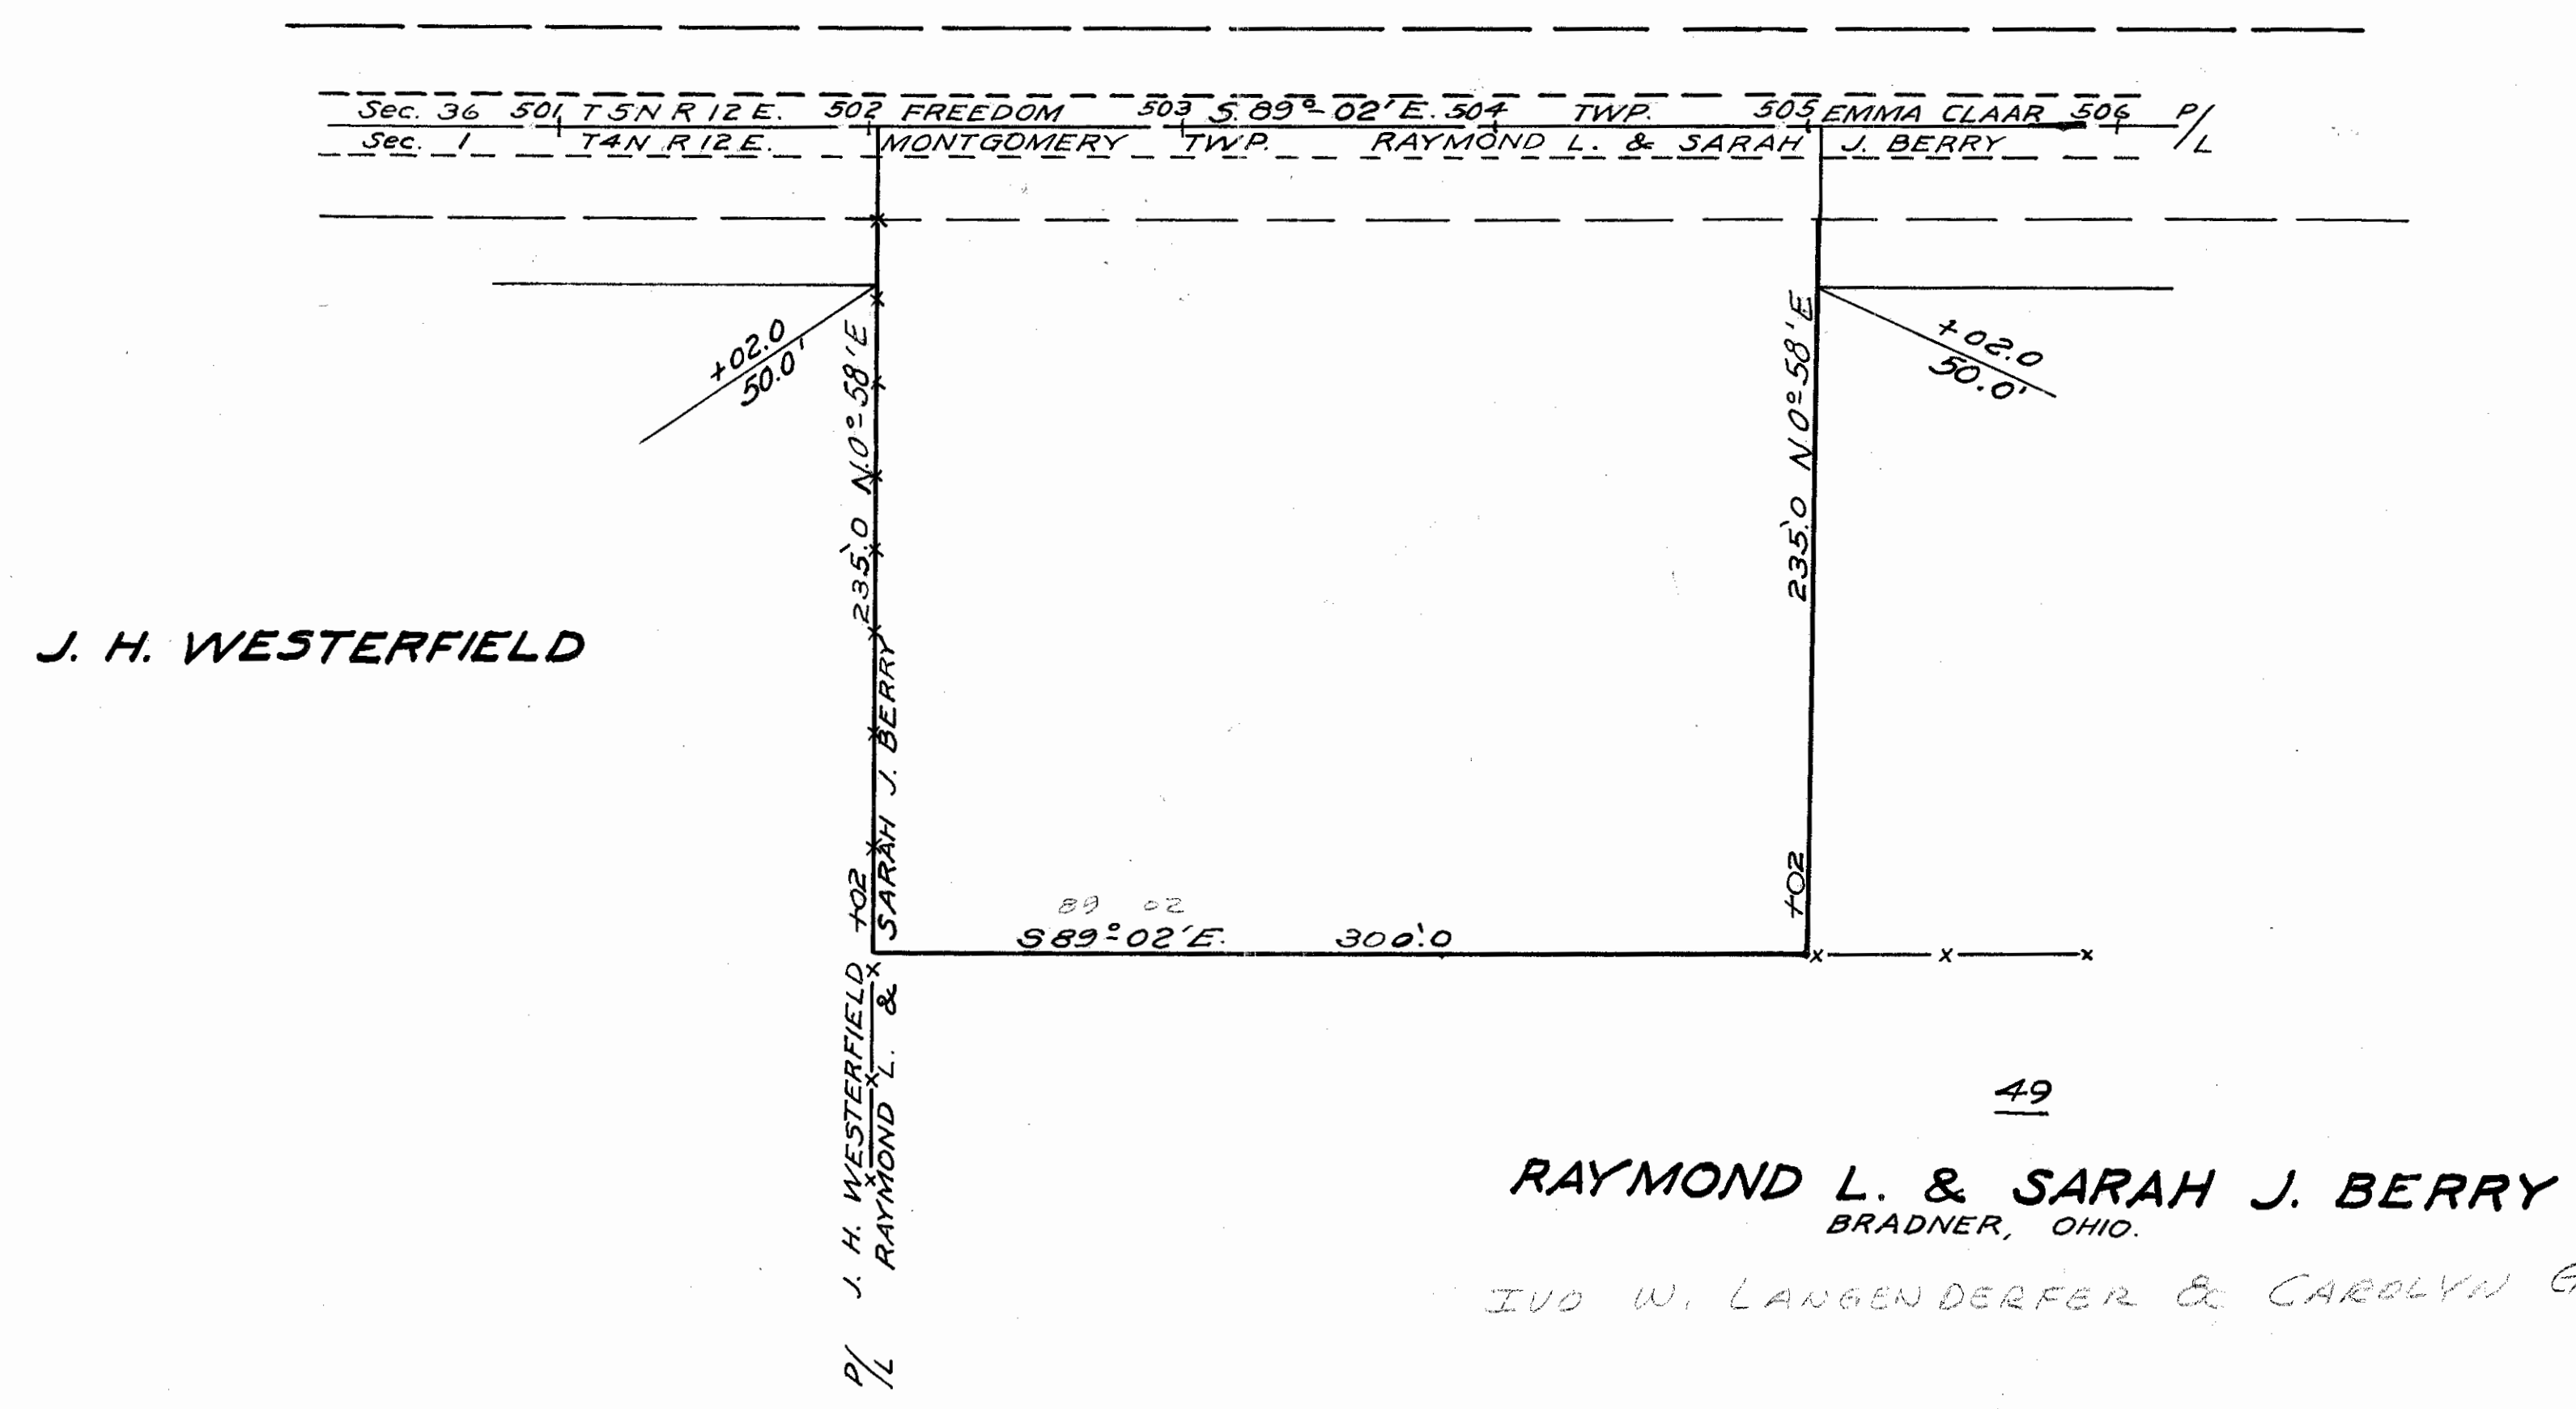↑  
EMMA CLaar



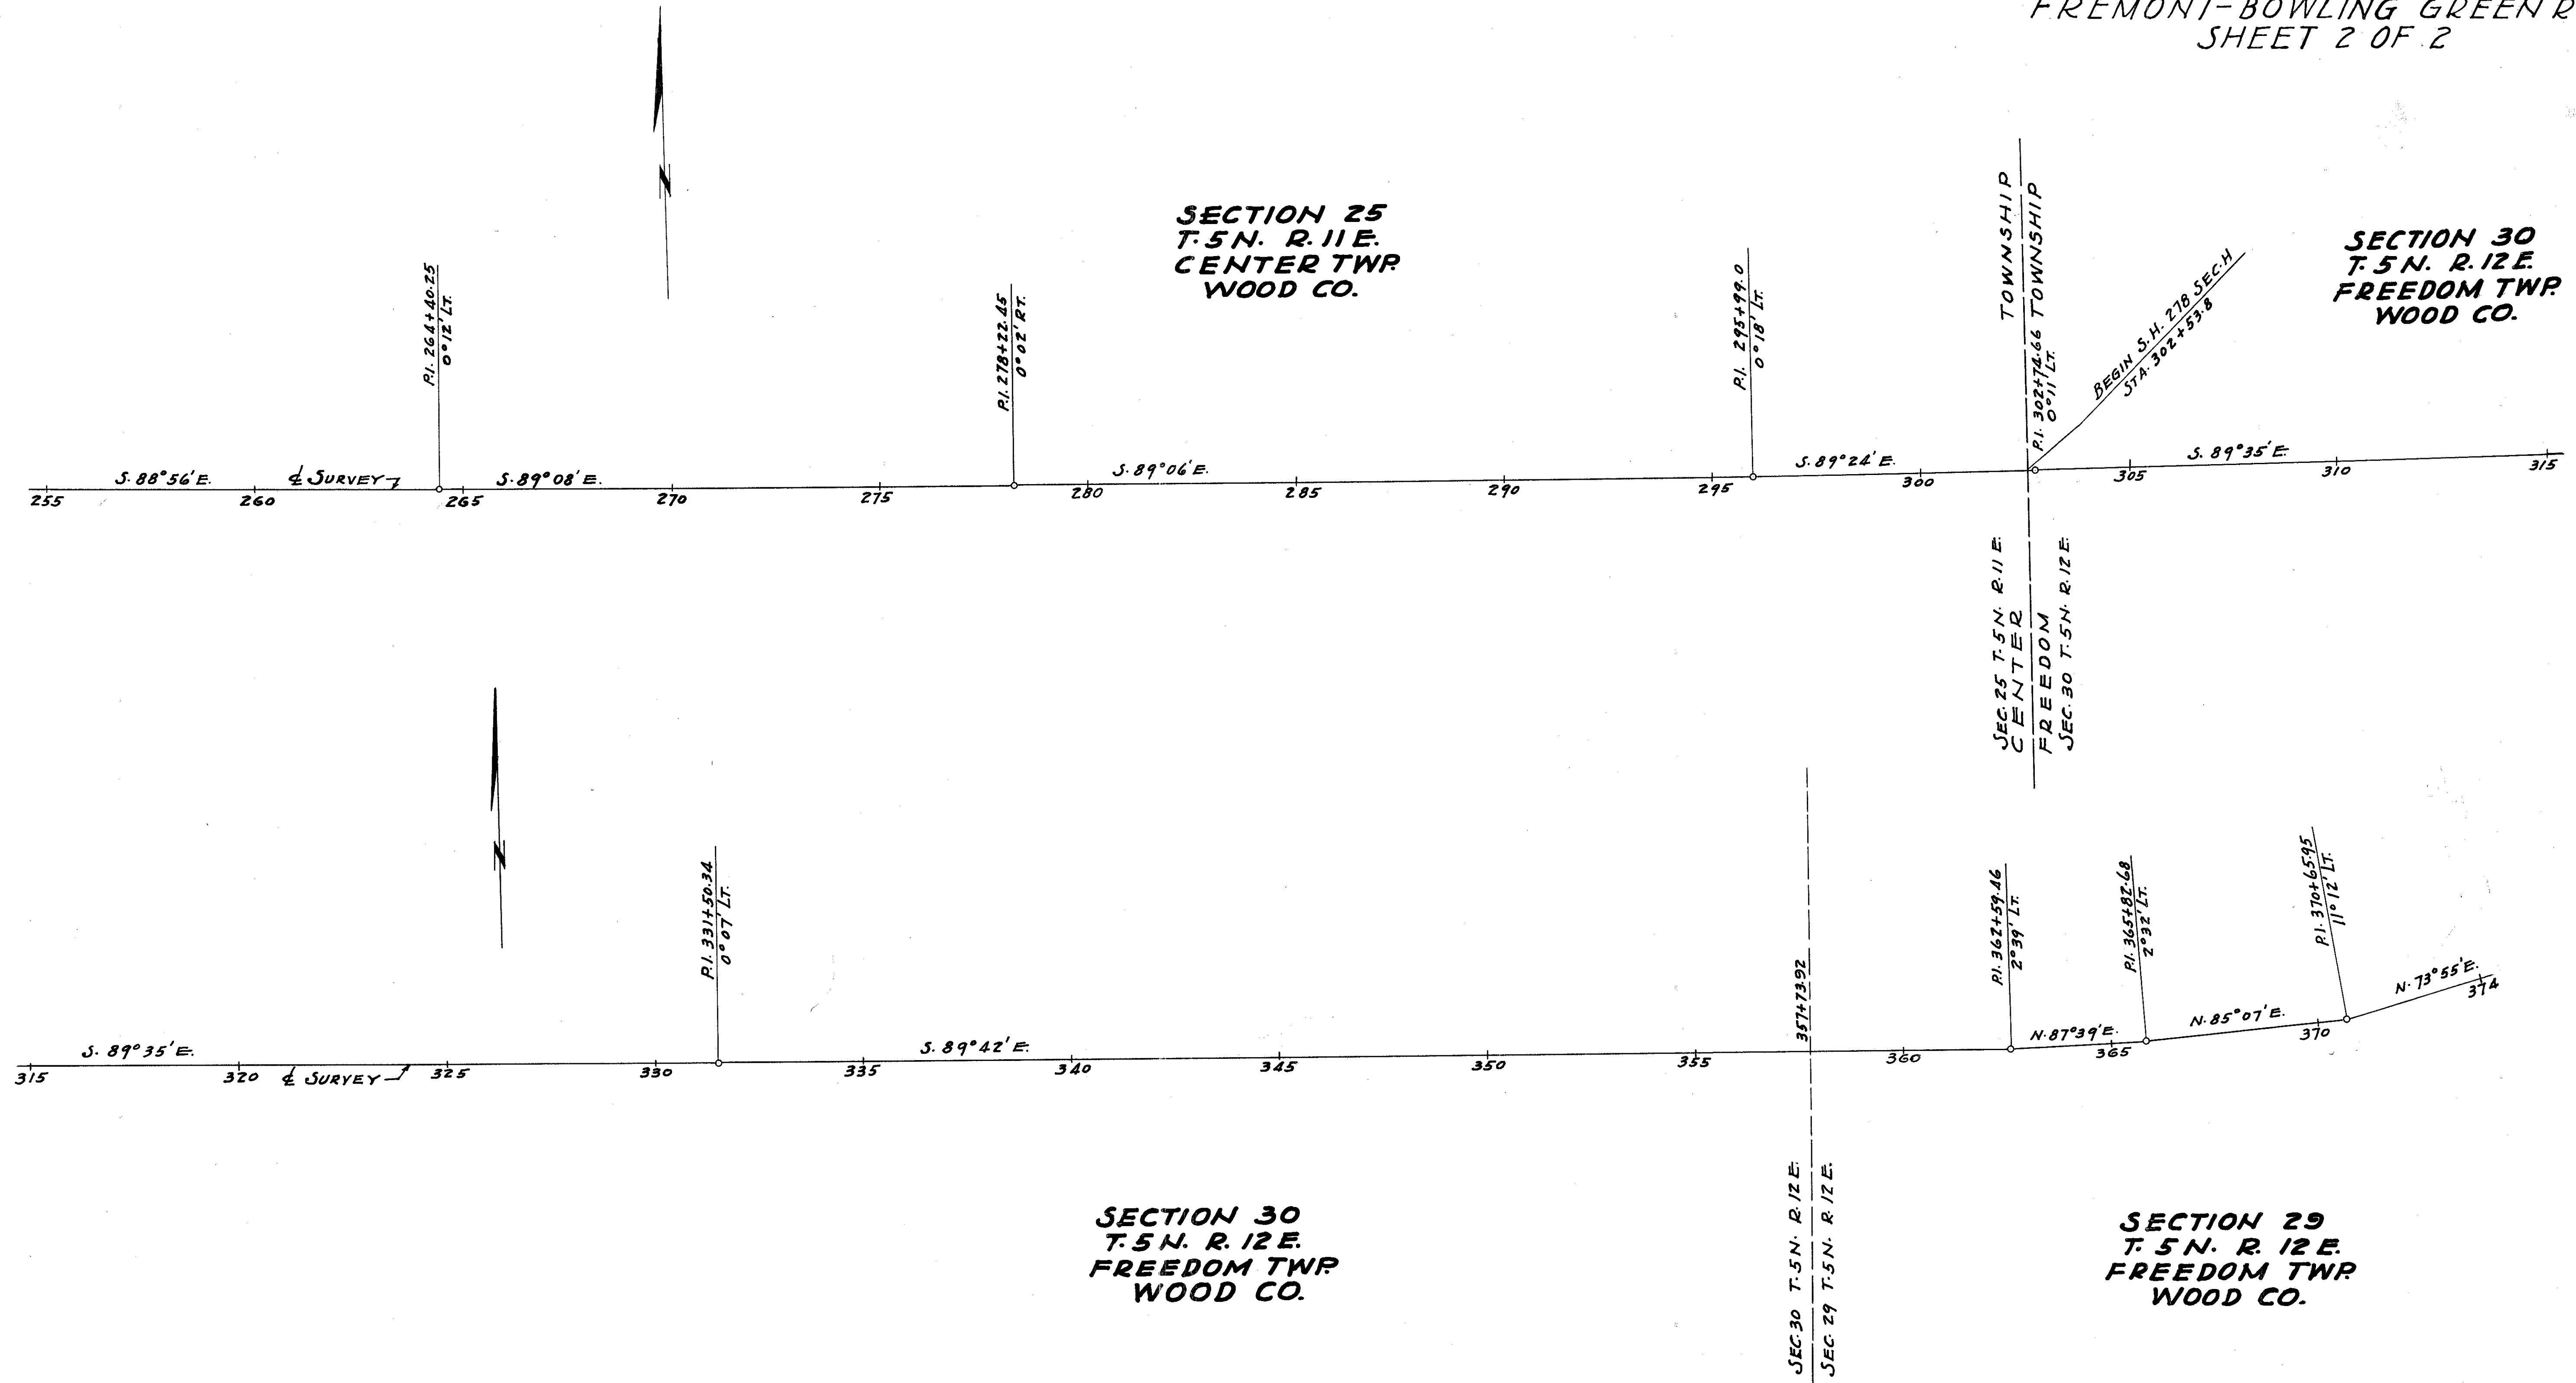LOCATION PLAN  
 S.H. 278 SEC. 6 (PT.) H & K (PT.)  
 FREMONT-BOWLING GREEN ROAD  
 SHEET 2 OF 2



CENTER LINE REFERENCE MONUMENTS WILL BE SET BEFORE OR AFTER CONSTRUCTION


STA. 257+00	STA. 264+40.25	STA. 270+00	STA. 276+33.0	STA. 286+00	STA. 295+99.0	STA. 302+74.66	STA. 312+00	STA. 321+00	STA. 331+50.34	STA. 339+00	STA. 347+00	STA. 355+00	STA. 362+59.46	STA. 365+82.68	STA. 370+65.95

Scanned  
 July  
 1997























# LOCATION PLAN S.H. 278 SEC. G (PT.) H & K (PT.) FREMONT-BOWLING GREEN ROAD 1942

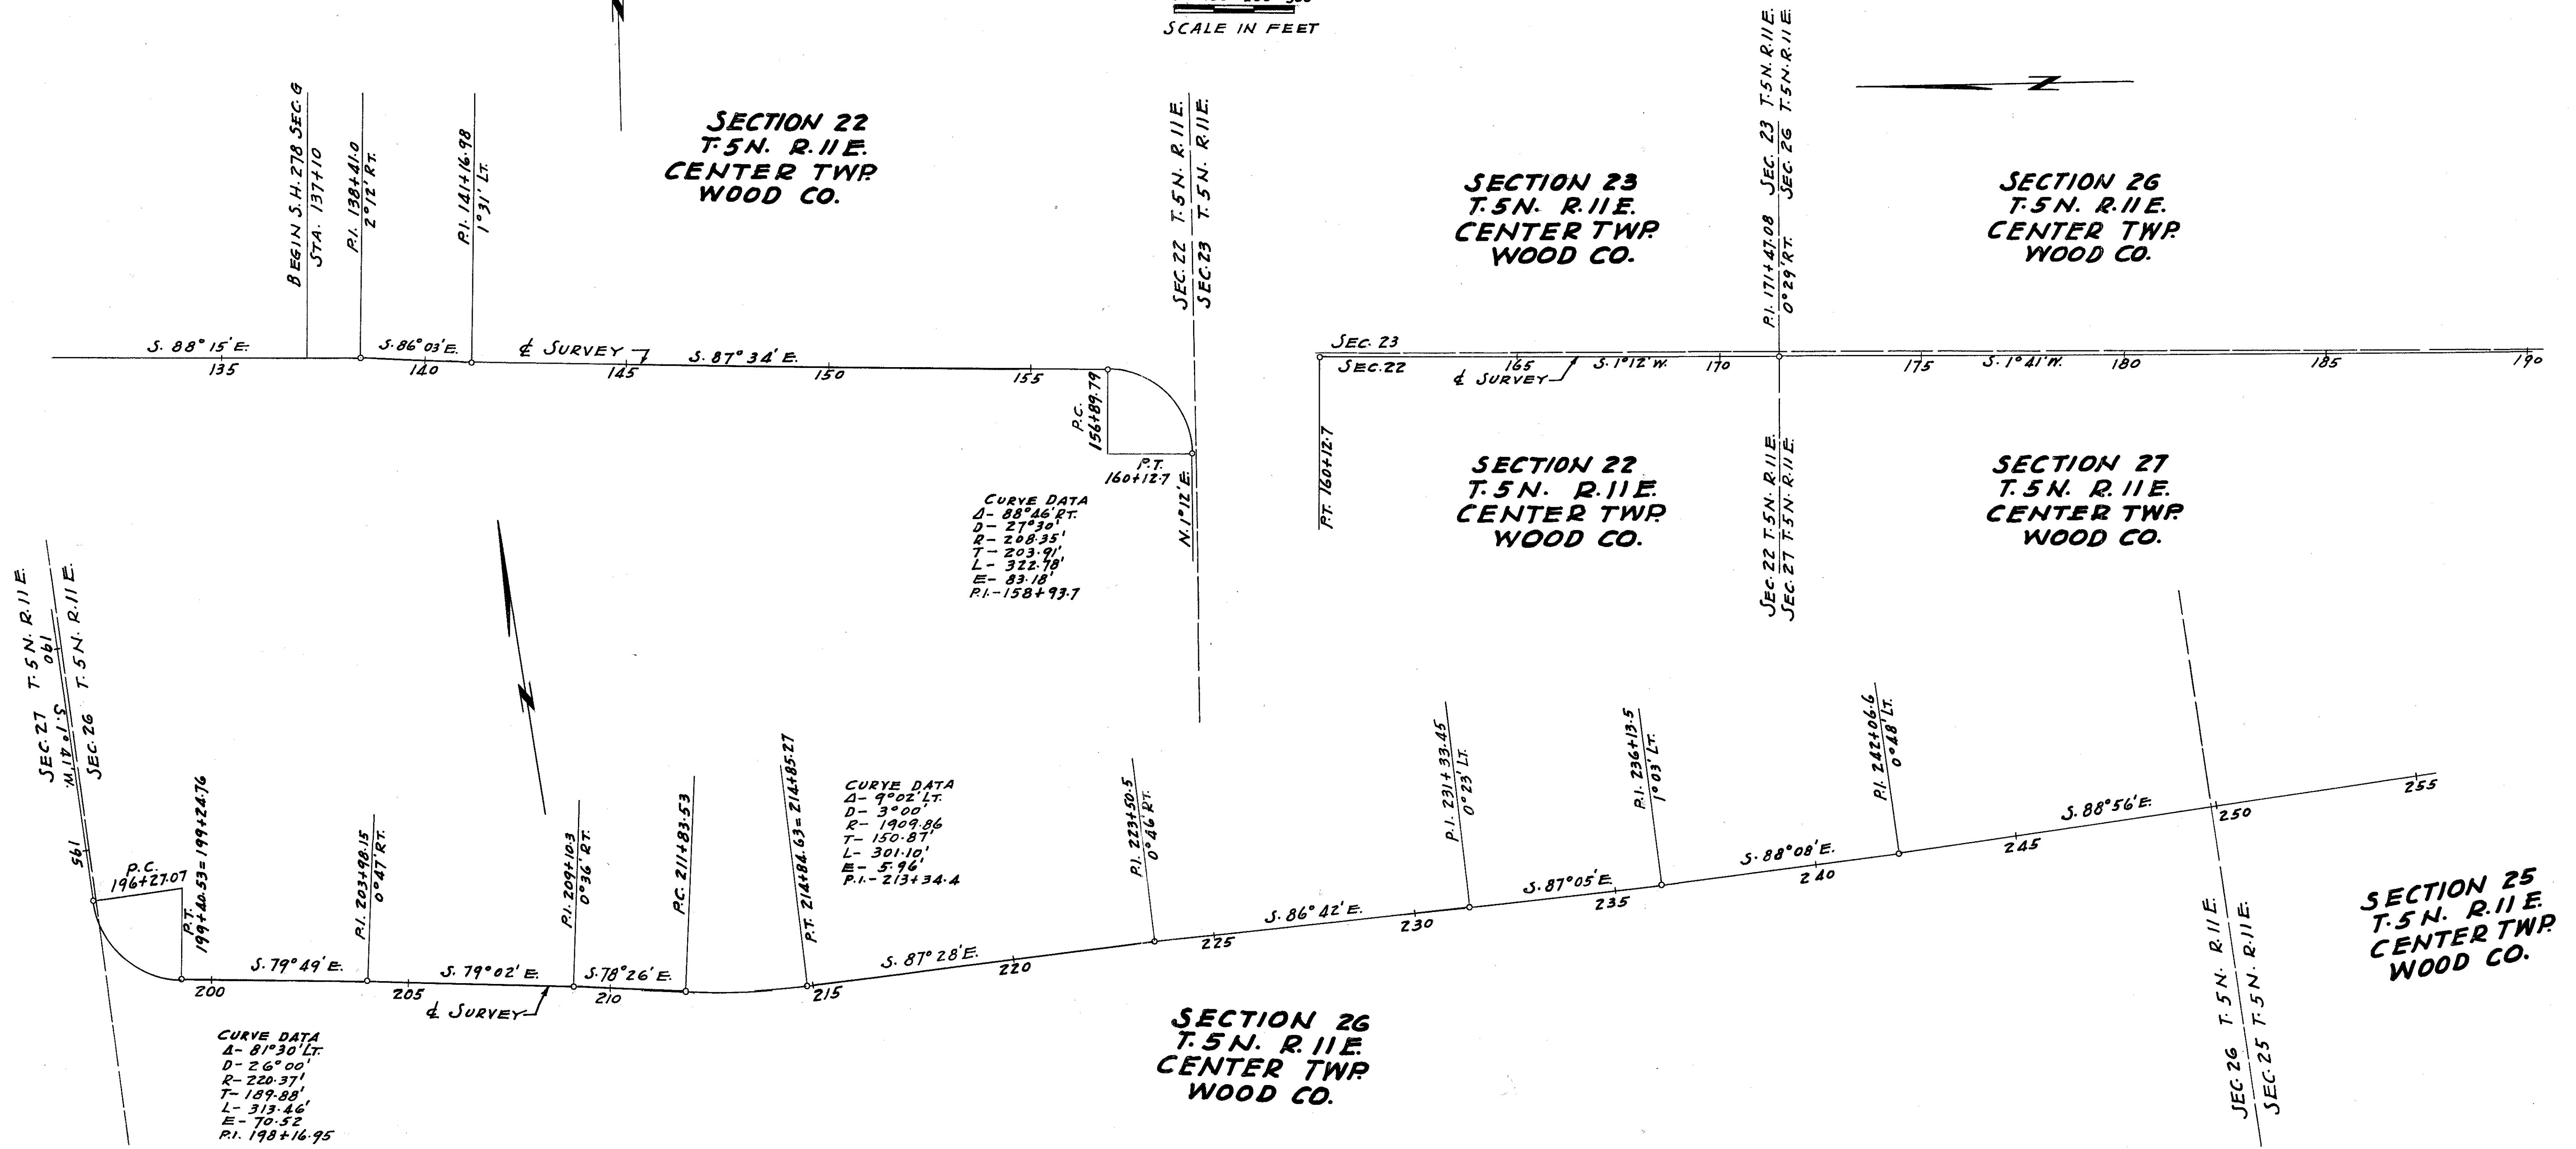0 100 200 300  
SCALE IN FEET



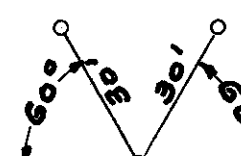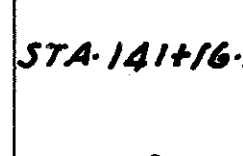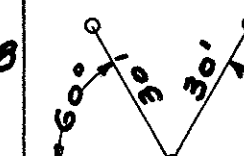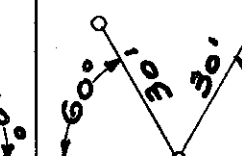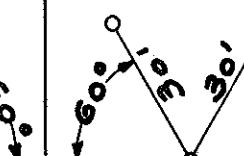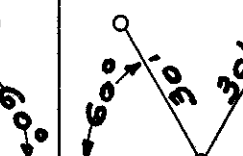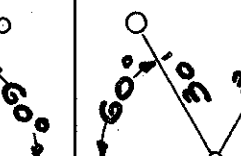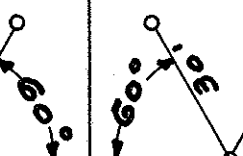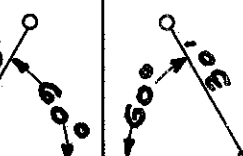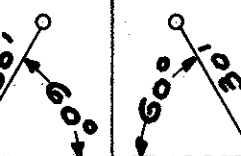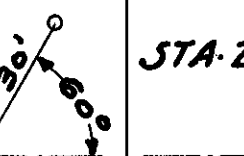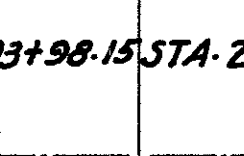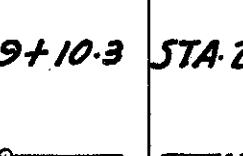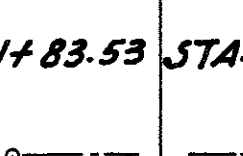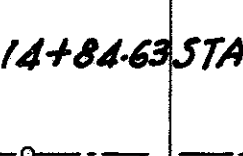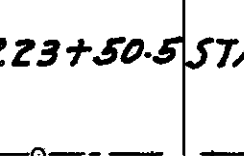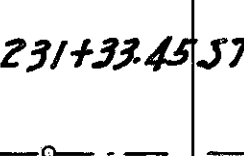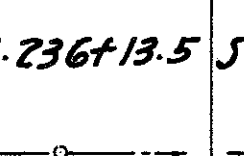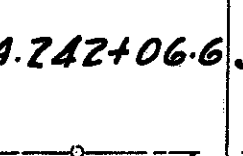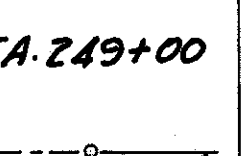CENTER LINE REFERENCE MONUMENTS WILL BE SET BEFORE OR AFTER CONSTRUCTION

	STA. 138+41.0		STA. 141+16.98																			

500000  
July 1999

LOCATION PLAN  
S.H. 278 SEC. G (PT.) H & K (PT.)  
FREMONT-BOWLING GREEN ROAD  
SHEET 2 OF

SECTION 32  
T. 5 N. R. 12 E.  
FREEDOM TWP.  
WOOD CO.

SECTION 29  
T. 5 N. R. 12 E.  
FREEDOM TWP.  
WOOD CO.

SECTION 28  
T. 5 N. R. 12 E.  
FREEDOM TWP.  
WOOD CO.

SECTION 29  
T. 5 N. R. 12 E.  
FREEDOM TWP.  
WOOD CO.


SECTION 32  
T. 5 N. R. 12 E.  
FREEDOM TWP.  
WOOD CO.

SECTION 33  
T. 5 N. R. 12 E.  
FREEDOM TWP.  
WOOD CO.

CURVE DATA  
A - 89°00' LT.  
D - 26°00'  
R - 220.37'  
T - 216.56'  
L - 342.31'  
E - 88.6'  
P.I. - 417+11.58

CENTER LINE REFERENCE MONUMENTS WILL BE SET BEFORE OR AFTER CONSTRUCTION

STA. 380+00	STA. 385+62.97	STA. 390+02.3	STA. 394+86.15	STA. 403+00	STA. 411+09.85	STA. 414+95.02	STA. 419+28.14	STA. 428+00	STA. 437+06.0	STA. 444+00	STA. 451+00	STA. 457+38.63	STA. 464+00	STA. 471+00	STA. 476+86.28	STA. 483+00	STA. 490+09.65

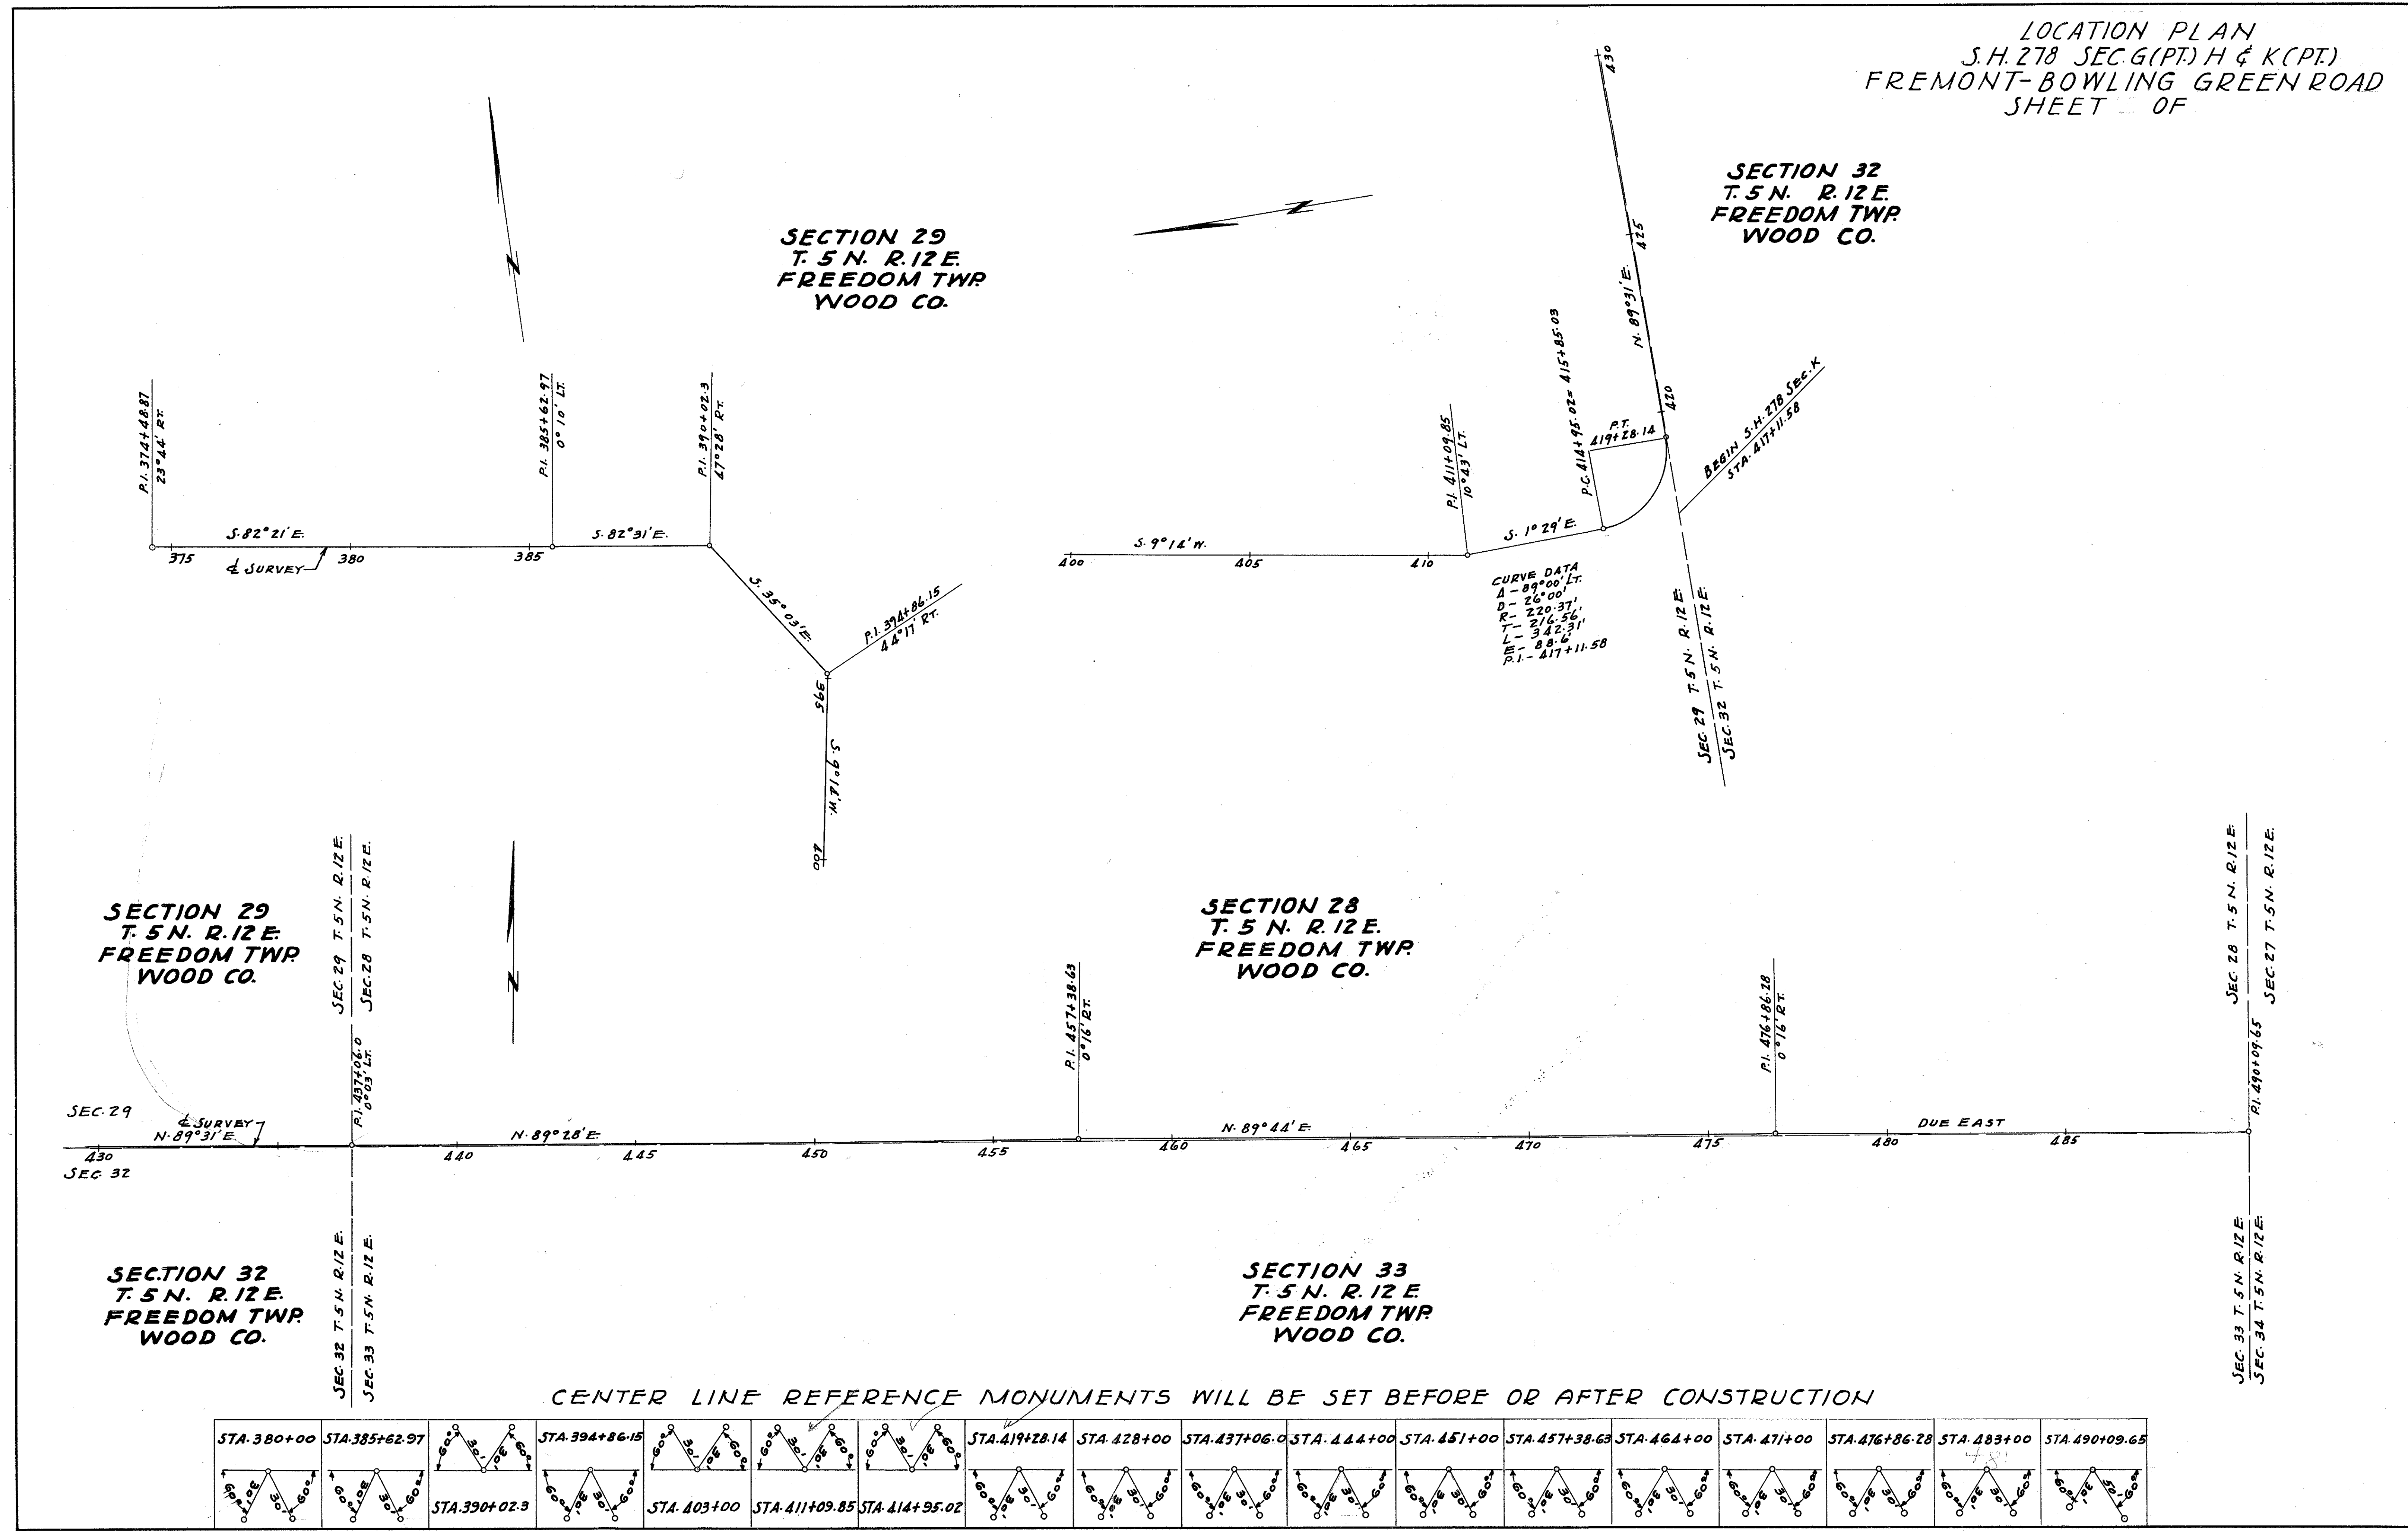

SEC. 28 T. 5 N. R. 12 E.  
SEC. 27 T. 5 N. R. 12 E.  
SEC. 33 T. 5 N. R. 12 E.  
SEC. 34 T. 5 N. R. 12 E.

SEC. 29 T. 5 N. R. 12 E.  
SEC. 28 T. 5 N. R. 12 E.  
SEC. 32 T. 5 N. R. 12 E.  
SEC. 33 T. 5 N. R. 12 E.