

PERSONNEL TITLE PERSONNEL TITLE COUNTY Wood DATE 9-15-81 WEATHER Clear
 Hoffmann
 Householder S. R. 25
 Lechke SEC. 582 - Bernsburg TEMP. +65°

JOB NO. _____

DESCRIPTION	CENTER LINE		RIGHT	
	LEFT			
833795 10' RT	S.B.L.		<p>single Post - driven in good</p>	
880+29 10' RT	S.B.L.		<p>single Post - driven in 2' x 2' - FAIR</p>	
881+20 29' RT	S.B.L.		<p>single Post - driven in For King Road 2 1/2 x 2 1/2 - Good</p>	
882+81 11' RT	N.B.L.		<p>single Post - driven in 2' x 2' - Good</p>	

SHEET NO. 2

DATE 9-15-81
COUNTY Wood
S. R. 25
WEATHER Clear
SEC. 582 - Perrysburg
TEMP. +65°

JOB NO.

TITLE PERSONNEL TITLE

Hoffman
Hoeseholder
Loehrke







Sign Locations

DESCRIPTION	LEFT	CENTER LINE	RIGHT
899470	35' RT	N.B.L.	 <p>FOR Dowling Rd. 2 1/2' x 2 1/2' - FAIR Single Post - driven in</p>
903+44	103' RT	N.B.L.	 <p>2' x 2' - Good Single Post - driven in</p>
925+87	107' RT	S.B.L.	 <p>2' x 2' - Good Single Post - driven in</p>
926+45	27' RT	S.B.L.	 <p>FOR OVI + Rd. 2 1/2' x 2 1/2' - Good</p>

SHEET NO. 3
 COUNTY wood DATE 9-15-81
 WEATHER Clear
 S. R. 25 TEMP. +65°
 SEC. 582 - Perrysburg

PERSONNEL TITLE PERSONNEL TITLE
Hofman
Householder
Loehke





DESCRIPTION Sign Locations CENTER LINE RIGHT JOB NO.

DESCRIPTION	LEFT	CENTER LINE	RIGHT	JOB NO.
948+07	11.5 Rt	S.B.L.	1.0 1.16' 18"  wood - 25 - 18 mile marker Single Post-driven in	
948+15	11.0 Rt	N.B.L.	1.0 1.16' 18"  wood - 25 - 18 mile marker Single Post-driven in, but is leaking	
953+23	9.5 Rt	S.B.L.	 2' x 2' - Good - but with a 1" hole Single Post-driven in	
953+90	24' rt	S.B.L.	 For Reitz Rd 2 1/2' x 2 1/2' - Good Reinforced Single Post-driven in (2 posts - )	
954+24	29' Rt.	N.B.L.	 For Reitz Rd	

SHEET NO. 4
 COUNTY wood DATE 9-15-81
 S. R. 25 WEATHER clear
 SEC. 582 - Perrysburg TEMP. +65°





PERSONNEL TITLE PERSONNEL TITLE
HoFFman Householder
Loehrke

DESCRIPTION Sign location LEFT CENTER LINE RIGHT JOB NO.

DESCRIPTION	LEFT	CENTER LINE	RIGHT	JOB NO.
1000+80	11.8' RT.	S.B.L.	116' 19"  wood - 25-19 mile marker Good Single Post-driven in, but leaning	
1004+39	10.9' RT.	S.B.L.	 2' x 2' - Good Single Post-driven in	
1007+63	23.6' RT.	S.B.L.	 For Five Point Ed. 2 1/2' x 2 1/2' - New Single Post-driven in	
1008+00	33' RT.	N.B.L.	 For Five Point Ed. 2 1/2' x 2 1/2' - Good Single Post-driven in	

PERSONNEL TITLE PERSONNEL TITLE COUNTY Wood DATE 9-15-81
 HOFFMAN HOUSEHOLDER S. R. 25 WEATHER Clear
 LOCKE SEC. 582 - Perryburg TEMP + 65°

DESCRIPTION Signal Location LEFT CENTER LINE RIGHT JOB NO.

1056717	20.6 RT	S.B.L.	 <p>2' x 2' - Good Single Post-driven in, but leaning</p>
1062100	19' RT	S.B.L.	 <p>For Roachton Rd. 2 1/2' x 2 1/2' - Good Single Post-driven in</p>
1062136	37' RT	N.B.L.	 <p>For Roachton Rd 2 1/2' x 2 1/2' - Good Single Post-driven in</p>
1064188	25 RT	N.B.L.	 <p>For Washington St. 2 1/2' x 2 1/2' - Good</p>

SHEET NO. 6

COUNTY Wood DATE 9-15-81

TITLE

PERSONNEL

TITLE

PERSONNEL

S. R. 25 WEATHER Clear

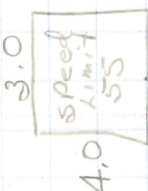

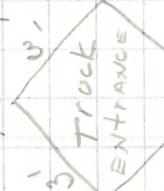

SEC. 582 - Perrysburg TEMP. +70°

DESCRIPTION Sign Location LEFT CENTER LINE RIGHT JOB NO. POITERSBERG

DESCRIPTION	LEFT	CENTER LINE	RIGHT
1067+32	29 Rt. N.B.L.		<p>FOR ROOSEVELT ST. 2 1/2' X 2 1/2' - Good Single Post - driven in</p>
1068+61	110 Rt. S.B.L.		<p>4.0 DUMPING REFUSE SEC. 3767.00 Rev. Code 2 - Single Posts - driven in</p>
1068+73	7' Rt. S.B.L.		<p>1.5 NO PARK NO. PARKING WITHIN 10 FEET OF PAVEMENT EDGE Single Post - driven in but Leaking</p>
1069+74	29.8 Rt. N.B.L.		<p>FOR HAROLD ST. 2 1/2' X 2 1/2' - Good single Post - driven in</p>
1070+27	15' Rt. N.B.L.		<p>7' 475 23 1st</p>

PERSONNEL TITLE PERSONNEL TITLE COUNTY wood DATE 9-15-81 WEATHER clear
 HoFF End
 Householder S. R. 25
 Loebike SEC. 580 - Perryberg TEMP. +70°

DESCRIPTION Sigt Location LEFT CENTER LINE RIGHT JOB NO.

DESCRIPTION	Sigt	Location	LEFT	CENTER LINE	RIGHT	JOB NO.
1073+66	9' Rt.	S.B.L.			 <p>Good 1-double Post. driven IN LEANING</p>	
1075+05	36 Rt.	N.B.L.			 <p>For Gloria St. 2 1/2' x 2 1/2' - Good Single Post - Driven in</p>	
1075+55	165' Rt.	N.B.L.			 <p>4.1' ... 5' ... Good Single Post - driven in</p>	
1077+52	30' Rt.	N.B.L.			 <p>For Lincoln St. 2 1/2' x 2 1/2' - Good Single Post - driven in</p>	



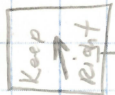

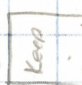
SHEET NO. 8

COUNTY Wood DATE 9-15-81

S. R. 25 WEATHER Clear

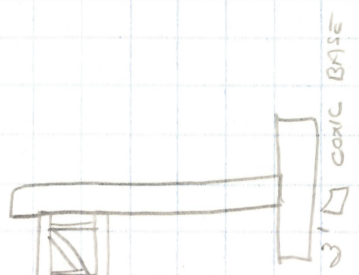
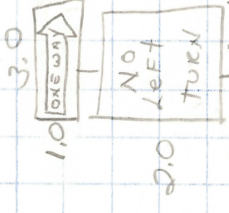
SEC. 582 - Perrysburg TEMP. +70°

DESCRIPTION Sign Locations LEFT CENTER LINE RIGHT JOB NO.

DESCRIPTION	LEFT	CENTER LINE	RIGHT	JOB NO.
1080+96	18.5' rt	S.B.L.	 <p>"FOR OWENS-ILLINOIS" Not O.D.O.T. Sign 2' X 2' Good Single Post - driven in</p>	
1082+14	48.7 ft. of the driving lane	S.B.L.	 <p>"FOR OWENS-ILLINOIS" with a "ONE WAY DO NOT ENTER" on the <u>GOOD</u> side 1.5' 2.0' Single Post - driven in</p>	
1081+75	2' Lt. IN medial strip	S.B.L.	 <p>2.0 2.5 Good Single Post - driven in</p>	
1082+61	49.3' rt.	N.B.L.	 <p>For Jefferson St 2 1/2' X 2 1/2' Good Single Post - driven in</p>	
1083+13	6' Lt.	N.B.L.	 <p>2.0 2.5 Good. - Sign Post IS MISSING Flat</p>	

SHEET NO. 9
 COUNTY Wood DATE 9-15-81
 S. R. 25 WEATHER Clear
 SEC. 582 - Perrysburg TEMP. +70°

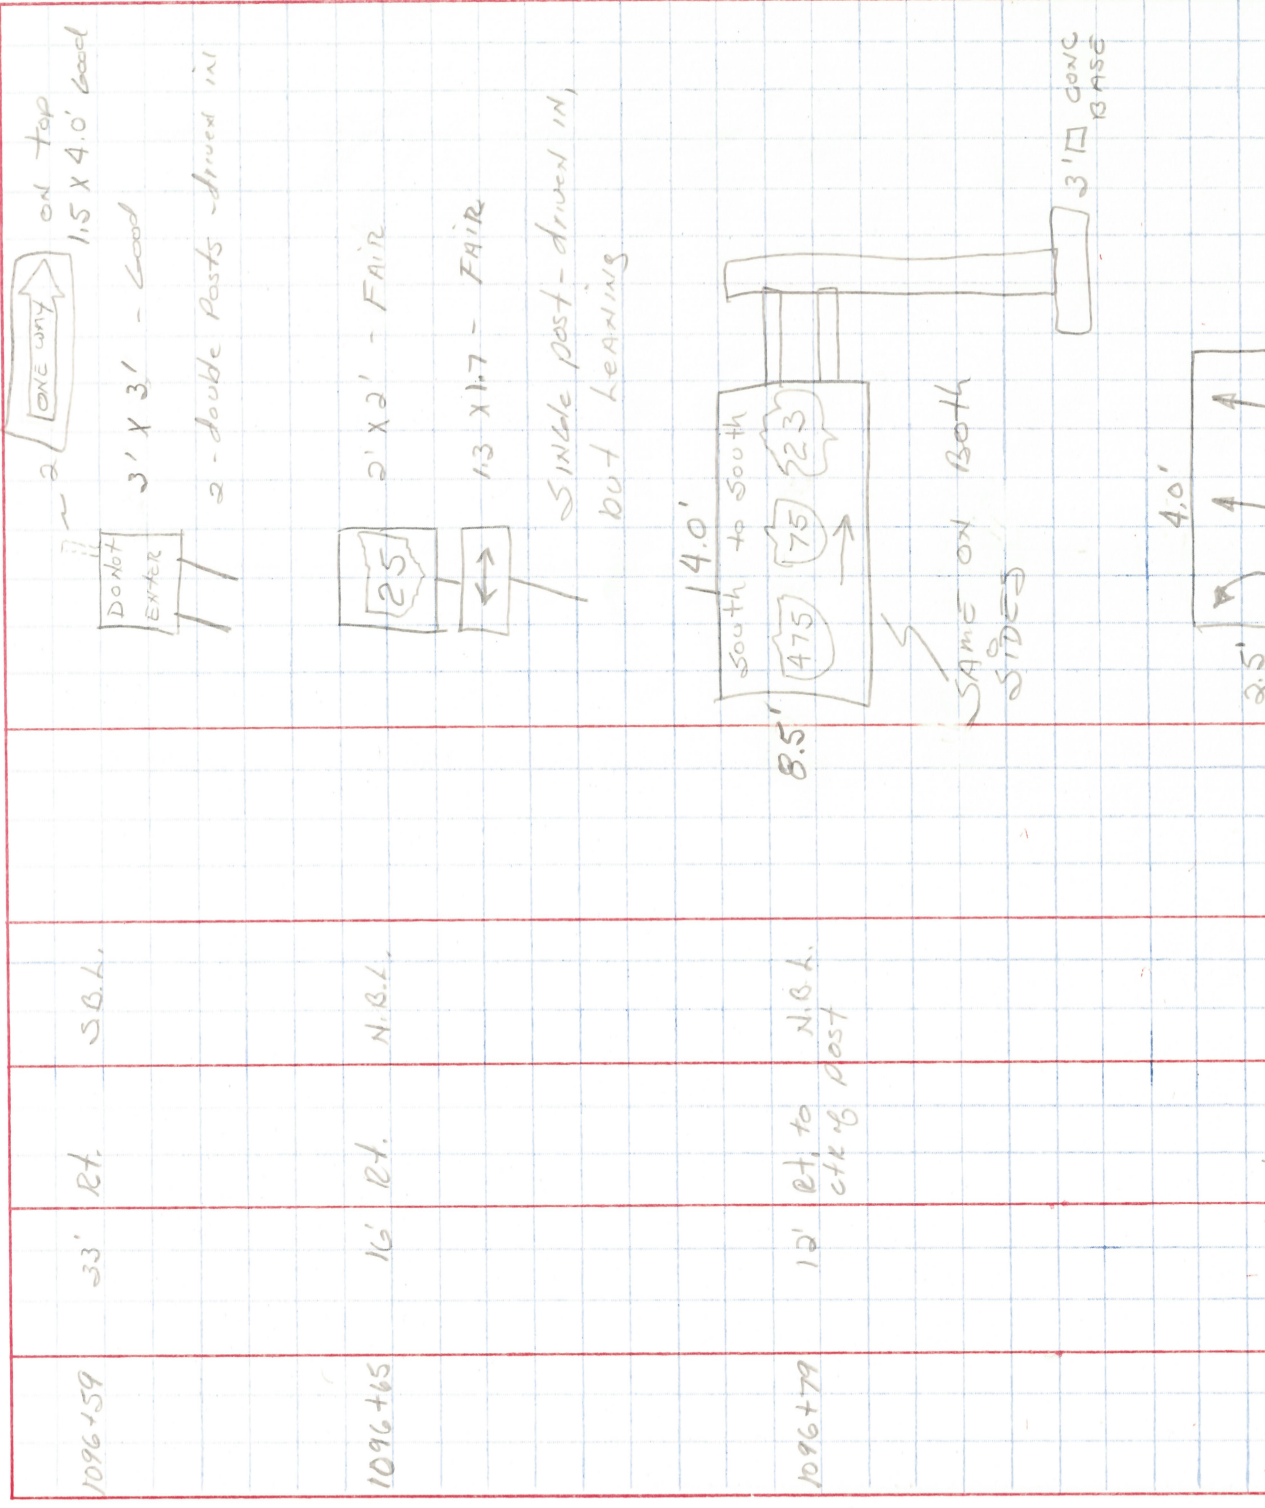
PERSONNEL HoFFman TITLE _____ PERSONNEL _____ TITLE _____
Householder _____
Loehke _____

DESCRIPTION	Sign Locations		JOB NO.
	LEFT	RIGHT	
1087+15	14.0 Rt cte of to Post	12.0' North Keep Left 475 South Keep Right 23 70'	 3' x 3' CONCRETE BASE
1088+42	35' Rt.	N.B.L.	For Williams St. 2 1/2' x 2 1/2' Good Single Post-driven in
1091+00	9.8 Lt. of	N.B.L. IN median	 3.0 1.0 2.0 1.5' NO LEFT TURN Good Single Post-driven in
1092+48	14.7 Rt.	N.B.L.	NO SIGN - Just A single post. Single Post-driven in
1095+02	12.4 Rt	S.B.L.	South 1' x 2' - Good 25' - 2' x 2' - Good

SHEET NO. 10
COUNTY Wood DATE 9-15-81
S. R. 25 WEATHER Clear
SEC. 582 - Perrysburg TEMP. + 70°

PERSONNEL TITLE PERSONNEL TITLE
HCF Final
Householder
Loch, ke

DESCRIPTION Sign Locations
LEFT CENTER LINE RIGHT JOB NO.



SHEET NO. 11
 COUNTY Wood DATE 9-15-81
 S. R. 25 WEATHER Clear
 SEC. 582 - Perrysburg TEMP. +70°

DESCRIPTION Sign Locations LEFT CENTER LINE RIGHT JOB NO.

DESCRIPTION	LEFT	CENTER LINE	RIGHT	JOB NO.
1099403	12' Rt	N.B.L.	<p>2' North 1" 2.5' x 2' 1.25' 1.65'</p>	
1099403	15' Rt	N.B.L.	<p>2' North 1" 2.5' x 2' 1.25' 1.65'</p> <p>1-double post on Each Sign both set in conc.</p>	
1099403	60' Lt	N.B.L. Set in conc. median	<p>2' North 1" 2.5' x 2' 1.25' 1.65'</p> <p>All Good</p>	
1099403	90' Lt	N.B.L.	<p>2' North 1" 2.5' x 2' 1.25' 1.65'</p> <p>1-double post on each sign both set in conc. (break-away posts)</p>	
1099408	120' Lt	S.B.L.	<p>4.0' ONLY ONLY 2.5' 2 - Single posts driven in</p>	

SHEET NO. 12
 COUNTY Wood DATE 9-15-81
 PERSONNEL TITLE PERSONNEL TITLE
Hoffman Householder Loehrke
 S. R. 25 WEATHER Clear
 SEC. 582 - Perrysburg TEMP. +70°

DESCRIPTION Sign locations LEFT CENTER LINE RIGHT JOB NO.

DESCRIPTION	LEFT	CENTER LINE	RIGHT	JOB NO.
1103+01	5.0' Lt. (23) S.B.L.	IN CONC. median	<p>2' x 1' South 475 2.5 x 2 All Good 1.25 x 1.65 1 - Single post EACH sign, driven IN, through hole in CONC.</p>	
1103+01	7.0' Lt. (475) S.B.L.		<p>2' x 1' South 475 2.5 x 2 All Good 1.25 x 1.65 1 - double post each sign, set in CONC.</p>	
1103+01	13' Rt. S.B.L. (475)			
1103+01	16.5' Rt. S.B.L. (23)			
1104+86	4.0' Lt. S.B.L.		<p>2.0 x 2.5 - Good single post, driven IN through hole in CONC.</p>	
			<p>4.0' 0.5' Good</p>	

SHEET NO. 13

PERSONNEL TITLE PERSONNEL TITLE COUNTY Wood DATE 9-15-81
 HoFFman
 Householder
 Lochite
 WEATHER Clear
 S. R. 25
 SEC. 582-Perryburg TEMP + 70°

DESCRIPTION Sign Locations LEFT CENTER LINE RIGHT JOB NO.

1105121	17.0 RT To str of Post	S. B. L.	
1105139	14.0' RT	S. B. L.	
1105147	33.5 RT	N. B. L.	

SHEET NO. 14
 COUNTY wood DATE 9-15-81
 S. R. 25 WEATHER Clear
 SEC. 582 - Perrysburg TEMP. +70°

PERSONNEL Hoffman TITLE _____ PERSONNEL _____ TITLE _____
Householder _____
Lehrke _____

DESCRIPTION Sigd Locatn's LEFT CENTER LINE RIGHT JOB NO. _____

DESCRIPTION	LEFT	CENTER LINE	RIGHT	JOB NO.
1106+19	16' rt	S.B.L.	<p>w00-25-21 mile marker Good Single post - driven in, but leaning</p>	
1106+28	15.5' rt.	N.B.L.	<p>w00-25-21 mile marker Good Single post - driven in, but leaning</p>	
1107+02	13' rt.	N.B.L.	<p>2' x 2' Good Single post set in conc.</p>	
1111+19	15' rt.	S.B.L.	<p>No sigd - Last a Single post - driven in</p>	
1112+40	5' rt 1st med mark	S.B.L.		

SHEET NO. 15
 COUNTY Wood DATE 9-15-81
 S. R. 25 WEATHER Clear
 SEC. 582-Perrysburg TEMP. +70°

PERSONNEL Loeffel TITLE _____ PERSONNEL _____ TITLE _____
Householder _____
Loebke _____

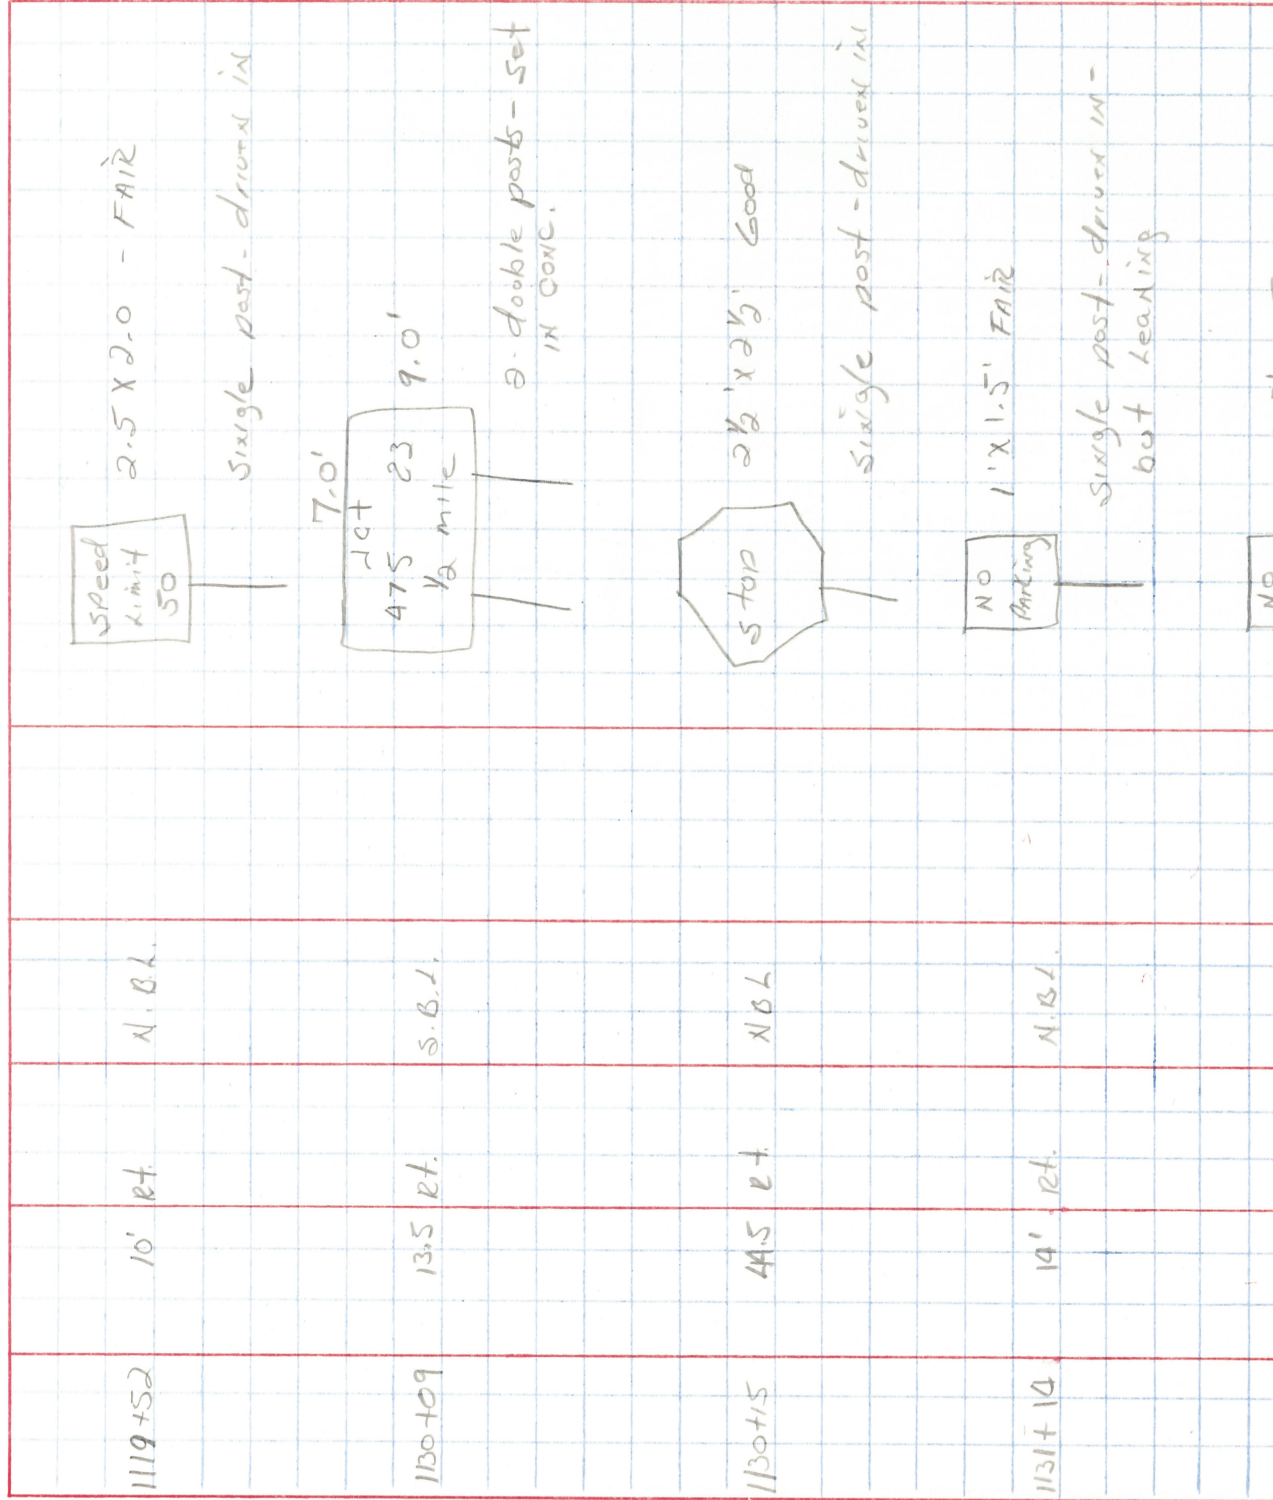
DESCRIPTION Sign Locations CENTER LINE RIGHT JOB NO. _____

DESCRIPTION	LEFT	CENTER LINE	RIGHT	JOB NO.
1114+03	135' Rt to CTR. 08	S.B.L. Post	<p>12.0' 7.0' 3' x 3' COXIC BASE</p>	
1114+25	12.8 Rt.	S.B.L.	<p>2' x 2' Good</p>	Single post, driver in
1116+19	27.5 Rt.	S.B.L.	<p>2 1/2 x 2 1/2 - Good</p>	For Edel-Junction Rd Single post - driver in
1116+60	29 Rt.	N.B.L.	<p>2 1/2 x 2 1/2 - Good</p>	For Edel-Junction Rd

SHEET NO. 16

PERSONNEL TITLE PERSONNEL TITLE COUNTY Wood DATE 9-15-81
 HoFFman
 Householder
 Loehke
 S. R. 25 WEATHER Clear
 SEC. 582- Parrisburg TEMP. +70°

DESCRIPTION Sign Locations LEFT CENTER LINE RIGHT JOB NO.



1119+52 10' Rt. N.B.L.

1100+09 13.5 Rt. S.B.L.

1130+15 44.5 Rt. N.B.L.

1131+10 14' Rt. N.B.L.

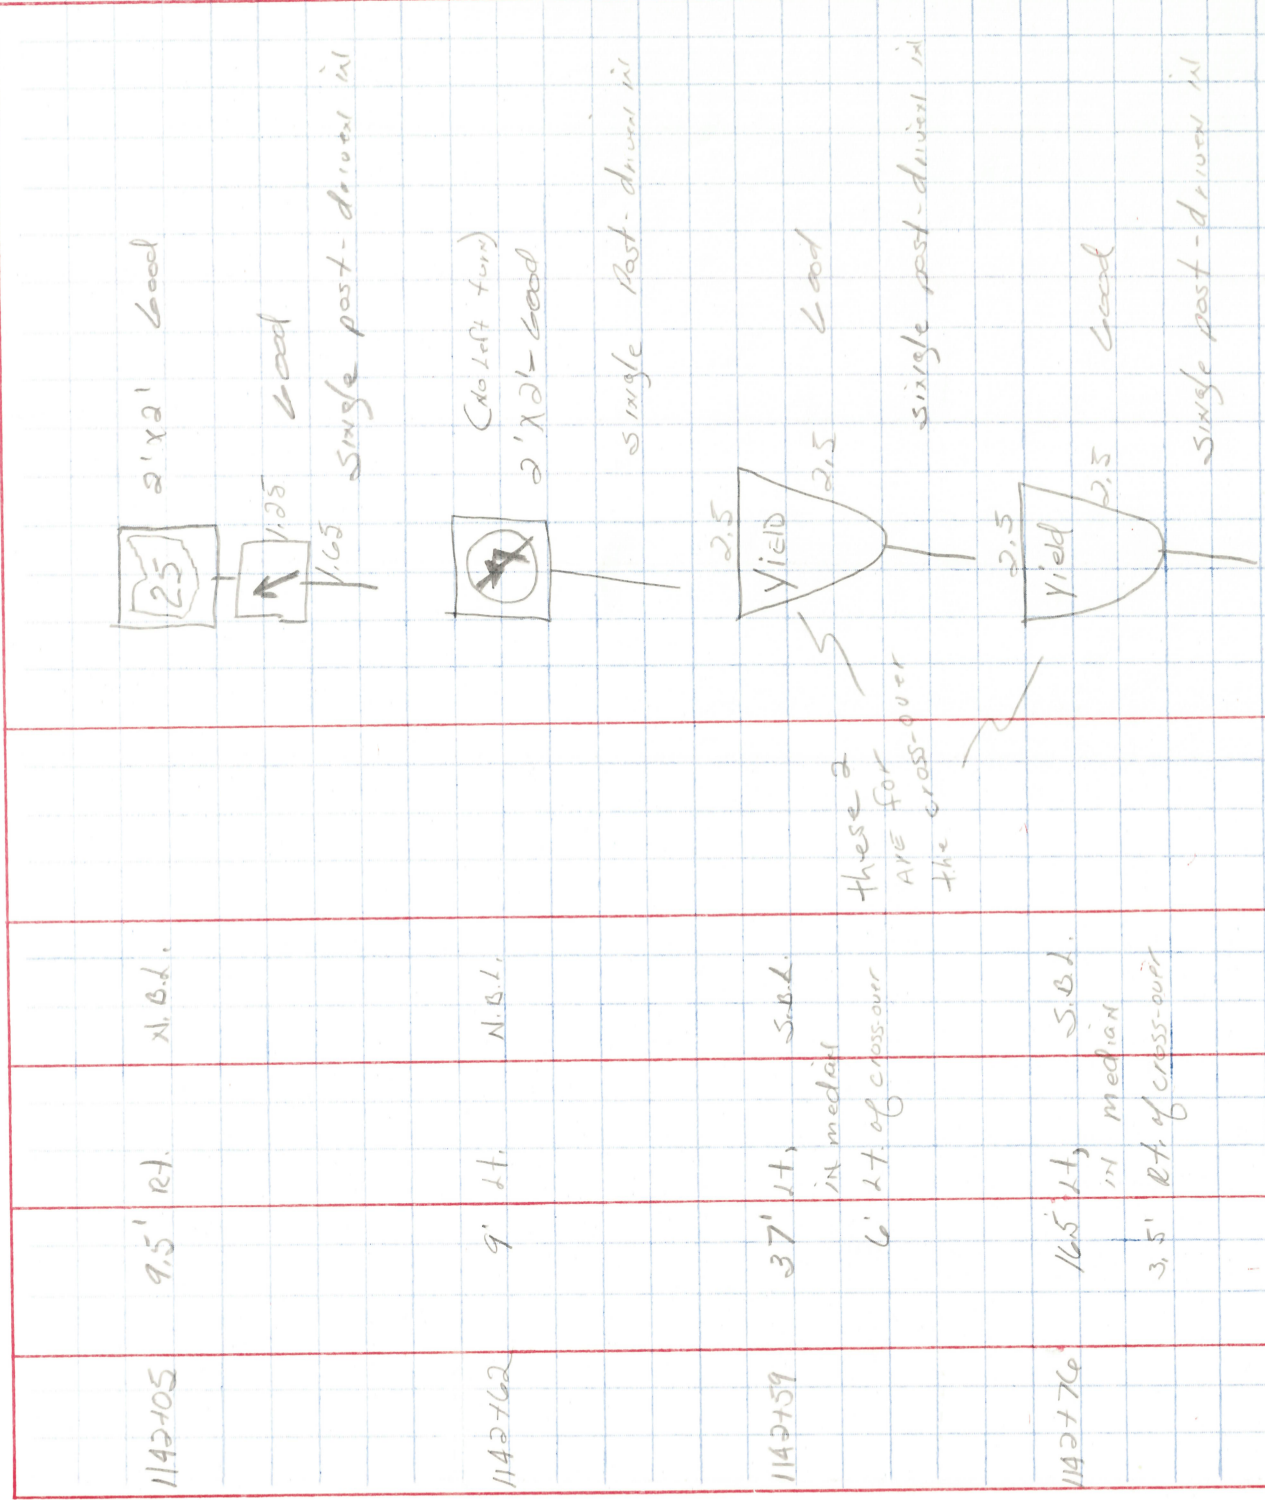
PERSONNEL TITLE PERSONNEL TITLE COUNTY Wood DATE 9-15-81
 HoFFmax
 Hoessholder
 Loehrke S. R. 25 WEATHER Clear
 SEC. 582- Perrysburg TEMP. +70°

DESCRIPTION SIGN LOCATIONS LEFT CENTER LINE RIGHT JOB NO.

DESCRIPTION	SIGN LOCATIONS LEFT	CENTER LINE	RIGHT	JOB NO.
1139453	11' Lt. N.B.L. IN medians		FOR CROSS-OVER STOP 2 1/2 x 2 1/2 POOR Single post - driven in - leaning	
1139485	19.5 Lt. N.B.L. IN medians		DO NOT ENTER 2 1/2 x 1 1/2 FAIR Single post - driven in	
1140493	30.5 Rt. N.B.L. 1002 Rt. of Findlay St.		2.0 75 South Boundary 2.5 Single post - driven in	
1141447	37 Rt. N.B.L. 8' Rt. of Findlay St.		1.5' Speed limit 25 FAIR weight limit 25 TONS Single post - driven in	


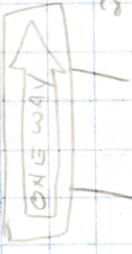
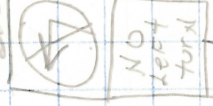


DESCRIPTION: Sign Locations LEFT CENTER LINE RIGHT JOB NO.



PERSONNEL TITLE PERSONNEL TITLE COUNTY Wood DATE 9-16-81
 HOFFMAN S. R. 25 WEATHER Cloudy
 SEC. 582 - Perrysburg TEMP. +65°

DESCRIPTION SIGN LOCATIONS LEFT CENTER LINE RIGHT JOB NO.

1144+46	125'	RT. N.B.L. 2.5' R.t. of cross-over		 For cross-over (Finley St) 2 1/2 x 2 1/2' - FAIR Single post - driven in
1146+62	6.5'	RT. N.B.L.		 3' FAIR 2 - single posts - driven in
1146+78	23'	RT. N.B.L.		 2.0 2.5 2.0 FAIR (For Caps Station) traffic FAIR single post, driven in but, leaning
1148+00	16.7'	RT. N.B.L.		 2.0 2.0 2.5 2.0 FAIR (FOR GAS Station traffic) NO THRU TRAFFIC (ON ROADSIDE) 2.0 Single post, driven in

PERSONNEL TITLE PERSONNEL TITLE

Hoffman

County Wood

Householder

S. R. 25

Loehrke

WEATHER cloudy

SEC. 582 - Ferrysburg TEMP. +65°

DESCRIPTION SIGN LOCATIONS LEFT CENTER LINE RIGHT JOB NO.

DESCRIPTION	SIGN LOCATIONS LEFT	CENTER LINE	RIGHT	JOB NO.
114946	20' Lt. 14' medial	NBL	<p>31 FAIR Single Post, driven in, but leaning</p>	
1149466	70' Rt	NBL	<p>2.0 SPEED LIMIT 40 FAIR Single post, driven in, but leaning</p>	
1150470	32 Rt. 25' Rt. of w. Ninth St.	N.B.L.	<p>2.0 NO TRUCKS Good Single post, driven in</p>	
1151402	28' Rt.		<p>FOR W. NINTH ST. 2 1/2 x 2 1/2 FAIR Single post - driven in but leaning</p>	
1151405	29' Lt.		<p>2.0 Good</p>	