O.D.O.T. DISTRICT 2 SURVEY OFFICE (USE ONLY)

PERSONNEL

NOTES LEU
H.C. WESTFALL
R.C. RHOADES

REFERENCE NO. 26 I SHEET 8 OF 25

DATE 8/19/14
WEATHER SUNNY
TEMP. 70°

ROUTE SR 65
COUNTY WOOD
TOWNSHIP PERRYSBURG
SECTION RT 64
T 7 N R 10 E

TYPE MONUMENT P.K.NAIL
ON SURFACE - ~~BELOW~~ ON
LEFT - ℄ PAV'T - ~~RIGHT~~ 10.9'
2.5' TO LT EDGE PAVEMENT
S.L.M. 860+16.18
Grid: Northing: 686902.808 Easting: 1649548.255

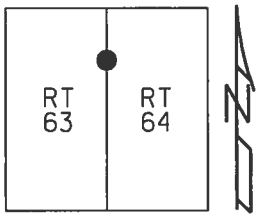

RECORD:
FD P.K./WASHER
11/5/84
FD P.K./WASHER
5/19/95, MB
SET P.K./WASHER
8/15/95, CL
FD P.K.NAIL
REFI26
9/24/12, SAH
FD P.K.NAIL
REFH26
8/19/14, EBW
SET MAG/WASHER
6/8/17, DCH

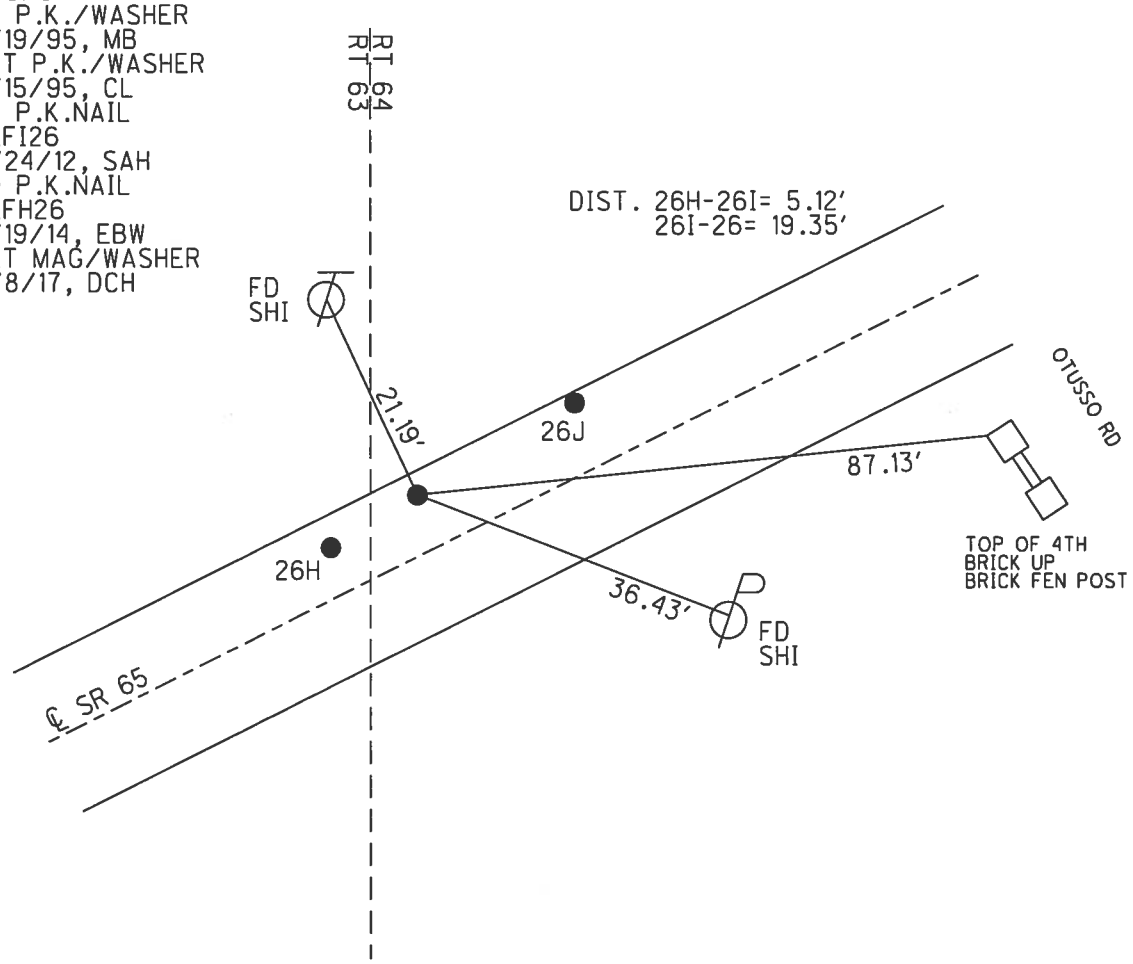

O.D.O.T. DISTRICT 2 SURVEY OFFICE

PERSONNEL

NOTES BARNHISEL
H.C. CROES
R.C. BARNHISEL

REFERENCE NO. _____

DATE 5-19-95
WEATHER SUNNY
TEMP. +75°

SHEET 77 OF 91

ROUTE S.R. 65
COUNTY PERRY
TOWNSHIP PERRYSBURG
SECTION 63 & 64
T 7 N R 10 E

TYPE MONUMENT PK WASHER (B & C) ~ SM RR SPIKE (A)
ON SURFACE - BELOW _____
LEFT - ℄ PAV'T. - RIGHT A = 12.0 B = 10.9' C = 9.7'
A = 9.7
B 9.4 C = 9.9 TO LT EDGE PAVEMENT
S.L.M. 858+29

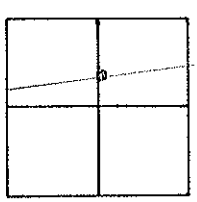

RECORD A:
P.I. STA = 857+89.62
Δ = 10°-20'-20" RT.
FD PK @ SURFACE
11-5-84

RECORD B:
FD PK WASHER
APPEARS TO BE ON BACK TANG.
11-5-84

RECORD C:
FD. PK WASHER
APPEARS TO BE ON BACK TANG.
& R.T. LINE
11-5-84

SET SM. RR. SPIKE ON PT A
SET PK/WASHER PT'S B & C
8-15-95
CL.

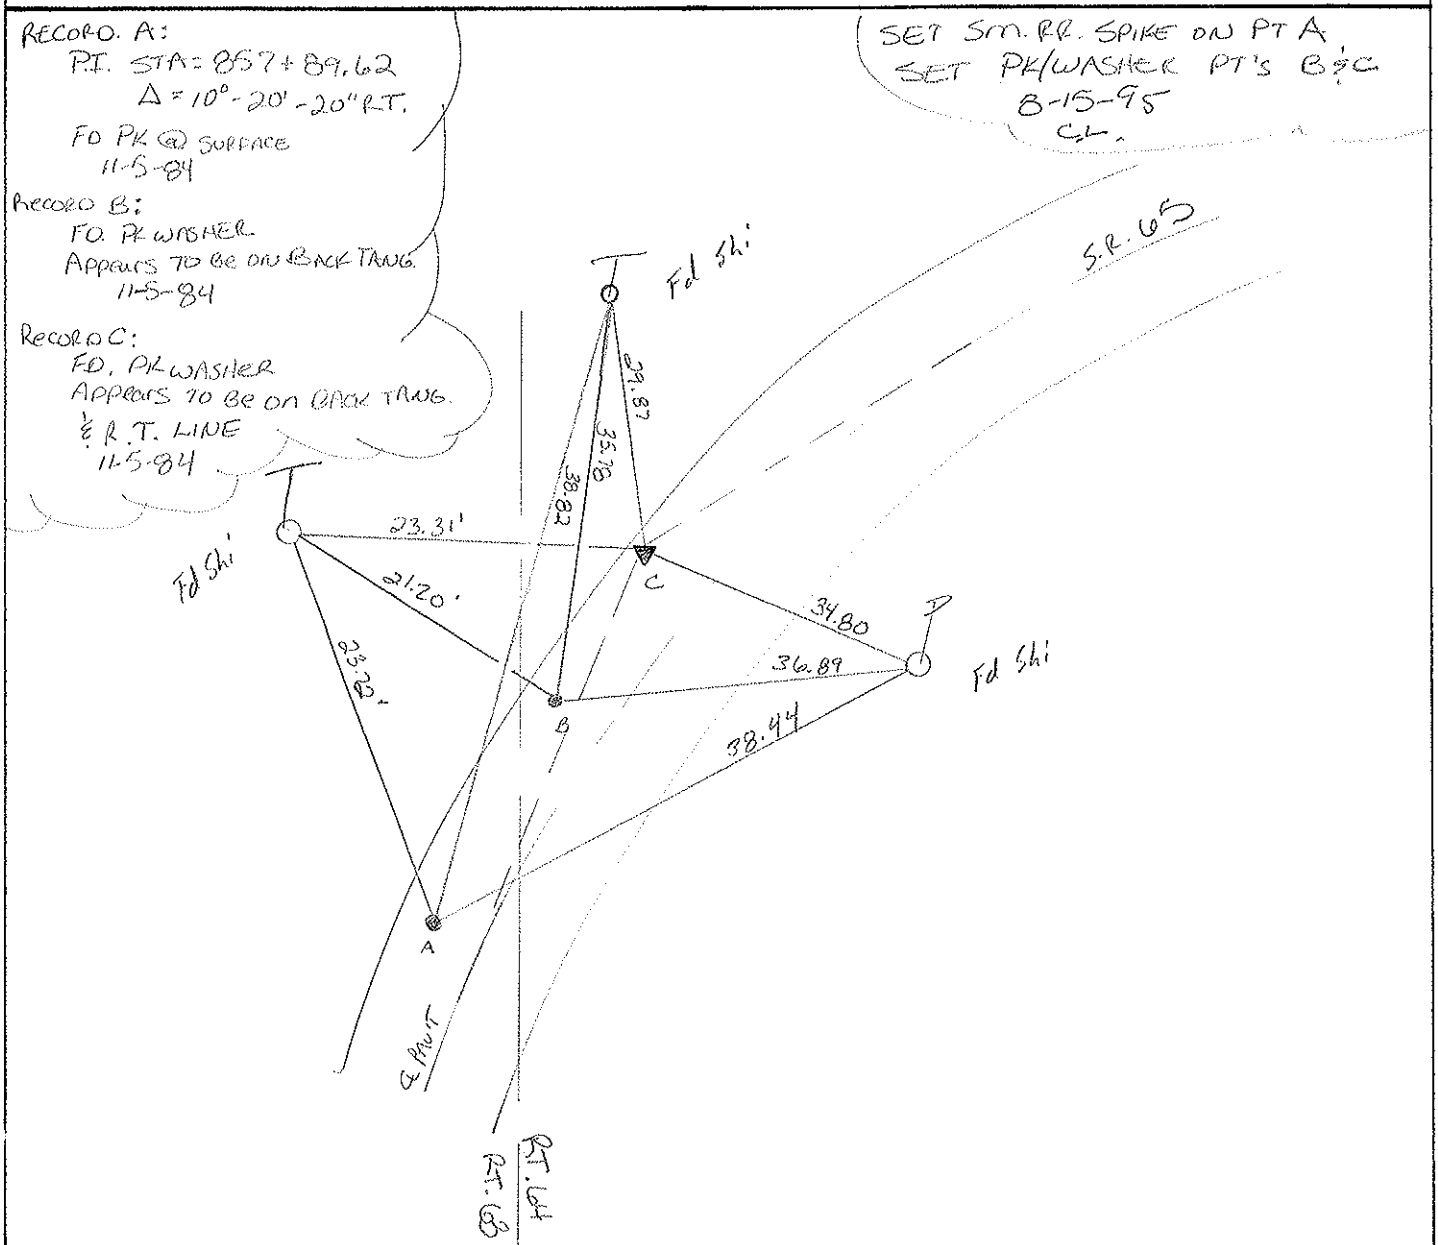

SMT-1

O.D.O.T. DISTRICT 2 SURVEY OFFICE

SHEET 77 OF 91

County WOOD S.R. 65
Township PERRYSBURG
Section R.T. 63
T 7N, R 10E
Personnel HOFFMAN
LOENRKE
HOUSEHOLDER
BARNHISEL

Date 5-10-84
Weather CLEAR
Temp. 50°

26-H
26-I
26-J

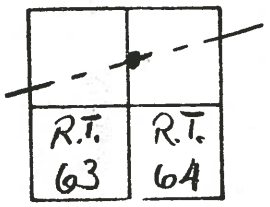

Ref # 26-E

"A" Fd P.K. @ ~~surface~~ WASHER 1" down + Set Small R.R. Spike
12.0 ~~12.9~~ ~~7.4~~ Lt. of ℄ Pavt
2.3 ~~2.5~~' to Lt. ℮P.
~~16.8' to Rt. ℮P.~~

SLM = ~~858+29~~

SET PK/WASHER @ Pt "A" + Pt "D"
SET PK @ Pt C
11-5-84
SW H
DID NOT SET "B" OR "E"

Record:
P.I. STA = 857+89.62
Δ = 10°-20'-20" Rt.

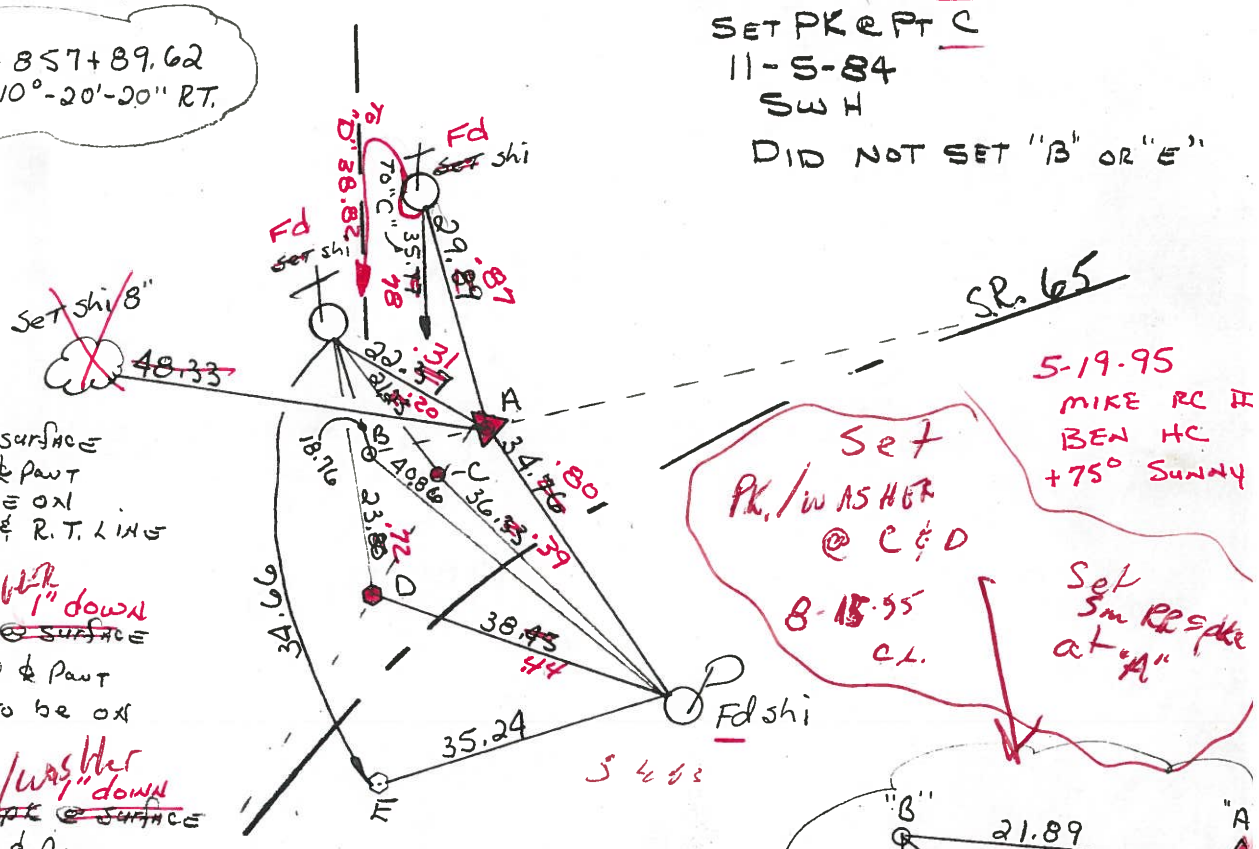

"B" Fd PK @ surface
9.5' Lt. of ℄ Pavt
APPEARS TO BE ON FWD TANG. & R.T. LINE

"B" PK/WASHER 1" down
~~10.9~~ ~~5.7~~' Lt. of ℄ Pavt
4.4 CT Edge APPEARS TO be on BACK TANG.

"C" Fd ~~R.R. Spk~~ P.K./WASHER 1" down @ ~~surface~~
9.7 ~~5.4~~ Lt. of ℄ Pavt
4.9 CT Edge APPEARS TO BE ON BACK TANG. & R.T. LINE

"E" Fd R.R. SPK @ surface APPEARS TO BE ON R.T. LINE ℄ PAVT

R.T. 64 / R.T. 63

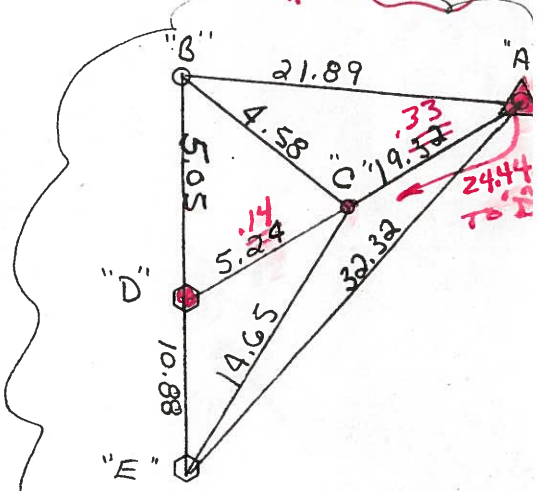

SMT-1

O.D.O.T. DISTRICT 2 SURVEY OFFICE

SHEET 77 OF 91

County WOOD S.R. 65
Township PERRYSBURG
Section R.T. 63
T 7N, R 10E
Personnel HOFFMAN
LOEHRKE
HOUSEHOLDER
BARNHISEL

Date 5-10-84
Weather CLEAR
Temp. 50°

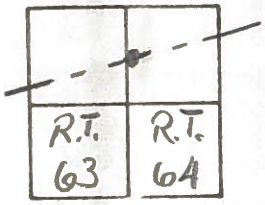

Ref # 26-E

26-H
26-I
26-J

"A" Fd P.K. @ surface
7.4' Lt. of & Pavt
2.5' to Lt. EP.
16.8' to Rt. EP.

Record!
P.I. STA = 857+89.62
Δ = 10°-20'-20" RT.

SLM = 858+29

SET PK/WASHER
@ Pt "A" + Pt "D"
SET PK @ Pt C
11-5-84
SWH
DID NOT SET "B" OR "E"

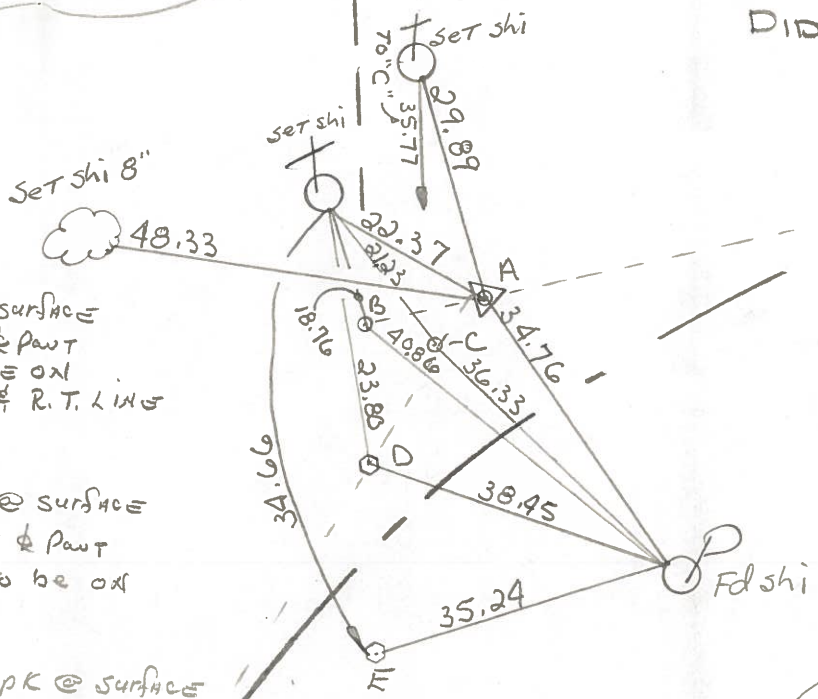

"B" Fd PK @ surface
9.5' Lt. of & Pavt
APPEARS TO BE ON
FWD TANG. & R.T. LINE

"C" Fd P.K. @ surface
5.7' Lt. of & Pavt
APPEARS TO be ON
BACK TANG.

"D" Fd R.R. spk @ surface
5.4' Lt. of & Pavt
APPEARS TO be ON
BACK TANG. &
R.T. LINE

"E" Fd R.R. spk
@ surface
APPEARS TO
BE ON
R.T. LINE

PAVT
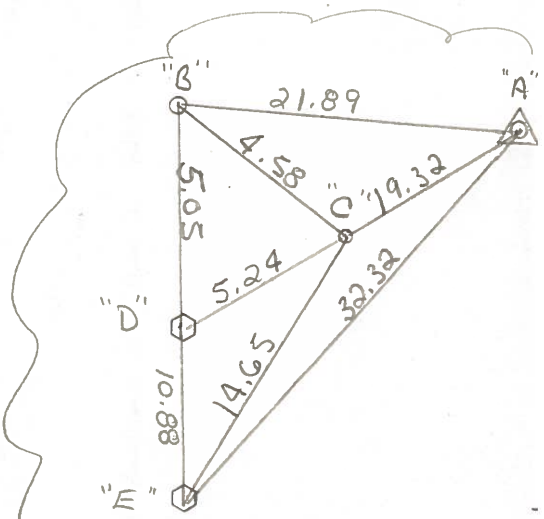
R.T. 64
R.T. 63