

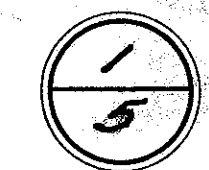


FED AID DIST. NO.	STATE	FED AID PROJ. NO.	FISCAL YEAR
	OHIO		1931

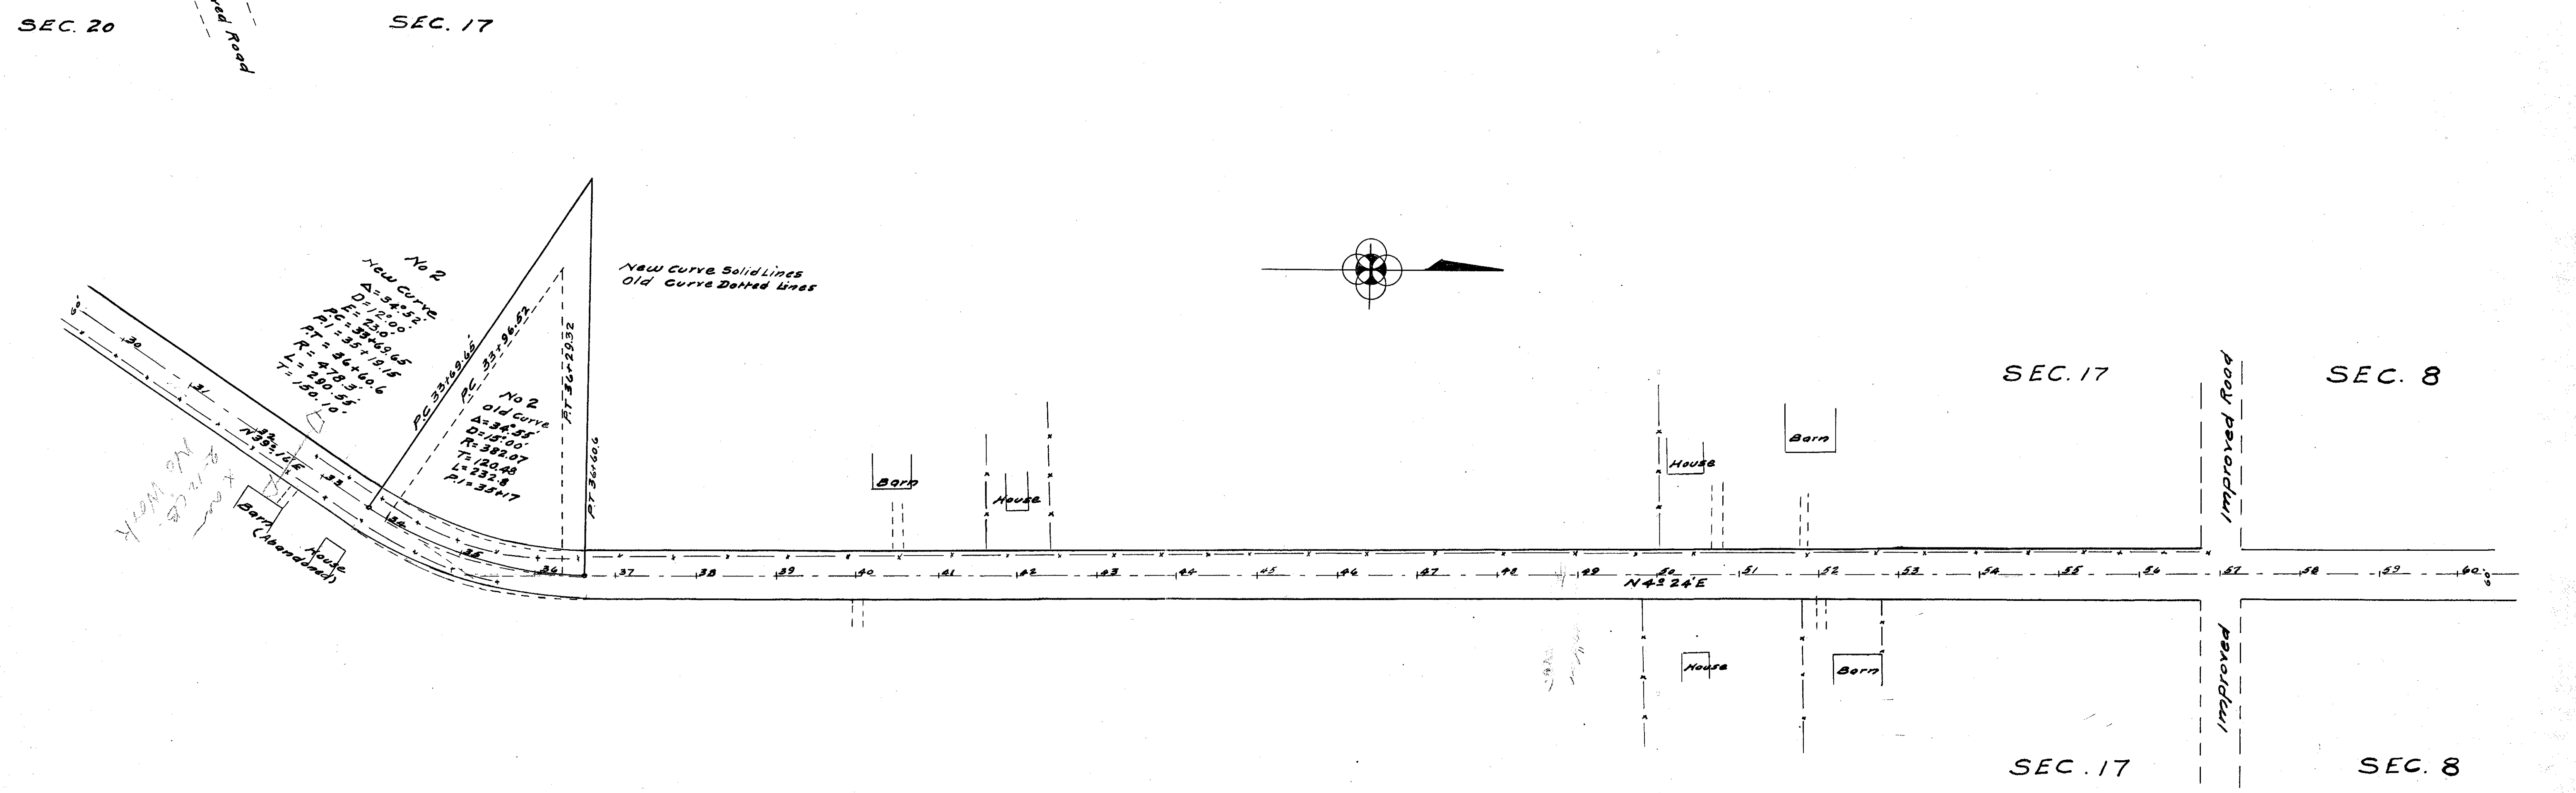


S.H.(C.H.) 273 SEC "F"
WOOD COUNTY
R.J.W. PLANS

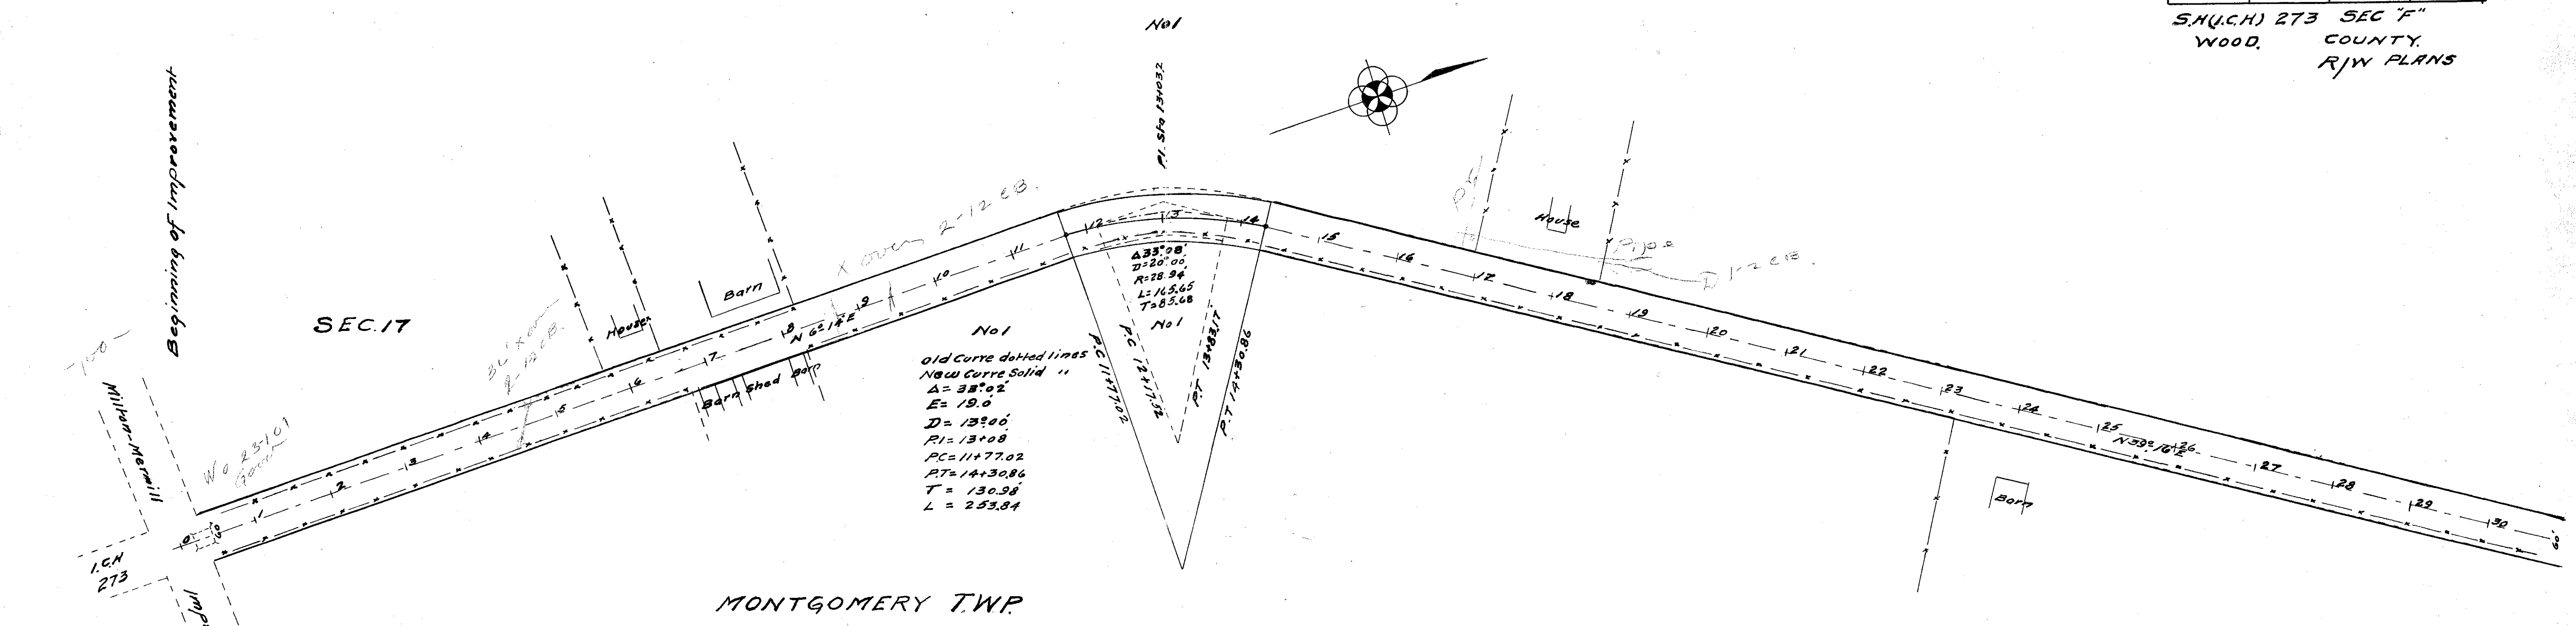

RBMW #2 0-74

FED AID DIST. NO	STATE	FED AID PROJ. NO	FISCAL YEAR
	OHIO		1931



SH.(U.C.H) 273 SEC "F"
WOOD COUNTY
R/W PLANS

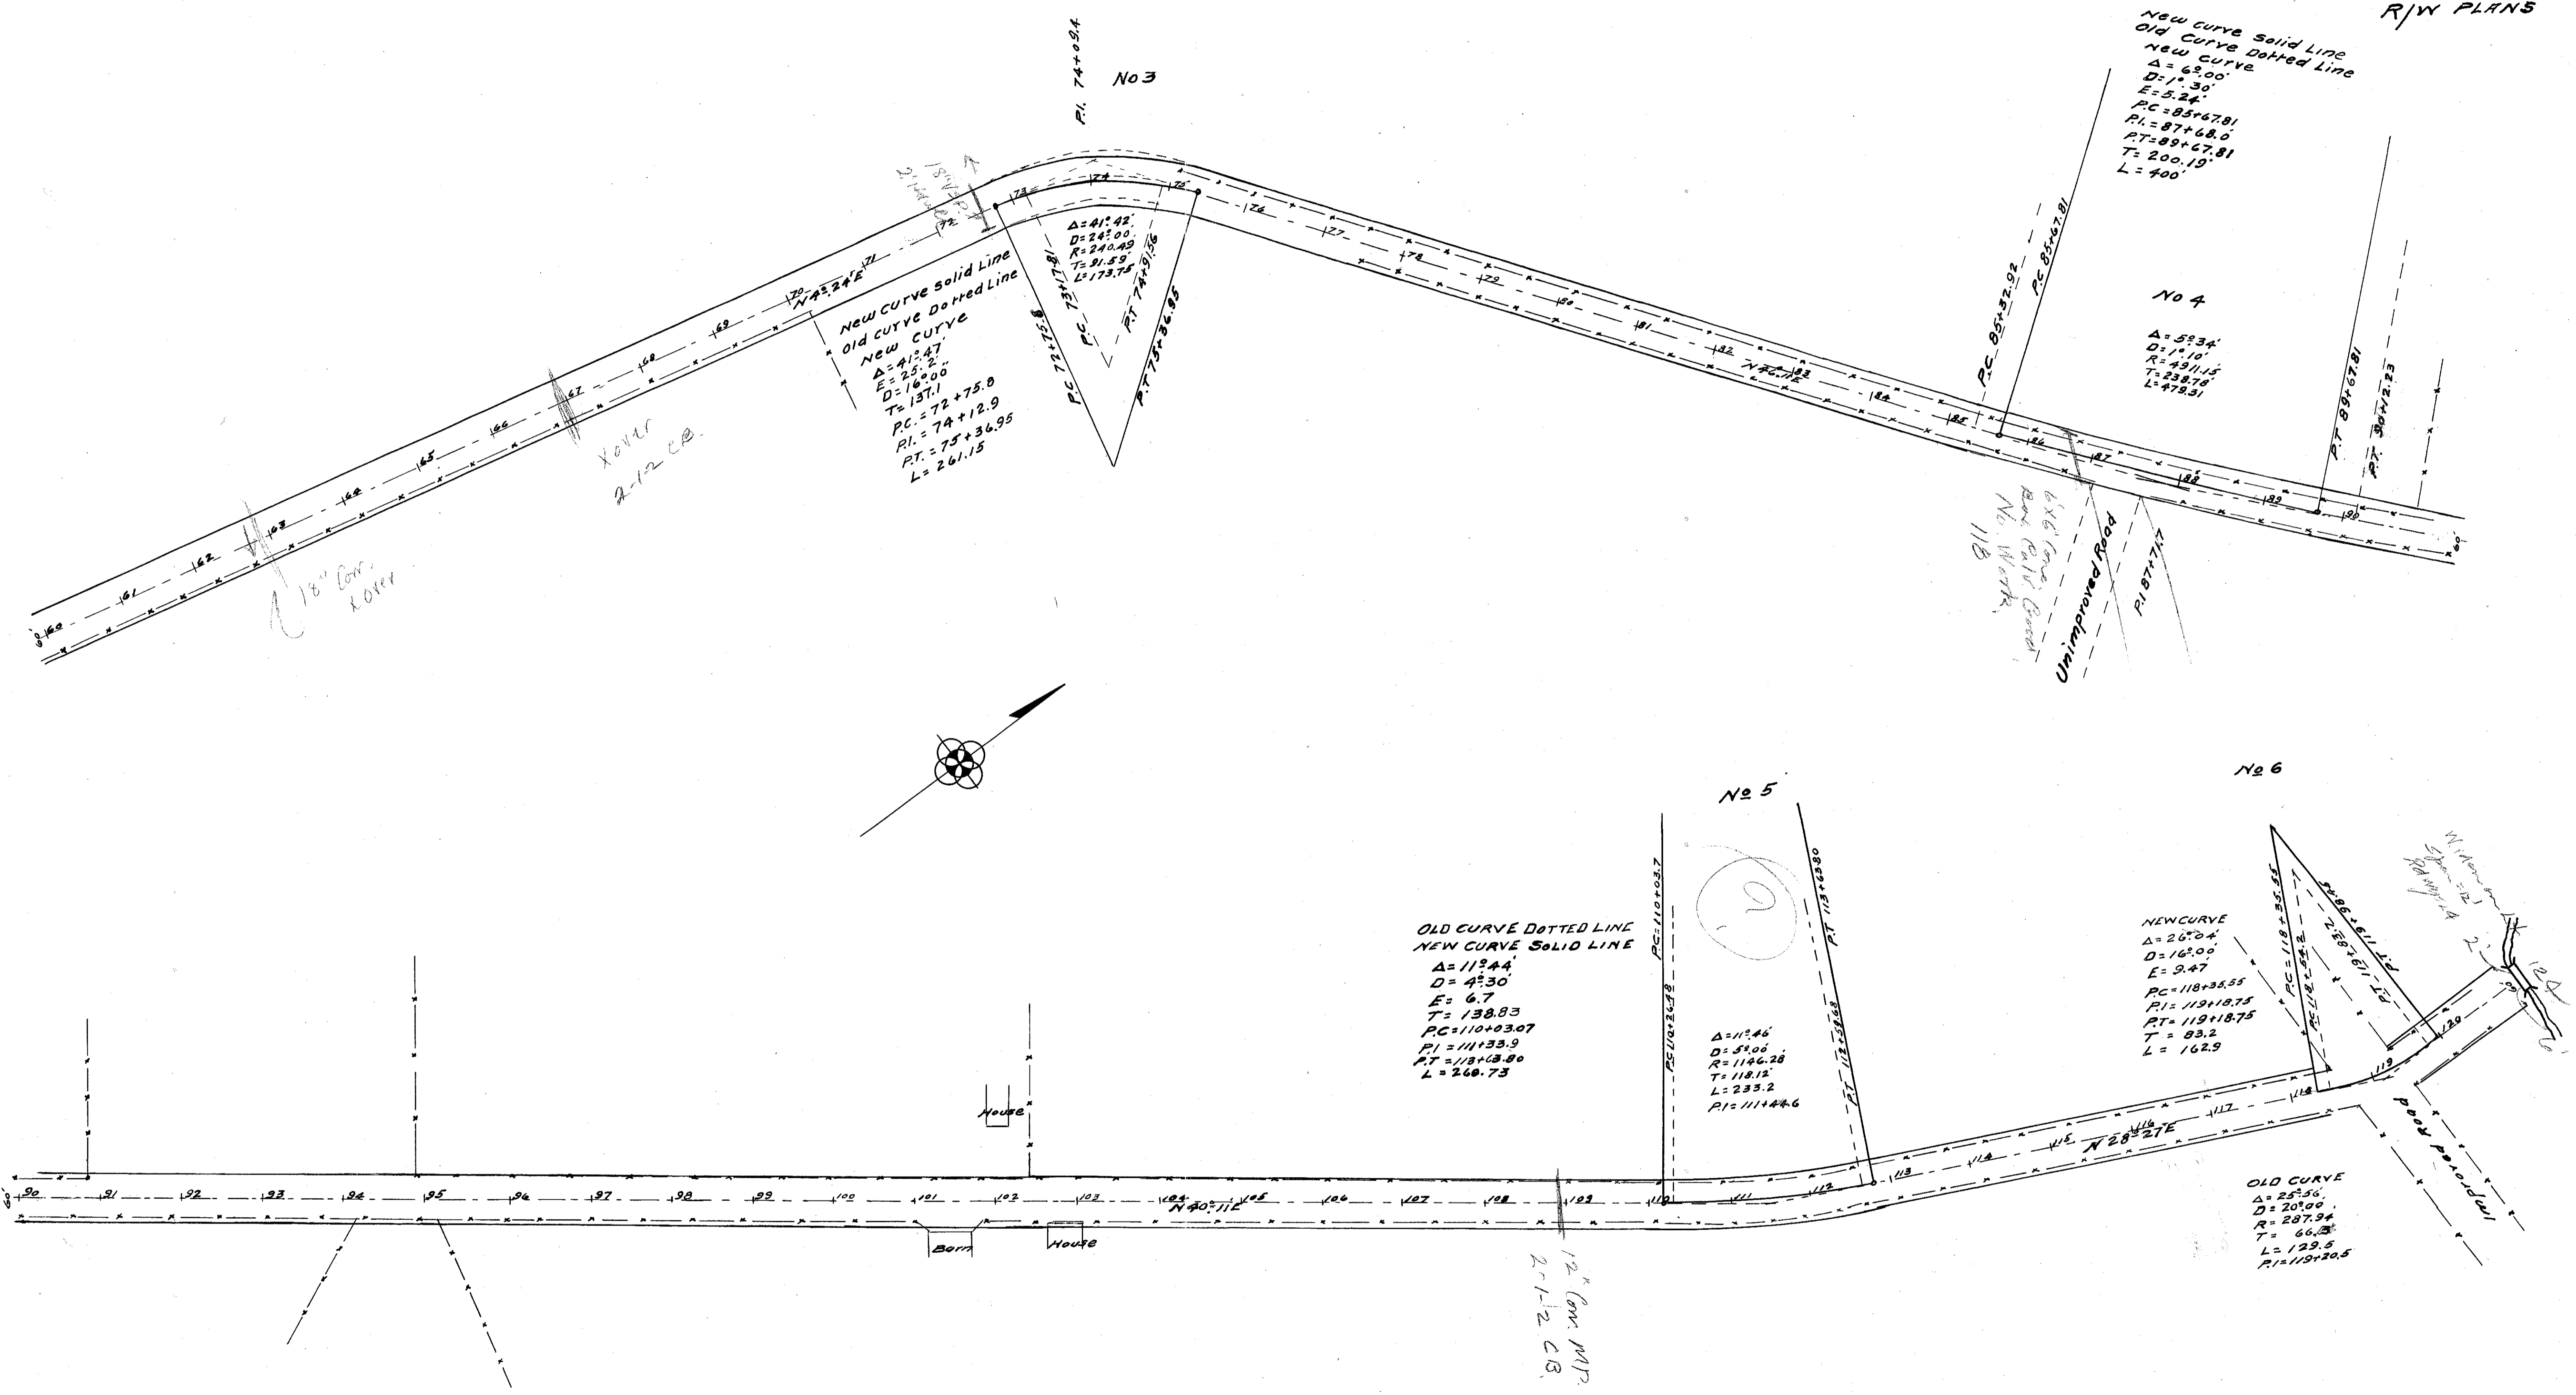

FED. AID DIST. NO.	STATE	FED. AID PROJ. NO.	FISCAL YEAR
	OHIO		1931

3
5



S.H. (I.C.H.) 273 SEC F
WOOD COUNTY
R/W PLANS

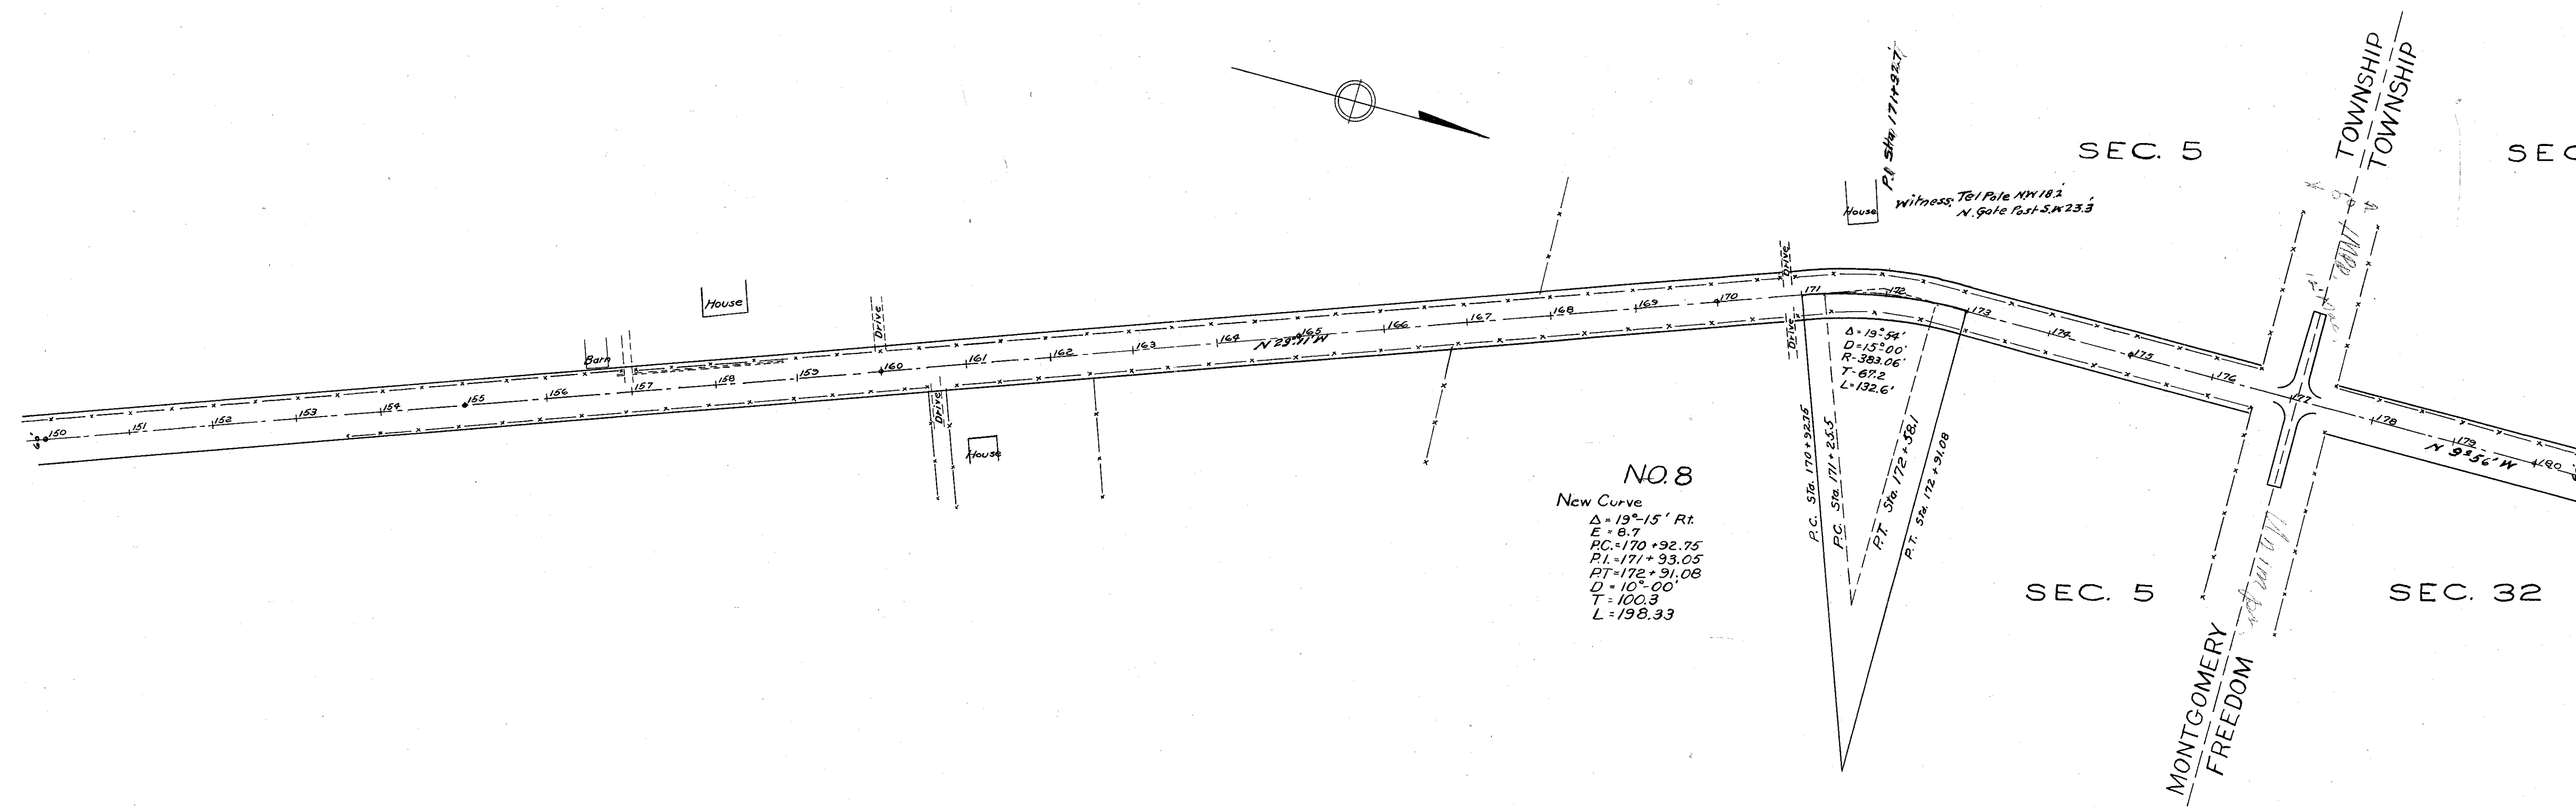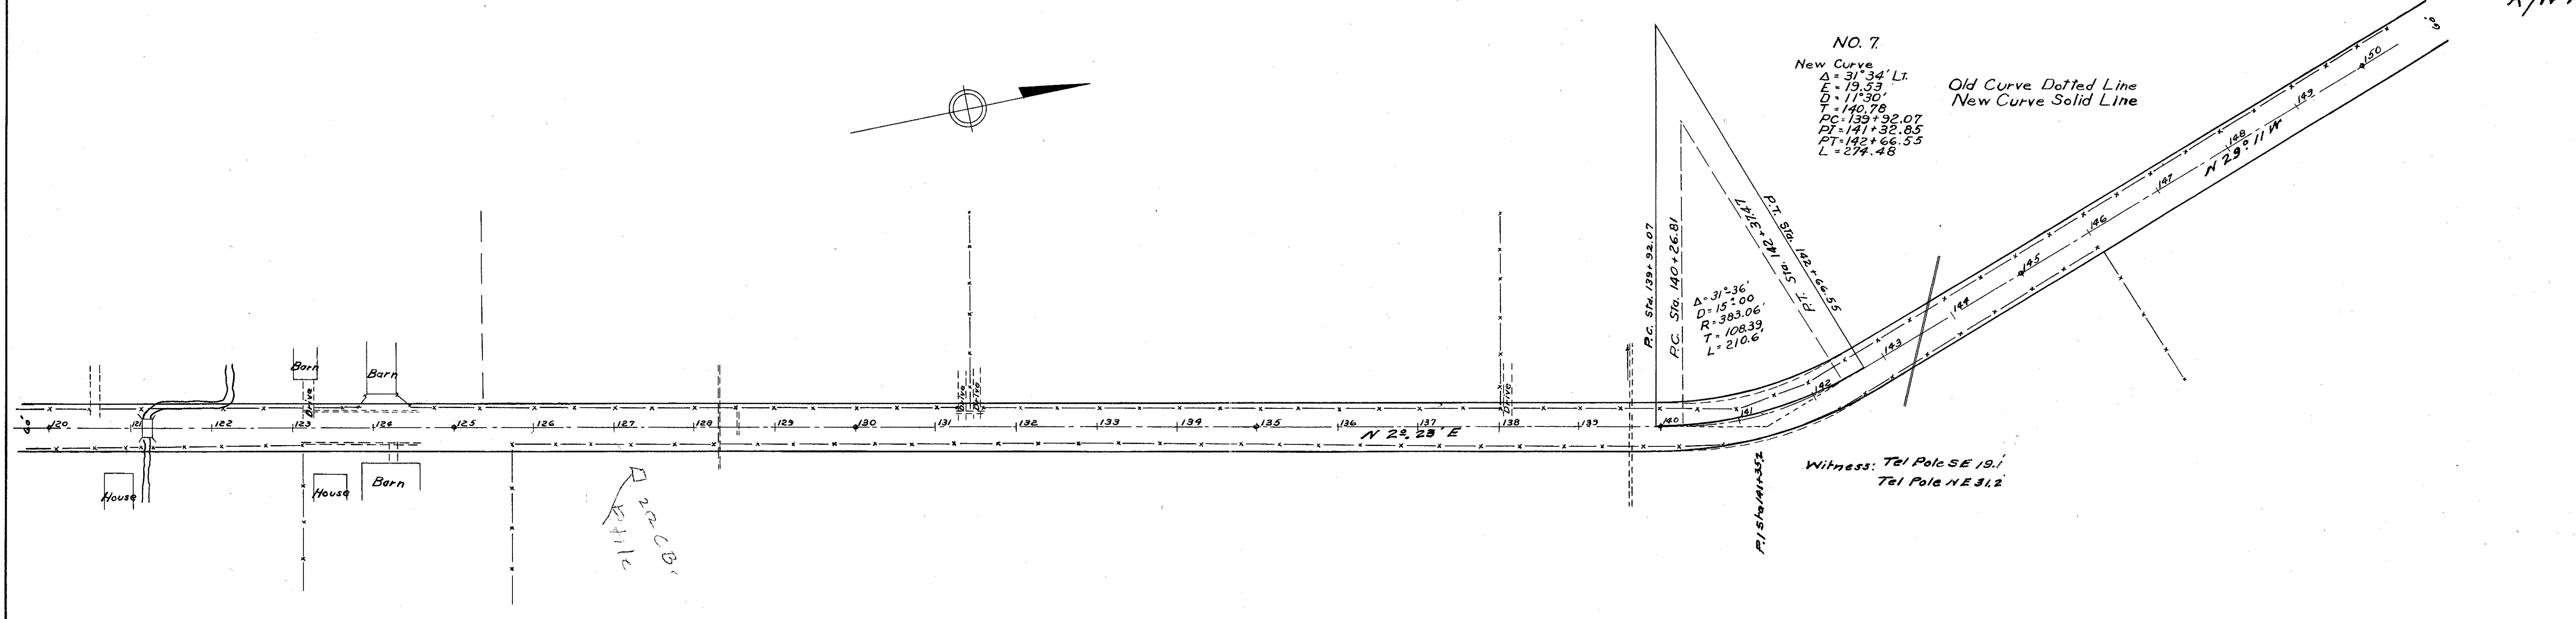

FED. AID DIST. NO.	STATE	FED. AID. PROS. NO.	FISCAL YEAR
	OHIO		1931

4
5

S.H. (I.C.H.) 273 SEC. F
WOOD COUNTY
R/W PLANS

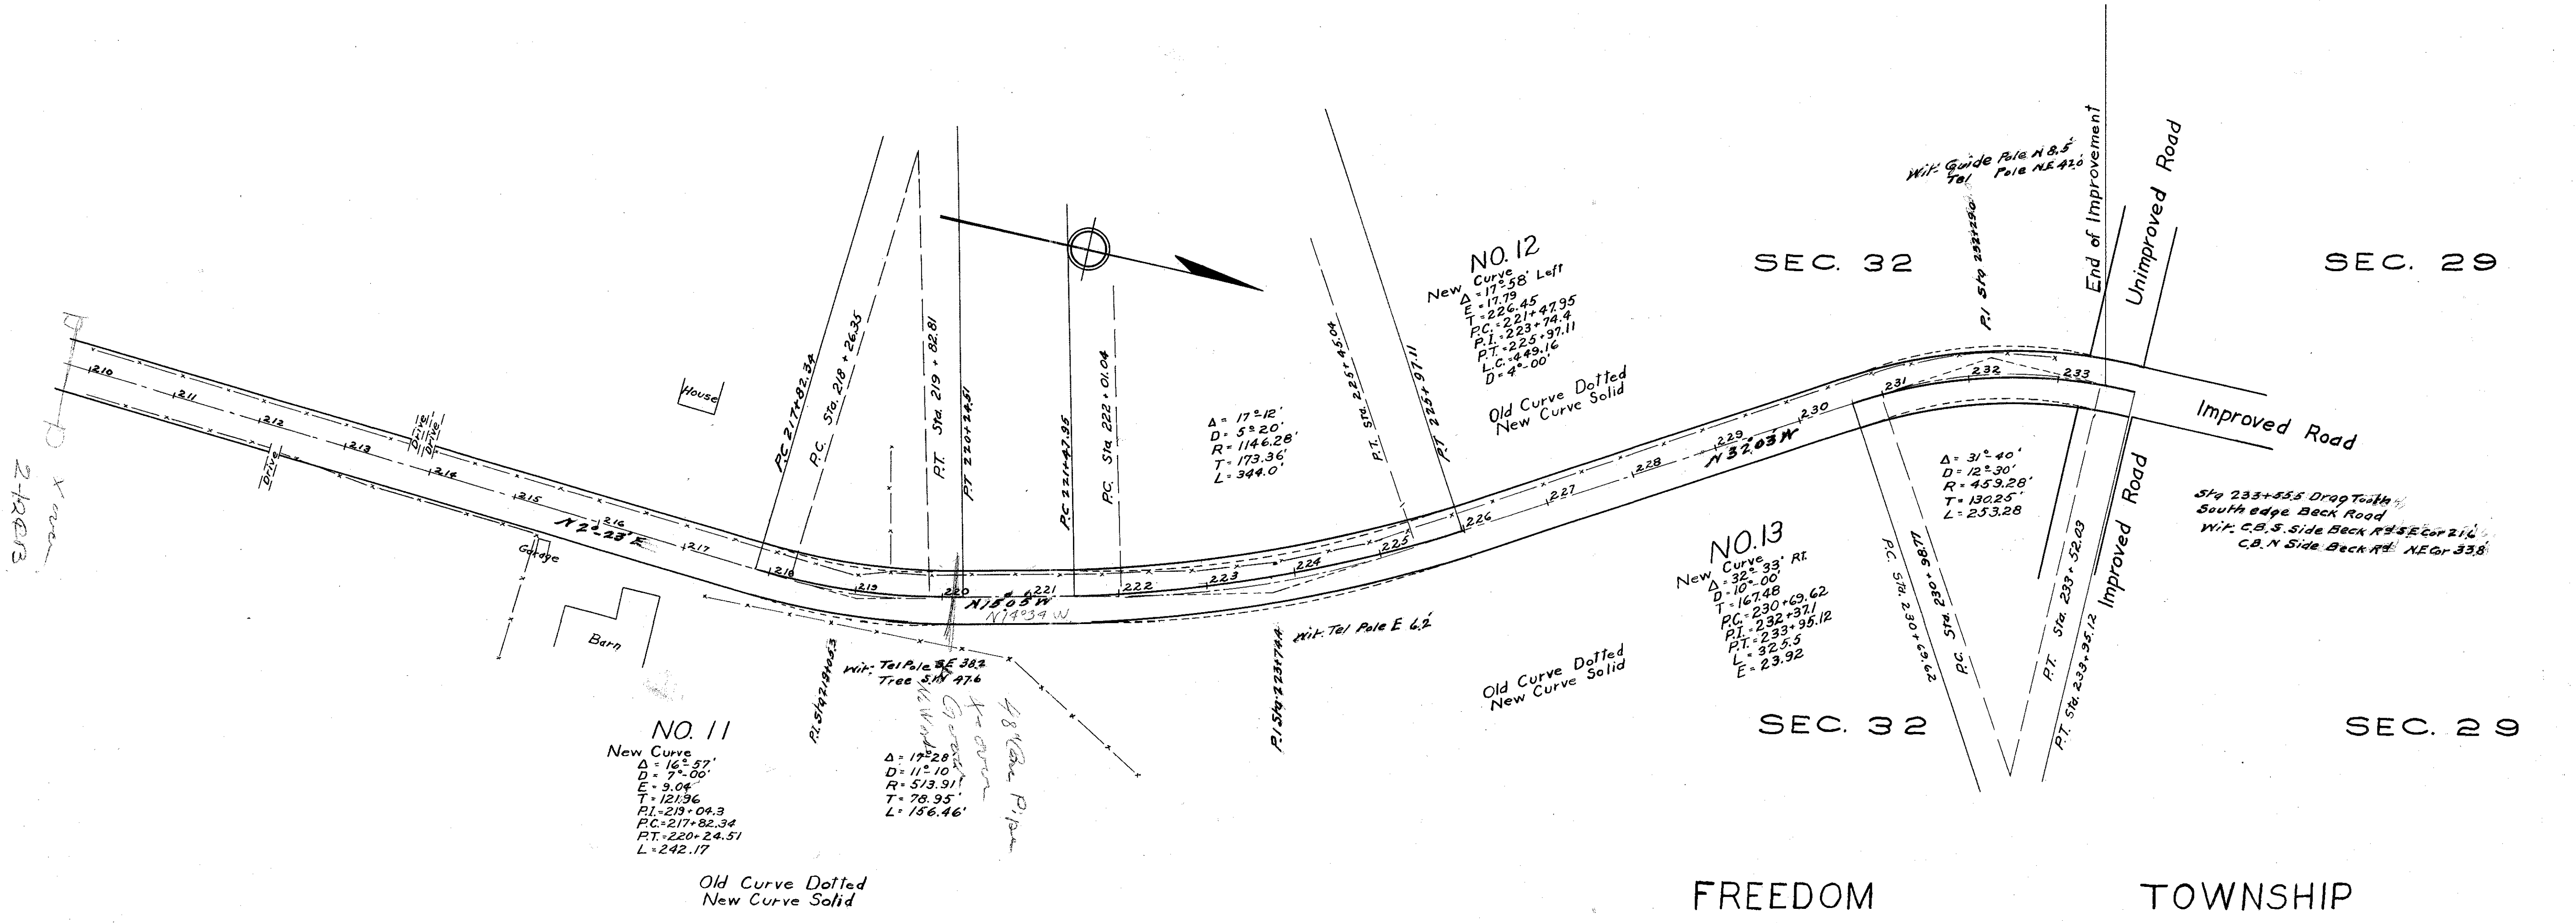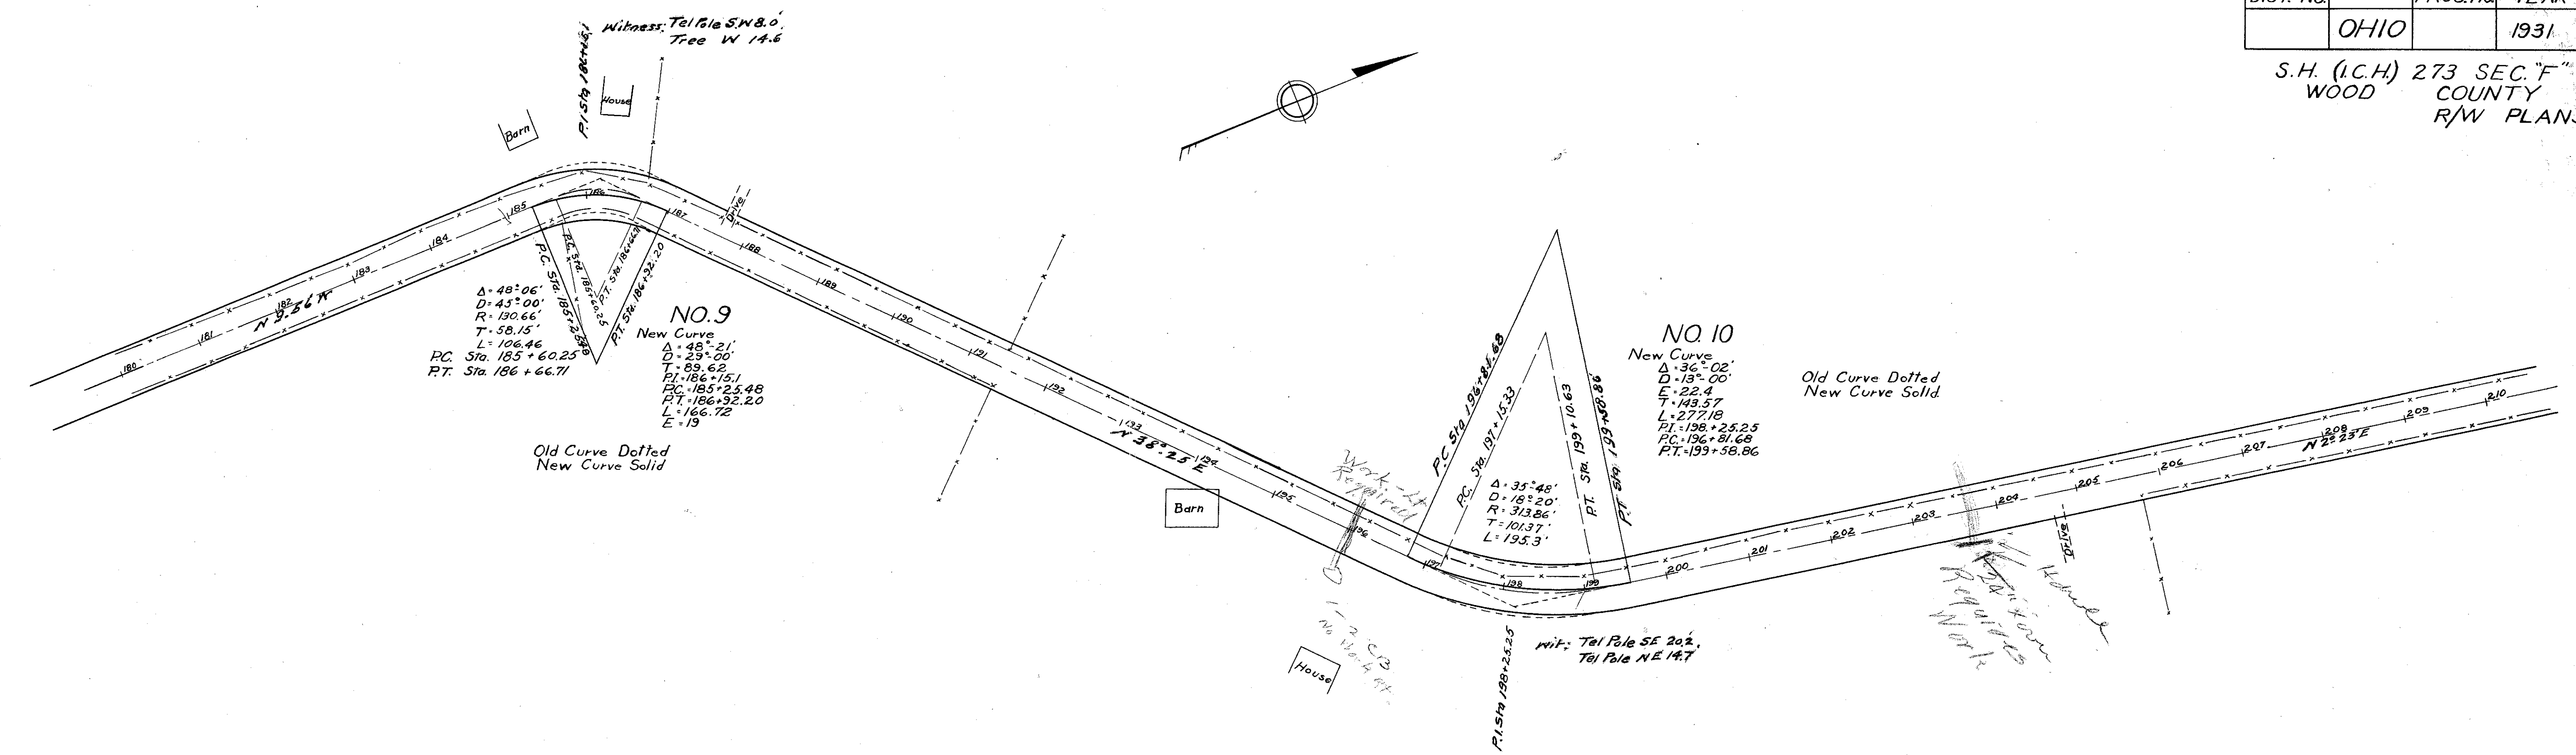


FREEDOM

TOWNSHIP

FED. AID DIST. NO.	STATE	FED. AID PROJ. NO.	FISCAL YEAR
	OHIO		1931

5
5

1/4 CH (NO 278) SEC "H"
WOOD COUNTY R/W PLANS

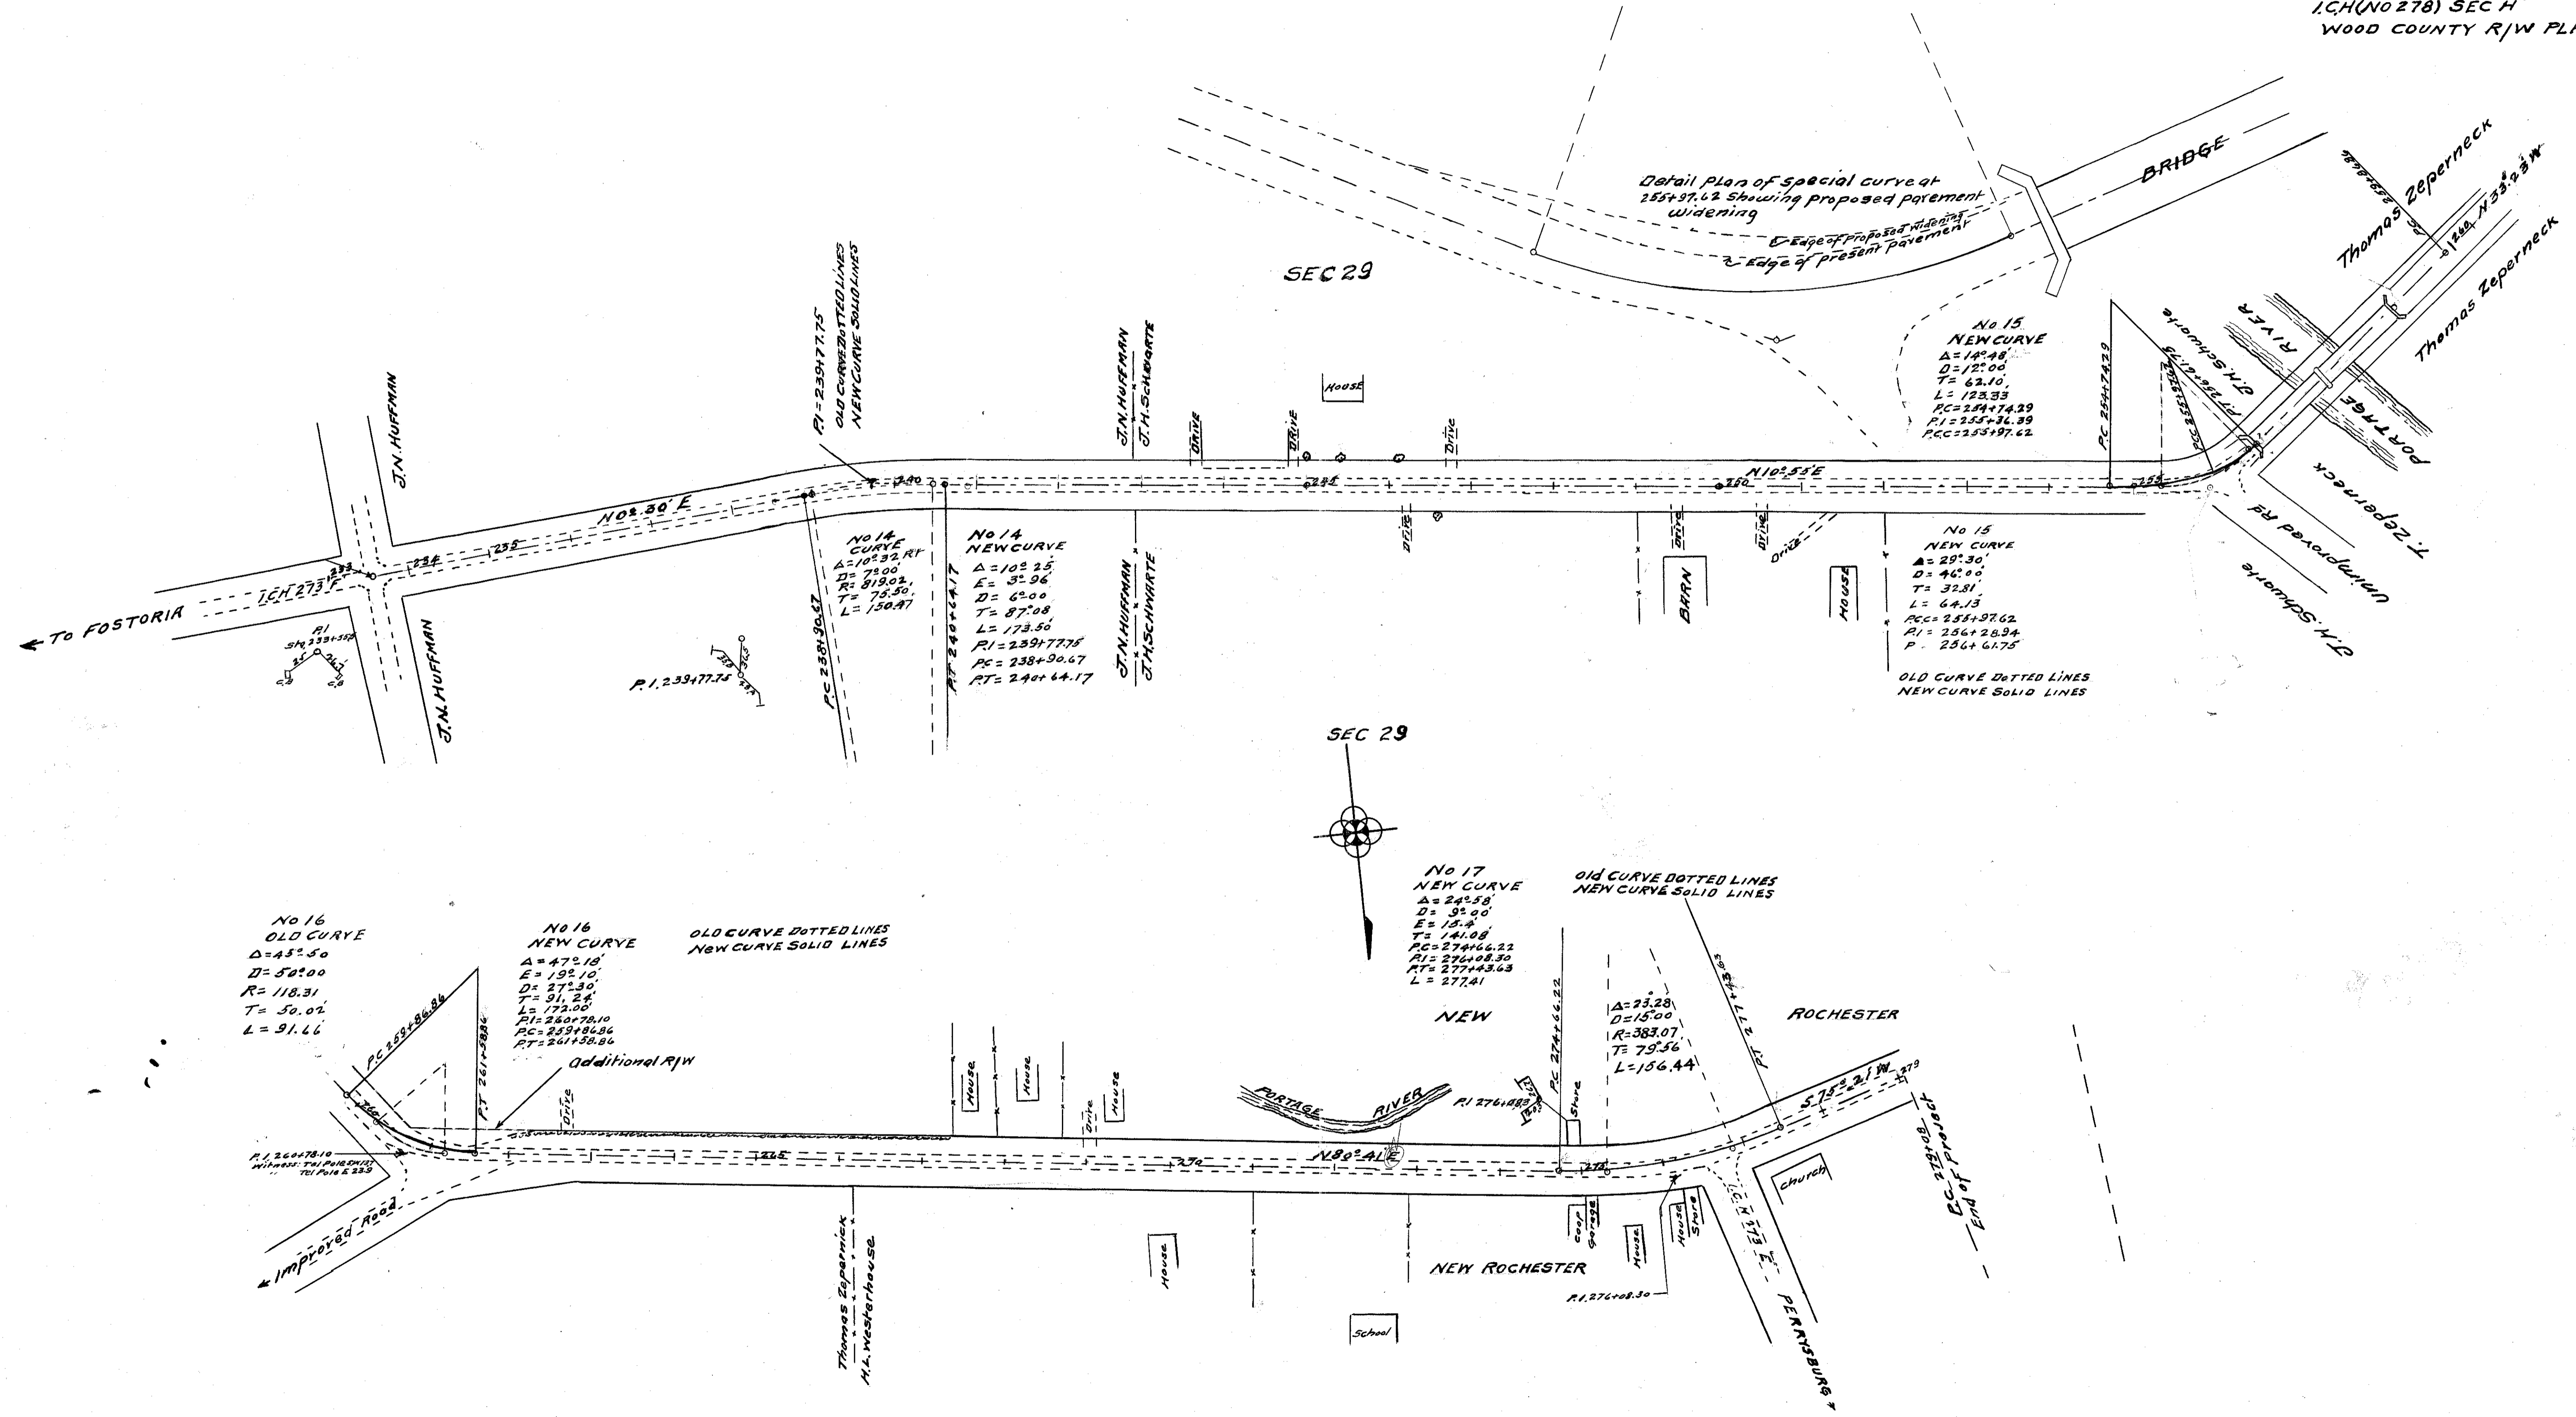

Detail Plan of special curve at
255+97.62 showing proposed pavement
widening
Edge of proposed pavement
Edge of present pavement

No 15
NEW CURVE
 $\Delta = 14.48^\circ$

No 15
NEW CURVE
 $\Delta = 29.30^\circ$
 $D = 46.00$
 $T = 32.81$
 $L = 64.13$

OLD CURVE DOTTED LINES
NEW CURVE SOLID LINES

No 17
NEW CURVE
 $\Delta = 24.58^\circ$
 $L = 277.41$

OLD CURVE DOTTED LINES
NEW CURVE SOLID LINES

No 16
OLD CURVE
 $\Delta = 45.50^\circ$
 $D = 50.00$
 $R = 118.31$
 $T = 50.02$
 $L = 91.66$

No 16
NEW CURVE
 $\Delta = 47.18^\circ$


OLD CURVE DOTTED LINES
NEW CURVE SOLID LINES

Additional R/W

FED. AID DIST. NO.	STATE	FED. AID PROJ. NO.	FISCAL YEAR
	OHIO		1931

5
6

I.C.H. (NO 278) SEC "H"
WOOD COUNTY R/W PLANS

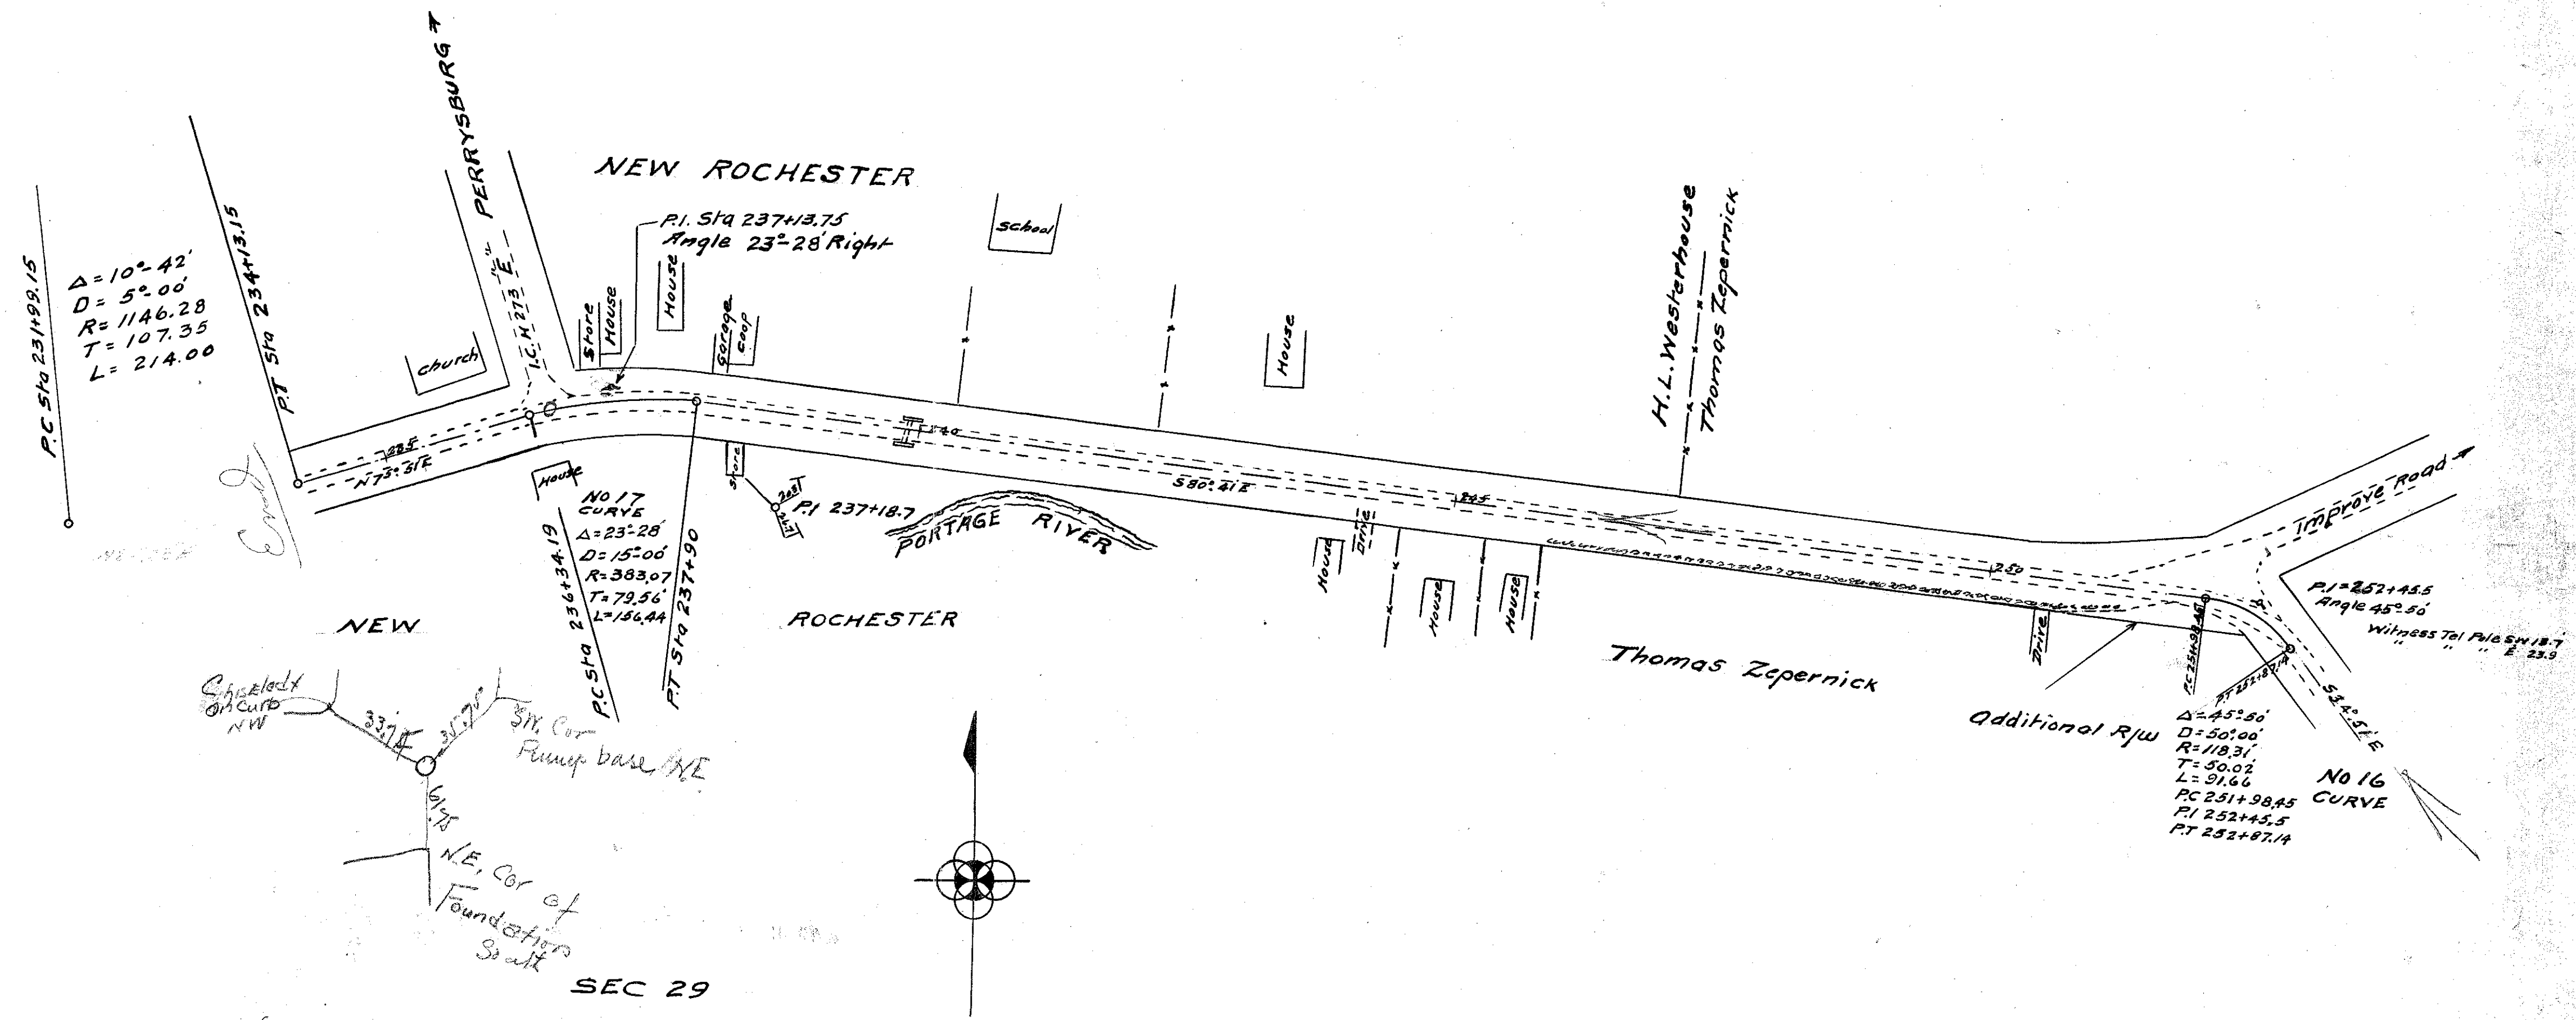

D-1