O.D.O.T. DISTRICT 2 SURVEY OFFICE (USE ONLY)

PERSONNEL

NOTES RHOADES
H.C. CODER
R.C. ROUSOS

REFERENCE NO. 7
DATE 5-6-13
WEATHER FAIR
TEMP. 65°

SHEET 10 OF 24
ROUTE SR 199
COUNTY WOOD
TOWNSHIP PERRY
SECTION 23
T 3 N R 12 E

TYPE MONUMENT P.K./WASHER
ON SURFACE - ~~BELOW~~ ON
LEFT - ℄ PAV'T - ~~RIGHT~~ 0.8'
- TO - EDGE PAVEMENT
S.L.M. 154+54.22
Grid: Northing: 561134.193 Easting: 1708141.238

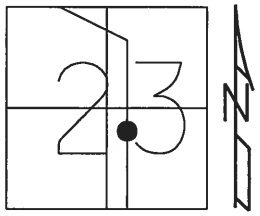

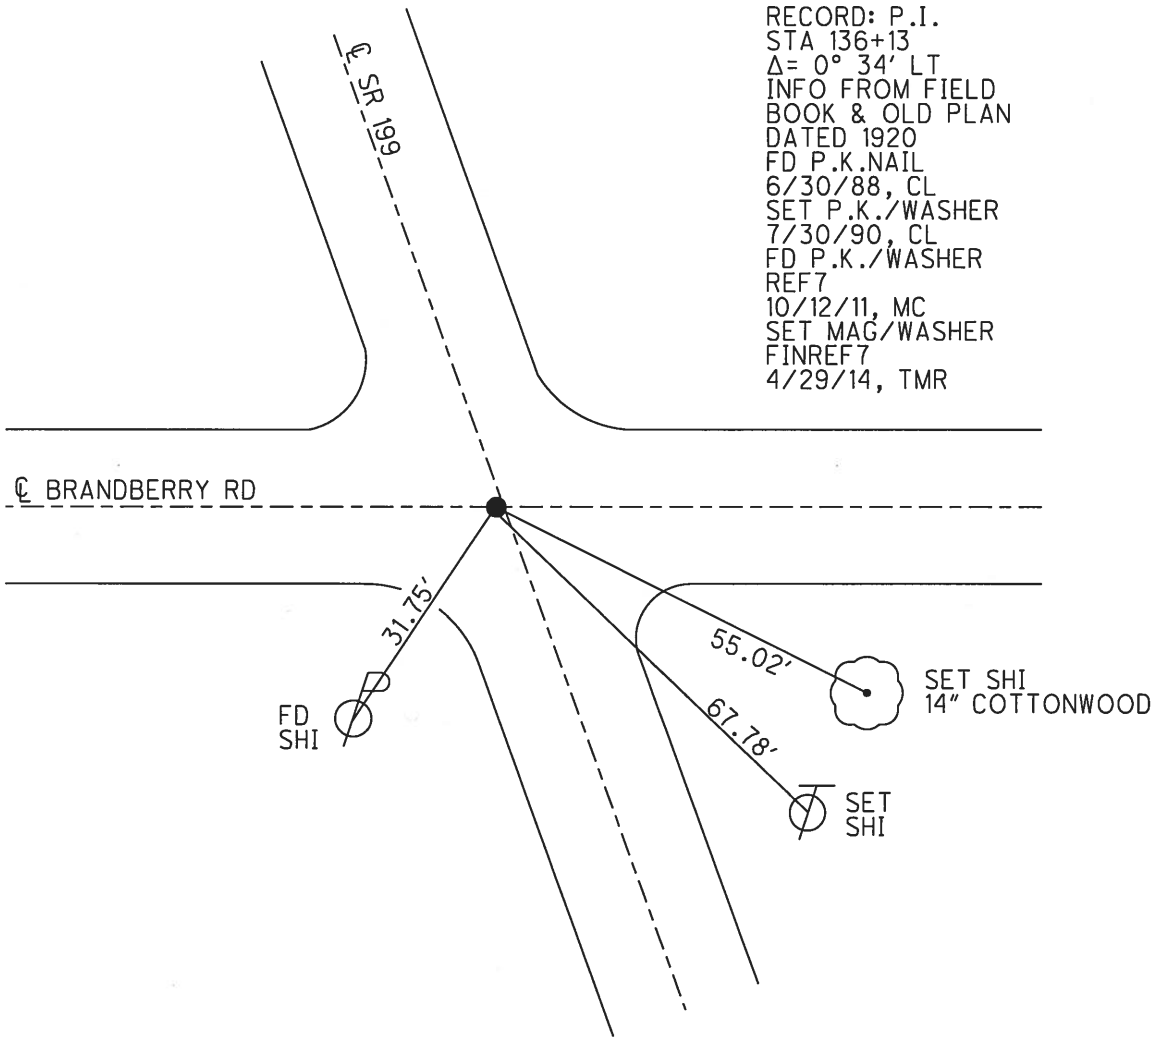

RECORD: P.I.
STA 136+13
Δ= 0° 34' LT
INFO FROM FIELD
BOOK & OLD PLAN
DATED 1920
FD P.K.NAIL
6/30/88, CL
SET P.K./WASHER
7/30/90, CL
FD P.K./WASHER
REF7
10/12/11, MC
SET MAG/WASHER
FINREF7
4/29/14, TMR

O.D.O.T. DISTRICT 2 SURVEY OFFICE

PERSONNEL

NOTES Loehrke
H.C. Barnhisel
R.C. Reed

REFERENCE NO. 7

DATE 6-30-88
WEATHER Clear
TEMP. H65

SHEET ____ OF ____

ROUTE 199
COUNTY Wood
TOWNSHIP Perry
SECTION 23
T 3 N R 12 E

TYPE MONUMENT P.K. NAIL
ON SURFACE - BELOW
LEFT - ℄ PAV'T. - RIGHT 0.8
TO EDGE PAVEMENT
S.L.M. 152+59

Set PK & WASHER
7-30-90
C.L.

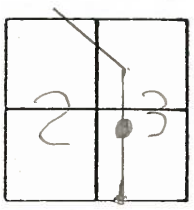

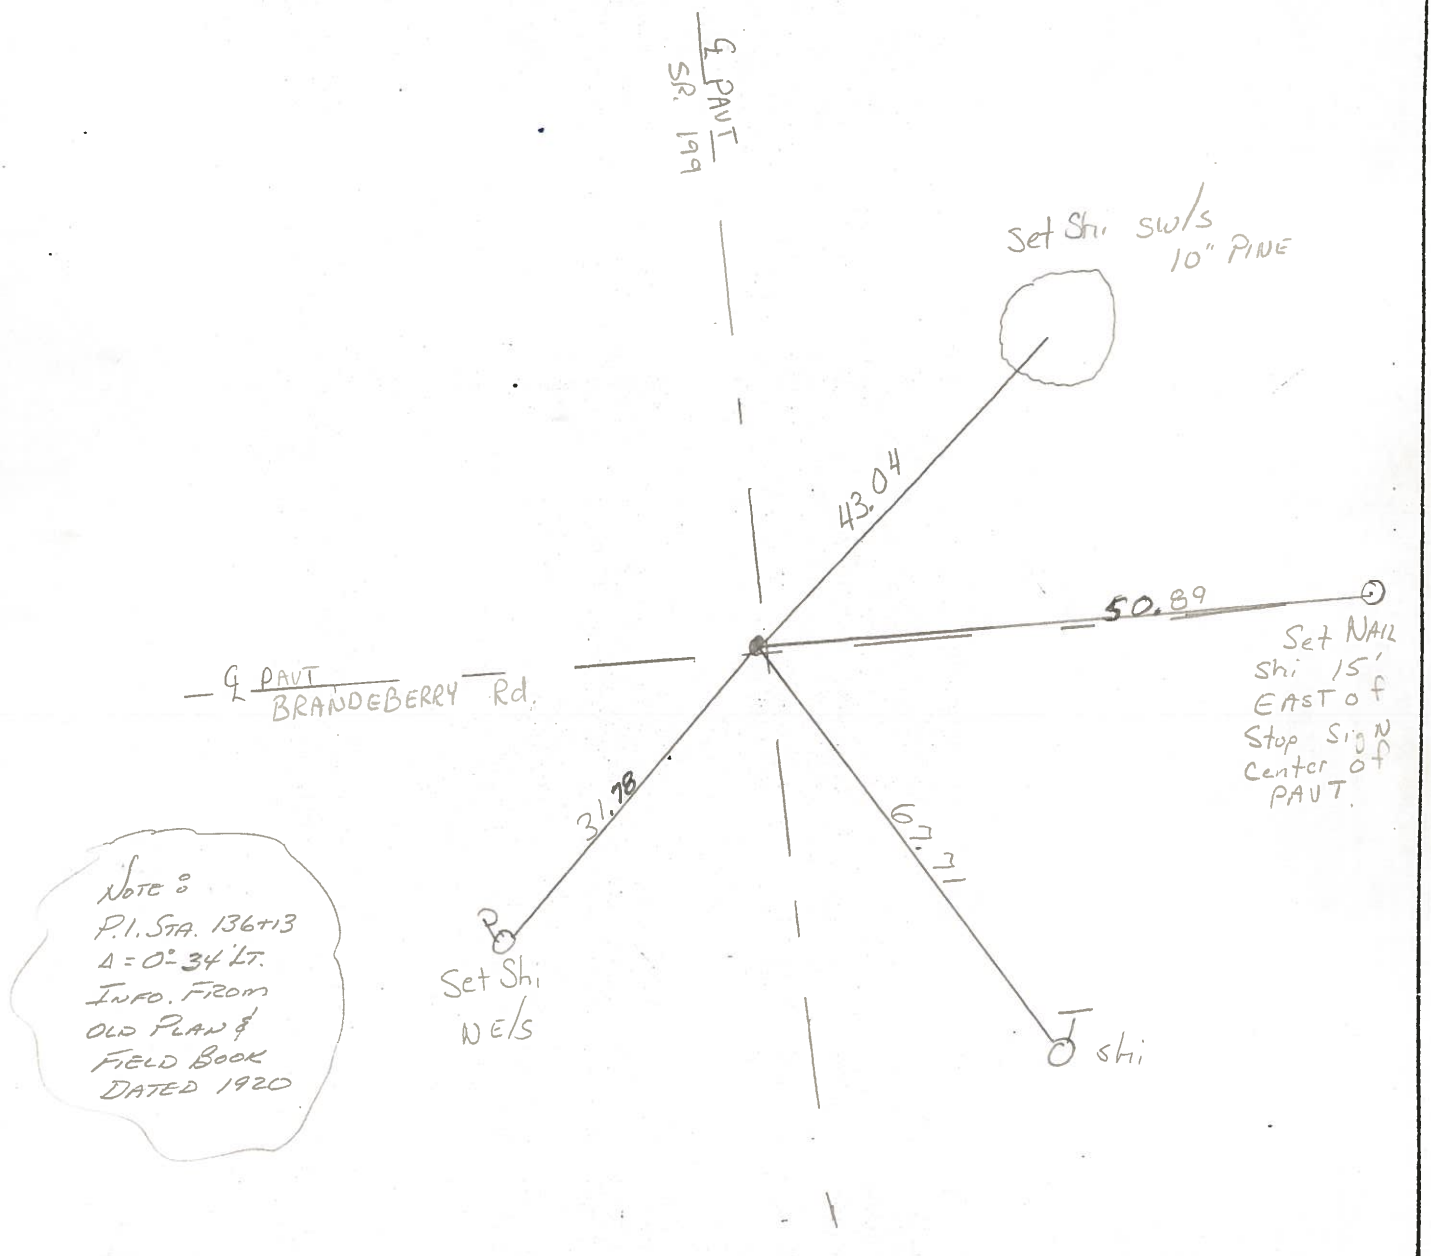

O.D.O.T. DISTRICT 2 SURVEY OFFICE

SHEET 8 OF

County WOOD S.R. 199
Township PERRY
Section 23
T__N, R__E
Personnel BURNSIDE
SMITH
BOWER

Date 3-27-72 (5-9-80) CHKD.
Weather
Temp.

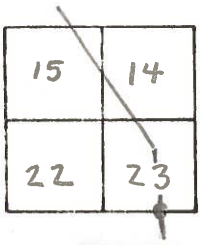

#7

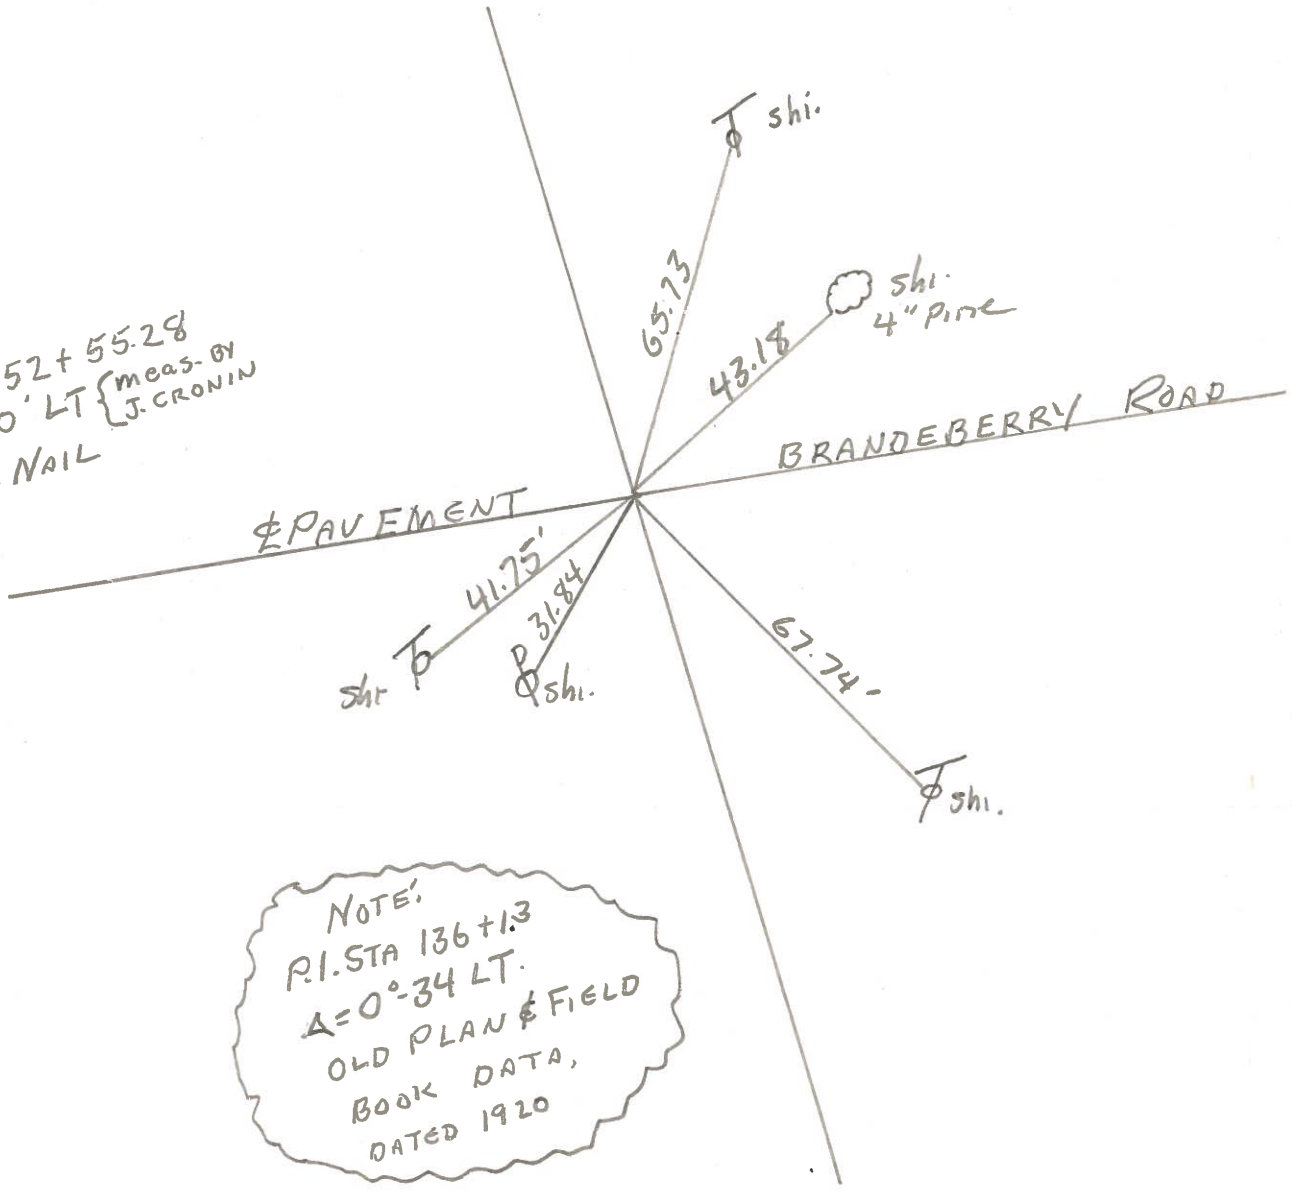

NOTE:
P.I. STA 136+1.3
Δ=0°-34 LT.
OLD PLAN & FIELD
BOOK DATA,
DATED 1920

LD-5—(25M—2-59)

COPIED

SHEET NO. 8

OK-5-9-80

PERSONNEL	TITLE	PERSONNEL	TITLE
BURNSIDE			
SMITH			

COUNTY WOOD DATE 3-27-72

S. R. 199 WEATHER CLEAR

SEC. TEMP. 50°

DESCRIPTION P.I. @ BRANDEBERRY ROAD JOB NO.

LEFT CENTER LINE RIGHT

#1

P.I. STA. 152+55.23
Δ = 0°-30' LT. {MEA. BY CRONIN
FD. P.K. NAIL

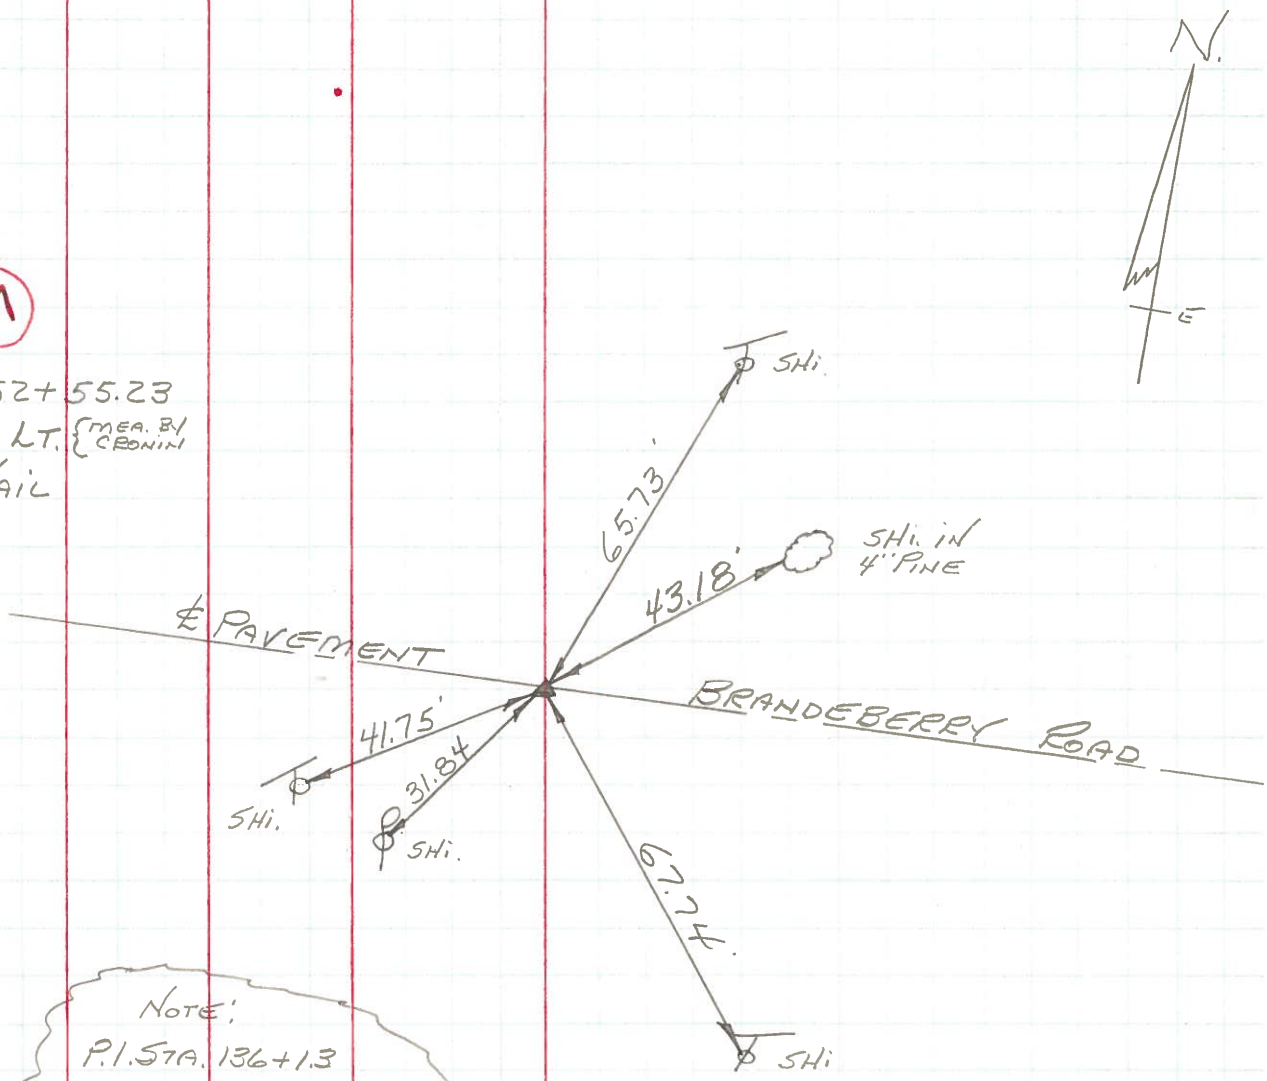

NOTE:
P.I. STA. 136+1.3
Δ = 0°-24' LT.
OLD PLAN & FIELD
BOOK DATA:
DATED 1920