


ERI-US 0006-CONNECTIVITY CORRIDOR

MODEL: CLP_SUP 1 - Plan 1-2 [Sheet] PAPER SIZE: 34x22 (in.) DATE: 6/9/2025 TIME: 11:52:16 AM USER: adlayton
pw:\ohiodot-pw.bentley.com\ohiodot-pw-02\Documents\01 Active Projects\District 03\Err\116570\402-Engineering_MOT\Sheets\116570_MP002.dgn

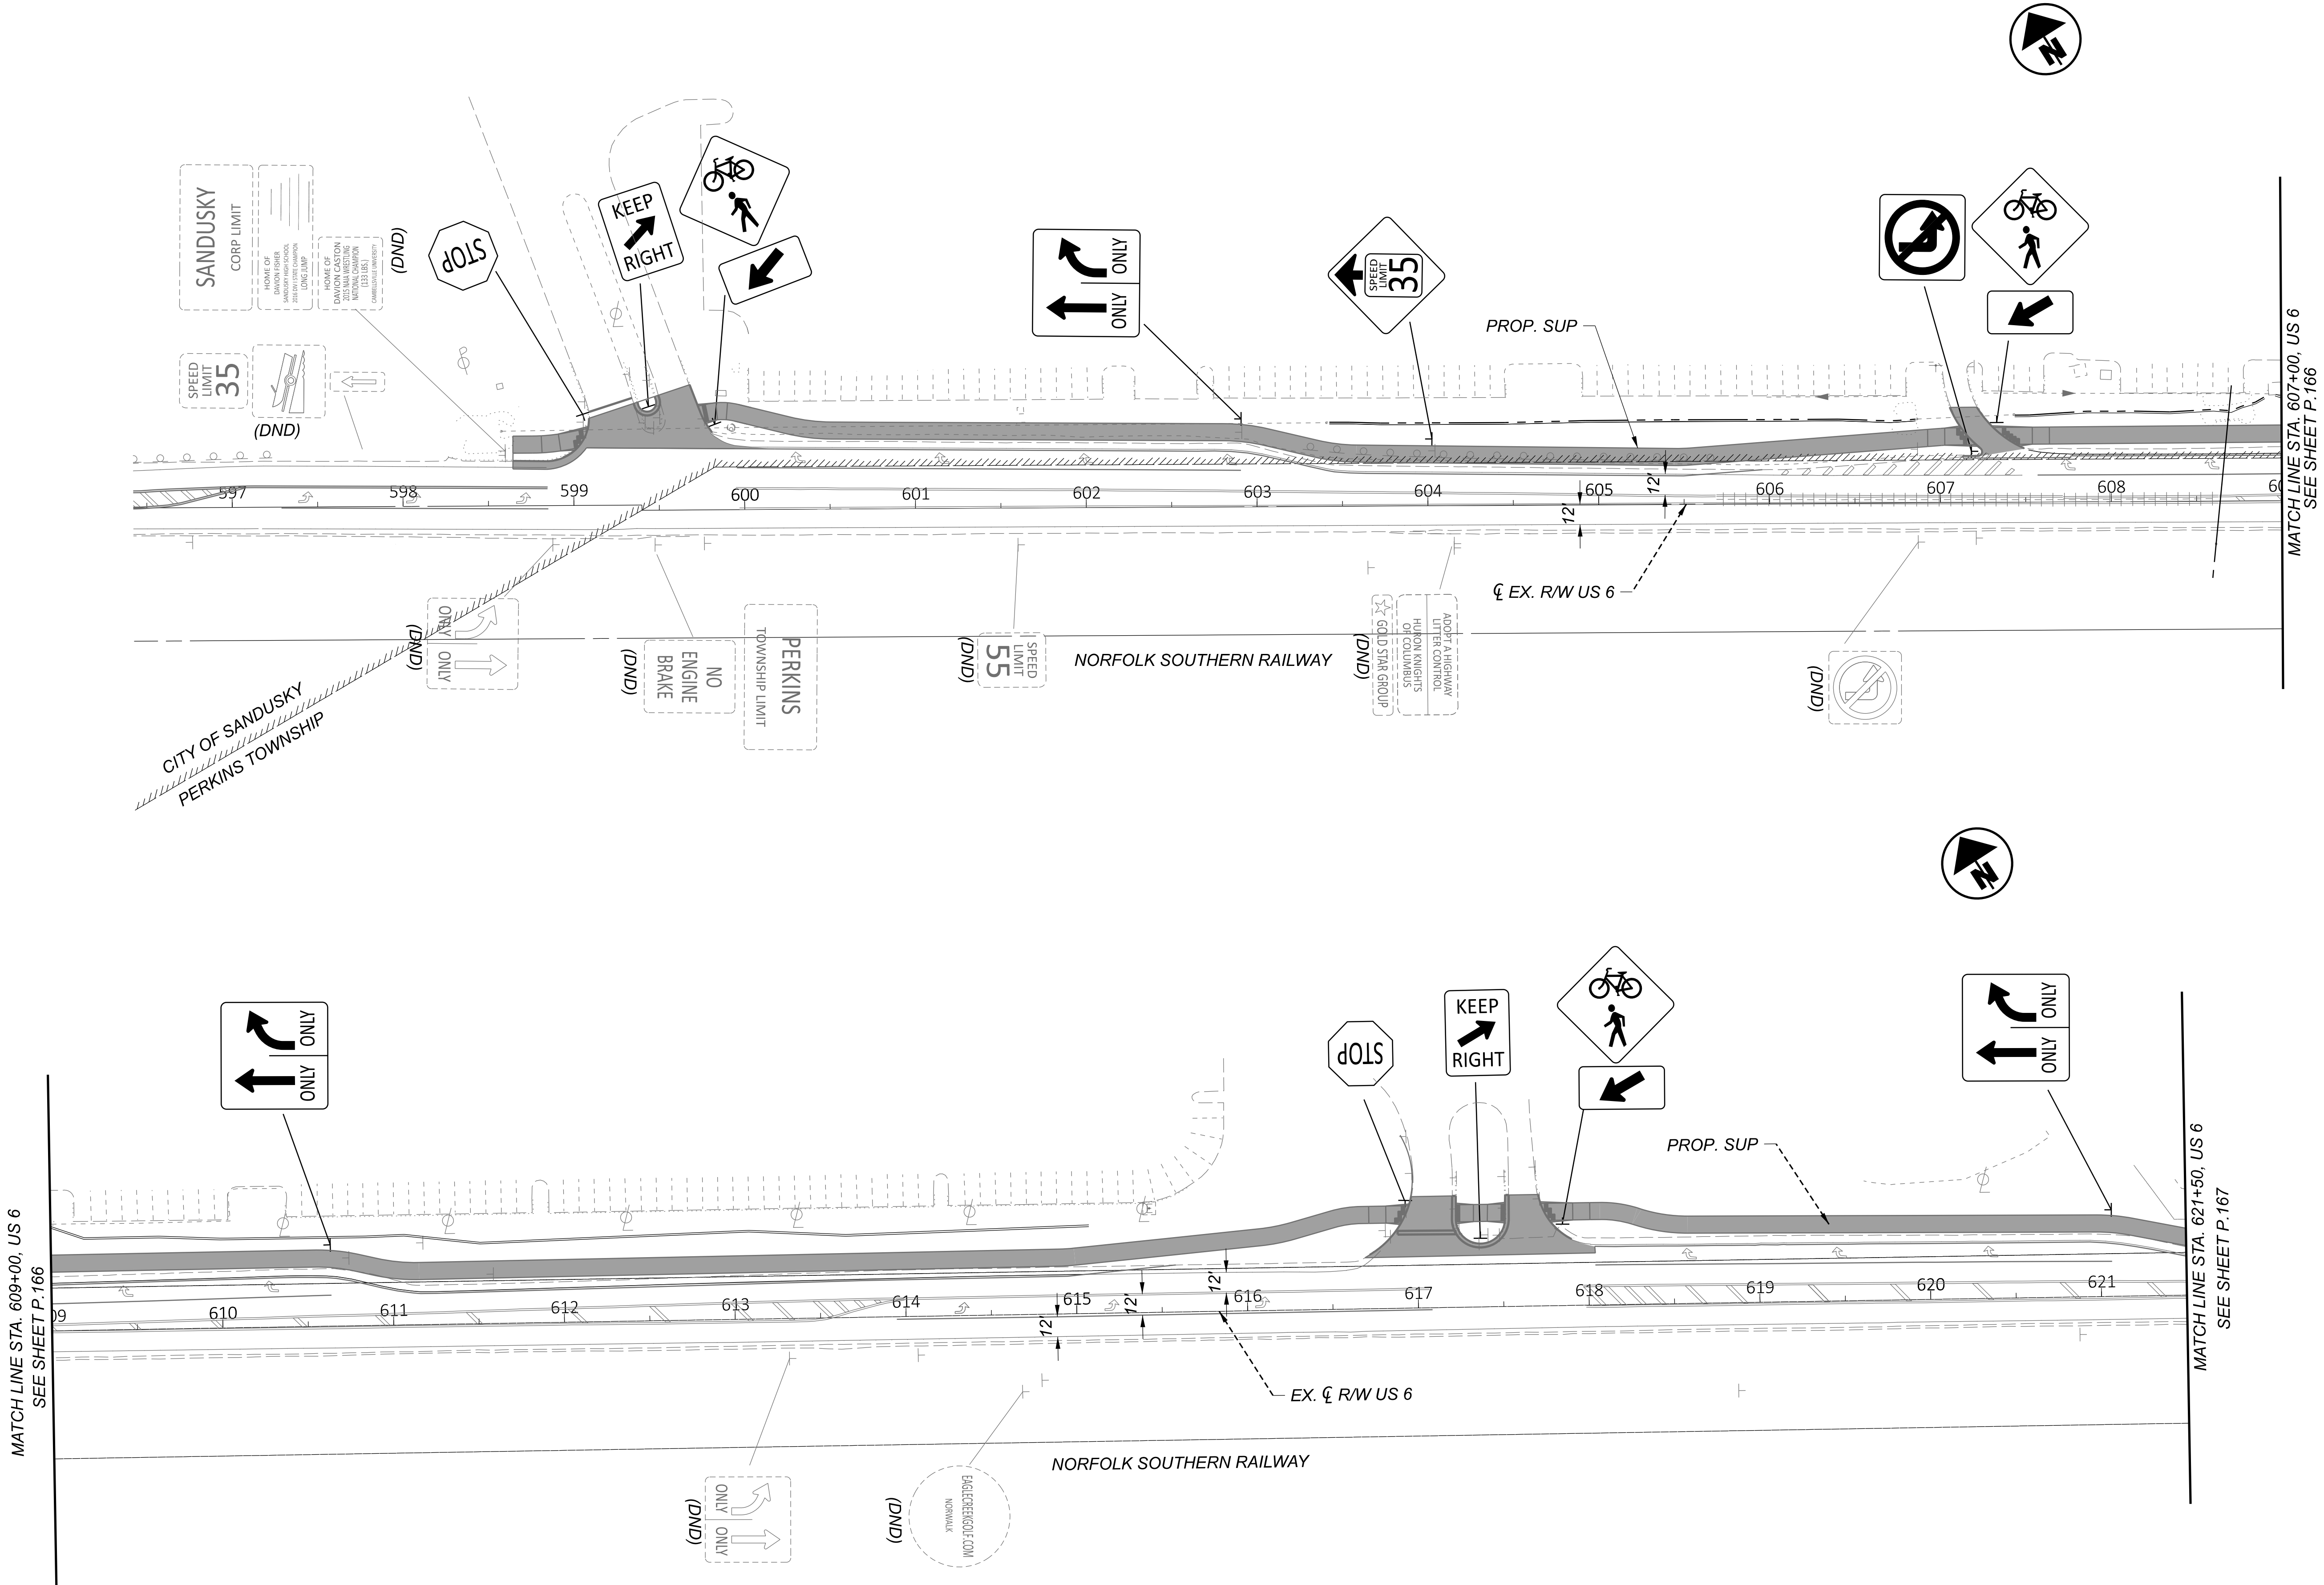

NOTES:
1. FOR MOT LEGEND, SEE SHEET P.067.


TRANSYSTEMS 400 W. NATIONWIDE BLVD., STE. 225 COLUMBUS, OHIO 43215		DESIGN AGENCY SSA	
DESIGNER SSA		REVIEWER SS 02/28/24	
PROJECT ID 116570		SHEET TOTAL P.169 782	

MAINTENANCE OF TRAFFIC - PHASE 2

US 6 - BEGIN PROJECT TO STA. 621+50

HORIZONTAL SCALE IN FEET

0 25 50 100

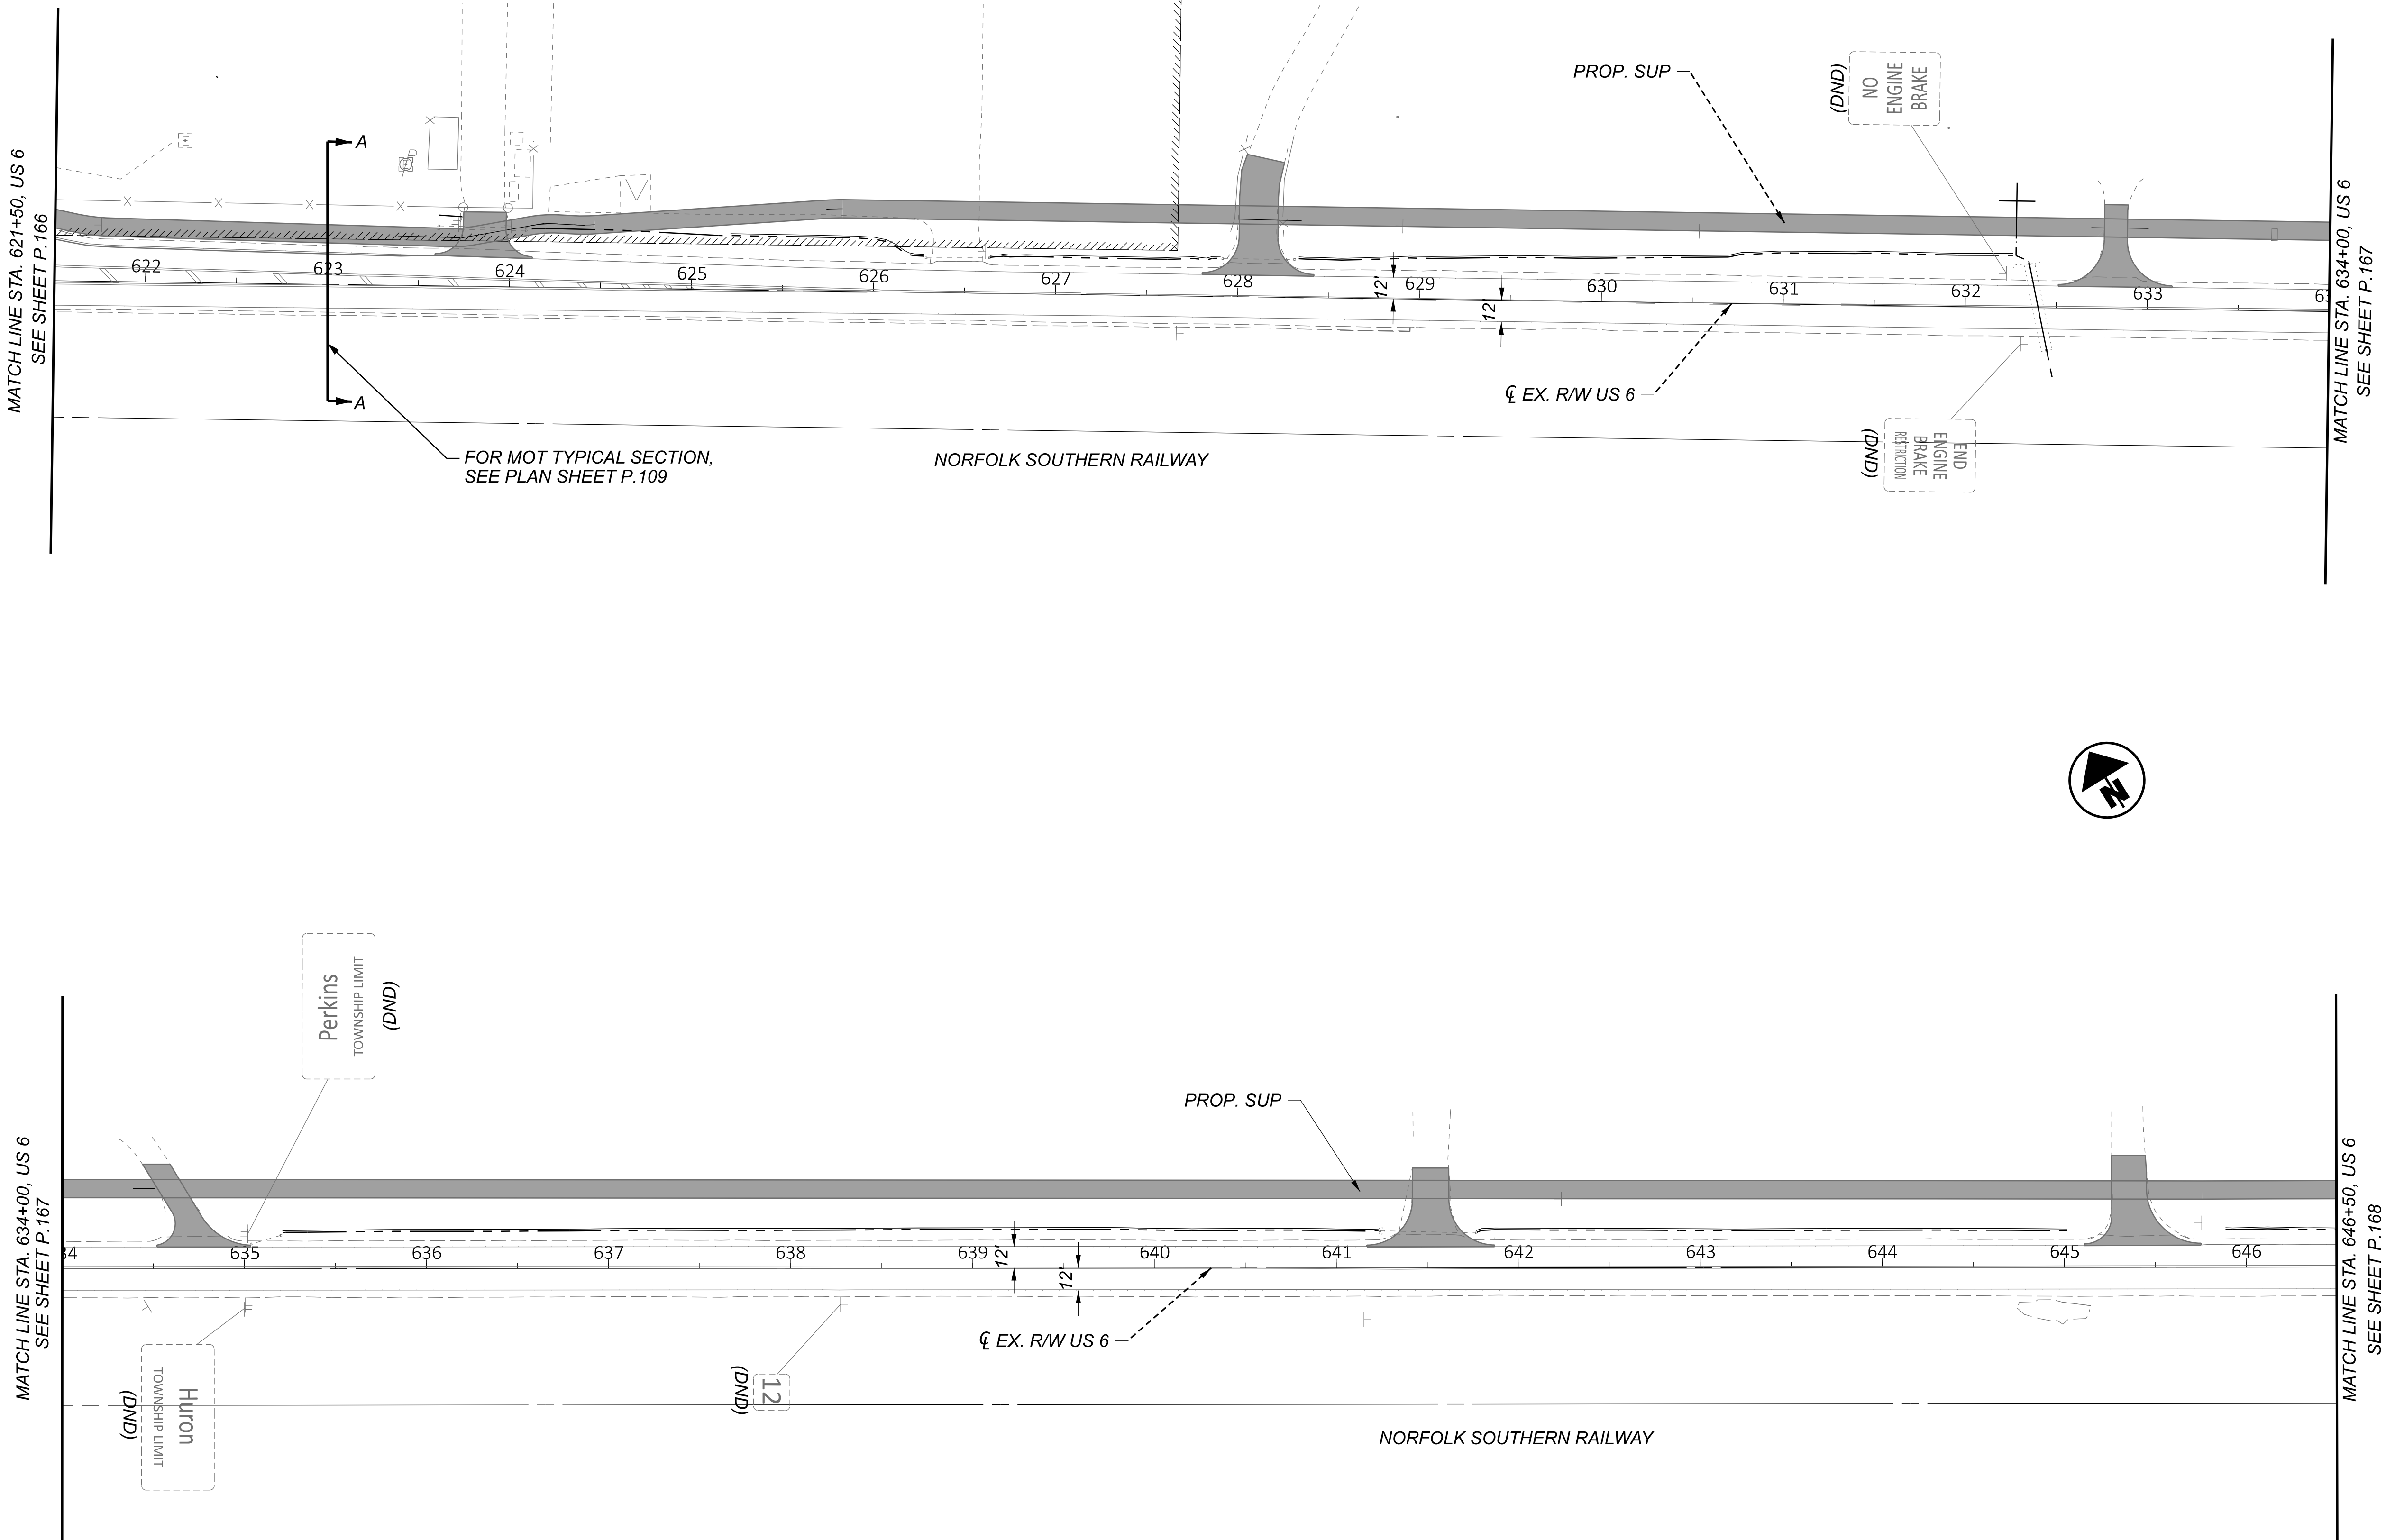

NOTES:
1. FOR MOT LEGEND, SEE SHEET P.067.

TRANSYSTEMS 400 W. WATKINSON BLVD., STE. 225 COLUMBUS, OHIO 43215		DESIGN AGENCY	
SSA		DESIGNER	
SS 02/28/24		REVIEWER	
116570		PROJECT ID	
P.170	782	SHEET TOTAL	


MAINTENANCE OF TRAFFIC - PHASE 2
US 6 - STA. 621+50.00 TO STA. 646+50.00


HORIZONTAL
SCALE IN FEET
0 25 50 100

ERI-US 0006-CONNECTIVITY CORRIDOR



MAINTENANCE OF TRAFFIC - PHASE 2
US 6 - STA. 646+50.00 TO STA. 671+50.00

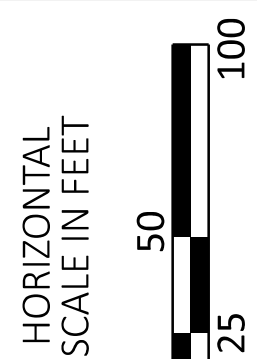

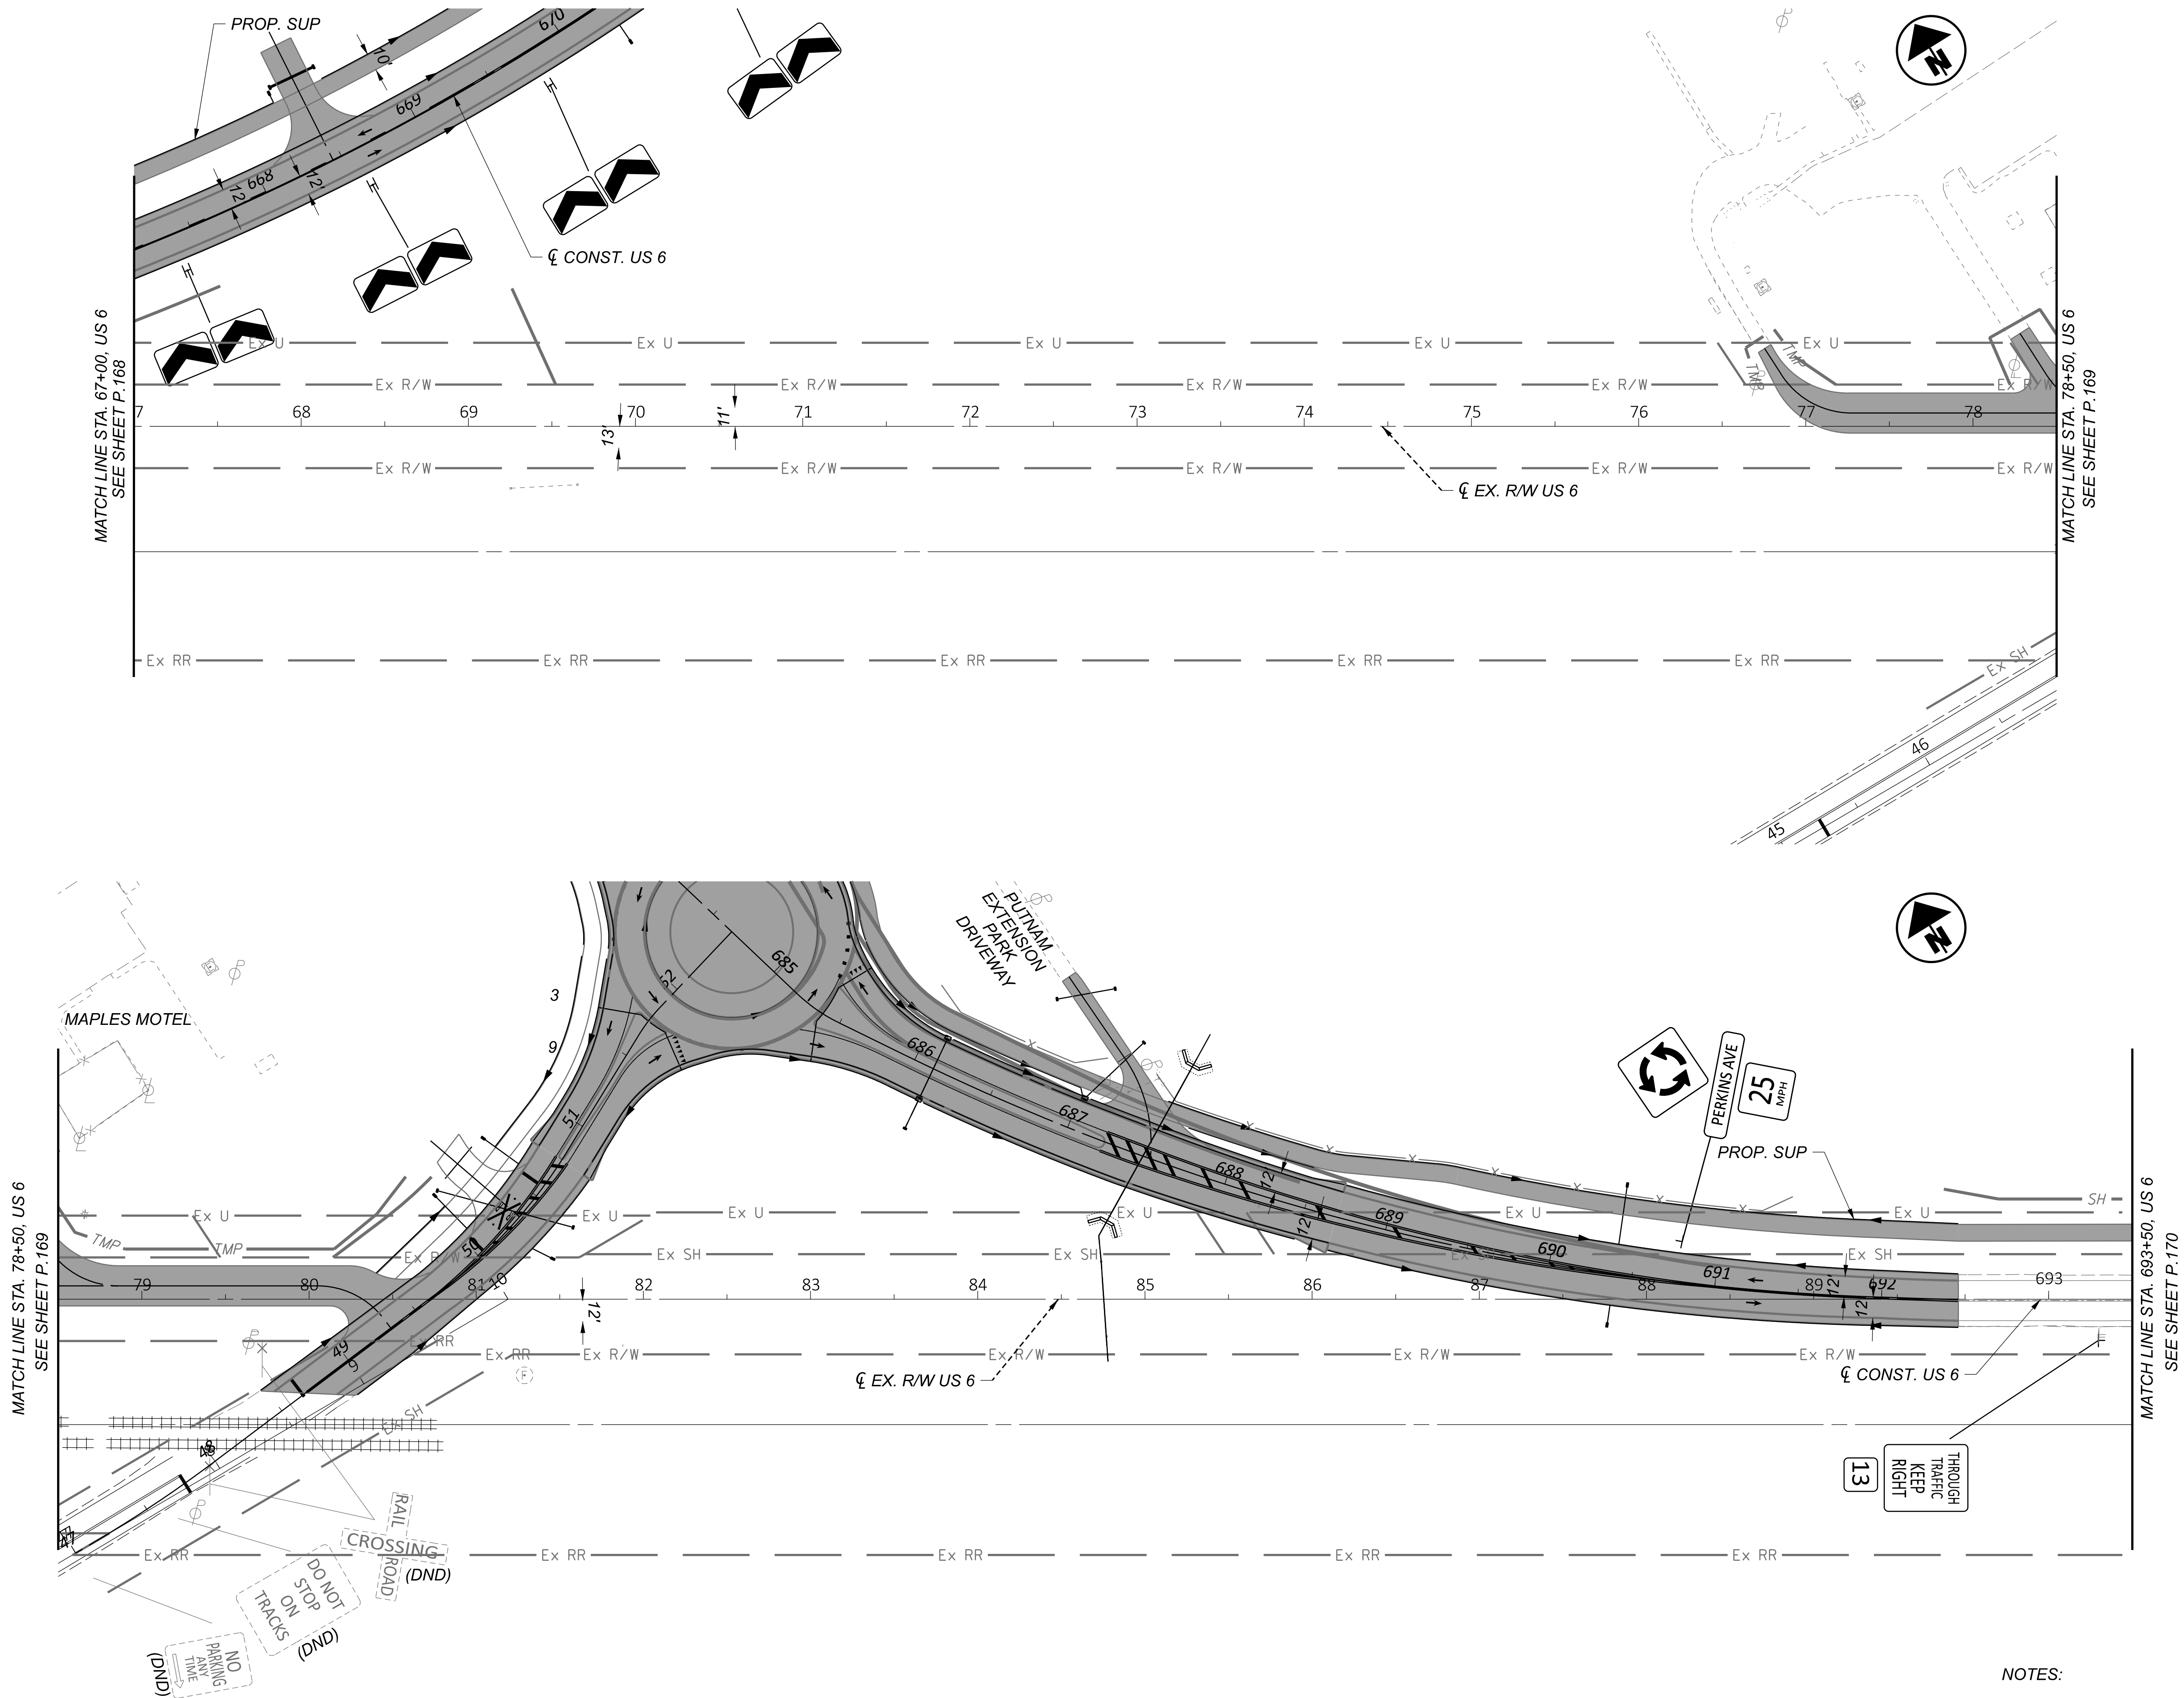

NOTES:
1. FOR MOT LEGEND, SEE SHEET P.067.


TRANSYSTEMS 400 W. WATSON BLVD., STE. 225 COLUMBUS, OHIO 43215		DESIGN AGENCY	
SSA		DESIGNER	
SS 02/28/24		REVIEWER	
116570		PROJECT ID	
P.172	782	SHEET TOTAL	

MAINTENANCE OF TRAFFIC - PHASE 2
US 6 - STA. 67+00.00 EX. US 6 TO 693+50.00 CONST. US 6 SUP


HORIZONTAL SCALE IN FEET
0 25 50 100



W20-1-48
1 MILE
W16-3aP-30
STA. 694+00, RT.

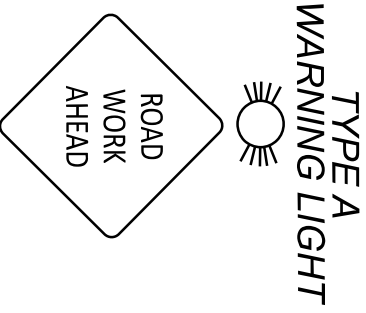

W20-5-48
STA. 699+00, RT.
THROUGH
TRAFFIC
KEEP
RIGHT
(DND)

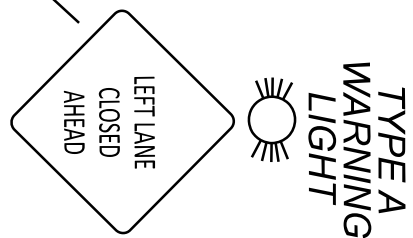


NORFOLK SOUTHERN RAILWAY

Q EX. R/W US 6

PROP. SUP

MATCH LINE STA. 706+00, US 6
SEE SHEET P.171


SEE SHEET P.171

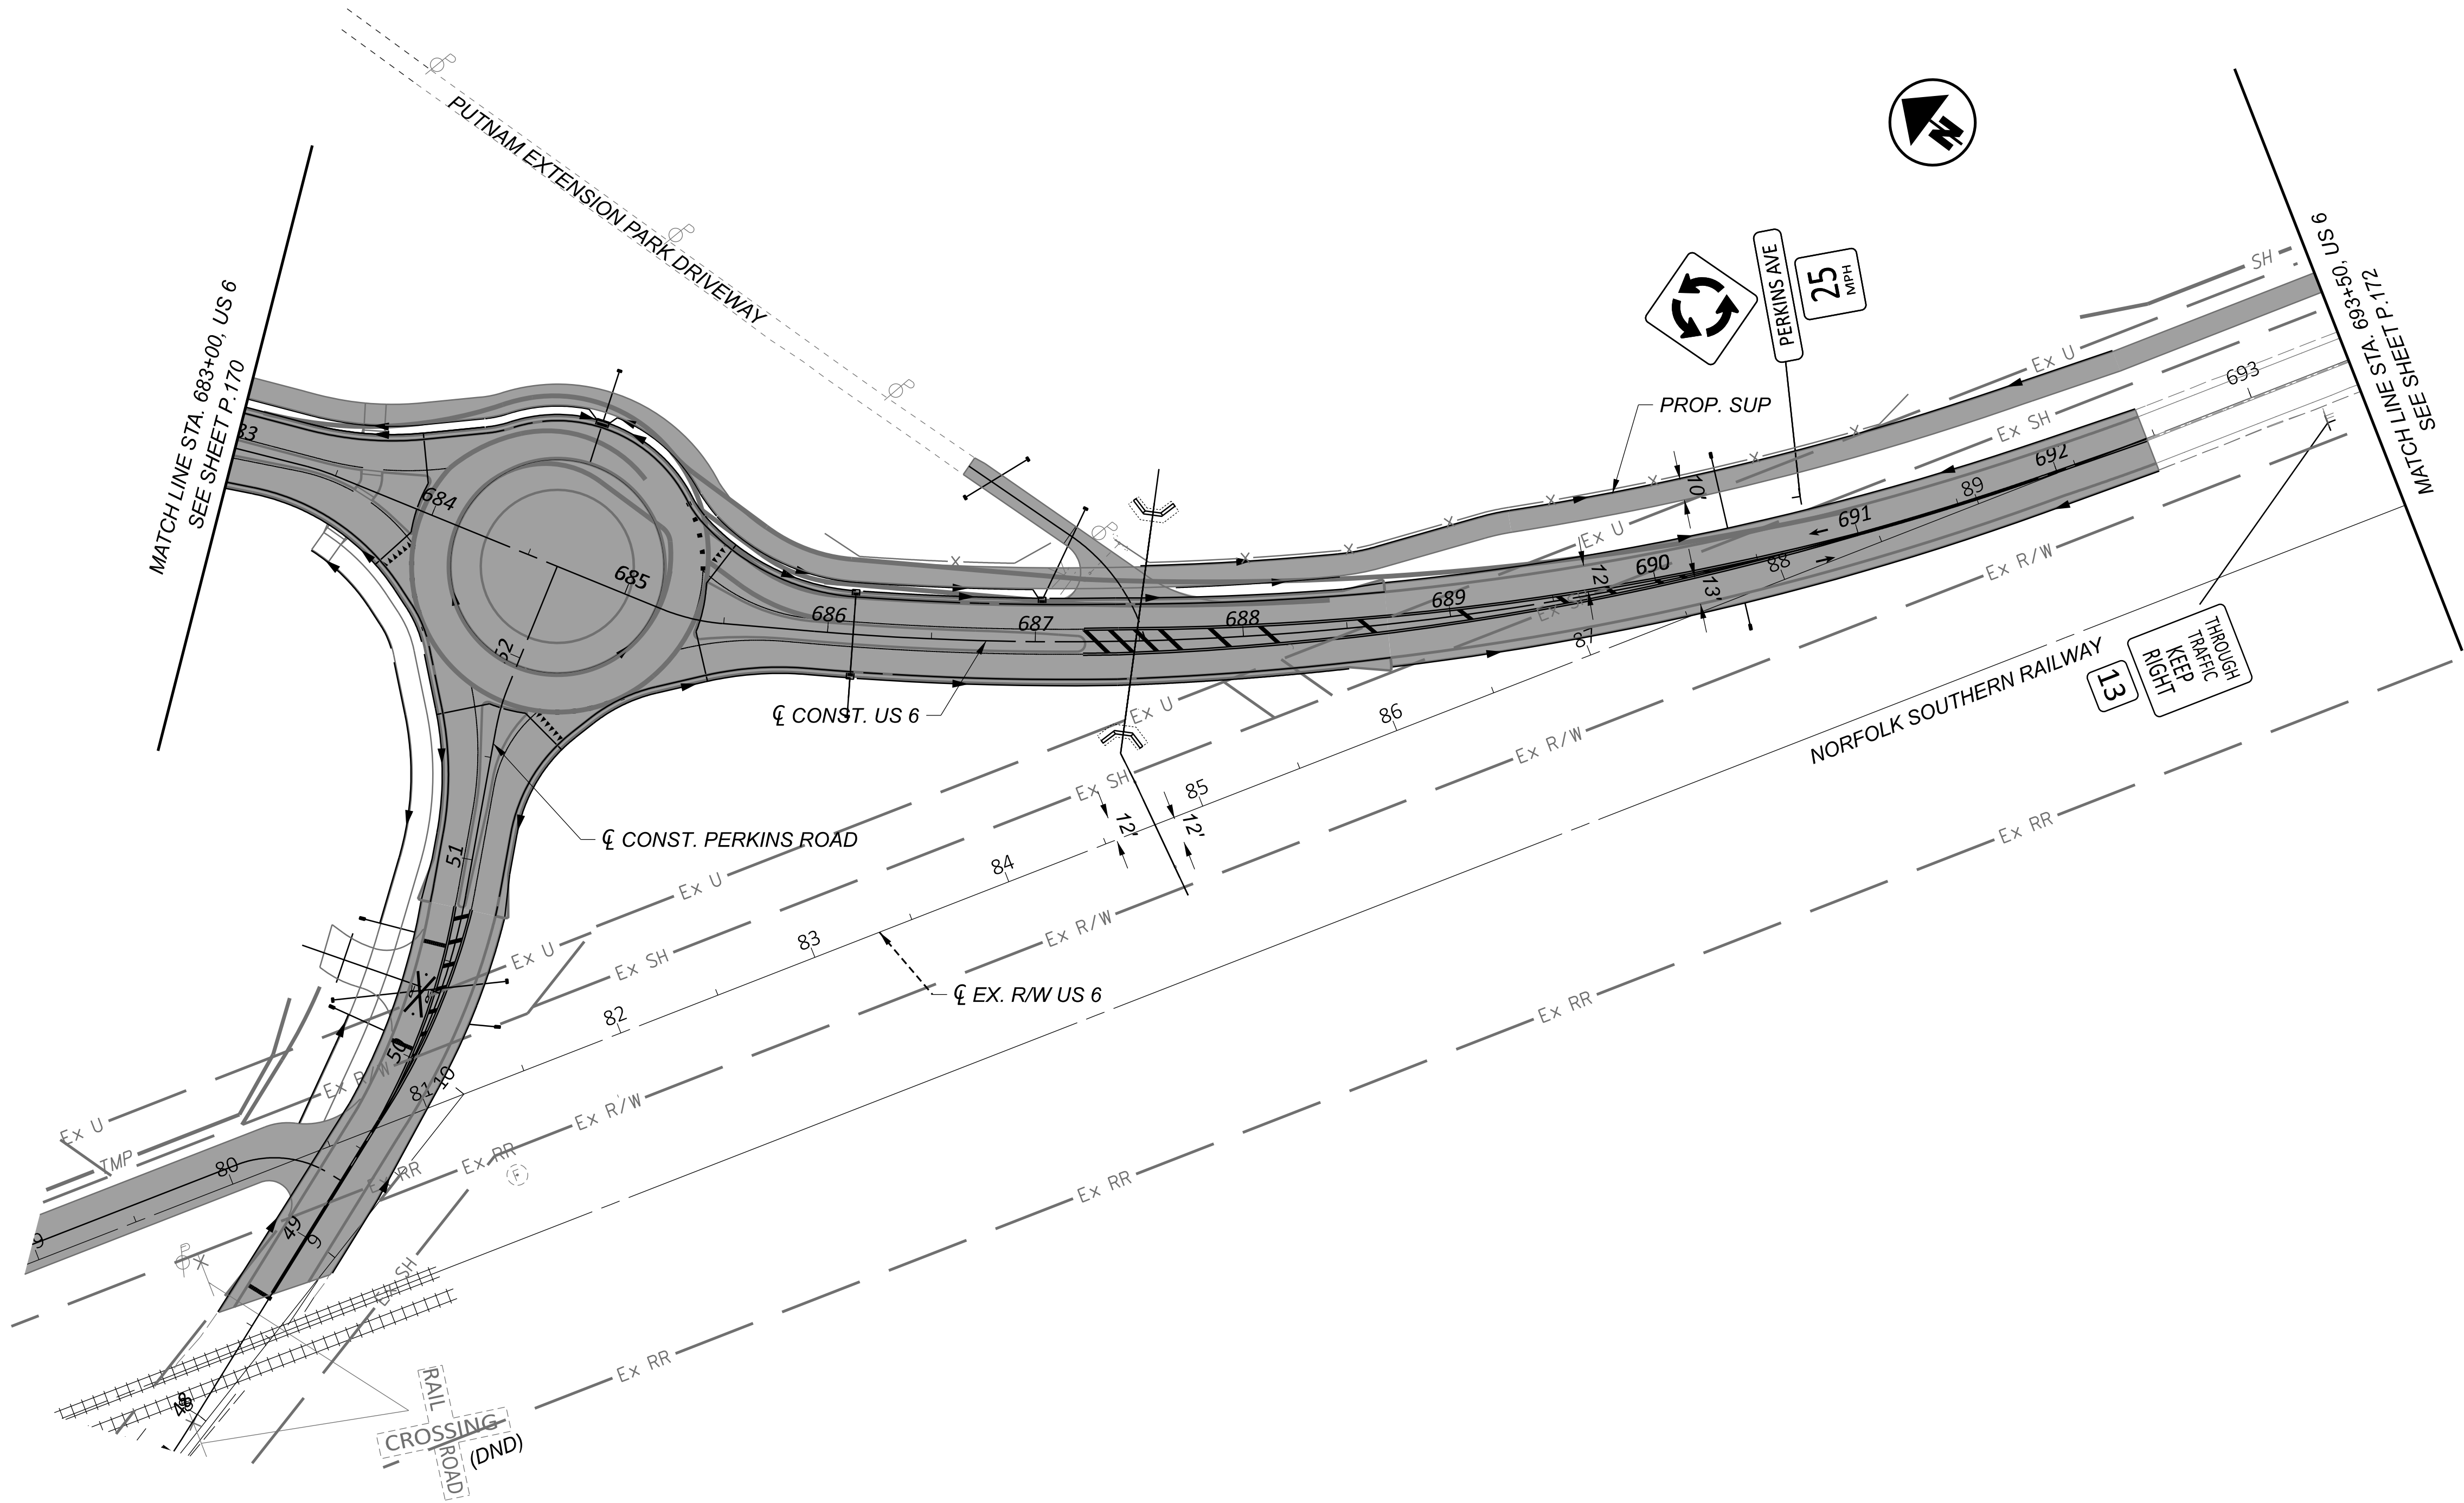

NOTES:
1. FOR MOT LEGEND, SEE SHEET P.067.


DESIGN AGENCY	
TRANSYSTEMS 400 W. WATSON BLVD., STE. 225 COLUMBUS, OHIO 43215	
DESIGNER	SSA
REVIEWER	SS
PROJECT ID	02/28/24
SHEET	116570
P.174	TOTAL 782

MAINTENANCE OF TRAFFIC - PHASE 2
US 6 - STA. 683+00.00 TO STA. 693+50.00

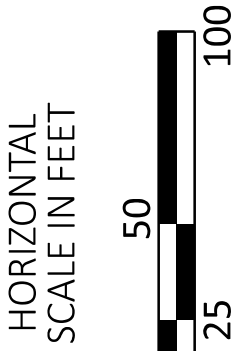


ERI-US 0006-CONNECTIVITY CORRIDOR

MODEL: CLIP_SUP 1 - Plan 12-13 [Sheet] PAPER SIZE: 34x22 (in.) DATE: 6/9/2025 TIME: 11:52:45 AM USER: adlayton
 www\lohiodist-pw.bentley.com:ohiodist-pw-02\Documents\01 Active Projects\District 03\Err\116570402-Engineering_TransSystems\MOT\Sheets\116570_MP002.dgn

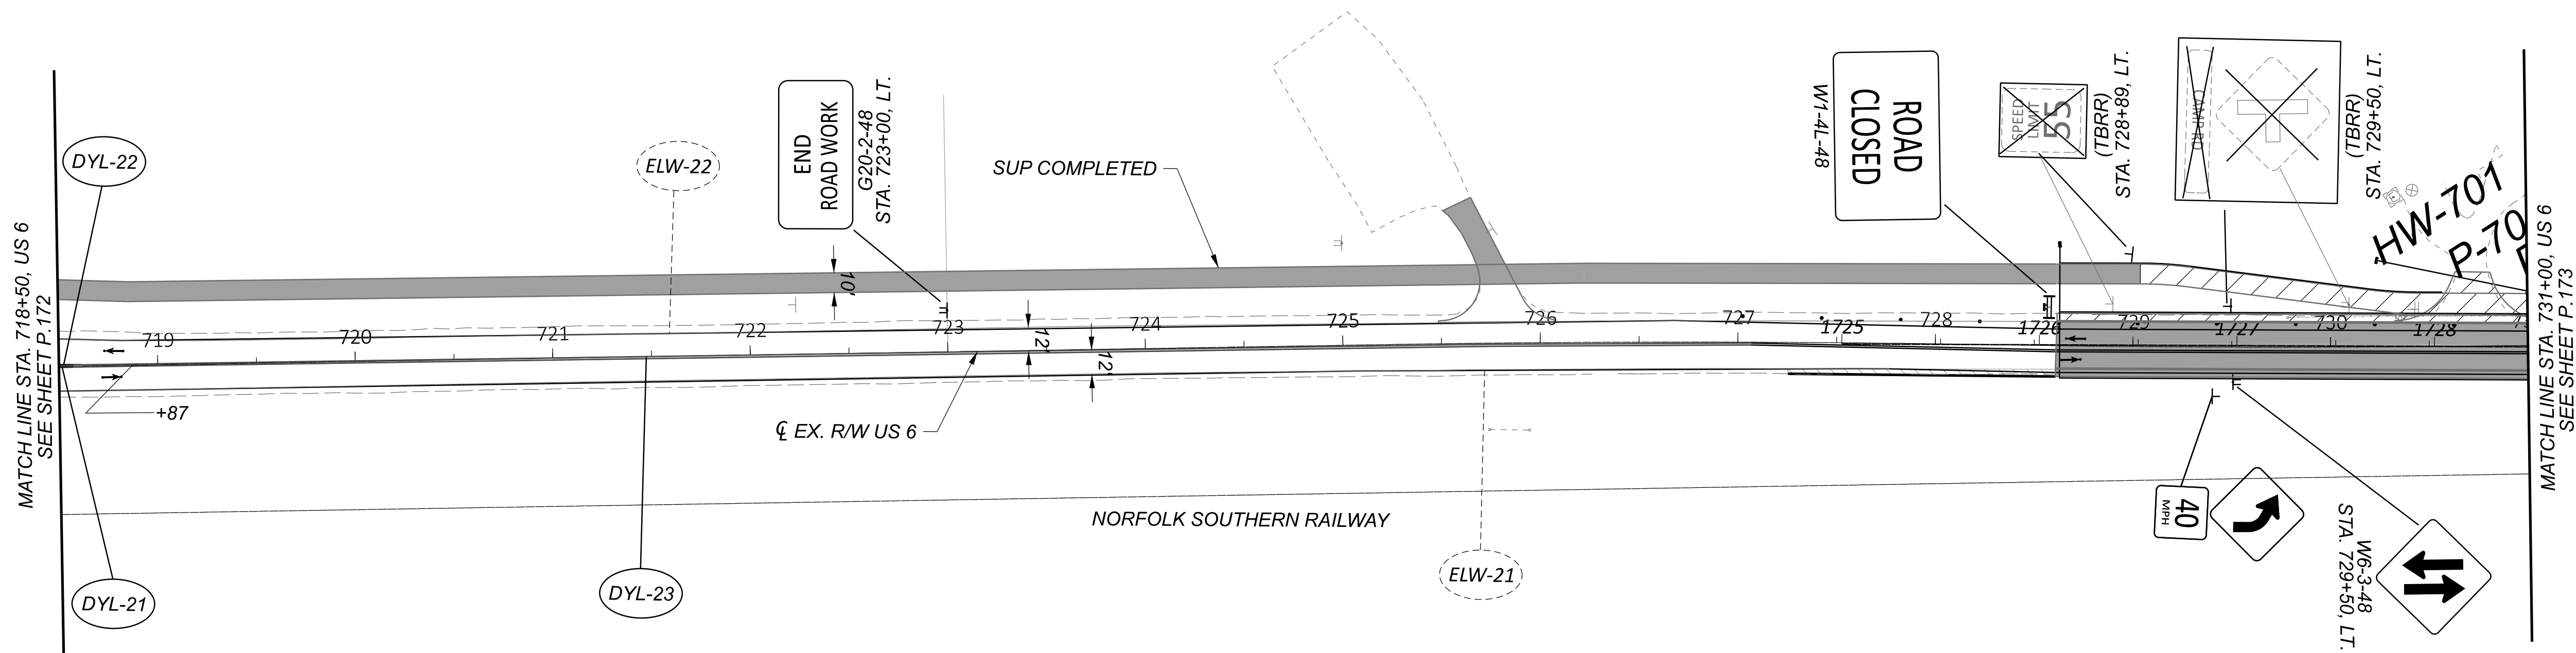


NOTES:


1. FOR MOT LEGEND, SEE SHEET P.067.

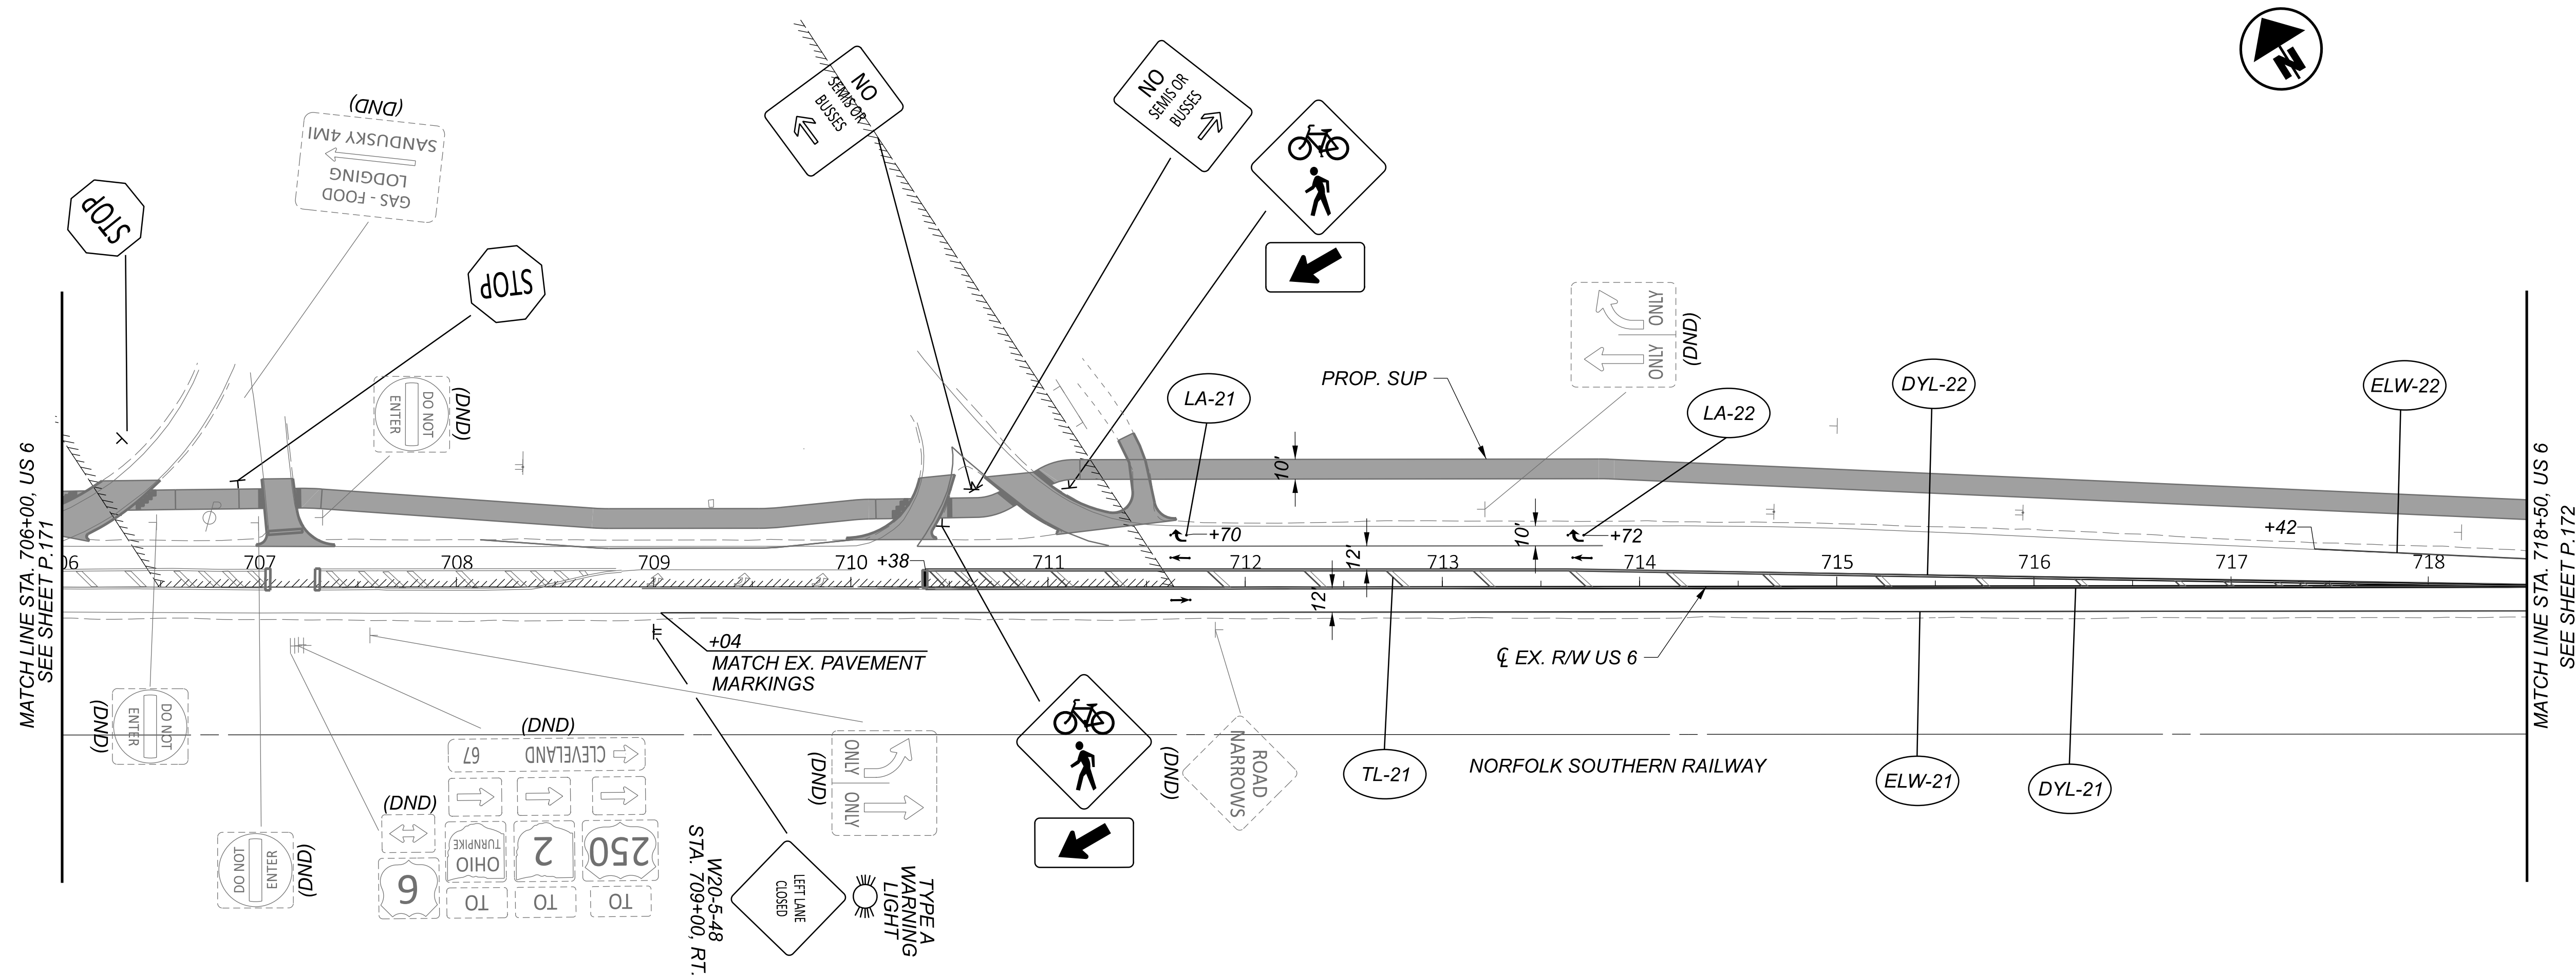


TRANSYSTEMS 400 W. NANTUCKET BLVD., STE 225 COLUMBUS, OHIO 43215	DESIGN AGENCY DESIGNER SSA REVIEWER SS 02/28/24 PROJECT ID 116570 SHEET P.175 TOTAL 782
---	--

MAINTENANCE OF TRAFFIC - PHASE 2

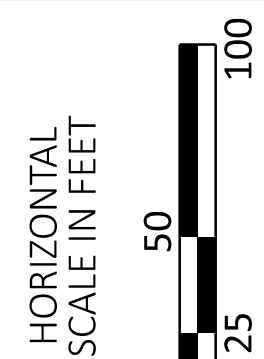

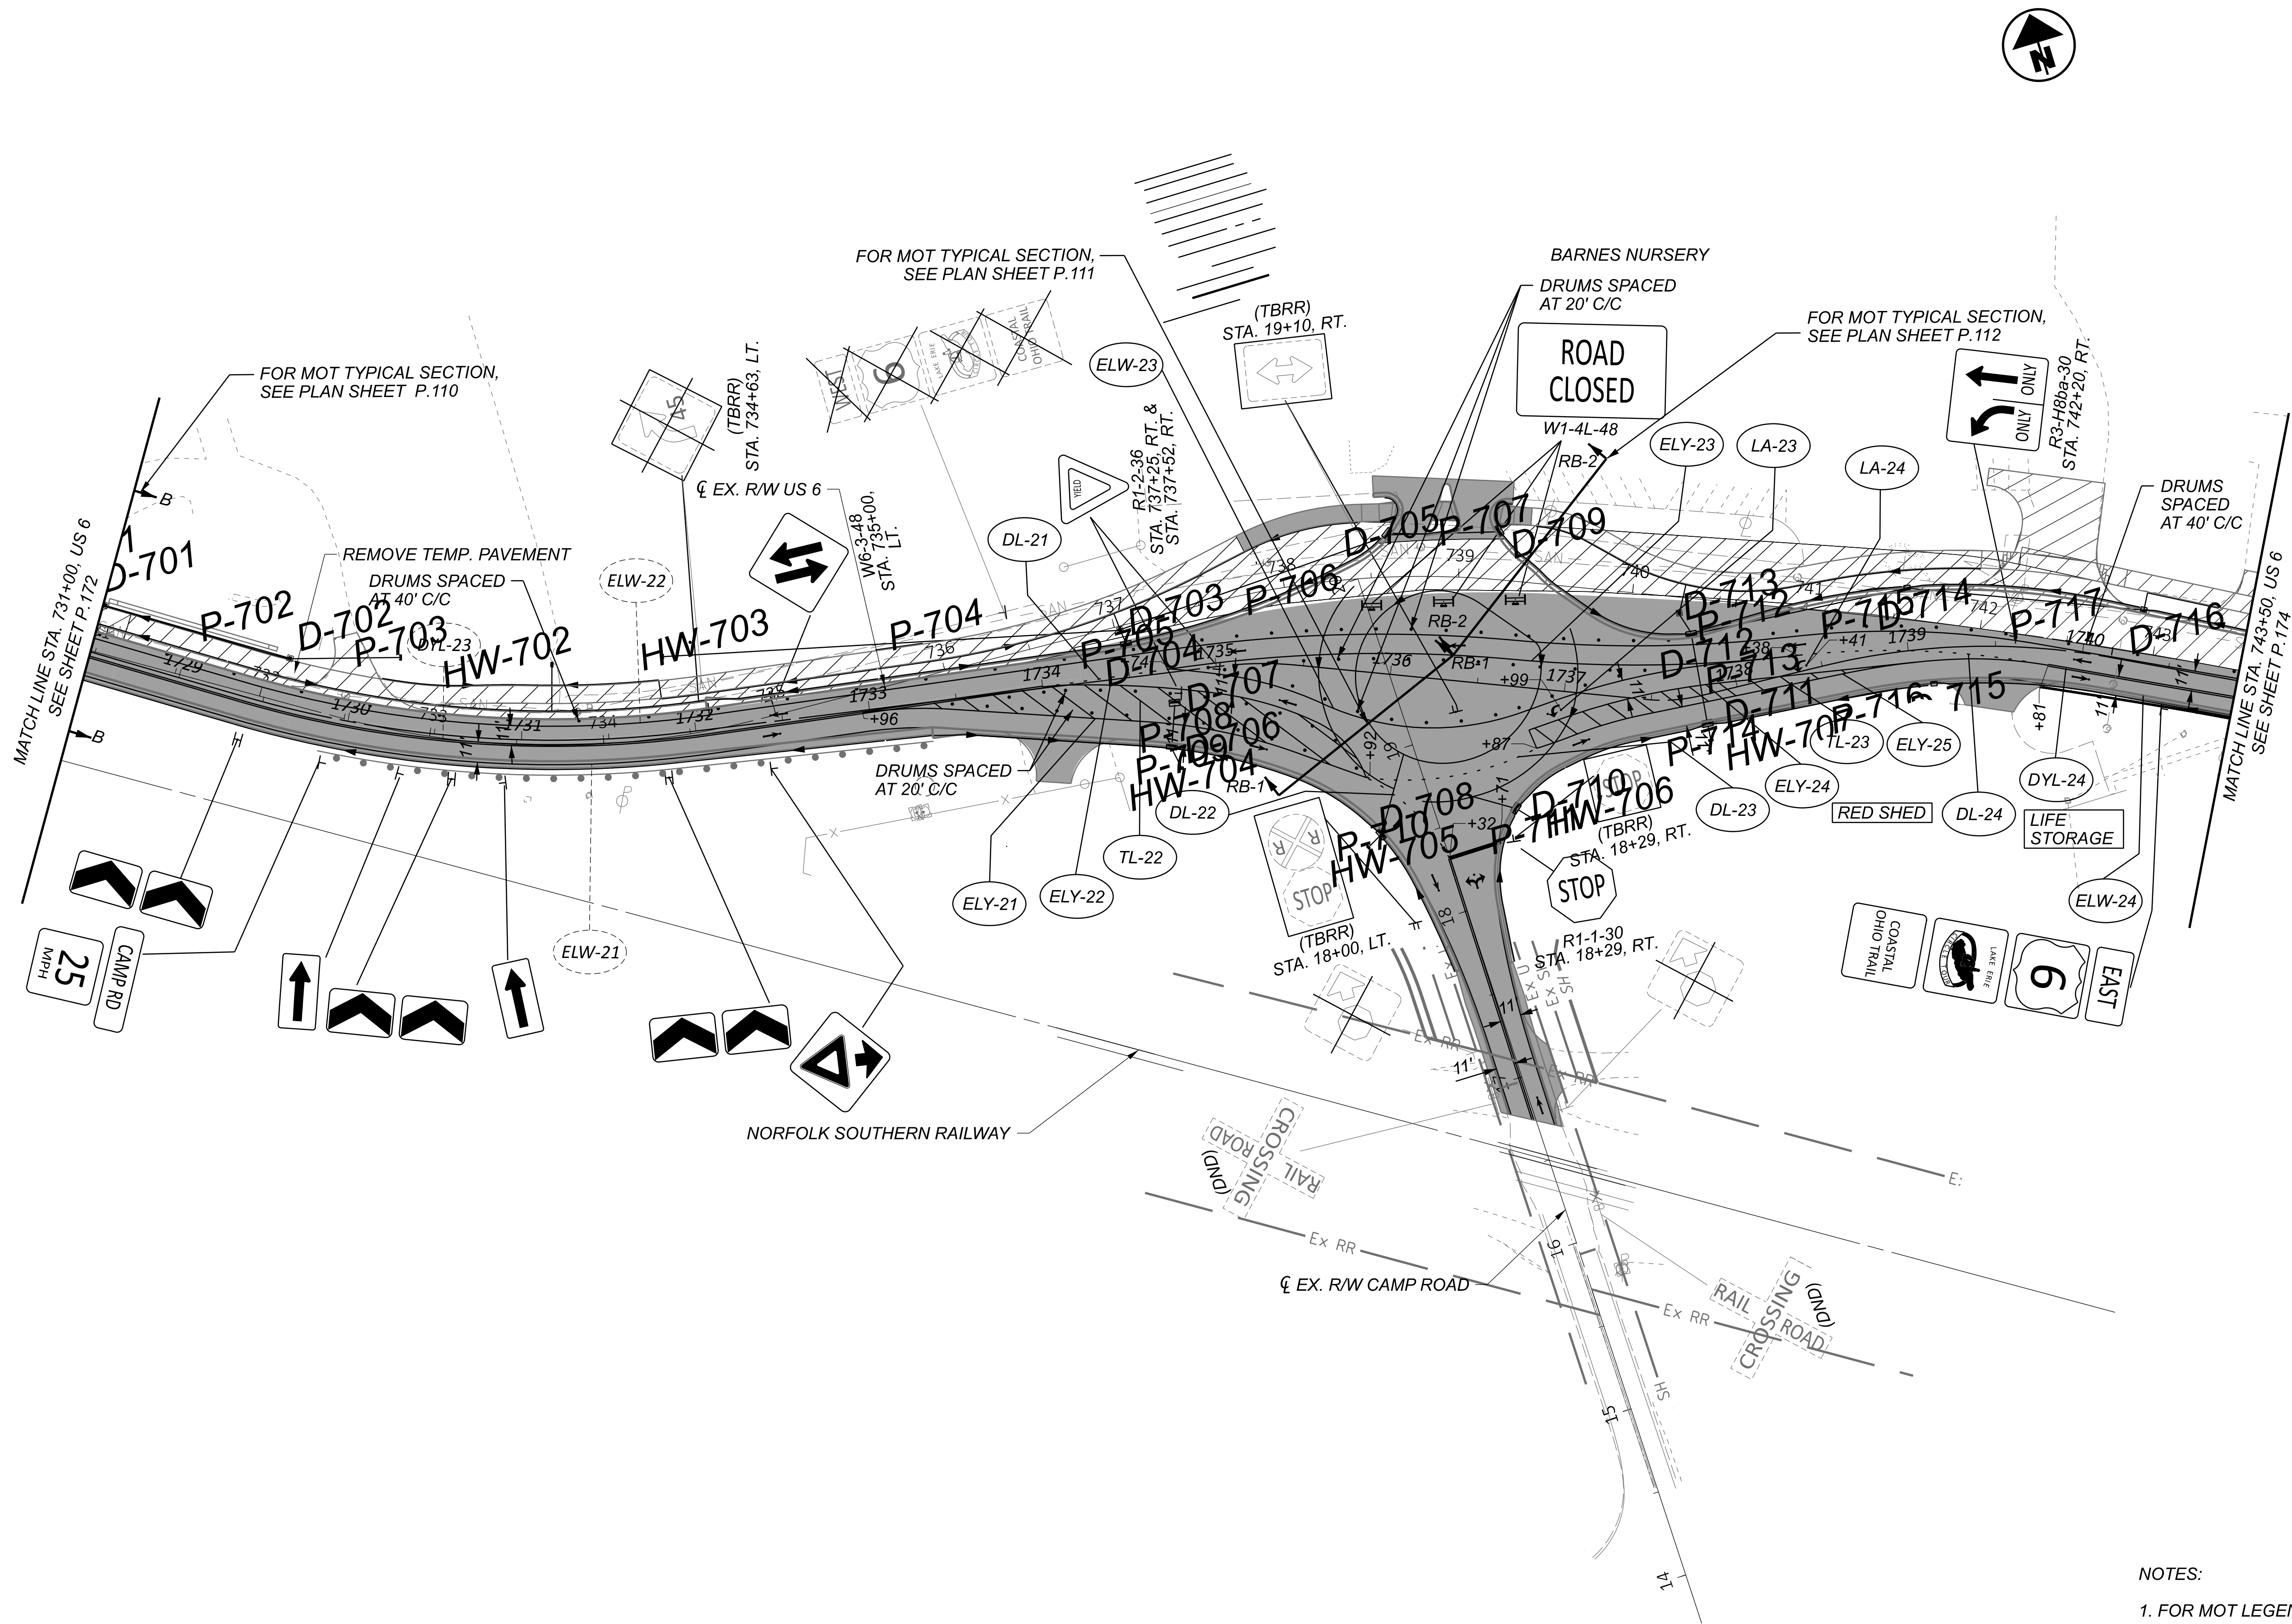

NOTES:
1. FOR MOT LEGEND, SEE SHEET P.067.

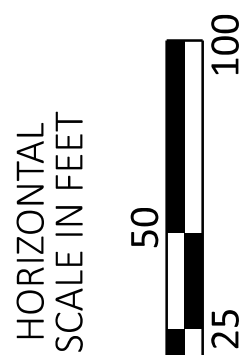


MAINTENANCE OF TRAFFIC - PHASE 2
US 6 - STA. 731+00.00 TO STA. 743+50.00

TRANSYSTEMS 400 W. WATKINSON BLVD., STE. 225 COLUMBUS, OHIO 43215	
DESIGN AGENCY	SSA
DESIGNER	SSA
REVIEWER	SS 02/28/24
PROJECT ID	116570
SHEET	TOTAL
P.176	782

ERI-US 0006-CONNECTIVITY CORRIDOR

MODEL: CLP_SUP 1 - Plan 15-16 [Sheet] PAPER SIZE: 34x22 (in.) DATE: 6/9/2025 TIME: 11:52:52 AM USER: adlayton
 pw://ohiodr-pw.bentley.com:ohiodr-pw-02 Documents\01 Active Projects\District 03\Ere\116570402-Engineering_TransSystems\MOT\Sheets\116570_MP002.dgn

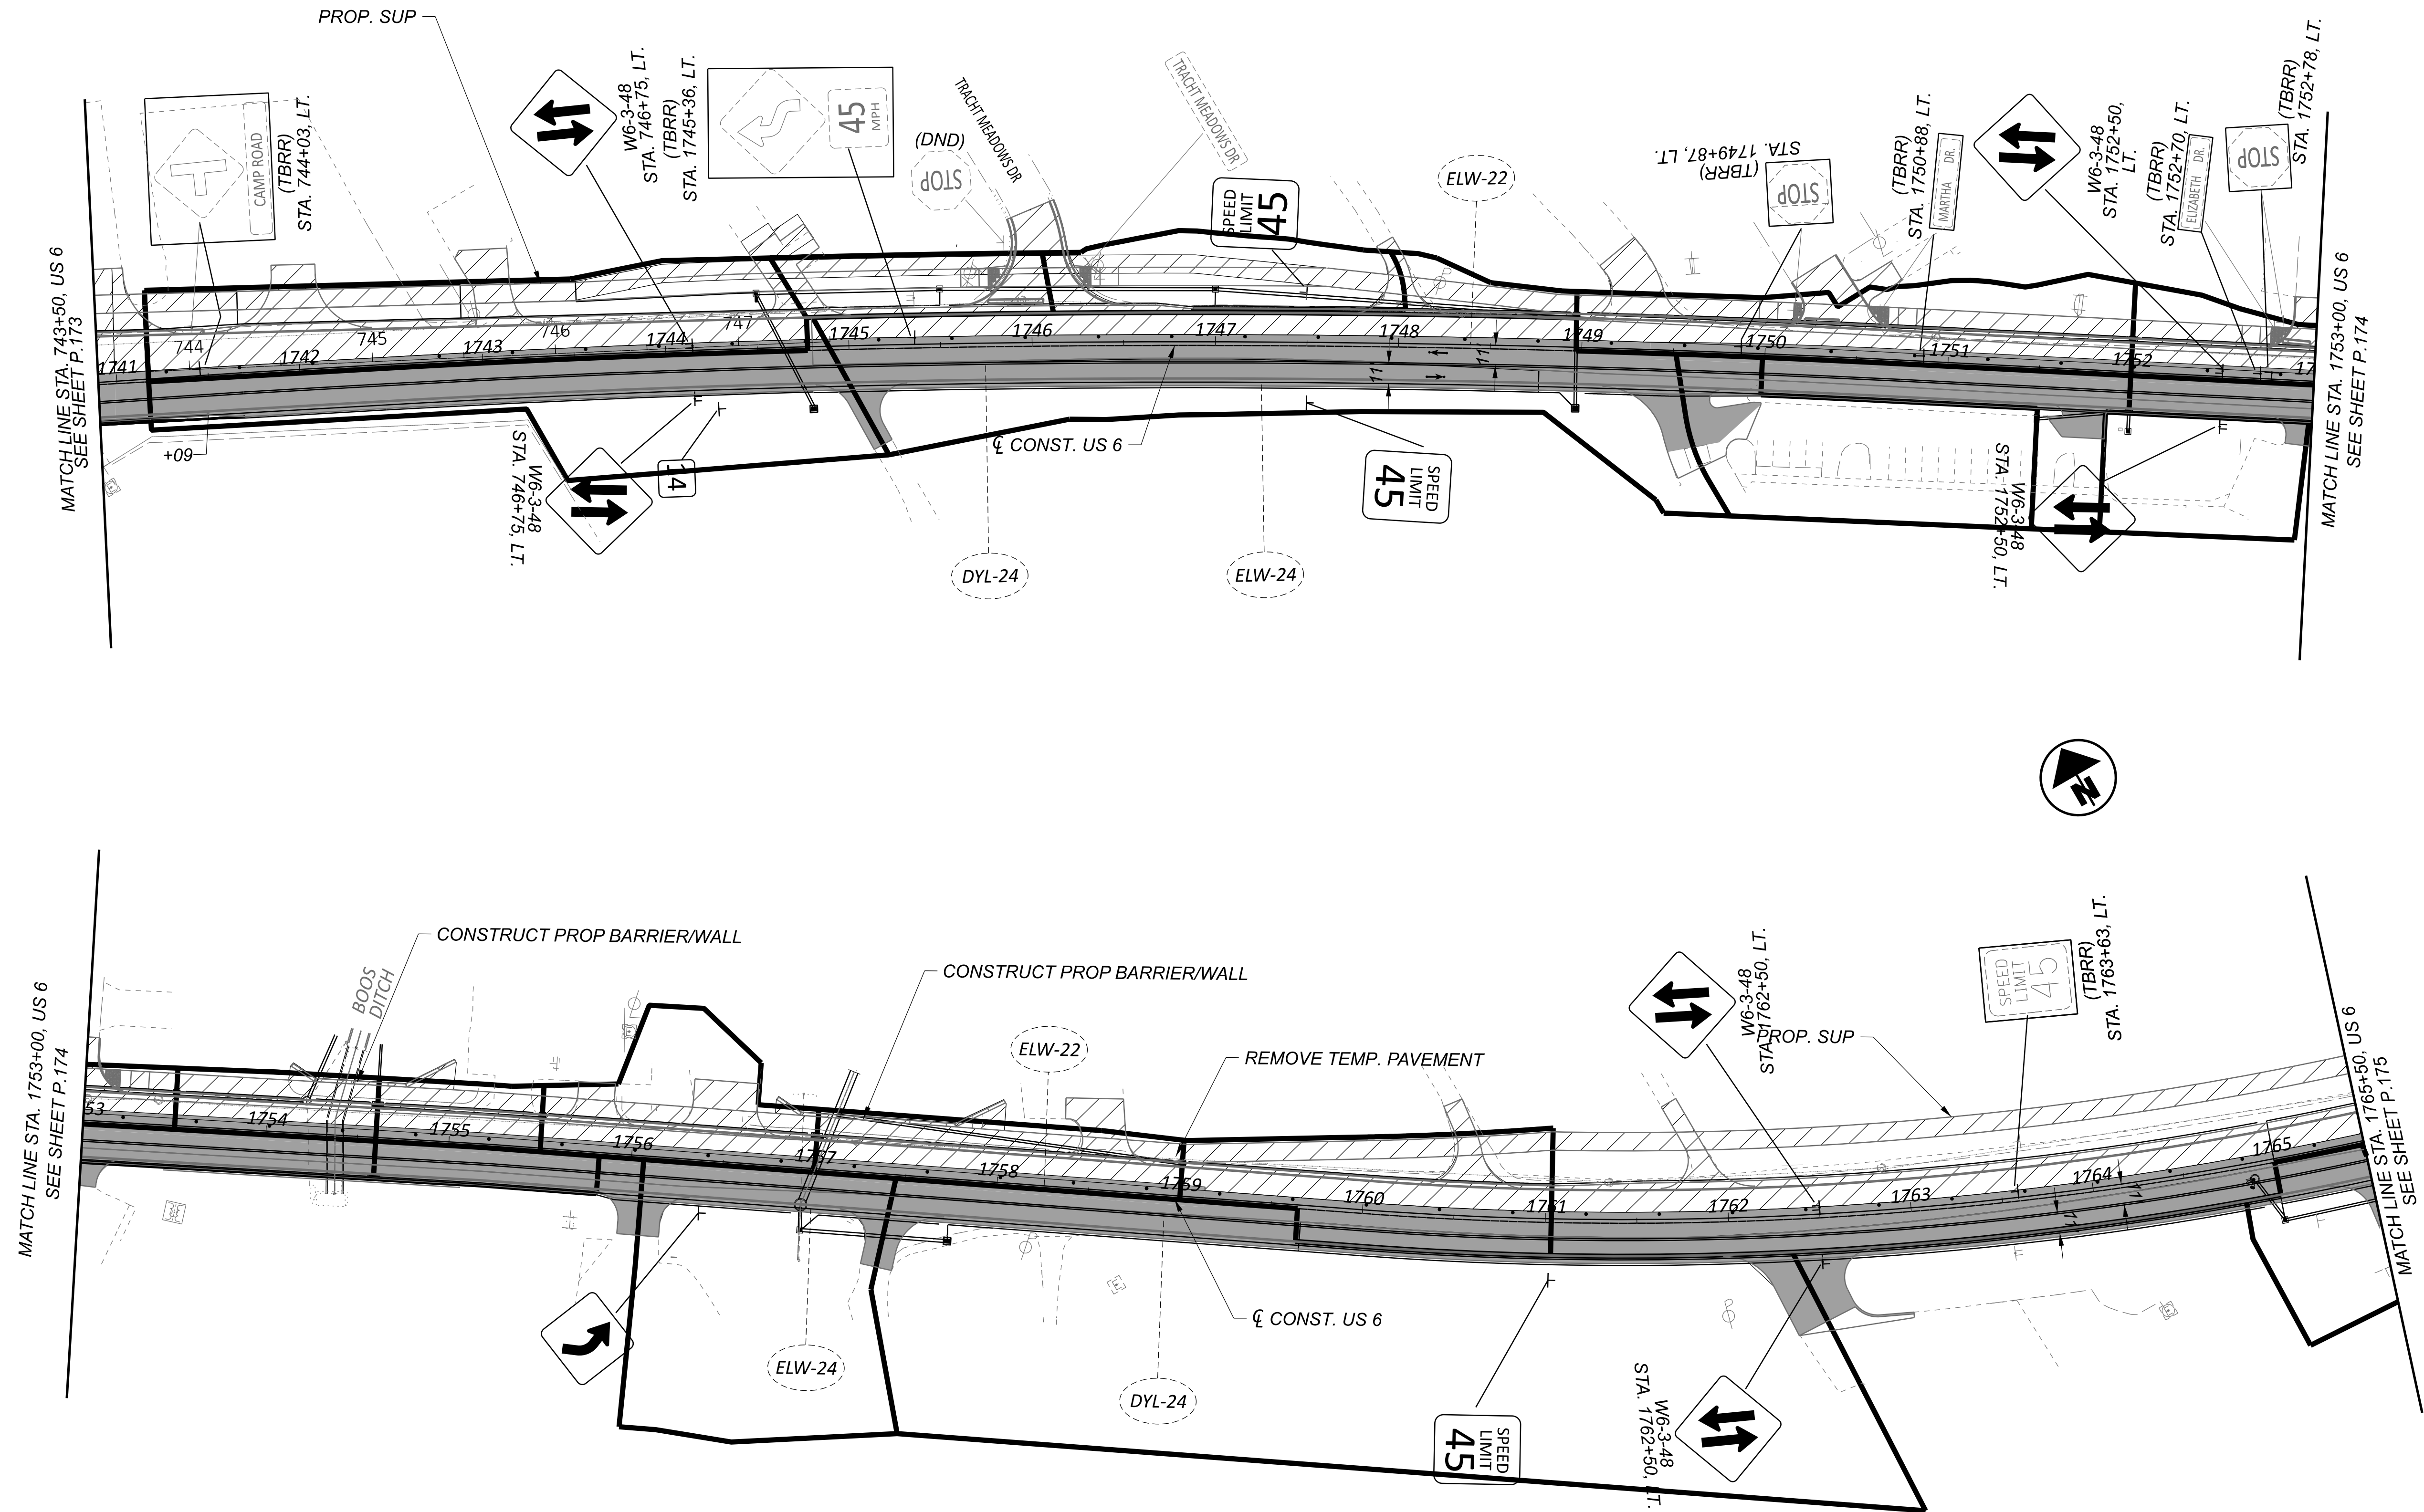

NOTES:

1. FOR MOT LEGEND, SEE SHEET P.067.

DESIGN AGENCY
TRANSYSTEMS
 400 W. NATION WIFE BLVD., STE 225
 COLUMBUS, OHIO 3215


DESIGNER
SSA

REVIEWER
SS 02/28/24

PROJECT ID
116570


SHEET TOTAL
P.177 | 782

MAINTENANCE OF TRAFFIC - PHASE 2
US 6 - EX. US 6 STA. 743+50.00 TO CONST. US 6 STA. 1765+50.00

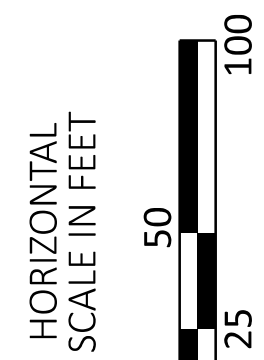

ERI-US 0006-CONNECTIVITY CORRIDOR

MODEL: CLP_SUP_1 - Plan 17-18 [Sheet] PAPER SIZE: 34x22 (in.) DATE: 6/9/2025 TIME: 11:52:56 AM USER: adlyaton
pw:\hohidow-pw.bentley.com:ohiodor-pw-02\Documents\01 Active Projects\District 03\Ere\116570 402-Engineering_TransSystems\WOT\Sheets\116570_MP002.dgn

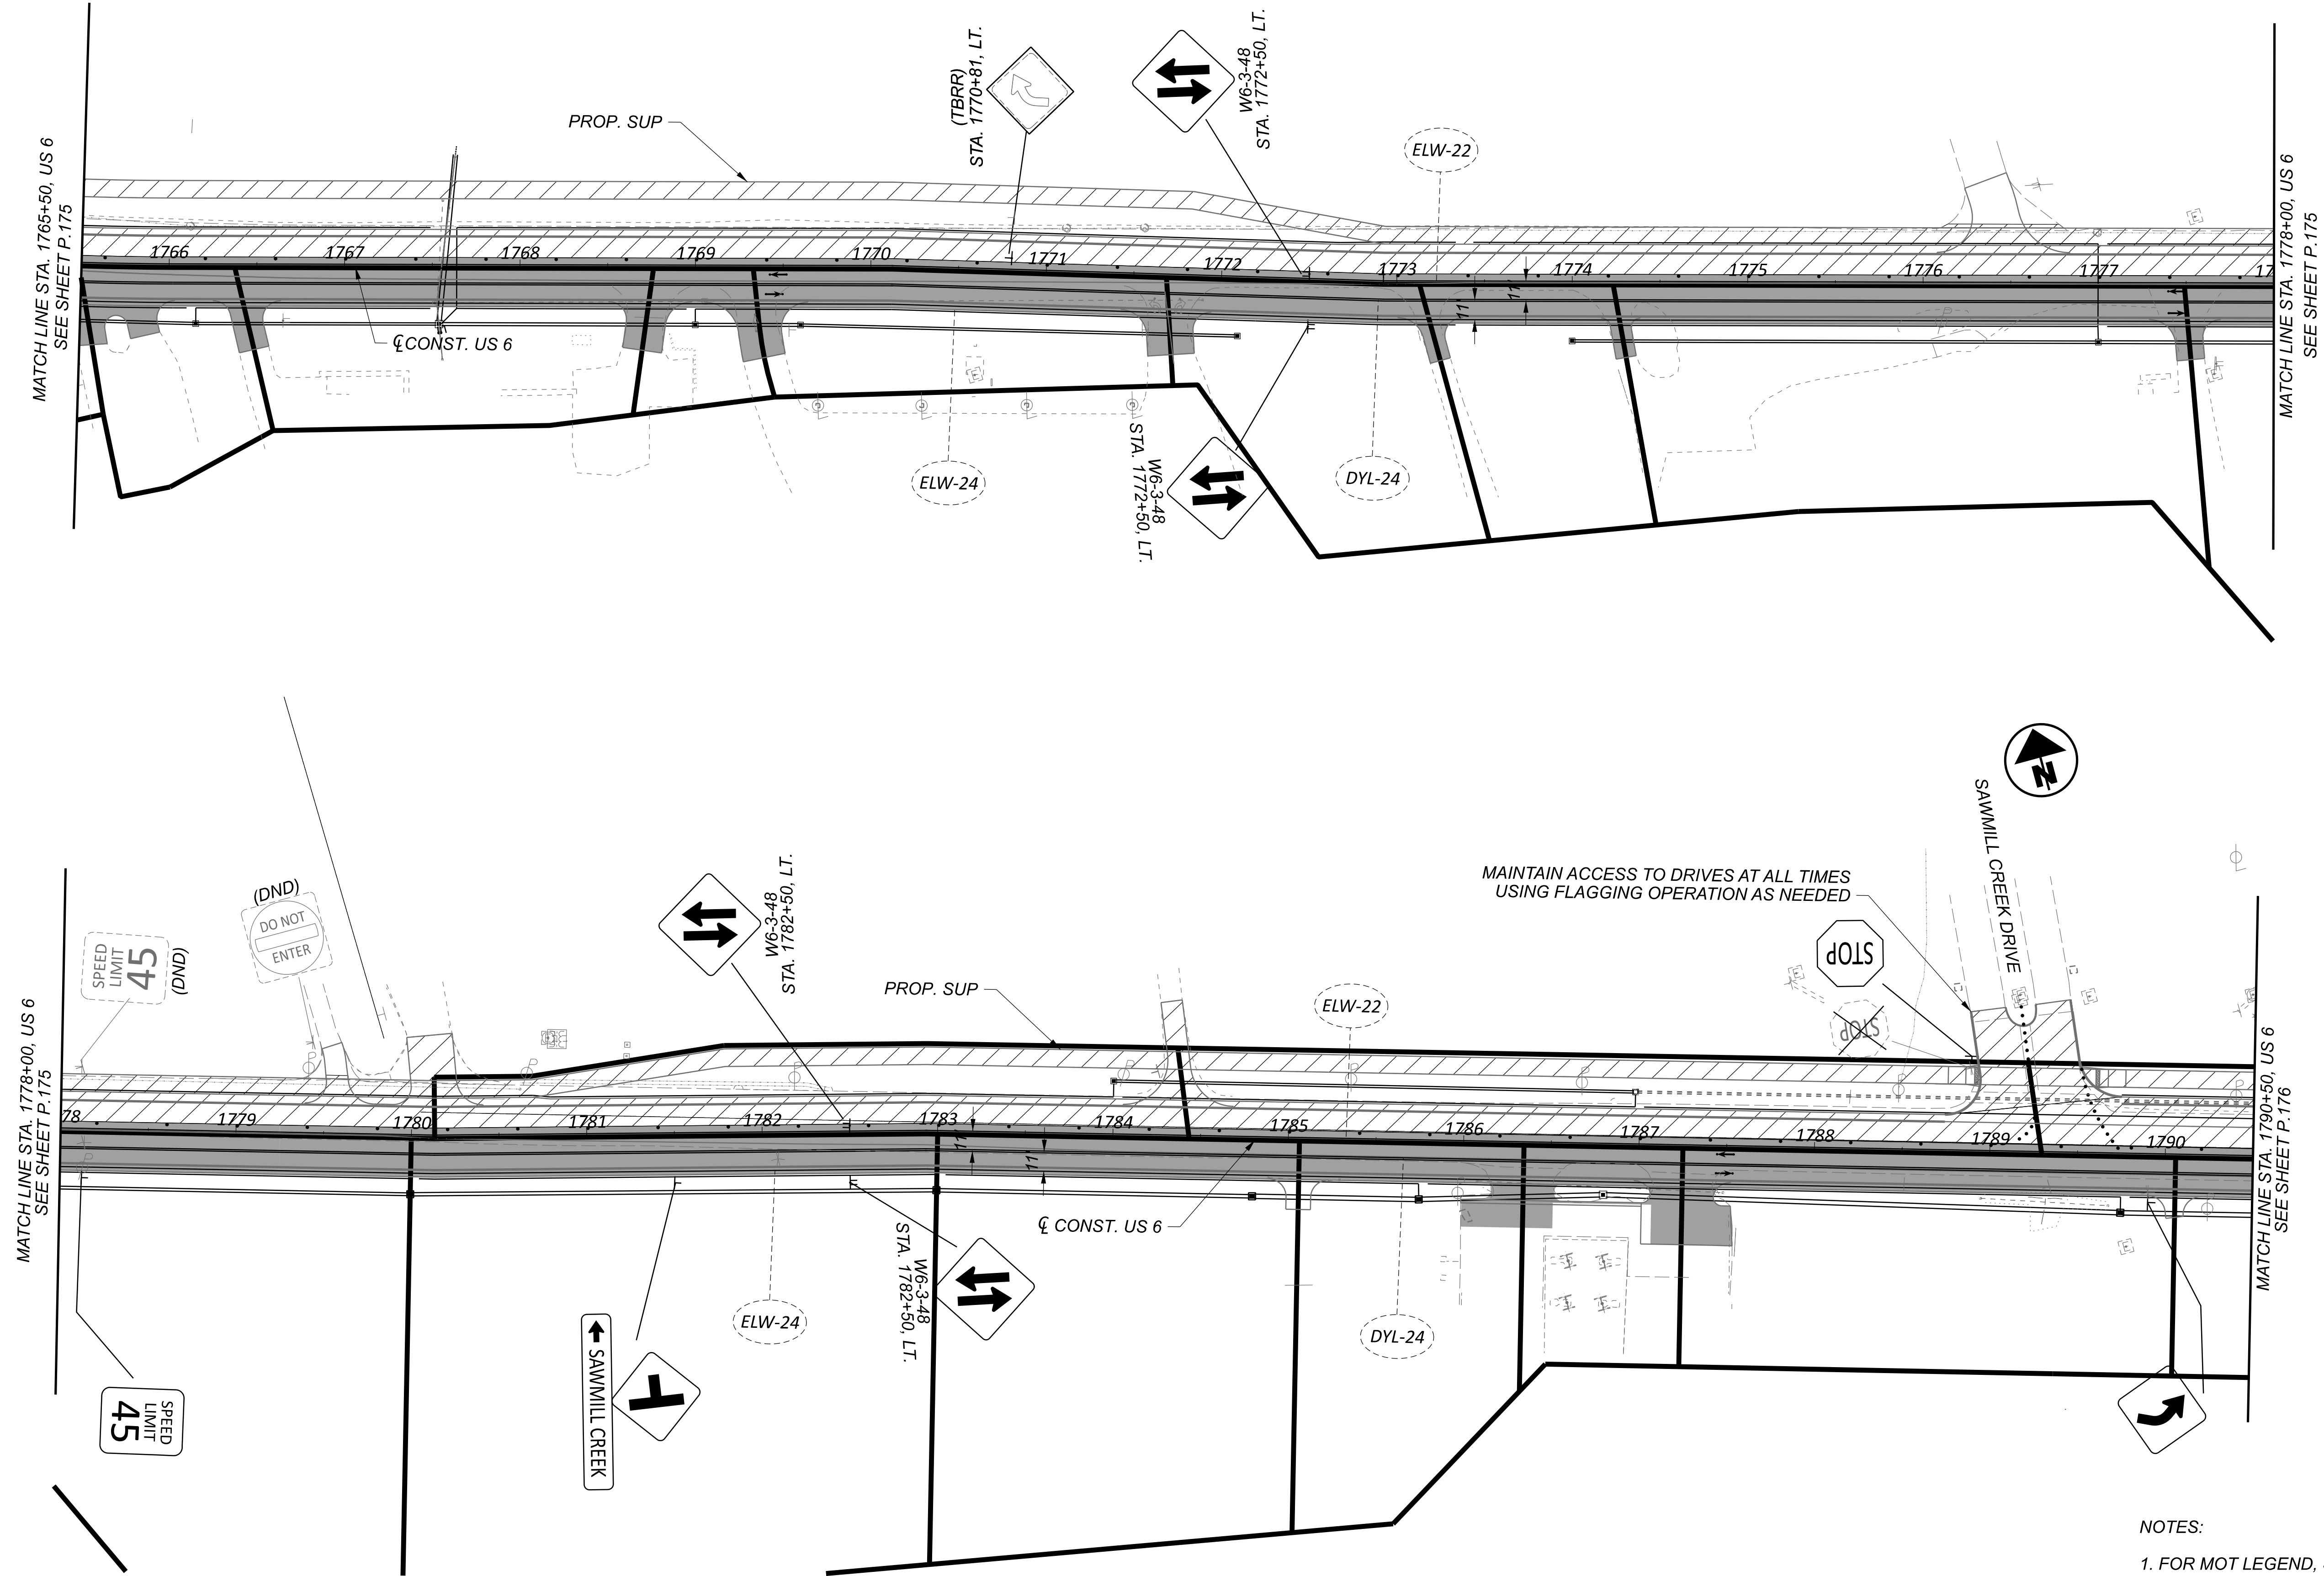

NOTES:


1. FOR MOT LEGEND, SEE SHEET P.067.


DESIGN AGENCY

TRANSYSTEMS
400 W. NATIONWIDE BLVD., STE 225
COLUMBUS, OHIO 43215

DESIGNER	
SSA	
REVIEWER	
SS	02/28/24
PROJECT ID	
116570	
SHEET	TOTAL
P.178	782

MAINTENANCE OF TRAFFIC - PHASE 2
US 6 - STA. 1765+50.00 TO STA. 1790+50.00

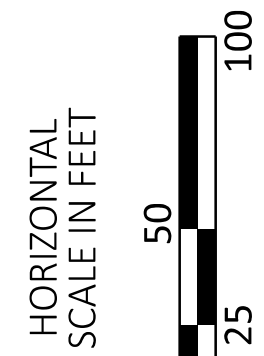


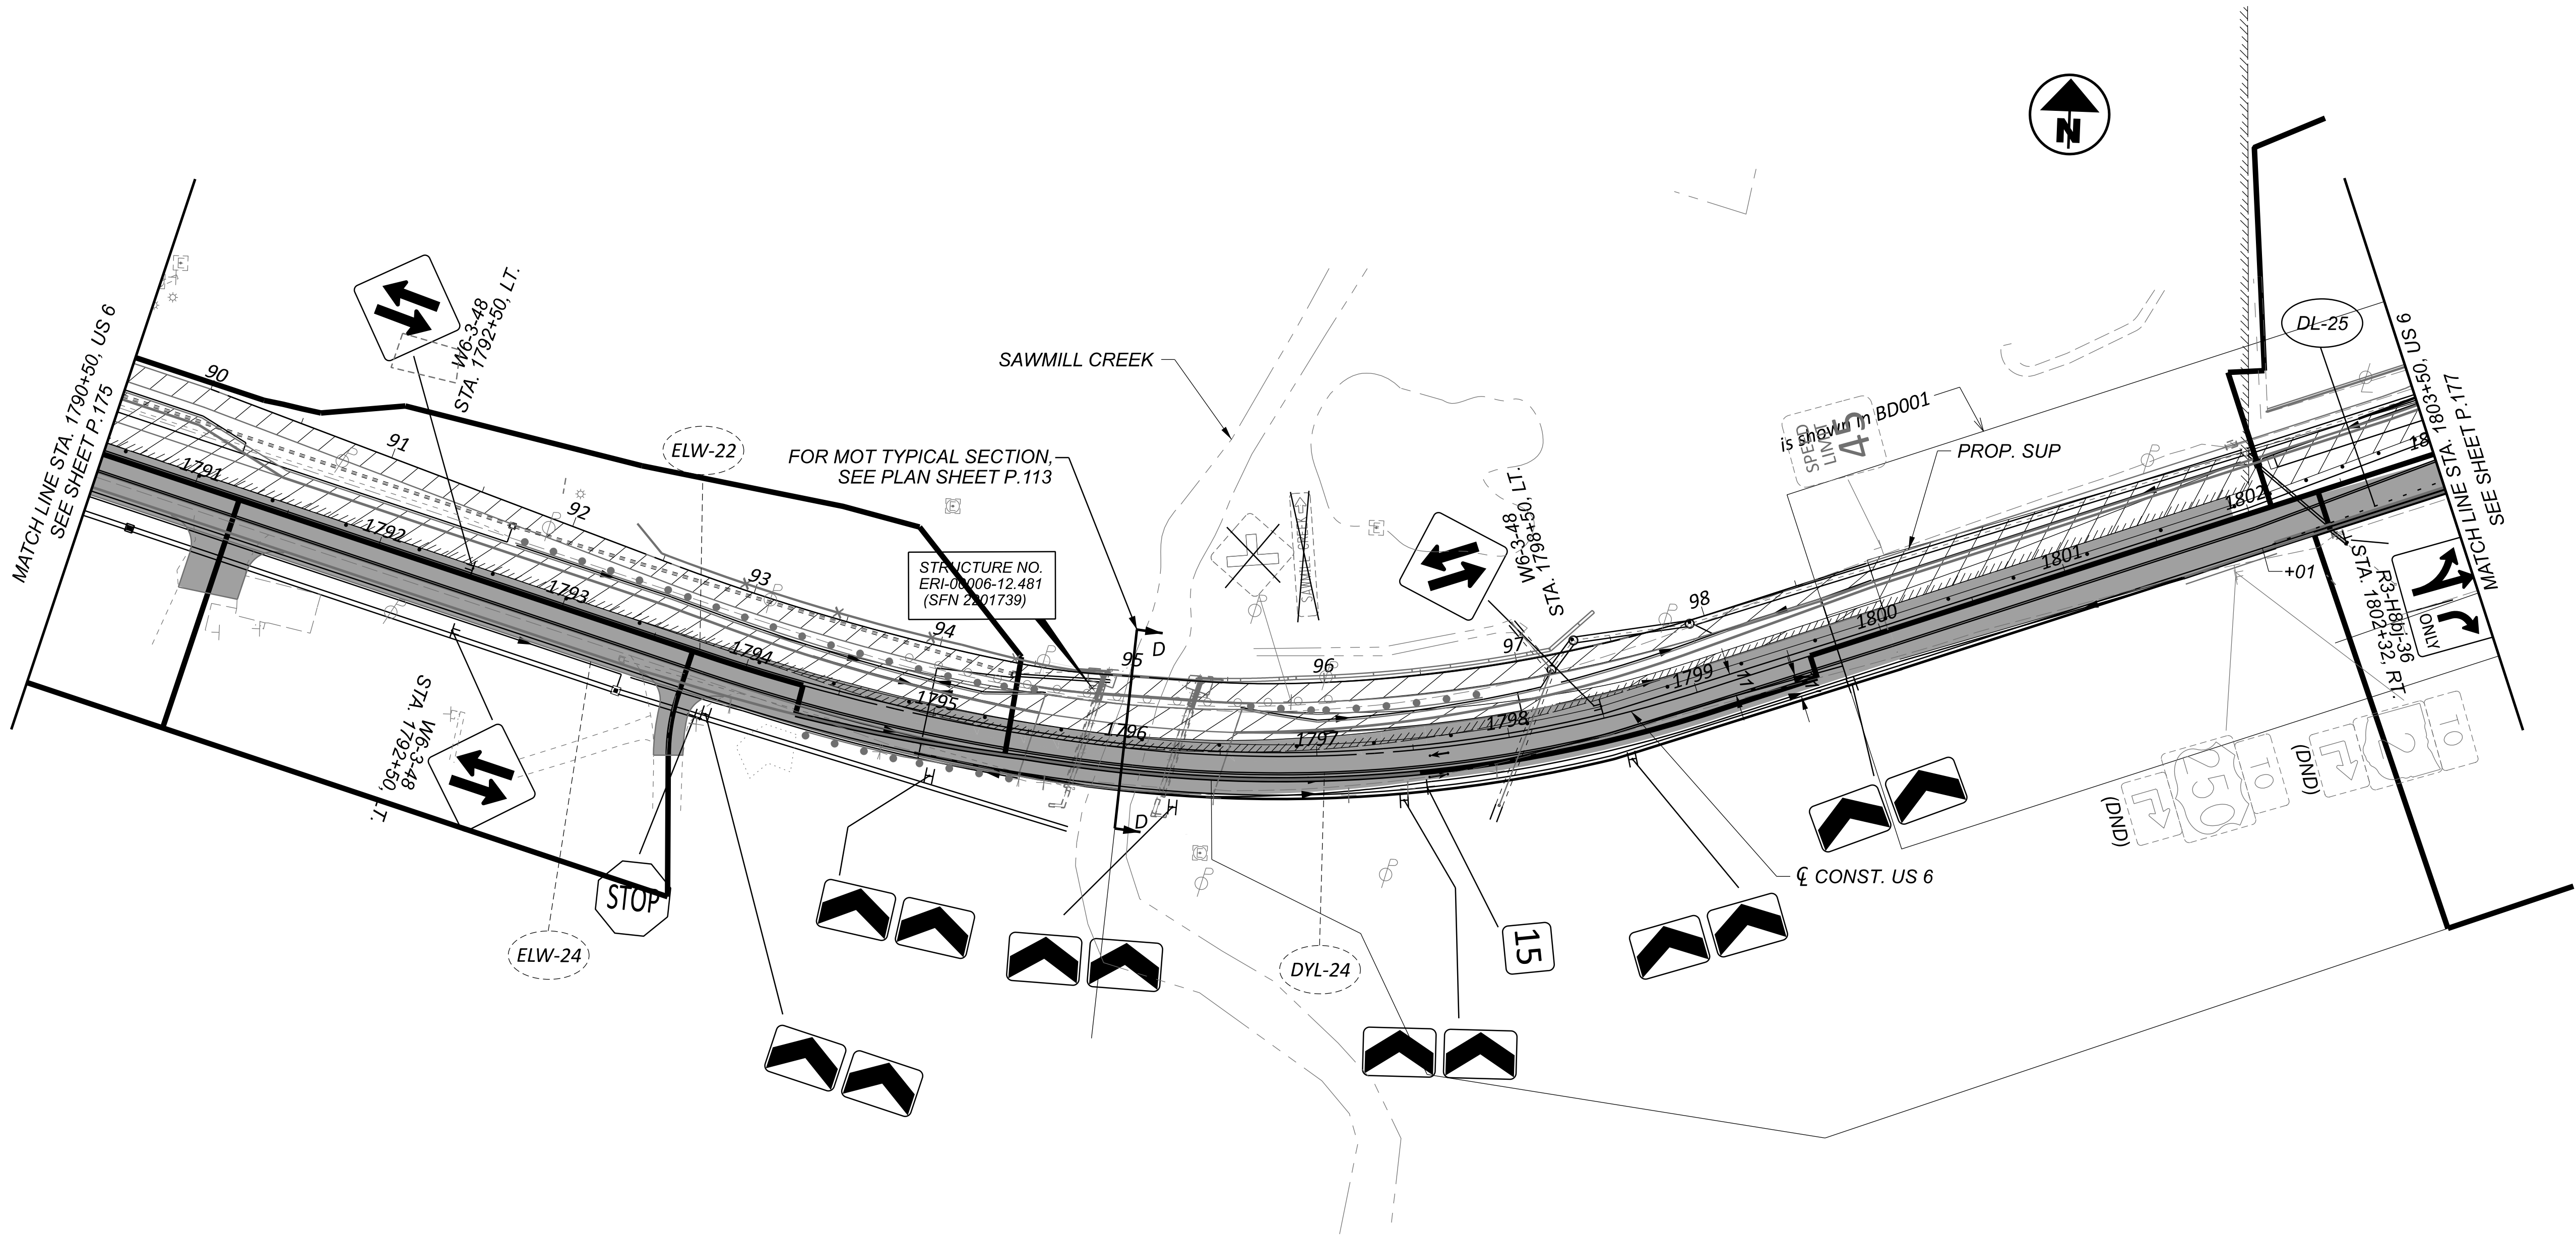

NOTES:
1. FOR MOT LEGEND, SEE SHEET P.067.


TRANSYSTEMS 400 W. WATSONWIDE BLVD., STE. 225 COLUMBUS, OHIO 43215	
DESIGNER	SSA
REVIEWER	SS 02/28/24
PROJECT ID	116570
SHEET	P.179
TOTAL	782

MAINTENANCE OF TRAFFIC - PHASE 2
US - 6 STA. 1790+50.00 TO STA. 1803+00.00

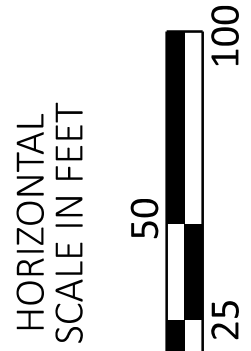

ERI-US 0006-CONNECTIVITY CORRIDOR

MODEL: CLP_SUP_2 - Plan 20 [Sheet] PAPERSIZE: 34x22 (in.) DATE: 6/9/2025 TIME: 11:53:02 AM USER: adlayton
pw://ohiodir-pw.bentley.com:ohiodir-pw-02/Documents\Q1 Active Projects\District 03\Ere\11570402-Engineering_TransSystems\MOT\Sheets\11570402-MPO02.dgn

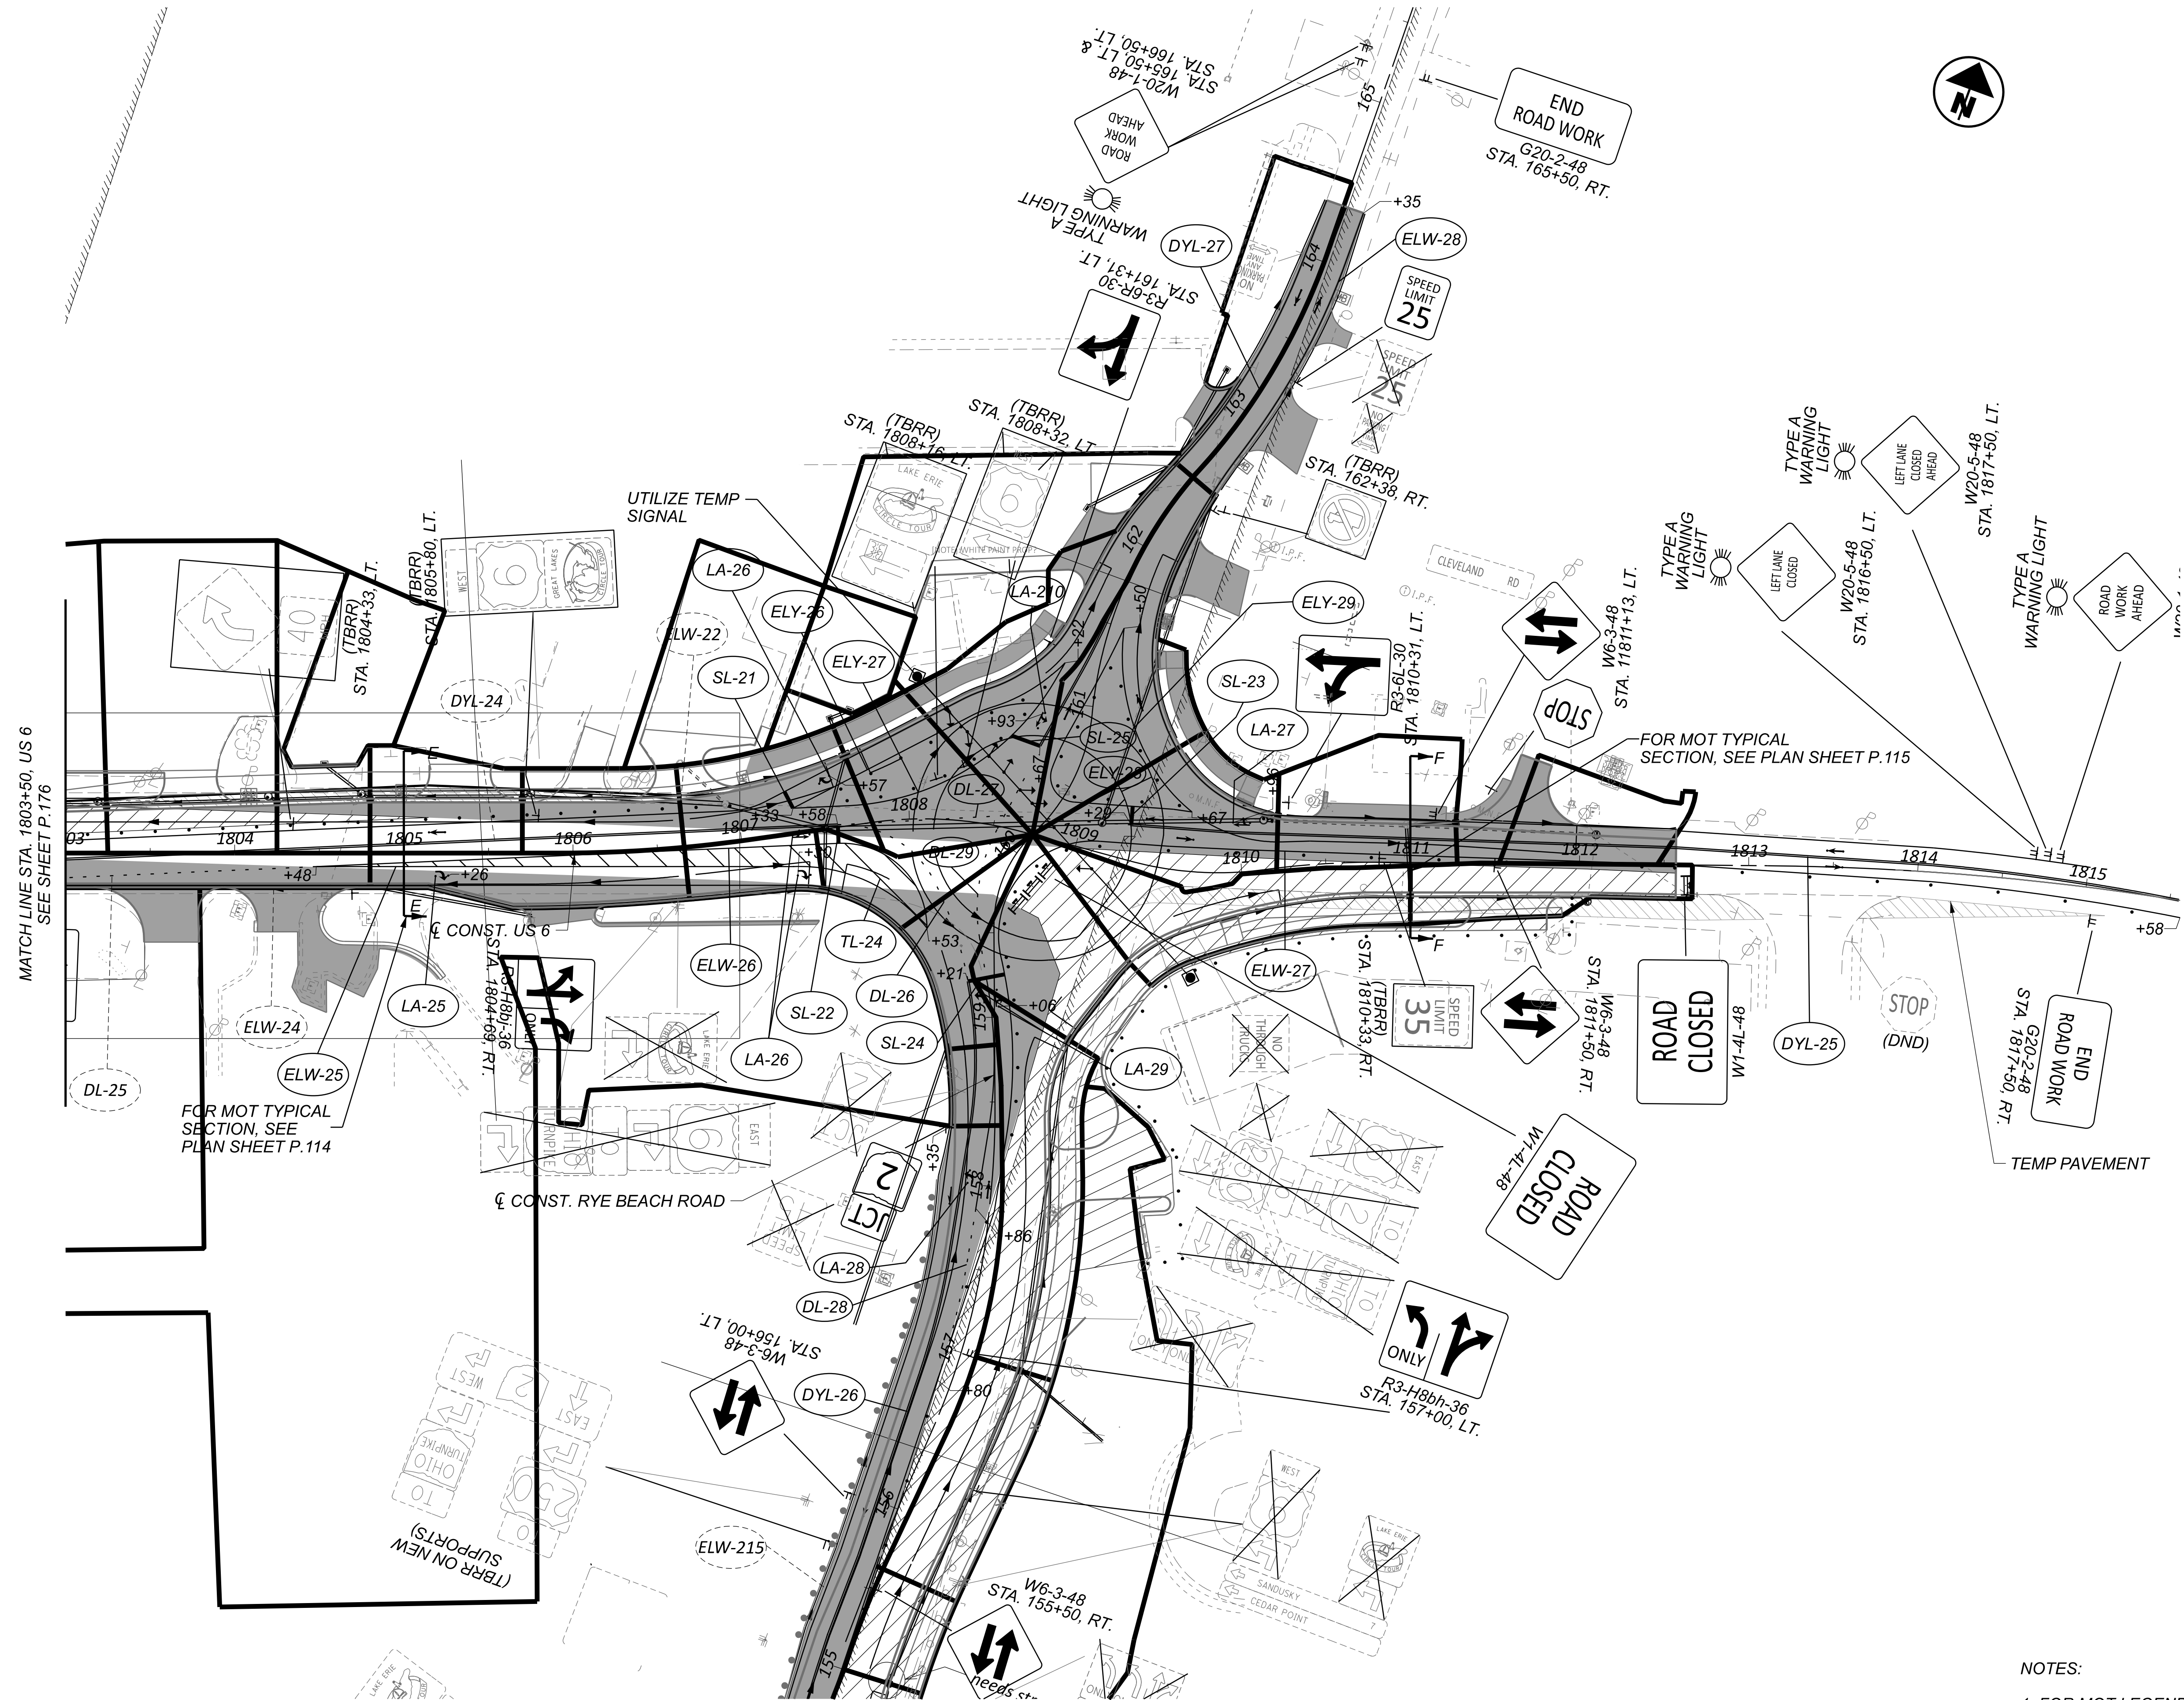



NOTES:

1. FOR MOT LEGEND, SEE SHEET P.067.


DESIGN AGENCY	
TRANSYSTEMS	400 W. NATIONWIDE BLVD., STE 225 COLUMBUS, OHIO 3215
DESIGNER	
SSA	
REVIEWER	
SS	02/28/24
PROJECT ID	
116570	
SHEET	TOTAL
P.180	782

MAINTENANCE OF TRAFFIC - PHASE 2
US 6 - STA. 1803+00.00 TO END PROJECT

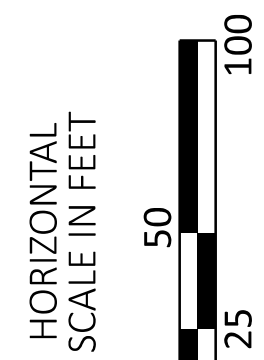


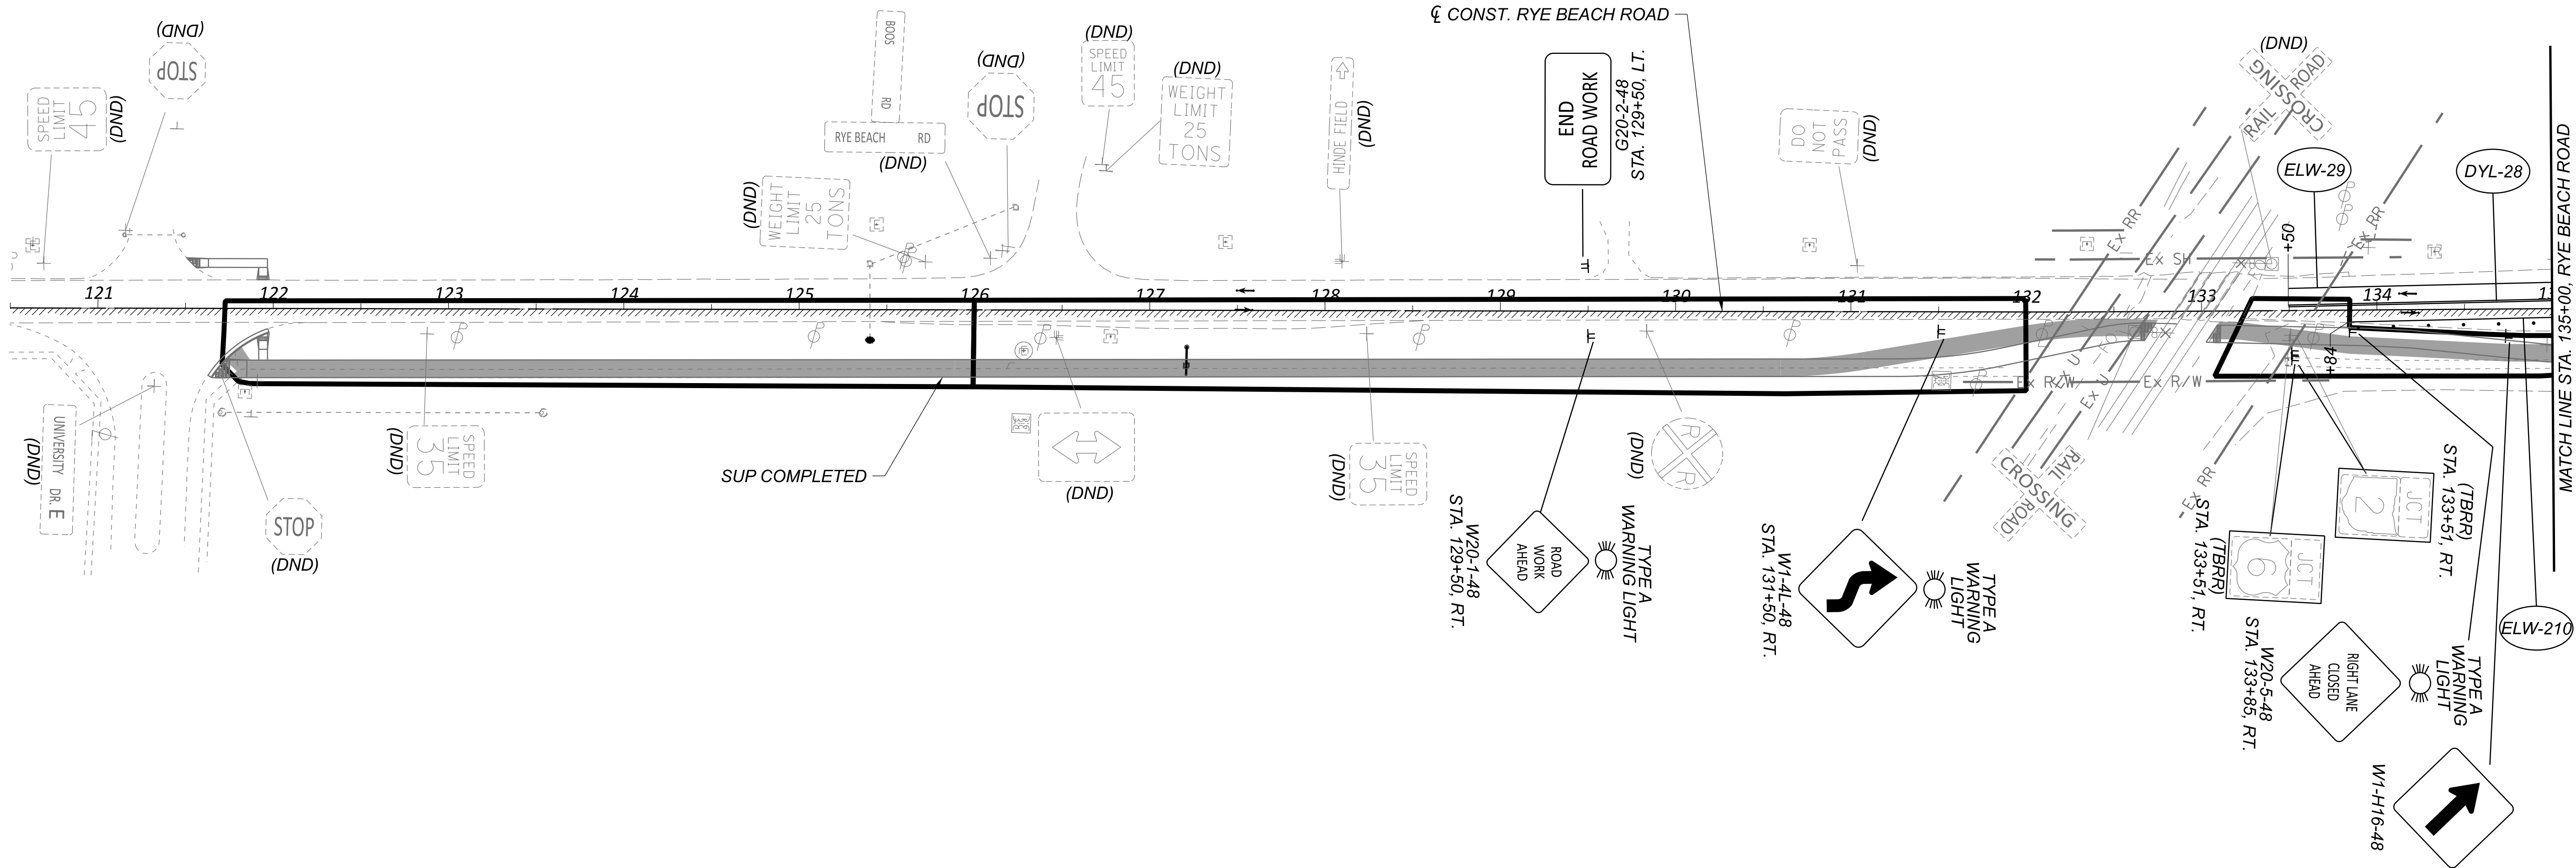

NOTES:
1. FOR MOT LEGEND, SEE SHEET P.067.

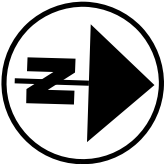

MAINTENANCE OF TRAFFIC - PHASE 2
RYE BEACH ROAD - BEGIN PROJECT TO STA. 135+00.00

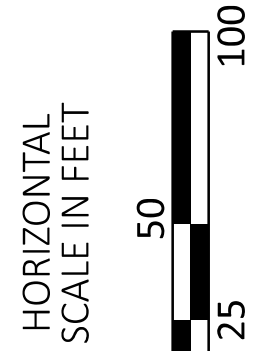

DESIGN AGENCY	
TRANSYSTEMS 400 W. WATKINSON BLVD., STE. 225 COLUMBUS, OHIO 43215	
DESIGNER	SSA
REVIEWER	SS 02/28/24
PROJECT ID	116570
SHEET	TOTAL
P.181	782



DESIGN AGENCY
TRANSYSTEMS
 400 W. NATIONWIDE BLVD., STE 225
 COLUMBUS, OHIO 43215



DESIGNER
SSA

REVIEWER
SS 02/28/24

PROJECT ID
116570

SHEET TOTAL
P.182 | 782

MAINTENANCE OF TRAFFIC - PHASE 2
 RYE BEACH ROAD - STA. 135+00.00 TO STA. 147+50.00

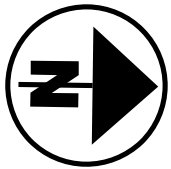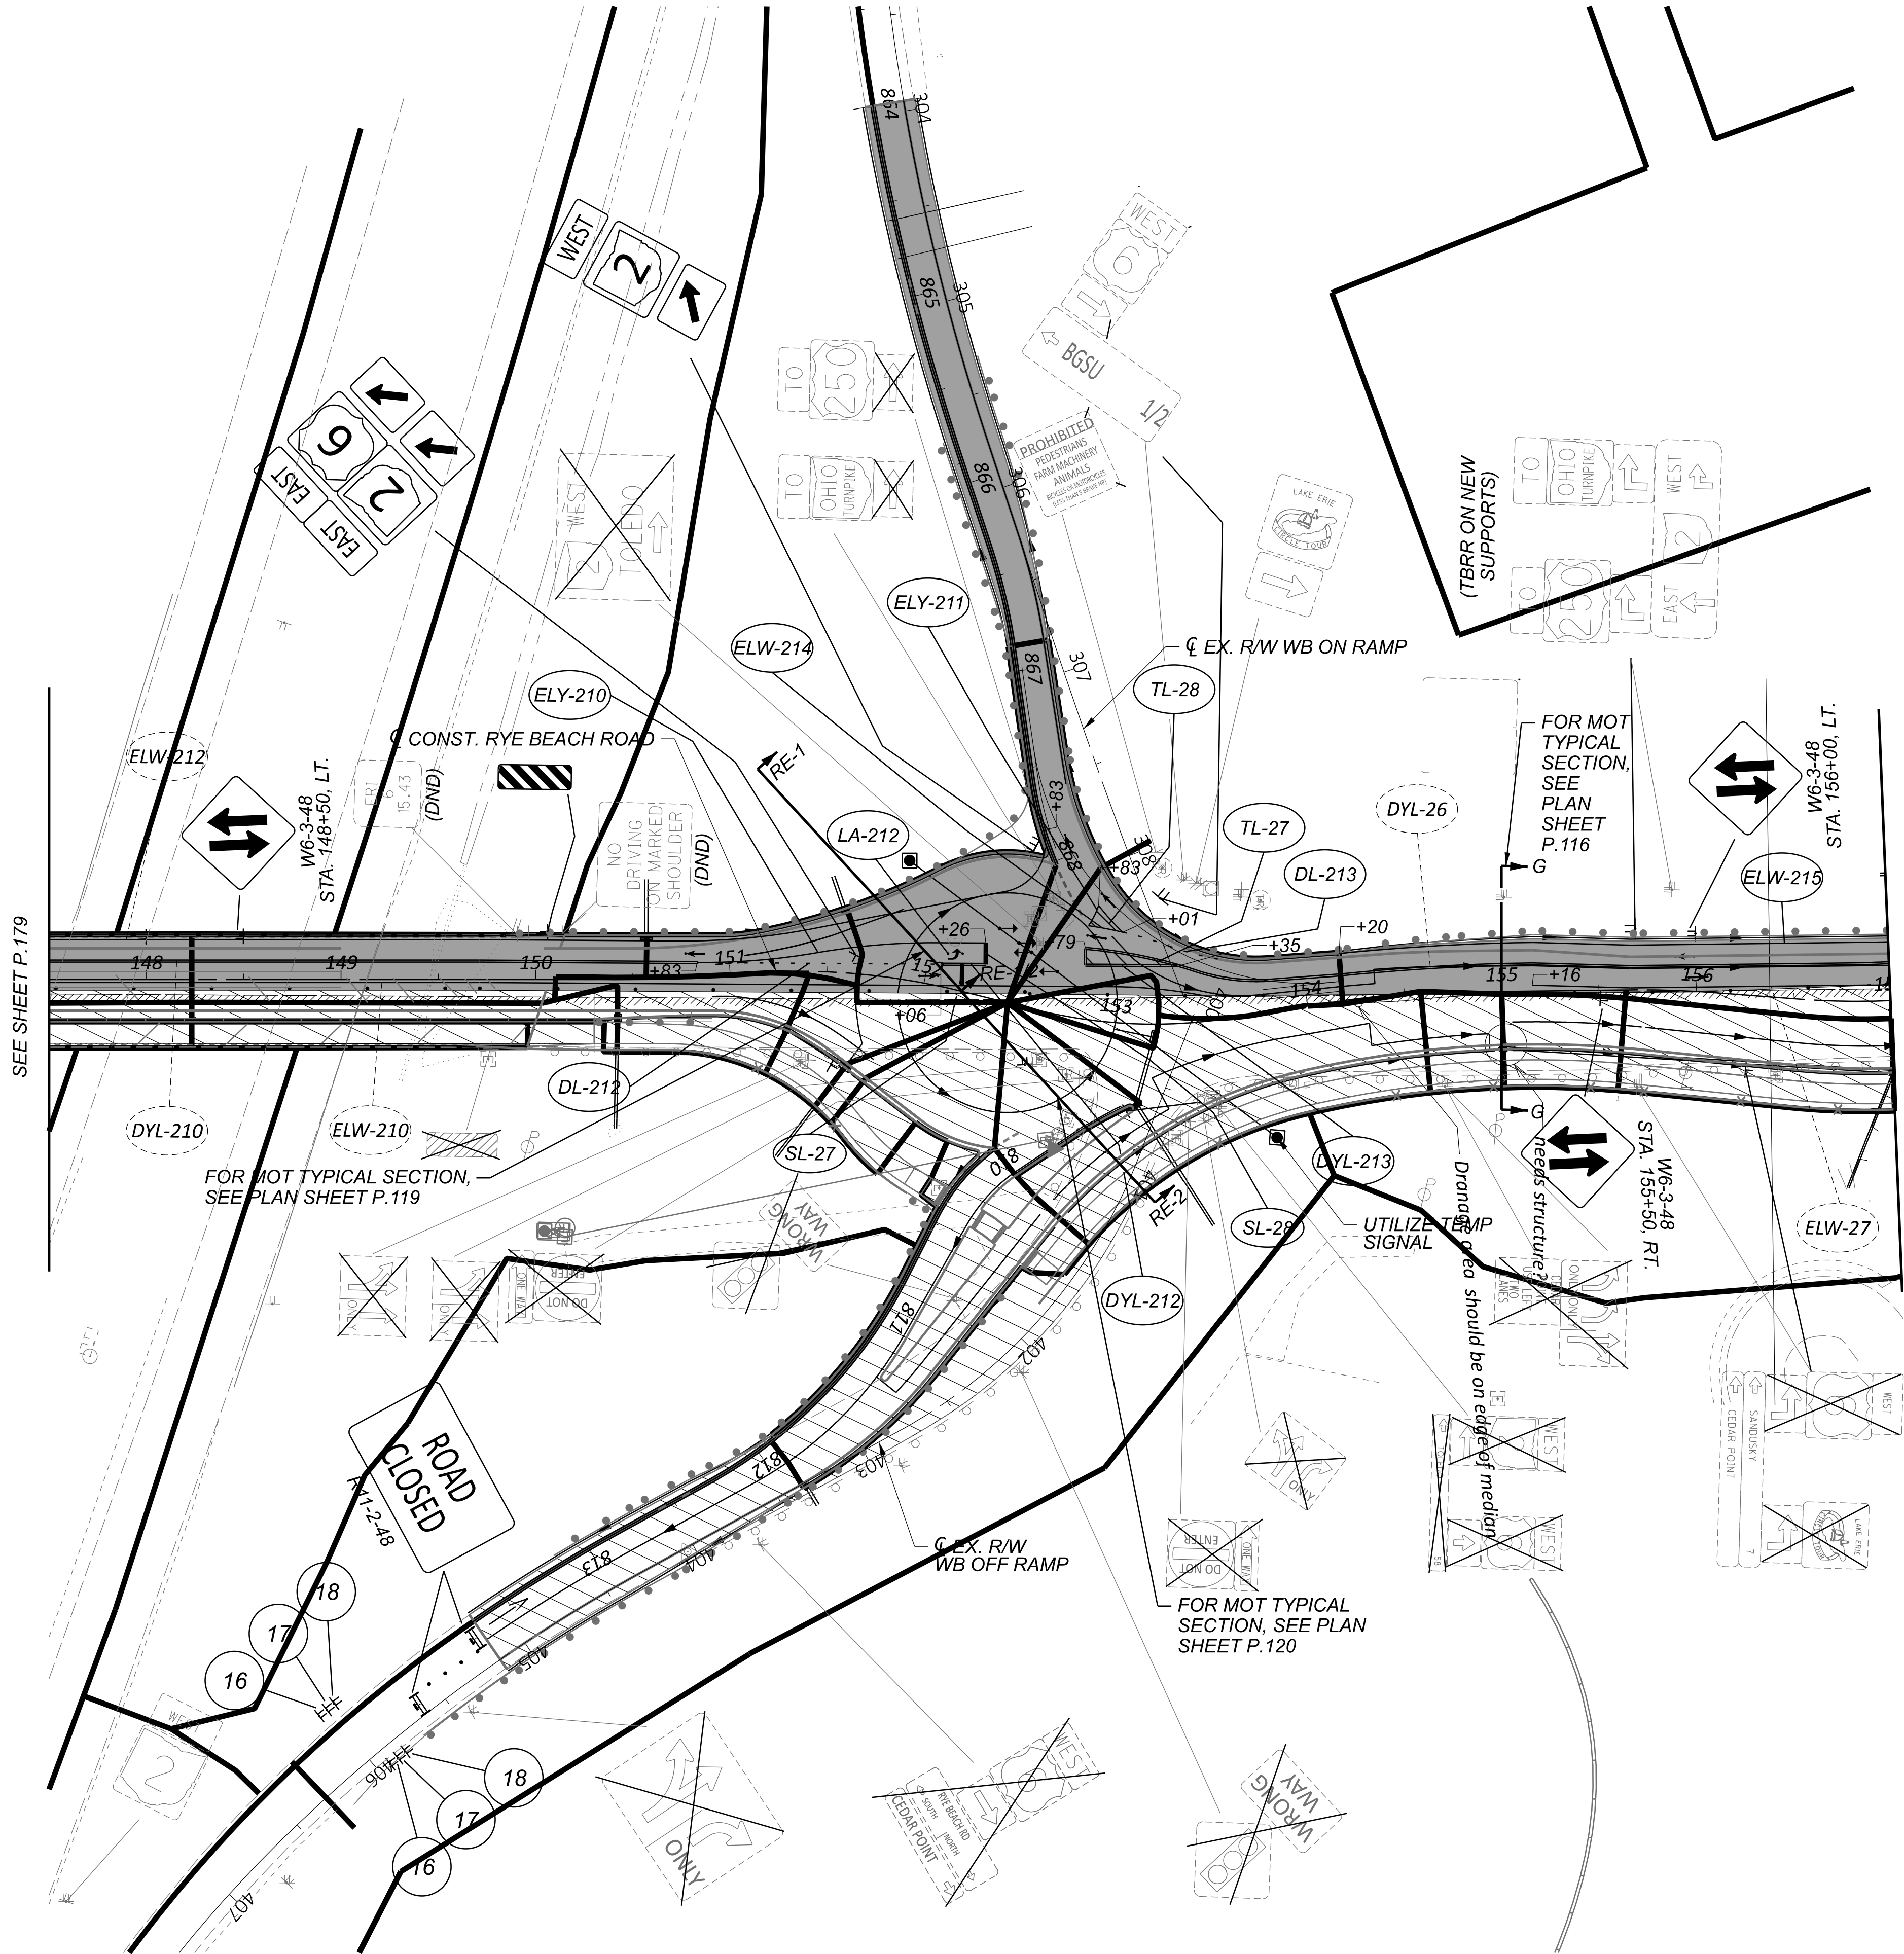


- 16
TYPE A
WARNING LIGHT

ROAD
WORK
AHEAD
W20-1-48
(PER SCD MT-98.29)
- 17
TYPE A
WARNING LIGHT

EXIT
CLOSED
AHEAD
E5-H2c-48
(PER SCD MT-98.29)
- 18
EXIT
CLOSED
E5-2a-48
(PER SCD MT-98.29)

NOTES:
1. FOR MOT LEGEND, SEE SHEET P.067.

MAINTENANCE OF TRAFFIC - PHASE 2
RYE BEACH ROAD - STA. 147+50.00 TO STA. 157+00.00

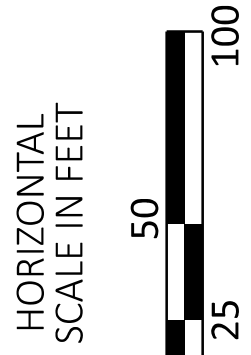

DESIGN AGENCY	
TRANSYSTEMS 400 W. WATKINSON BLVD., STE. 225 COLUMBUS, OHIO 43215	
DESIGNER	
SSA	
REVIEWER	
SS 02/28/24	
PROJECT ID	
116570	
SHEET	TOTAL
P.183	782