National Engineering & Architectural Services, INC. (NEAS)
2800 Corporate Exchange Dr.
Suite 240
Columbus, Ohio 43231
Office: (614) 714-0299
Fax: (614) 714-0251

LEVEL A TEST HOLE CERTIFICATION FORM

PROJECT NAME: AKRON CENTRAL INTERCHANGE, PID#: 101402
NEAS PROJECT #: 16-0153
PROJECT LOCATION (CTY., CITY, ST.): SUMMIT, AKRON, OH.
FOREMAN/TRUCK: N. MILLER/A. CROOKS/J. HINKLE
DATE OF EXCAVATION: 02/18/19
WEATHER CONDITIONS: 16° LIGHT SNOW

TEST HOLE #: 001
UTILITY TO BE LOCATED: STORM LINE (FOUND)

CONTROL POINT: 3
NORTHING: 510268.0710
EASTING: 2240350.2250
ELEVATION: 1038.87

TEST HOLE LOCATION (PAV., BERM, ETC): PAVED INSIDE SHOULDER
EXISTING SURFACE GRADE ELEVATION: 1073.84
PAVING CONDITION PRIOR TO WORK: GOOD
PAVING THICKNESS AND TYPE: 0.25' ASPHALT, 0.7' CONCRETE
SOIL TYPE: ROCK & CLAY FIELD CONDITIONS: DRY
COLOR OF RIBBON INSTALLED IN TEST HOLE: N/A

FIELD REMARKS: N/A

SIZE OF UTILITY: 36"
TYPE OF UTILITY: RCP
THE UTILITY WAS IN GOOD CONDITION
THERE WERE NOT ADDITIONAL UTILITIES IN THE TEST HOLE
SURVEYED ELEVATION TOP OF UTILITY: 1066.22
SURVEYED ELEVATION BOTTOM OF UTIL (IF REQ.): N/A
SURVEYED NORTHING TOP OF UTILITY: 508690.7031 *
SURVEYED EASTING TOP OF UTILITY: 2243051.7198 *
DEPTH OF UTILITY LINE FROM SURFACE: 7.6' TO TOP
DIRECTION OF UTILITY LINE: SOUTH TO NORTH
PHOTO IMAGE NUMBERS: 72, 74-76

UTILITY REMARKS: * HORIZONTAL AND VERTICAL LOCATIONS BASED ON INTERPOLATION OF MULTIPLE SURVEY SHOTS AROUND PIPE.

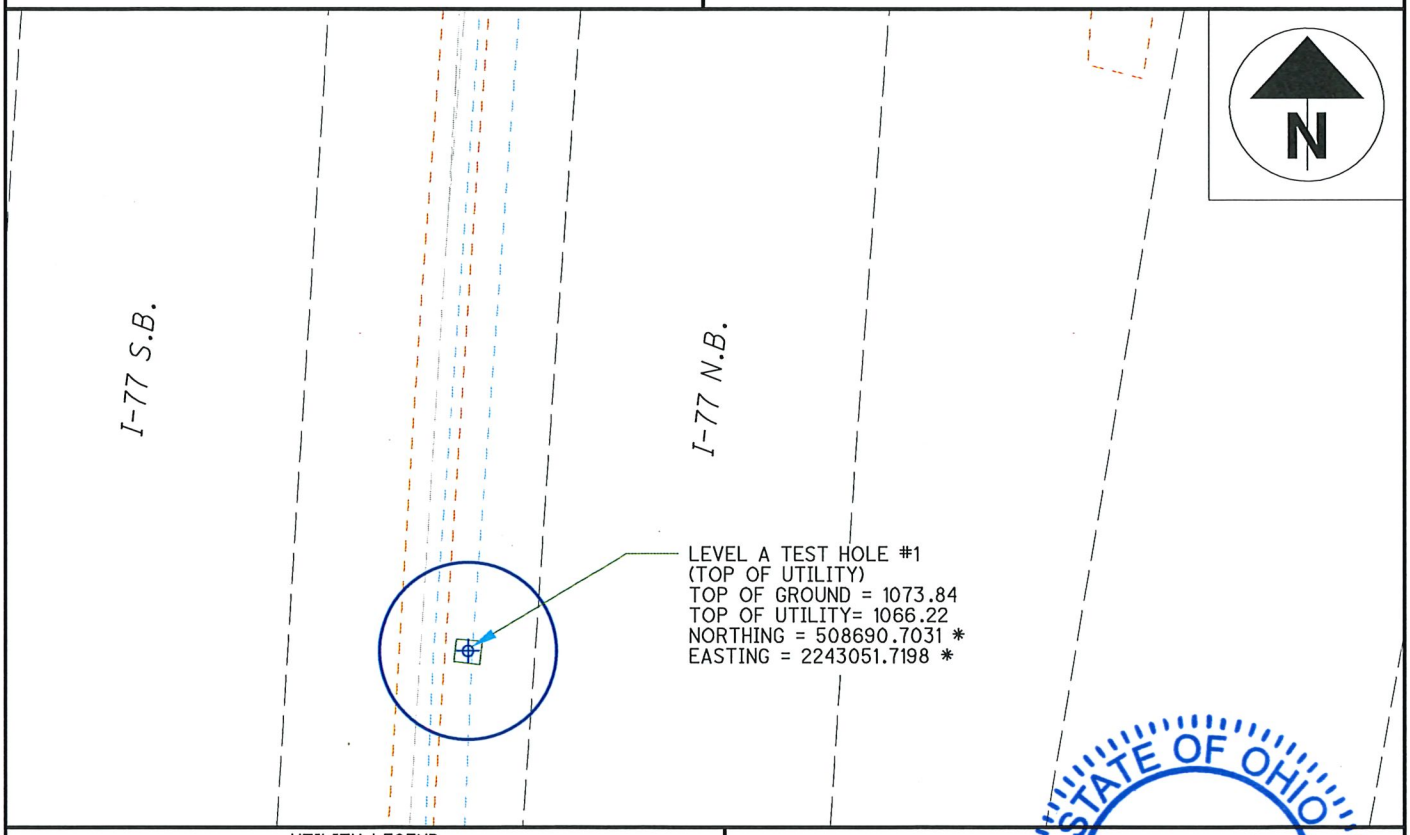

UTILITY LEGEND

GAS	TEST HOLE	ELEC. P.B.
WATER	FIRE HYDRANT	POWER POLE
TELEPHONE	WATER VALVE	POWER/LIGHT
ELECTRIC	GAS MARKER	LIGHT POLE
SANITARY SEWER	GAS VALVE	SAN M.H.
STORM SEWER	F.O. MARKER	TRAFFIC P.B.
FIBER OPTIC	UNKNOWN P.B.	GROUND SHOT
CABLE TV		
TRAFFIC		

I, Charles W. Price, JR. do hereby certify that the positioning of the utility facilities provided utilizing the Quality Levels was performed in accordance with ODOT's SULS specifications.

Charles W. Price, JR., P.S.
DATE 2/26/19

STATE OF OHIO
CHARLES W. PRICE, JR.
S-7825
REGISTERED
PROFESSIONAL SURVEYOR

National Engineering & Architectural Services, INC. (NEAS)
2800 Corporate Exchange Dr.
Suite 240
Columbus, Ohio 43231
Office: (614) 714-0299
Fax: (614) 714-0251

LEVEL A TEST HOLE CERTIFICATION FORM

PROJECT NAME: AKRON CENTRAL INTERCHANGE, PID#: 101402
NEAS PROJECT #: 16-0153
PROJECT LOCATION (CTY., CITY, ST.): SUMMIT, AKRON, OH.
FOREMAN/TRUCK: N. MILLER/A. CROOKS/J. HINKLE
DATE OF EXCAVATION: 02/18/19
WEATHER CONDITIONS: 16° LIGHT SNOW

TEST HOLE #: 002
UTILITY TO BE LOCATED: STORM LINE (FOUND)

CONTROL POINT: 3
NORTHING: 510268.0710
EASTING: 2240350.2250
ELEVATION: 1038.87

TEST HOLE LOCATION (PAV., BERM, ETC): PAVED INSIDE SHOULDER
EXISTING SURFACE GRADE ELEVATION: 1055.00
PAVING CONDITION PRIOR TO WORK: GOOD
PAVING THICKNESS AND TYPE: 0.15' ASPHALT, 1.0' CONCRETE
SOIL TYPE: SAND & ROCK FIELD CONDITIONS: DRY
COLOR OF RIBBON INSTALLED IN TEST HOLE: N/A

FIELD REMARKS: N/A

SIZE OF UTILITY: 48"
TYPE OF UTILITY: RCP
THE UTILITY WAS IN GOOD CONDITION
THERE WERE NOT ADDITIONAL UTILITIES IN THE TEST HOLE
SURVEYED ELEVATION TOP OF UTILITY: 1051.97 *
SURVEYED ELEVATION BOTTOM OF UTIL (IF REQ.): N/A
SURVEYED NORTHING TOP OF UTILITY: 509722.6521 *
SURVEYED EASTING TOP OF UTILITY: 2243139.0553 *
DEPTH OF UTILITY LINE FROM SURFACE: 3.0' TO TOP
DIRECTION OF UTILITY LINE: SOUTH TO NORTH
PHOTO IMAGE NUMBERS: 77,78 & 80

UTILITY REMARKS: * HORIZONTAL AND VERTICAL LOCATIONS BASED ON INTERPOLATION OF MULTIPLE SURVEY SHOTS AROUND PIPE.

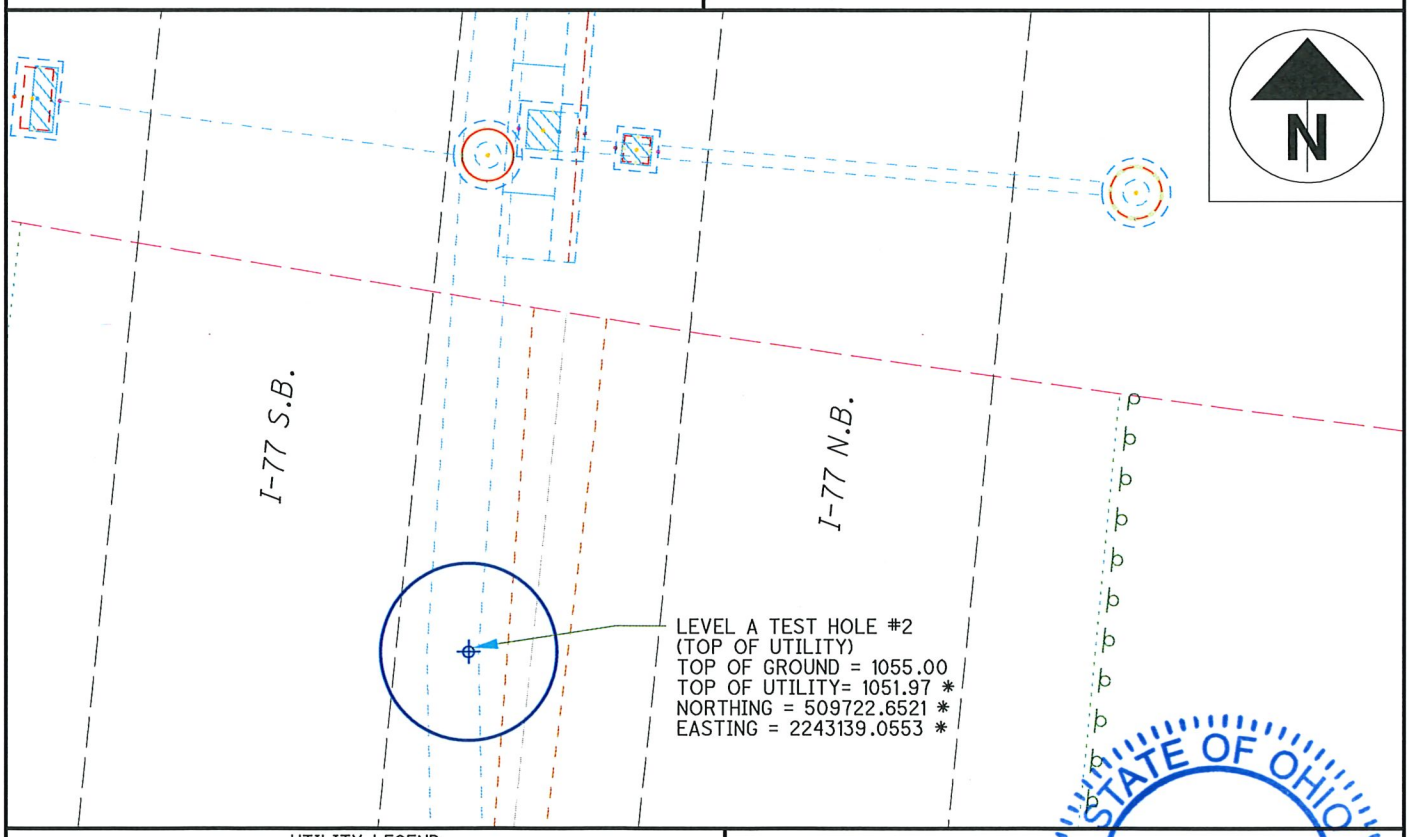

UTILITY LEGEND

GAS	TEST HOLE	ELEC. P.B.
WATER	FIRE HYDRANT	POWER POLE
TELEPHONE	WATER VALVE	POWER/LIGHT
ELECTRIC	GAS MARKER	LIGHT POLE
SANITARY SEWER	GAS VALVE	SAN M.H.
STORM SEWER	F.O. MARKER	TRAFFIC P.B.
FIBER OPTIC	UNKNOWN P.B.	GROUND SHOT
CABLE TV		
TRAFFIC		

I, Charles W. Price, JR. do hereby certify that the positioning of the utility facilities provided utilizing the Quality Levels was performed in accordance with ODOT's SUAS specifications.

Charles W. Price, JR., P.S.
DATE 2/26/19

STATE OF OHIO
CHARLES W. PRICE, JR.
S-7825
REGISTERED
PROFESSIONAL SURVEYOR

National Engineering & Architectural Services, INC. (NEAS)
2800 Corporate Exchange Dr.
Suite 240
Columbus, Ohio 43231
Office: (614) 714-0299
Fax: (614) 714-0251

LEVEL A TEST HOLE CERTIFICATION FORM

PROJECT NAME: AKRON CENTRAL INTERCHANGE, PID#: 101402
NEAS PROJECT #: 16-0153
PROJECT LOCATION (CTY., CITY, ST.): SUMMIT, AKRON, OH.
FOREMAN/TRUCK: N. MILLER/A. CROOKS/J. HINKLE
DATE OF EXCAVATION: 02/19/19
WEATHER CONDITIONS: 28° CLOUDY

TEST HOLE #: 004
UTILITY TO BE LOCATED: SANITARY LINE (FOUND)

CONTROL POINT: 3
NORTHING: 510268.0710
EASTING: 2240350.2250
ELEVATION: 1038.87

TEST HOLE LOCATION (PAV., BERM, ETC): GRAVEL INSIDE SHOULDER
EXISTING SURFACE GRADE ELEVATION: 1083.52
PAVING CONDITION PRIOR TO WORK: N/A
PAVING THICKNESS AND TYPE: N/A
SOIL TYPE: SAND & ROCK FIELD CONDITIONS: DRY
COLOR OF RIBBON INSTALLED IN TEST HOLE: N/A

SIZE OF UTILITY: 42"
TYPE OF UTILITY: RCP
THE UTILITY WAS IN GOOD CONDITION
THERE WERE NOT ADDITIONAL UTILITIES IN THE TEST HOLE
SURVEYED ELEVATION TOP OF UTILITY: 1079.28
SURVEYED ELEVATION BOTTOM OF UTIL (IF REQ.): N/A
SURVEYED NORTHING TOP OF UTILITY: 509748.2710
SURVEYED EASTING TOP OF UTILITY: 2243433.8410
DEPTH OF UTILITY LINE FROM SURFACE: 4.2' TO TOP
DIRECTION OF UTILITY LINE: SOUTHWEST TO NORTHEAST
PHOTO IMAGE NUMBERS: 81-82

FIELD REMARKS: N/A

UTILITY REMARKS: N/A

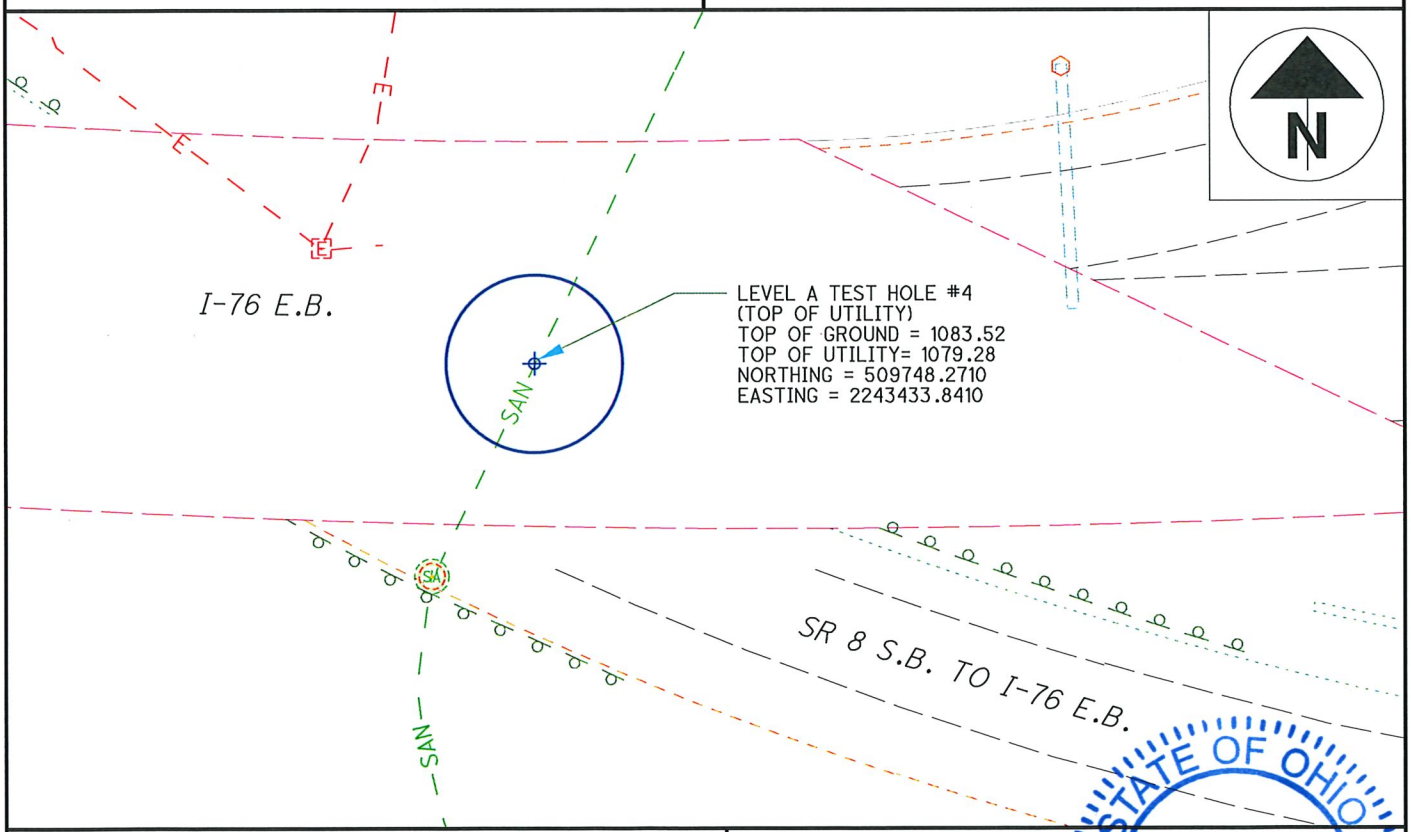

UTILITY LEGEND

GAS	TEST HOLE	ELEC. P.B.
WATER	FIRE HYDRANT	POWER POLE
TELEPHONE	WATER VALVE	POWER/LIGHT
ELECTRIC	GAS MARKER	LIGHT POLE
SANITARY SEWER	GAS VALVE	SAN M.H.
STORM SEWER	F.O. MARKER	TRAFFIC P.B.
FIBER OPTIC	UNKNOWN P.B.	GROUND SHOT
CABLE TV		
TRAFFIC		

I, Charles W. Price, JR. do hereby certify that the positioning of the utility facilities provided utilizing the Quality Levels was performed in accordance with ODOT's SULS specifications

Charles W. Price, JR., P.S.
DATE 2/26/19

STATE OF OHIO
CHARLES W. PRICE, JR.
S-7825
REGISTERED
PROFESSIONAL SURVEYOR

National Engineering & Architectural Services, INC. (NEAS)
2800 Corporate Exchange Dr.
Suite 240
Columbus, Ohio 43231
Office: (614) 714-0299
Fax: (614) 714-0251

LEVEL A TEST HOLE CERTIFICATION FORM

PROJECT NAME: AKRON CENTRAL INTERCHANGE, PID#: 101402
NEAS PROJECT #: 16-0153
PROJECT LOCATION (CTY., CITY, ST.): SUMMIT, AKRON, OH.
FOREMAN/TRUCK: N. MILLER/A. CROOKS/J. HINKLE
DATE OF EXCAVATION: 02/13/19
WEATHER CONDITIONS: 26° SNOW

TEST HOLE #: 006
UTILITY TO BE LOCATED: GAS LINE (FOUND)

CONTROL POINT: 3
NORTHING: 510268.0710
EASTING: 2240350.2250
ELEVATION: 1038.87

TEST HOLE LOCATION (PAV., BERM, ETC): CONCRETE SIDEWALK
EXISTING SURFACE GRADE ELEVATION: 1043.81
PAVING CONDITION PRIOR TO WORK: GOOD
PAVING THICKNESS AND TYPE: 0.29' CONCRETE
SOIL TYPE: SAND & DIRT FIELD CONDITIONS: WET
COLOR OF RIBBON INSTALLED IN TEST HOLE: N/A

SIZE OF UTILITY: 12"
TYPE OF UTILITY: PLASTIC
THE UTILITY WAS NOT IN GOOD CONDITION
THERE WERE NOT ADDITIONAL UTILITIES IN THE TEST HOLE
SURVEYED ELEVATION TOP OF UTILITY: 1042.16
SURVEYED ELEVATION BOTTOM OF UTIL (IF REQ.): N/A
SURVEYED NORTHING TOP OF UTILITY: 509999.4030
SURVEYED EASTING TOP OF UTILITY: 2241752.1270
DEPTH OF UTILITY LINE FROM SURFACE: 1.7' TO TOP
DIRECTION OF UTILITY LINE: SOUTHEAST TO NORTHWEST
PHOTO IMAGE NUMBERS: 65-67

FIELD REMARKS: N/A

UTILITY REMARKS: PIPE WAS BENT TO THE EAST

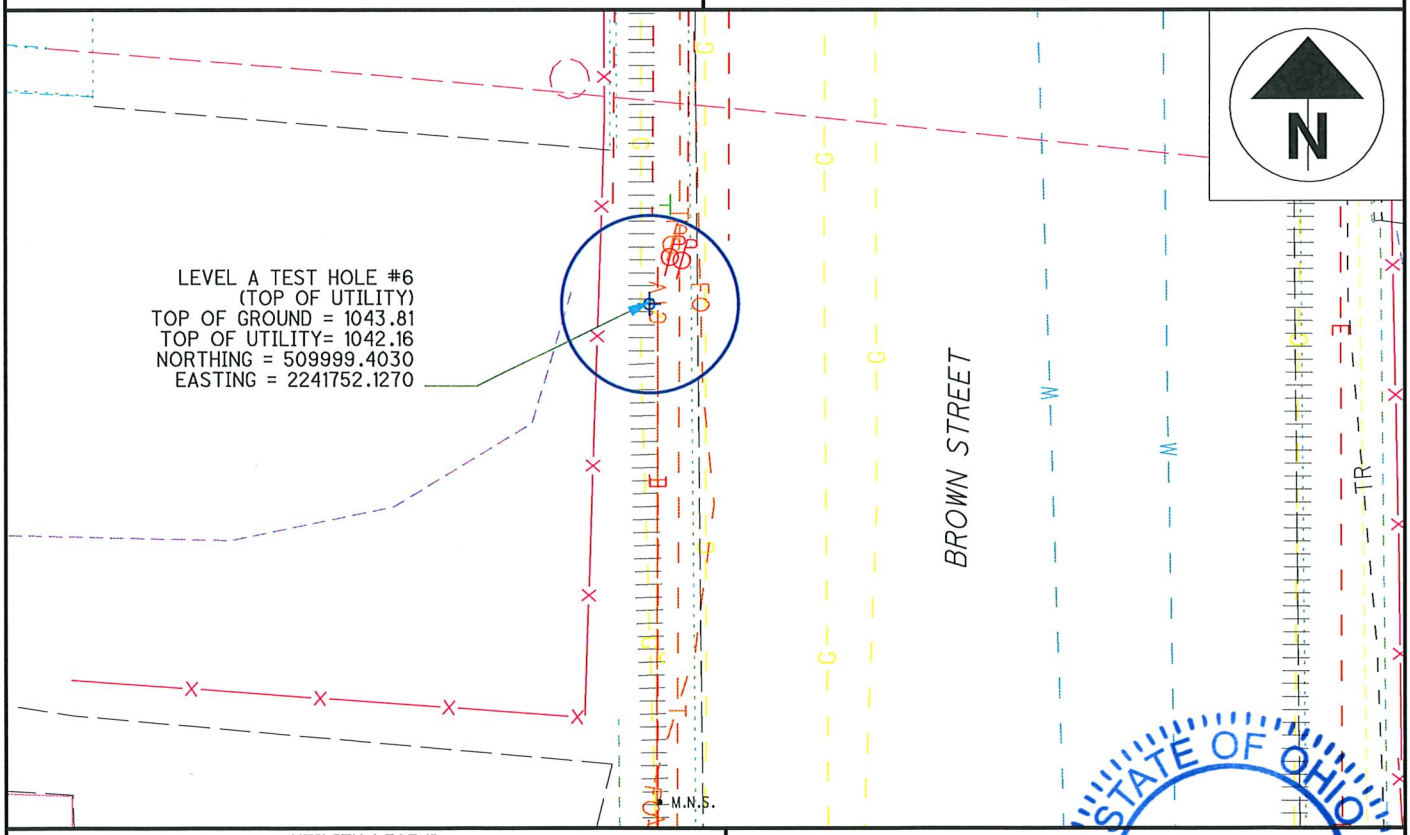

UTILITY LEGEND

GAS	TEST HOLE	ELEC. P.B.
WATER	FIRE HYDRANT	POWER POLE
TELEPHONE	WATER VALVE	POWER/LIGHT
ELECTRIC	GAS MARKER	LIGHT POLE
SANITARY SEWER	GAS VALVE	SAN M.H.
STORM SEWER	F.O. MARKER	TRAFFIC P.B.
FIBER OPTIC	UNKNOWN P.B.	GROUND SHOT
CABLE TV		
TRAFFIC		

I, Charles W. Price, JR. do hereby certify that the positioning of the utility facilities provided utilizing the Quality Levels was performed in accordance with ODOT's SUE specifications.

Charles W. Price, JR., P.S.
DATE 2/26/19

STATE OF OHIO
CHARLES W. PRICE, JR.
S-7825
REGISTERED
PROFESSIONAL SURVEYOR