

Heim, Kimber

From: Wooldridge, John
Sent: Friday, June 5, 2020 11:08 AM
To: 'jhoward@wearehls.com'; 'choward@wearehls.com'
Cc: Heim, Kimber; Norton, Harvey
Subject: 110412 FAI 037 Safety Project D5 Requests Cost Proposal ASAP
Attachments: 110412 FAI 037 Preliminary RW with all sheets.pdf; 110412 FAI 037 Cost Proposal 34127 HLS 060520.xlsx

Importance: High

Hello Chris and James,

We hope you are all doing well over at HLS. I apologize for the short notice on this. D5 invites you to provide a cost proposal for this project. At this time; we will authorize PE phase APPRAISAL work (and PM) only for these parcels:

- LSUM: PCL 1 & 4.
- VF: PCL 6, 8, 9, 11, 15, 17, 18, & 20.
- PM X 10 PCL.

The acquisition service needs, if any, are undecided at this time; however, I am asking that you provide all the project costs on the proposal so that we can authorize if needed (including negotiation, closings, asbestos, and appropriation support for trials, etc.).

Project Dates:

- **Authorize Appraisals around 6/15/20.**
- **Appraisal and PM (PE Phase) due 8/15/20.**
- Project Authorization (offers) is 9/1/20.
- Clear Date (acquisition complete) [for Utility Relocation] is 5/31/2021.
- Plan File is 10/1/21.

Please submit the cost proposal (just fill in the highlighted fields on the attached spreadsheet and return) by (is needed soon) on Monday COB 6/8/20 to ensure we can encumber the funds prior to Fiscal shutdown. Unfortunately, we cannot encumber money (therefore cannot authorize work) from June 10 until Late July; so your timely attention to this request is needed. Kimber did mention that she already has spoken to your team at HLS about this.

In addition to the proposed costs needed; please provide the name or names of the appraisal for inclusion on the authorization and the checklists (scope doc) that I will provide to the Reviewer (Harvey Norton of CO ODOT) as soon as I have the names (we will both sign and have to your appraiser(s) ASAP. Thanks!

Please let me know if you have any questions, comments, or concerns. Thank you.

Respectfully,

John R. Wooldridge

Real Estate Administrator

ODOT District 5

9600 Jacksontown Road, Jacksontown, OH 43030



From: Wooldridge, John

Sent: Monday, May 11, 2020 5:12 PM

To: Walker, Luke <Luke.Walker@dot.ohio.gov>; Morgan, Douglas <Doug.Morgan@dot.ohio.gov>; Heim, Kimber <Kimber.Heim@dot.ohio.gov>

Subject: RE: FAI-37-6.34 Preliminary Right of Way Plans (PID No. 110412)


Hello Doug,

I looked over these plans and have only a few comments as they were pretty good for R/W. The Stage 1 comments and our meeting with them was obviously beneficial to the quality of this submission. Thanks Doug.

- Missing sheet 20 of 37 as Luke stated.
- Page 21/36 (22/37) Parcel 11-SH shows "Utility Pole Save" for private light poles. I would have them removed as ODOT will need to pay for them anyways (in take area) and would need to do a permit (not recommended) for the poles that are very close to the fence needing removed. Same Parcel has three of those poles (not 2) and also has a small sign near the fence that was not picked up on these plans:



- Page 23/36 (24/37) Can Parcel 12-SH be completely removed? The Construction limits are almost all out of the take and the ditch is in the Ex R/W. Could save some money having one less parcel.
- Page 25/36 (26/37) 14 no take, Please mark encroachment of a singular post:

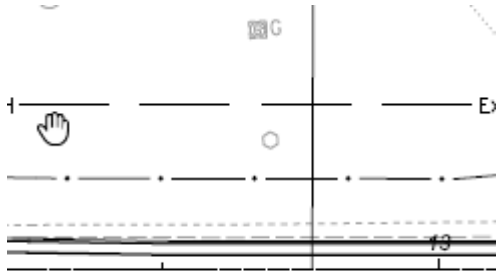

○



○

- PG 31/36 (32/37) We may have future comments about the water building. Pending Village of Thurston review comments. Latest email by Utilities is attached.
- PG 31/36 (32/37) PCL 9 No Take has encroachments to mark for removal (2 of the 3 signs ... last one shown as "save" not in R/W):



- Several pages: “edge of farm field ... SAVE” within R/W is shown; I do not recommend saving that as it will not be permitted and construction company should be able to use all the R/W existing at their discretion. We typically do not label it either save nor remove.
- Legal descriptions were not provided to me and therefore not reviewed against these R/W Plans.

They did a great job of taking our prior comments into consideration and did a very nice job of providing the disposition of improvements in and near the R/W and takes. Thanks.

Please let me know if you have any questions, comments, or concerns. Thank you.

Respectfully,

John R. Wooldridge

Real Estate Administrator

ODOT District 5

9600 Jacksontown Road, Jacksontown, OH 43030

(p) 740.323.5427 (f) 614.887.4546 (m) 740.404.2101

transportation.ohio.gov

