FRA-33-2.64
SECTION 26,27,34,35, TWP. 15, RANGE 20
VIOLET TWP., FAIRFIELD COUNTY, STATE OF OHIO

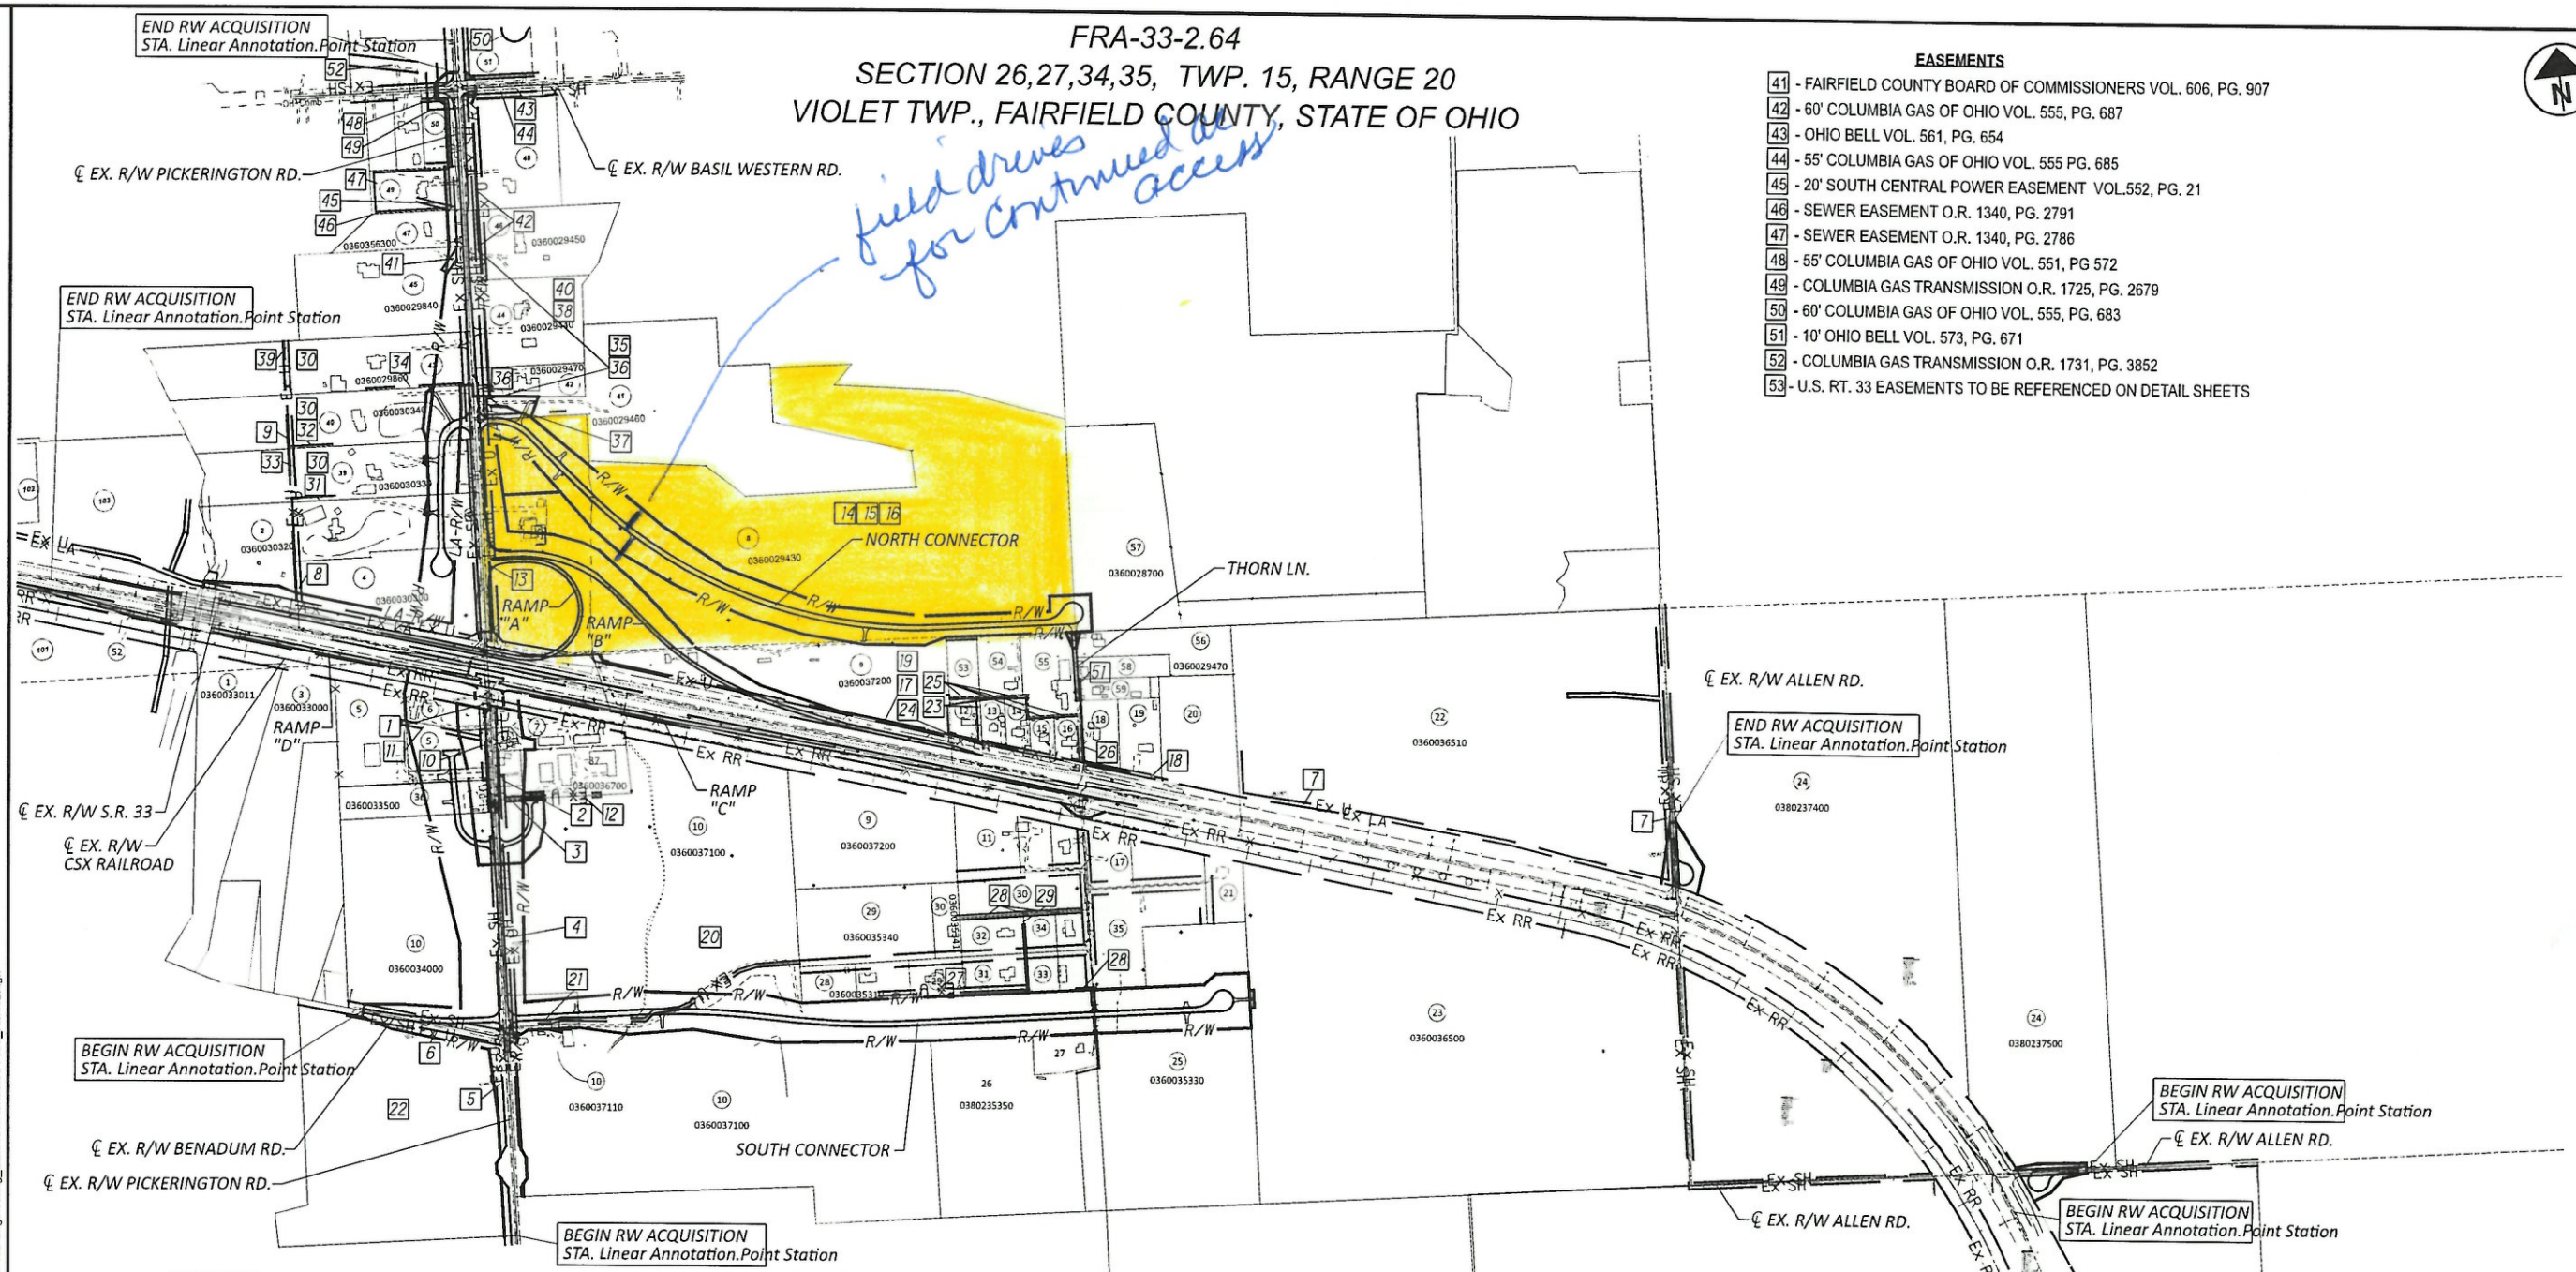

EASEMENTS

41 - FAIRFIELD COUNTY BOARD OF COMMISSIONERS VOL. 606, PG. 907
42 - 60' COLUMBIA GAS OF OHIO VOL. 555, PG. 687
43 - OHIO BELL VOL. 561, PG. 654
44 - 55' COLUMBIA GAS OF OHIO VOL. 555 PG. 685
45 - 20' SOUTH CENTRAL POWER EASEMENT VOL.552, PG. 21
46 - SEWER EASEMENT O.R. 1340, PG. 2791
47 - SEWER EASEMENT O.R. 1340, PG. 2786
48 - 55' COLUMBIA GAS OF OHIO VOL. 551, PG 572
49 - COLUMBIA GAS TRANSMISSION O.R. 1725, PG. 2679
50 - 60' COLUMBIA GAS OF OHIO VOL. 555, PG. 683
51 - 10' OHIO BELL VOL. 573, PG. 671
52 - COLUMBIA GAS TRANSMISSION O.R. 1731, PG. 3852
53 - U.S. RT. 33 EASEMENTS TO BE REFERENCED ON DETAIL SHEETS

EASEMENTS

1 - PIPE LINE LICENSE - AGREEMENT NO. INOH 991228
2 - SEWER EASEMENT - O.R.1525, PG. 943
3 - SEWER EASEMENT - O.R.1525, PG. 3746
4 - SEWER EASEMENT - O.R.1525, PG. 1829, & O.R.1525, PG. 3260
5 - SEWER EASEMENT - VOL. 1103, PG. 1307
6 - 10' SOUTH CENTRAL POWER EASEMENT - VOL. 692, PG. 814
7 - 20' SOUTH CENTRAL POWER EASEMENT - O.R. 1688, PG. 805
8 - 20' SOUTH CENTRAL POWER EASEMENT - VOL. 554, PG. 955 & 926
9 - 5' C & G DEVELOPMENT, INC. - VOL. 558, PG. 498
10 - SEWER EASEMENT - O.R. 1520, PG. 437
11 - 20' SOUTH CENTRAL POWER EASEMENT - O.R. 1518, PG. 528
12 - 20' SOUTH CENTRAL POWER EASEMENT - VOL. 660, PG. 70
13 - 60' COLUMBIA GAS - VOL. 562, PG. 892
14 - OHIO MIDLAND POWER VOL. 185, PG. 417 (BLANKET EASEMENT)
15 - SOUTH CENTRAL POWER EASEMENT VOL. 1, PG. 90 (BLANKET EASEMENT)
16 - OHIO FUEL & GAS BK.43, PG.50 (UNDEFINABLE)
17 - OHIO BELL VOL. 579, PG. 677
18 - OHIO BELL VOL. 573, PG. 650
19 - OHIO MIDLAND POWER VOL. 289, PG. 518 (UNDEFINABLE)
20 - OHIO MIDLAND POWER VOL.185, PG. 362 (BLANKET EASEMENT)

EASEMENTS

21 - OHIO BELL VOL. 446, PG.327
22 - OHIO MIDLAND POWER VOL.224, PG. 224 (BLANKET EASEMENT)
23 - ACCESS EAESMENT VOL.221, PG. 154 & VOL. 401, PG. 649
24 - INGRESS , EGRESS EASEMENT VOL. 459, PG 82
25 - OHIO BELL VOL. 573, PG. 653 & 656 & 659 & 662 & 665
26 - OHIO BELL VOL. 573, PG. 647
27 - 20' SOUTH CENTRAL POWER EASEMENT VOL. 423, PG 619 (UNDEFINABLE)
28 - 20' SOUTH CENTRAL POWER EASEMENT VOL. 423, PG. 609
29 - 10' SOUTH CENTRAL POWER EASEMENT VOL. 557, PG. 83
30 - C & G DEVELOPMENT INC. VOL. 558, PG. 498 (UNDEFINABLE)
31 - 20' SOUTH CENTRAL POWER EASEMENT VOL. 574, PG. 649
32 - 10' SOUTH CENTRAL POWER EASEMENT VOL. 631, PG. 844
33 - 20' SOUTH CENTRAL POWER EASEMENT VOL. 557, PG. 56
34 - 10' SOUTH CENTRAL POWER EASEMENT VOL. 574, PG. 650
35 - COLUMBIA GAS OF OHIO VOL. 546, PG. 64 (BLANKET EASEMENT)
36 - 60' COLUMBIA GAS OF OHIO VOL. 560, PG. 207
37 - 20' SOUTH CENTRAL POWER EASEMENT VOL. 565, PG. 890
38 - OHIO FUEL & GAS LB. 43, PG. 50 (UNDEFINABLE)
39 - 20' SOUTH CENTRAL POWER EASEMENT VOL. 557, PG. 67
40 - OHIO MIDLAND POWER VOL. 185, PG. 417 (BLANKET EASEMENT)

HORIZONTAL SCALE IN FEET
0 200 400 800

PROPERTY MAP

REV. BY	DATE	DESCRIPTION
DATE COMPLETED		

DESIGN AGENCY
2LMN
2475 Sugar Grove Blvd. NE
Lancaster, Ohio 43130
(740) 681-5142 Phone
www.2LMN.com

DESIGNER: DB
REVIEWER: RFM MM-DD-YY
PROJECT ID: 77555
SUBSET: RW.12 TOTAL: 60
SHEET: P.0 TOTAL: 0

FAI-33-2.64

MODEL: Sheet PAPERSIZE: 34x22 (in.) DATE: 1/11/2024 TIME: 12:59:30 PM USER: Dave_Burnheimer
pw:\\ohiodot-pw.bentley.com:ohiodot-pw-02\Documents\01 Active Projects\District 05\Fairfield\77555\402-Engineering_2LMN\RW\Sheets\77555_RM002.dgn