










A:\2023\2023\_CAD\2023\_03\2023\_03\_01.dwg, Plot Scale: 1/8"=1'-0", Date: 3/1/2024 11:53 AM, User: jrb, Printed By: jrb, Date: 3/1/2024 3:53 PM  
 3 Xref: 20211131-VS-BORD-E, 20220307-VS-REFR-E, 20220307-C-S-REFR-ROAD-12

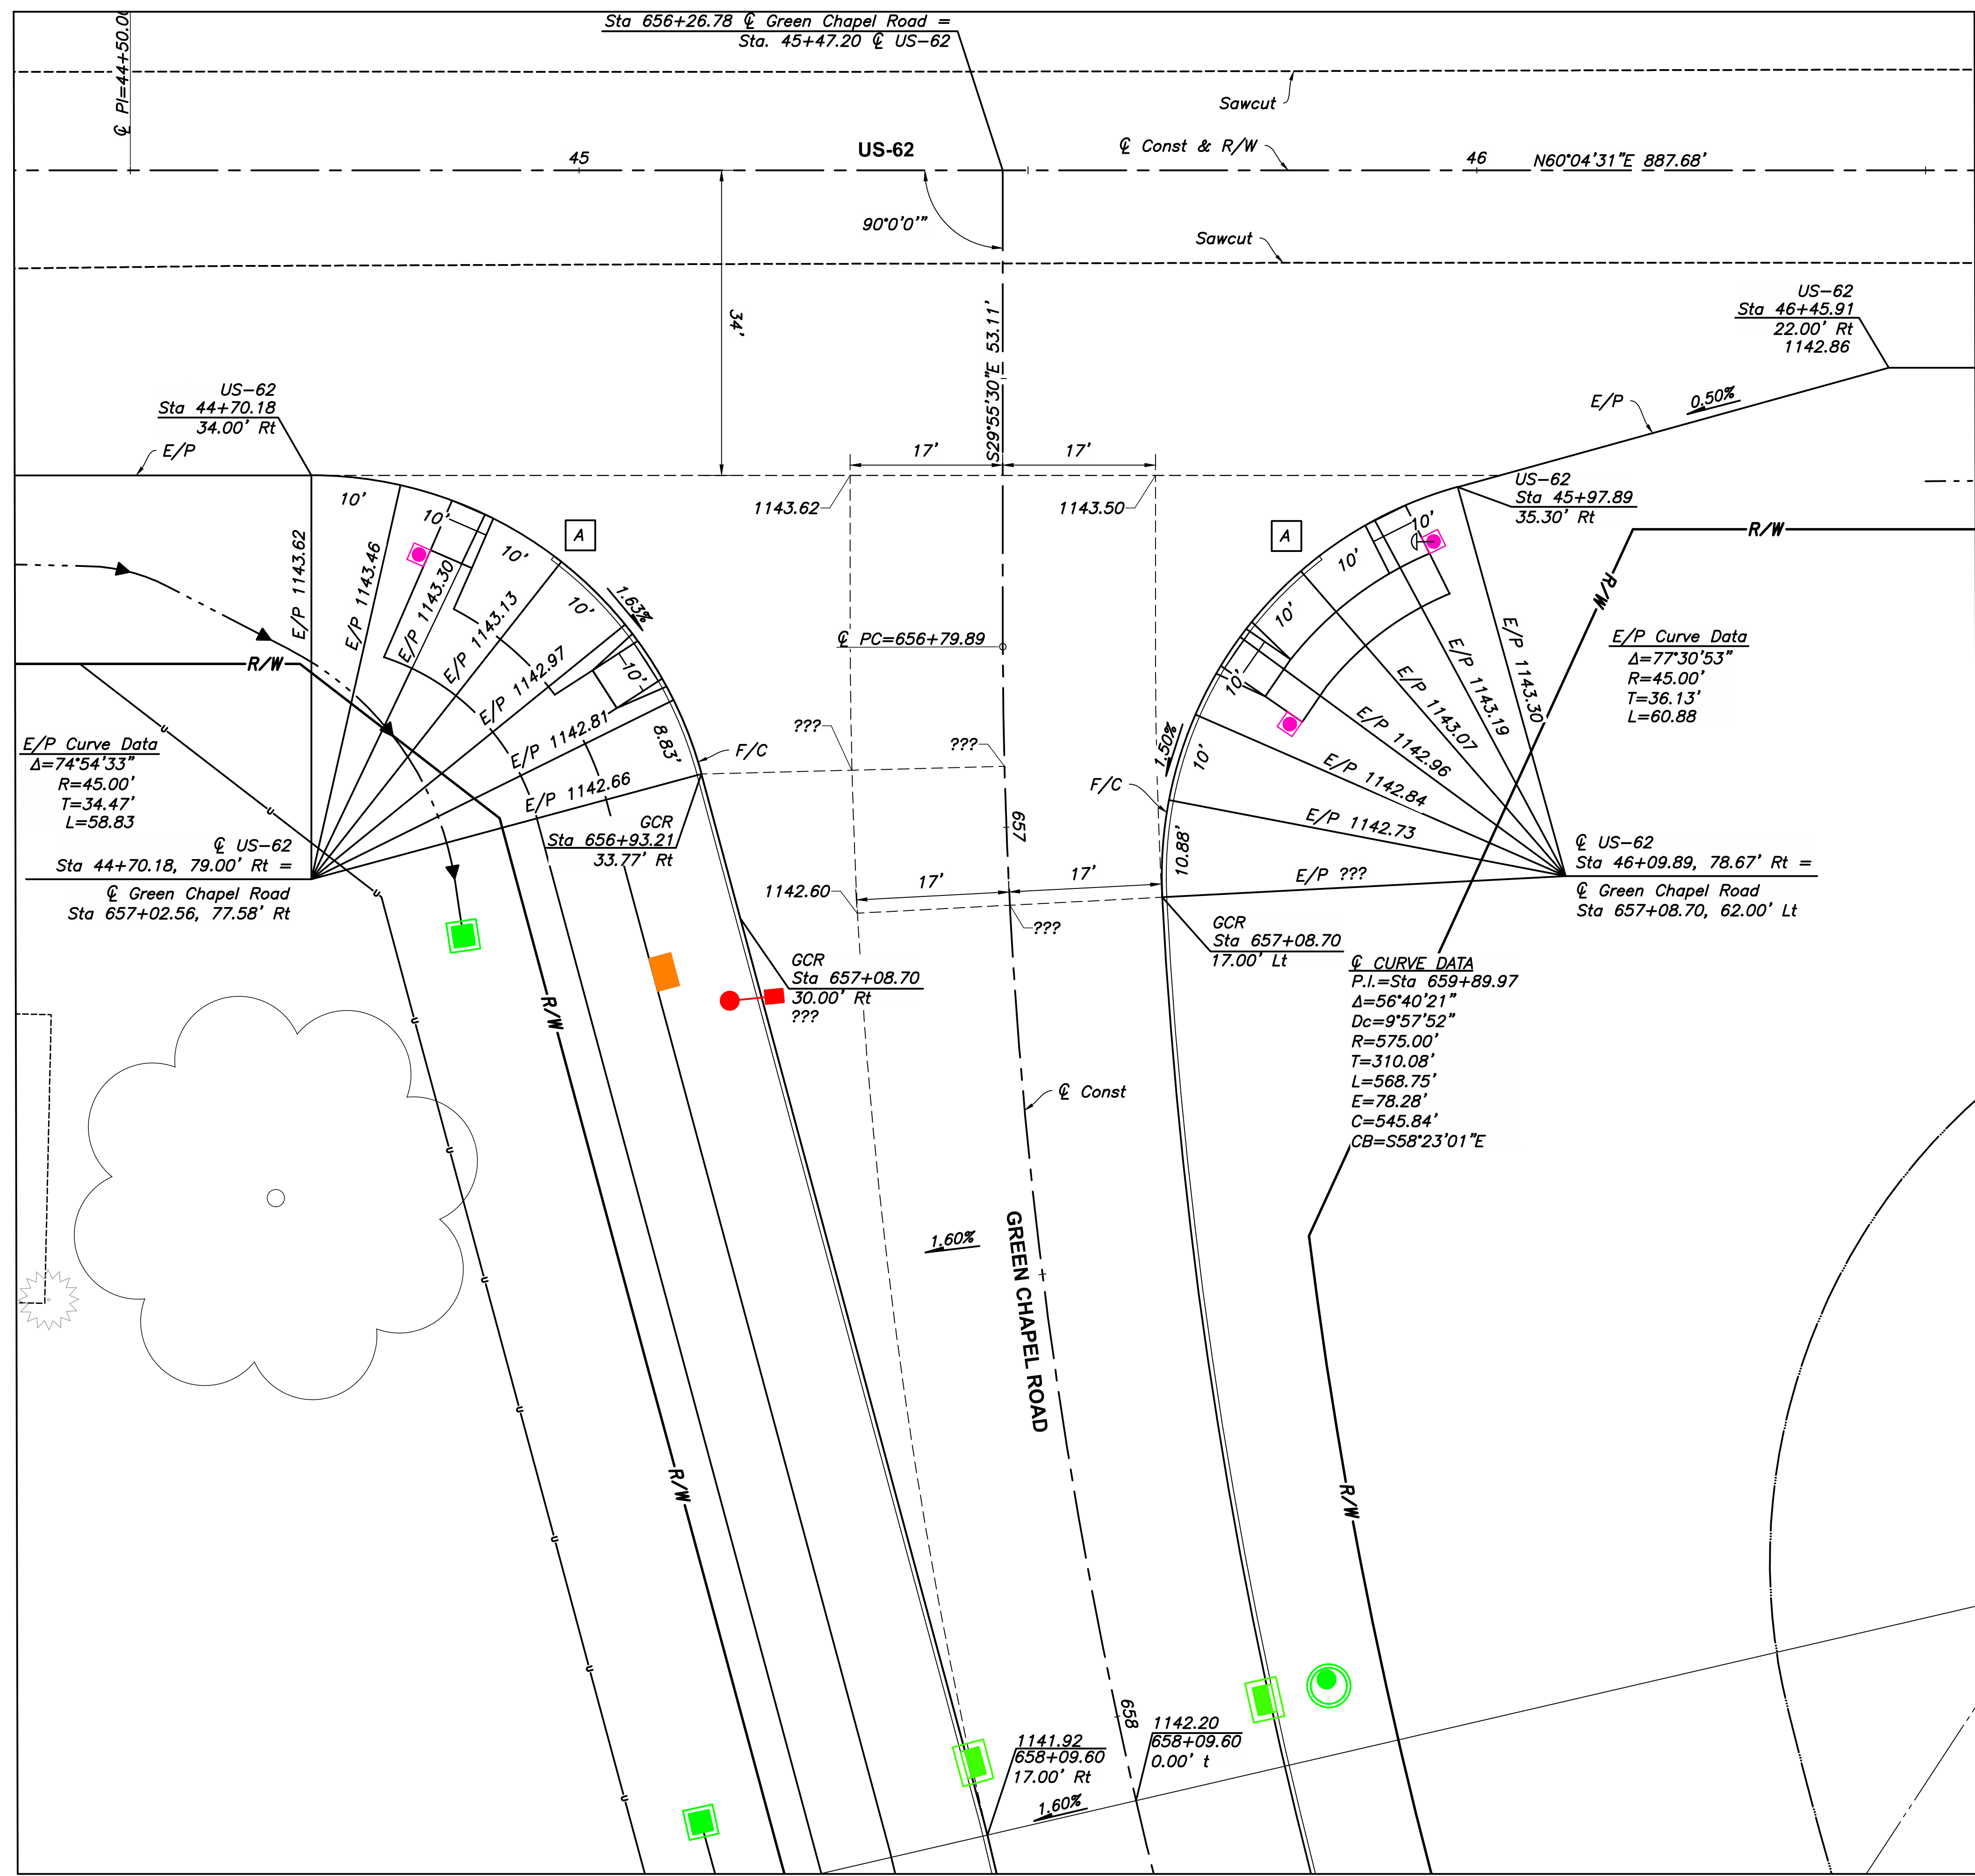

**NOTES**  
 See Sheet 84 for Curb Ramp Details  
 Elevations represent top of pavement unless otherwise noted.

**Legend**  
 GCR = Green Chapel Road  
 E/P = Edge of Pavement  
 F/C = Face of Curb

[A] Taper curb reveal from 6" to 0" over 10'

CALCULATED: JJB  
 CHECKED: M/S  
 GRAPHIC SCALE: 1 inch = 10 feet

**INTERSECTION DETAILS**  
**US-62**

**GREEN CHAPEL ROAD**  
**IMPROVEMENTS PHASE 2**