BRIDGE NO.	COUNTY	ROUTE NO.	S.H. NO.	SECTION	STRENGTH	ROADWAY	CLEARANCE	TYPE
LIC-70-1943	Licking	4070						17

SKETCH OF STRUCTURE SHOWING DIMENSIONS

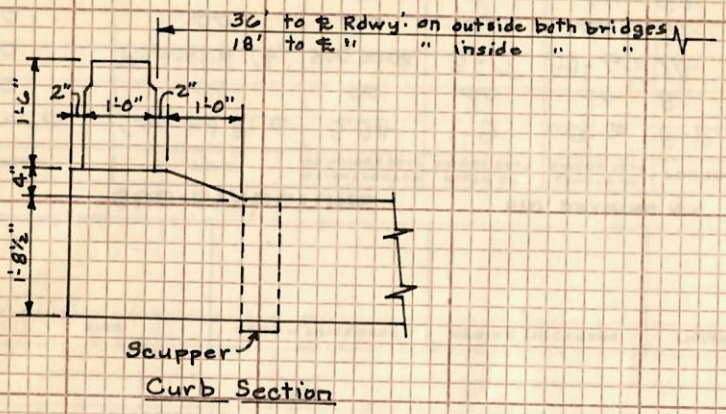

Curb Section

PROJ 1027(93) WIDENED – REPLACED RAILS & A.S. SLABS - OVERLAYED

LFT RT BRIDGE COMBINED INTO ONE STRUCTURE FOR BRIDGE INVENTORY (SFN 4603937 RETIRED 2-11-03)

HEIGHT FOOTER TO BRIDGE SEAT

	W.B. Lane		E.B. Lane	
	Rt.	Lt.	Rt.	Lt.
Pier	19.18	18.33	19.82	19.56
Pier	18.60	17.78	18.35	18.12
Pier	21.01	20.20	21.10	20.90

LOCATION SKETCH

See Green Card

REMARKS:-

Profile Grade: (E.B. Lane) 600' V.C.
Grades Rr. + 3.0% Fwd. + 1.79%
P.I. Sta. : 1074 + 75
Contractor - ~~See Ltr.~~ - Frank Mashuda
Proj. No: 194-57; LIC-40-19.42
Built as Br. No. LIC-40-2029
PROJ 471(91) REMOVED 2¼" A.C. AND REPLACE 1¾" Ac. 448 BOTH BRIDGES