BRIDGE NO.	COUNTY	ROUTE NO.	S. H. NO.	SECTION	STRENGTH	ROADWAY	CLEARANCE	TYPE
GUE-77-0143R	Guernsey	77			H10 H12 H15 x H20	15 18 19 22 23 + x	12- 12-14 14 + x OPEN	A 13 B G S T

SKETCH OF STRUCTURE SHOWING DIMENSIONS

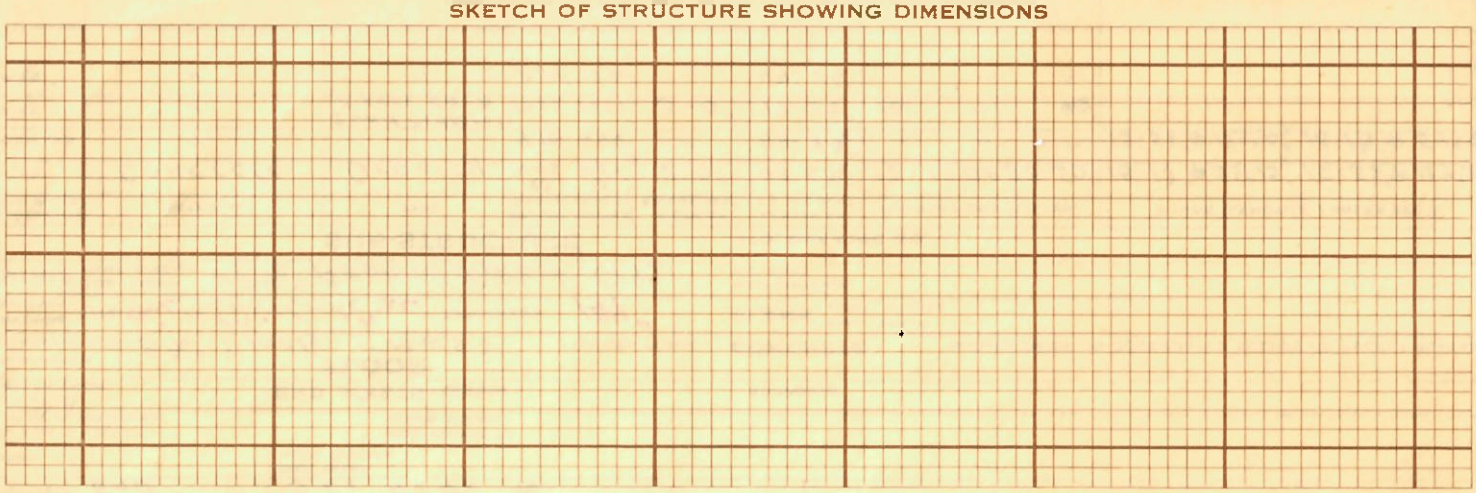

Project 411(93) Resurface Replace Parapets

LOCATION SKETCH

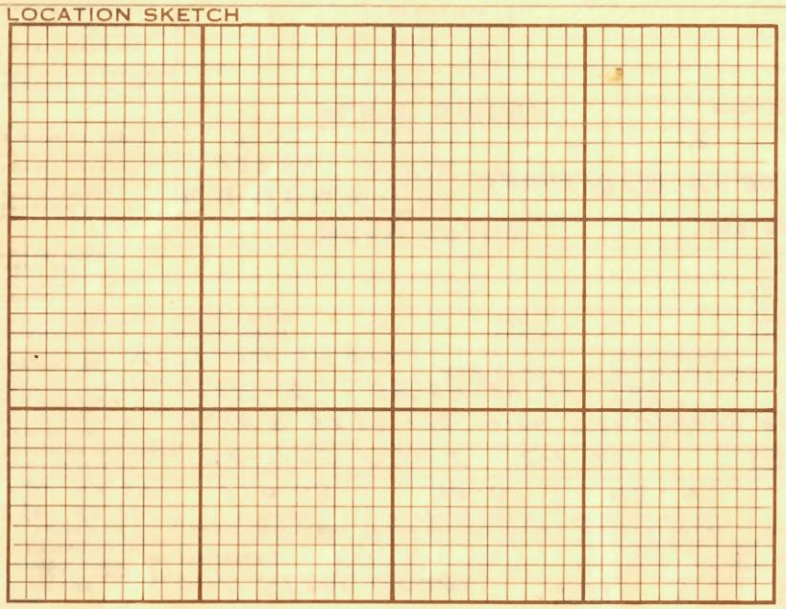

REMARKS:- Prof. Gr. 1200' V.C. PVI Sta. 76+50
Gr Rear + 1.087%; Gr. Fwd. - 1.24% For both Appr.
Superelevation 0.015.6 ft/ft.
Ptg Str. Stl = 230,700 # 235,266
Fabricator: Lisbon Steel, Lisbon, O.
Cement: } See GUE-77-0143L
Sand: }
#57 Agg.

Painted 1983, Proj. 210(83) Colonial Painting & Sheeting

Built as Br. GUE-77-0143R on
Proj. 591-65 by C & M Co.

Cleared July 1991 - PO 51380 - $2140
PROJ 469(83) SPOT PAINTING

OHIO-BR.
1805-8