



TRAFFIC CONTROL PLAN
S.R. 435 - STA. 36+00 TO STA. 46+00

| | |
|---|--------------------|
| DESIGN AGENCY | Palmer ENGINEERING |
| 8350 E. KEMPER RD. SUITE B CINCINNATI, OH 45249 513-469-1600 | |
| DESIGNER | SVK |
| REVIEWER | DCJ |
| DATE | 06/07/24 |
| PROJECT ID | 117955 |
| SHEET | P. 3 |
| TOTAL | 18 |

SEE SHEET P. 2 FOR LEGEND

NOTE 1: RELOCATE EXIST M2-H5-108 SIGN USING 29 FT. GROUND-MOUNTED STRUCTURE BEAM SUPPORT S4 X 7.7 AND 2 BREAKAWAY BEAM SUPPORT & 2 GROUND MOUNTED BEAM SUPPORT FOUNDATIONS.

NOTE 2: RELOCATE EXISTING SIGN USING 44 FT. GROUND-MOUNTED STRUCTURE BEAM SUPPORT W10 X 12 AND 2 BREAKAWAY BEAM SUPPORTS & 2 GROUND MOUNTED BEAM SUPPORT FOUNDATIONS.

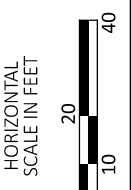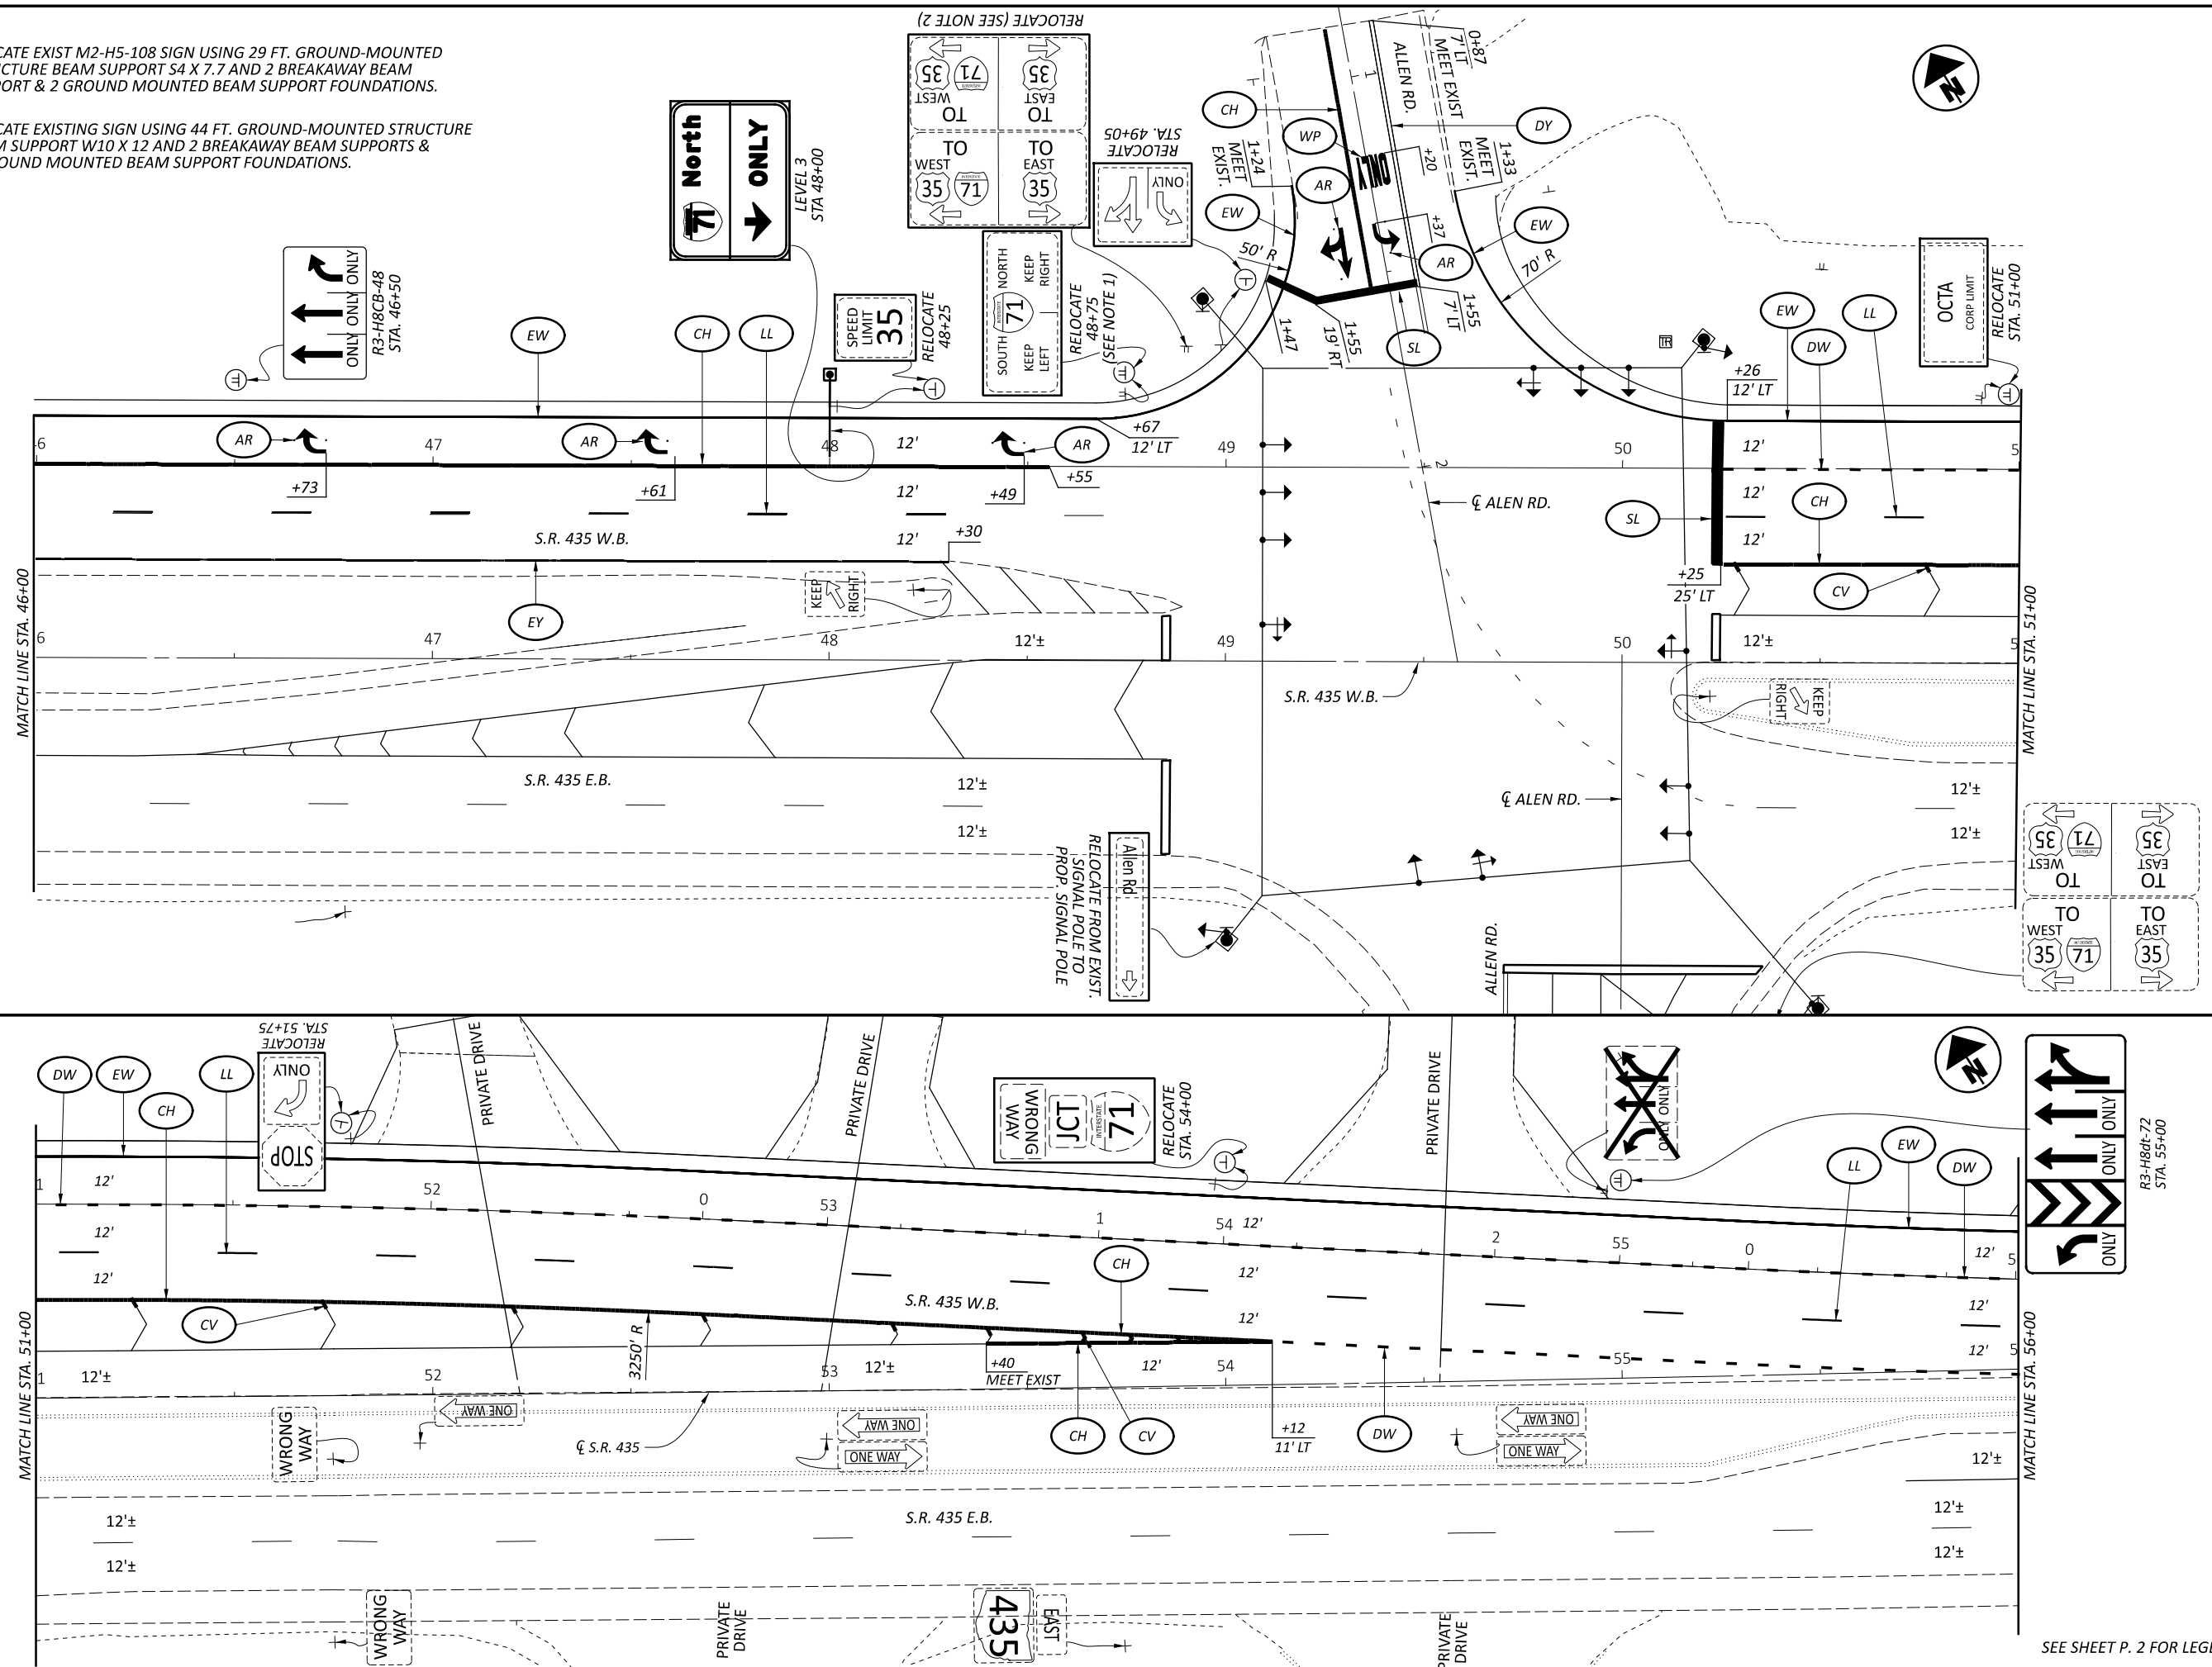



TRAFFIC CONTROL PLAN
S.R. 435 - STA. 46+00 TO STA. 56+00

DESIGN AGENCY
Palmer
ENGINEERING
8350 E. KEMPER RD.
SUITE B
CINCINNATI, OH 45249
513-469-1600


| | |
|------------|----------|
| DESIGNER | SVK |
| REVIEWER | DCJ |
| DATE | 06/07/24 |
| PROJECT ID | 117955 |
| SHEET | P. 4 |
| TOTAL | 18 |

SEE SHEET P. 2 FOR LEGEND

Do not locate the lane control sign and the directional guide sign in the same location. Move the guide sign further west (+/- sta 43+20).

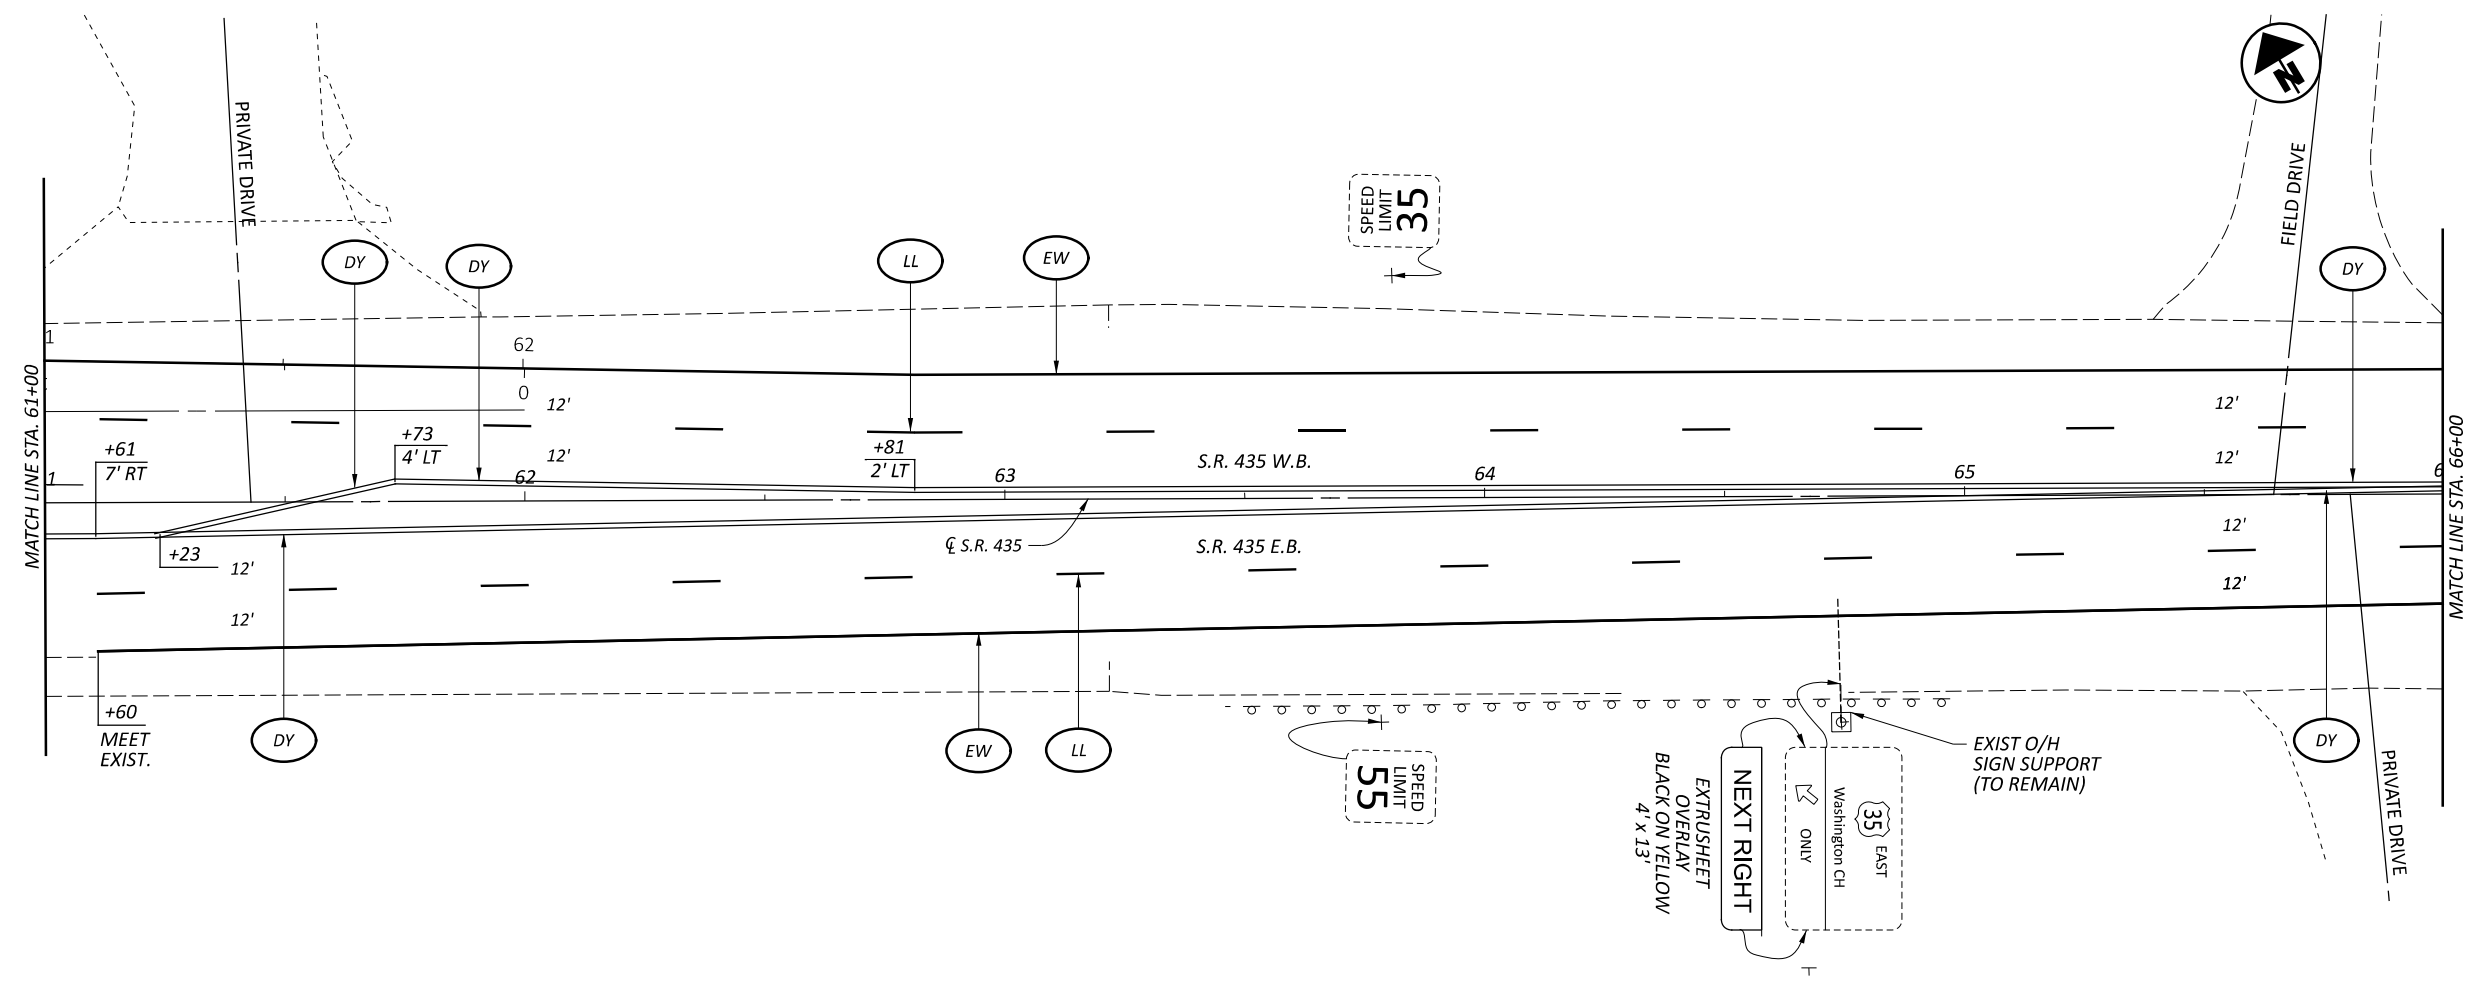
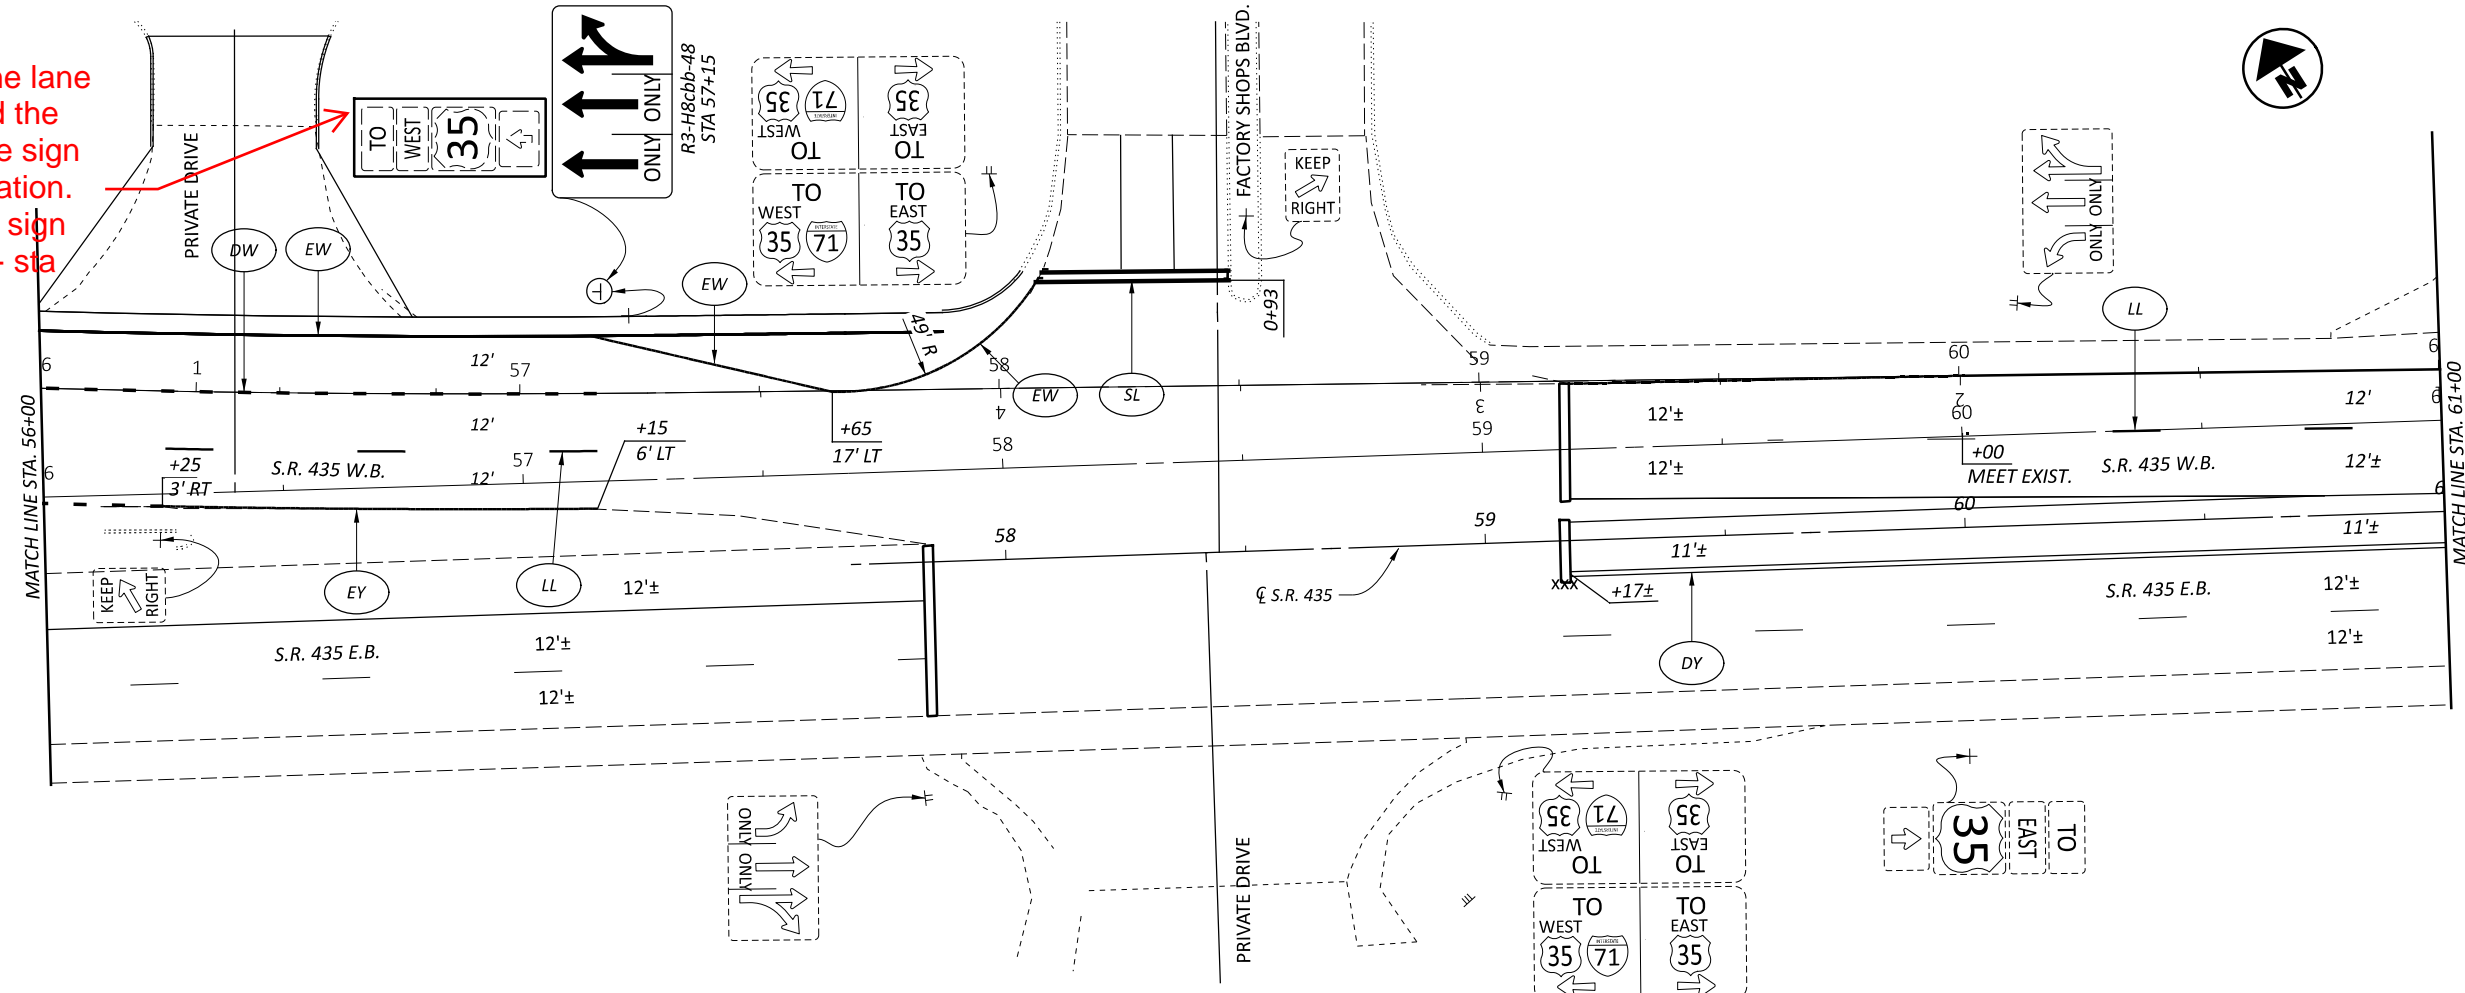


SEE SHEET P. 2 FOR LEGEND

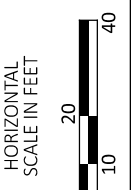


TRAFFIC CONTROL PLAN
 S.R. 435 - STA. 56+00 TO STA. 66+00

| | |
|---------------|------------------------------|
| DESIGN AGENCY | Palmer ENGINEERING |
| DESIGNER | SVK |
| REVIEWER | DCJ 06/07/24 |
| PROJECT ID | 117955 |
| SHEET | P. 5 |
| TOTAL | 18 |

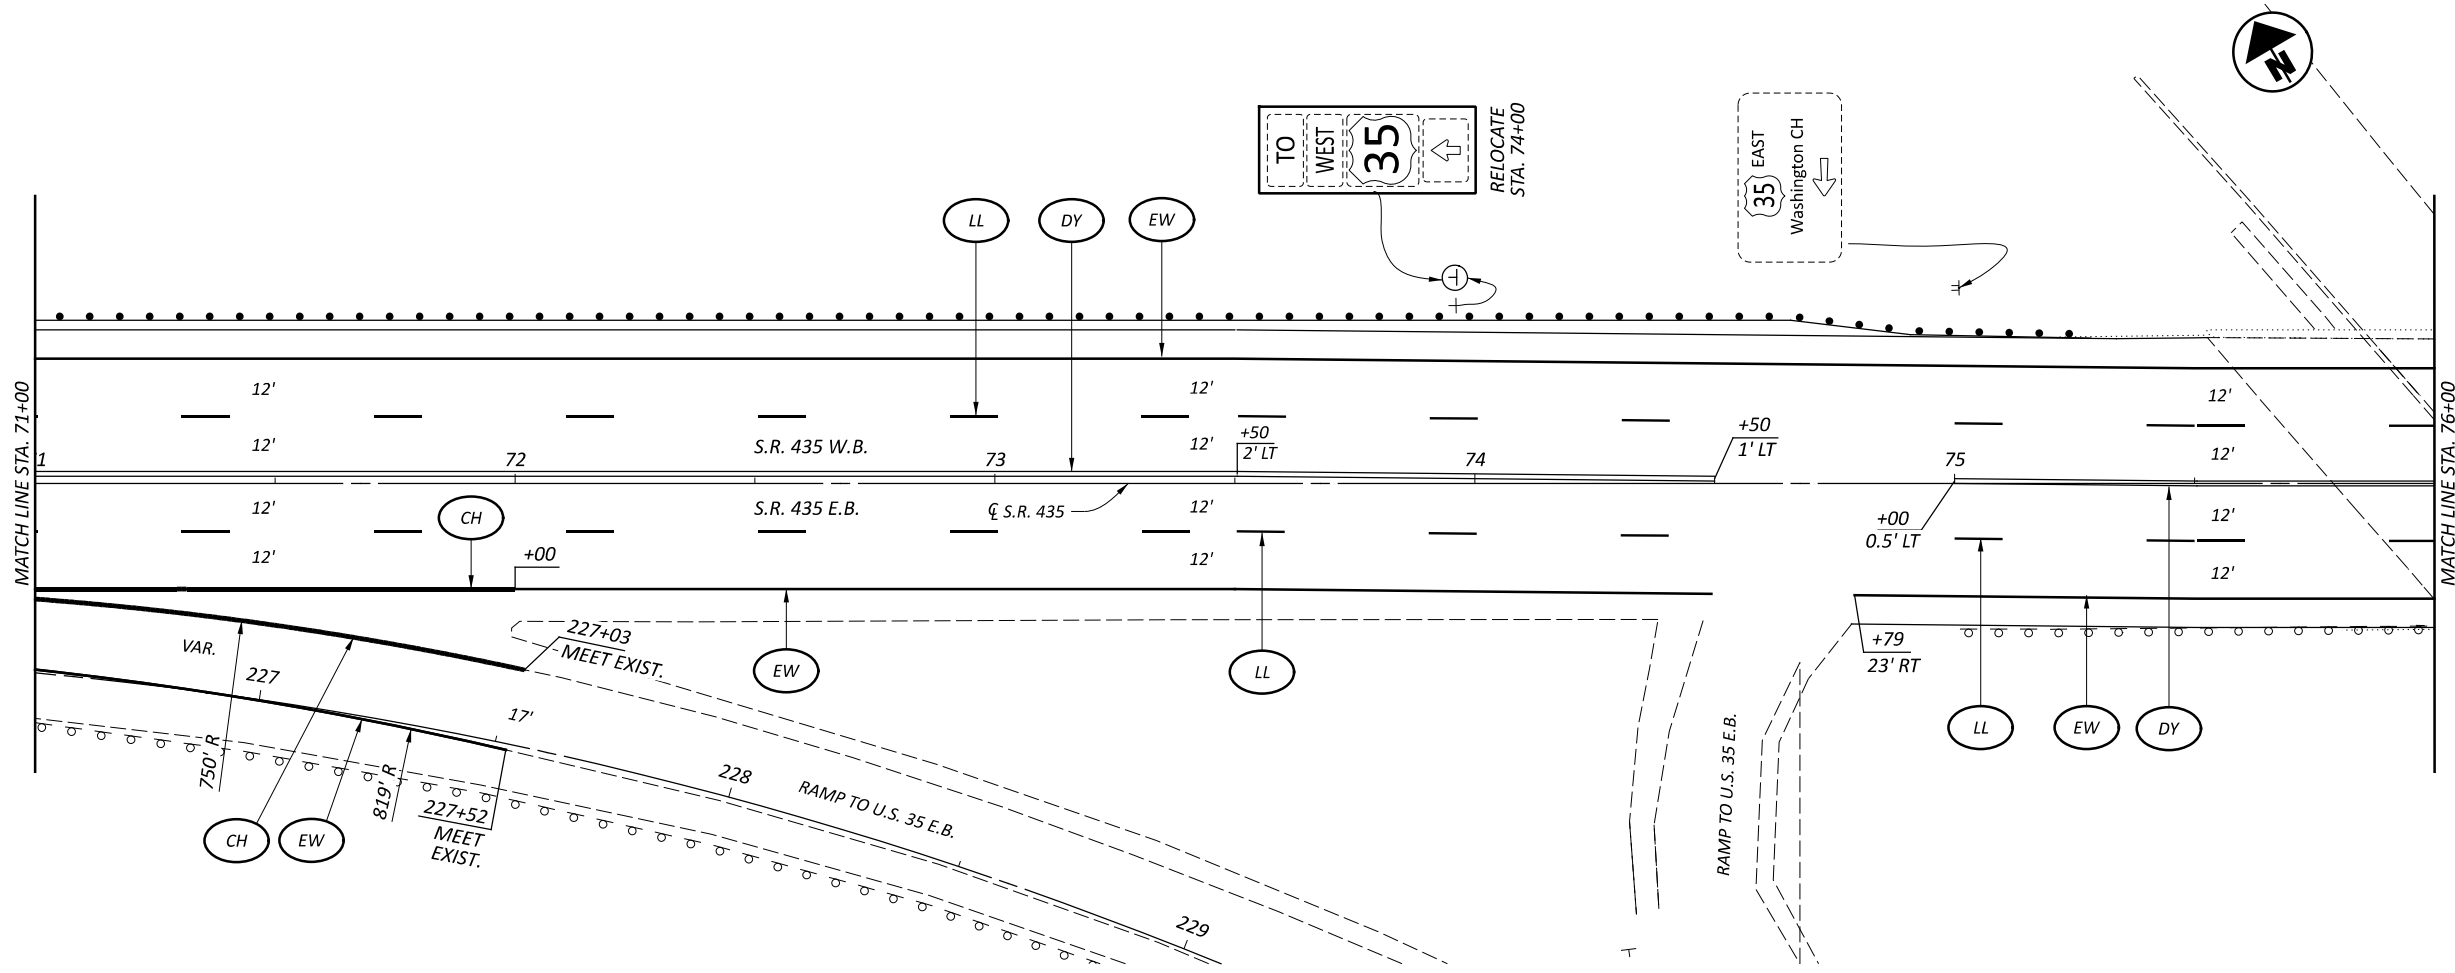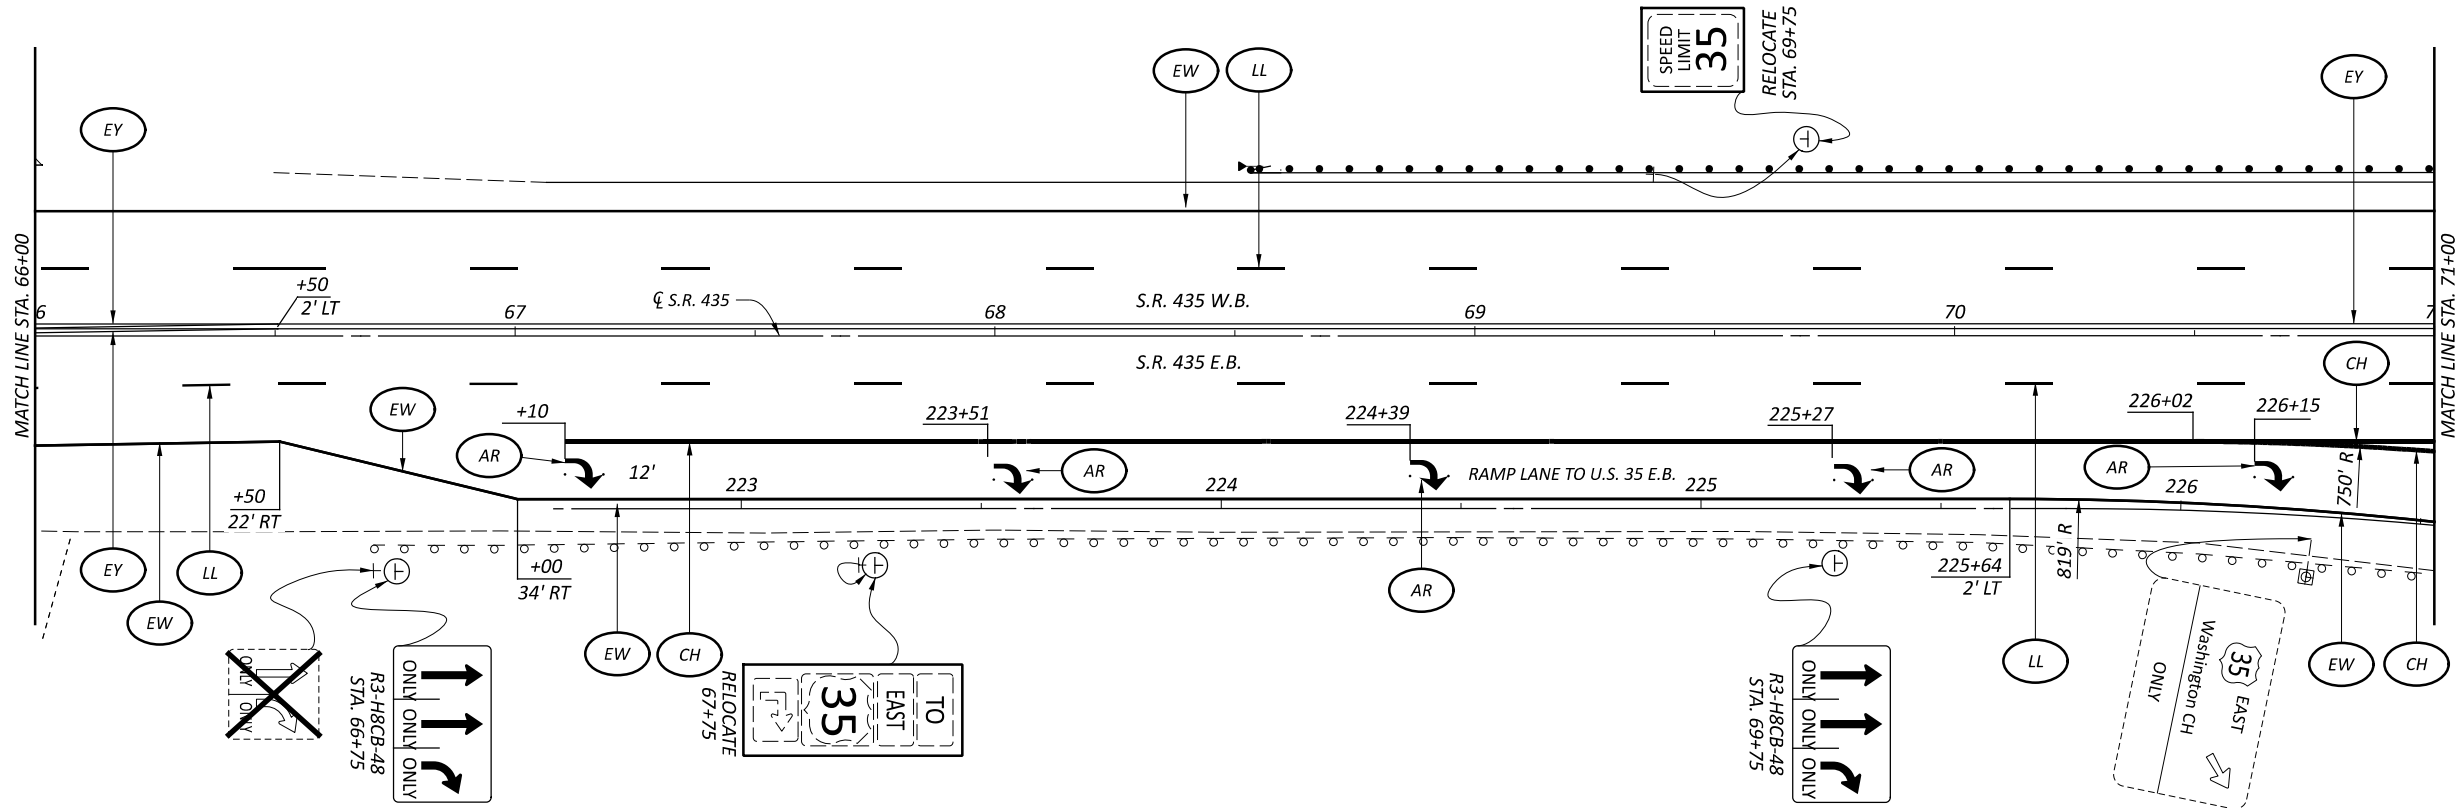

SEE SHEET P. 2 FOR LEGEND

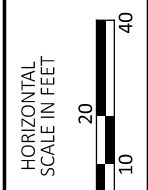

TRAFFIC CONTROL PLAN
 S.R. 435 - STA. 66+00 TO STA. 76+00



| | |
|--|----------|
| DESIGN AGENCY | |
| | |
| 8350 E. KEMPER RD. SUITE B CINCINNATI, OH 45249 513-469-1600 | |
| DESIGNER | SVK |
| REVIEWER | DCJ |
| DATE | 06/07/24 |
| PROJECT ID | 117955 |
| SHEET | TOTAL |
| P. 6 | 18 |

MATCH LINE STA. 76+00


MATCH LINE STA. 81+00

MATCH LINE STA. 81+00

MATCH LINE STA. 86+00

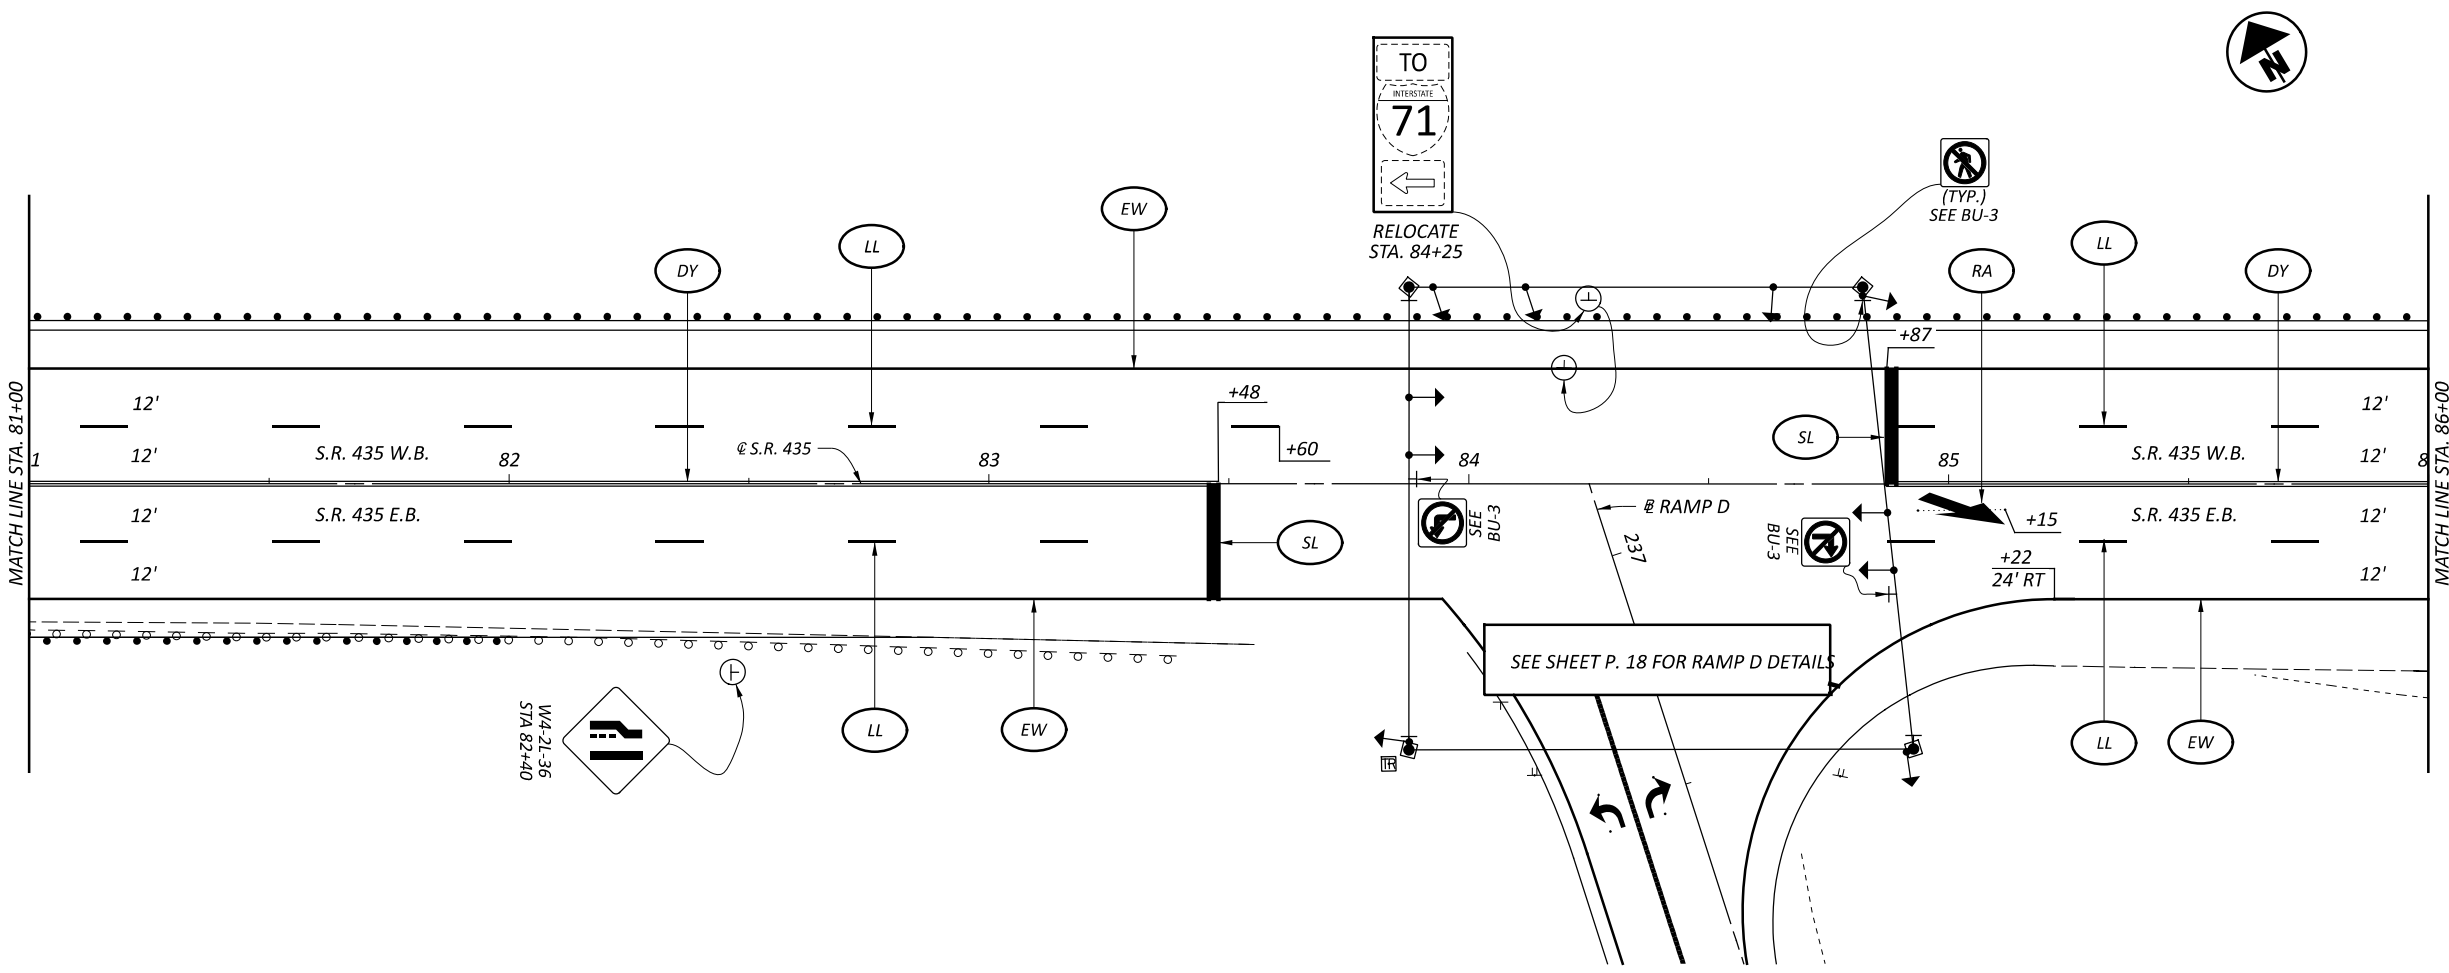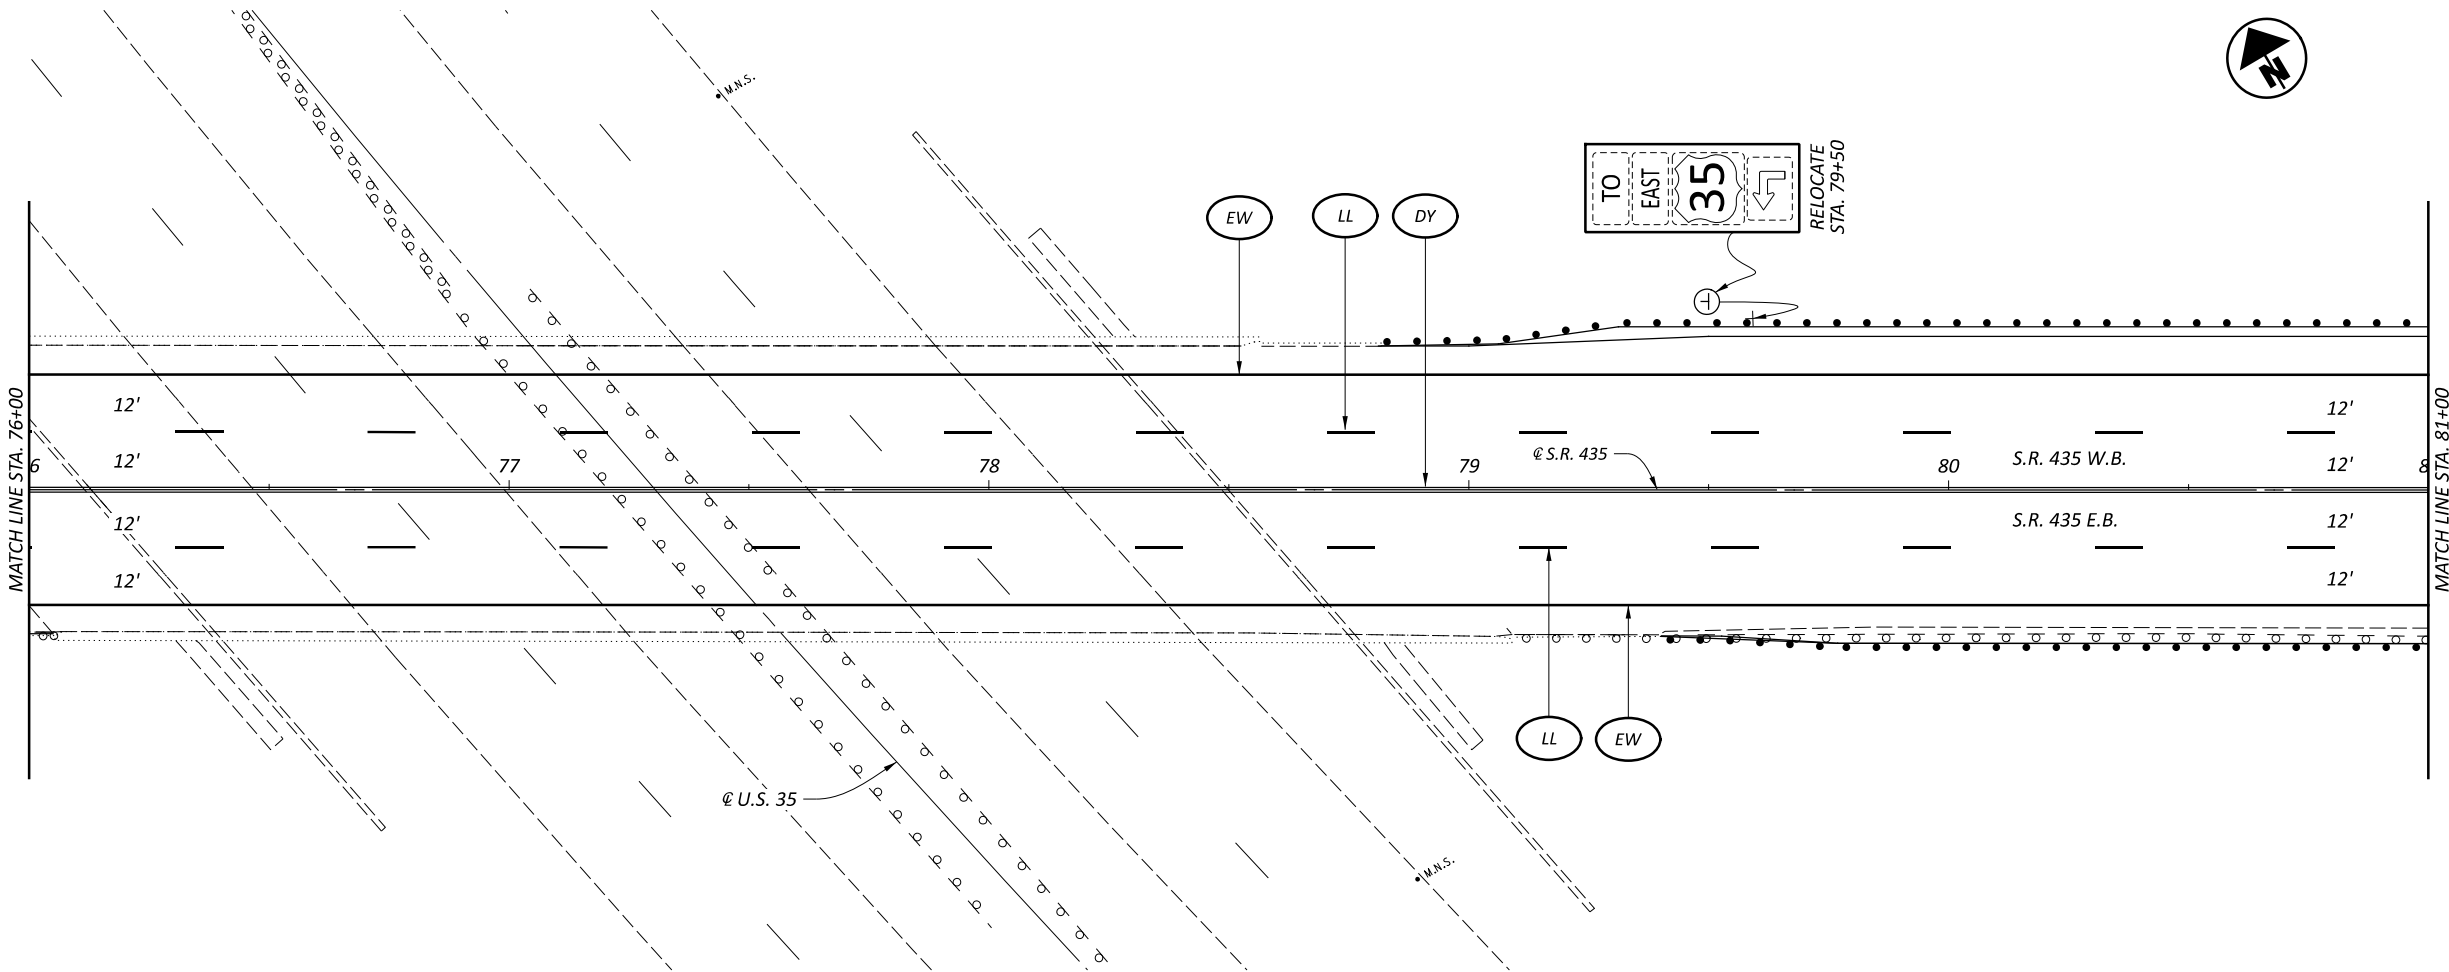




SEE SHEET P. 2 FOR LEGEND

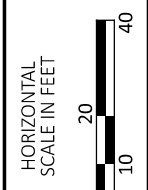

TRAFFIC CONTROL PLAN
S.R. 435 - STA. 76+00 TO STA. 86+00

DESIGN AGENCY
Palmer
ENGINEERING
8350 E. KEMPER RD.
SUITE B
CINCINNATI, OH 45249
513-469-1600




DESIGNER
SVK
REVIEWER
DCJ 06/07/24
PROJECT ID
117955
SHEET TOTAL
P. 7 18

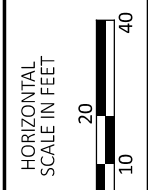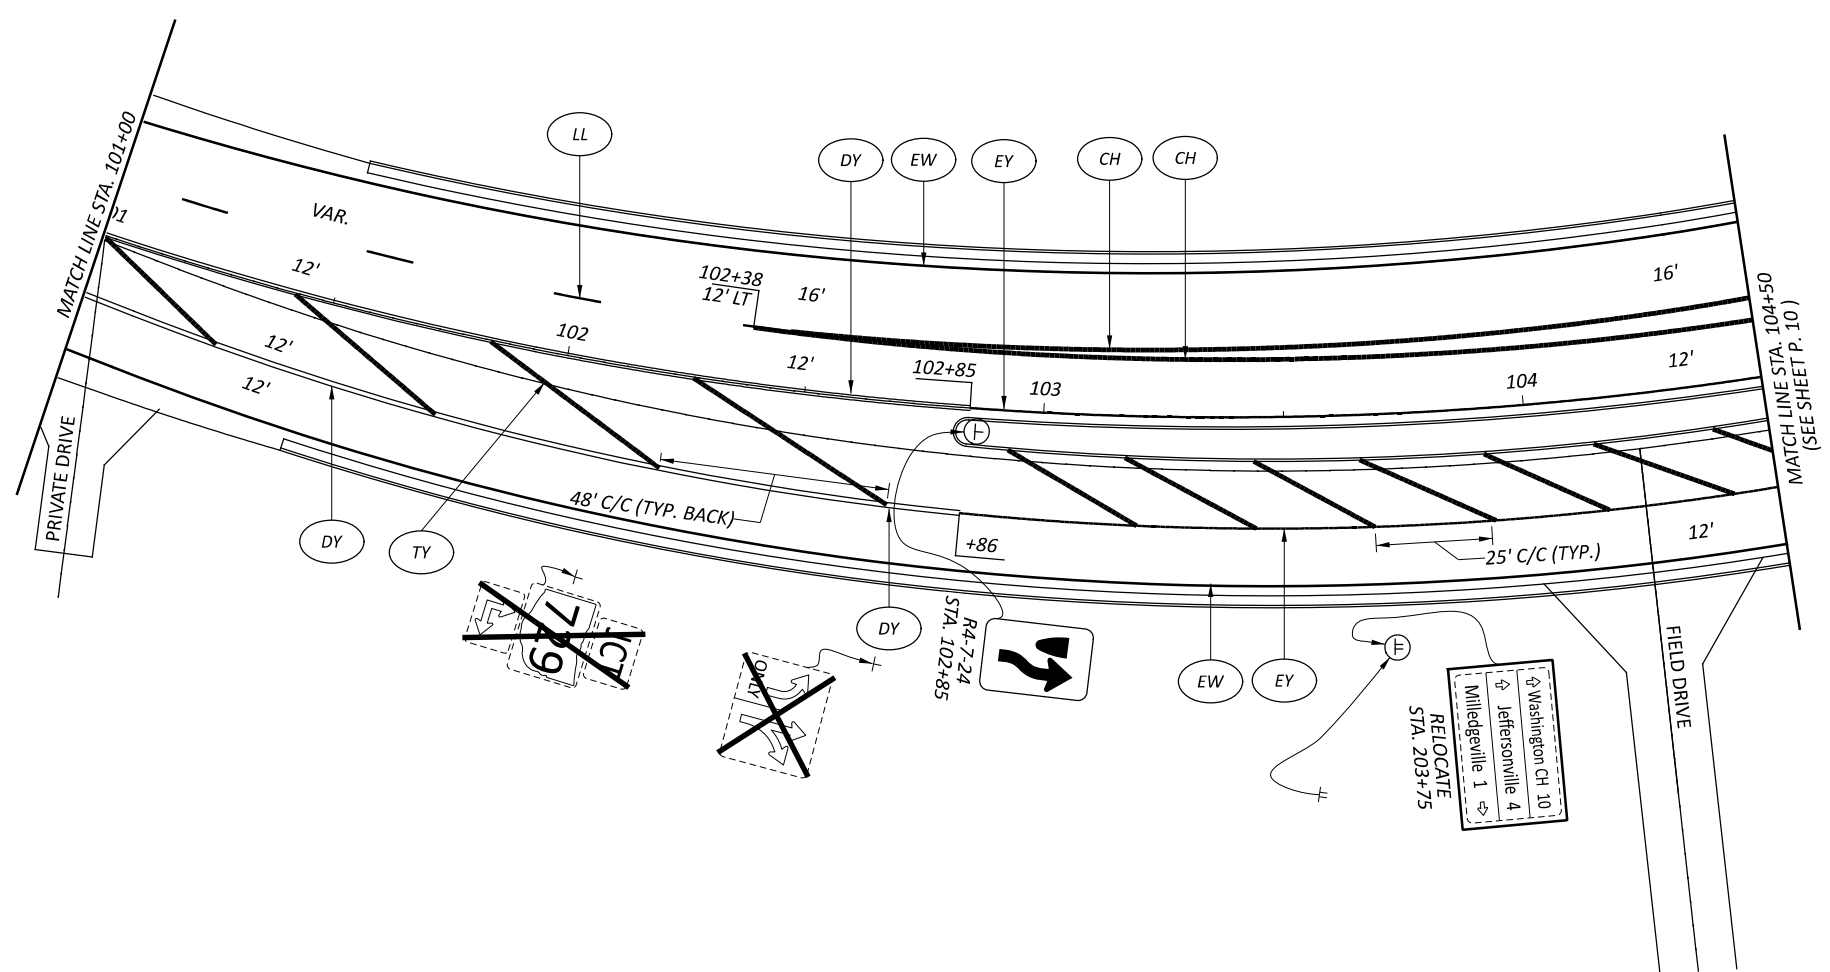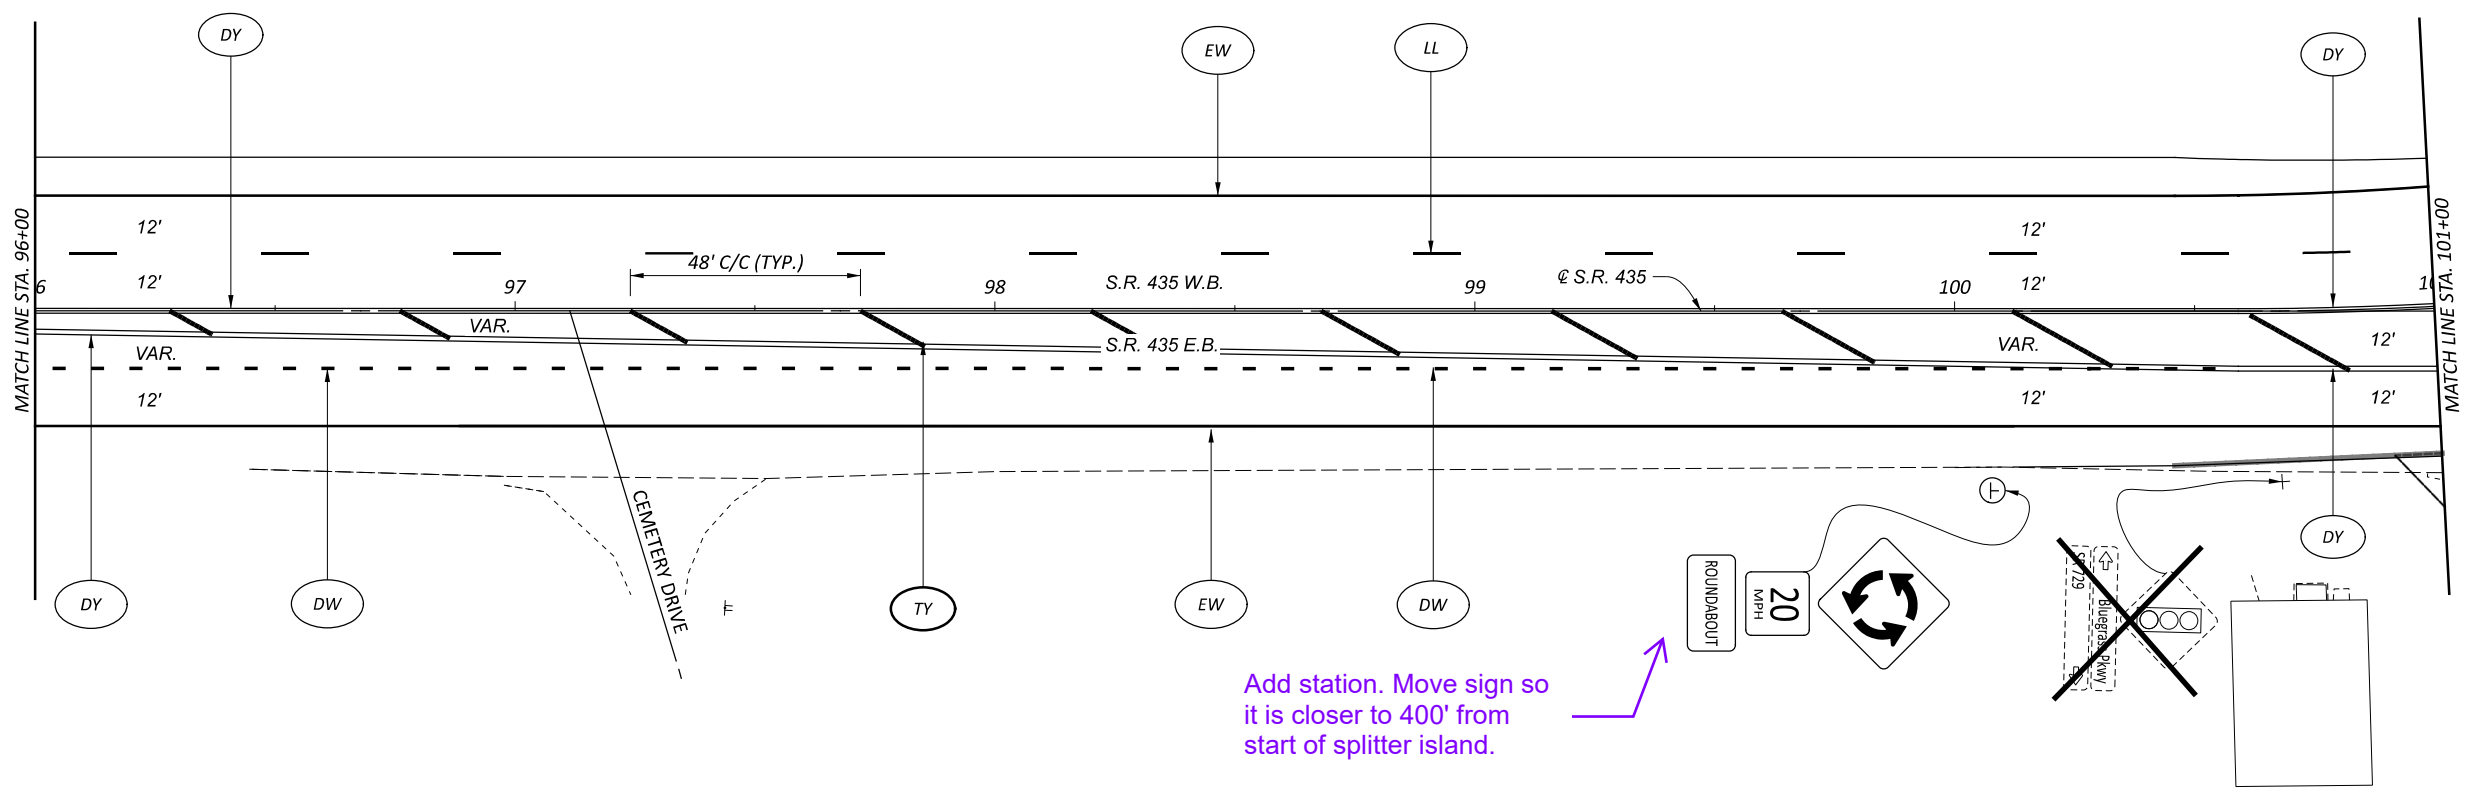

TRAFFIC CONTROL PLAN
 S.R. 435 - STA. 101+00 TO STA. 104+00

| | |
|---------------|--------------------|
| DESIGN AGENCY | Palmer ENGINEERING |
| DESIGNER | SVK |
| REVIEWER | DCJ 06/07/24 |
| PROJECT ID | 117955 |
| SHEET | P. 9 |
| TOTAL | 18 |


SEE SHEET P. 2 FOR LEGEND

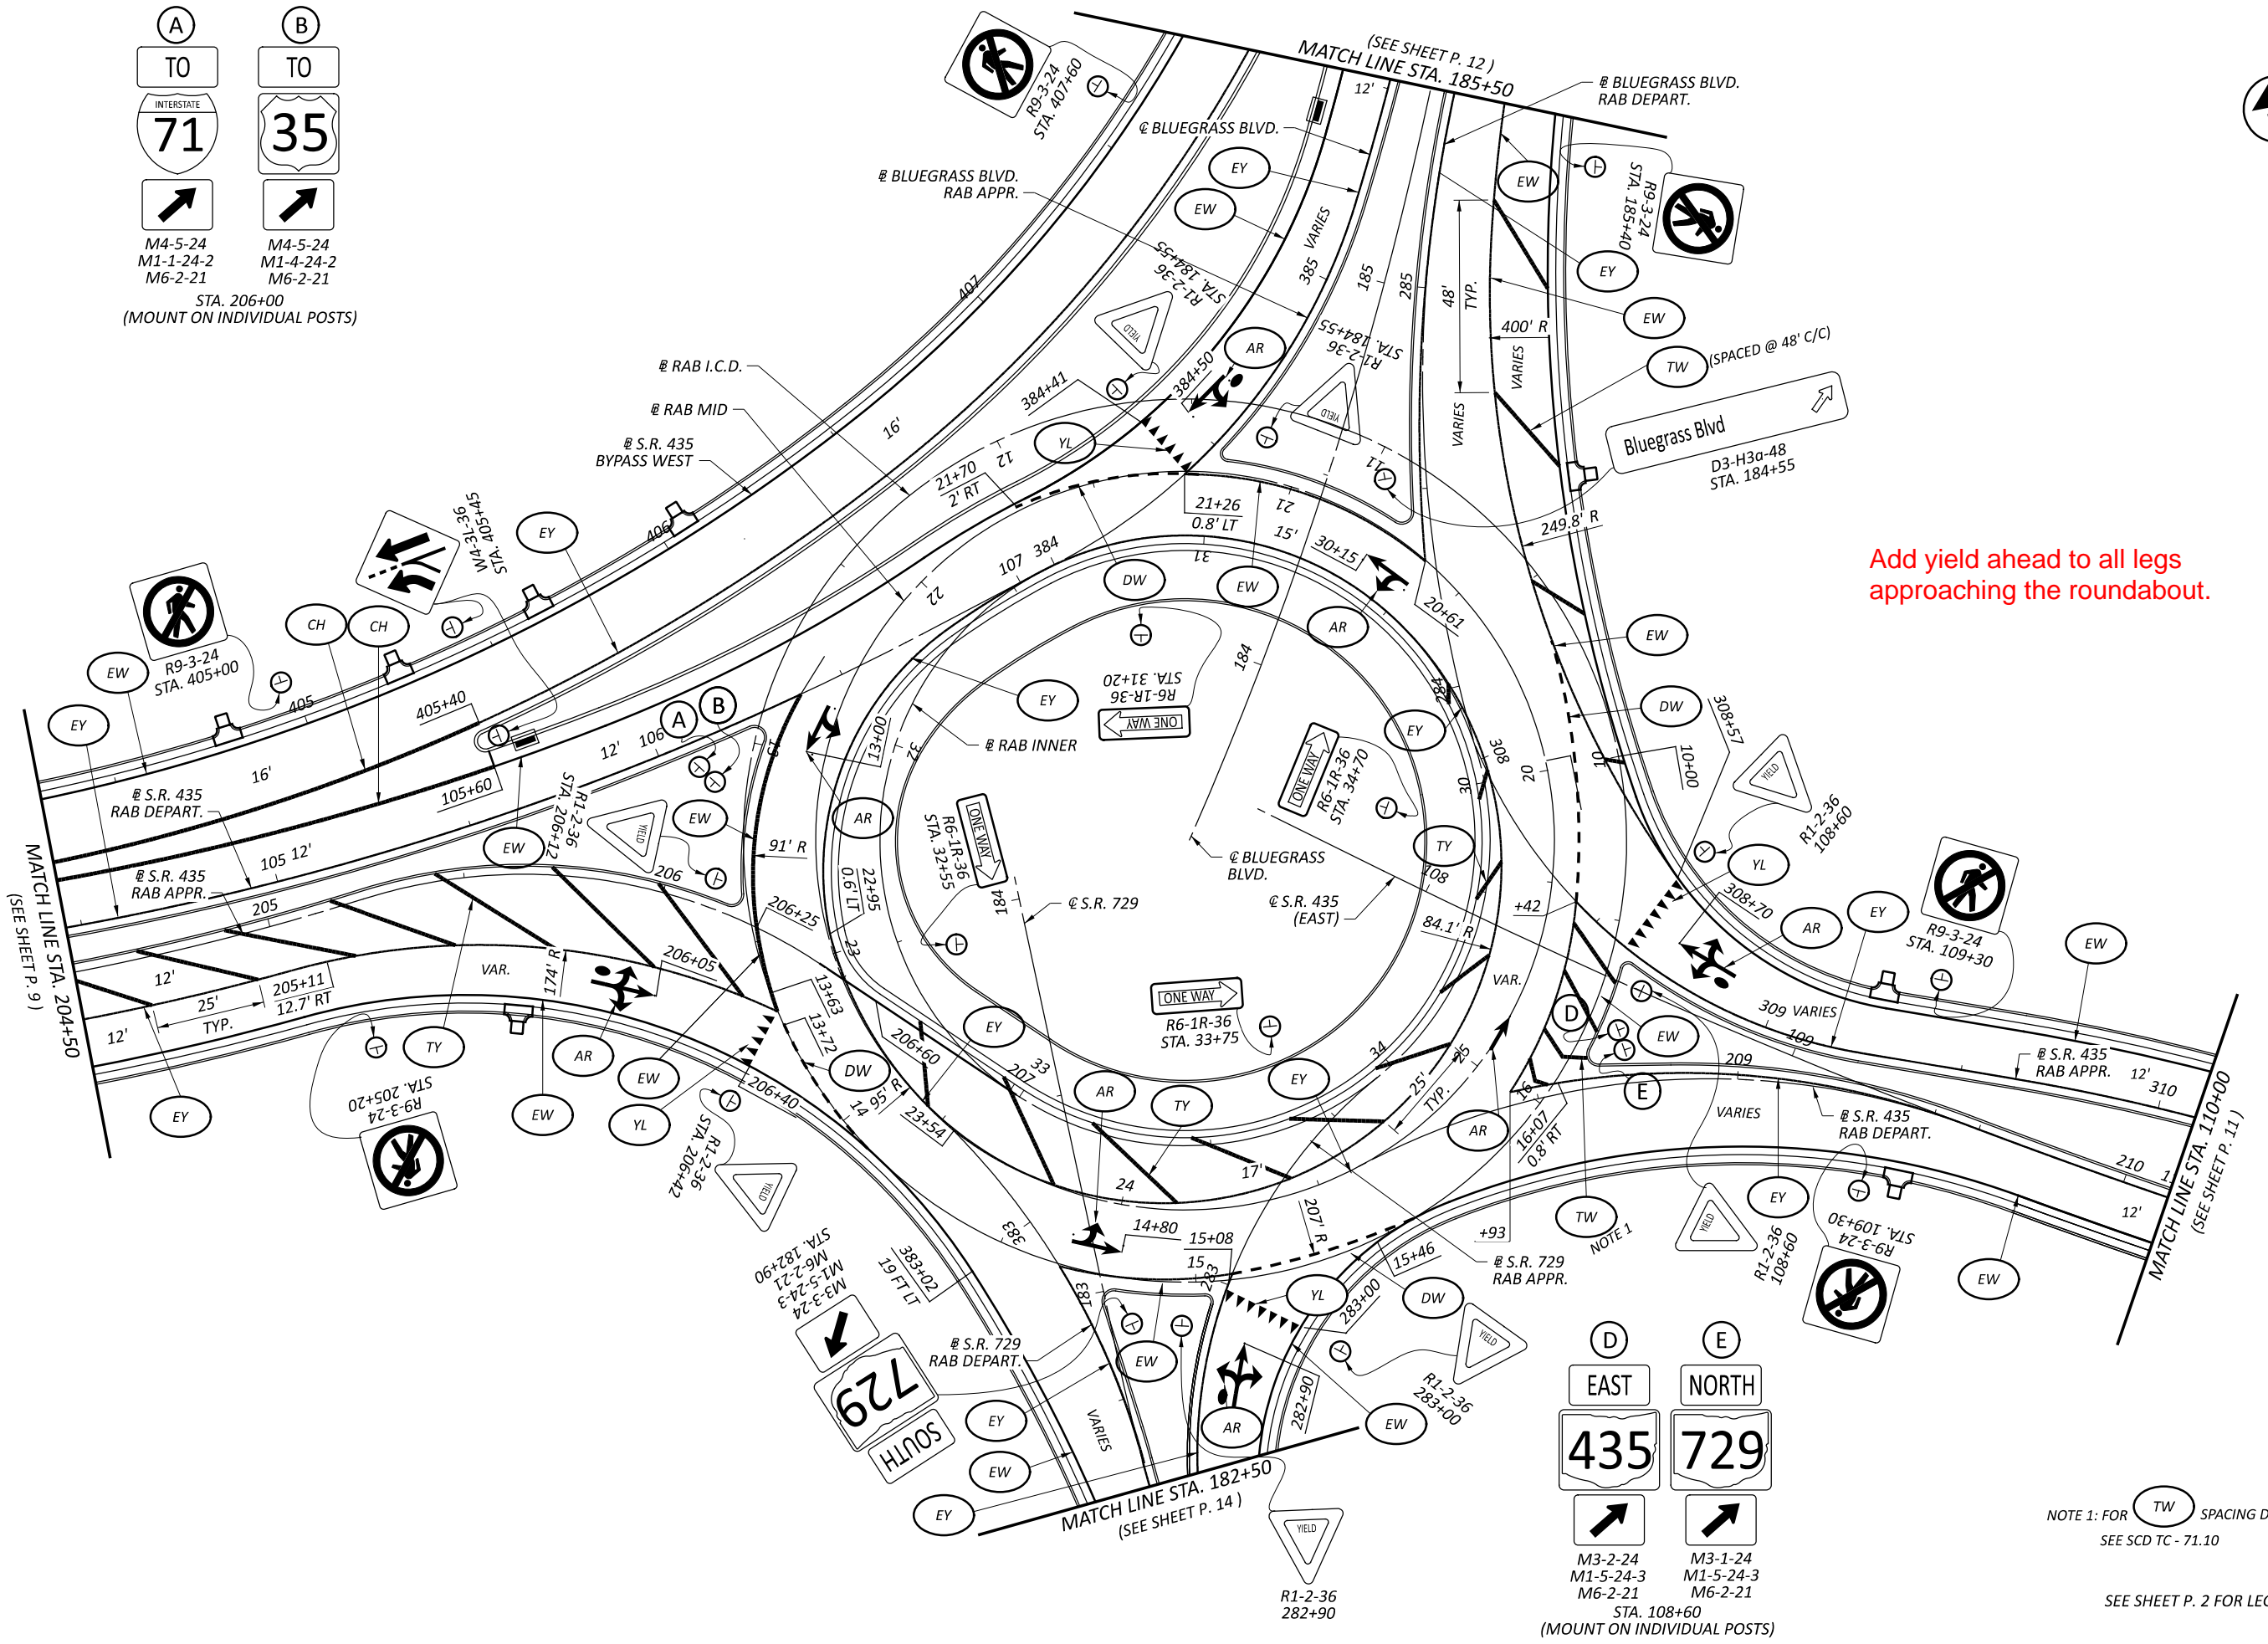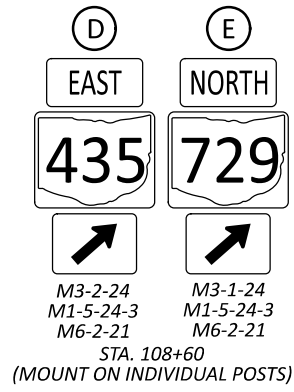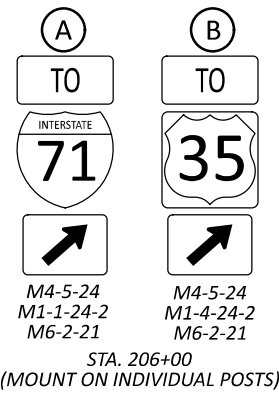

Add yield ahead to all legs approaching the roundabout.





NOTE 1: FOR TW SPACING DETAILS, SEE SCD TC - 71.10

SEE SHEET P. 2 FOR LEGEND

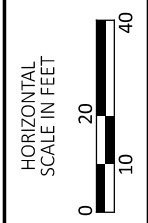




TRAFFIC CONTROL PLAN
 ROUNDABOUT CENTER

| | |
|---|--------------------|
| DESIGN AGENCY | Palmer ENGINEERING |
| 8350 E. KEMPER RD. SUITE B CINCINNATI, OH 45249 513-469-1600 | |
| DESIGNER | SVK |
| REVIEWER | DCJ |
| PROJECT ID | 117955 |
| SHEET | TOTAL |
| P. 10 | 18 |

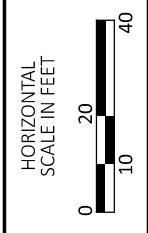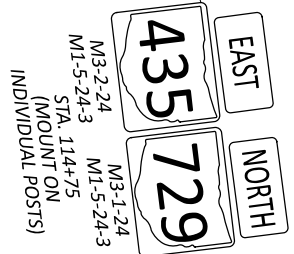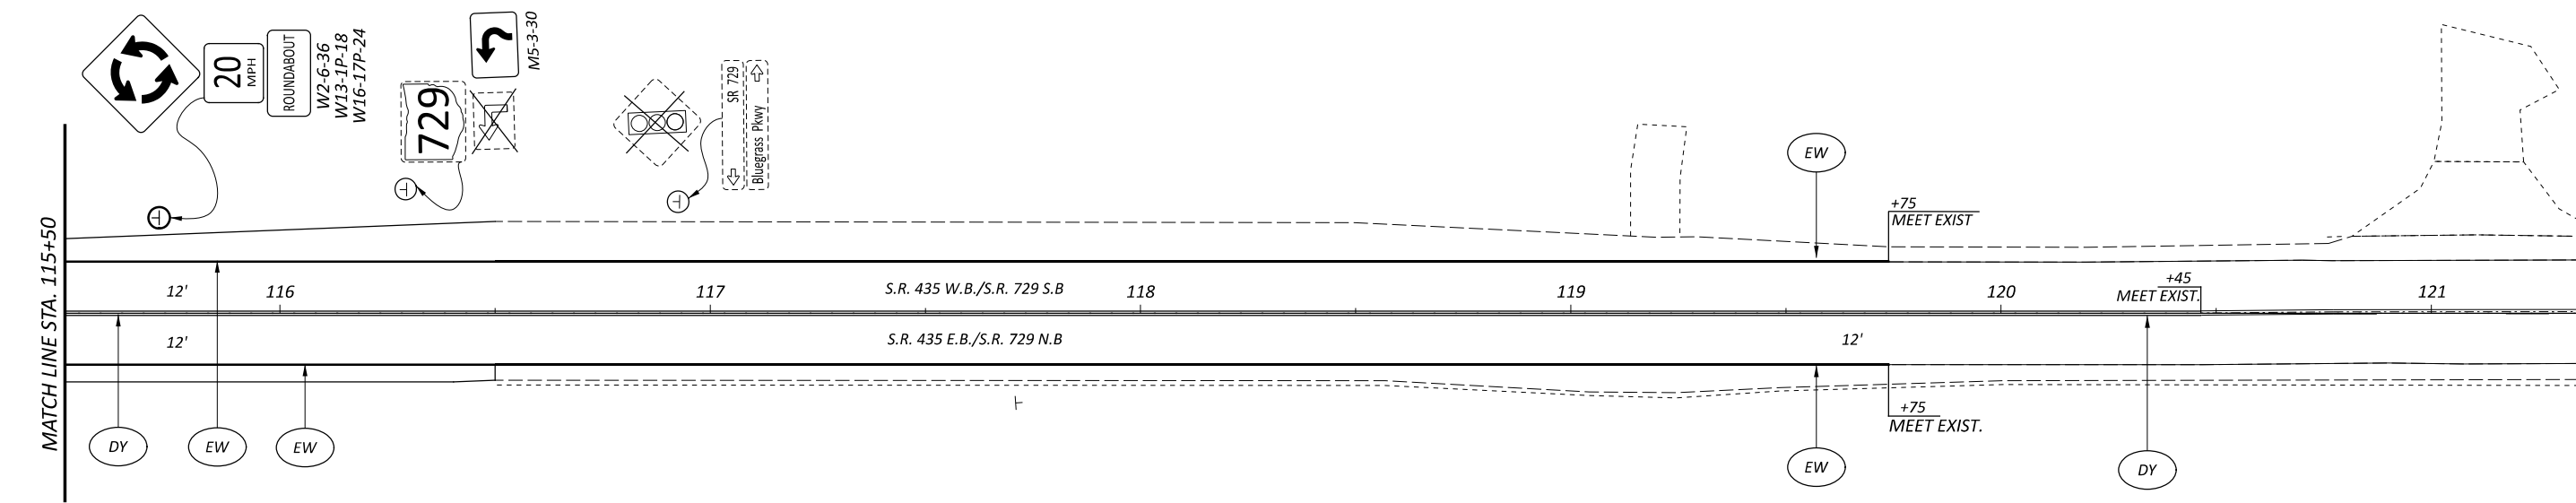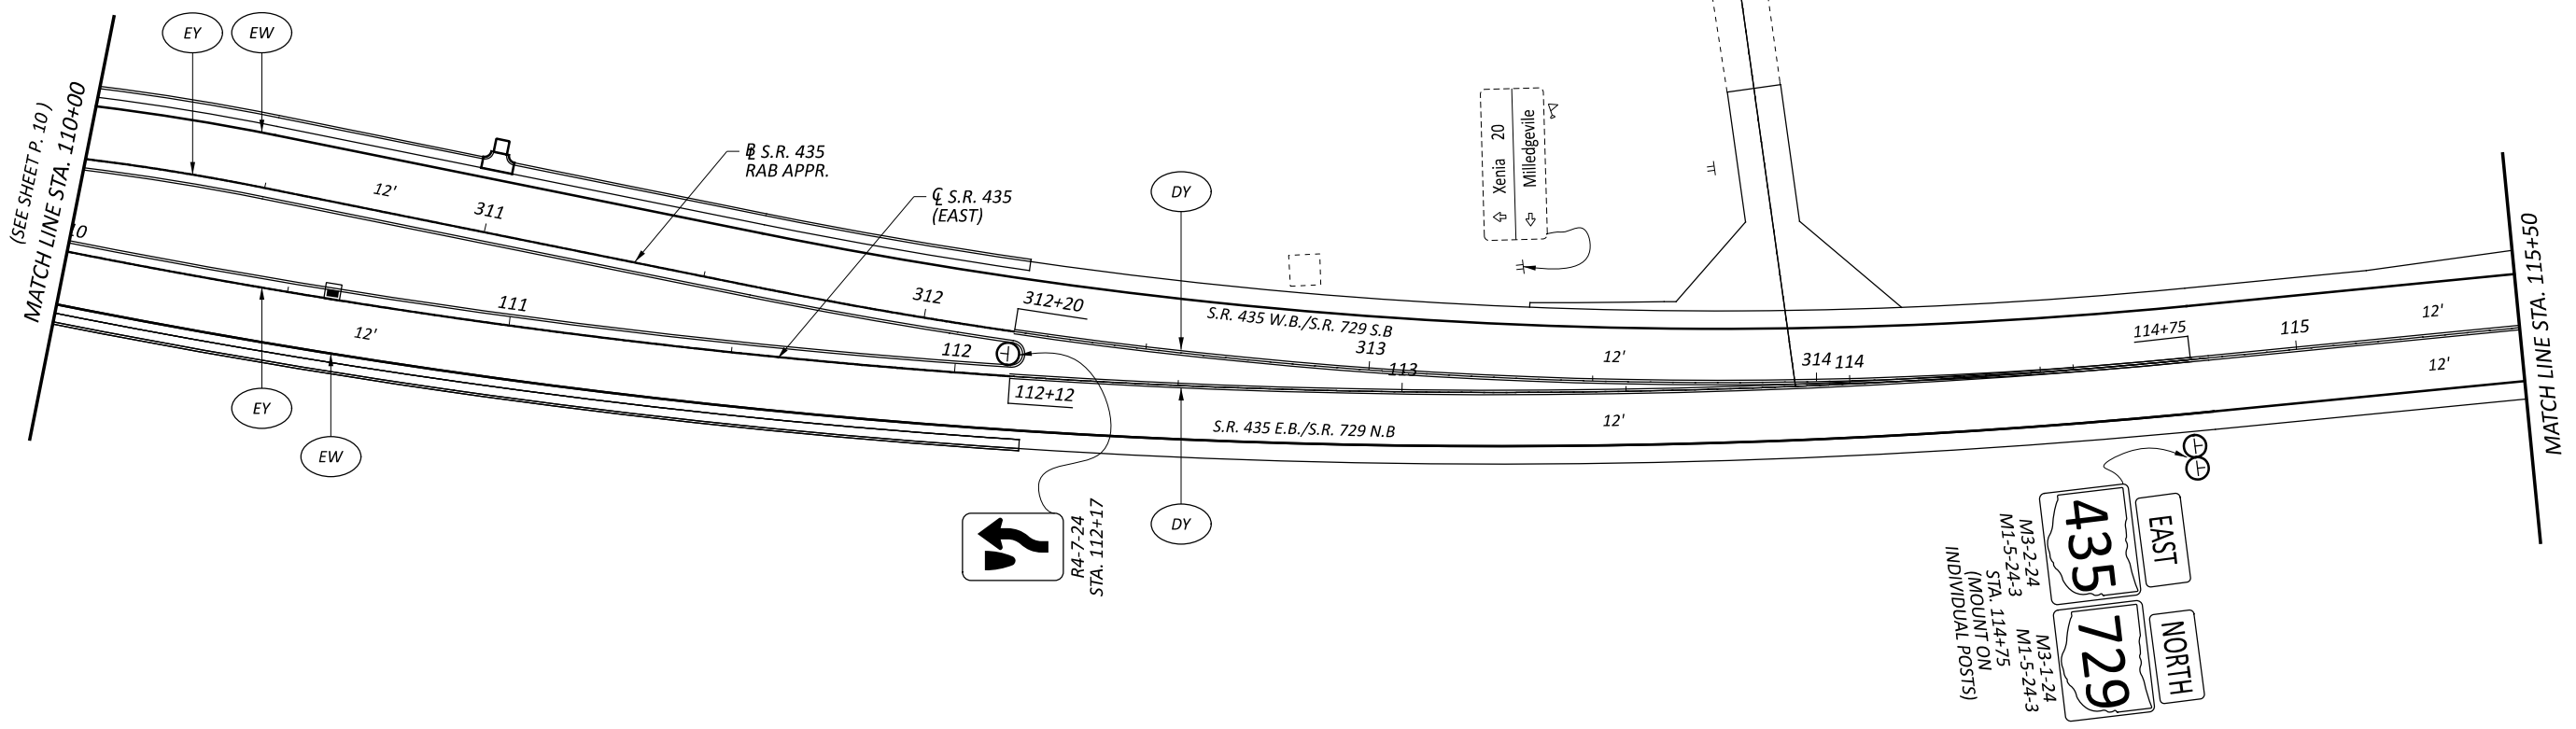

TRAFFIC CONTROL PLAN
 S.R. 435 WEST - STA. 110+00 TO STA. 121+00

| | |
|---|----------|
| DESIGN AGENCY | |
| | |
| 8350 E. KEMPER RD. SUITE B CINCINNATI, OH 45249 513-469-1600 | |
| DESIGNER | SVK |
| REVIEWER | DCJ |
| PROJECT ID | 06/07/24 |
| SHEET | 117955 |
| TOTAL | 18 |

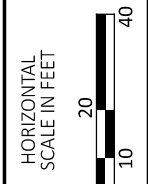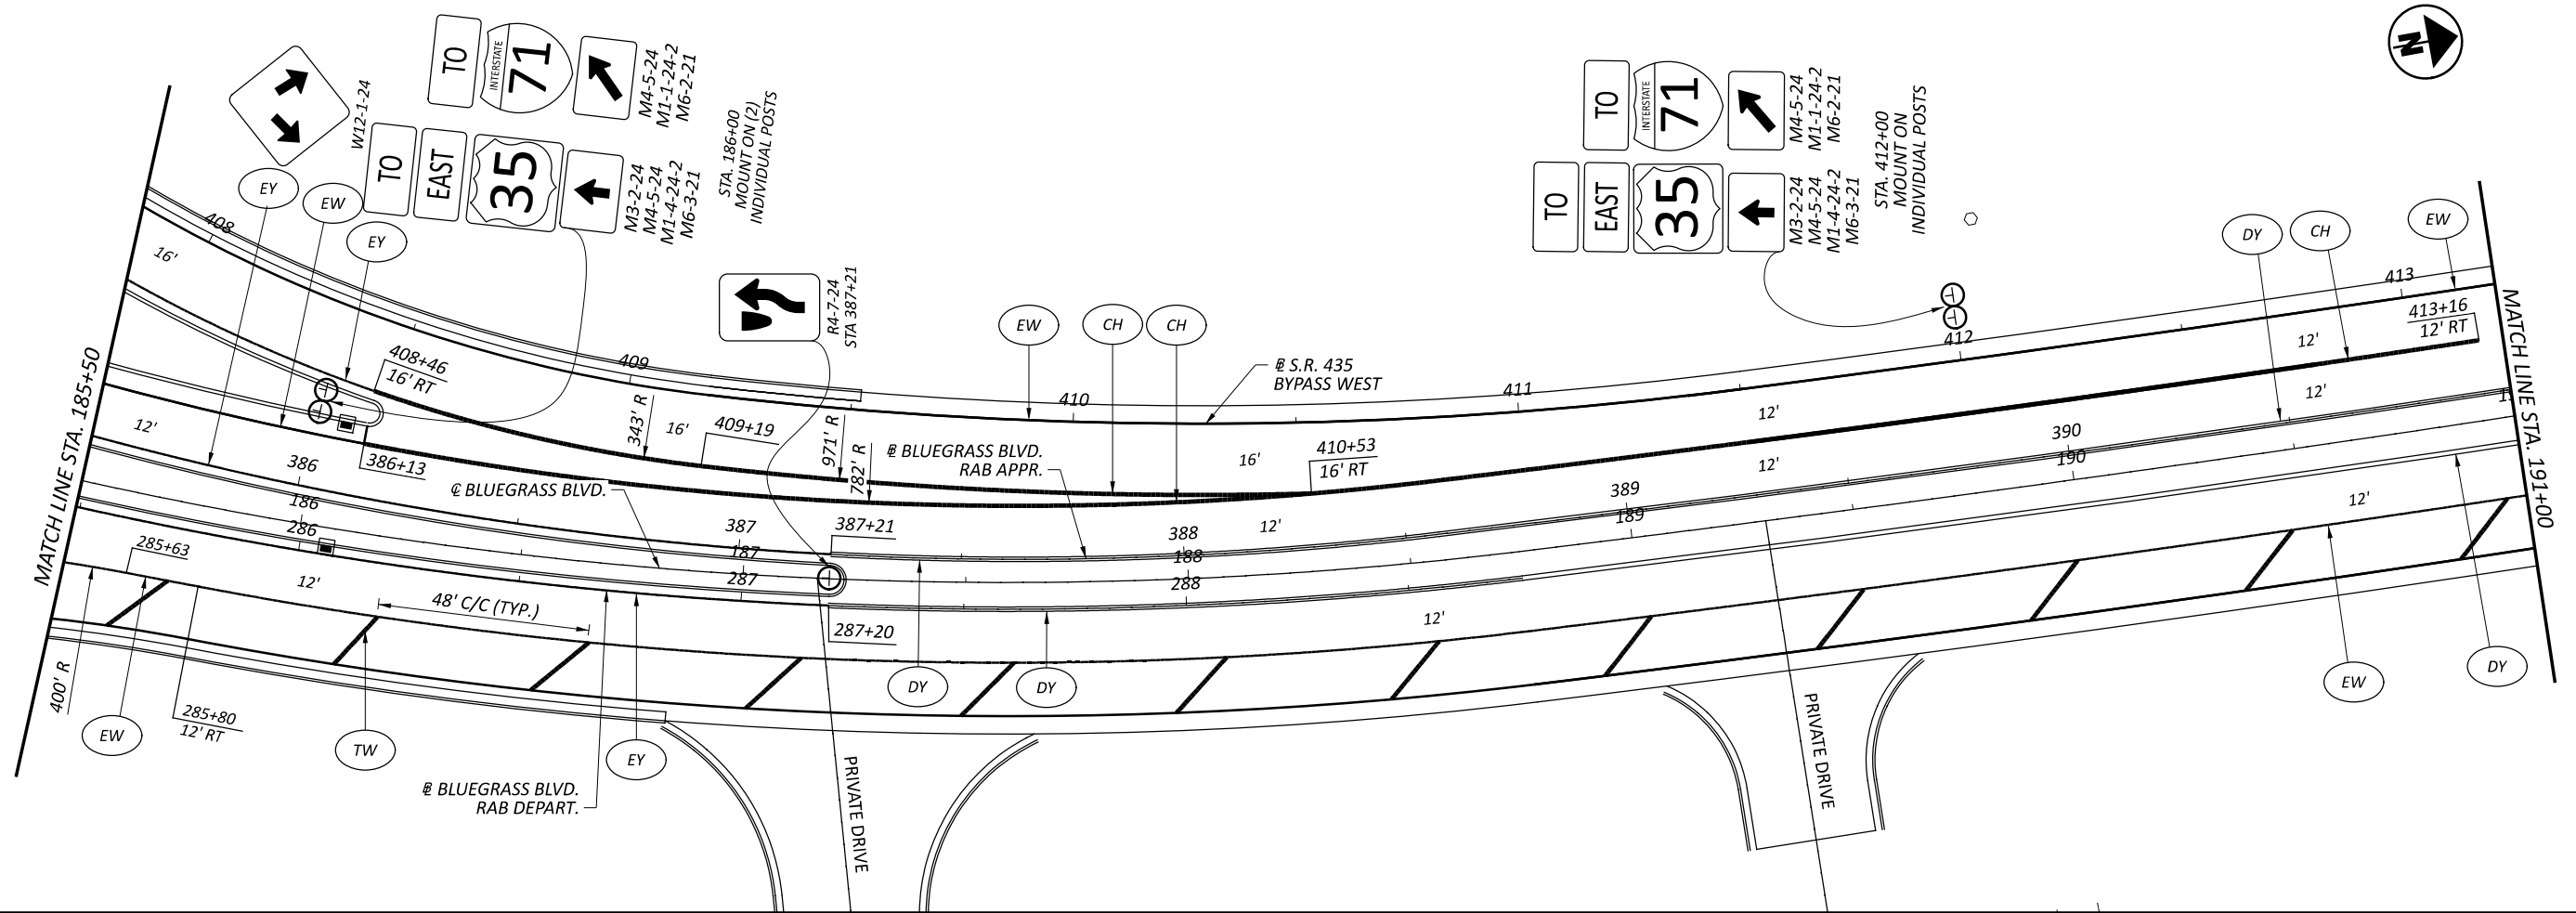
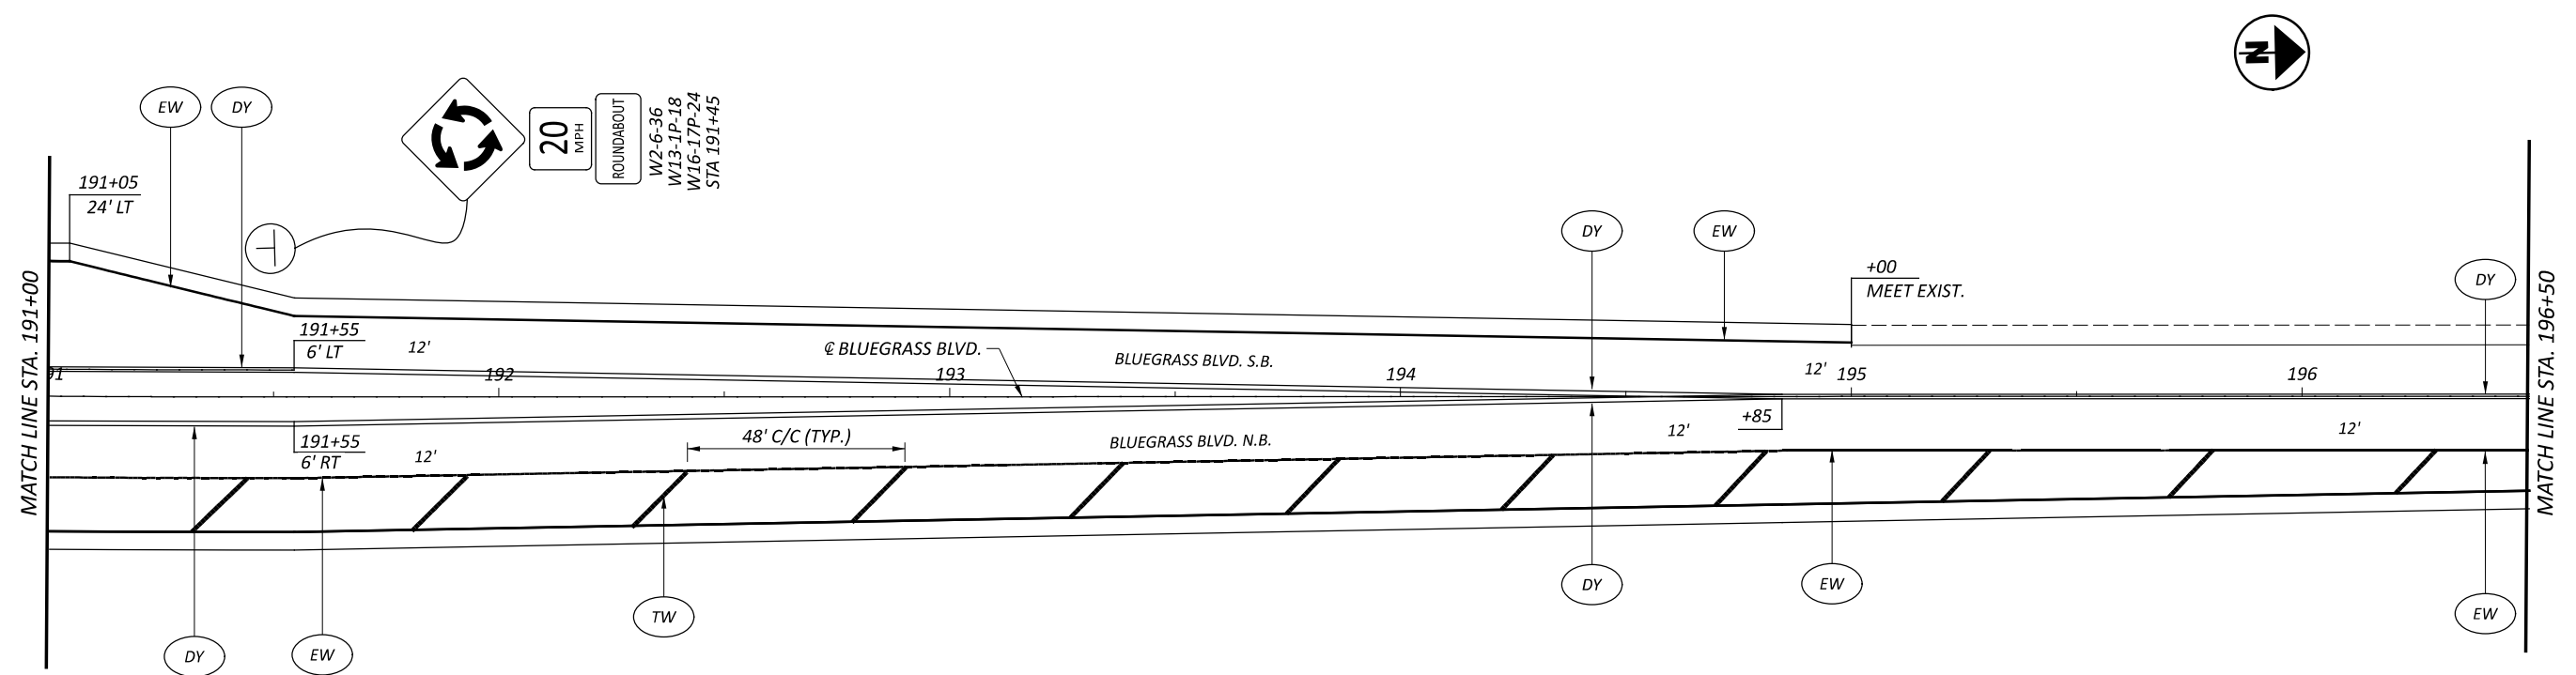


TRAFFIC CONTROL PLAN
 BLUEGRASS BLVD. - STA. 185+50 TO STA. 196+50

DESIGN AGENCY
Palmer
 ENGINEERING
 8350 E. KEMPER RD.
 SUITE B
 CINCINNATI, OH 45249
 513-469-1600




| | |
|------------|--------------|
| DESIGNER | SVK |
| REVIEWER | DCJ 06/07/24 |
| PROJECT ID | 117955 |
| SHEET | TOTAL |
| P. 12 | 18 |

SEE SHEET P. 2 FOR LEGEND

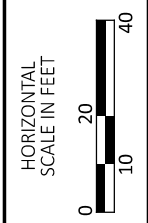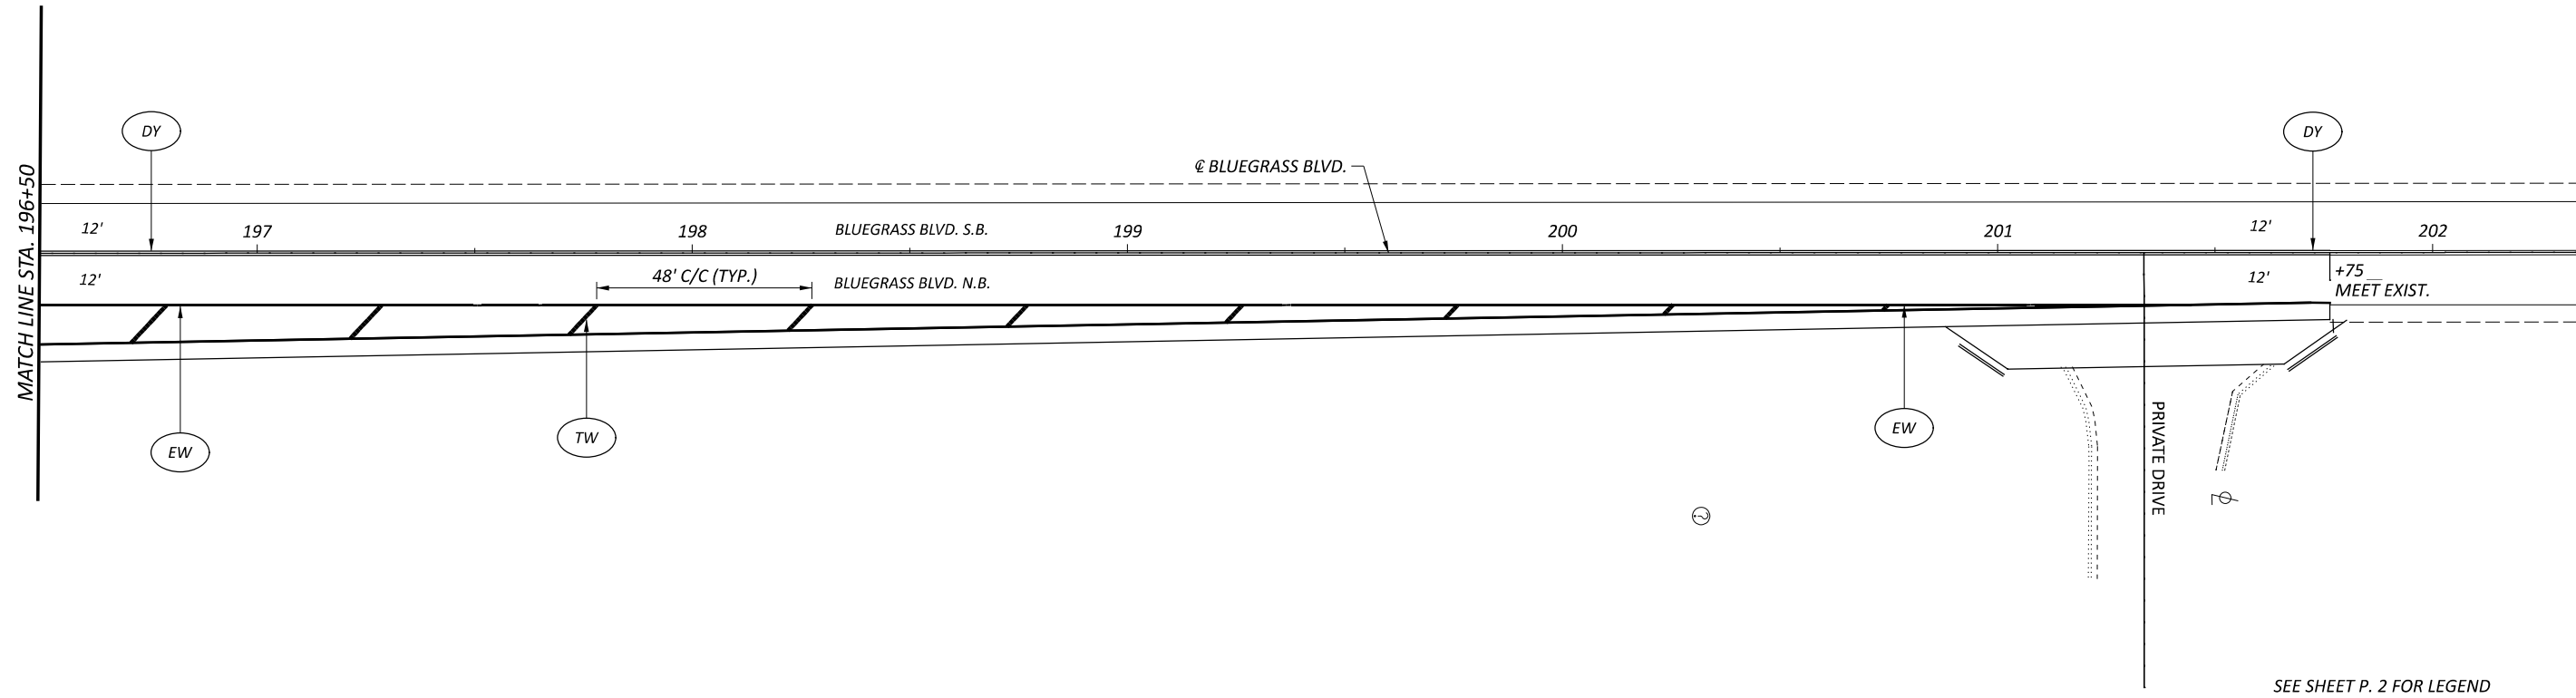

TRAFFIC CONTROL PLAN
 BLUEGRASS BLVD. - STA. 196+50 TO STA. 202+00



| | |
|---|--------------|
| DESIGN AGENCY | |
| 8350 E. KEMPER RD. SUITE B CINCINNATI, OH 45249 513-469-1600 | |
| DESIGNER | SVK |
| REVIEWER | DCJ 06/07/24 |
| PROJECT ID | 117955 |
| SHEET | TOTAL |
| P. 13 | 18 |

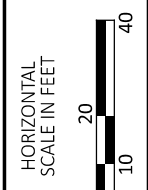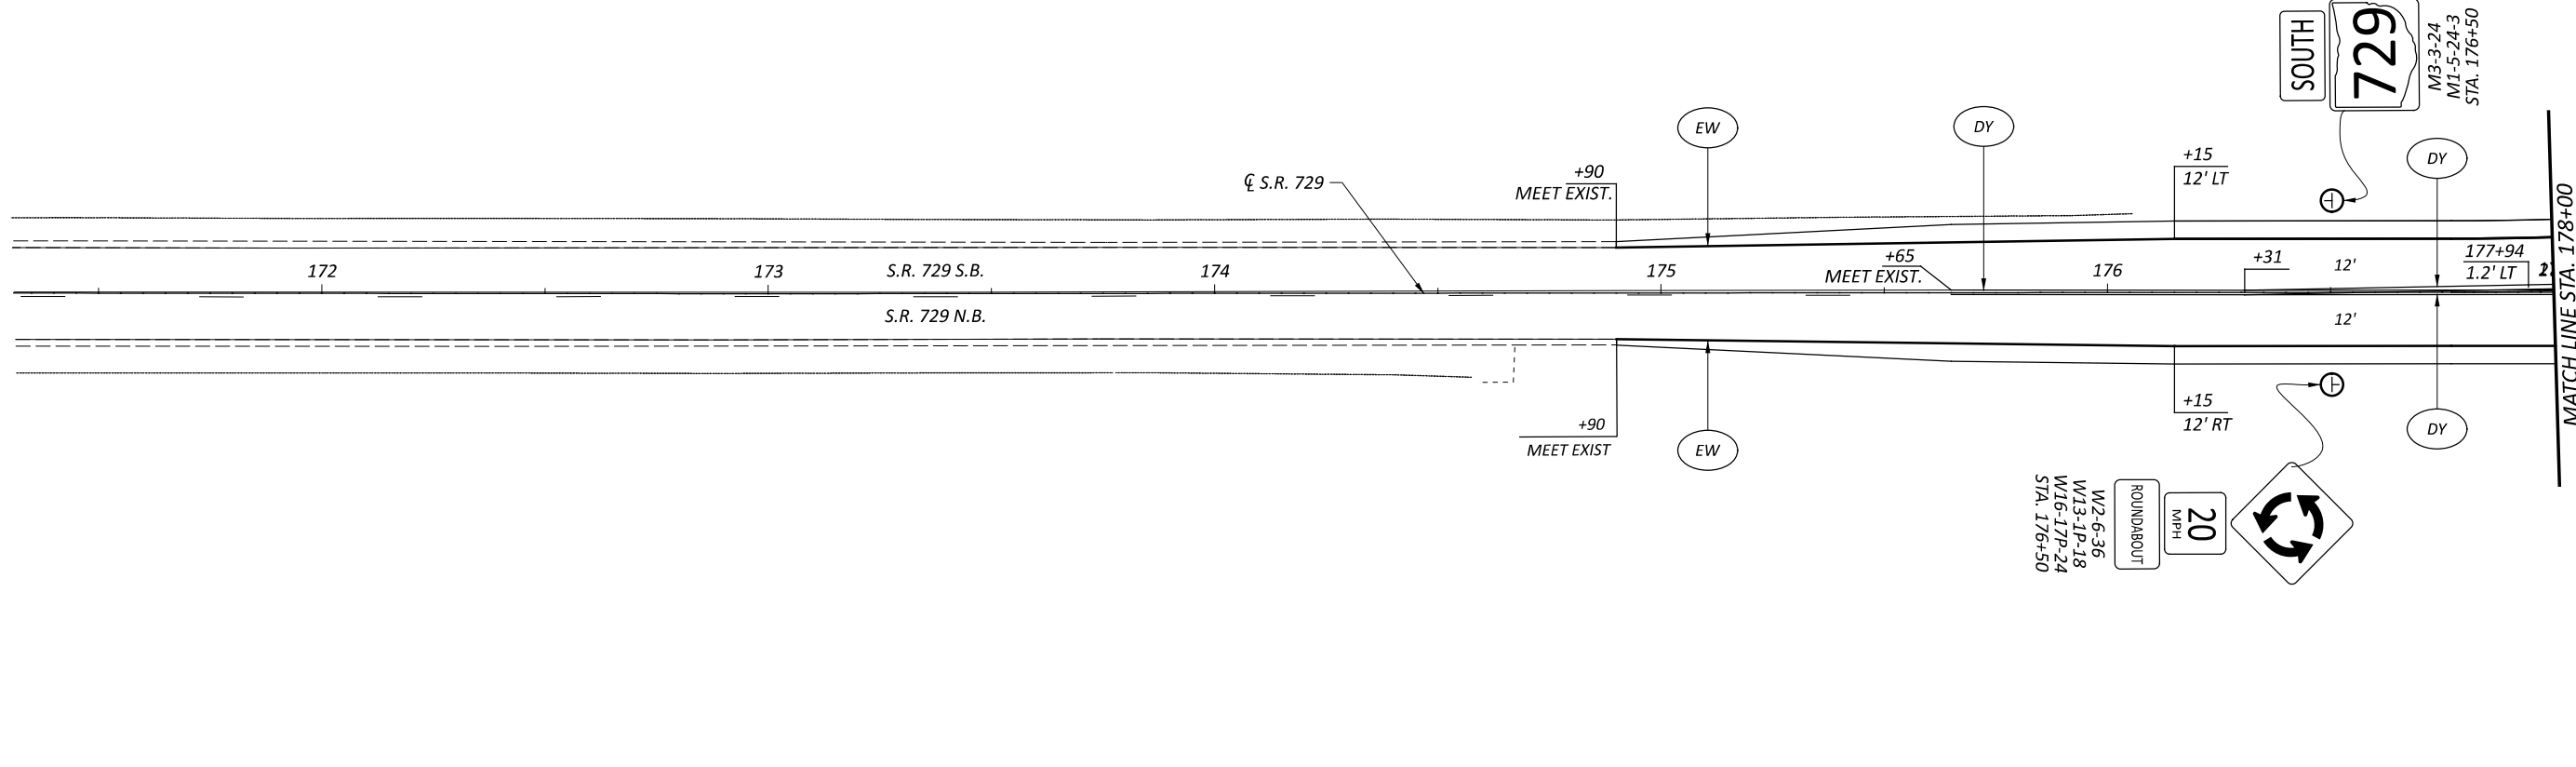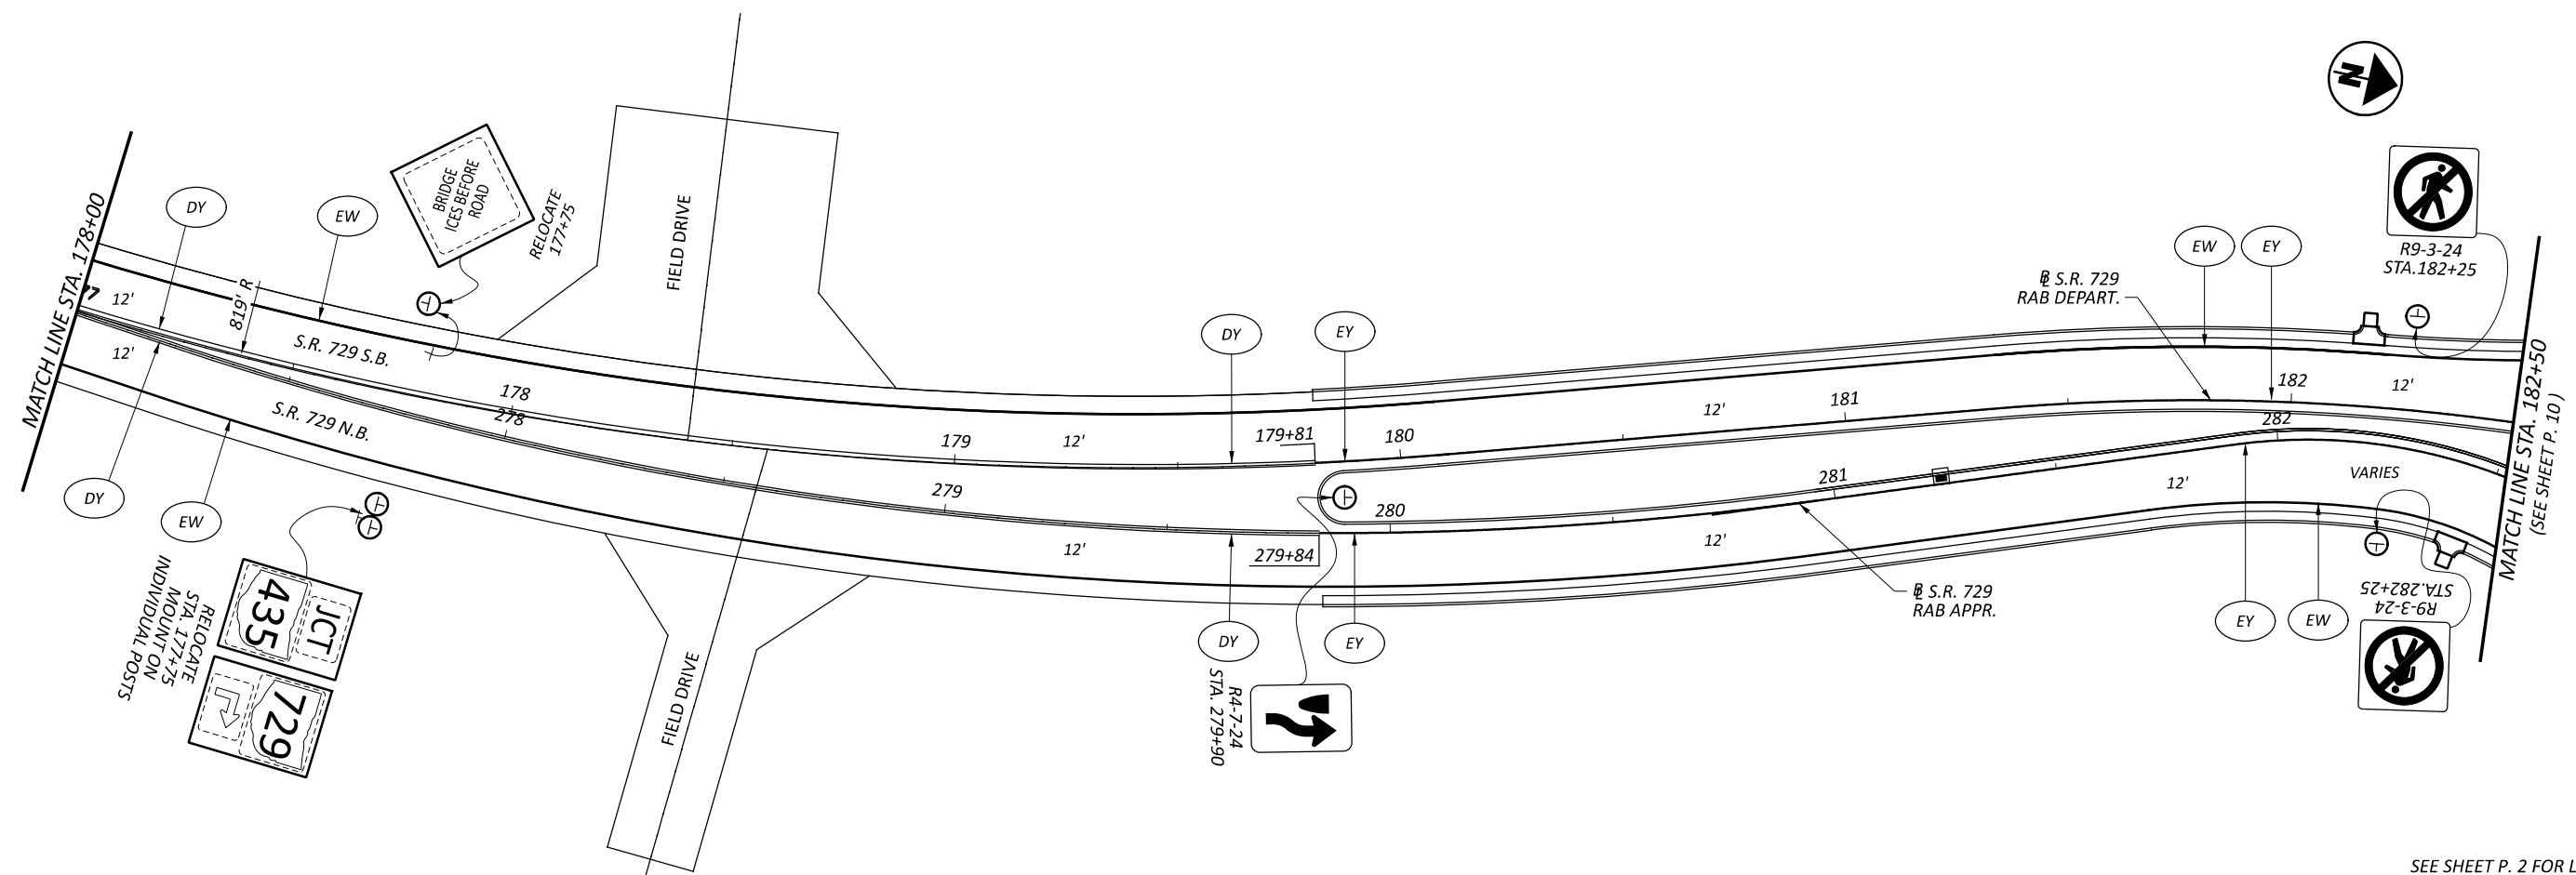

TRAFFIC CONTROL PLAN
S.R. 729 - STA. 171+50 TO STA. 182+50

| | |
|---------------|--------------------|
| DESIGN AGENCY | Palmer ENGINEERING |
| DESIGNER | SVK |
| REVIEWER | DCJ 06/07/24 |
| PROJECT ID | 117955 |
| SHEET | P. 14 |
| TOTAL | 18 |

SEE SHEET P. 2 FOR LEGEND

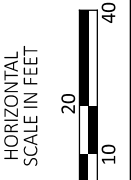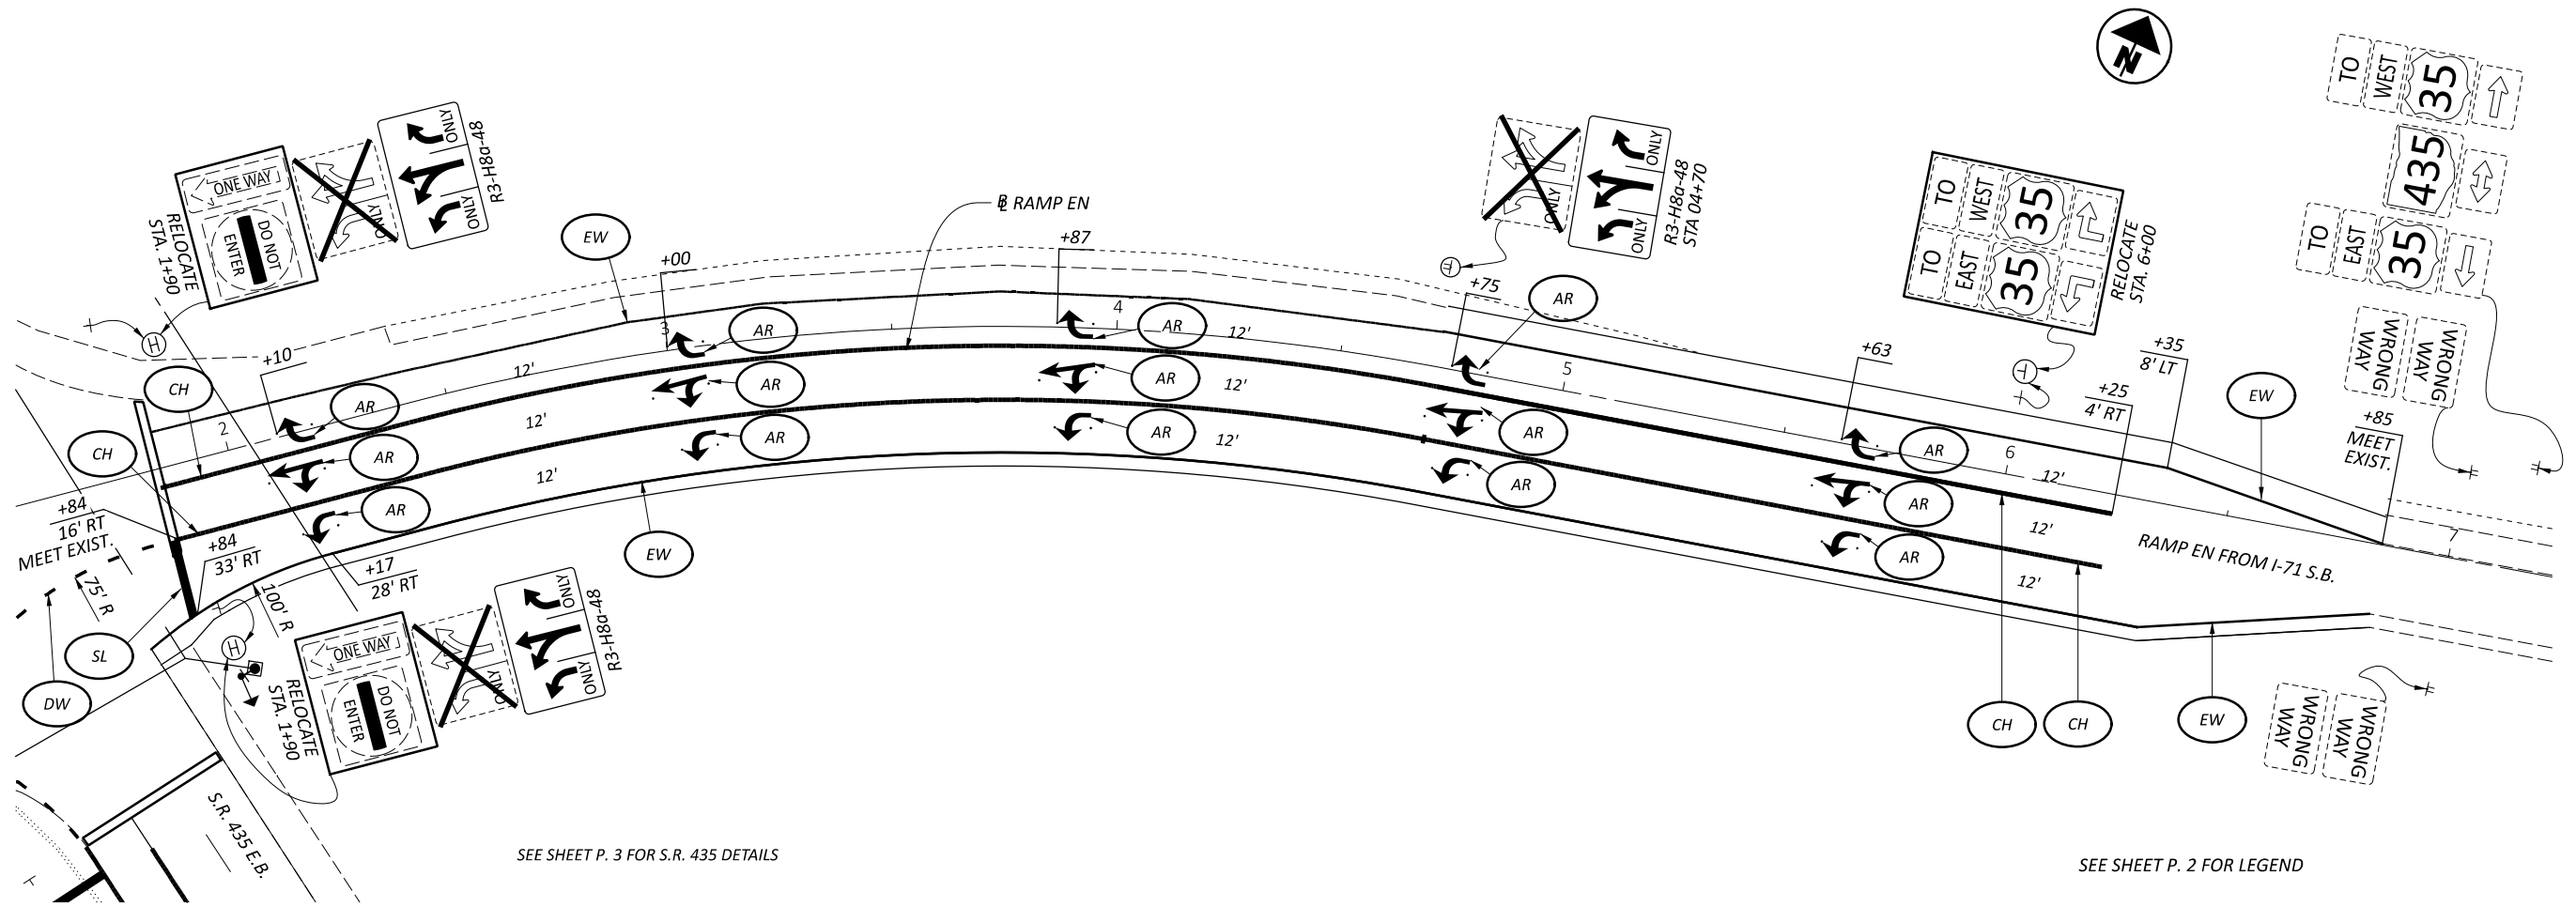

TRAFFIC CONTROL PLAN
 RAMP EN - STA. 2.50 TO STA. 7+00

DESIGN AGENCY



Palmer
 ENGINEERING
 8350 E. KEMPER RD.
 SUITE B
 CINCINNATI, OH 45249
 513-469-1600

DESIGNER
 SVK

REVIEWER
 DCJ 06/07/24

PROJECT ID
 117955

SHEET TOTAL
 P. 15 18


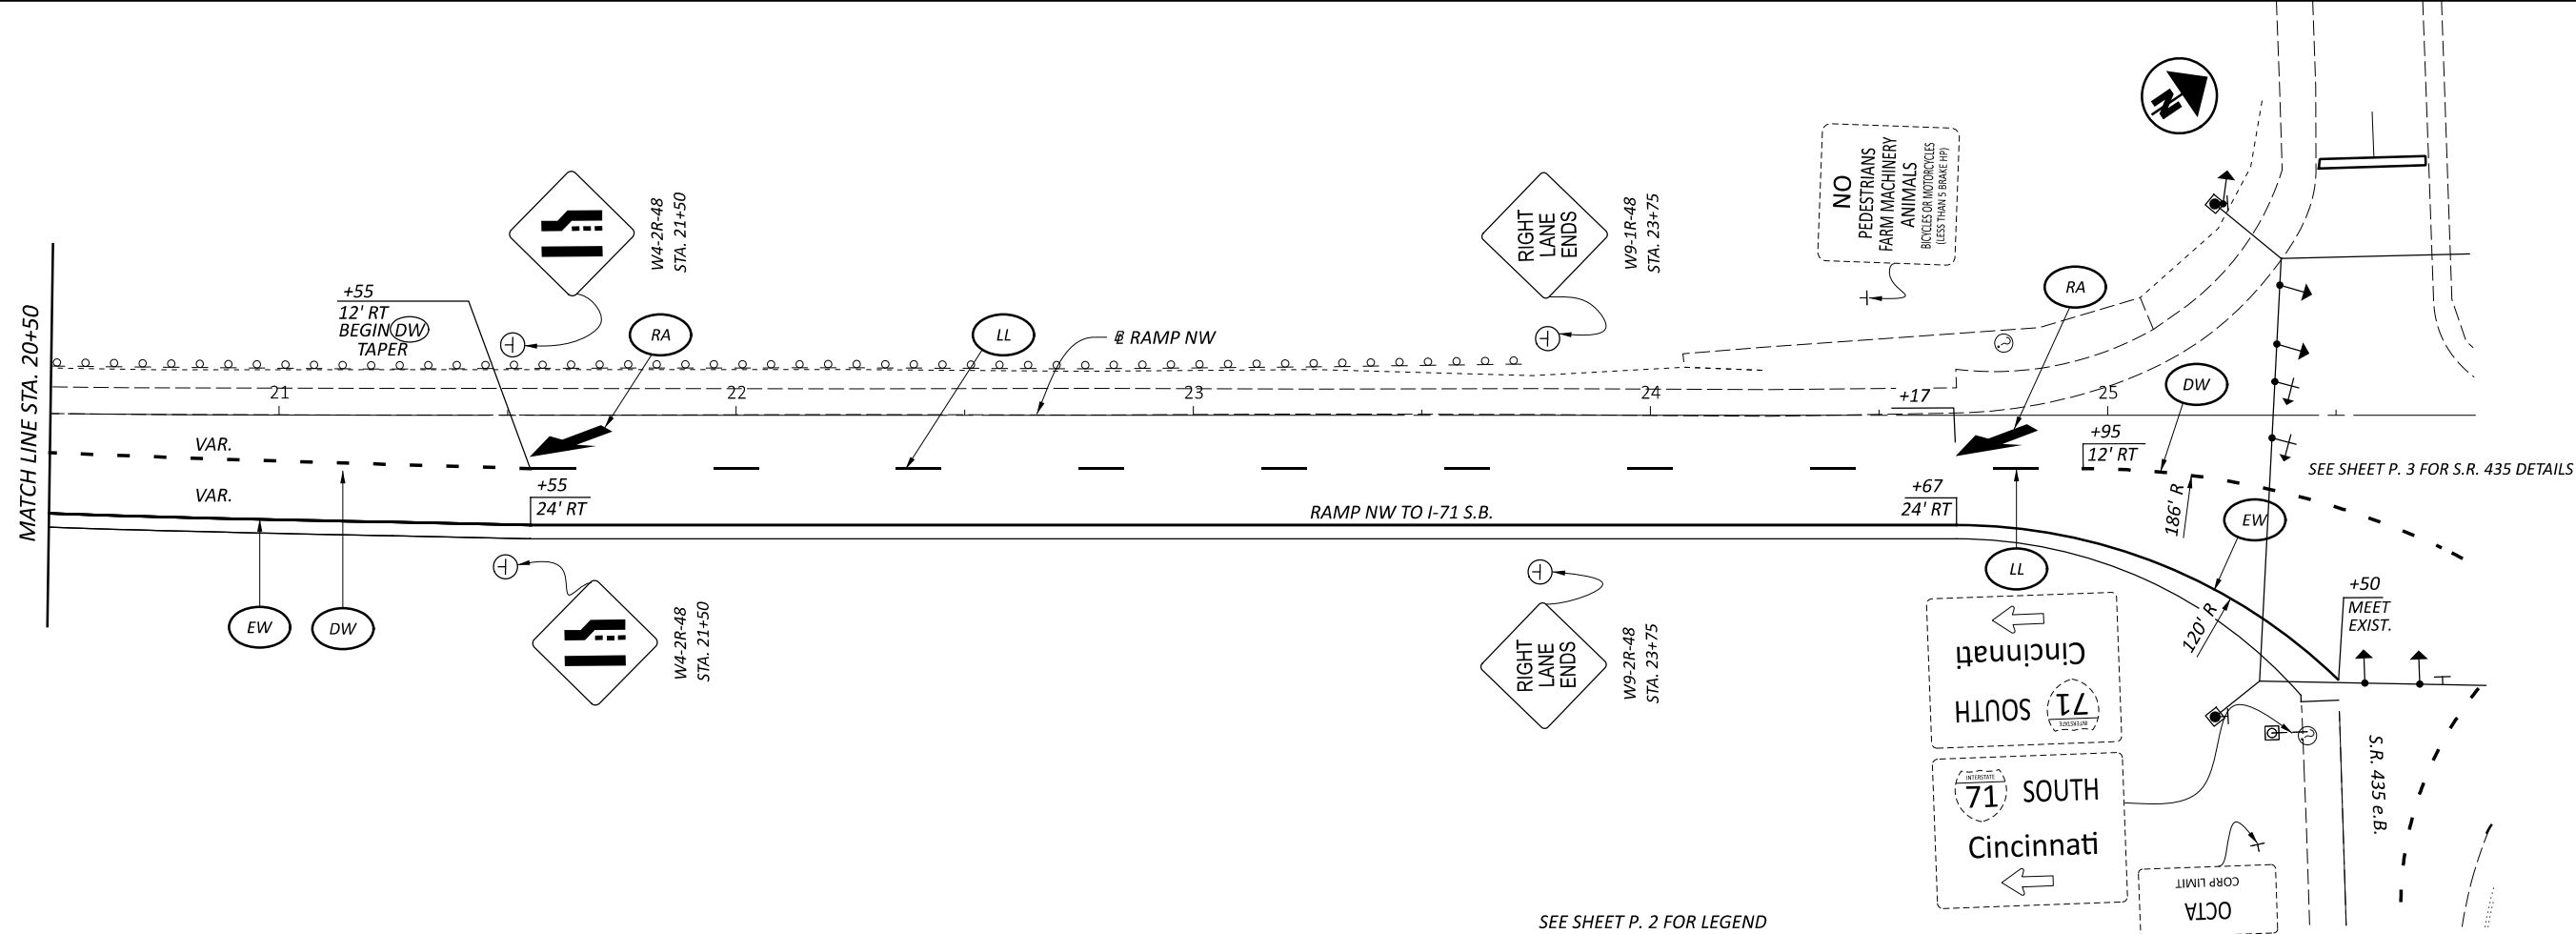
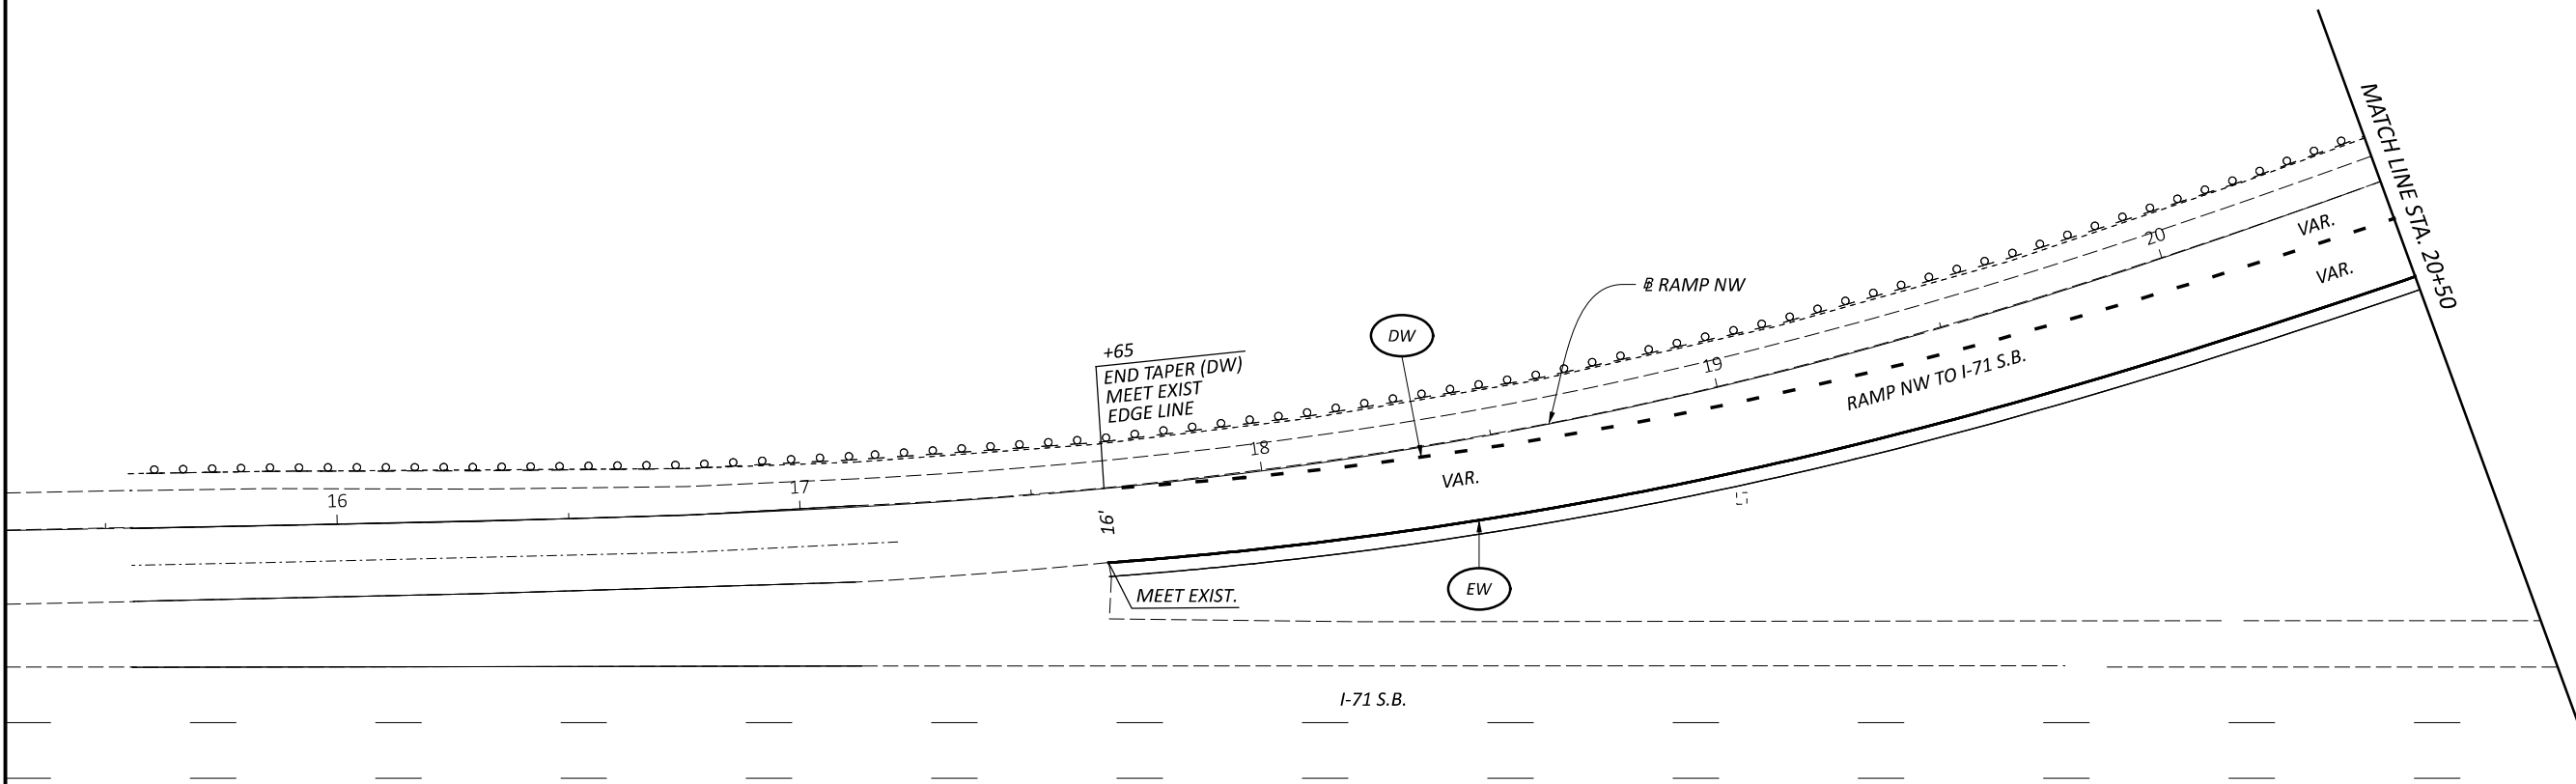


SEE SHEET P. 2 FOR LEGEND

TRAFFIC CONTROL PLAN
 RAMP NW - STA. 15+50 TO STA. 25+50

| | |
|---------------|--------------------|
| DESIGN AGENCY | Palmer ENGINEERING |
| DESIGNER | SVK |
| REVIEWER | DCJ |
| DATE | 06/07/24 |
| PROJECT ID | 117955 |
| SHEET | P. 16 |
| TOTAL | 18 |


8350 E. KEMPER RD.
 SUITE B
 CINCINNATI, OH 45249
 513-469-1600

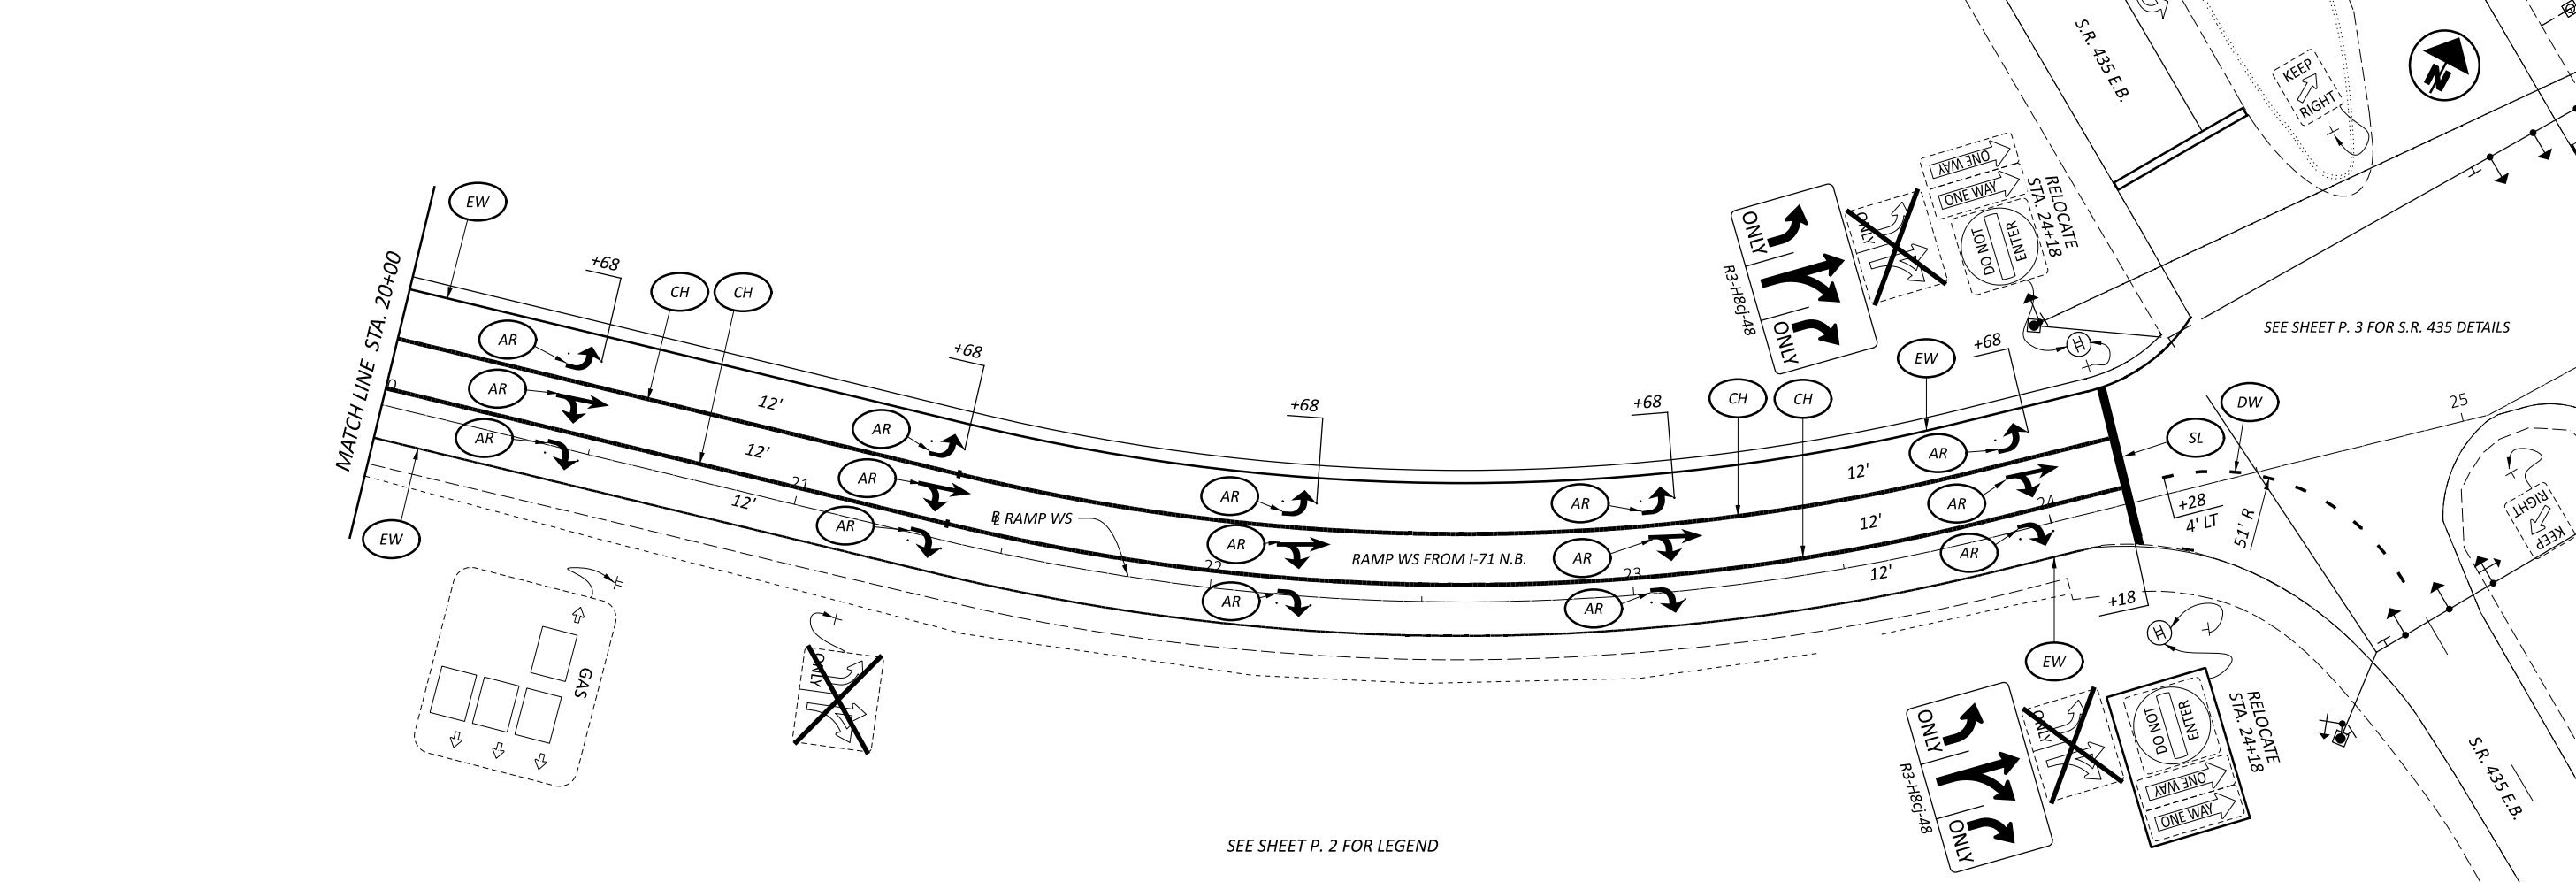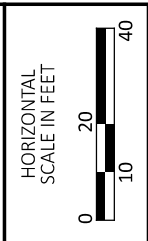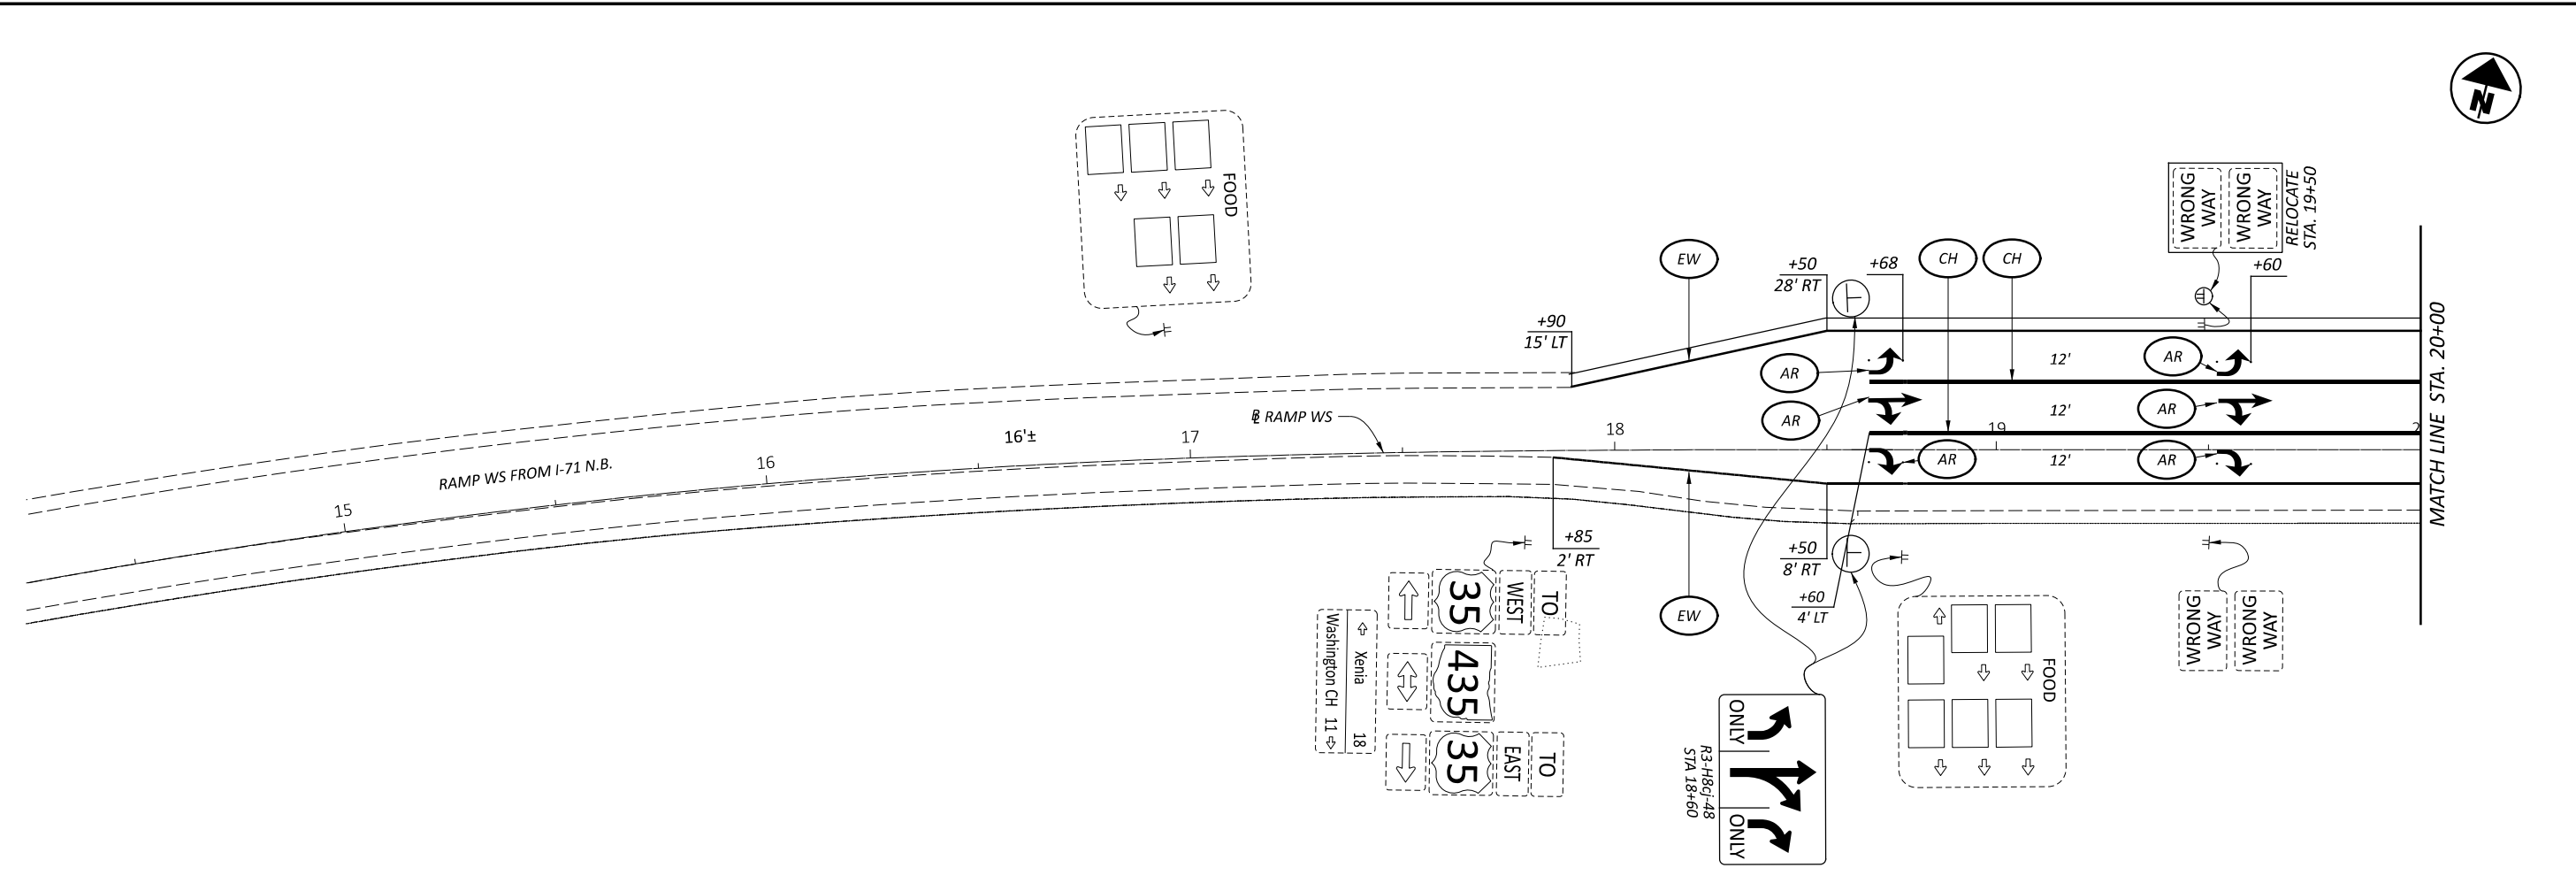

SEE SHEET P. 2 FOR LEGEND

TRAFFIC CONTROL PLAN
 RAMP WS - STA. 14+50 TO STA. 25+00

| | |
|---|--------|
| DESIGN AGENCY | |
| Palmer ENGINEERING | |
| 8350 E. KEMPER RD. SUITE B CINCINNATI OH 45249 513-469-1600 | |
| DESIGNER | SVK |
| REVIEWER | DCJ |
| PROJECT ID | 117955 |
| SHEET | TOTAL |
| P. 17 | 18 |

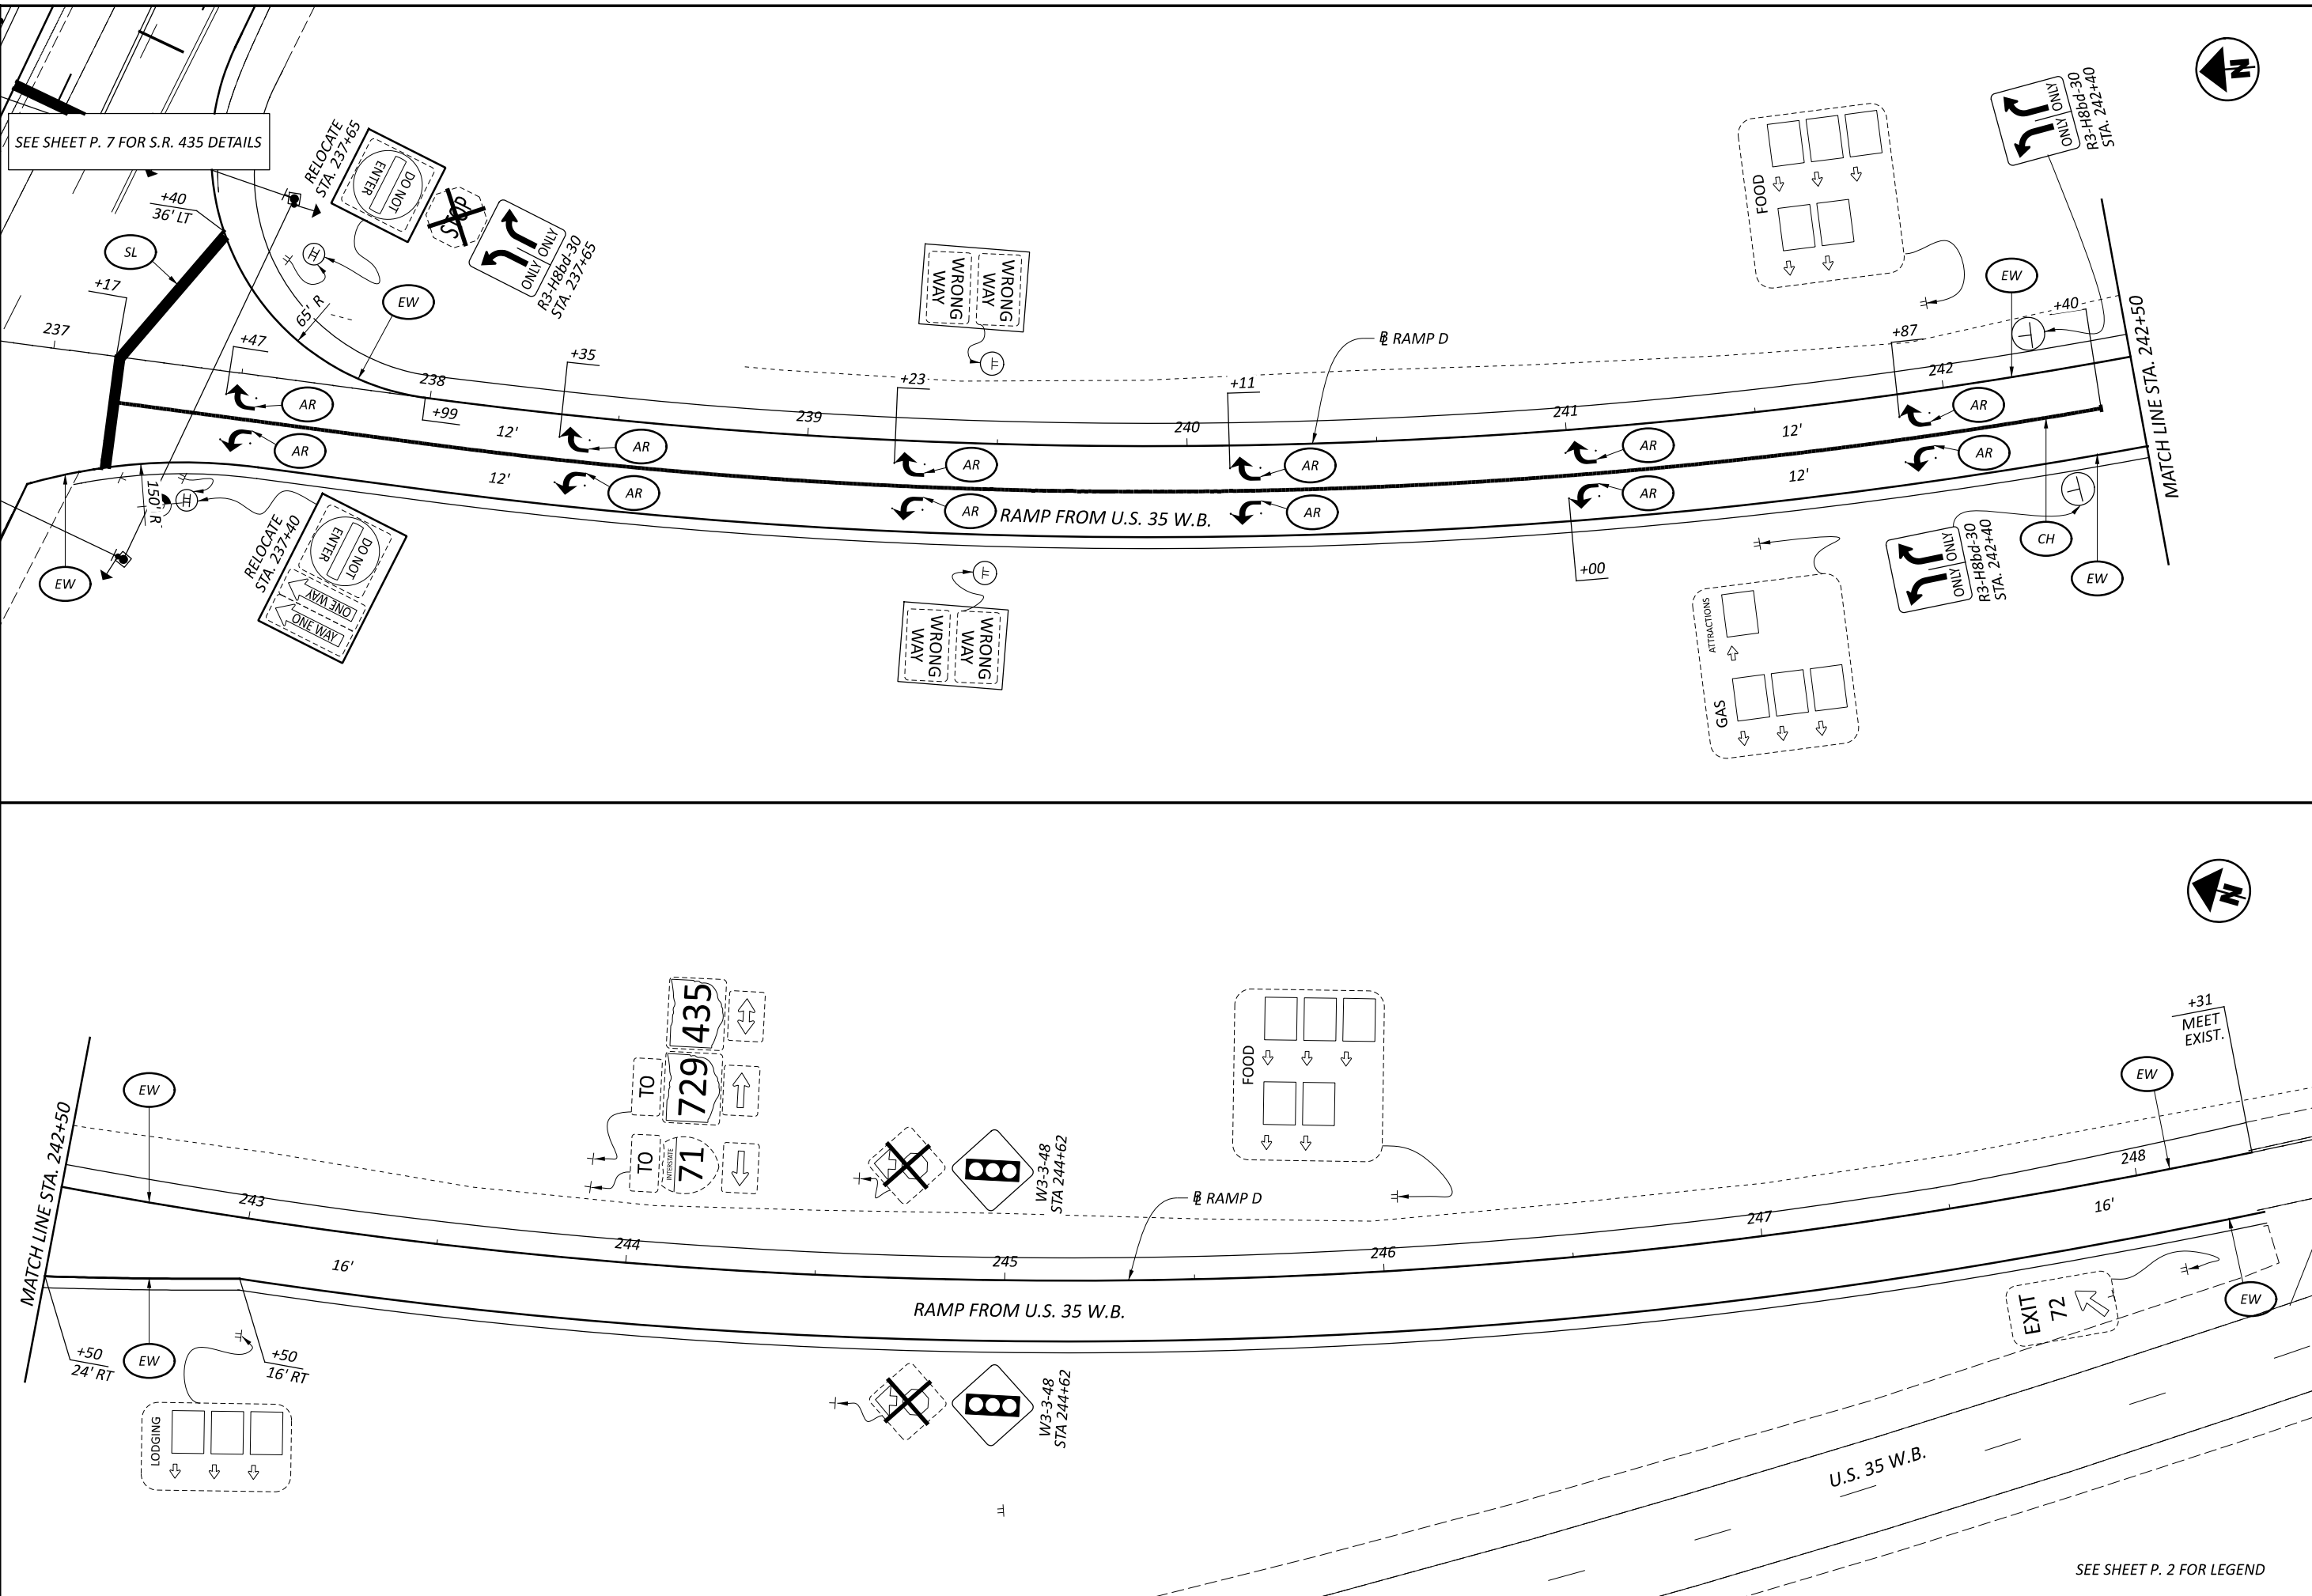

TRAFFIC CONTROL PLAN
RAMP D - STA. 237+00 TO STA. 248+50

| | |
|---|----------|
| DESIGN AGENCY | |
| Palmer ENGINEERING | |
| 8350 E. KEMPER RD. SUITE B CINCINNATI, OH 45249 513-469-1600 | |
| DESIGNER | SVK |
| REVIEWER | DCJ |
| PROJECT ID | 06/07/24 |
| | 117955 |
| SHEET | TOTAL |
| P. 18 | 18 |

SEE SHEET P. 2 FOR LEGEND