

DESIGN DESIGNATION

DESIGN DESIGNATION - SR-435 FROM PROJECT BEGINNING TO STA. 86+00

LOCATION: SR-435
 CURRENT ADT (2024): 18,680
 DESIGN YEAR ADT (2044): 24,590
 DESIGN HOURLY VOLUME: 3,580
 DIRECTIONAL DISTRIBUTION: 68%
 TRUCKS: 27%
 DESIGN SPEED: 35 MPH (FROM BEGIN PROJECT TO STA. 63+78) 60 MPH (FROM STA. 63+78 TO 86+00)
 LEGAL SPEED: 35 MPH (FROM BEGIN PROJECT TO STA. 63+78) 55 MPH (FROM STA. 63+78 TO 86+00)
 DESIGN FUNCTIONAL CLASSIFICATION: 05 – MAJOR COLLECTOR (RURAL)
 NHS: NO

DESIGN DESIGNATION - SR-435 FROM STA. 86+00 TO END PROJECT

LOCATION: SR-435
 CURRENT ADT (2024): 8,110
 DESIGN YEAR ADT (2044): 12,830
 DESIGN HOURLY VOLUME: 2,280
 DIRECTIONAL DISTRIBUTION: 68%
 TRUCKS: 12%
 DESIGN SPEED: 60 MPH
 LEGAL SPEED: 55 MPH
 DESIGN FUNCTIONAL CLASSIFICATION: 05 – MAJOR COLLECTOR (RURAL)
 NHS: NO

DESIGN DESIGNATION – US-35 WB EXIT RAMP TO SR-435 (RAMP D)

LOCATION: US-35 WB EXIT RAMP TO SR-435 (RAMP D)
 CURRENT ADT (2024): 4,240
 DESIGN YEAR ADT (2044): 7,280
 DESIGN HOURLY VOLUME: 840
 DIRECTIONAL DISTRIBUTION: -
 TRUCKS: 31%
 DESIGN SPEED: REFER TO L&D VOLUME 1 SECTION 503.2
 LEGAL SPEED:
 DESIGN FUNCTIONAL CLASSIFICATION: 02 – OTHER FREEWAYS OR EXPRESSWAYS (RURAL)
 NHS: YES

DESIGN DESIGNATION – I-71 SB EXIT RAMP TO SR-435 (RAMP EN)

LOCATION: I-71 SB EXIT RAMP TO SR-435 (RAMP EN)
 CURRENT ADT (2024): 4,340
 DESIGN YEAR ADT (2044): 5,150
 DESIGN HOURLY VOLUME: 670
 DIRECTIONAL DISTRIBUTION: -
 TRUCKS: 29%
 DESIGN SPEED: REFER TO L&D VOLUME 1 SECTION 503.2
 LEGAL SPEED:
 DESIGN FUNCTIONAL CLASSIFICATION: 01 – INTERSTATE (RURAL)
 NHS: YES

DESIGN DESIGNATION – I-71 NB EXIT RAMP TO SR-435 (RAMP WS)

LOCATION: I-71 NB EXIT RAMP TO SR-435 (RAMP WS)
 CURRENT ADT (2024): 4,570
 DESIGN YEAR ADT (2044): 5,250
 DESIGN HOURLY VOLUME: 590
 DIRECTIONAL DISTRIBUTION: -
 TRUCKS: 29%
 DESIGN SPEED: REFER TO L&D VOLUME 1 SECTION 503.2
 LEGAL SPEED:
 DESIGN FUNCTIONAL CLASSIFICATION: 01 – INTERSTATE (RURAL)
 NHS: YES

DESIGN DESIGNATION – SR-435 TO I-71 SB ENTRANCE RAMP (RAMP NW)

LOCATION: SR-435 TO I-71 SB ENTRANCE RAMP (RAMP NW)
 CURRENT ADT (2024): 4,040
 DESIGN YEAR ADT (2044): 4,350
 DESIGN HOURLY VOLUME: 760
 DIRECTIONAL DISTRIBUTION: -
 TRUCKS: 26%
 DESIGN SPEED: REFER TO L&D VOLUME 1 SECTION 503.2
 LEGAL SPEED:
 DESIGN FUNCTIONAL CLASSIFICATION: 01 – INTERSTATE (RURAL)
 NHS: YES

DESIGN DESIGNATION – SR-729

LOCATION: SR-729
 CURRENT ADT (2024): 1,190
 DESIGN YEAR ADT (2044): 3,090
 DESIGN HOURLY VOLUME: 290
 DIRECTIONAL DISTRIBUTION: 63%
 TRUCKS: 16%
 DESIGN SPEED: 60 MPH
 LEGAL SPEED: 55 MPH
 DESIGN FUNCTIONAL CLASSIFICATION: 05 – MAJOR COLLECTOR (RURAL)
 NHS: NO

DESIGN DESIGNATION – BLUEGRASS BLVD

LOCATION: BLUEGRASS BLVD
 CURRENT ADT (2024): 8,280
 DESIGN YEAR ADT (2044): 16,370
 DESIGN HOURLY VOLUME: 2,380
 DIRECTIONAL DISTRIBUTION: 73%
 TRUCKS: 5%
 DESIGN SPEED: 60 MPH
 LEGAL SPEED: 55 MPH
 DESIGN FUNCTIONAL CLASSIFICATION: 07 – LOCAL ROAD (RURAL)
 NHS: NO

DESIGN DESIGNATIONS

FAY-435-1.52

MODEL: Sheet_SurvFI_PAPER SIZE: 17x11 (in.) DATE: 3/25/2024 TIME: 3:33:24 PM USER: dianf pvc:\pwwork\04\pwwork\pale.palmer.com\Palmer_Engineering\Documents\Ohio\000\17955\400-Engineering\Roadway\Sheets\BU-5\17955_GT002.dgn

DESIGN AGENCY



DESIGNER

DPF

REVIEWER

DCJ MM-DD-YY

PROJECT ID


117955

SHEET TOTAL

P. 2 | 228

I-71 SB EXIT RAMP TO SR-435 (RAMP EN)
 CURVE DATA
 P.I. = STA. 3+58.14
 $\Delta = 25^{\circ}25'59''$ RT
 $D_c = 11^{\circ}00'00''$
 $R = 520.87'$
 $T = 117.54'$
 $L = 231.21'$
 $E = 13.1'$
 SPIRAL DATA
 P.I. = STA. 8+63.52
 $L_s = 200.00'$
 $O_s = 03^{\circ}00'00''$
 $LT = 133.35'$
 $ST = 66.68'$
 $x = 199.95'$
 $y = 3.49'$
 $k = 99.99'$
 $p = 0.87'$
 $C = 199.98'$
 Start = Sta. 7+30.17
 End = Sta. 9+30.17
 C.B. = $N74^{\circ}51'55''E$

SR-435 TO I-71 SB ENTRANCE RAMP (RAMP NW)
 CURVE DATA
 P.I. = STA. 18+60.45
 $\Delta = 07^{\circ}44'11''$ LT
 $D_c = 06^{\circ}00'00''$
 $R = 954.93'$
 $T = 64.57'$
 $L = 128.94'$
 $E = 2.18'$
 SPIRAL DATA
 P.I. = STA. 17+29.29
 $L_s = 200.00'$
 $O_s = 06^{\circ}00'00''$
 $LT = 133.41'$
 $ST = 66.74'$
 $x = 199.78'$
 $y = 6.98'$
 $k = 99.96'$
 $p = 1.74'$
 $C = 199.90'$
 Start = Sta. 15+95.88
 End = Sta. 17+95.88
 C.B. = $N51^{\circ}50'07''E$

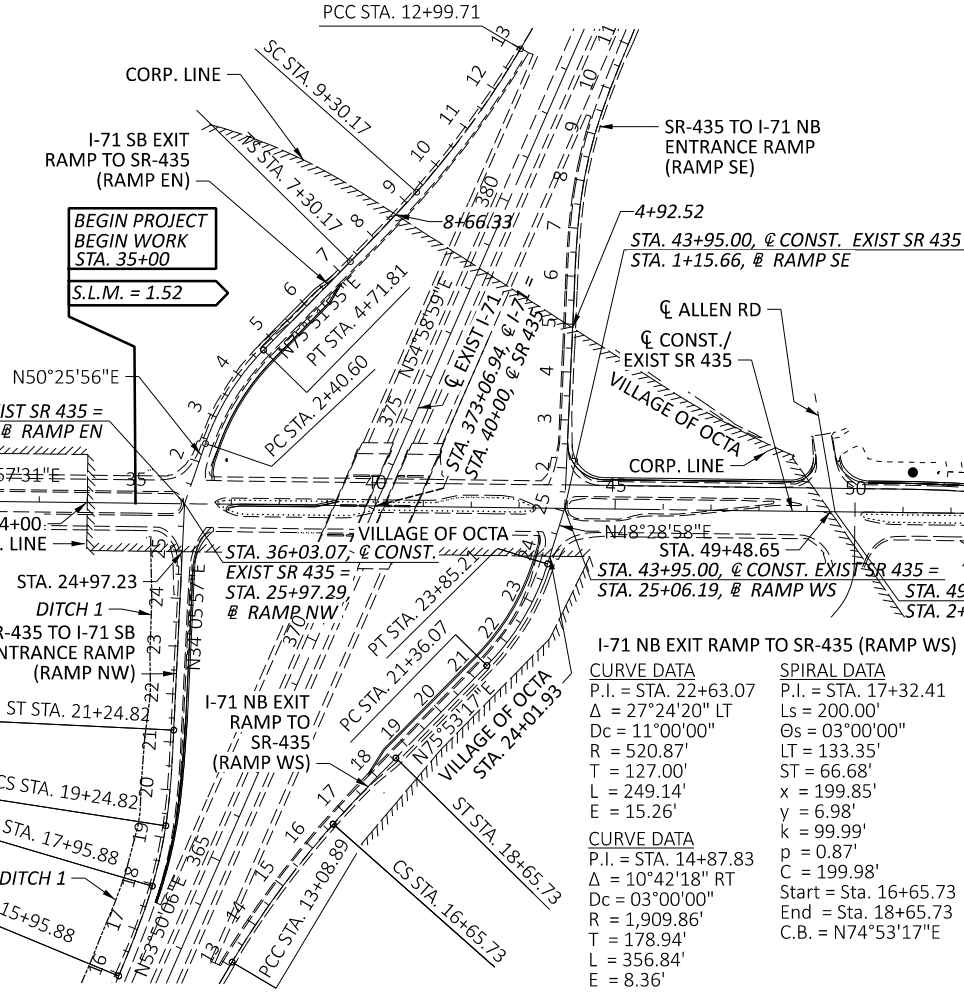

CONST./EXIST SR 435
 CURVE DATA
 P.I. = STA. 55+02.22
 $\Delta = 01^{\circ}25'00''$ LT
 $D_c = 00^{\circ}16'00''$
 $R = 21,485.94'$
 $T = 265.64'$
 $L = 531.25'$
 $E = 1.64'$

I-71 NB EXIT RAMP TO SR-435 (RAMP WS)
 CURVE DATA
 P.I. = STA. 22+63.07
 $\Delta = 27^{\circ}24'20''$ LT
 $D_c = 11^{\circ}00'00''$
 $R = 520.87'$
 $T = 127.00'$
 $L = 249.14'$
 $E = 15.26'$
 SPIRAL DATA
 P.I. = STA. 17+32.41
 $L_s = 200.00'$
 $O_s = 03^{\circ}00'00''$
 $LT = 133.35'$
 $ST = 66.68'$
 $x = 199.85'$
 $y = 6.98'$
 $k = 99.99'$
 $p = 0.87'$
 $C = 199.98'$
 Start = Sta. 16+65.73
 End = Sta. 18+65.73
 C.B. = $N74^{\circ}53'17''E$

PARTICIPATION	
FUND	LOCATION
01/SAF/21	I-71 RAMP EN/RAMP WS/RAMP NW; US 35 RAMP D
02/SAF/21	SR 435/ROUNDAABOUT/BLUEGRASS/SR729


US-35 WB ENTRANCE RAMP TO SR-435 (RAMP C)
 CURVE DATA
 P.I. = STA. 227+20.87
 $\Delta = 19^{\circ}21'51''$ RT
 $D_c = 06^{\circ}45'00''$
 $R = 848.83'$
 $T = 144.82'$
 $L = 286.88'$
 $E = 12.27'$

PROJECT CONTROL POINTS

CONTROL POINT	NORTHING (GROUND)	EASTING (GROUND)	NORTHING (GRID)	EASTING (GRID)	ELEV	DESC	ALIGNMENT	STATION	OFFSET
100	589060.598	1661179.587	589000.873	1661011.160	1057.826	CNPT	CL EX. SR 435 EAST	93+50.16	35.424 LT
101	589227.624	1660770.483	589167.882	1660602.097	1058.615	CNPT	CL EX. SR 435 EAST	89+13.03	29.249 RT
102	591593.362	1657195.501	591533.380	1657027.478	1062.200	IPINS	CL EX. SR 435 WEST	46+28.56	126.827 LT
103	591770.163	1656878.193	591710.163	1656710.202	1055.282	IPINS	CL EX. SR 435 WEST	42+65.79	108.354 LT
104	591527.048	1657208.523	591467.073	1657040.499	1052.667	IPINS	CL EX. SR 435 WEST	46+74.78	77.523 LT
105	591011.712	1657962.657	590951.789	1657794.556	1057.412	IPINS	CL EX. SR 435 WEST	55+88.08	37.911 LT
106	587860.255	1664814.690	587800.652	1664645.894	1042.538	IPINS	CL EX. SR 435 EAST	132+41.19	19.8 LT
107	587750.060	1665287.998	587690.468	1665119.154	1043.693	IPINS	CL EX. SR 435 EAST	137+27.16	19.544 LT
108	592043.049	1656226.559	591983.022	1656058.634	1050.967	IPINS	CL EX. SR 435 WEST	35+68.65	6.042 RT
109	591734.331	1656733.798	591674.335	1656565.822	1053.921	CUT	CL EX. SR 435 WEST	41+62.41	1.374 LT
110	591819.274	1656582.369	591759.269	1656414.408	1053.016	CUT	CL EX. SR 435 WEST	39+88.98	6.96 RT
111	591875.533	1656482.875	591815.523	1656314.924	1052.677	CUT	CL EX. SR 435 WEST	38+74.80	12.056 RT
112	589720.142	1659871.972	589660.350	1659703.678	1060.310	MAGS	CL EX. SR 435 EAST	78+88.81	75.137 RT
113	589934.807	1659829.666	589874.994	1659661.376	1060.872	MAGS	CL EX. SR 435 EAST	77+43.06	88.036 LT
114	588716.808	1661757.924	588657.118	1661589.438	1051.835	IPID	CL EX. SR 435 EAST	100+23.09	34.174 LT
115	588621.386	1661814.142	588561.706	1661645.651	1052.643	MAGS	CL EX. SR 435 EAST	101+19.17	21.304 RT


PROJECT BENCHMARKS

BM	NORTHING (GROUND)	EASTING (GROUND)	NORTHING (GRID)	EASTING (GRID)	ELEV	DESC	ALIGNMENT	STATION	OFFSET
44217	591805.548	1656899.944	591745.545	1656731.951	1056.868	X-NOTCH IN CONC. BASE OF LIGHT POLE	CL EX. SR 435 WEST	42+65.46	149.9 LT
44218	589492.600	1660734.726	589432.831	1660566.344	1057.766	X-NOTCH ON CONC. PAD	CL EX. SR 435 EAST	87+47.28	180.6 LT
44223	589194.015	1660806.208	589134.277	1660637.819	1059.161	SPIKE IN POWER POLE	CL EX. SR 435 EAST	89+60.89	39.97 RT
44228	591352.006	1657508.258	591292.049	1657340.203	1057.081	X-NOTCH ON CONC. PAD	CL EX. SR 435 WEST	50+21.72	88.17 LT
45100	588528.210	1662146.140	588468.539	1661977.615	1049.862	ARROW BOLT ON FH	CL EX. SR 435 EAST	104+60.40	35.05 LT
46786	588688.868	1662621.578	588629.181	1662453.005	1048.534	X-NOTCH ON TOP OF HEADWALL	CL EX. SR 435 EAST	108+93.99	330.8 LT
48608	592018.586	1656552.286	591958.561	1656384.328	1051.464	X-NOTCH IN CONC. BASE OF LIGHT POLE	CL EX. SR 435 WEST	38+57.74	146 LT

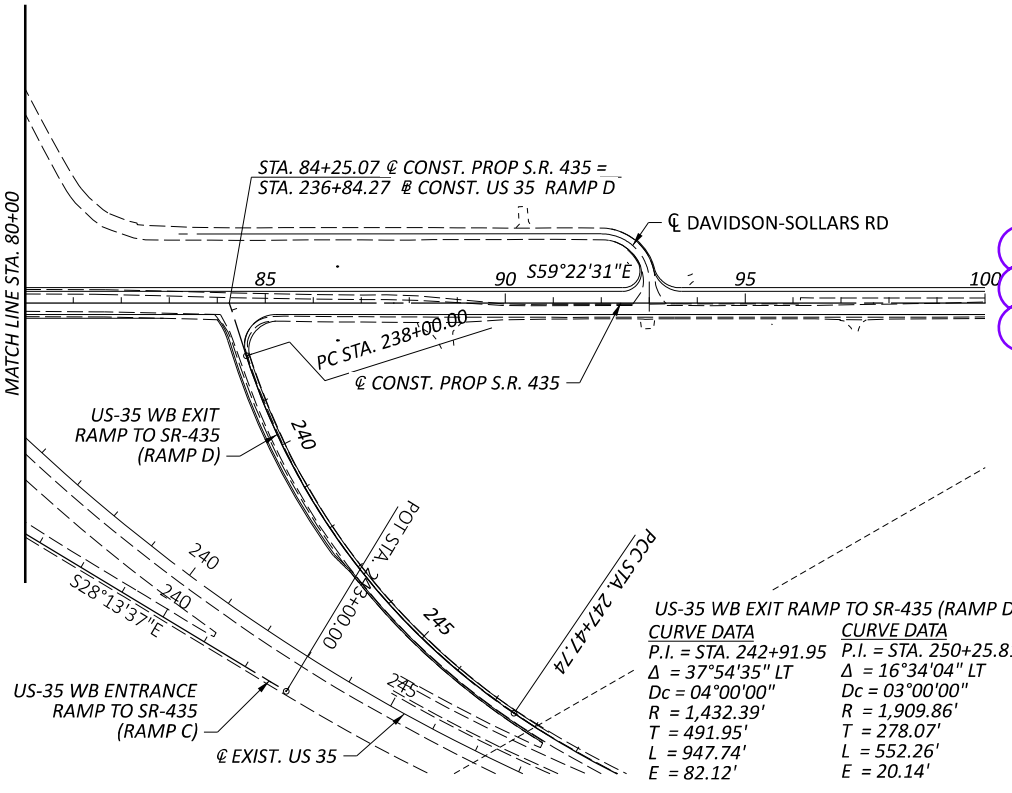

US-35 WB EXIT RAMP TO SR-435 (RAMP D)
 CURVE DATA
 P.I. = STA. 242+91.95
 $\Delta = 37^{\circ}54'35''$ LT
 $D_c = 04^{\circ}00'00''$
 $R = 1,432.39'$
 $T = 491.95'$
 $L = 947.74'$
 $E = 82.12'$

US-35 WB ENTRANCE RAMP TO SR-435 (RAMP C)
 CURVE DATA
 P.I. = STA. 250+25.81
 $\Delta = 16^{\circ}34'04''$ LT
 $D_c = 03^{\circ}00'00''$
 $R = 1,909.86'$
 $T = 278.07'$
 $L = 552.26'$
 $E = 20.14'$

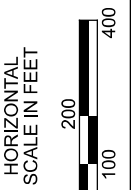


SCHEMATIC PLAN - SR 435 (BU-5)


DESIGN AGENCY
Palmer ENGINEERING
 8350 E. KEMPER RD.
 SUITE B
 CINCINNATI, OH 45249
 513-469-1600
 DESIGNER
 DPF
 REVIEWER
 DCJ MM-DD-YY
 PROJECT ID
 117955
 SHEET TOTAL
 P. 3 | 228

text scale is off

END PROJECT
END WORK
STA. 119+75
S.L.M. = 2.62

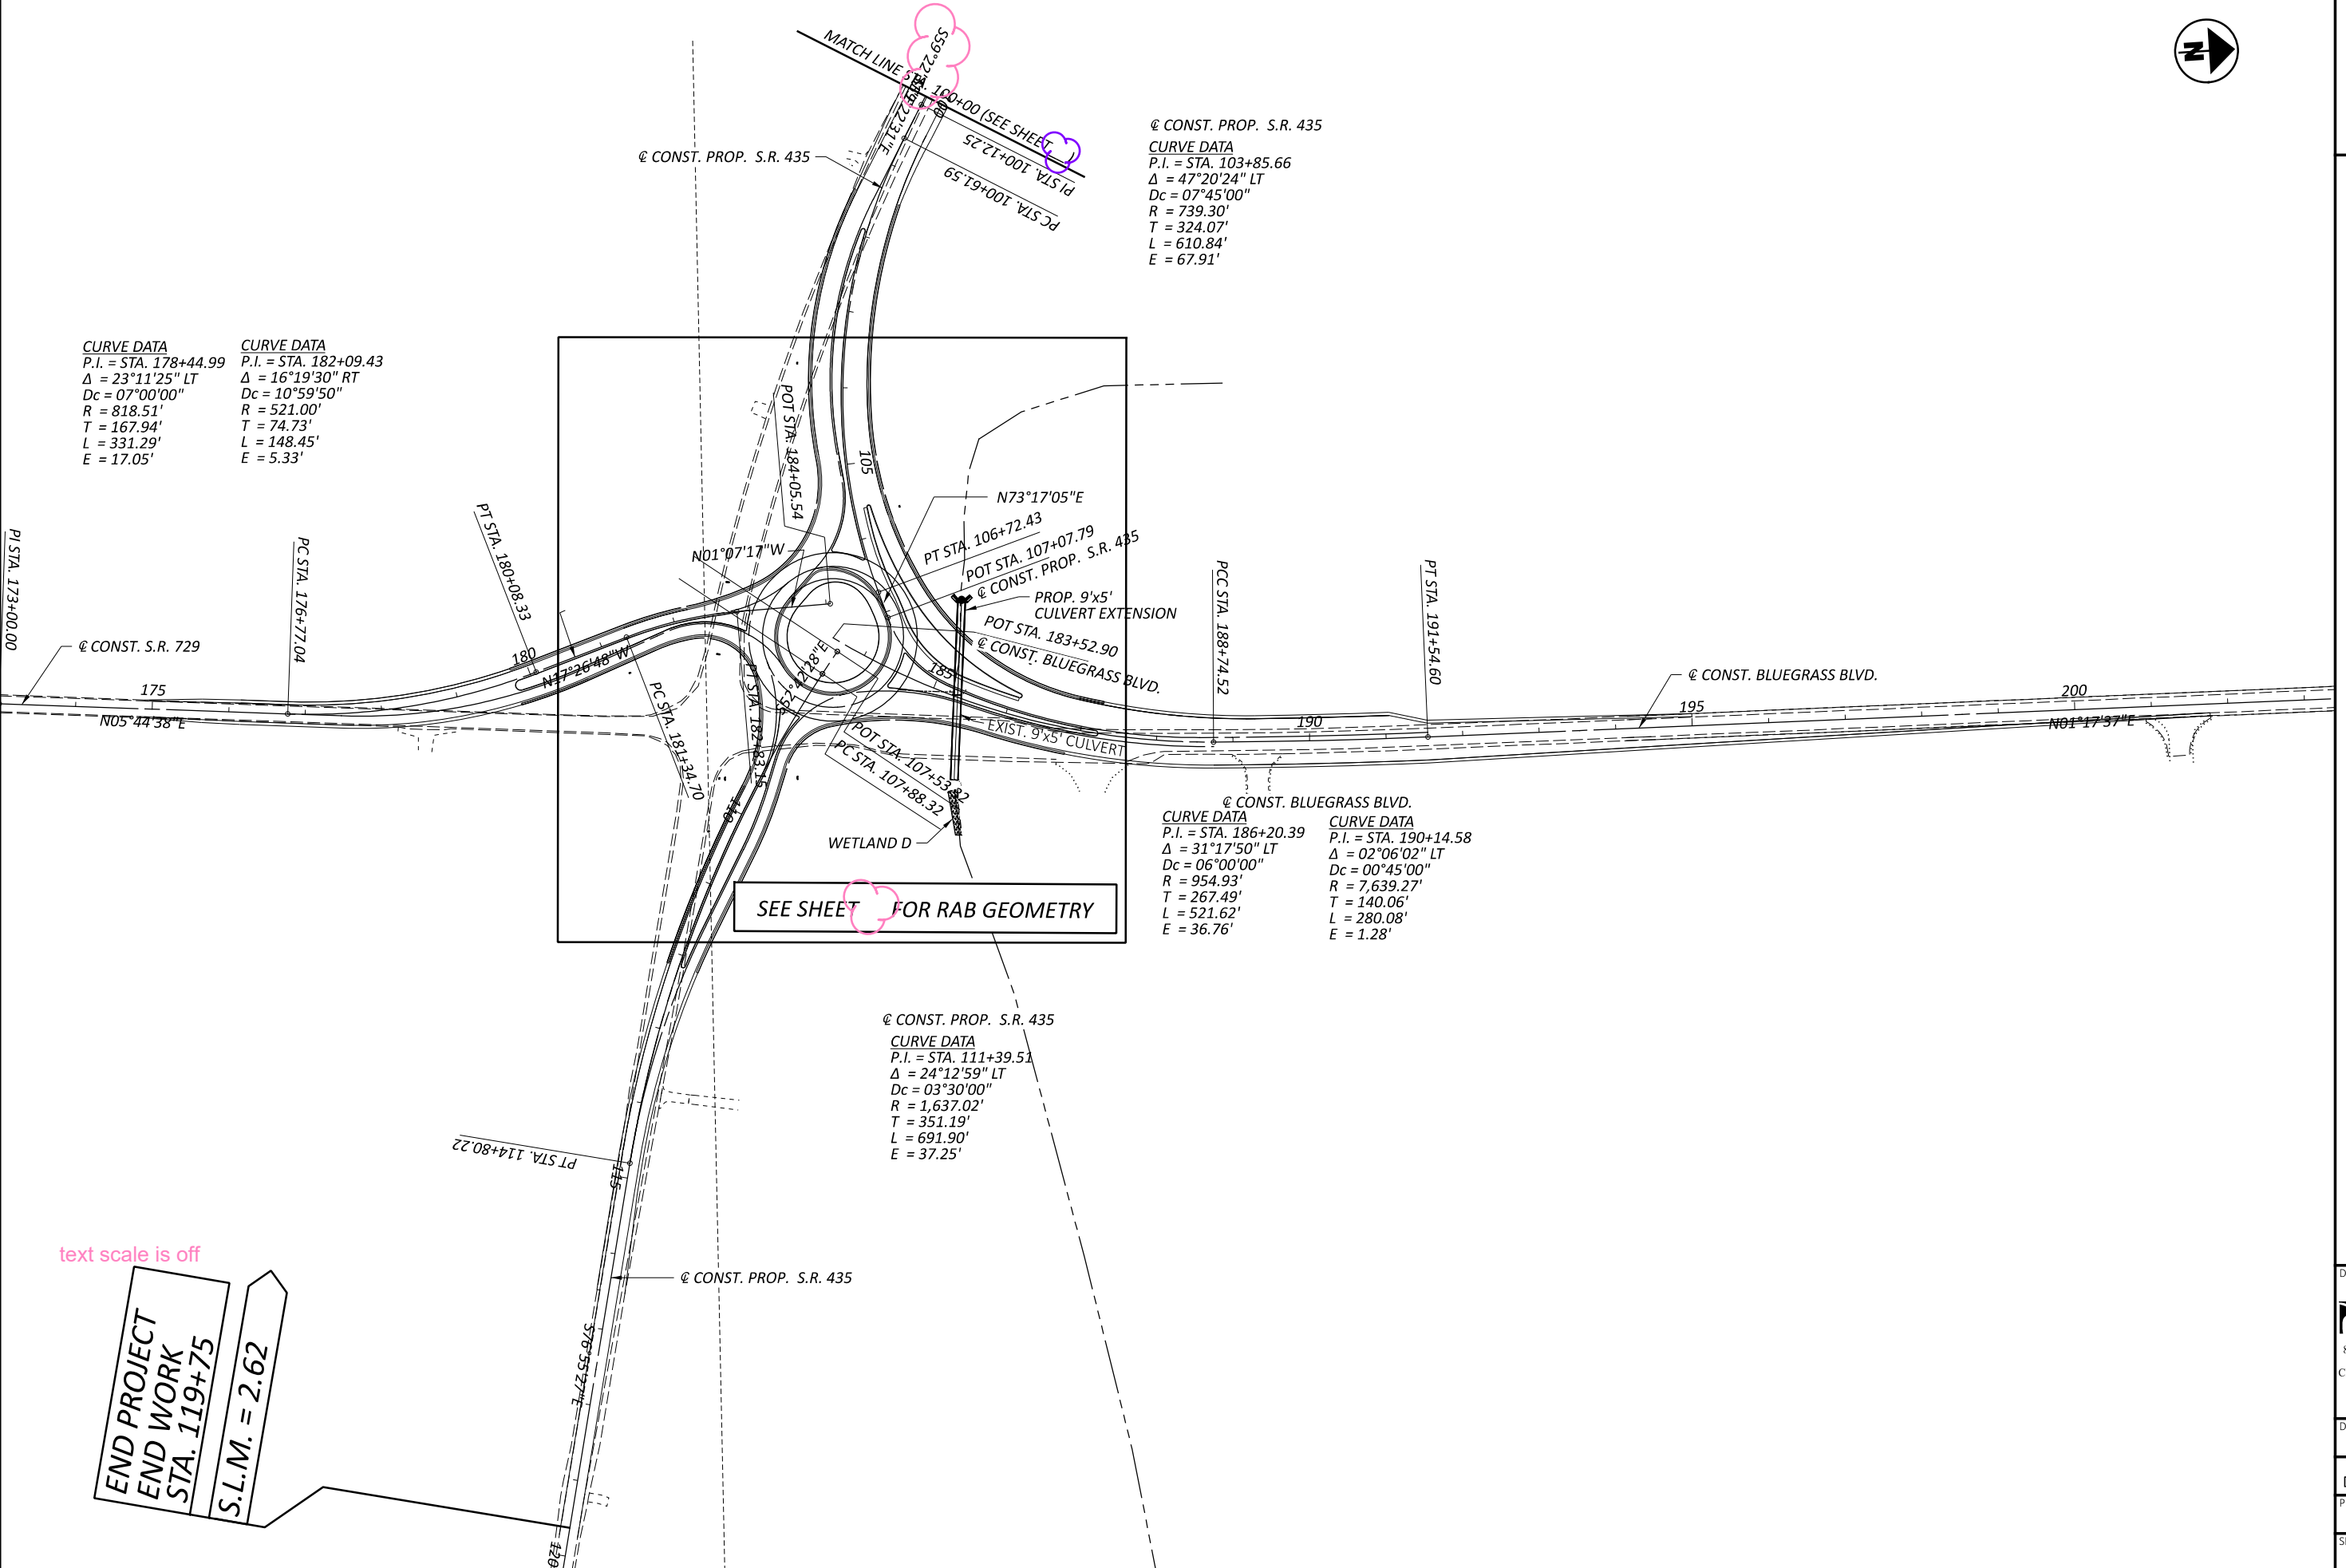

SEE SHEET FOR RAB GEOMETRY

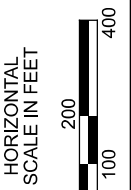

SCHEMATIC PLAN - SR729\BLUEGRASS (BU-5)

DESIGN AGENCY

Palmer
ENGINEERING
8350 E. KEMPER RD.
SUITE B
CINCINNATI, OH 45249
513-469-1600

DESIGNER
DPF

REVIEWER
DCJ MM-DD-YY


PROJECT ID
117955

SHEET TOTAL
P. 4 | 228

MODEL: Sheet RAB Geometry PAPER: 17x11 (in.) DATE: 3/25/2024 TIME: 3:33:47 PM USER: dan-f
 pw:\pewinp04.pewin,private.palmernet.com:Palmer_Engineering\Documents\Ohio\ODOT\06\FAY\17955\400-Engineering\Roadway\Sheets\BU-5\17955_GB001_BUS.dgn

REF. LINE	P.I. STATION	P.I. NORTHING	P.I. EASTING	Dc	Δ	T (FT.)	L (FT.)	R (FT.)	BEGIN CURVE	END CURVE
BL CONST. BLUEGRASS RAB APPROACH	384+63.30	588639.598	1662468.313	38.197°	26.253°	64.063	121.091	150	383+99.24	385+20.33
BL CONST. BLUEGRASS RAB APPROACH	386+91.12	588847.325	1662577.87	7.216°	24.278°	170.784	336.442	794	385+20.33	388+56.77
BL CONST. BLUEGRASS RAB APPROACH	390+05.75	589166.482	1662597.558	0.751°	2.236°	148.979	297.921	7633.274	388+56.77	391+54.69
CL CONST. BLUEGRASS BLVD.	186+20.39	588768.428	1662579.628	6.000°	31.297°	267.494	521.619	954.93	183+52.90	188+74.52
CL CONST. BLUEGRASS BLVD.	190+14.58	589175.266	1662603.756	0.750°	2.101°	140.058	280.085	7639.274	188+74.52	191+54.60
BL CONST. BLUEGRASS RAB DEPARTURE	284+65.93	588638.833	1662493.658	17.629°	28.730°	83.234	162.965	325	283+82.70	285+45.67
BL CONST. BLUEGRASS RAB DEPARTURE	287+12.32	588868.735	1662591.584	5.963°	9.678°	166.656	330.029	960.93	285+45.67	288+75.69

Format as Degrees, Minutes, Seconds (typ.)

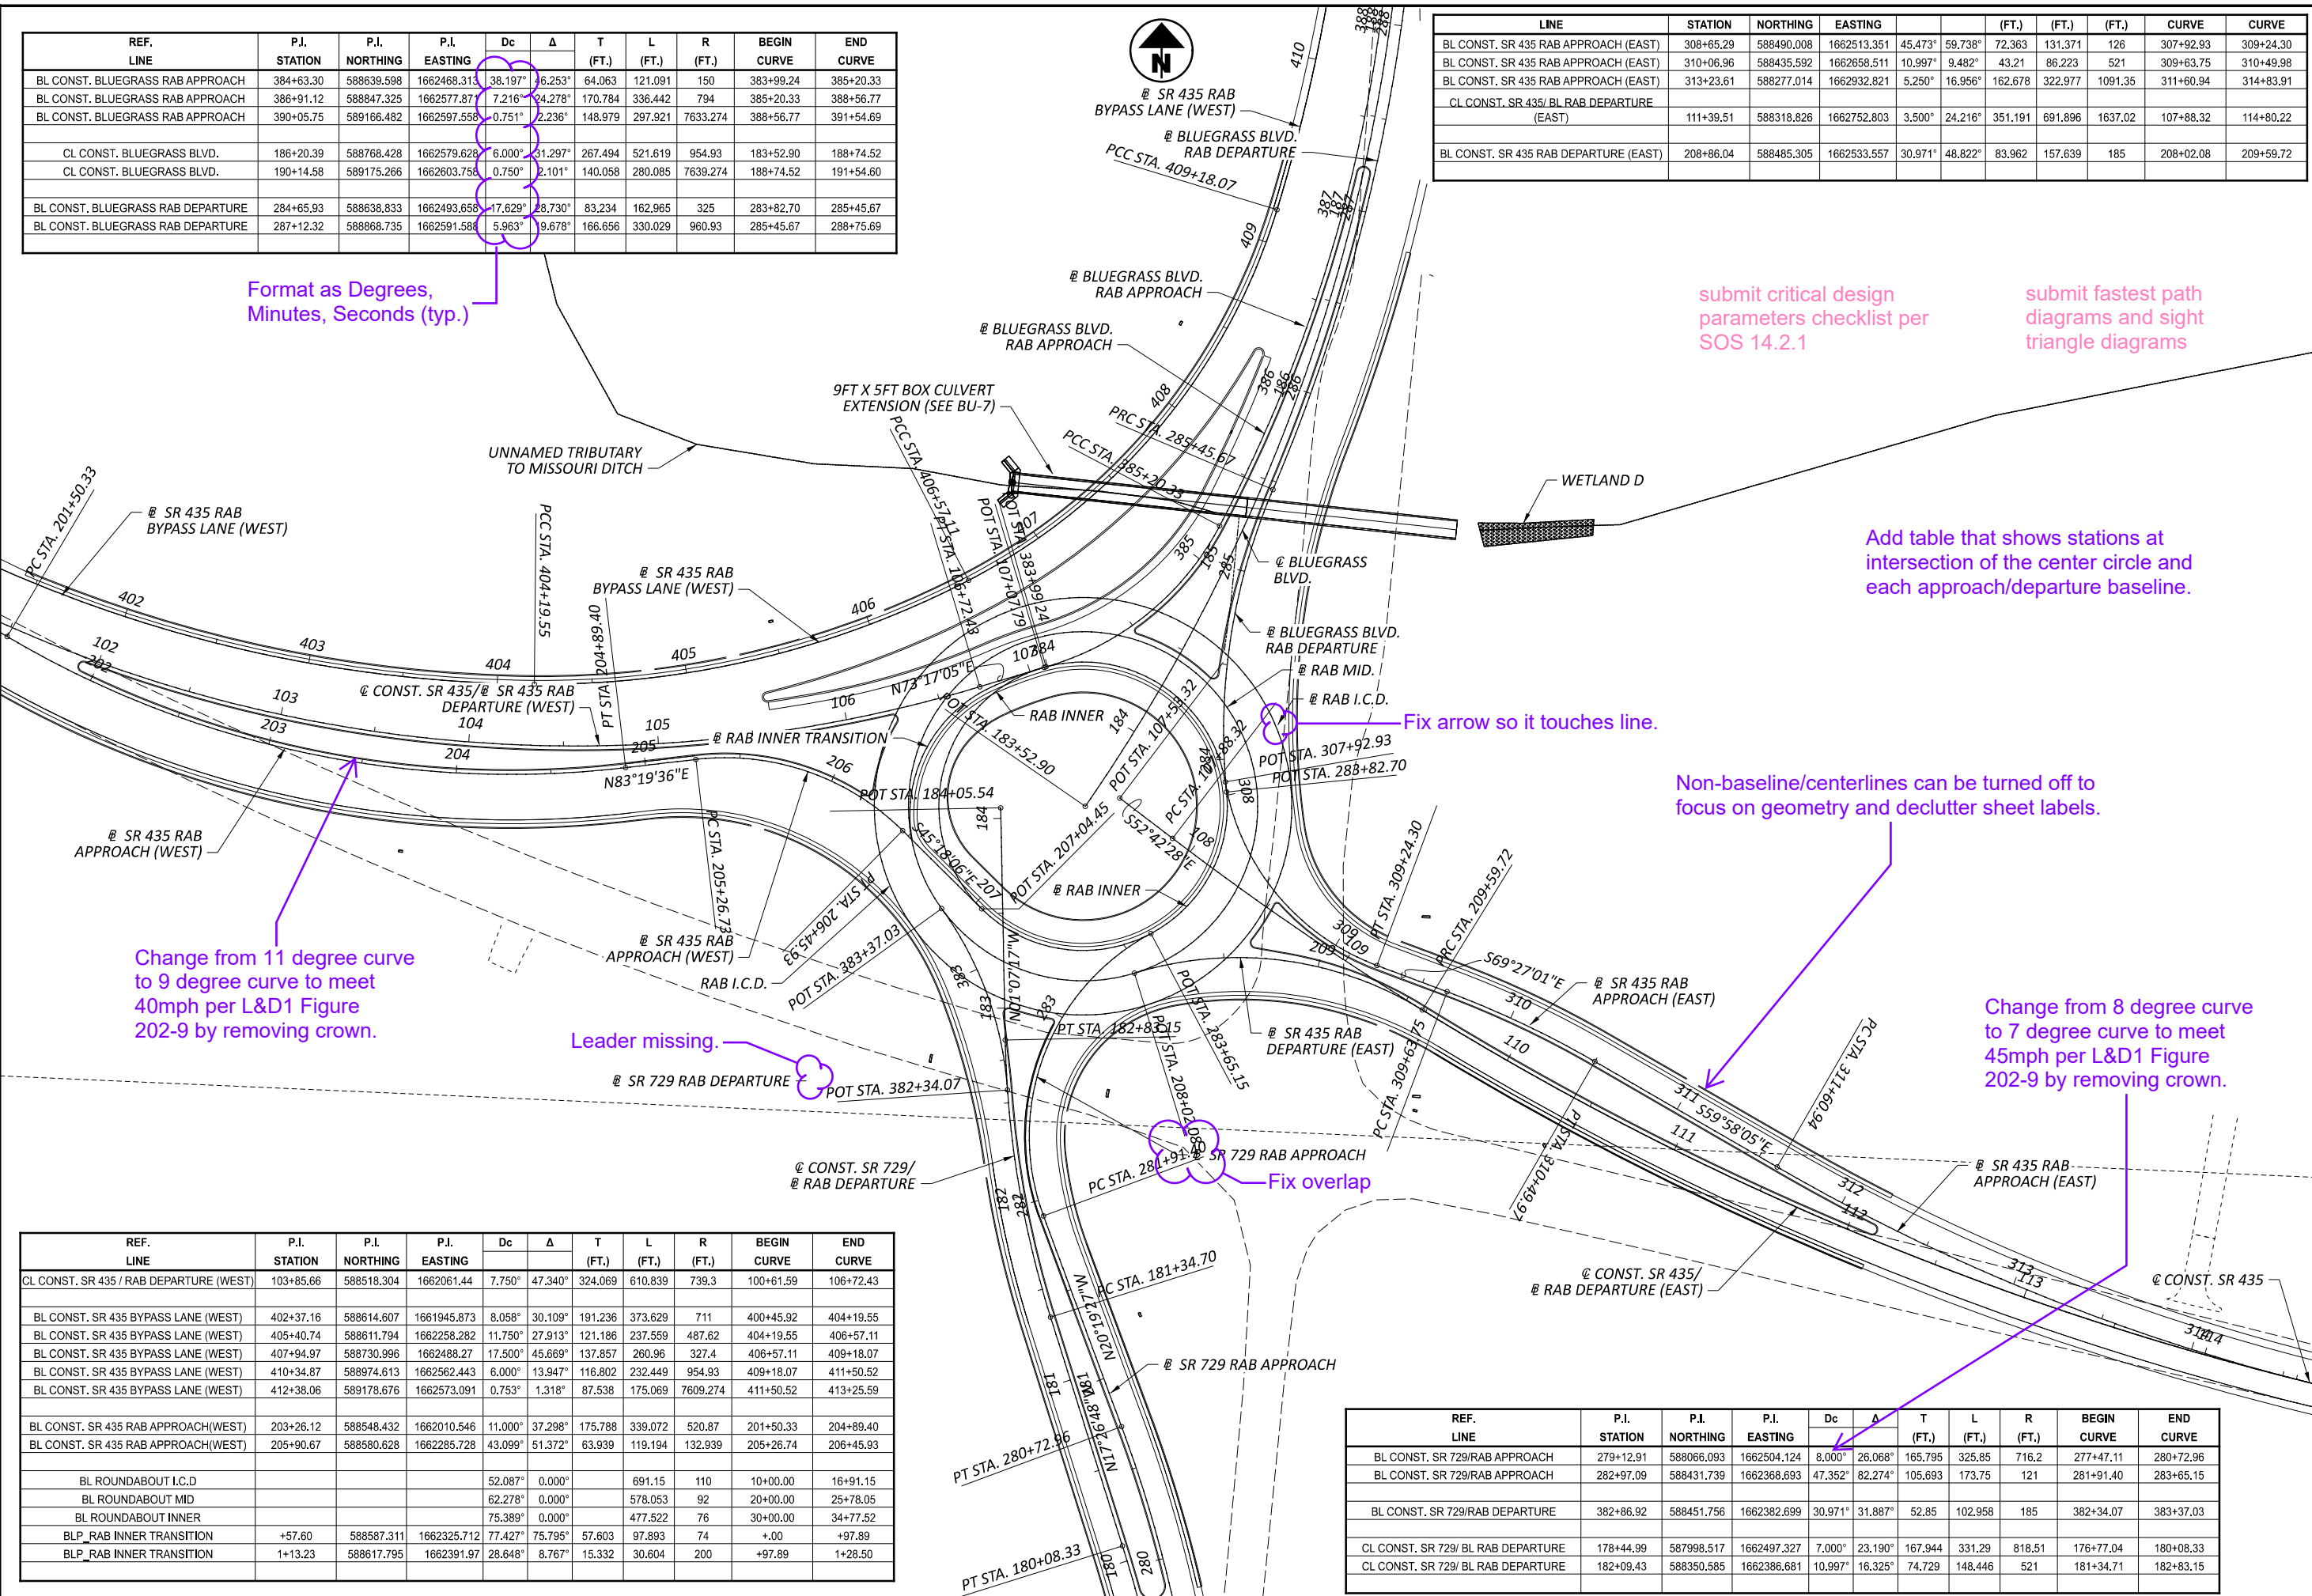

REF. LINE	P.I. STATION	P.I. NORTHING	P.I. EASTING	Dc	Δ	T (FT.)	L (FT.)	R (FT.)	BEGIN CURVE	END CURVE
CL CONST. SR 435 / RAB DEPARTURE (WEST)	103+85.66	588518.304	1662061.44	7.750°	47.340°	324.069	610.839	739.3	100+61.59	106+72.43
BL CONST. SR 435 BYPASS LANE (WEST)	402+37.16	588614.607	1661945.873	8.058°	30.109°	191.236	373.629	711	400+45.92	404+19.55
BL CONST. SR 435 BYPASS LANE (WEST)	405+40.74	588611.794	1662258.282	11.750°	27.913°	121.186	237.559	487.62	404+19.55	406+57.11
BL CONST. SR 435 BYPASS LANE (WEST)	407+94.97	588730.996	1662488.27	17.500°	45.669°	137.857	260.96	327.4	406+57.11	409+18.07
BL CONST. SR 435 BYPASS LANE (WEST)	410+34.87	588974.613	1662562.443	6.000°	13.947°	116.802	232.449	954.93	409+18.07	411+50.52
BL CONST. SR 435 BYPASS LANE (WEST)	412+38.06	589178.676	1662573.091	0.753°	1.318°	87.538	175.069	7609.274	411+50.52	413+25.59
BL CONST. SR 435 RAB APPROACH (WEST)	203+26.12	588548.432	1662010.546	11.000°	37.298°	175.788	339.072	520.87	201+50.33	204+89.40
BL CONST. SR 435 RAB APPROACH (WEST)	205+90.67	588580.628	1662285.728	43.099°	51.372°	63.939	119.194	132.939	205+26.74	206+45.93
BL ROUNDABOUT I.C.D.				52.087°	0.000°		691.15	110	10+00.00	16+91.15
BL ROUNDABOUT MID				62.278°	0.000°		578.053	92	20+00.00	25+78.05
BL ROUNDABOUT INNER				75.389°	0.000°		477.522	76	30+00.00	34+77.52
BLP RAB INNER TRANSITION	+57.60	588587.311	1662325.712	77.427°	75.795°	57.603	97.893	74	+00	+97.89
BLP RAB INNER TRANSITION	1+13.23	588617.795	1662391.97	28.648°	8.767°	15.332	30.604	200	+97.89	1+28.50

REF. LINE	P.I. STATION	P.I. NORTHING	P.I. EASTING	Dc	Δ	T (FT.)	L (FT.)	R (FT.)	BEGIN CURVE	END CURVE
BL CONST. SR 729/RAB APPROACH	279+12.91	588066.093	1662504.124	8.000°	26.068°	165.795	325.85	716.2	277+47.11	280+72.96
BL CONST. SR 729/RAB APPROACH	282+97.09	588431.739	1662368.693	47.352°	82.274°	105.693	173.75	121	281+91.40	283+65.15
BL CONST. SR 729/RAB DEPARTURE	382+86.92	588451.756	1662382.699	30.971°	31.887°	52.85	102.958	185	382+34.07	383+37.03
CL CONST. SR 729/ BL RAB DEPARTURE	178+44.99	587998.517	1662497.327	7.000°	23.190°	167.944	331.29	818.51	176+77.04	180+08.33
CL CONST. SR 729/ BL RAB DEPARTURE	182+09.43	588350.585	1662386.681	10.997°	16.325°	74.729	148.446	521	181+34.71	182+83.15

LINE	STATION	NORTHING	EASTING	(FT.)	(FT.)	(FT.)	CURVE	CURVE		
BL CONST. SR 435 RAB APPROACH (EAST)	308+65.29	588490.008	1662513.351	45.473°	59.738°	72.363	131.371	126	307+92.93	309+24.30
BL CONST. SR 435 RAB APPROACH (EAST)	310+06.96	588435.592	1662658.511	10.997°	9.482°	43.21	86.223	521	309+63.75	310+49.98
BL CONST. SR 435 RAB APPROACH (EAST)	313+23.61	588277.014	1662932.821	5.250°	16.956°	162.678	322.977	1091.35	311+60.94	314+83.91
CL CONST. SR 435/ BL RAB DEPARTURE (EAST)	111+39.51	588318.826	1662752.803	3.500°	24.216°	351.191	691.896	1637.02	107+88.32	114+80.22
BL CONST. SR 435 RAB DEPARTURE (EAST)	208+86.04	588485.305	1662533.557	30.971°	48.822°	83.962	157.639	185	208+02.08	209+59.72



ROUNDABOUT GEOMETRIC LAYOUT


DESIGN AGENCY
Palmer
 ENGINEERING
 8350 E. KEMPER RD.
 SUITE B
 CINCINNATI, OH 45249
 513-469-1600

DESIGNER
DPF


REVIEWER
DCJ MM-DD-YY

PROJECT ID
117955


SHEET TOTAL
P. 5 | 228

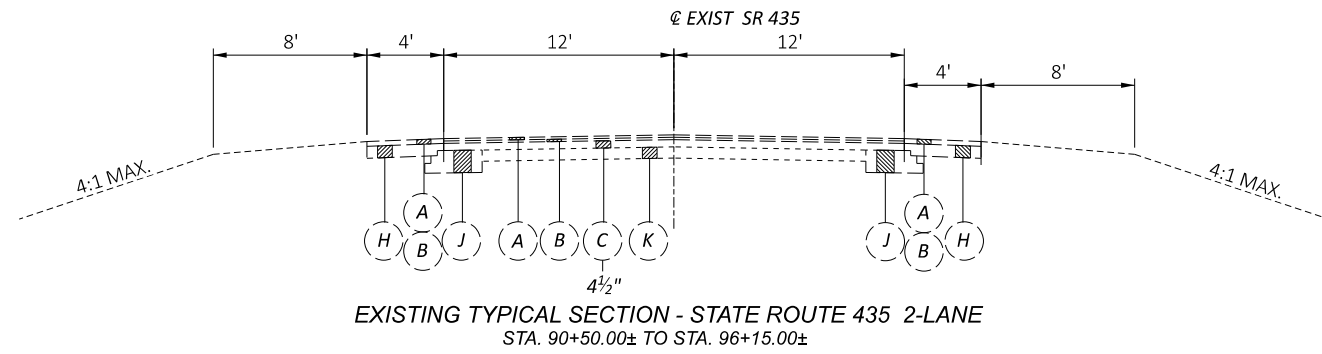


EXISTING TYPICAL SECTION - STATE ROUTE 435 2-LANE
STA. 90+50.00± TO STA. 96+15.00±

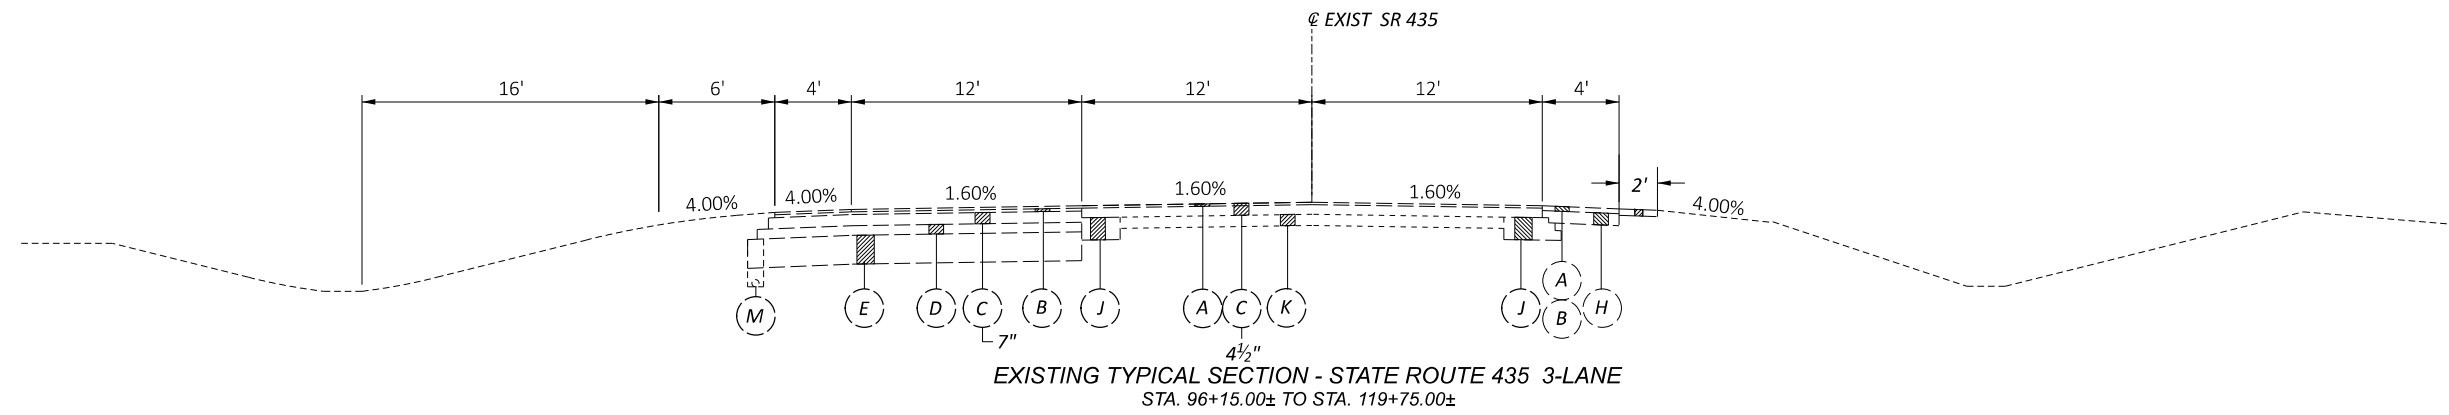

EXISTING TYPICAL SECTION - STATE ROUTE 435 3-LANE
STA. 96+15.00± TO STA. 119+75.00±

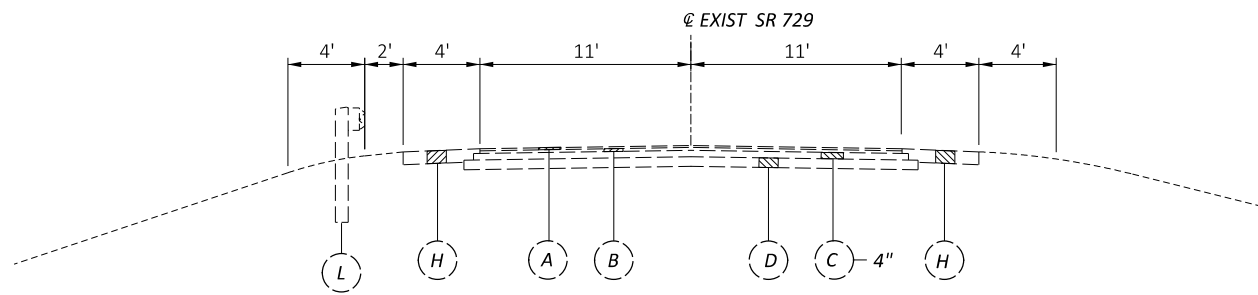

EXISTING TYPICAL SECTION - STATE ROUTE 729
STA. 175+25.00±

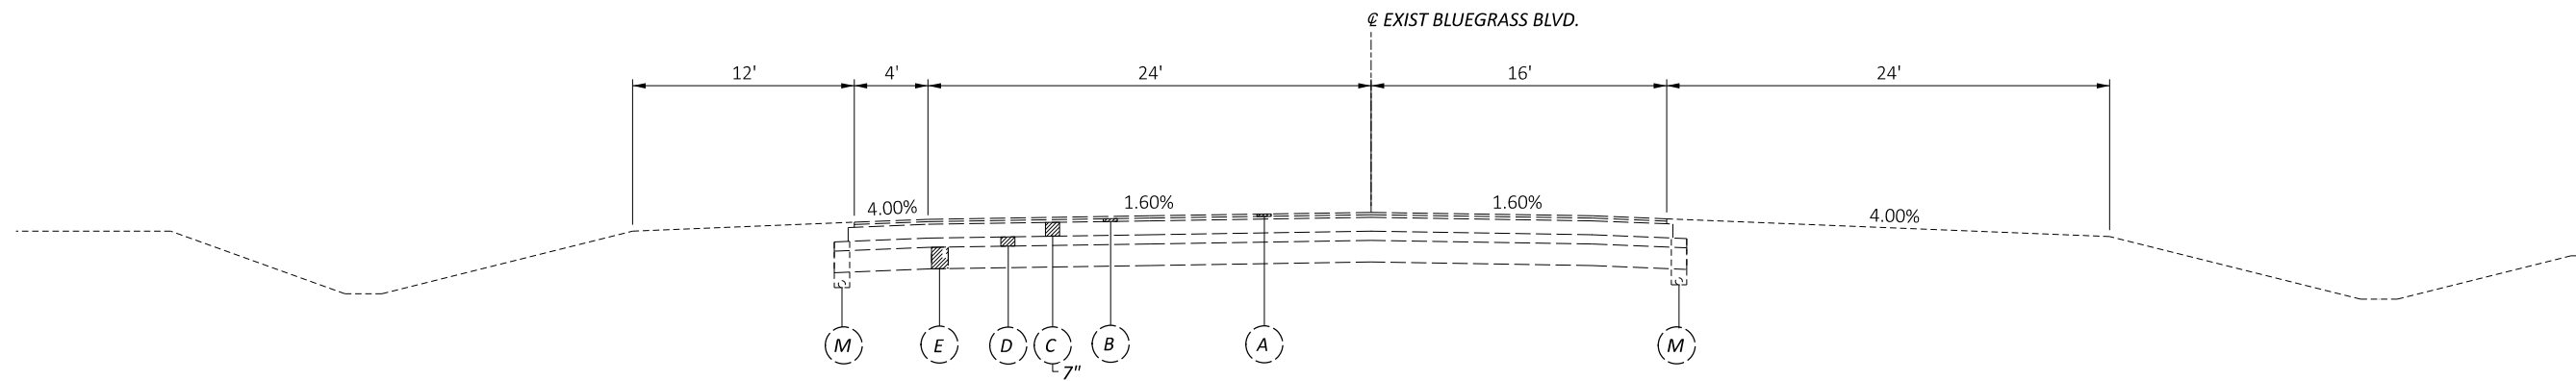

EXISTING TYPICAL SECTION - BLUEGRASS BOULEVARD
STA. 195+00.00±

DESIGN AGENCY

Palmer
ENGINEERING
8350 E. KEMPER RD.
SUITE B
CINCINNATI, OH 45249
513-469-1600

DESIGNER
DPF

REVIEWER
DCJ MM-DD-YY

PROJECT ID
117955


SHEET TOTAL
P. 7 | 228

The layers of the typical sections should be visible - adjust the vertical scale - applies to all typical sections.

According to the ODOT CMS - the depth of the underdrain needs to be indicated in the plan set. That depth is typically shown in the typical sections.

Specify the material if using a 6" pipe underdrain.


All underdrain outlet elevations need to be specified. If the underdrain outlets into a storm structure then the underdrain needs to be shown as a lateral into that structure. Underdrains which outlet to a slope should be provided an outlet per SCD DM-1.1 and the associated quantities need to be provided. See Pavement Design Manual, Section 205.1.3.

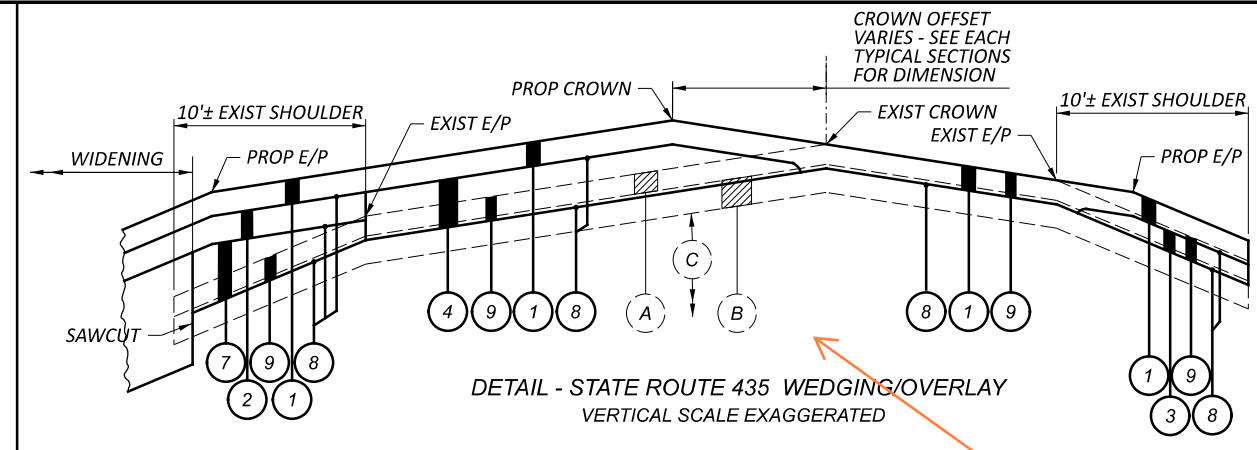

Variable depth milling with constant depth asphalt provides the ability to obtain better design. Recommend investigating. At a minimum, a butt joint would be better than a tapered end. See SCD BP-3.1

Provide a widening detail in the plans. This detail would require the stepped construction of a joint at the sawcut line. The widening joint should be treated in a manner similar to a phasing joint. See 2023 CMS, Section 401.08D. "Where phasing for maintenance of traffic will not allow lapping cold longitudinal joints per SCD BP3.1, provide a minimum of 6 inches offset between cold joints for each course placed."


See comment Sheet 9

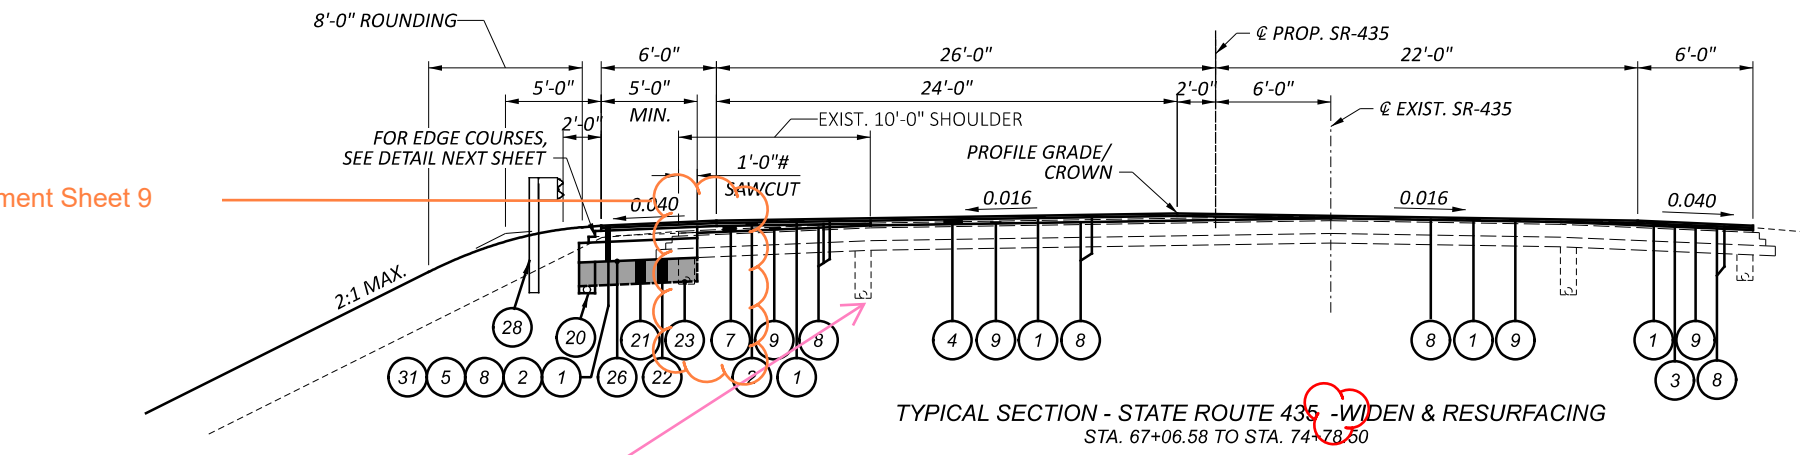

did we verify these will still outlet? or is our widening/embankment going to cover the ex. underdrain outlet pipes or did it tie to the old edge underdrain we are replacing?

line thickness is preventing layers from being visible

= 1'-0" MIN., OR UNTIL SOUND PAVEMENT IS REACHED

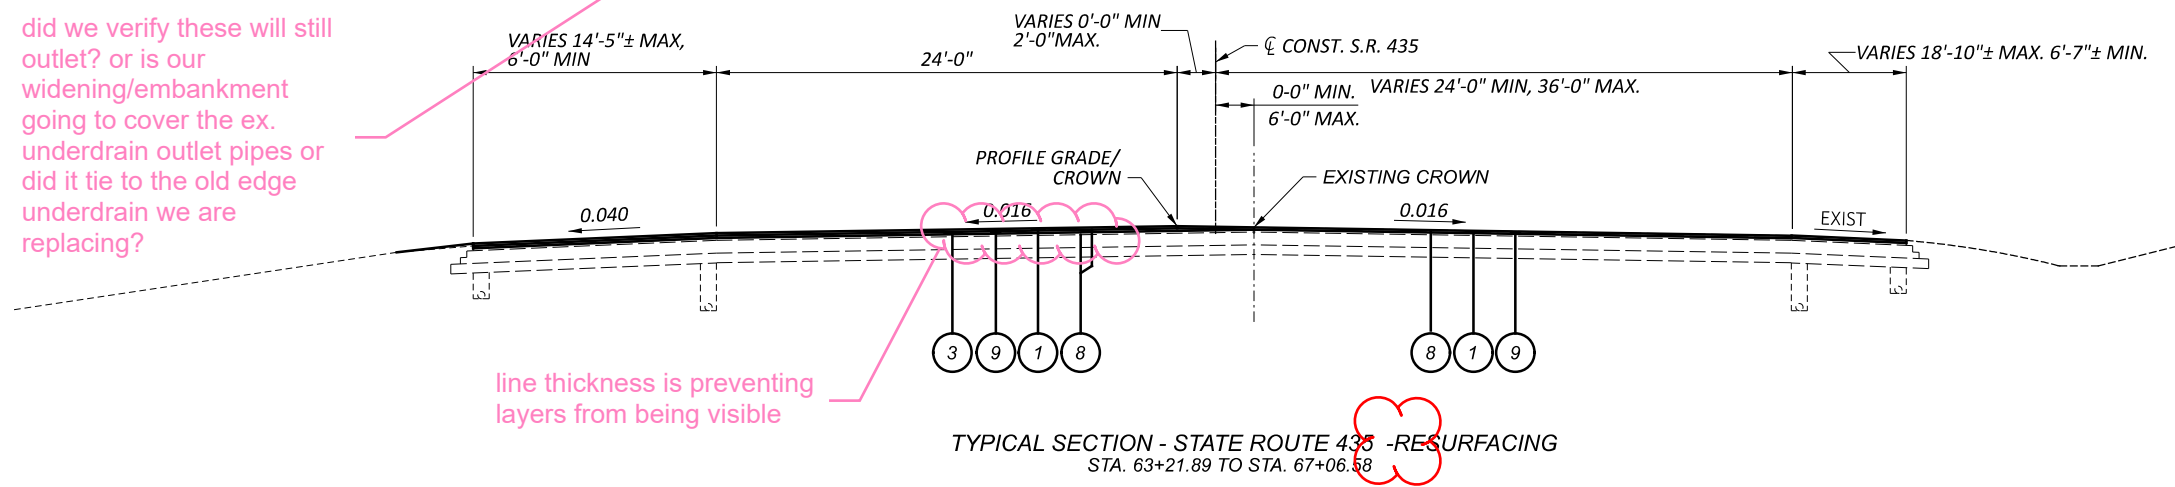

EXISTING ITEM LEGEND (SEE SHEET __)

PROPOSED ITEM LEGEND





1	ITEM 442 - 1/2" ASPHALT CONCRETE SURFACE COURSE, 12.5MM, TYPE A (446)	11	ITEM 451 - 7" REINFORCED CONCRETE PAVEMENT	21	ITEM 204 - EXCAVATION OF SUBGRADE, 12"	31	ITEM 304 - VARIABLE DEPTH AGGREGATE BASE (MATCH EXIST SUBGRADE ELEVATION)
2	ITEM 442 - 3/4" ASPHALT CONCRETE INTERMEDIATE COURSE, 12.5MM, TYPE A (449)	12	ITEM 304 - 6" AGGREGATE BASE	22	ITEM 204 - GRANULAR MATERIAL, TYPE B		
3	ITEM 442 - 0" MIN. - 2 1/2" MAX. ASPHALT CONCRETE INTERMEDIATE COURSE, 12.5MM, TYPE A (449)	13	ITEM 304 - 15" AGGREGATE BASE	23	ITEM 204 - GEOTEXTILE FABRIC		
4	ITEM 442 - 0" MIN. - 3 3/4" MAX. ASPHALT CONCRETE INTERMEDIATE COURSE, 19MM, TYPE A (449)	14	ITEM 304 - 4" AGGREGATE BASE	24	ITEM 206 - CEMENT STABILIZED SUBGRADE, 14"		
5	ITEM 301 - 7" ASPHALT CONCRETE BASE, PG64-22, (449) (2 - 3 1/2" LIFTS)	15	ITEM 609 - COMBINATION CURB & GUTTER, TYPE 3	25	ITEM 206 - CURING COAT		
6	ITEM 301 - 9" ASPHALT CONCRETE BASE, PG64-22, (449) (2 - 4 1/2" LIFTS)	16	ITEM 609 - COMBINATION CURB & GUTTER, TYPE 9	26	ITEM 204 - PROOF ROLLING		
7	ITEM 301 - 3 1/2" MIN. - " MAX. ASPHALT CONCRETE BASE, PG64-22, (449)	17	ITEM 609 - CURB, TYPE 4C	27	ITEM 659 - SEEDING & MULCHING		
8	ITEM 407 - NON-TRACKING TACK COAT (RATE PER CMS TABLE 407.06-1)	18	ITEM 609 - CURB, TYPE 10	28	ITEM 608 - GUARDRAIL, TYPE MGS		
9	ITEM 254 - PAVEMENT PLANING, ASPHALT (VARIABLE DEPTH, 1 1/2" TYPICAL)	19	ITEM 609 - 4" CONCRETE MEDIAN	29	ITEM 204 - SUBGRADE COMPACTION		
10	ITEM 452 - 10" NON-REINFORCED CONCRETE PAVEMENT, CLASS QC 1P	20	ITEM 605 - 6" BASE PIPE UNDERDRAIN	30	ITEM 203 - 6" NO. 2 AGGREGATE (CMS TABLE 703.01-1)		

■ SUBGRADE STABILIZATION LIMITS


The roundabout pavement meets the criteria of a high stress location. Per Pavement Design Manual, Appendix B. The PB Binder for the surface course needs to be increased to PG 76-22M.

Vertical widening joint is not allowed. See Pavement Design manual Section 403.1.1 for proper stepping of the phase line. (typical)

This is not the proper way to label layers on typical sections. Each layer of each item should be labeled. (typical)

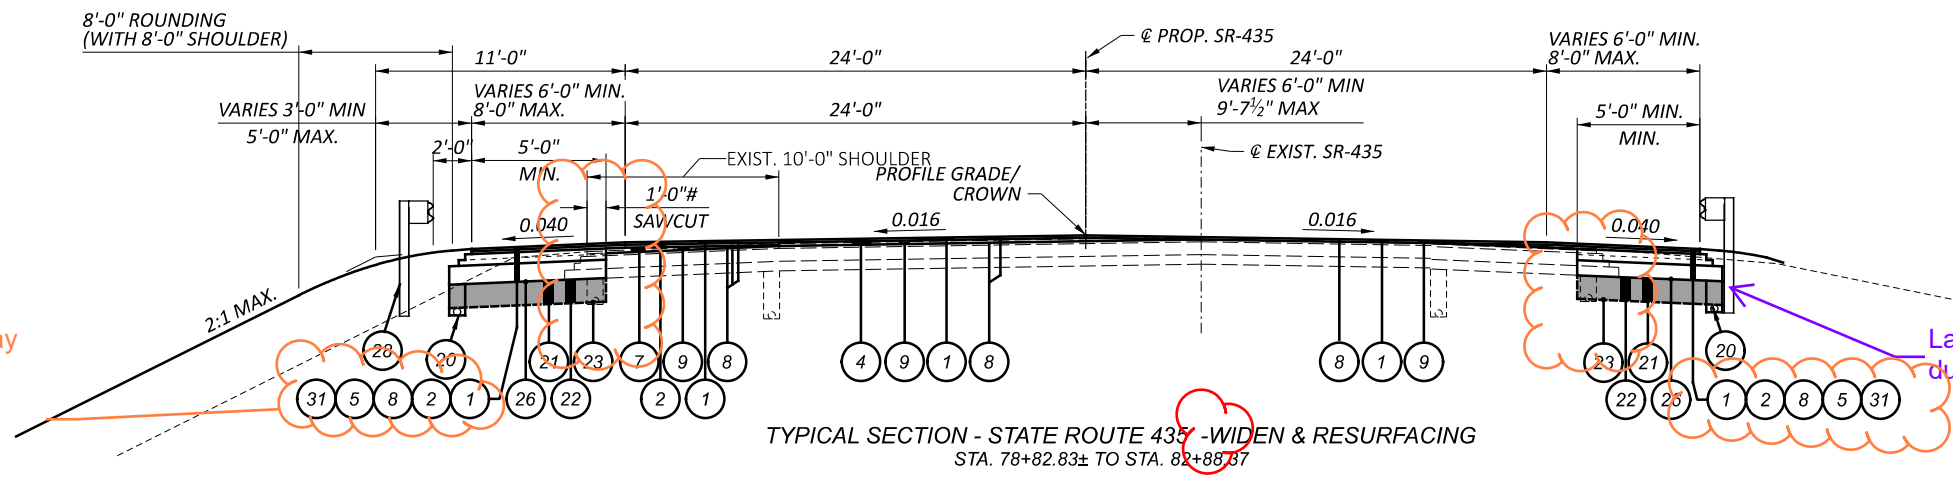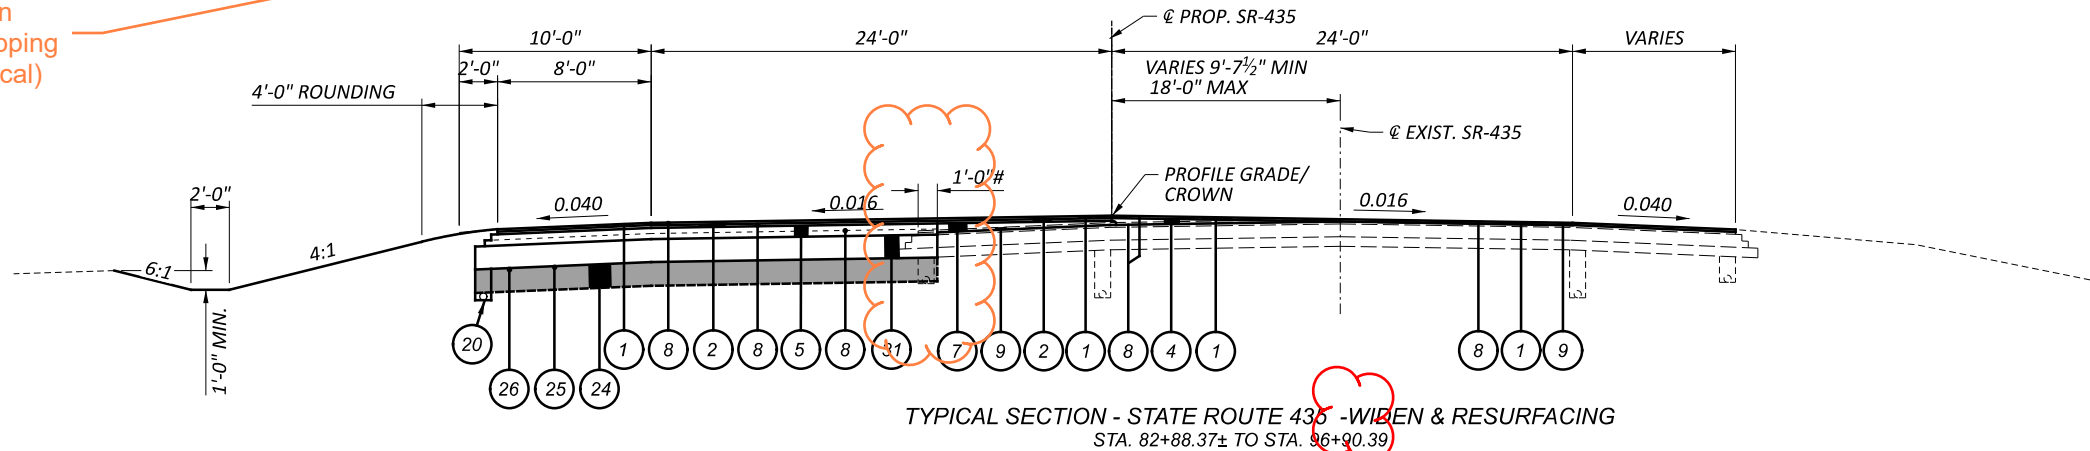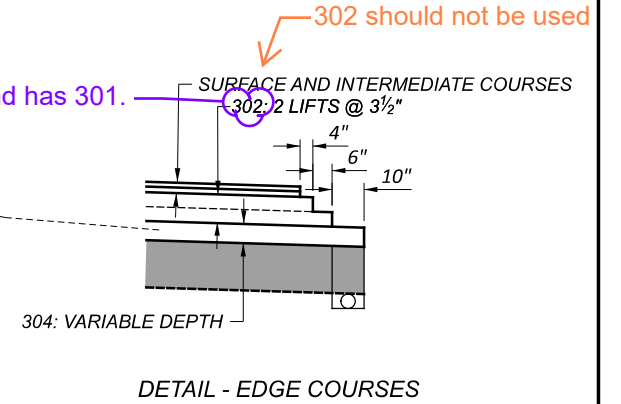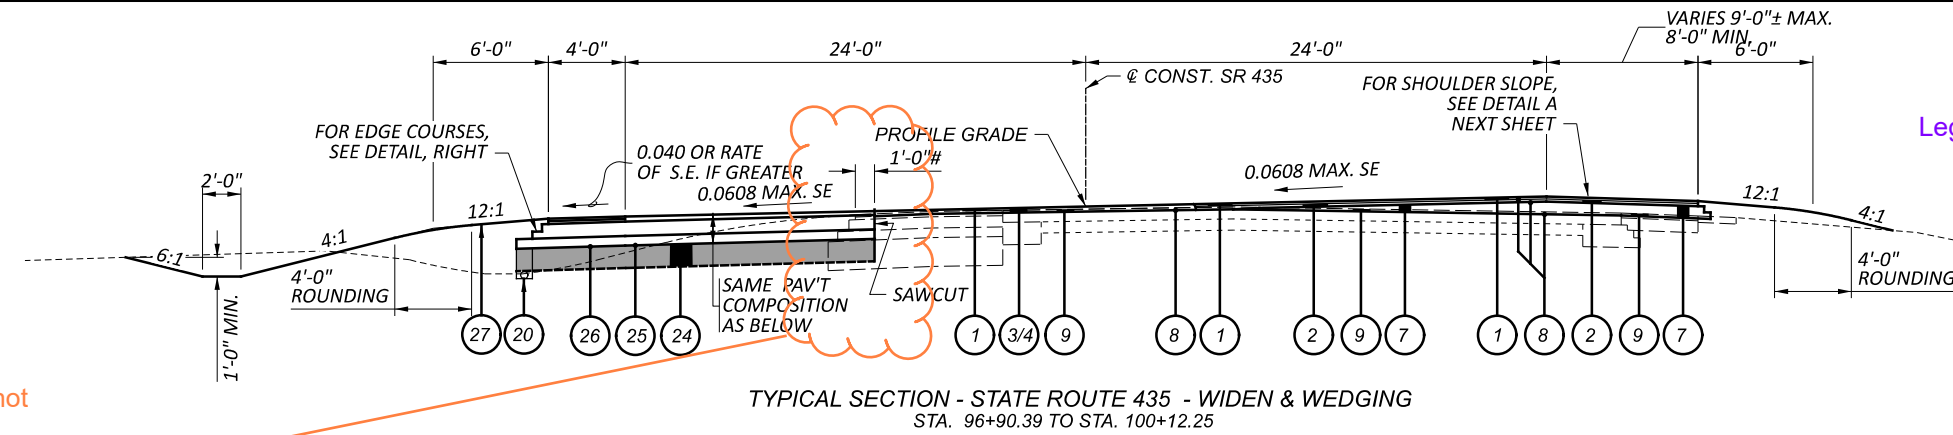


Label guardrail. Will this be long-post due to the narrow shoulder?

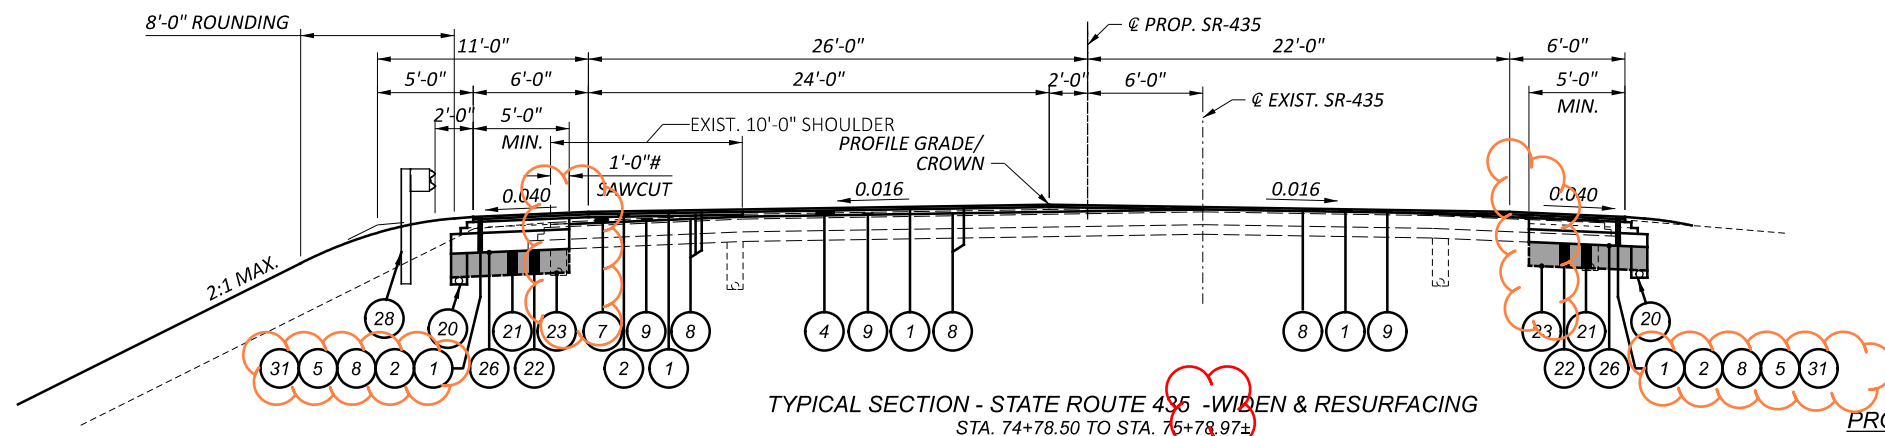

PROPOSED ITEM LEGEND (SEE SHEET __)
EXISTING ITEM LEGEND (SEE SHEET __)


= 1'-0" MIN., OR UNTIL SOUND PAVEMENT IS REACHED

DESIGN AGENCY	Palmer ENGINEERING
DESIGNER	DPF
REVIEWER	DCJ MM-DD-YY
PROJECT ID	117955
SHEET	P. 9
TOTAL	228

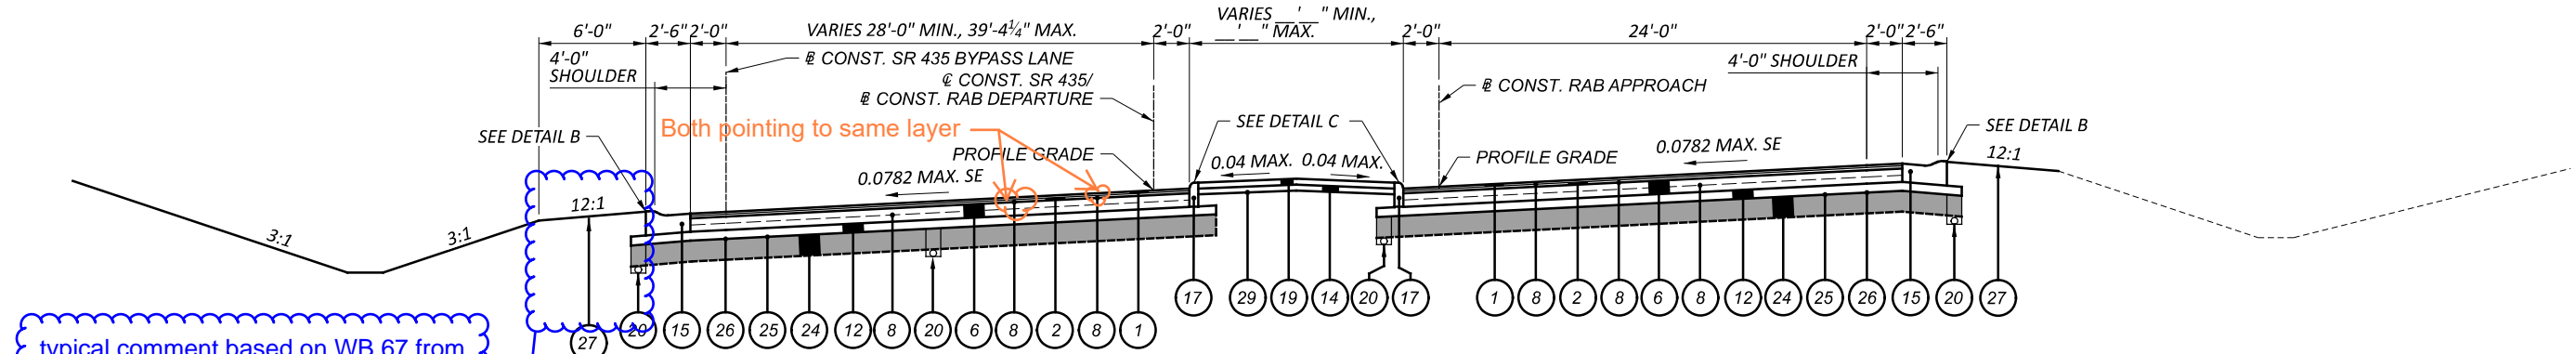


TYPICAL SECTION - WEST ROUNDABOUT APPROACH (SR-435)
FULL-DEPTH WITH SPLITTER ISLANDS
STA. 179+74.72 TO STA. 106+28.16


typical comment based on WB 67 from BU 1 and farm vehicle tracking would additional graded shoulder improvements behind the type 3 curb be warranted to reduce long term maintenance issues?

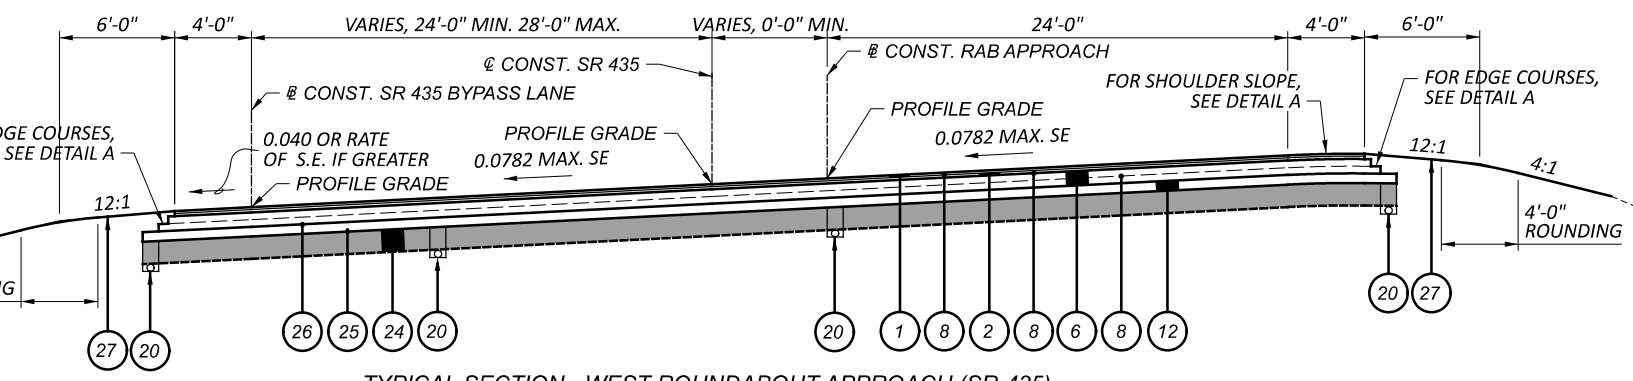

TYPICAL SECTION - WEST ROUNDABOUT APPROACH (SR-435)
FULL-DEPTH WITH SHOULDERS
STA. 101+06.00 TO STA. 179+74.72

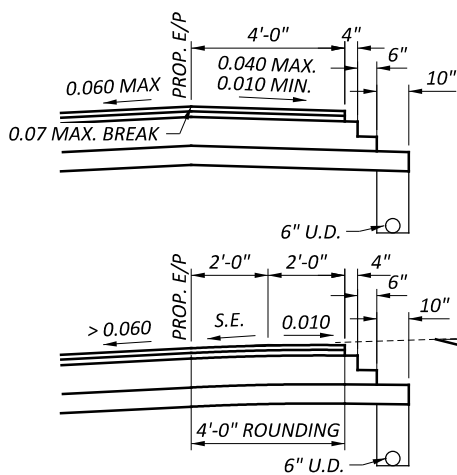


DETAIL A - HIGH SIDE SHOULDER

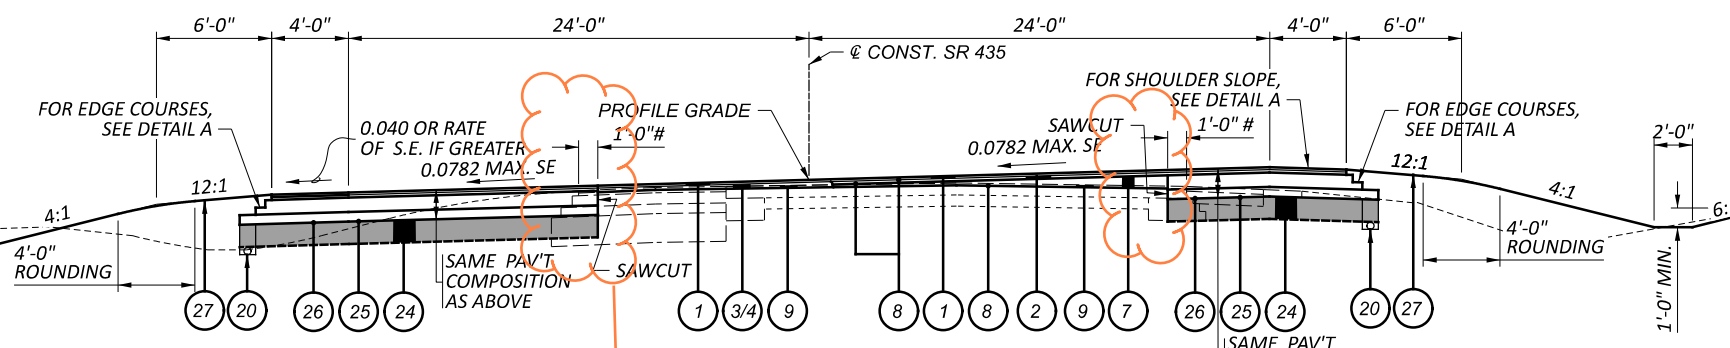


TYPICAL SECTION - WEST ROUNDABOUT APPROACH (SR-435)
WIDENING AND RESURFACING/WEDGING
STA. 100+12.25 TO STA. 101+06.00

See comment Sheet 9

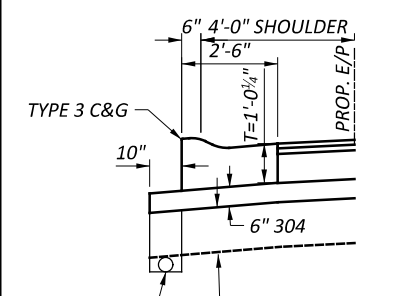

DETAIL B

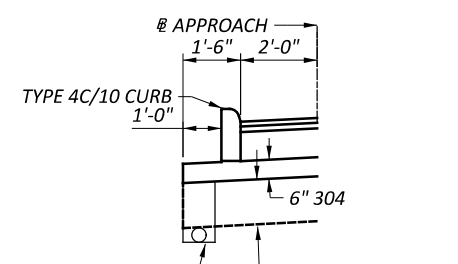

DETAIL C

EXISTING ITEM LEGEND (SEE SHEET)

= 1'-0" MIN. , OR UNTIL SOUND PAVEMENT IS REACHED

DESIGN AGENCY


Palmer
ENGINEERING
8350 E. KEMPER RD.
SUITE B
CINCINNATI, OH 45249
513-469-1600

DESIGNER
DPF


REVIEWER
DCJ MM-DD-YY

PROJECT ID
117955


SHEET TOTAL
P. 10 | 228

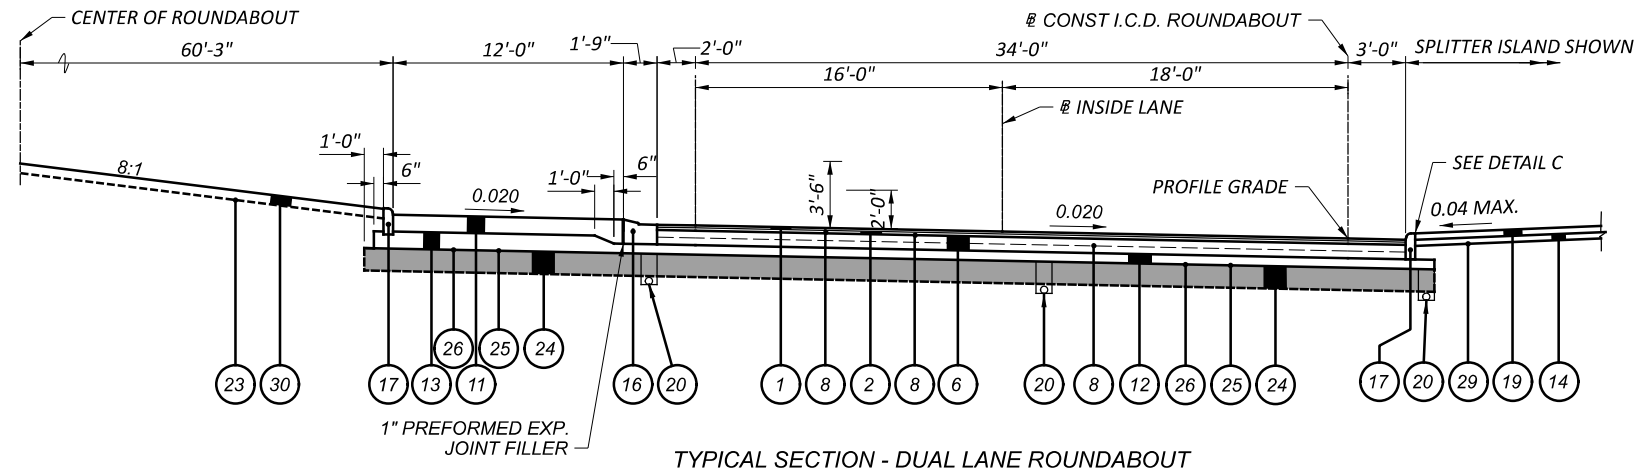

TYPICAL SECTION - DUAL LANE ROUNDABOUT

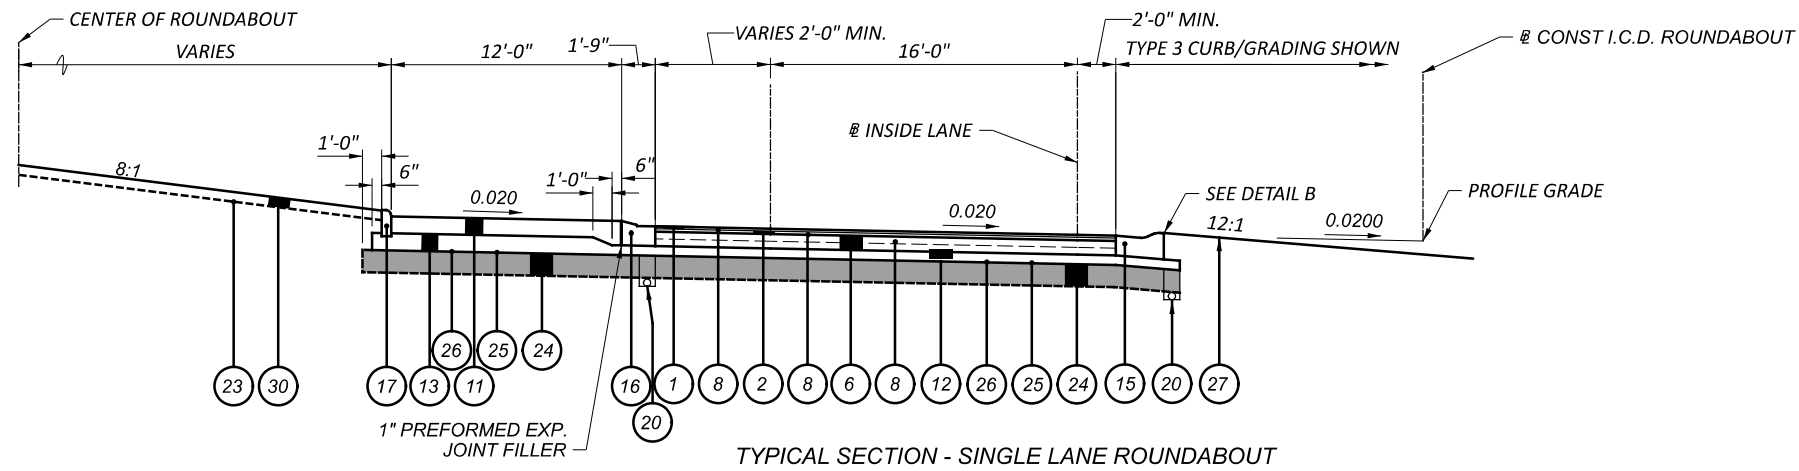

TYPICAL SECTION - SINGLE LANE ROUNDABOUT

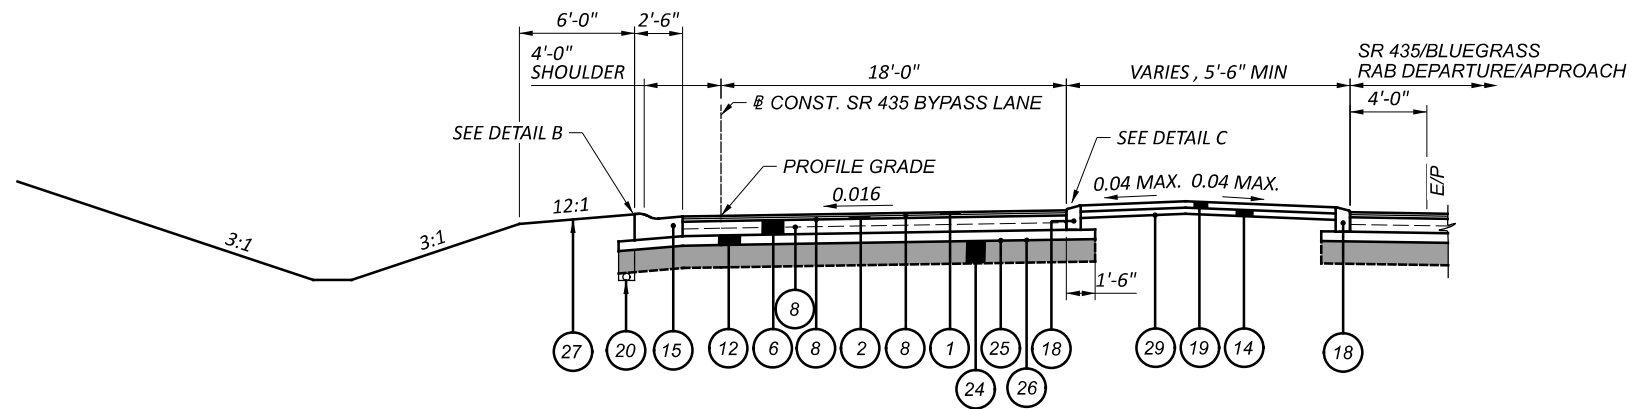

TYPICAL SECTION - SR 435 BYPASS LANE


TYPICAL SECTIONS - SR 435 ROUNDABOUT (BU-5)

FAY-435-1.52


MODEL: SHEET2 PAPER SIZE: 17x11 (in.) DATE: 3/25/2024 TIME: 3:34:19 PM USER: dar-f p:\paw\paw\04\paw\private\palmer\palmer.com\Palmer_Engineering\Documents\Ohio\DOT\06\FAY\117955\400-Engineering\Roadway\Sheets\BU-5\117955_GY025.dgn

FOR PROPOSED ITEM LEGEND, SEE SHEET ___
 FOR EXISTING ITEM LEGEND, SEE SHEET ___
 FOR DETAILS A, B AND C, SEE SHEET ___
 FOR SLOPE AND WIDTH VARIATIONS, SEE
 PLANS, PAVEMENT DETAILS AND
 SUPERELEVATION TABLES


DESIGN AGENCY	Palmer ENGINEERING
DESIGNER	DPF
REVIEWER	DCJ MM-DD-YY
PROJECT ID	117955
SHEET TOTAL	P. 11 228

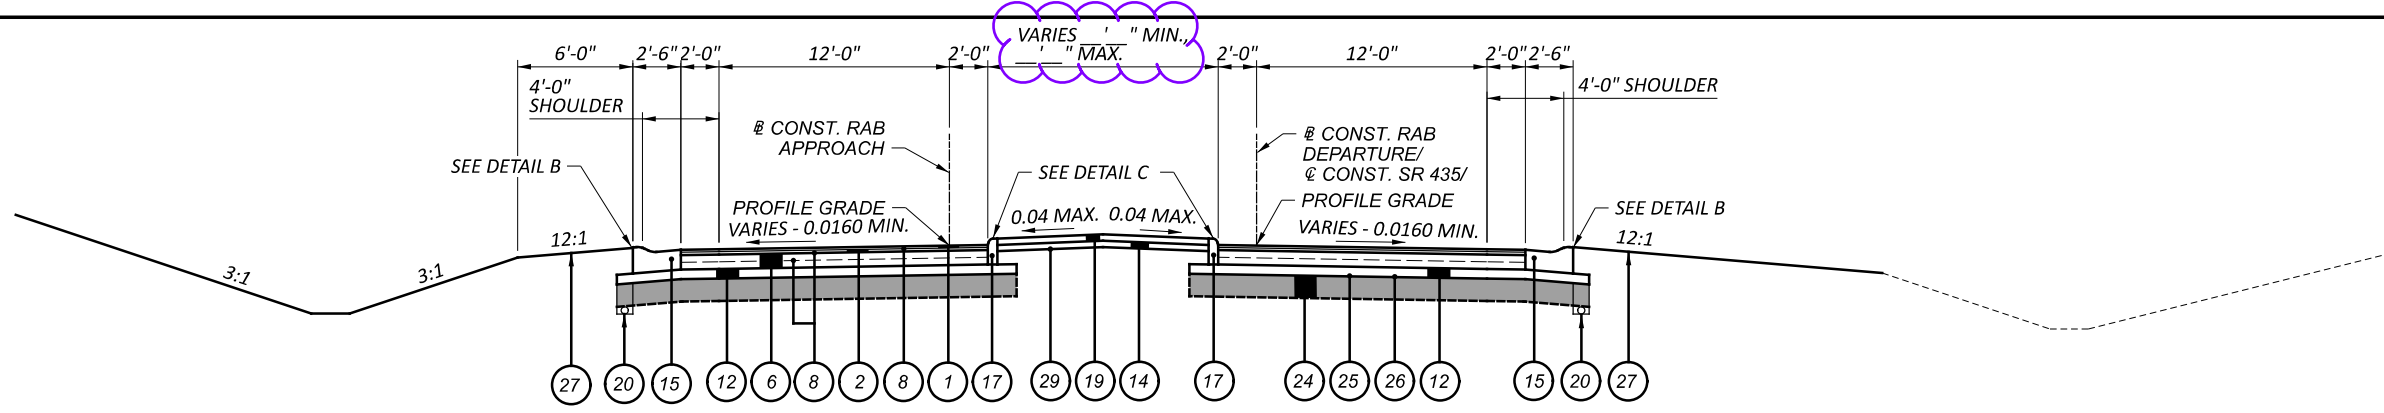

TYPICAL SECTION - EAST ROUNDABOUT APPROACH (SR-435)
FULL-DEPTH WITH SPLITTER ISLANDS
STA. 108+49.35 TO STA. 112+15.39

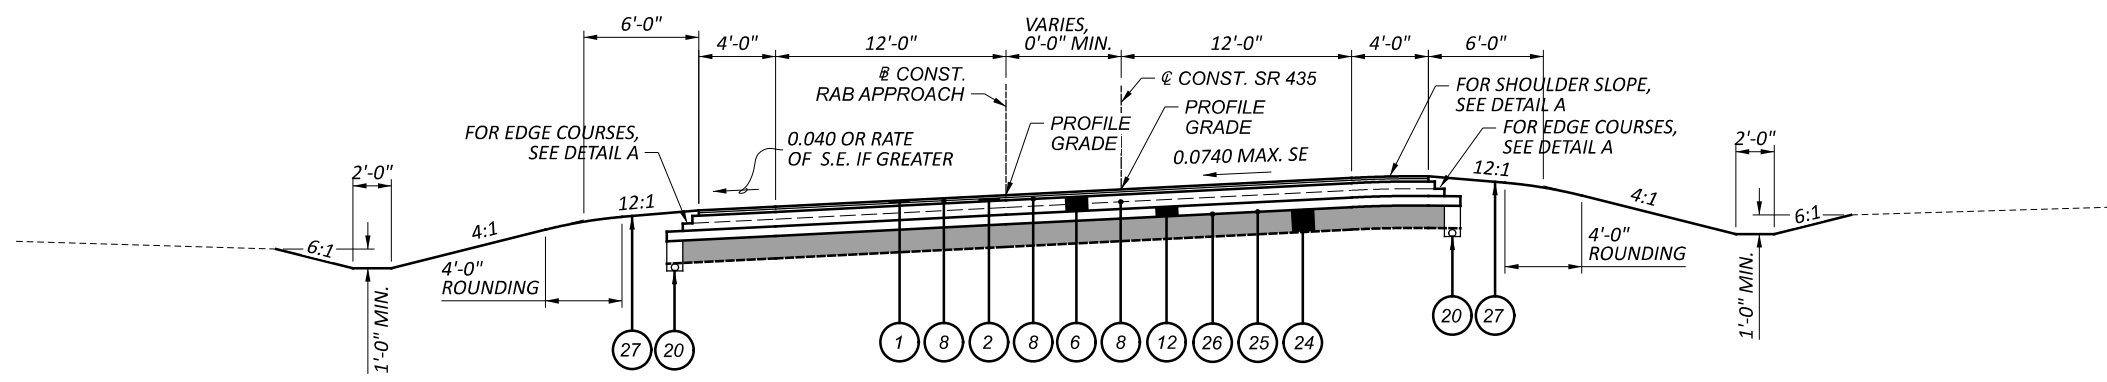


TYPICAL SECTION - EAST ROUNDABOUT APPROACH (SR-435)
FULL-DEPTH WITH SHOULDERS
STA. 112+15.39 TO STA. 114+80.22

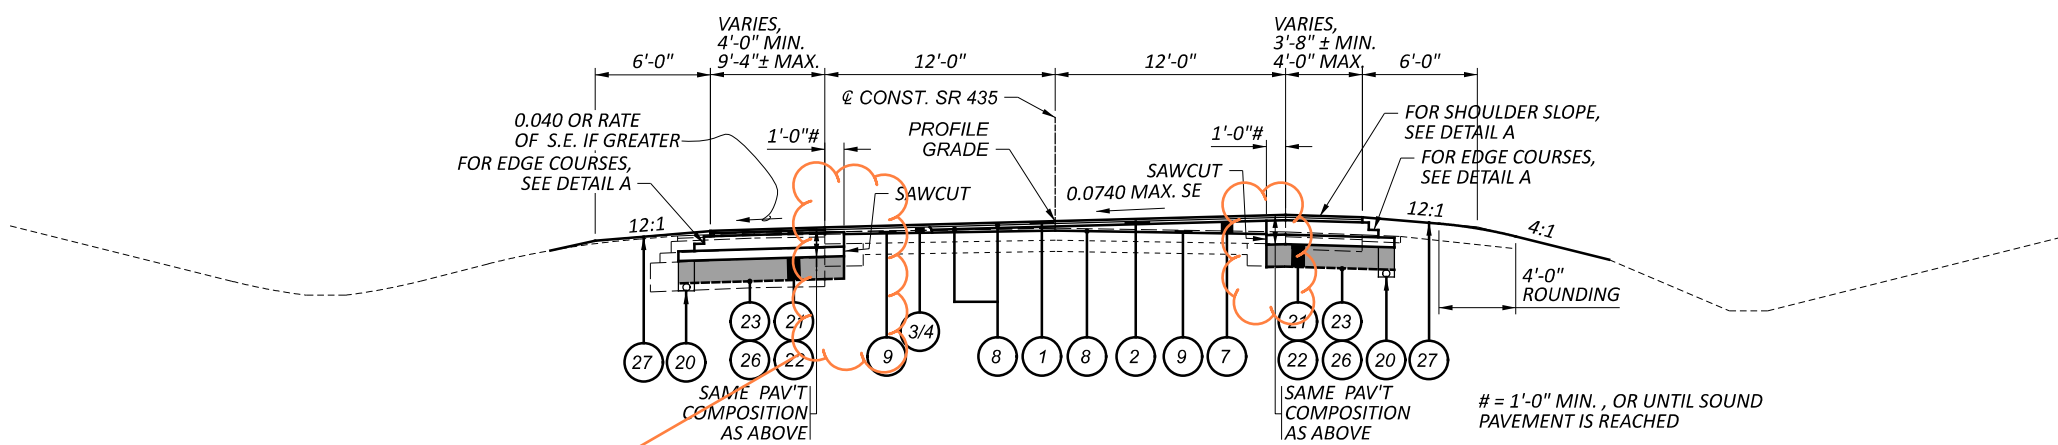

TYPICAL SECTION - EAST ROUNDABOUT APPROACH (SR-435)
WIDENING AND RESURFACING/WEDGING
STA. 114+80.22 TO STA. 116+50.00


See comment
Sheet 9

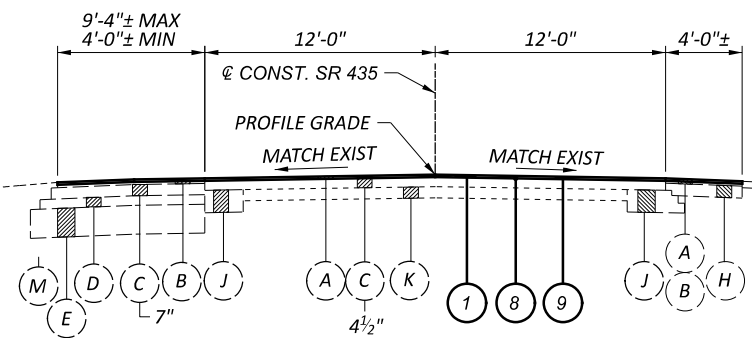

TYPICAL SECTION - EAST ROUNDABOUT APPROACH (SR-435)
RESURFACING
STA. 116+50.00 TO STA. 119+75.00


FOR PROPOSED ITEM LEGEND, SEE SHEET —
FOR EXISTING ITEM LEGEND, SEE SHEET —
FOR DETAILS A, B AND C, SEE SHEET —
FOR SLOPE AND WIDTH VARIATIONS, SEE
PLANS, PAVEMENT DETAILS AND
SUPERELEVATION TABLES

DESIGN AGENCY	Palmer ENGINEERING
DESIGNER	DPF
REVIEWER	DCJ MM-DD-YY
PROJECT ID	117955
SHEET TOTAL	P. 12 228

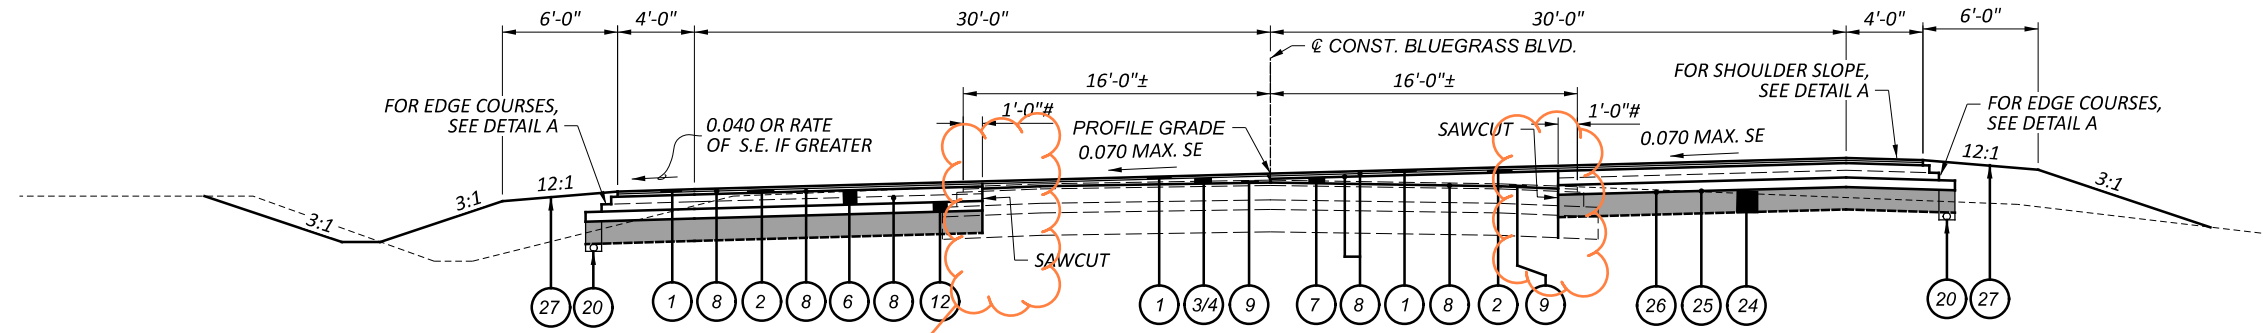


TYPICAL SECTION - ROUNDABOUT APPROACH (BLUEGRASS BLVD)
WIDENING AND RESURFACING/WEDGING
STA. 188+10.34 TO STA. 191+54.60

See comment
Sheet 9

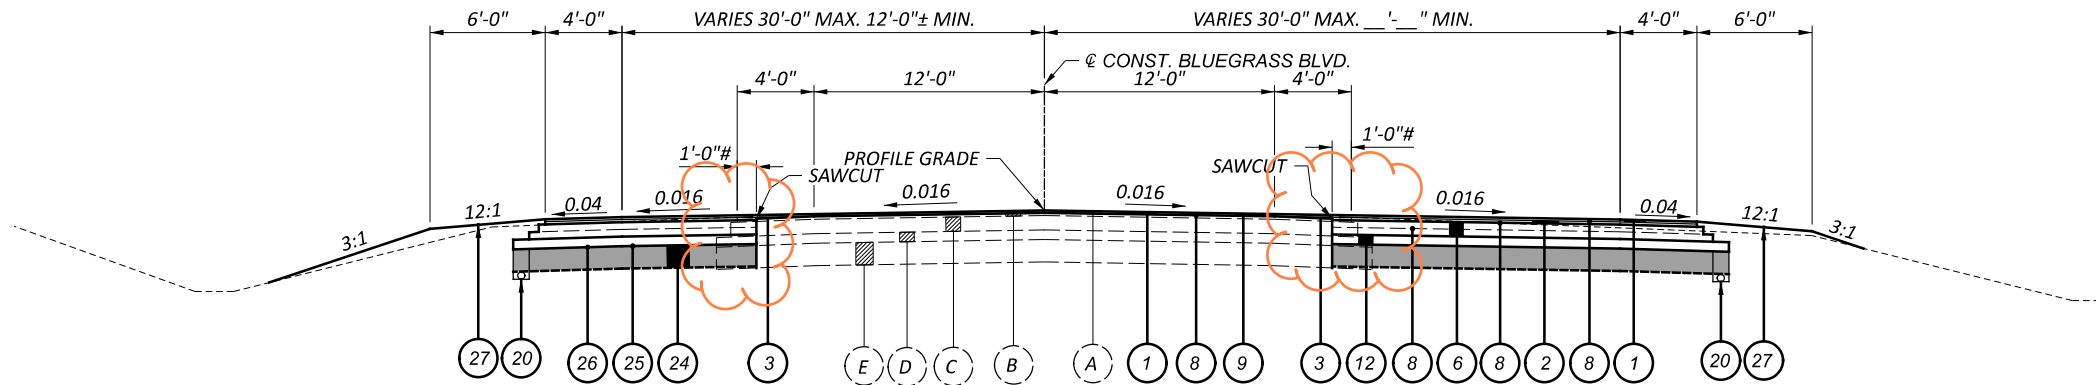

TYPICAL SECTION - BLUEGRASS BLVD
WIDENING AND RESURFACING
STA. 191+54.60 TO STA. 195+00.00

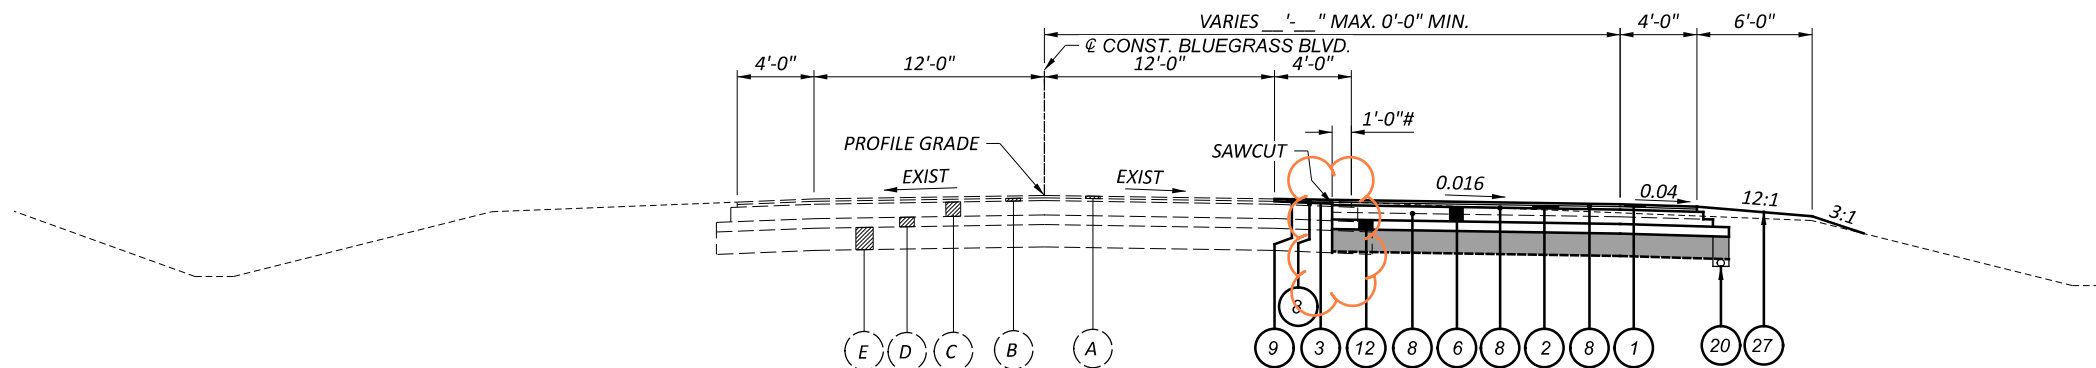

TYPICAL SECTION - BLUEGRASS BLVD
WIDENING
STA. 195+00.00 TO STA. 201+76.00

= 1'-0" MIN. OR UNTIL SOUND PAVEMENT IS REACHED

FOR PROPOSED ITEM LEGEND, SEE SHEET ___
FOR EXISTING ITEM LEGEND, SEE SHEET ___
FOR DETAILS A, B AND C, SEE SHEET ___

FOR SLOPE AND WIDTH VARIATIONS, SEE PLANS, PAVEMENT DETAILS AND SUPERELEVATION TABLES

ROUNDING

THE ROUNDING AT SLOPE BREAKPOINTS SHOWN ON THE TYPICAL SECTIONS APPLIES TO ALL CROSS-SECTIONS, EVEN THOUGH OTHERWISE SHOWN.

UTILITIES

LISTED BELOW ARE ALL UTILITIES LOCATED WITHIN THE PROJECT CONSTRUCTION LIMITS TOGETHER WITH THEIR RESPECTIVE OWNERS:

TRAFFIC SIGNALS AND LIGHTING:
OHIO DEPARTMENT OF TRANSPORTATION – DISTRICT 6
DAVID CARLIN
DAVID.CARLIN@DOT.OHIO.GOV
740-833-8198

WATER AND SANITARY SEWER:
FAYETTE COUNTY ENGINEER'S OFFICE
WATER & SEWER DEPARTMENT
STEVE LUEBBE
STEVE.LUEBBE@FAYETTE-CO-OH.COM
740-333-3538

TELECOMMUNICATIONS:
AT&T
SCOTT ECKLEY
SE1236@ATT.COM
937-965-9839

TELECOMMUNICATIONS:
SPECTRUM/CHARTER
JIM OREBAUGH
JIM.OREBAUGH@CHARTER.COM
740-253-2122

ELECTRIC:
AES
BILL WARD
WILLIAM.WARD@AES.COM

THE LOCATION OF THE UNDERGROUND UTILITIES SHOWN ON THE PLANS ARE AS OBTAINED FROM THE OWNERS AS REQUIRED BY SECTION 153.64 O.R.C.

WORK LIMITS

THE WORK LIMITS SHOWN ON THESE PLANS ARE FOR PHYSICAL CONSTRUCTION ONLY. PROVIDE THE INSTALLATION AND OPERATION OF ALL WORK ZONE TRAFFIC CONTROL AND WORK ZONE TRAFFIC CONTROL DEVICES REQUIRED BY THESE PLANS WHETHER INSIDE OR OUTSIDE THESE WORK LIMITS.

SEEDING AND MULCHING

SEEDING AND MULCHING SHALL BE APPLIED TO ALL AREAS OF EXPOSED SOIL BETWEEN THE RIGHT-OF-WAY LINES, AND WITHIN THE CONSTRUCTION LIMITS FOR AREAS OUTSIDE THE RIGHT-OF-WAY LINES COVERED BY WORK AGREEMENT OR SLOPE EASEMENT.

CLEARING AND GRUBBING

THE PLANS DO NOT IDENTIFY INDIVIDUAL TREES AND STUMPS FOR REMOVAL. UNLESS SPECIFICALLY DESIGNATED AS "DO NOT DISTURB" IN THE PLANS, REMOVE ALL TREES AND STUMPS WITHIN THE CONSTRUCTION LIMITS

BENCHING OF FOUNDATION SLOPES

ALTHOUGH CROSS-SECTIONS INDICATE SPECIFIC DIMENSIONS FOR PROPOSED BENCHING OF THE EMBANKMENT FOUNDATIONS IN CERTAIN AREAS, NO WAIVER OF THE SPECIFICATIONS IS INTENDED. BENCH ALL OTHER SLOPED EMBANKMENT AREAS AS SET FORTH IN SECTION 203.05 OF THE CONSTRUCTION AND MATERIAL SPECIFICATIONS (C&MS). NO ADDITIONAL PAYMENT WILL BE MADE FOR BENCHING REQUIRED UNDER THE PROVISIONS OF SECTION 203.05.

SURVEYING PARAMETERS

PRIMARY PROJECT CONTROL MONUMENTS GOVERN ALL POSITIONING ON ODOT PROJECTS. SEE SHEET P. 3 OF THE PLANS FOR A TABLE CONTAINING PROJECT CONTROL INFORMATION.

USE THE FOLLOWING PROJECT CONTROL, VERTICAL POSITIONING, AND HORIZONTAL POSITIONING PARAMETERS FOR ALL SURVEYING:

PROJECT CONTROL

POSITIONING METHOD: NGS OPUS
MONUMENT TYPE: VARIOUS SET BY ODOT, SEE TABLE SHEET P.3

VERTICAL POSITIONING

ORTHOMETRIC HEIGHT DATUM: NAVD88
GEOID: GEOID 18

HORIZONTAL POSITIONING

REFERENCE FRAME: NAD83 (2011) EPOCH 2010.0
ELLIPSOID: GRS80
MAP PROJECTION: LAMBERT CONFORMAL CONIC
COORDINATE SYSTEM: OHIO STATE PLANE COORDINATE SYSTEM, SOUTH ZONE
COMBINED SCALE FACTOR: 0.99989861 (GROUND TO GRID)
PROJECT SCALE FACTOR: 1.00010140 (GRID TO GROUND)
ORIGIN OF COORDINATE SYSTEM: GRID COORDINATES SCALED ABOUT 0,0

USE THE POSITIONING METHODS AND MONUMENT TYPE USED IN THE ORIGINAL SURVEY TO RESTORE ALL MONUMENTS RELATED TO PRIMARY PROJECT CONTROL THAT ARE DAMAGED OR DESTROYED BY CONSTRUCTION ACTIVITIES. RESTORE THE DAMAGED OR DESTROYED MONUMENTS IN ACCORDANCE WITH CMS 623.

UNITS ARE IN U.S. SURVEY FEET.

AIRWAY/HIGHWAY CLEARANCE FOR AIRPORTS AND HELIPOINTS

THIS PROJECT HAS BEEN IDENTIFIED AS BEING WITHIN THE INFLUENCE AREA OF A PRIVATE-USE AIRPORT OR HELIPOINT. NO TEMPORARY STRUCTURES OR CONSTRUCTION EQUIPMENT, AT MAXIMUM OPERATING HEIGHT, SHALL EXCEED A HEIGHT OF 50 FT. IF ANY TEMPORARY STRUCTURES OR CONSTRUCTION EQUIPMENT WILL EXCEED THIS HEIGHT, COORDINATION WITH THE AIRPORT OWNER AND THE ODOT OFFICE OF AVIATION WILL BE NECESSARY PRIOR TO ERECTING SUCH TEMPORARY STRUCTURES OR OPERATING SUCH EQUIPMENT ON THE PROJECT. FOR PRIVATE USE AIRPORTS OR HELIPOINTS, COORDINATE WITH THE AIRPORT OWNER AND THE ODOT OFFICE OF AVIATION. NO TEMPORARY STRUCTURES OR CONSTRUCTION EQUIPMENT SHALL EXCEED THE PERMISSIBLE HEIGHT, UNTIL COORDINATION IS MET AND DOCUMENTATION HAS BEEN FURNISHED TO THE PROJECT ENGINEER. IF COORDINATION IS NOT OBTAINED, THEN THE PROJECT ENGINEER WILL HAVE THE AUTHORITY TO PROVIDE RESTRICTIONS AS REQUIRED.

MEDFLIGHT 9 (HELIPAD)
(PCL OWNER FAYETTE COUNTY BOARD OF COMMISSIONERS)
11280 OLD US HWY 35 NW, JEFFERSONVILLE, OH 43128
(877) 633 - 3598

PART-WIDTH CONSTRUCTION

BECAUSE OF THE NECESSITY TO BUILD THIS PROJECT UNDER TRAFFIC AND TO CONSTRUCT THE FULL PAVEMENT WIDTH IN STAGES, EXERCISE CARE TO PREVENT THE CONSTRUCTION OF A BUTT JOINT IN THE BASE COURSES. LAP LONGITUDINAL JOINTS AS SHOWN ON STANDARD CONSTRUCTION DRAWING BP-3.1.

ITEM 606 - ANCHOR ASSEMBLY, MGS TYPE E (MASH 2016)

THIS ITEM SHALL CONSIST OF FURNISHING AND INSTALLING ANY OF THE GUARDRAIL END TERMINALS FOR TYPE MGS GUARDRAIL AS LISTED ON ROADWAY ENGINEERING'S WEB PAGE UNDER ROADSIDE SAFETY DEVICES FOR APPROVED GUARDRAIL END TREATMENTS. INSTALLATION SHALL BE AT THE LOCATIONS SPECIFIED IN THE PLANS, IN ACCORDANCE WITH THE MANUFACTURER'S SPECIFICATIONS.

Update to latest language
THE FACE OF THE TYPE E IMPACT HEAD SHALL BE COVERED WITH A SHEET OF TYPE G REFLECTIVE SHEETING, PER CMS 730.19.

REFER TO THE MANUFACTURER'S INSTRUCTIONS REGARDING THE INSTALLATION OF, AND THE GRADING AROUND THE FOUNDATION TUBES AND GROUND STRUT. THE TOP OF ANY FOUNDATION TUBE SHOULD BE LESS THAN 4 INCHES ABOVE THE GROUND. THE PLACEMENT OF THE FOUNDATION TUBES SHOULD BE AN APPROPRIATE DEPTH BELOW THE LEVEL LINE IN ORDER TO MAINTAIN THE FINISHED GUARDRAIL HEIGHT OF 31 INCHES FROM THE EDGE OF THE SHOULDER.

ON-SITE GRADING IS REQUIRED IF THE TOP OF THE FOUNDATION TUBES OR TOP OF THE GROUND STRUT DOES PROJECT MORE THAN 4 INCHES ABOVE THE GROUND LINE.

PAYMENT FOR THE ABOVE WORK SHALL BE MADE AT THE UNIT PRICE BID FOR ITEM 606, ANCHOR ASSEMBLY, MGS TYPE E, EACH, AND SHALL INCLUDE ALL LABOR, TOOLS, EQUIPMENT AND MATERIALS NECESSARY TO CONSTRUCT A COMPLETE AND FUNCTIONAL ANCHOR ASSEMBLY SYSTEM, INCLUDING ALL RELATED TRANSITIONS, REFLECTIVE SHEETING, HARDWARE, GRADING, EMBANKMENT AND EXCAVATION NOT SEPARATELY SPECIFIED, AS REQUIRED BY THE MANUFACTURER.

EMBANKMENT OVER EXISTING DITCHES

WHERE EMBANKMENT IS PROPOSED TO PLACED IN EXISTING DITCHES, THE CONTRACTOR SHALL EXCAVATE AND REPLACE UNSUITABLE MATERIAL BEFORE PLACING EMBANKMENTS. EXCAVATE THE UNSUITABLE MATERIAL TO A NOMINAL DEPTH OF 2 FEET BELOW THE EXISTING ELEVATION OF THE DITCH BOTTOM, THE LIMITS OF WHICH SHALL BE THE WIDTH OF THE DITCH. SHAPE AND COMPACT THE SUBGRADE AFTER REMOVAL OF UNSUITABLE MATERIAL PRIOR TO PLACING THE EMBANKMENT.

ITEM SPECIAL - MAILBOX SUPPORT

THIS WORK SHALL CONSIST OF FURNISHING AND ERECTING MAILBOX SUPPORTS AND ANY ASSOCIATED MOUNTING HARDWARE IN ACCORDANCE WITH PLAN DETAILS, AND ATTACHING AN OWNER-SUPPLIED MAILBOX AT LOCATIONS SPECIFIED IN THE PLAN, OR OTHERWISE ESTABLISHED BY THE ENGINEER.

WOOD POSTS SHALL BE NOMINAL 4 INCHES BY 4 INCHES SQUARE OR 4.5 INCHES DIAMETER ROUND, AND CONFORM TO 710.14.

STEEL POSTS SHALL BE NOMINAL PIPE SIZE 2 INCHES I.D., AND CONFORM TO AASHTO M 181.

ALL HARDWARE INCLUDING BUT NOT LIMITED TO PLATES, SCREWS, BOLTS, AND ETC. SHALL BE COMMERCIAL-GRADE GALVANIZED STEEL.

POSTS SHALL BE SET PER THE FIRST PARAGRAPH OF 606.03, AND SHALL IN NO INSTANCE BE ENCASED IN CONCRETE.

SUPPORT HARDWARE SHALL ACCOMMODATE EITHER A SINGLE OR A DOUBLE MAILBOX INSTALLATION, AND NO MORE THAN TWO BOXES MAY BE MOUNTED ON A SINGLE POST.

THE MAILBOX SHALL BE SECURELY AND NEATLY ATTACHED BY THE CONTRACTOR TO THE NEW SUPPORT. THE CONTRACTOR SHALL FURNISH ALL NECESSARY ATTACHMENT HARDWARE (NUTS, BOLTS, PLATES, SPACERS, AND WASHERS) AS NECESSARY TO ACCOMMODATE THE COMPLETE INSTALLATION.

IN THE ABSENCE OF A NEW BOX SUPPLIED BY THE OWNER, THE CONTRACTOR SHALL SALVAGE THE EXISTING BOX AND PLACE IT ON THE NEW SUPPORT. DUE CARE SHALL BE EXERCISED IN SUCH AN OPERATION, AND THE CONTRACTOR SHALL BE RESPONSIBLE FOR REPAIRING OR REPLACING ANY BOX DAMAGED BY IMPROPER HANDLING ON HIS PART, AS JUDGED AND DIRECTED BY THE ENGINEER.

THE CONTRACTOR SHALL BE RESPONSIBLE FOR COORDINATING WITH THE LOCAL POST MASTER REGARDING THE TIMING OF THE MOVEMENT OF ANY MAILBOX TO A NEW LOCATION.

TEMPORARY INSTALLATIONS SHALL BE IN ACCORDANCE WITH 107.10. HOWEVER, THE SAME MATERIAL AND SIZE LIMITATIONS AS FOR PERMANENT INSTALLATIONS SHALL APPLY.

DESIGN AGENCY

Palmer
ENGINEERING
8350 E. KEMPER RD.
SUITE B
CINCINNATI, OH 45249
513-469-1600

DESIGNER
DPF

REVIEWER
DCJ MM-DD-YY

PROJECT ID
117955

SHEET TOTAL
P. 17 | 228

CROSSINGS AND CONNECTIONS TO EXISTING PIPES AND UTILITIES

WHERE PLANS PROVIDE FOR A PROPOSED CONDUIT TO BE CONNECTED TO, OR CROSS OVER OR UNDER AN EXISTING SEWER OR UNDERGROUND UTILITY, LOCATE THE EXISTING PIPES OR UTILITIES BOTH AS TO LINE AND GRADE BEFORE STARTING TO LAY THE PROPOSED CONDUIT.

IF IT IS DETERMINED THAT THE ELEVATION OF THE EXISTING CONDUIT, OR EXISTING APPURTENANCE TO BE CONNECTED, DIFFERS FROM THE PLAN ELEVATION OR RESULTS IN A CHANGE IN THE PLAN CONDUIT SLOPE, NOTIFY THE ENGINEER BEFORE STARTING CONSTRUCTION OF ANY PORTION OF THE PROPOSED CONDUIT WHICH WILL BE AFFECTED BY THE VARIANCE IN THE EXISTING ELEVATIONS.

IF IT IS DETERMINED THAT THE PROPOSED CONDUIT WILL INTERSECT AN EXISTING SEWER OR UNDERGROUND UTILITY IF CONSTRUCTED AS SHOWN ON THE PLAN, NOTIFY THE ENGINEER BEFORE STARTING CONSTRUCTION OF ANY PORTION OF THE PROPOSED CONDUIT WHICH WOULD BE AFFECTED BY THE INTERFERENCE WITH AN EXISTING FACILITY.

DRAINAGE DISCHARGE CONTINUANCE

FURNISH A DRAINAGE DISCHARGE CONTINUANCE FOR ANY DRAINAGE DISCHARGE DISTURBED BY THE WORK AND NOT SHOWN IN THE PLANS. THE LOCATION, TYPE (CONDUIT OR SWALE), SIZE AND GRADE OF THE DRAINAGE DISCHARGE CONTINUANCE WILL BE AGREED TO BY THE ENGINEER

FURNISH AN INSPECTION WELL AT THE RIGHT OF WAY LINE IN ACCORDANCE WITH SCD DM-3.1 FOR EACH DRAINAGE DISCHARGE THAT OUTLETS THROUGH A CURB OPENING, OR INTO A STORM SEWER OR DRAINAGE STRUCTURE.

FURNISH A WELL GRADED TRANSITION BETWEEN THE DITCH AND THE SWALE WHEN OUTLETTING A SWALE TO A DITCH.

FURNISH AN EROSION CONTROL PAD AS SHOWN IN SCD DM-1.1 WHEN OUTLETTING A CONDUIT TO A DITCH.

FURNISH A DRILLED HOLE OR A CURB SECTION WITH A HOLE WHEN OUTLETTING A CONDUIT THROUGH A CURB OPENING.

FURNISH A DRILLED CORE HOLE WHEN OUTLETTING INTO A STORM SEWER OR DRAINAGE STRUCTURE. .

DOCUMENTATION

THE CONTRACTOR SHALL FURNISH WRITTEN DOCUMENTATION TO THE ENGINEER AND TO THE DISTRICT R/W PERMIT OFFICE. THE DOCUMENTATION INCLUDES THE CONSTRUCTION PROJECT NUMBER, PID, COUNTY, ROUTE, SECTION, LATITUDE AND LONGITUDE OF THE DRAINAGE DISCHARGE AT THE R/W, THE NAME OF PROPERTY OWNER WITH ADDRESS, THE DATE THE DRAINAGE DISCHARGE WAS LOCATED, THE DATE THE DRAINAGE DISCHARGE CONTINUANCE WAS FURNISHED, A DETAILED DESCRIPTION OF THE WORK AND PICTURES OF THE DRAINAGE DISCHARGE CONTINUANCE (IN PDF OR JPEG FORMAT).

DRAINAGE DISCHARGE CONTINUANCE REMOVAL
THE ENGINEER MAY REQUIRE THE NEWLY INSTALLED DRAINAGE DISCHARGE CONTINUANCE TO BE REMOVED.

REMOVE THE NEWLY INSTALLED CONDUIT AND ANY EXISTING CONDUIT TO THE RIGHT OF WAY LINE. FOR CONDUIT THAT OUTLETS THROUGH THE CURB RESTORE THE CURB BY FILLING THE HOLE WITH CLASS QC 1 CONCRETE OR REPLACE THE CURB SECTION. FOR STRUCTURE THAT OUTLETS TO A STORM SEWER OR DRAINAGE STRUCTURE LEAVE 6 INCHES PROTRUDING OUTSIDE OF THE STRUCTURE. PLUG THE PROTRUDING CONDUIT WITH EITHER A MANUFACTURED CAP OR CLASS QC 1 CONCRETE. FOR CONDUIT THAT OUTLETS TO THE DITCH REMOVE THE EROSION CONTROL PAD. RESTORE ALL AREAS AS REQUIRED. PLUG THE EXISTING CONDUIT REGARDLESS OF SIZE AT THE RIGHT OF WAY LINE WITH CLASS QC 1 CONCRETE AND RESTORE ALL AREAS AS REQUIRED.

REVIEW OF DRAINAGE FACILITIES

PRIOR TO THE START OF WORK AND AGAIN BEFORE FINAL ACCEPTANCE, PERFORM AN INSPECTION WITH REPRESENTATIVES OF THE DEPARTMENT, CONTRACTOR AND LOCALS OF ALL EXISTING DRAINAGE FACILITIES THAT ARE TO REMAIN IN SERVICE WHICH MAY BE AFFECTED BY THE WORK. THE CONDITION OF THE EXISTING CONDUITS AND THEIR APPURTENANCES IS DETERMINED FROM FIELD OBSERVATIONS. RECORDS OF THE INSPECTION ARE MAINTAINED BY THE DEPARTMENT.

CONFIRM ALL EXISTING SEWERS INSPECTED INITIALLY BY THE ABOVE-MENTIONED PARTIES ARE MAINTAINED AND LEFT IN A CONDITION COMPARABLE TO THAT DETERMINED BY THE ORIGINAL INSPECTION. THE CONTRACTOR IS RESPONSIBLE TO CORRECT ANY CHANGE IN THE CONDITION RESULTING FROM THEIR OPERATIONS AS DIRECTED AND APPROVED BY THE ENGINEER.

EXISTING SUBSURFACE DRAINAGE

PROVIDE UNOBSTRUCTED OUTLETS FOR ALL EXISTING UNDERDRAINS OR AGGREGATE DRAINS ENCOUNTERED DURING CONSTRUCTION.

PROVIDE AN OUTLET PER STANDARD CONSTRUCTION DRAWING DM-1.1 FOR ALL UNDERDRAINS THAT OUTLET TO A SLOPE. UNDERDRAINS THAT CAN BE CONNECTED TO THE NEW OR EXISTING UNDERDRAINS AT THE END OF THE PROJECT LIMITS AS WELL AS ALL NECESSARY BENDS OR BRANCHES REQUIRED FOR CONNECTION ARE INCLUDED IN THE BASIS OF PAYMENT FOR UNCLASSIFIED PIPE UNDERDRAINS.

POST CONSTRUCTION STORM WATER TREATMENT

THIS PLAN UTILIZES STRUCTURAL BEST MANAGEMENT PRACTICES (BMP'S) FOR POST CONSTRUCTION STORM WATER TREATMENT.

EXTENDED DETENTION BASIN

THIS PLAN UTILIZES EXTENDED DETENTION BASIN(S) FOR POST CONSTRUCTION STORM WATER TREATMENT. DETENTION BASINS MAY BE USED AS SEDIMENT CONTROL DEVICES DURING CONSTRUCTION. FOLLOWING STABILIZATION OF THE TRIBUTARY AREA, FINAL GRADING OF THE DETENTION BASIN MUST MATCH THE PLANS. THE DETENTION BASIN OUTLET STRUCTURE FOR CONSTRUCTION SEDIMENT CONTROL MUST BE REMOVED AND THE OUTLET STRUCTURE MUST BE MADE TO MATCH THE DESIGN SHOWN IN THE PLANS.

DESIGN AGENCY



DESIGNER
DPF

REVIEWER
DCJ MM-DD-YY

PROJECT ID
117955

SHEET TOTAL
P. 18 | 228

ITEM 614, MAINTAINING TRAFFIC

PHASE 1

CONSTRUCT PAVEMENT FOR MAINTAINING TRAFFIC, CLASS A FROM STATION ___ TO STATION ____ ON THE SOUTH SIDE OF SR 435 AND ON THE EAST SIDE OF SR 729 AND BLUEGRASS NEAR THE INTERSECTION. EXTEND CULVERTS AND PLACE TEMPORARY DRAINAGE AS SHOWN ON SHEETS _____. CONSTRUCT PERMANENT PAVEMENT WIDENING (SUBGRADE IMPROVEMENT AND BASES) ON BLUEGRASS STATION ___ TO STATION ____ FOR TEMPORARY MODIFICATIONS TO THE EXISTING SIGNAL AT SR 729 AND SR435 SEE SHEET P. 68. SEE SHEETS ___ FOR PHASE DETAILS.

PHASE 2

SHIFT SR 435 TRAFFIC TO THE SOUTH (RIGHT) SIDE AND SHIFT SR 729/BUEGRASS TO THE EAST (RIGHT) SIDE ON THE EXISTING PAVEMENT AND PAVEMENT FOR M.O.T CONSTRUCTED IN PHASE 1, PER THE MOT PHASE DETAIL SHEETS ___-. CONSTRUCT WIDENING, DRAINAGE, CURB, AND FULL-DEPTH PAVEMENT ON THE LEFT SIDE OF S.R. 435 FROM THE BEGINNING OF THE PROJECT TO THE END.

ON BRIDGE FAY-035-0435 OVER US 35 HYDRODEMO AND OVERLAY LEFT HALF OF BRIDGE DECK. CONSTRUCT ROUNDABOUT AND PORTIONS OF THE APPROACHES AND DRAINAGE ON THE NORTHWEST QUADRANT, INCLUDING EXTENSION OF 9FT SPAN x 5FT RISE BOX CULVERT. FOR TEMPORARY MODIFICATIONS TO THE EXISTING SIGNAL AT SR 729 AND SR435 SEE SHEET P. 69. SEE SHEETS ___ FOR PHASE DETAILS.

PHASE 3

SHIFT SR 435 TRAFFIC TO THE NORTH (LEFT) SIDE ON THE PAVEMENT AND BRIDGE DECK CONSTRUCTED IN PHASE 2. THE SR 435 WEST APPROACH AND BLUEGRASS NORTH APPROACH TO THE ROUNDABOUT WILL USE THE APPROACH PAVEMENT CONSTRUCTED IN PHASE 2. THE SR 435 EAST APPROACH TO THE ROUNDABOUT WILL UTILIZE THE EXISTING PAVEMENT AND TEMPORARY SPLITTER ISLAND ARRANGEMENT. THE SR 729 APPROACH WILL BE CLOSED FOR A PERIOD NOT TO EXCEED 30 CONSECUTIVE CALENDAR DAYS, FROM 9/1/2024 TO 10/1/2024. A DISINCENTIVE SHALL BE ASSESSED IN THE AMOUNT OF \$1000 PER DAY FOR EACH CALENDAR DAY THE ROADWAY REMAINS CLOSED TO TRAFFIC BEYOND THE SPECIFIED LIMIT. SEE SHEET ___ FOR SR 729 DETOUR PLAN.

ON BRIDGE FAY-035-0435 OVER US 35 COMPLETE THE HYDRODEMO AND OVERLAY ON THE RIGHT HALF OF THE BRIDGE DECK. CONSTRUCT THE REMAINING PORTION OF THE SR 435 WEST APPROACH AND BLUEGRASS NORTH APPROACH TO THE ROUNDABOUT. CONSTRUCT THE SR 435 EAST APPROACH TO THE ROUNDABOUT BY PART-WIDTH. COMPLETE THE SR 729 APPROACH TO THE ROUNDABOUT. SEE SHEETS ___ FOR PHASE DETAILS.

PHASE 4

OPEN SR 435 TO 4 LANES UP TO THE SR 435 WEST APPROACH TO THE ROUNDABOUT. COMPLETE THE SPLITTER ISLANDS ON THE SR 435 WEST APPROACH AND BLUEGRASS NORTH APPROACH TO THE ROUNDABOUT. SPLIT THE SR 435 EAST APPROACH TO THE ROUNDABOUT, THE OUTBOUND MOVEMENT WILL UTILIZE THE PHASE 3 LANE LOCATION, AND THE INBOUND MOVEMENT WILL UTILIZE THE LEFT HALF OF THE APPROACH CONSTRUCTED IN PHASE 3. COMPLETE THE SPLITTER ISLAND AND PAVEMENT ON THE SR 435 EAST APPROACH TO THE ROUNDABOUT. OPEN SR 729 ON THE APPROACH TO THE ROUNDABOUT COMPLETED IN PHASE 3. SEE SHEETS ___ FOR PHASE DETAILS.

PHASE 5

PLACE FINAL SURFACE COURSE ON COMPLETED PAVEMENTS, FINAL GRADING, AND OTHER ANCILLARY ITEMS NOT COMPLETED IN PRIOR PHASES.

RAMP D – WB US-35 OFF-RAMP

RAMP D - PHASES 1 THRU PHASE 3 SHALL BE PERMITTED FOR A TOTAL DURATION OF 60 CONSECUTIVE CALENDAR DAYS. A DISINCENTIVE SHALL BE ASSESSED IN THE AMOUNT OF \$5000 PER DAY FOR EACH CALENDAR DAY THE LANE REMAINS CLOSED TO TRAFFIC BEYOND THE SPECIFIED LIMIT.

RAMP D - PHASE 1

SHIFT TRAFFIC ON RAMP D TO THE OUTSIDE AS SHOWN ON SHEETS ___ AND CONSTRUCT FULL-DEPTH PAVEMENT WIDENING TO STA. 242+50 AND PAVEMENT FOR MOT FROM STA. 243+00 TO STA. 248+31 (THE EXISTING RAMP GORE) ON THE INSIDE OF THE RAMP. PROVIDE SIGNAGE ON N.B. I-71 AS PER SCD MT-98.28

RAMP D - PHASE 2

SHIFT TRAFFIC ON RAMP D TO THE INSIDE TO THE PAVEMENT AND PAVEMENT FOR MOT CONSTRUCTED IN PHASE 1 AS SHOWN ON SHEETS ___ AND CONSTRUCT FULL-DEPTH PAVEMENT ON THE OUTSIDE OF THE RAMP. DEFER 3'-0" INSIDE SHOULDER FROM STA. 243+00 TO STA. 248+31 TO BE BUILT IN PHASE 3. PROVIDE SIGNAGE ON S.B. I-71 AS PER SCD MT-98.21

RAMP D - PHASE 3

SHIFT TRAFFIC ON RAMP D TO THE OUTSIDE THE PAVEMENT COMPLETED IN PHASE 2 AS SHOWN ON SHEETS ___ AND CONSTRUCT REMAINING 3'-0" INSIDE FULL-DEPTH SHOULDER FROM STA 243+00 TO 248+31. REMOVE PAVEMENT FOR MOT. PROVIDE SIGNAGE ON N.B. I-71 AS PER SCD MT-98.28. INSTALL TEMPORARY SIGNAL AT RAMP D AND SR 435 AS DETAILED ON SHEET P. 66 – P. 67.

NO WORK SHALL BE PERFORMED AND THE SAME NUMBER OF LANES AS WERE AVAILABLE AT THE START OF THE PROJECT SHALL BE OPEN TO TRAFFIC DURING THE FOLLOWING DESIGNATED HOLIDAYS OR SPECIAL EVENTS:

- HOLIDAYS :
- NEW YEAR'S (OBSERVED) LABOR DAY
- ~~TOTAL SOLAR ECLIPSE (4/8/24)~~ GENERAL/REGULAR ELECTION DAY (NOV.)
- MEMORIAL DAY THANKSGIVING
- FOURTH OF JULY (OBSERVED) CHRISTMAS (OBSERVED)

THE PERIOD OF TIME THAT THE LANES ARE TO BE OPEN DEPENDS ON THE DAY OF THE WEEK ON WHICH THE HOLIDAY FALLS. THE FOLLOWING SCHEDULE SHALL BE USED TO DETERMINE THIS PERIOD:

DAY OF HOLIDAY OR SPECIAL EVENT	TIMES ALL LANES MUST BE OPEN TO TRAFFIC
SUNDAY	12:00 NOON FRIDAY THROUGH 6:00 AM MONDAY
MONDAY	12:00 NOON FRIDAY THROUGH 6:00 AM TUESDAY
MONDAY (TOTAL SOLAR ECLIPSE)	12:00 NOON MONDAY THROUGH 6:00 AM WEDNESDAY
TUESDAY	5:00 AM TUESDAY THROUGH 12:00 AM WEDNESDAY
TUESDAY (GEN./REG.ELECTION)	12:00 NOON TUESDAY THROUGH 6:00 AM THURSDAY
WEDNESDAY	12:00 NOON WEDNESDAY THROUGH 6:00 AM FRIDAY
THURSDAY	6:00 AM WEDNESDAY THROUGH 6:00 AM MONDAY
THANKSGIVING	12:00 NOON THURSDAY THROUGH 6:00 AM MONDAY
FRIDAY	12:00 NOON THURSDAY THROUGH 6:00 AM MONDAY
SATURDAY	12:00 NOON FRIDAY THROUGH 6:00 AM MONDAY

NEWLY CONSTRUCTED LANE ADDITIONS, ONCE COMPLETED AND INITIALLY OPENED TO TRAFFIC, SHALL BE OPEN TO TRAFFIC DURING ALL SUBSEQUENT DESIGNATED HOLIDAYS AND SPECIAL EVENTS, AND RELATED PERIODS OF TIME, SPECIFIED ABOVE. NO EXTENSIONS OF TIME SHALL BE GRANTED FOR DELAYS IN MATERIAL DELIVERIES, UNLESS SUCH DELAYS ARE INDUSTRY WIDE, OR FOR LABOR STRIKES, UNLESS SUCH STRIKES ARE AREA WIDE. SHOULD THE CONTRACTOR FAIL TO MEET ANY OF THESE REQUIREMENTS, THE CONTRACTOR SHALL BE ASSESSED A DISINCENTIVE PER THE LANE VALUE CONTRACT ON SHEET P.9.

LENGTH AND DURATION OF LANE CLOSURES AND RESTRICTIONS SHALL BE AT THE APPROVAL OF THE ENGINEER. IT IS THE INTENT TO MINIMIZE THE IMPACT TO THE TRAVELING PUBLIC. LANE CLOSURES OR RESTRICTIONS OVER SEGMENTS OF THE PROJECT IN WHICH NO WORK IS ANTICIPATED WITHIN A REASONABLE TIME FRAME, AS DETERMINED BY THE ENGINEER, SHALL NOT BE PERMITTED. THE LEVEL OF UTILIZATION OF MAINTENANCE OF TRAFFIC DEVICES SHALL BE COMMENSURATE WITH THE WORK IN PROGRESS.

ALL WORK AND TRAFFIC CONTROL DEVICES SHALL BE IN ACCORDANCE WITH C&MS 614 AND OTHER APPLICABLE PORTIONS OF THE SPECIFICATIONS, AS WELL AS THE OHIO MANUAL OF UNIFORM TRAFFIC CONTROL DEVICES. PAYMENT FOR ALL LABOR, EQUIPMENT AND MATERIALS SHALL BE INCLUDED IN THE LUMP SUM CONTRACT PRICE FOR ITEM 614, MAINTAINING TRAFFIC.

COORDINATION BETWEEN CONTRACTORS

COORDINATION WILL BE REQUIRED WITH ADJACENT ODOT PROJECTS. ODOT WILL HAVE MULTIPLE ONGOING PROJECTS IN THE AREA, INCLUDING BUT NOT LIMITED TO:

- FAY-71-0.00, PID 112747
- CLI-729-2.85 AND VARIOUS, PID 77922

THE CONTRACTOR MUST COORDINATE FULL-CLOSURES AND SIGNIFICANT MOT IMPACTS WITH THE ENGINEER & CONTRACTOR(S) FOR ALL ADJACENT PROJECTS.

Add additional language from this note.

NOTIFICATION OF TRAFFIC RESTRICTIONS

THROUGHOUT THE DURATION OF THE PROJECT, THE CONTRACTOR SHALL NOTIFY THE PROJECT ENGINEER IN WRITING OF ALL TRAFFIC RESTRICTIONS AND UPCOMING MAINTENANCE OF TRAFFIC CHANGES. THE CONTRACTOR SHALL ENSURE THE WRITTEN NOTIFICATION IS SUBMITTED IN A TIMELY MANNER TO ALLOW THE PROJECT ENGINEER TO MEET THE REQUIRED TIME FRAMES SET FORTH IN THE TABLE BELOW TO INFORM SPECIAL HAULING (HAULING.PERMITS@DOT.OHIO.GOV) AND THE DISTRICT PUBLIC INFORMATION OFFICE (PIO). THIS NOTIFICATION SHALL BE RECEIVED BY THE PROJECT ENGINEER PRIOR TO THE PHYSICAL SETUP OF ANY APPLICABLE SIGNS OR MESSAGE BOARDS. INFORMATION SHALL INCLUDE BUT IS NOT LIMITED TO ALL CONSTRUCTION ACTIVITIES THAT IMPACT OR INTERFERE WITH TRAFFIC AND SHALL LIST THE SPECIFIC LOCATION, TYPE OF WORK, ROAD STATUS, DATE AND TIME OF RESTRICTION, DURATION OF RESTRICTION, NUMBER OF LANES MAINTAINED, NUMBER OF LANES CLOSED, DETOUR ROUTES IF APPLICABLE, AND ANY OTHER INFORMATION REQUESTED BY THE PROJECT ENGINEER.

NOTIFICATION TIME FRAME TABLE			
ITEM	DURATION OF CLOSURE	NOTIFICATION DUE TO DISTRICT 6 PIO	SIGN DISPLAYED TO PUBLIC
RAMP & ROAD CLOSURES	>=2 WEEKS	21 CALENDAR DAYS PRIOR TO CLOSURE	14 CALENDAR DAYS PRIOR TO CLOSURE
	> 12 HOURS & < 2 WEEKS	14 CALENDAR DAYS PRIOR TO CLOSURE	7 CALENDAR DAYS PRIOR TO CLOSURE
	<=12 HOURS	4 CALENDAR DAYS PRIOR TO CLOSURE	2 CALENDAR DAYS PRIOR TO CLOSURE
LANE CLOSURES & RESTRICTIONS	>=2 WEEKS	14 CALENDAR DAYS PRIOR TO CLOSURE	
	< 2 WEEKS	5 CALENDAR DAYS PRIOR TO CLOSURE	
START OF CONSTRUCTION & TRAFFIC PATTERN CHANGES	N/A	14 CALENDAR DAYS PRIOR TO IMPLEMENTATION	

WRECKER AND EMERGENCY VEHICLE ACCESS

THE DBT SHALL MAKE PROVISIONS TO ASSIST IN THE ACCESS OF WRECKERS AND EMERGENCY VEHICLES THROUGHOUT THE WORK ZONE. THIS MAY INCLUDE, BUT NOT LIMITED TO, PROVIDING FLAGGERS OR REMOVING SECTIONS OF BARRIER TO ALLOW EMERGENCY VEHICLES AND WRECKER TO MOVE THROUGH PORTIONS OF THE WORK ZONE TO REACH ACCIDENTS AND/OR BREAKDOWNS. THE INTENT IS TO MINIMIZE EXTENDED DELAYS TO THE TRAVELLING PUBLIC AND TO PROVIDE QUICKER RESPONSE TIMES FOR WRECKERS AND EMERGENCY VEHICLES.

NOTIFICATION OF CONSTRUCTION INITIATION

AT LEAST FOURTEEN DAYS PRIOR TO STARTING INITIAL CONSTRUCTION ACTIVITIES, THE DBT SHALL ADVISE THE DISTRICT 6 PUBLIC INFORMATION OFFICE VIA EMAIL AT D06.PIO@DOT.OHIO.GOV, THE DISTRICT WORK ZONE TRAFFIC MANAGER VIA EMAIL AT D06.MOT@DOT.OHIO.GOV AND THE CENTRAL OFFICE SPECIAL HAUL PERMITS SECTION BY FAX AT (614)728-4099 OF THE ANTICIPATED START DATE OF ANY CONSTRUCTION ACTIVITIES INCLUDING BUT NOT LIMITED TO THE PLACING OF WORK ZONE SIGNS. THE NOTIFICATION SHALL ALSO INCLUDE THE PROJECT NUMBER, PID, NAME AND PHONE NUMBER OF THE DBT, A POINT OF CONTACT AND THE ANTICIPATED IMPACT ON TRAFFIC. THE DBT WILL IMMEDIATELY INFORM THE DISTRICT PUBLIC INFORMATION OFFICE AND THE DISTRICT WORK ZONE TRAFFIC MANAGER OF ANY AND ALL DELAYS AND/OR CHANGES REGARDING THE CONSTRUCTION INITIATION DATE.

SHORT DURATION RAMP CLOSURES

FOR THE PURPOSE OF PERFORMING THE REQUIRED WORK, RAMPS MAY BE CLOSED FOR SHORT DURATIONS AND DETOURED IN ACCORDANCE WITH THE RAMP CLOSURE TABLE IF APPROVED BY THE ENGINEER. RAMP CLOSURES ARE SUBJECT TO A DISINCENTIVE OF \$50 PER MINUTE FOR EACH MINUTE EXCEEDING THE ALLOWABLE CLOSURE DURATION.

FOR ALL RAMP CLOSURES LASTING MORE THAN 12 HOURS BUT LESS THAN 60 HOURS, THE CONTRACTOR SHALL PROVIDE THE FOLLOWING:

-A MINIMUM OF TWO PORTABLE CHANGEABLE MESSAGE SIGNS (PCMS) PLACED, AS DIRECTED BY THE ENGINEER, TO WARN DRIVERS OF THE CLOSURE AND TO PROVIDE THE DESIGNATED DETOUR ROUTE.

-POSITIVE GUIDANCE ALONG THE DETOUR ROUTE WITH DETOUR SIGNS (M4-9 SERIES).

FOR ALL SERVICE RAMP CLOSURES LASTING LESS THAN 12 HOURS, THE CONTRACTOR SHALL PROVIDE THE FOLLOWING:

-A MINIMUM OF TWO PORTABLE CHANGEABLE MESSAGE SIGNS (PCMS) PLACED, AS DIRECTED BY THE ENGINEER, TO WARN DRIVERS OF THE CLOSURE AND TO PROVIDE THE DESIGNATED DETOUR ROUTE. WHEN CLOSING ENTRANCE RAMPS, CORRESPONDING LEAD

RAMP CLOSURES FOR CONCRETE PAVEMENT TIE-IN

THE CONTRACTOR SHALL BE PERMITTED ONE "WEEKEND" CLOSURE PER RAMP BEING RECONSTRUCTED OR WIDENED WITH CONCRETE PAVEMENT (RAMP D) TO TIE INTO THE MAINLINE PAVEMENT. "WEEKEND" CLOSURE IS DEFINED AS A FULL CLOSURE OF THE RAMP FROM 10PM FRIDAY TO 5AM MONDAY (55 HOURS TOTAL).

RAMP CLOSURE RESTRICTIONS

US Route 35 in Fayette County					
Secondary Route: State Route 435 SLM along 35:					
RAMP DESIGNATION	MOVEMENT	NO CLOSURES ALLOWED		DETOUR ROUTES	
		MON-FRI	SAT-SUN	PRIMARY DETOUR ROUTE	SECONDARY DETOUR ROUTE
C	SR-435 to US-35 EB	5AM-10PM	6AM-10PM	SR-435 WB to US-35 WB to SR-72 SB to US-35 EB	SR-435 EB to Old US-35* EB to Palmer Rd WB to US-35 EB
D	US-35 WB to SR-435	5AM-10PM	6AM-10PM	US-35 WB to SR-72 SB to US-35 EB to SR-435	US-35 WB to Old US-35* WB to SR-435

RAMP NAME	RESTRICTED ACTIVITY	ALLOWABLE DURATION	DISINCENTIVE (AMOUNT PER CALENDAR DAY THE RESTRICTION REMAINS IN PLACE BEYOND ALLOWABLE DURATION SPECIFIED)
RAMP D	LANE & SHOULDER WIDTH REDUCTION	60 DAYS	\$5,000/DAY

LANE CLOSURE RESTRICTIONS

LANE VALUE CONTRACT TABLE						
SECTION (SLM)	EXISTING NUMBER OF LANES PER DIRECTION	LANE CLOSURES ARE NOT PERMITTED:				DISINCENTIVE AMOUNTS PER MINUTE
		Lane Reduction	Mon to Fri	Sat	Sun	
FAY-435						
Factory Shops Blvd (1.96) to US 35 (2.48) Eastbound	1	2 to 1	6AM-9AM & 4PM-6PM	6AM-9AM & 4PM-6PM	6AM-9AM & 4PM-6PM	\$100
US 35 (2.48) to SR 729 (3.97)	1	2 to 1	6AM-9AM & 4PM-6PM	6AM-9AM & 4PM-6PM	6AM-9AM & 4PM-6PM	\$25
FAY-435 (4.37) to SR 739 (17.23)	2	2 TO 1	No Restriction	No Restriction	No Restriction	\$25

FLOODLIGHTING

FLOODLIGHTING OF THE WORK SITE FOR OPERATIONS CONDUCTED DURING NIGHTTIME PERIODS SHALL BE ACCOMPLISHED SO THAT THE LIGHTS DO NOT CAUSE GLARE TO THE DRIVERS ON THE ROADWAY. TO ENSURE THE ADEQUACY OF THE FLOODLIGHT PLACEMENT, THE CONTRACTOR AND THE ENGINEER SHALL DRIVE THROUGH THE WORK SITE EACH NIGHT WHEN THE LIGHTING IS IN PLACE AND OPERATIVE PRIOR TO COMMENCING ANY WORK. IF GLARE IS DETECTED, THE LIGHT PLACEMENT AND SHIELDING SHALL BE ADJUSTED TO THE SATISFACTION OF THE ENGINEER BEFORE WORK PROCEEDS.

PAYMENT FOR ALL LABOR, EQUIPMENT AND MATERIALS SHALL BE INCLUDED IN THE LUMP SUM CONTRACT PRICE FOR ITEM 614, MAINTAINING TRAFFIC.

DUST CONTROL

THE CONTRACTOR SHALL FURNISH AND APPLY WATER FOR DUST CONTROL AS DIRECTED BY THE ENGINEER.

TRENCH FOR WIDENING

TRENCH EXCAVATION FOR BASE WIDENING SHALL BE ONLY ON ONE SIDE OF THE PAVEMENT AT A TIME. THE OPEN TRENCH SHALL BE ADEQUATELY MAINTAINED AND PROTECTED WITH DRUMS OR BARRICADES AT ALL TIMES. PLACEMENT OF PROPOSED SUBBASE AND BASE MATERIAL SHALL FOLLOW AS CLOSELY AS POSSIBLE BEHIND EXCAVATION OPERATIONS. THE LENGTH OF WIDENING TRENCH WHICH IS OPEN AT ANY ONE TIME SHALL BE HELD TO A MINIMUM AND SHALL AT ALL TIMES BE SUBJECT TO APPROVAL OF THE ENGINEER.

MAINTENANCE OF TRAFFIC (SIGNAL/FLASHER INSTALLATION)

THE CONTRACTOR SHALL BE RESPONSIBLE FOR MAINTAINING TRAFFIC SIGNAL/FLASHER INSTALLATIONS WITHIN THE PROJECT UNDER THE FOLLOWING CONDITIONS:

1. EXISTING SIGNAL/FLASHER INSTALLATIONS WHICH THE APPROVED PLANS REQUIRE THE CONTRACTOR TO ADJUST, MODIFY, ADD ONTO OR REMOVE, OR WHICH THE CONTRACTOR ACTUALLY ADJUSTS, MODIFIES OR OTHERWISE DISTURBS: THE CONTRACTOR SHALL BE RESPONSIBLE FOR THE ENTIRE INSTALLATION (AT AN INTERSECTION) FROM THE TIME THE CONTRACTOR'S OPERATIONS FIRST DISTURB THE INSTALLATION UNTIL THE INSTALLATION HAS BEEN SUBSEQUENTLY REMOVED OR MODIFIED AND THE WORK IS ACCEPTED.

2. NEW OR REUSED SIGNAL/FLASHER INSTALLATIONS OR DEVICES INSTALLED BY THE CONTRACTOR: THE CONTRACTOR SHALL BE RESPONSIBLE FOR MAINTENANCE OF THESE FROM THE TIME OF INSTALLATION UNTIL THE WORK IS ACCEPTED.

THE CONTRACTOR SHALL CORRECT AS QUICKLY AS POSSIBLE ALL OUTAGES OR MALFUNCTIONS. THE CONTRACTOR SHALL PROVIDE THE MAINTAINING AGENCY AND THE PROJECT ENGINEER SUCH ADDRESSES AND PHONE NUMBERS WHERE HIS MAINTENANCE FORCES CAN BE CONTACTED. THE CONTRACTOR SHALL PROVIDE ONE OR MORE PERSONS TO RECEIVE ALL CALLS AND DISPATCH THE NECESSARY MAINTENANCE FORCES TO CORRECT OUTAGES. SUCH A PERSON OR PERSONS MAY BE USED TO PERFORM OTHER DUTIES AS LONG AS PROMPT ATTENTION IS GIVEN TO THESE CALLS AND A PERSON IS READILY AVAILABLE CONTINUOUSLY 24 HOURS A DAY, 7 DAYS A WEEK. ALL LAMP OUTAGES, CABLE OUTAGES, ELECTRICAL FAILURES, EQUIPMENT MALFUNCTIONS AND MISALIGNED SIGNAL HEADS SHALL BE CORRECTED TO THE SATISFACTION OF THE ENGINEER WITH THE SIGNAL BACK TO SERVICE WITHIN FOUR HOURS AFTER THE CONTRACTOR HAS BEEN NOTIFIED OF THE OUTAGE.

IN THE EVENT NEW SIGNALS ARE DAMAGED PRIOR TO ACCEPTANCE, ALL DAMAGED EQUIPMENT EXCEPT POLES AND CONTROL EQUIPMENT SHALL BE REPLACED BY THE CONTRACTOR TO THE SATISFACTION OF THE ENGINEER WITH THE SIGNAL BACK IN SERVICE WITHIN 8 HOURS AFTER THE CONTRACTOR'S NOTIFICATION OF THE OUTAGE. THE CONTRACTOR SHALL ARRANGE FOR FULL TRAFFIC CONTROL UNTIL THE SIGNAL IS BACK IN OPERATION. IF POLES AND/OR CONTROL EQUIPMENT ARE DAMAGED AND MUST BE REPLACED, THE CONTRACTOR SHALL MAKE TEMPORARY REPAIRS AS NECESSARY TO BRING THE SIGNAL BACK INTO FULL OPERATION WITHIN THE ALLOWED 8-HOUR PERIOD AND SHALL MAKE PERMANENT REPAIRS OR REPLACEMENT AS SOON THEREAFTER AS POSSIBLE.

NONE OF THE ABOVE SHALL BE CONSTRUED AS COLLECTIVE OR CONSECUTIVE OUTAGE TIME PERIODS AT ANY ONE LOCATION. THAT IS, WHERE MORE THAN ONE OUTAGE OCCURS AT ANY ONE LOCATION THEN THE ALLOTTED TIME LIMIT SHALL BE FOR THE WORST SINGLE OUTAGE.

WHERE OUTAGES ARE THE DIRECT RESULT OF A VEHICLE ACCIDENT THE RESPONSE OF THE CONTRACTOR SHALL BE AS OUTLINED ABOVE. THE CONTRACTOR SHALL BE RESPONSIBLE FOR COLLECTION OF ANY COMPENSATION FOR THIS WORK FROM THOSE PARTIES RESPONSIBLE FOR THE DAMAGE.

WHERE THE CONTRACTOR HAS FAILED TO, OR CANNOT RESPOND TO, AN OUTAGE OR SIGNAL EQUIPMENT MALFUNCTION, AT THESE LOCATIONS WITHIN HIS RESPONSIBILITY, WITHIN PERIODS AS SPECIFIED ABOVE, THE ENGINEER MAY INVOKE THE PROVISIONS OF SECTION 105.15 AND ANY SUBSEQUENT BILLINGS TO THE STATE OR APPROPRIATE MUNICIPALITY FOR POLICE SERVICES AND MAINTENANCE SERVICES BY STATE (OR MUNICIPAL) FORCES SHALL BE DEDUCTED FROM MONIES DUE OR TO BECOME DUE THE CONTRACTOR IN ACCORDANCE WITH PROVISIONS OF SECTION 105.15.

ANY VEHICULAR TRAFFIC SIGNAL HEAD, EITHER NEW OR EXISTING WHICH WILL BE OUT OF OPERATION SHALL BE COVERED IN THE MANNER DESCRIBED IN CMS 632.25.

THE CONTRACTOR SHALL MAINTAIN COMPLETE RECORDS OF MALFUNCTIONS INCLUDING:

- TIME OF NOTIFICATION OF MALFUNCTION;
- TIME OF WORK CREWS ARRIVAL TO CORRECT THE MALFUNCTION;
- ACTIONS TAKEN TO CORRECT THE MALFUNCTION, INCLUDING A LIST OF PARTS REPAIRED OR REPLACED;
- A DIAGNOSIS OF REASON FOR THE MALFUNCTION AND PROBABILITY OF REOCCURRENCE;
- TIME OF COMPLETION OF THE REPAIR AND SYSTEM RESTORED TO FULL SERVICE.
- A COPY OF THESE RECORDS SHALL BE PROVIDED TO THE ENGINEER WITHIN THREE (3) WORKING DAYS FOLLOWING COMPLETION OF EACH REPAIR.

TEMPORARY SIGNAL VEHICLE DETECTION AND MAINTENANCE

THE CONTRACTOR SHALL PROVIDE VEHICLE DETECTION IN ALL M.O.T. PHASES AT THE EXISTING TRAFFIC SIGNALS. THE CONTRACTOR SHALL ENSURE THAT THE EXISTING DETECTION IS OPERATING AND MAINTAINED BY RECONFIGURING THE DETECTION UNITS ACCORDINGLY DURING ALL CONSTRUCTION PHASES. RADAR VEHICLE DETECTION EXISTS AT THE EXISTING SIGNALS. IF VEHICLE DETECTION BECOMES UNAVOIDABLY OR UNEXPECTEDLY DISABLED OR IS SCHEDULED TO BE TEMPORARILY REMOVED DURING THE CONSTRUCTION PROJECT, THE CONTRACTOR SHALL IMMEDIATELY NOTIFY THE ENGINEER.

WORKSITE TRAFFIC SUPERVISOR

SUBJECT TO APPROVAL OF THE ENGINEER, THE CONTRACTOR SHALL EMPLOY AND IDENTIFY (SOMEONE OTHER THAN THE SUPERINTENDENT) A PREQUALIFIED WORKSITE TRAFFIC SUPERVISOR (WTS) BEFORE STARTING WORK IN THE FIELD. THE WTS SHALL BE TRAINED IN ACCORDANCE WITH CMS 614.03, SHALL HAVE SUCCESSFULLY COMPLETED ODOT ADMINISTERED WTS TESTING (AND RE-TESTING WHEN APPLICABLE) AND BE LISTED ON THE ODOT PREQUALIFIED WTS ROSTER. PREQUALIFICATION EXPIRES EVERY 5 YEARS. RE-TESTING SHALL BE SUCCESSFULLY REPEATED EVERY 5 YEARS TO REMAIN PREQUALIFIED.

THE NAME OF THE PREQUALIFIED WTS AND RELATED 24-HOUR CONTACT INFORMATION SHALL BE PROVIDED TO THE ENGINEER AT THE PRECONSTRUCTION CONFERENCE. IF THE DESIGNATED WTS WILL NOT BE AVAILABLE FULL TIME (24/7), THE CONTRACTOR MAY DESIGNATE AN ALTERNATE (SECONDARY) WTS TO BE AVAILABLE WHEN THE PRIMARY IS OFF DUTY; HOWEVER, THE PRIMARY WTS SHALL REMAIN THE POINT OF CONTACT AT ALL TIMES. ANY ALTERNATE (SECONDARY) WTS IS SUBJECT TO THE SAME TRAINING, PREQUALIFICATION AND OTHER REQUIREMENTS OUTLINED WITHIN THIS PLAN NOTE. AT ALL TIMES THE ENGINEER, OR ENGINEER'S REPRESENTATIVES, MUST BE INFORMED OF WHO THE PRIMARY WTS (AND SECONDARY WTS, IF APPLICABLE) IS AT THE CURRENT TIME.

THE WTS POSITION HAS THE PRIMARY RESPONSIBILITY OF IMPLEMENTING THE TRAFFIC MANAGEMENT PLAN (TMP), MONITORING THE SAFETY AND MOBILITY OF THE ENTIRE WORK ZONE, AND CORRECTING TEMPORARY TRAFFIC CONTROL (TTC) DEFICIENCIES FOR THE ENTIRE WORK ZONE. THE WTS, AND ALTERNATE WTS WHEN ON DUTY, SHALL HAVE SUFFICIENT AUTHORITY TO EFFECTIVELY CARRY OUT THE IDENTIFIED WTS RESPONSIBILITIES AND DUTIES. THE DUTIES OF THE WTS ARE AS FOLLOWS:

1. BE AVAILABLE ON A 24-HOUR PER DAY BASIS.
2. BE ON SITE FOR ALL EMERGENCY TTC NEEDS WITHIN ONE HOUR OF NOTIFICATION BY POLICE OR PROJECT STAFF, AND EFFECT CORRECTIVE MEASURES IMMEDIATELY ON EXISTING WORK ZONE TTC DEVICES.
3. ATTEND PRECONSTRUCTION MEETING AND ALL PROJECT MEETINGS WHERE TTC MANAGEMENT IS DISCUSSED.
4. BE AVAILABLE ON SITE FOR OTHER MEETINGS OR DISCUSSIONS WITH THE ENGINEER UPON REQUEST.
5. BE AWARE OF ALL EXISTING AND PROPOSED TTC OPERATIONS OF THE CONTRACTOR, SUBCONTRACTORS AND SUPPLIERS, AND ENSURE COORDINATION OCCURS BETWEEN THEM TO ELIMINATE CONFLICTING TEMPORARY AND/OR PERMANENT TRAFFIC CONTROL.
6. COORDINATE PROJECT ACTIVITIES WITH ALL LAW ENFORCEMENT OFFICERS (LEOS). THE WTS SHALL ALSO BE THE MAIN CONTACT PERSON WITH THE LEOS WHILE LEOS ARE ON THE PROJECT.
7. COORDINATE AND FACILITATE MEETINGS WITH ODOT PERSONNEL, LEOS AND OTHER APPLICABLE ENTITIES BEFORE EACH PLAN PHASE SWITCH TO DISCUSS THE WORK ZONE TTC FOR IMPLEMENTING THE PHASE SWITCH. SUBMIT A WRITTEN DETAIL OF MOT OPERATIONS AND SCHEDULE OF EVENTS TO IMPLEMENT THE SWITCH BETWEEN PHASE PLANS TO THE ENGINEER 5 CALENDAR DAYS PRIOR TO THIS MEETING.

8. BE PRESENT, ON SITE FOR, AND INVOLVED WITH, EACH TTC SET UP/TAKE DOWN AND EACH PHASE CHANGE IN ACCORDANCE WITH CMS 614.03.
9. ON A CONTINUAL BASIS ENSURE THAT THE TTC ZONE AND ALL RELATED DEVICES ARE INSTALLED, MAINTAINED AND REMOVED IN COMPLIANCE WITH THE CONTRACT DOCUMENTS.
10. ON A CONTINUAL BASIS FACILITATE CORRECTIVE ACTION(S) NECESSARY TO BRING DEFICIENT TTC ZONES AND ALL RELATED DEVICES INTO COMPLIANCE WITH CONTRACT DOCUMENTS IN THE TIMEFRAME DETERMINED BY THE ENGINEER.
11. INSPECT, EVALUATE, PROPOSE NECESSARY MODIFICATIONS TO, AND DOCUMENT THE EFFECTIVENESS OF, THE TTC DEVICES AND TRAFFIC OPERATIONS ON A DAILY BASIS (7 DAYS A WEEK). IN ADDITION, PERFORM ONE WEEKLY NIGHT INSPECTION OF THE WORK ZONE SETUP FOR DAYTIME WORK OPERATIONS; AND ONE DAYTIME INSPECTION PER WEEK FOR NIGHTTIME PROJECTS. THIS SHALL INCLUDE (BUT NOT BE LIMITED TO) DOCUMENTATION ON THE FOLLOWING PROJECT EVENTS:
 - A. INITIAL TTC SETUP (DAY AND NIGHT REVIEW).
 - B. DAILY TTC SETUP AND REMOVAL.
 - C. WHEN CONSTRUCTION STAGING CAUSES A CHANGE IN THE TTC SETUP.
 - D. CRASH OCCURRENCES WITHIN THE CONSTRUCTION AREA AND WITHIN THE INFLUENCE AREA(S) APPROACHING THE WORK ZONE.
 - E. REMOVAL OF TTC DEVICES AT THE END OF A PHASE OR PROJECT.
 - F. ALL OTHER EMERGENCY TTC NEEDS.

12. COMPLETE THE DEPARTMENT APPROVED (CA-D-8) WITHIN GOFORMZ AFTER EACH INSPECTION AS REQUIRED IN # 11 AND SUBMIT IT TO THE ENGINEER BY THE END OF THE WORKDAY IN WHICH THE INSPECTION OCCURRED. THE CA-D-8 INCLUDES A CHECKLIST OF ALL TTC MAINTENANCE ITEMS TO BE REVIEWED. CONTACT GOFORMZ.HELP@DOT.OHIO.GOV TO OBTAIN A USER ACCOUNT. ANY DEFICIENCIES OBSERVED SHALL BE NOTED ON THE CA-D-8, ALONG WITH RECOMMENDED OR COMPLETED CORRECTIVE ACTIONS AND THE DATES BY WHICH SUCH CORRECTIONS WERE, OR WILL BE, COMPLETED. A COPY OF THE CURRENT CA-D-8 DOCUMENT CAN BE FOUND ON THE OFFICE OF CONSTRUCTION ADMINISTRATION'S INSPECTION FORMS WEBSITE.

13. HAVE COPIES OF THE ODOT TEMPORARY TRAFFIC CONTROL MANUAL AND CONTRACT DOCUMENTS AVAILABLE AT ALL TIMES ON THE PROJECT.

THE DEPARTMENT WILL DEDUCT:

- A. THE PRORATED DAILY AMOUNT OF ITEM 614 MAINTAINING TRAFFIC FOR ANY DAY IN WHICH THE WTS FAILS TO PERFORM THE DUTIES SET FORTH ABOVE. THE PRORATED DAILY AMOUNT WILL BE EQUAL TO THE ORIGINAL BID AMOUNT FOR ITEM 614 MAINTAINING TRAFFIC DIVIDED BY THE DIFFERENCE BETWEEN THE ORIGINAL COMPLETION DATE AND THE FIRST DAY OF WORK, IN CALENDAR DAYS.
- B. 1% OF THE ORIGINAL BID AMOUNT FOR ITEM 614 MAINTAINING TRAFFIC FOR ANY DAY THAT A FAILURE TO PERFORM WTS DUTIES REOCCURS OR A TTC ISSUE IS IDENTIFIED IN THE FIELD AND IS NOT CORRECTED IN THE GIVEN TIMEFRAME PER THE ENGINEER. DEDUCTION B SHALL NOT APPLY TO SITUATIONS COVERED BY DEDUCTION C.

C. 1% OF THE ORIGINAL BID AMOUNT FOR ITEM 614 MAINTAINING TRAFFIC FOR ANY DAY THAT A LANE OR RAMP IS BLOCKED (FULLY OR PARTIALLY) WITHOUT TTC, AS DETERMINED BY THE ENGINEER. THIS DEDUCTION SHALL BE IN ADDITION TO ANY OTHER DISINCENTIVES ESTABLISHED FOR UNAUTHORIZED LANE USE.

FOR DAYS IN WHICH MORE THAN ONE DEDUCTION LISTED ABOVE OCCUR, THE HIGHEST DEDUCTION AMOUNT WILL APPLY.

IF THREE OR MORE TOTAL DAYS RESULT IN ISSUES DESCRIBED IN DEDUCTION B OR C ABOVE, THE PRIMARY WTS (AND ANY ALTERNATE WTS, IF APPLICABLE) SHALL BE IMMEDIATELY REMOVED FROM THE WORK IN ACCORDANCE WITH C&MS 108.05. UPON REMOVAL THE ENGINEER SHALL NOTIFY ODOT CENTRAL OFFICE (WTSPREQUALIFICATION@DOT.OHIO.GOV) TO REGISTER A REMOVAL AT THE PROJECT LEVEL AGAINST THE STATEWIDE PREQUALIFICATION FOR THE PRIMARY WTS (AND ALTERNATE WTS, IF APPLICABLE). ACCUMULATION OF THREE PROJECT LEVEL REMOVALS (FROM ANY PROJECTS STATEWIDE) SHALL CAUSE STATEWIDE DISQUALIFICATION FOR ANY FORMERLY PREQUALIFIED WTS. A WTS (AND ALTERNATE WTS, IF APPLICABLE) MAY BE IMMEDIATELY AND CONCURRENTLY REMOVED FROM THE WORK AT THE PROJECT LEVEL IN ACCORDANCE WITH C&MS 108.05 AND DISQUALIFIED STATEWIDE FROM THE ODOT PREQUALIFIED WTS ROSTER (REGARDLESS OF THE NUMBER OF PROJECT LEVEL REMOVALS), AS WELL AS BEING SUBJECT TO OTHER POTENTIAL CONSEQUENCES, IN CASES OF FALSIFIED, DISHONEST OR OTHERWISE UNETHICAL ACTIVITY OR DOCUMENTATION.

PAYMENT FOR THE ABOVE REQUIREMENTS, RESPONSIBILITIES AND DUTIES SHALL BE INCLUDED IN THE LUMP SUM PRICE BID FOR ITEM 614, MAINTAINING TRAFFIC.

ITEM 614, WORK ZONE RAISED PAVEMENT MARKER, AS PER PLAN

WORK ZONE RAISED PAVEMENT MARKERS, AS PER PLAN, AND THEIR INSTALLATION SHALL CONFORM TO C&MS 614 OR C&MS 621 AS SPECIFIED HEREIN.

RAISED PAVEMENT MARKERS IN USE DURING THE SNOW-PLOWING SEASON SHALL CONFORM TO 621.

RAISED PAVEMENT MARKERS IN USE DURING THE NON-SNOW-PLOW SEASON SHALL CONFORM TO EITHER 614 OR TO 621.

THE SNOW-PLOWING SEASON SHALL RUN FROM OCTOBER 31 THROUGH APRIL 1.

IF PROJECT DELAYS, NOT THE FAULT OF ODOT, CAUSE THE WORK TO EXTEND INTO THE SNOW-PLOWING SEASON, THE CONTRACTOR SHALL BE RESPONSIBLE FOR REPLACING WORK ZONE RAISED PAVEMENT MARKERS (WZRPMS) CONFORMING TO C&MS 614, WITH RAISED PAVEMENT MARKERS CONFORMING TO 621, AS DETERMINED BY THE ENGINEER, AT THE CONTRACTOR'S EXPENSE.

ITEM 614, WORK ZONE RAISED PAVEMENT MARKERS ON PERMANENT CONCRETE SURFACES

RAISED PAVEMENT MARKERS IN WORK ZONES, INSTALLED ON PERMANENT CONCRETE SURFACES, SHALL BE ITEM 614 WORK ZONE RAISED PAVEMENT MARKERS. WZRPMS ARE INTENDED FOR USE ONLY DURING THE NON-SNOW-PLOWING SEASON. WZRPMS SHALL NOT BE PROVIDED DURING THE SNOW- PLOWING SEASON.

THE SNOW-PLOWING SEASON SHALL RUN FROM OCTOBER 31 THROUGH APRIL 1.

WHERE A TEMPORARY ALIGNMENT WILL REMAIN IN USE THROUGH THE WINTER, THE WZRPMS SHALL BE REMOVED PRIOR TO THE BEGINNING OF THE SNOW-PLOWING SEASON AND REPLACED APPROXIMATELY APRIL 1, OR AS OTHERWISE DETERMINED BY THE ENGINEER.

THIS ITEM SHALL INCLUDE PURCHASE, INSTALLATION AND REMOVAL OF ITEM 614 WORK ZONE RAISED PAVEMENT MARKERS.

DESIGN AGENCY



DESIGNER

DPF

REVIEWER

DCJ MM-DD-YY

PROJECT ID

117955

SHEET TOTAL

P. 21 228

ITEM 614, WORK ZONE IMPACT ATTENUATOR FOR 24" WIDE HAZARDS (UNIDIRECTIONAL OR BIDIRECTIONAL)

THIS ITEM SHALL CONSIST OF FURNISHING AND INSTALLING A NON-GATING IMPACT ATTENUATOR. FURNISH AN IMPACT ATTENUATOR FROM THE OFFICE OF ROADWAY ENGINEERING'S APPROVED LIST FOR WORK ZONE IMPACT ATTENUATORS, FROM THE ROADWAY STANDARDS APPROVED PRODUCTS WEB PAGE.

INSTALLATION SHALL BE AT THE LOCATIONS SPECIFIED IN THE PLANS IN ACCORDANCE WITH THE MANUFACTURER'S SPECIFICATIONS.

THE CONTRACTOR SHALL REPAIR OR REPLACE A DAMAGED UNIT WITHIN 24 HOURS OF A DAMAGING IMPACT.

WHEN BIDIRECTIONAL DESIGNS ARE SPECIFIED, THE CONTRACTOR SHALL SUPPLY APPROPRIATE TRANSITIONS.

WHEN GATING IMPACT ATTENUATORS ARE DESIRED, THE CONTRACTOR SHALL SUBMIT DOCUMENTATION TO THE ENGINEER FOR ACCEPTANCE.

THE COST FOR THE ADDITIONAL BARRIER REQUIRED FOR A GATING IMPACT ATTENUATOR SHALL BE INCLUDED IN THE COST OF THE GATING IMPACT ATTENUATOR.

PAYMENT FOR THE ABOVE WORK SHALL BE MADE AT THE UNIT PRICE BID AND SHALL INCLUDE ALL LABOR, TOOLS, EQUIPMENT AND MATERIALS NECESSARY TO CONSTRUCT AND MAINTAIN A COMPLETE AND FUNCTIONAL IMPACT ATTENUATOR SYSTEM, INCLUDING ALL RELATED BACKUPS, TRANSITIONS, LEVELING PADS, HARDWARE AND GRADING, NOT SEPARATELY SPECIFIED, AS REQUIRED BY THE MANUFACTURER.

ITEM 614, PORTABLE CHANGEABLE MESSAGE SIGNS, AS PER PLAN

THE CONTRACTOR SHALL FURNISH, INSTALL, MAINTAIN AND REMOVE, WHEN NO LONGER NEEDED, A CHANGEABLE MESSAGE SIGN. THE SIGN SHALL BE OF A TYPE SHOWN ON A LIST OF APPROVED PCMS UNITS AVAILABLE ON THE OFFICE OF MATERIALS MANAGEMENT WEB PAGE. THE LIST CONTAINS CLASS A AND B UNITS WITH MINIMUM LEGIBILITY DISTANCES OF 800 FEET AND 650 FEET, RESPECTIVELY.

EACH SIGN SHALL BE TRAILER-MOUNTED AND EQUIPPED WITH A FUNCTIONAL DIMMING MECHANISM, TO DIM THE SIGN DURING DARKNESS, AND A TAMPER AND VANDAL PROOF ENCLOSURE. EACH SIGN SHALL BE PROVIDED WITH APPROPRIATE TRAINING AND OPERATION INSTRUCTIONS TO ENABLE ON-SITE PERSONNEL TO OPERATE AND TROUBLESHOOT THE UNIT. THE SIGN SHALL ALSO BE CAPABLE OF BEING POWERED BY AN ELECTRICAL SERVICE DROP FROM A LOCAL UTILITY COMPANY. THE PCMS SHALL BE DELINEATED IN ACCORDANCE WITH C&MS 614.03.

PLACEMENT, OPERATION, MAINTENANCE AND ALL ACTIVATION OF THE SIGNS BY THE CONTRACTOR SHALL BE AS DIRECTED BY THE ENGINEER. THE PCMS SHALL BE LOCATED IN A HIGHLY VISIBLE POSITION YET PROTECTED FROM TRAFFIC. THE CONTRACTOR SHALL, AT THE DIRECTION OF THE ENGINEER, RELOCATE THE PCMS TO IMPROVE VISIBILITY OR ACCOMMODATE CHANGED CONDITIONS. WHEN NOT IN USE, THE PCMS SHALL BE TURNED OFF. ADDITIONALLY, WHEN NOT IN USE FOR EXTENDED PERIODS OF TIME, THE PCMS SHALL BE TURNED AWAY FROM ALL TRAFFIC.

THE ENGINEER SHALL BE PROVIDED ACCESS TO EACH SIGN UNIT AND SHALL BE PROVIDED WITH APPROPRIATE TRAINING AND OPERATION INSTRUCTIONS TO ENABLE ODOT PERSONNEL TO OPERATE AND TROUBLESHOOT THE UNIT, AND TO REVISE SIGN MESSAGES, IF NECESSARY.

ALL MESSAGES TO BE DISPLAYED ON THE SIGN WILL BE PROVIDED BY THE ENGINEER. A LIST OF ALL REQUIRED PRE-PROGRAMMED MESSAGES WILL BE GIVEN TO THE CONTRACTOR AT THE PROJECT PRECONSTRUCTION CONFERENCE. THE SIGN SHALL HAVE THE CAPABILITY TO STORE UP TO 99 MESSAGES. MESSAGE MEMORY OR PRE-PROGRAMMED DISPLAYS SHALL NOT BE LOST AS A RESULT OF POWER FAILURES TO THE ON-BOARD COMPUTER. THE SIGN LEGEND SHALL BE CAPABLE OF BEING CHANGED IN THE FIELD. THREE-LINE PRESENTATION FORMATS WITH UP TO SIX MESSAGE PHASES SHALL BE SUPPORTED. PCMS FORMAT SHALL PERMIT THE COMPLETE MESSAGE FOR EACH PHASE TO BE READ AT LEAST TWICE.

THE PCMS SHALL CONTAIN AN ACCURATE CLOCK AND PROGRAMMING LOGIC WHICH WILL ALLOW THE SIGN TO BE ACTIVATED, DEACTIVATED OR MESSAGES CHANGED AUTOMATICALLY AT DIFFERENT TIMES OF THE DAY FOR DIFFERENT DAYS OF THE WEEK.

THE CONTRACTOR SHALL BE RESPONSIBLE FOR 24-HOUR-PER- DAY OPERATION AND MAINTENANCE OF THESE SIGNS ON THE PROJECT FOR THE DURATION OF THE PHASES WHEN THE PLAN REQUIRES THEIR USE.

THE CONTRACTOR SHALL MAINTAIN AT LEAST 4 PCMS FOR THE DURATION OF THE PROJECT.

DELINEATION OF PORTABLE AND PERMANENT BARRIER

BARRIER REFLECTORS AND OBJECT MARKERS SHALL BE INSTALLED ON ALL PORTABLE BARRIER (PB) USED FOR TRAFFIC CONTROL; AND, ON PERMANENT CONCRETE BARRIER (INCLUDING BRIDGE PARAPETS) LOCATED WITHIN 5 FEET OF THE EDGE OF THE ADJACENT TRAVEL LANE.

BARRIER REFLECTORS SHALL CONFORM TO C&MS 626, EXCEPT THAT THE SPACING SHALL BE AS PER TRAFFIC SCD MT-101.70. OBJECT MARKERS AND THEIR INSTALLATION SHALL CONFORM TO C&MS 614.03 AND SCD MT-101.70. WHEN THE PB CONTAINS GLARE SCREEN, ONE SET OF THREE VERTICAL STRIPES OF SHEETING SHALL BE CONSIDERED EQUIVALENT TO AN OBJECT MARKER, ONE-WAY.

DELINEATION OF TEMPORARY AND PERMANENT GUARDRAIL

BARRIER REFLECTORS SHALL BE INSTALLED ON ALL TEMPORARY GUARDRAIL USED FOR TRAFFIC CONTROL; AND, ON ALL PERMANENT GUARDRAIL LOCATED WITHIN 5 FEET OF THE EDGE OF THE ADJACENT TRAVEL LANE. BARRIER REFLECTORS SHALL CONFORM TO C&MS 626 AND THE SPACING SHALL BE APPROXIMATELY 50 FEET.

ITEM 614, LAW ENFORCEMENT OFFICER (WITH PATROL CAR) FOR ASSISTANCE DURING CONSTRUCTION OPERATIONS

USE OF LAW ENFORCEMENT OFFICERS (LEOS) BY CONTRACTORS OTHER THAN THE USES SPECIFIED BELOW WILL NOT BE PERMITTED AT PROJECT COST. LEOS SHOULD NOT BE USED WHERE THE ODOT INTENDS THAT FLAGGERS BE USED.

IN ADDITION TO THE REQUIREMENTS OF C&MS 614 AND THE ODOT, A UNIFORMED LEO WITH AN OFFICIAL PATROL CAR (CAR WITH TOP-MOUNTED EMERGENCY FLASHING LIGHTS AND COMPLETE MARKINGS OF THE APPROPRIATE LAW ENFORCEMENT AGENCY) SHALL BE PROVIDED FOR THE FOLLOWING TRAFFIC CONTROL TASKS:

DURING THE ENTIRE ADVANCE PREPARATION AND CLOSURE SEQUENCE WHERE COMPLETE BLOCKAGE OF TRAFFIC IS REQUIRED.

DURING A TRAFFIC SIGNAL INSTALLATION WHEN IMPACTING THE NORMAL FUNCTION OF THE SIGNAL OR THE FLOW OF TRAFFIC, OR WHEN TRAFFIC NEEDS TO BE DIRECTED THROUGH AN ENERGIZED TRAFFIC SIGNAL CONTRARY TO THE SIGNAL DISPLAY (E.G., DIRECTING MOTORISTS THROUGH A RED LIGHT).

IN ADDITION TO THE REQUIREMENT OF C&MS 614 AND THE ODOT, A UNIFORMED LEO WITH AN OFFICIAL PATROL CAR (CAR WITH TOP-MOUNTED EMERGENCY FLASHING LIGHTS AND COMPLETE MARKINGS OF THE APPROPRIATE LAW ENFORCEMENT AGENCY) SHOULD BE PROVIDED FOR THE FOLLOWING TRAFFIC CONTROL TASKS AS APPROVED BY THE ENGINEER:

FOR LANE CLOSURES: DURING INITIAL SET-UP PERIODS, TEAR DOWN PERIODS, SUBSTANTIAL SHIFTS OF A CLOSURE POINT OR WHEN NEW LANE CLOSURE ARRANGEMENTS ARE INITIATED FOR LONG-TERM LANE CLOSURES/SHIFTS (FOR THE FIRST AND LAST DAY OF MAJOR CHANGES IN TRAFFIC CONTROL SETUP).

FOR OPERATIONS WITHOUT POSITIVE PROTECTION OCCURRING WITHIN 10 FEET OF AN OPEN TRAVELED LANE THAT MEET ALL OF THE FOLLOWING CRITERIA:

- ON A MULTI-LANE DIVIDED INTERSTATE, OTHER FREEWAY OR EXPRESSWAY; AND
- AN AUTHORIZED SPEED LIMIT OF 45 MPH OR GREATER THAT IS IN EFFECT AT THE TIME OF THE OPERATION; AND,
- AADT OF 50,000 (OR AADT OF 30,000 WITH 25% OR HIGHER PERCENT TRUCKS)

"WITHOUT POSITIVE PROTECTION" MEANS USE OF DRUMS, CONES, SHADOW VEHICLE, ETC, WITHOUT PROTECTION FROM PORTABLE BARRIER OR OTHER RIGID BARRIER ALONG THE WORK AREA. THIS PHRASE DOES NOT APPLY TO CASES WHERE POSITIVE PROTECTION IS REQUIRED. MOBILE OPERATIONS ARE REGARDED AS "WITHOUT POSITIVE PROTECTION". FOR WORK ZONES USING A COMBINATION OF BARRIER AND TEMPORARY TRAFFIC CONTROL DEVICES (CONES, DRUMS, ETC), THE DESIGNATION SHALL BE BASED UPON THE TYPE OF DEVICES USED IN THE AREA THAT WORKERS ARE LOCATED.

IF MULTIPLE ACTIVE LOCALIZED QUALIFYING WORK AREAS OCCUR WITHOUT POSITIVE PROTECTION, PER MAINLINE TRAFFIC DIRECTION, PROVIDE A UNIFORMED LEO AND OFFICIAL PATROL CAR IN ADVANCE OF:

- THE FIRST ACTIVE WORK AREA THAT DRIVERS WILL ENCOUNTER; OR
- THE ACTIVE WORK AREA Laterally CLOSEst TO THE OPEN TRAVELED LANE; OR
- OTHER LOCATION AS APPROVED BY THE ENGINEER.

THE UNIFORMED LEO AND OFFICIAL PATROL CAR MAY RELOCATE AMONG THE LISTED LOCATIONS AS APPROPRIATE AS THE OPERATIONS PROCEED IN THE LOCALIZED QUALIFYING WORK AREAS.

IN GENERAL, LEOS SHOULD BE POSITIONED IN ADVANCE OF AND ON THE SAME SIDE AS THE LANE RESTRICTION (OR AT THE POINT OF ROAD CLOSURE), AND TO MANUALLY CONTROL TRAFFIC MOVEMENTS THROUGH SIGNALIZED INTERSECTIONS IN WORK ZONES.

LEOS SHOULD NOT FORGO THEIR TRAFFIC CONTROL RESPONSIBILITIES TO APPREHEND MOTORISTS FOR ROUTINE TRAFFIC VIOLATIONS. HOWEVER, IF A MOTORIST'S ACTIONS ARE CONSIDERED TO BE RECKLESS, THEN PURSUIT OF THE MOTORIST IS APPROPRIATE.

THE LEOS WORK AT THE DIRECTION OF THE CONTRACTOR. THE CONTRACTOR IS RESPONSIBLE FOR SECURING THE SERVICES OF THE LEOS WITH THE APPROPRIATE AGENCIES AND COMMUNICATING THE INTENTIONS OF THE PLANS WITH RESPECT TO DUTIES OF THE LEOS. THE ENGINEER SHALL HAVE FINAL CONTROL OVER THE LEOS' DUTIES AND PLACEMENT, AND WILL RESOLVE ANY ISSUES THAT MAY ARISE BETWEEN THE TWO PARTIES.

ENSURE PROVIDED LEOS HAVE BEEN TRAINED APPROPRIATE TO THE JOB DECISIONS THEY ARE REQUIRED TO MAKE WHILE ON THE PROJECT, IN ACCORDANCE WITH C&MS 614.03.

THE LEO SHALL REPORT IN TO THE CONTRACTOR PRIOR TO THE START OF THE SHIFT, IN ORDER TO RECEIVE INSTRUCTIONS REGARDING SPECIFIC WORK ASSIGNMENTS DURING HIS/HER SHIFT. THE LEO IS EXPECTED TO STAY AT THE PROJECT SITE FOR THE ENTIRE DURATION OF HIS/HER SHIFT. THE LEO SHALL REPORT TO THE CONTRACTOR AT THE END OF HIS/HER SHIFT. SHOULD IT BE NECESSARY TO LEAVE THE PROJECT SITE, THE LEO SHALL NOTIFY THE ENGINEER. THE CONTRACTOR SHALL PROVIDE THE LEO WITH A TWO-WAY COMMUNICATION DEVICE THAT SHALL BE RETURNED TO THE CONTRACTOR AT THE END OF HIS/HER SHIFT.

DESIGN AGENCY



DESIGNER

DPF

REVIEWER





DCJ MM-DD-YY

PROJECT ID



117955





SHEET TOTAL

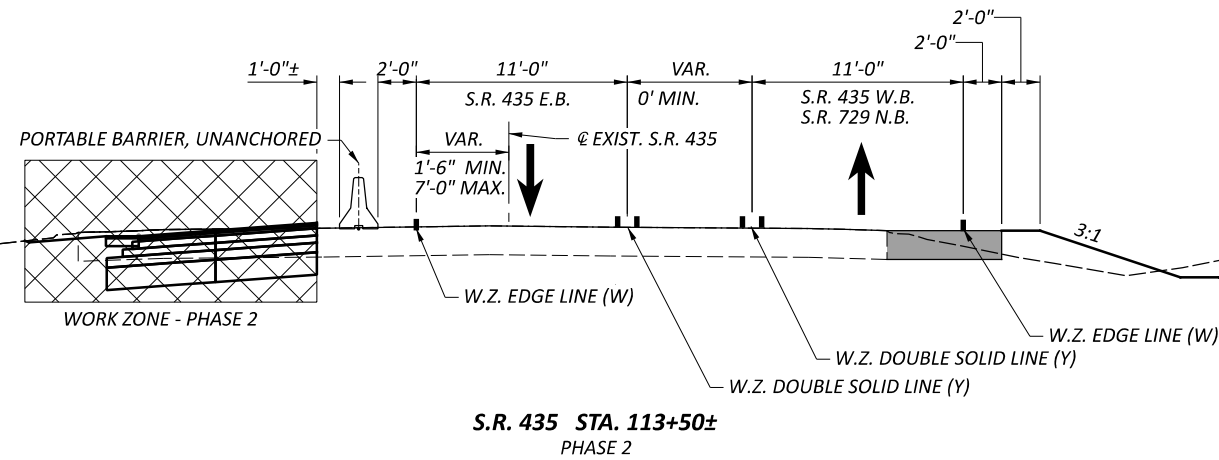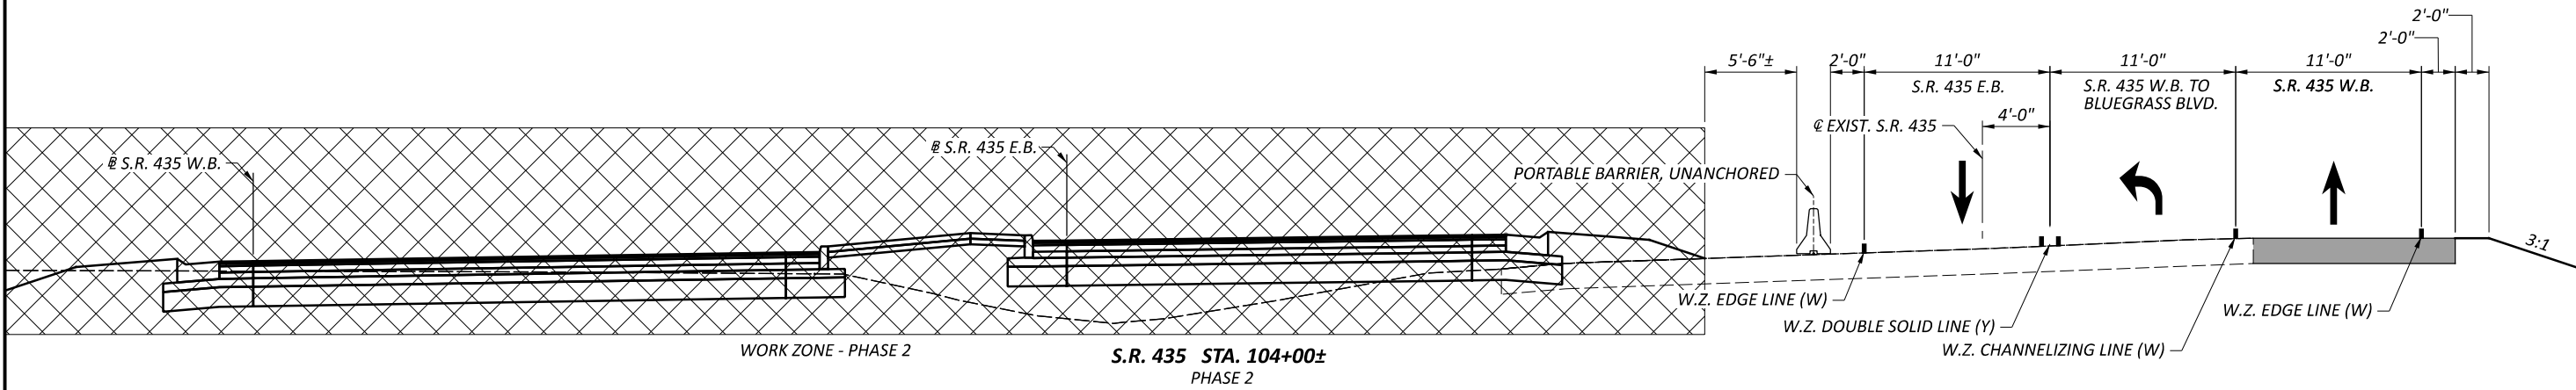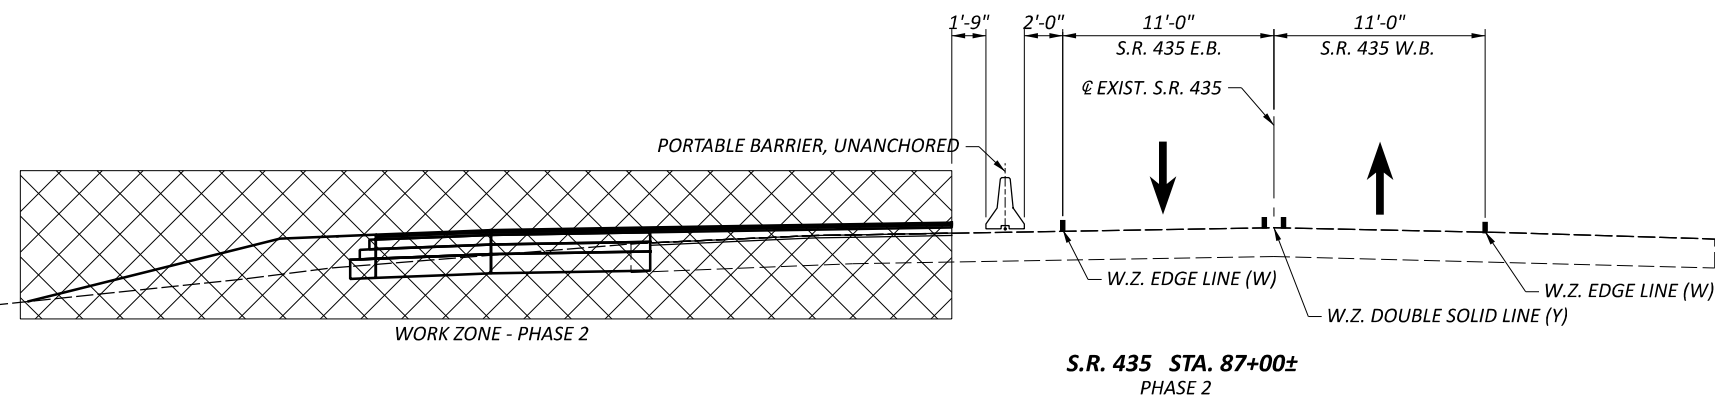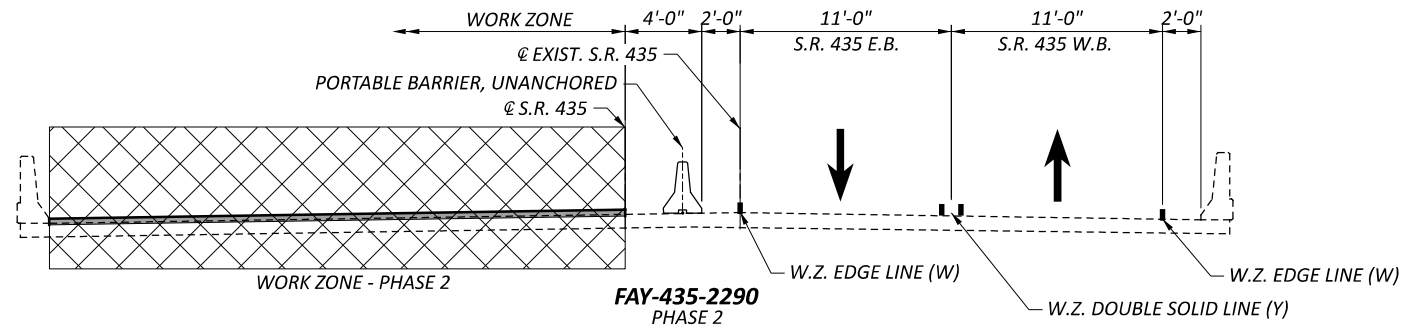P. 22 | 228



LEGEND

-  WORK ZONE
-  PAVEMENT FOR M.O.T., CLASS A

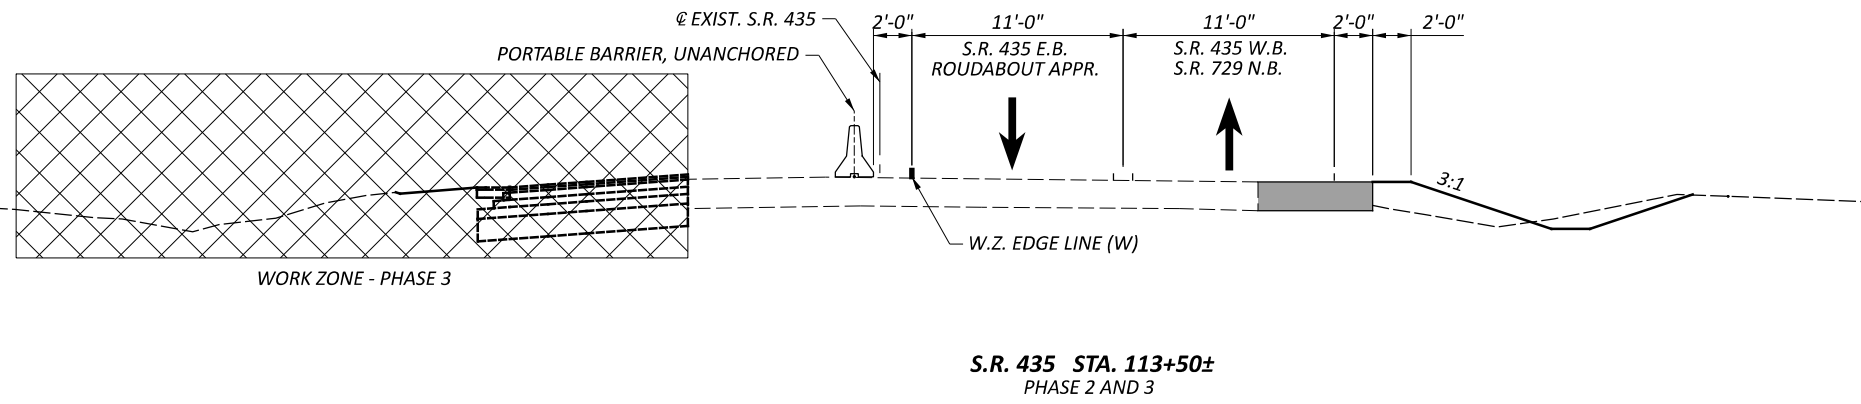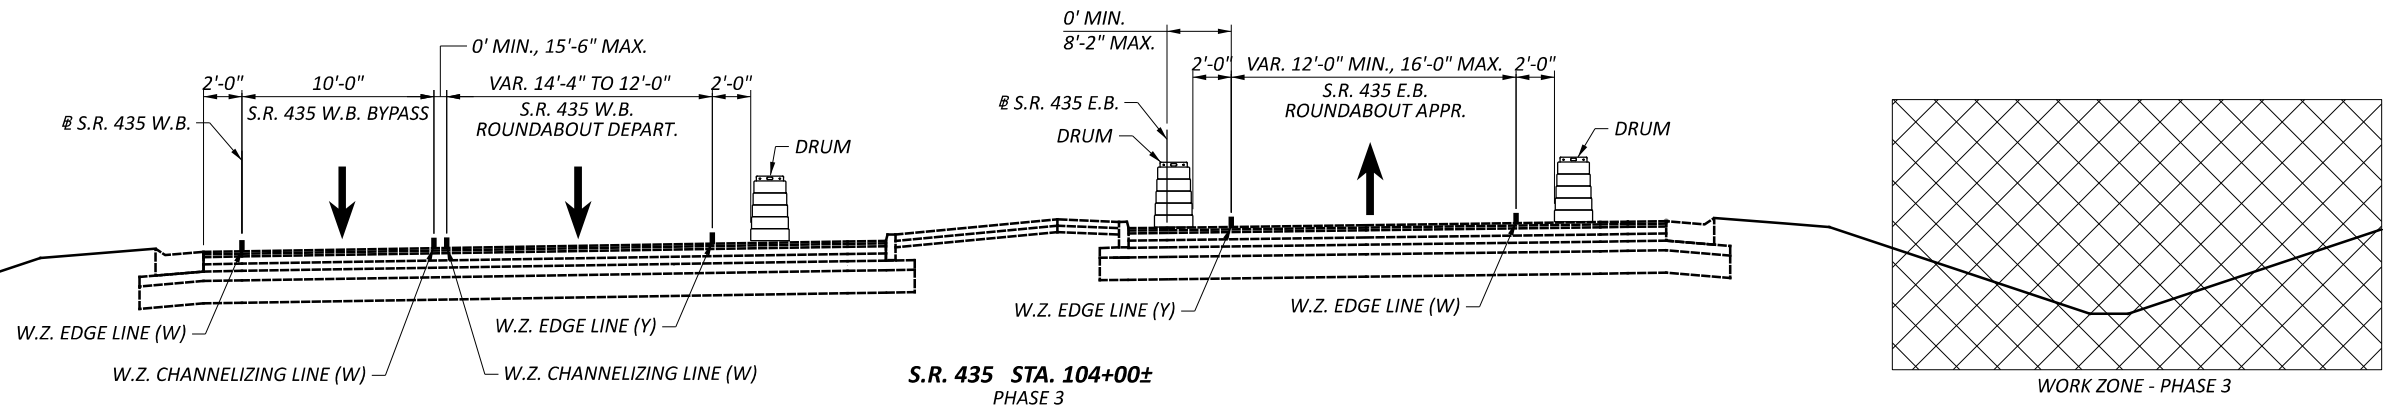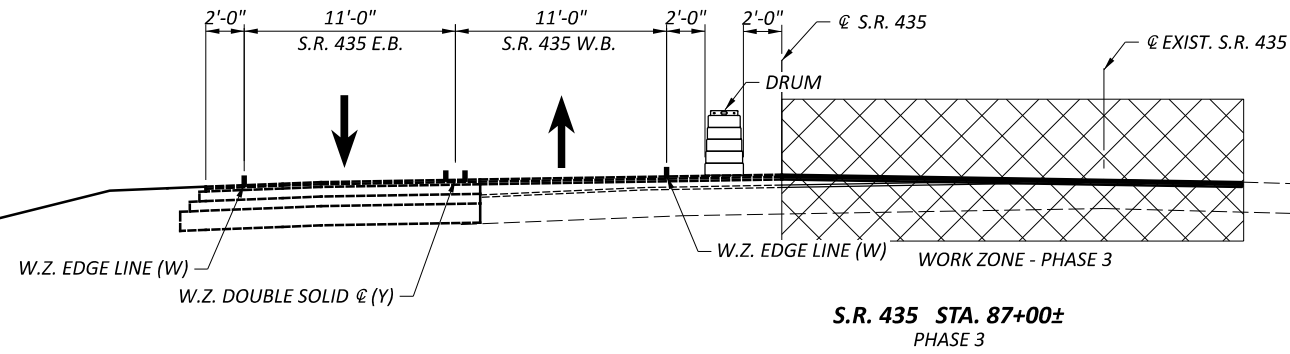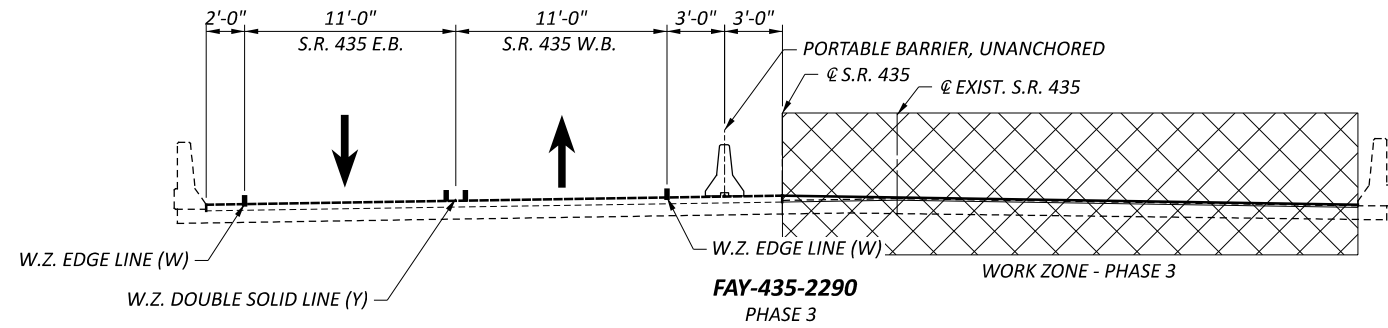



LEGEND


- WORK ZONE
- PAVEMENT FOR M.O.T., CLASS A

DESIGN AGENCY	
Palmer ENGINEERING	
8350 E. KEMPER RD. SUITE B CINCINNATI, OH 45249 513-469-1600	
DESIGNER	DPF
REVIEWER	DCJ MM-DD-YY
PROJECT ID	117955
SHEET	TOTAL
P. 24	228

LEGEND

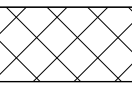 WORK ZONE



 PAVEMENT FOR M.O.T., CLASS A

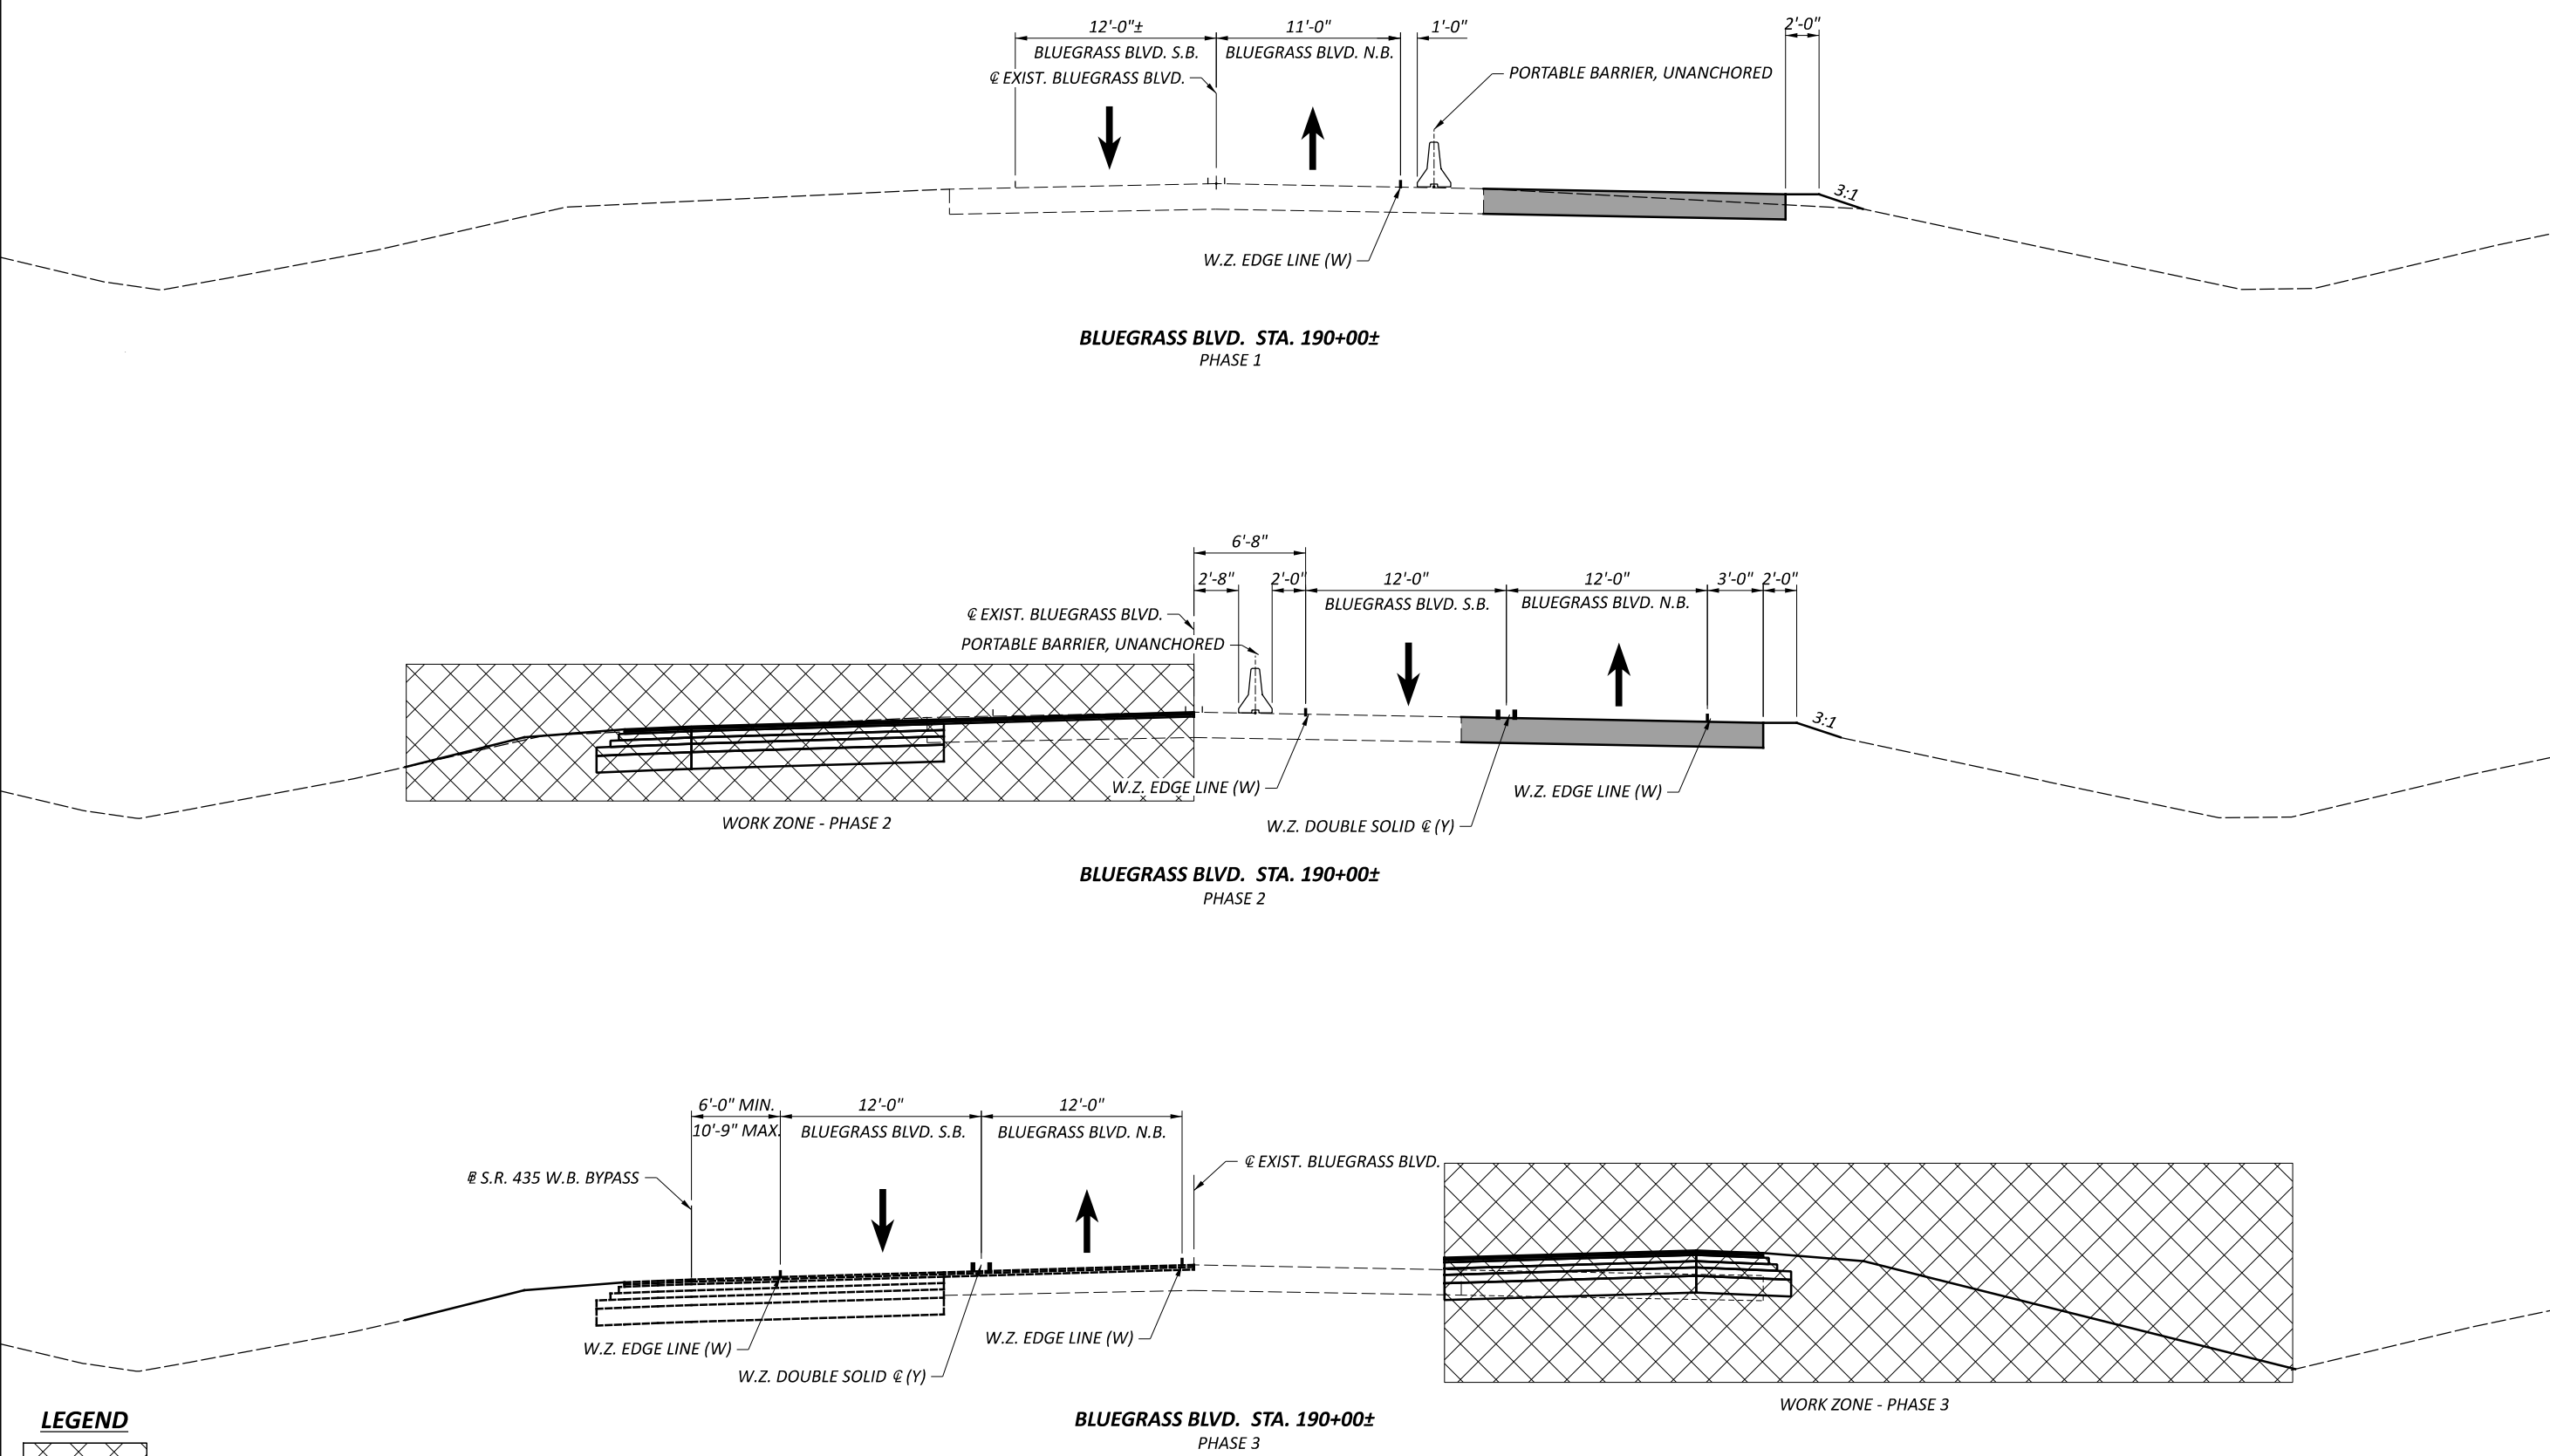


MAINTENANCE OF TRAFFIC (BU-5)
 TYPICAL SECTIONS - BLUEGRASS BLVD - PHASES 1 - 3


DESIGN AGENCY	Palmer ENGINEERING
DESIGNER	DPF
REVIEWER	DCJ MM-DD-YY
PROJECT ID	117955
SHEET TOTAL	P. 25 228

LEGEND

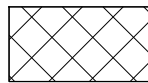-  WORK ZONE
-  PAVEMENT FOR M.O.T., CLASS A

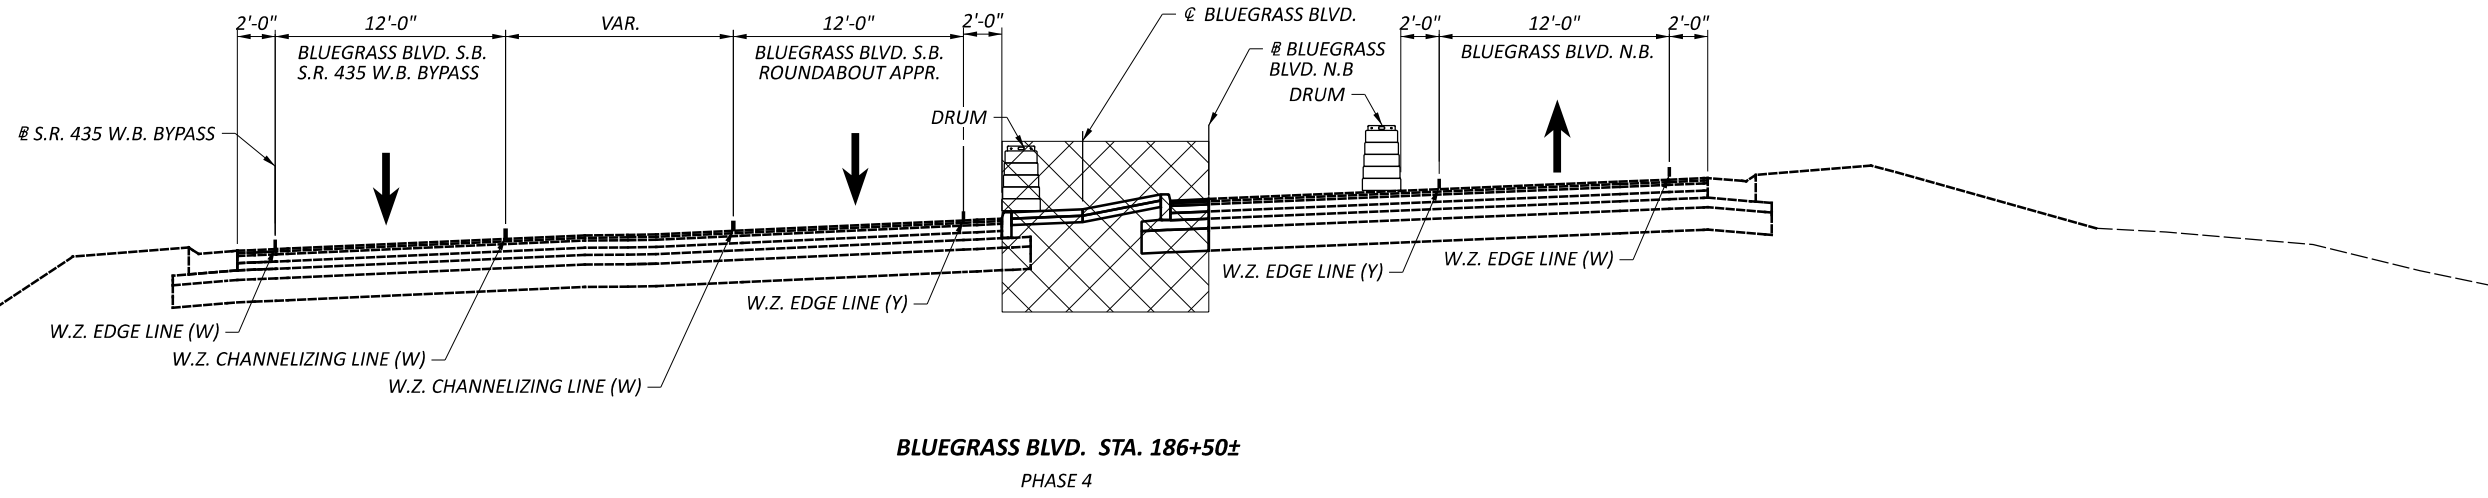

BLUEGRASS BLVD. STA. 186+50±
 PHASE 4

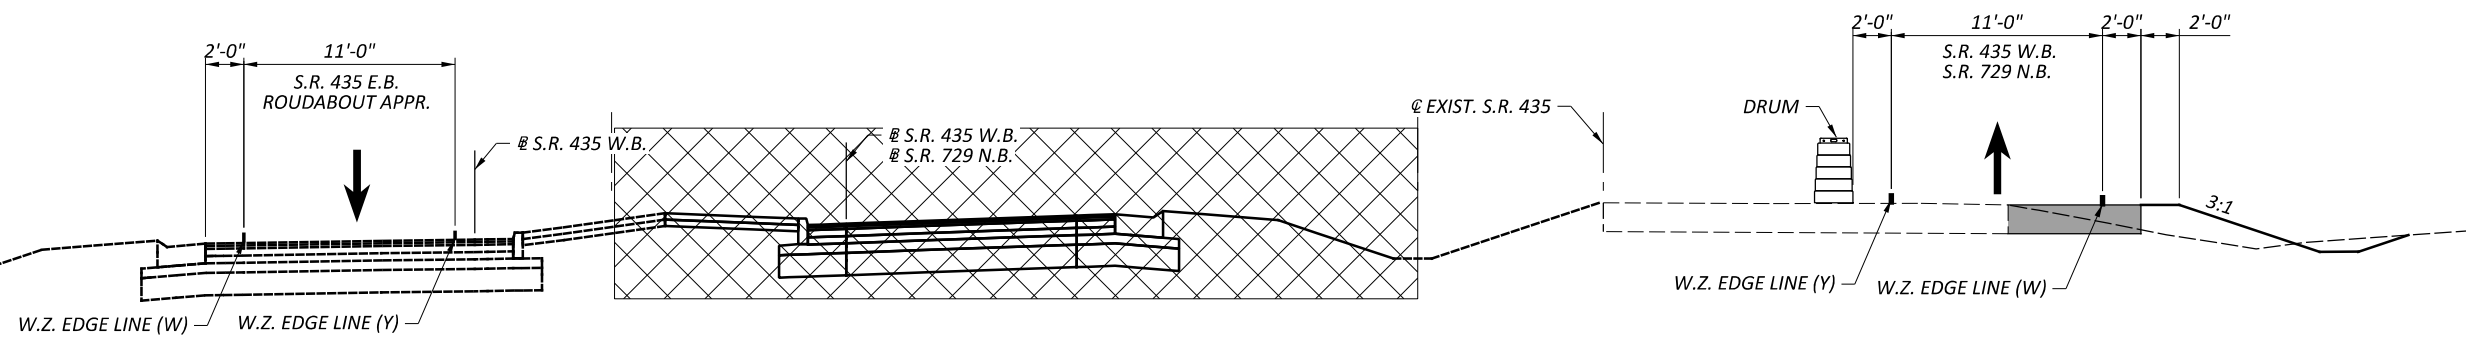

S.R. 435 STA. 111+00±
 PHASE 4

DESIGN AGENCY

Palmer
 ENGINEERING
 8350 E. KEMPER RD.
 SUITE B
 CINCINNATI, OH 45249
 513-469-1600

DESIGNER

DPF

REVIEWER


DCJ MM-DD-YY

PROJECT ID


117955

SHEET TOTAL


P. 26 | 228

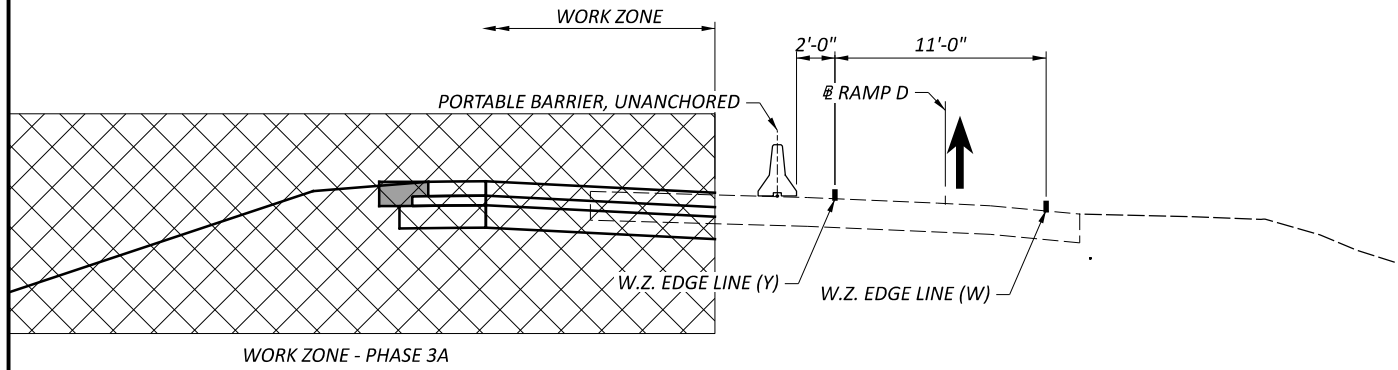


RAMP D - STA. 239+50±
PHASE 3A

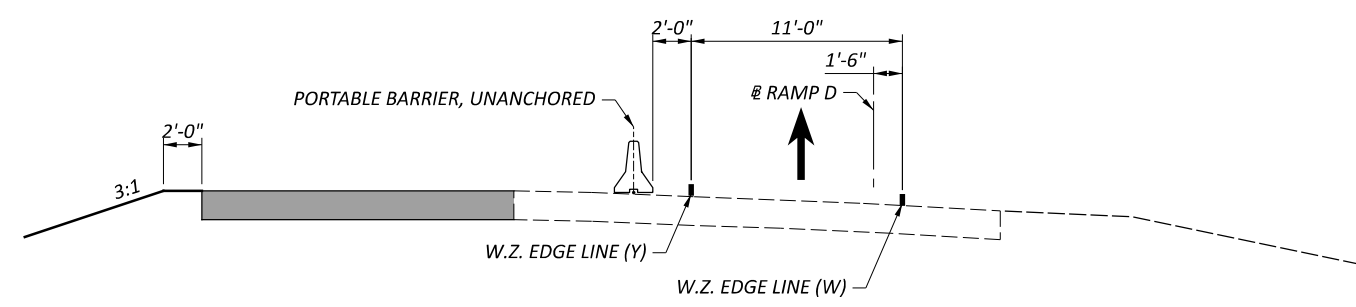


RAMP D - STA. 246+00±
PHASE 3A

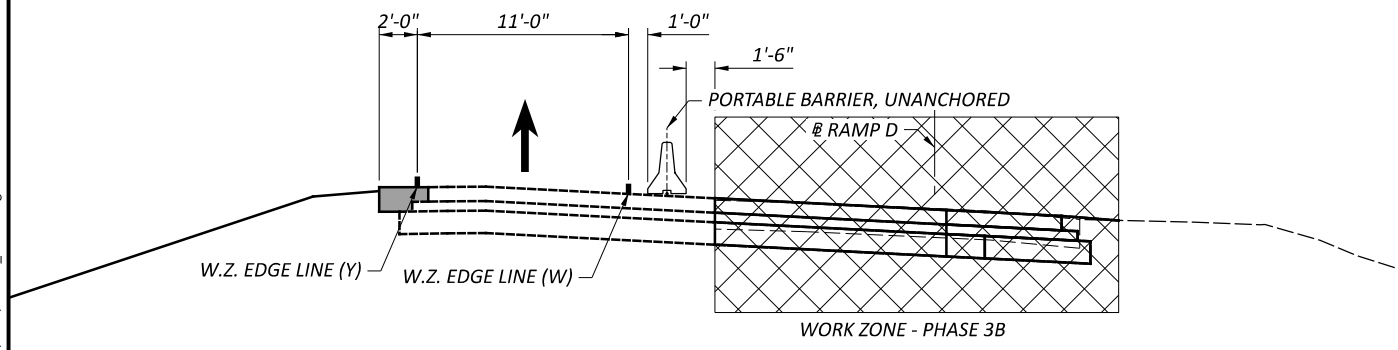


RAMP D - STA. 239+50±
PHASE 3B

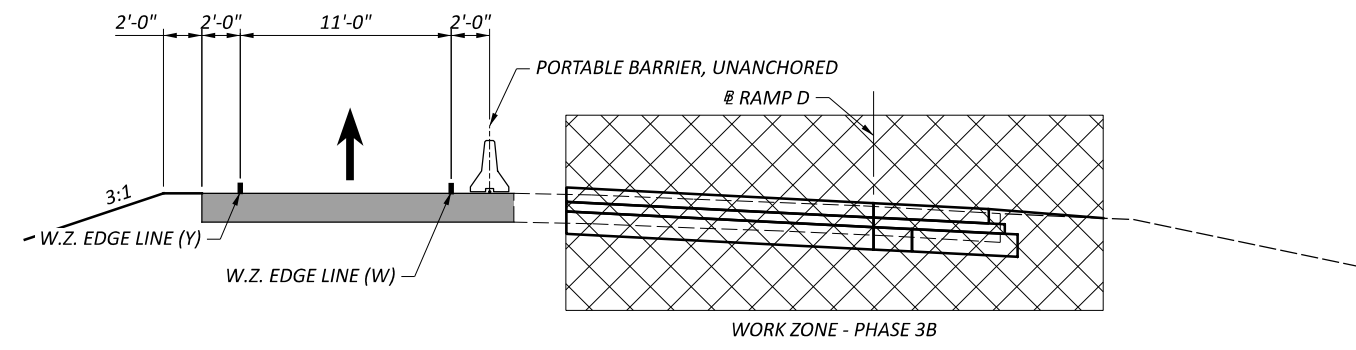

RAMP D - STA. 246+00±
PHASE 3B

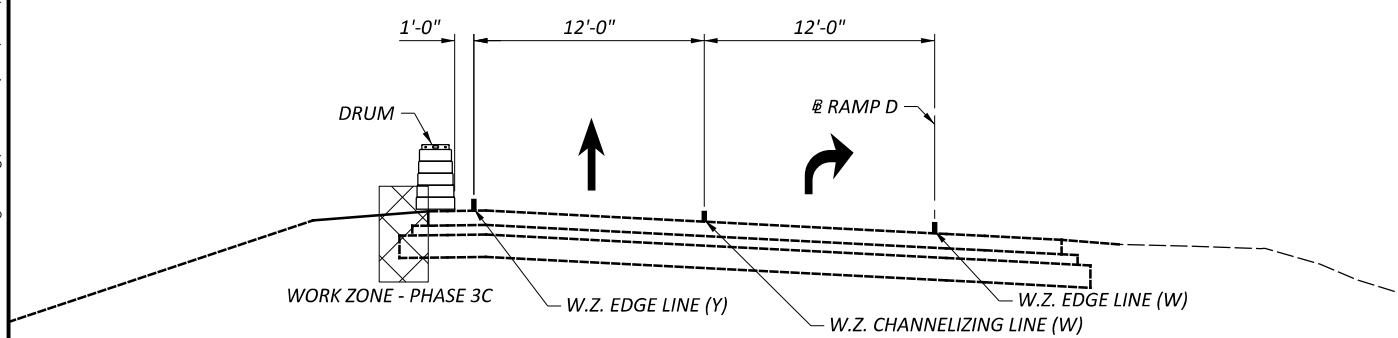

RAMP D - STA. 239+50±
PHASE 3C

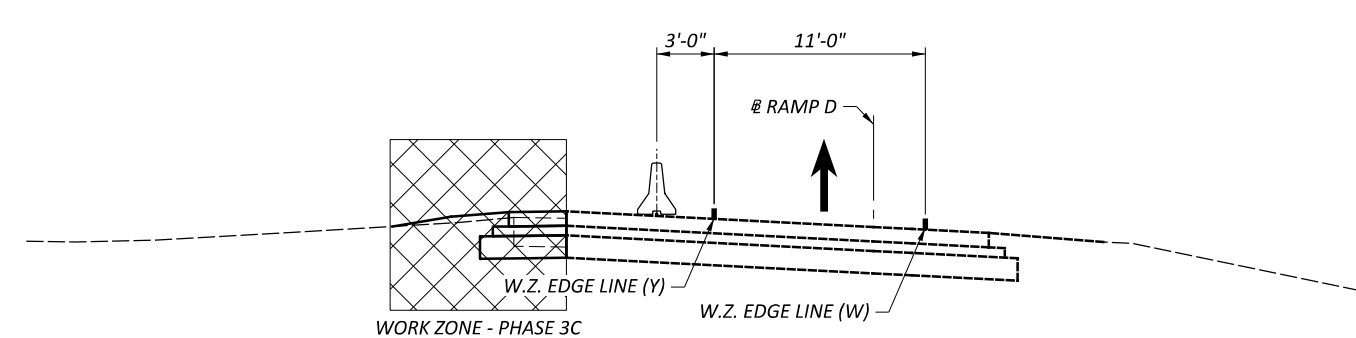

RAMP D - STA. 246+00±
PHASE 3C

LEGEND

- WORK ZONE
- PAVEMENT FOR M.O.T., CLASS A

MAINTENANCE OF TRAFFIC (BU-5)
 TYPICAL SECTIONS - RAMP D - PHASES 3A - 3C

DESIGN AGENCY	
Palmer ENGINEERING 8350 E. KEMPER RD. SUITE B CINCINNATI, OH 45249 513-469-1600	
DESIGNER	
DPF	
REVIEWER	
DCJ MM-DD-YY	
PROJECT ID	
117955	
SHEET	TOTAL
P. 27	228

HATCH LEGEND

	PROPOSED WORK ZONE
	PAVEMENT FOR M.O.T., CLASS A




SIGN LEGEND

	REMOVE AND DISPOSE OF EXISTING SIGN		EXISTING SIGN TO REMAIN
	PROPOSED SIGN		COVER EXISTING SIGN

xxx = REMOVAL OF EXISTING PAVEMENT MARKINGS



BALLOON LEGEND

	WORK ZONE EDGE LINE (Y), 4"		PORTABLE BARRIER, UNANCHORED		WORK ZONE DOTTED LINE, (W), 4"
	WORK ZONE EDGE LINE (W), 4"		ISLAND MARKING		WORK ZONE DOTTED LINE, (Y), 4"
	WORK ZONE STOP LINE (W) 24"		CHANNELIZING LINE, 8"		WORK ZONE IMPACT ATTENUATOR
	WORK ZONE DOUBLE SOLID LINE, (Y), 4"		LANE ARROW		

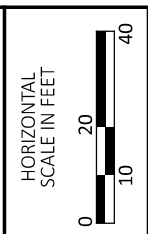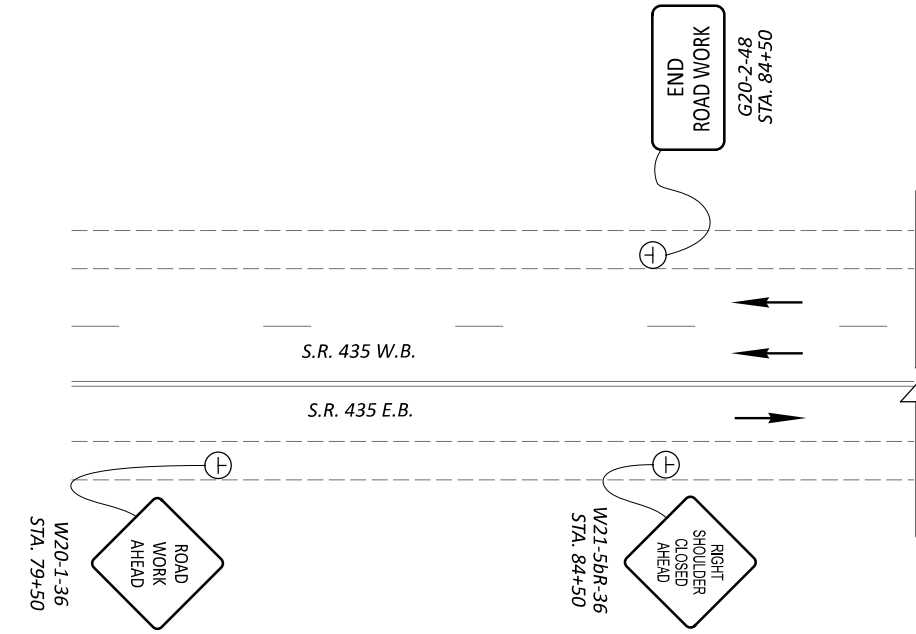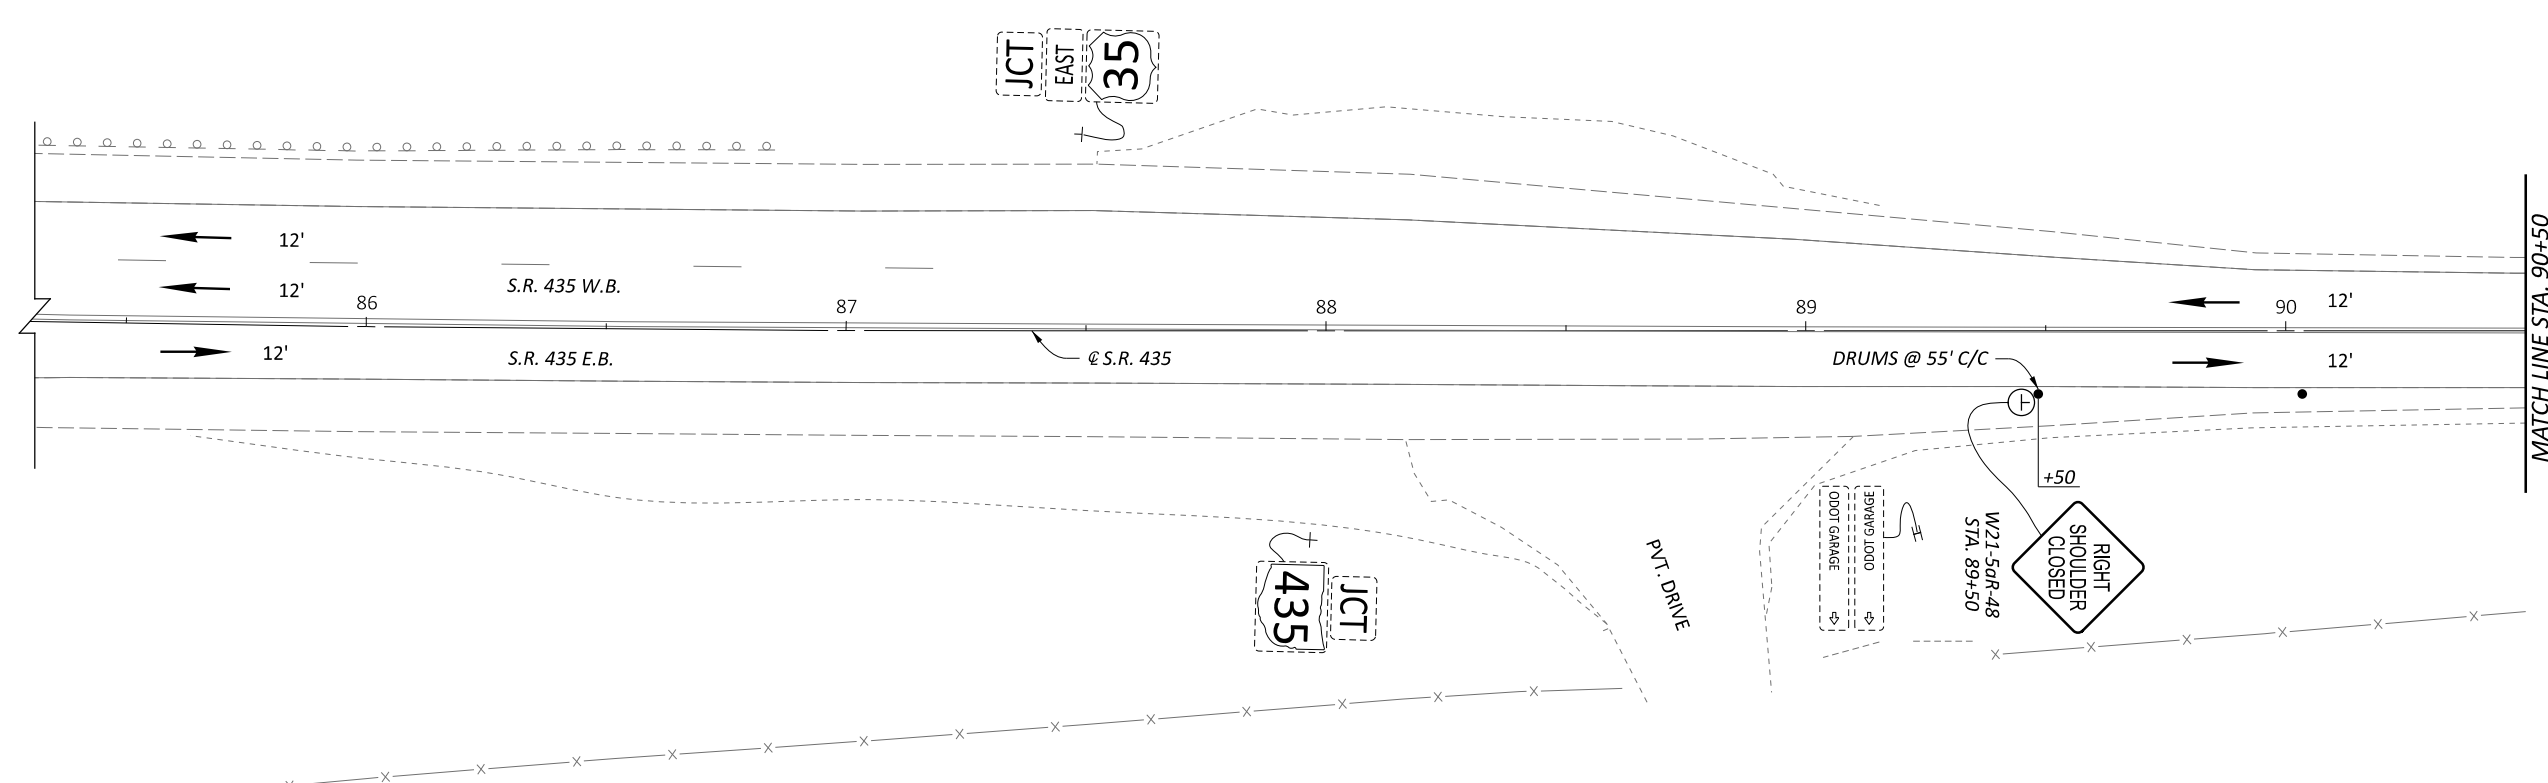

**MAINTENANCE OF TRAFFIC (BU-5)
 PHASE 1 - S.R. 435 STA. 79+50 TO STA. 90+50**

DESIGN AGENCY	Palmer ENGINEERING
8350 E. KEMPER RD. SUITTE B CINCINNATI, OH 45249 513-469-1600	
DESIGNER	DPF
REVIEWER	DCJ MM-DD-YY
PROJECT ID	117955
SHEET TOTAL	P. 28 228

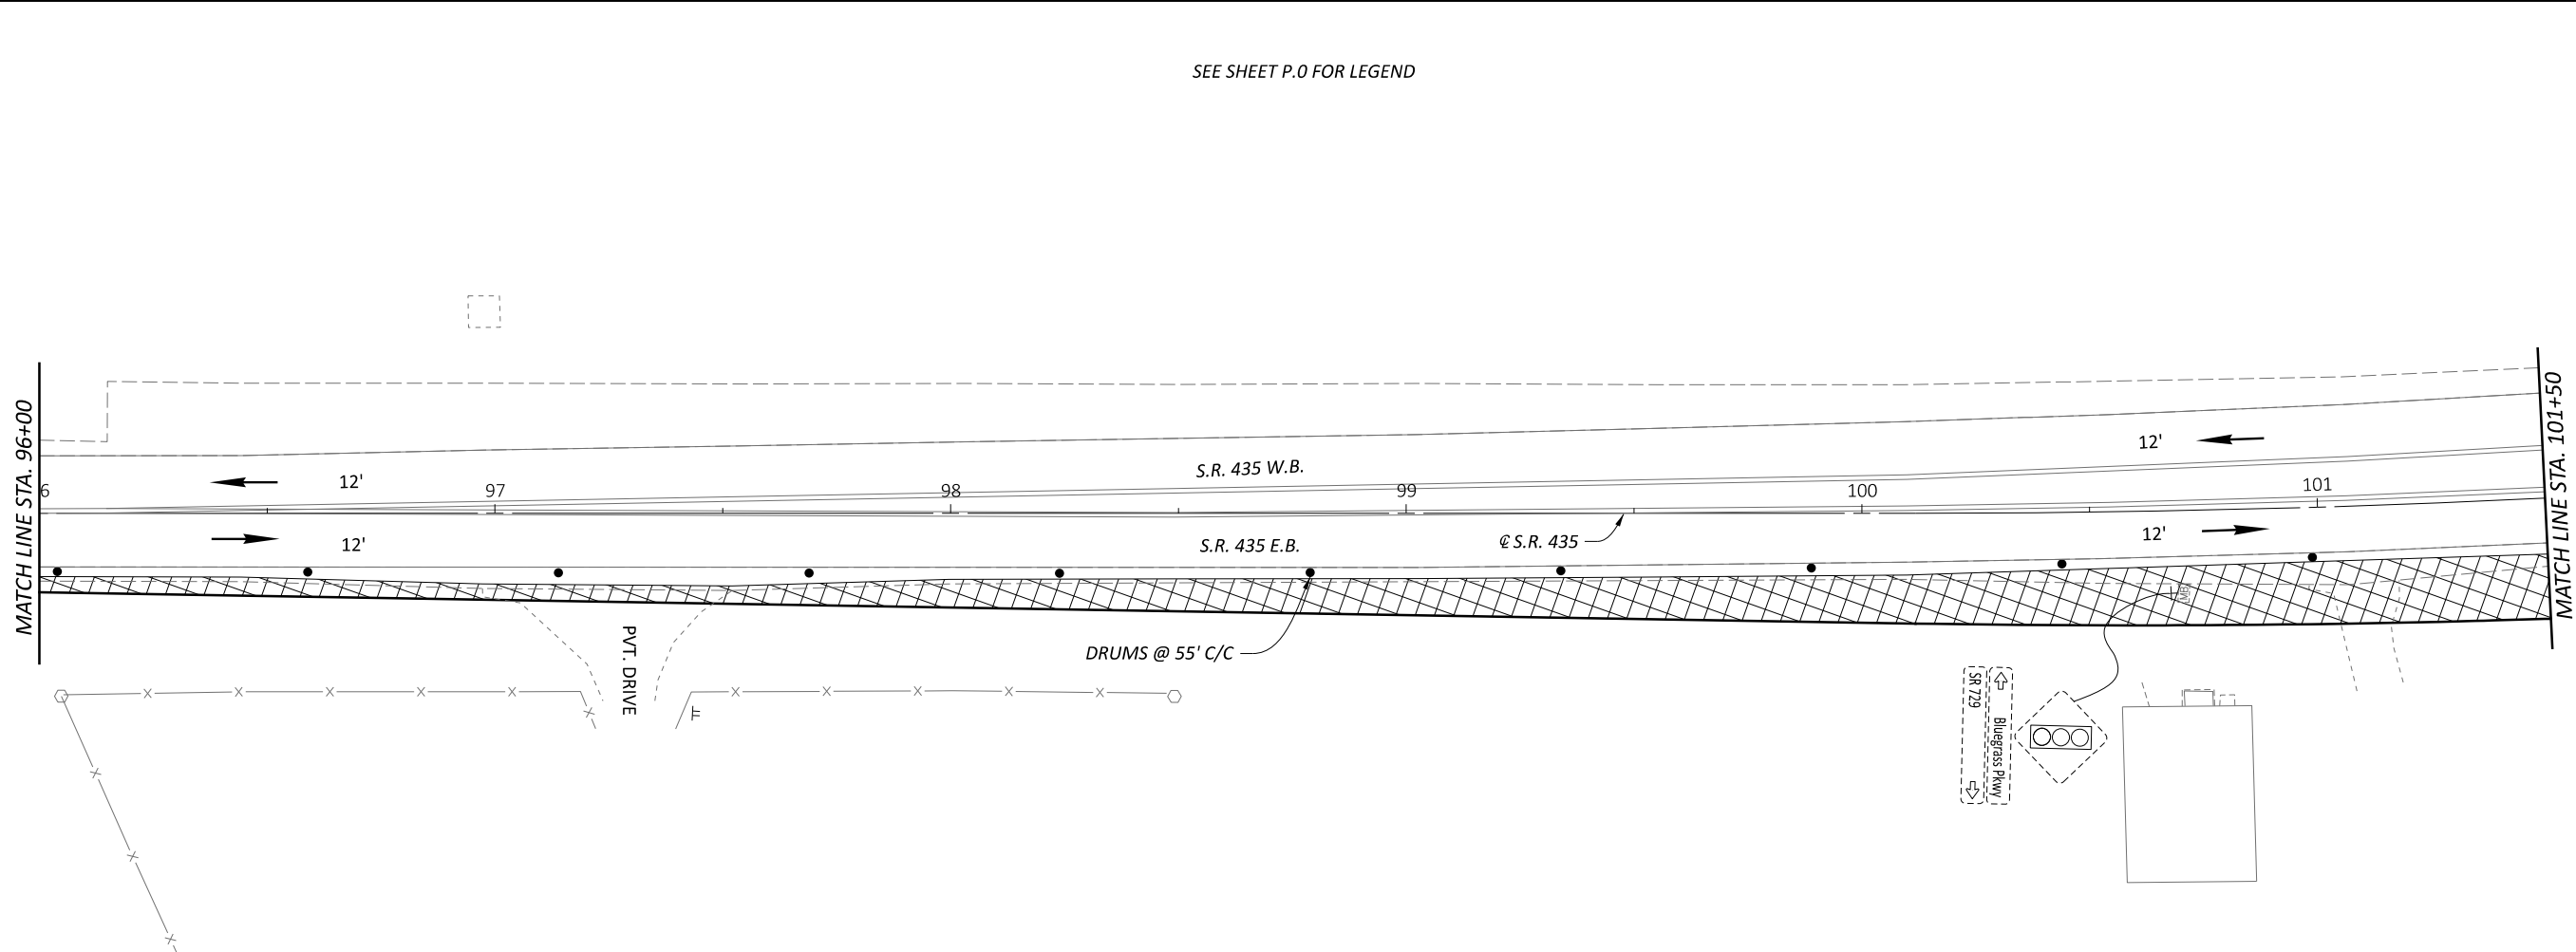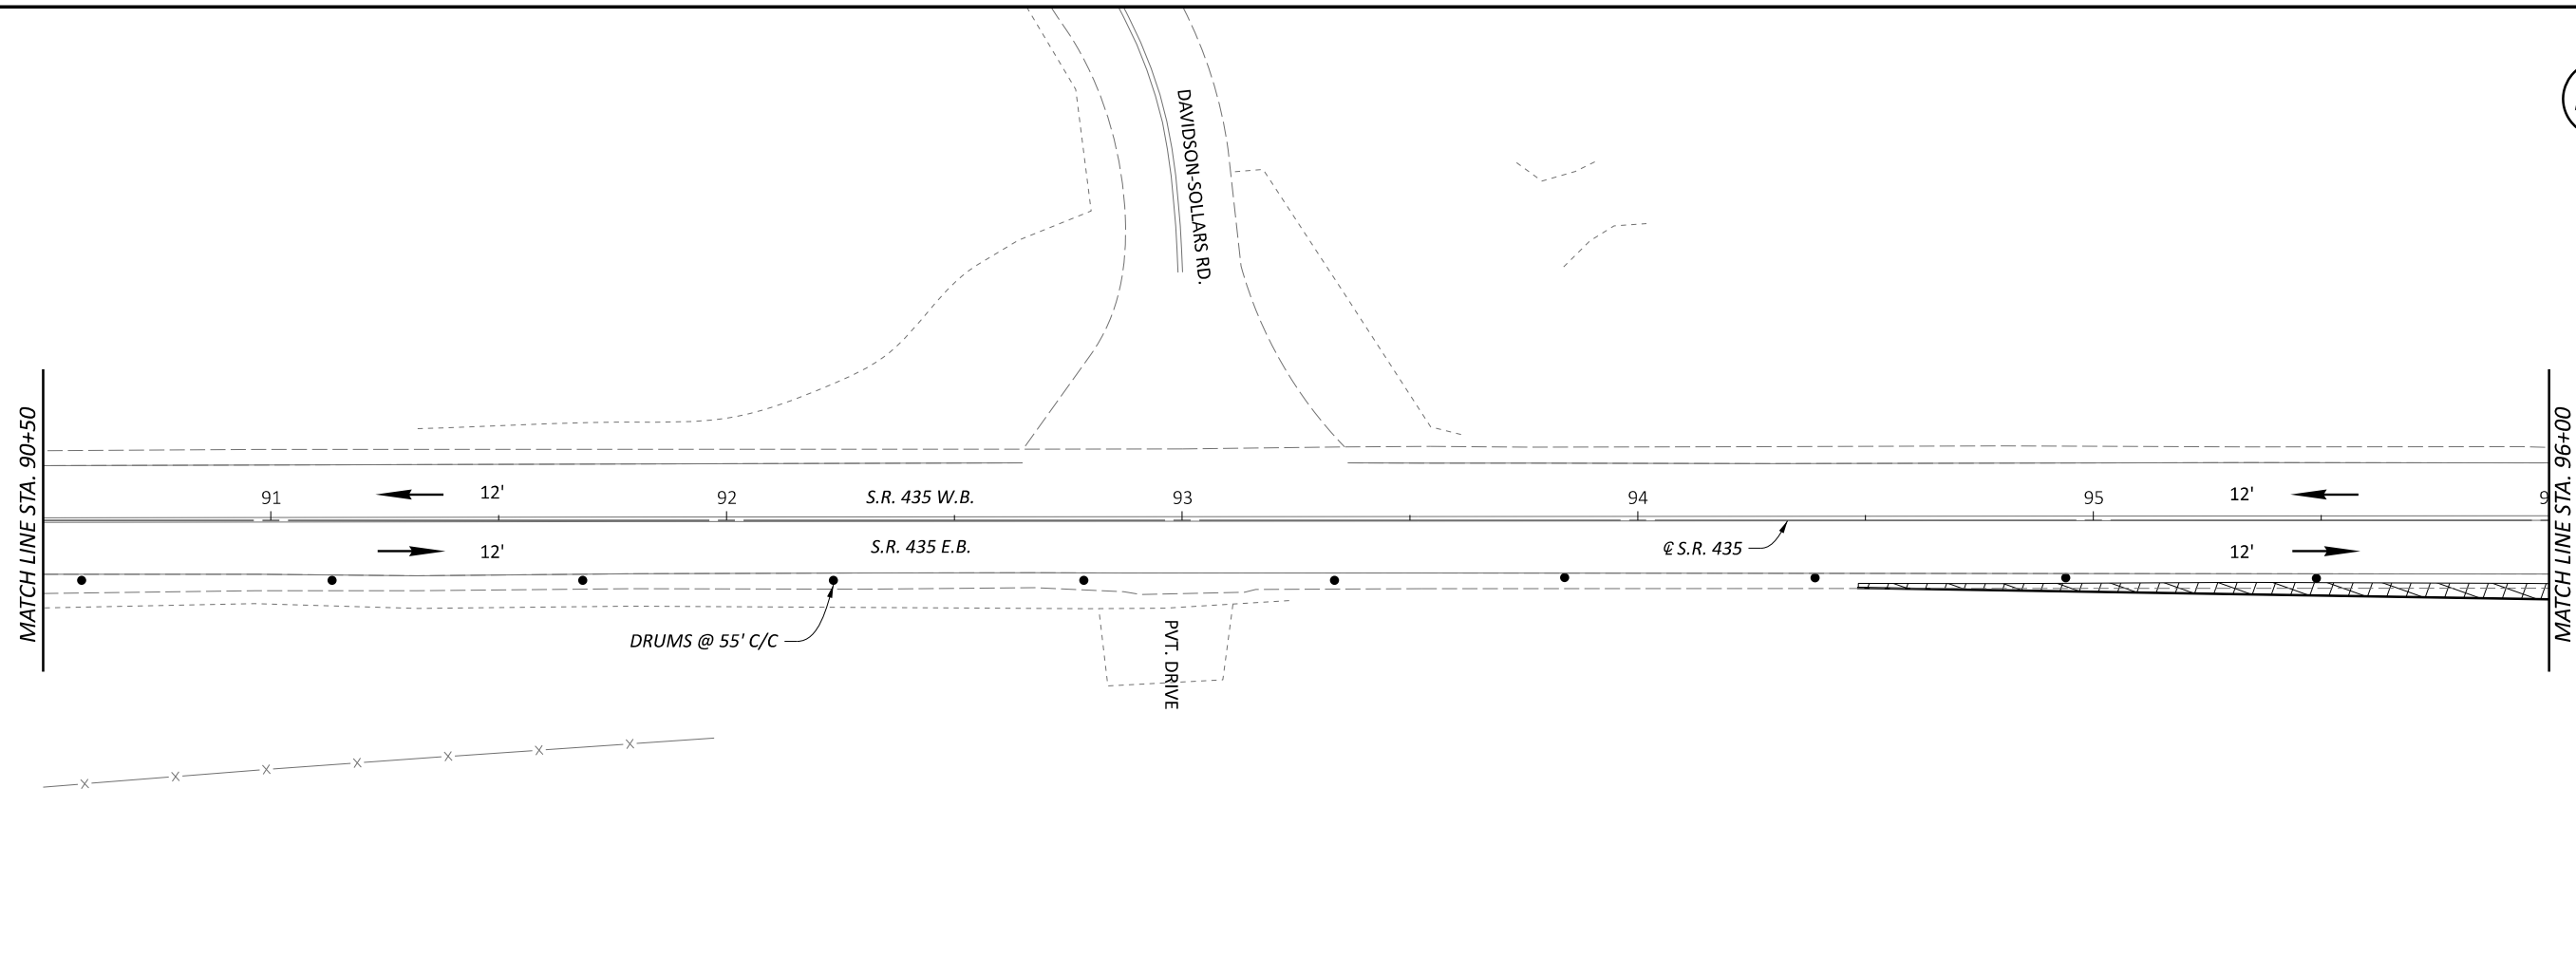

SEE SHEET P.0 FOR LEGEND



MAINTENANCE OF TRAFFIC (BU-5)
 PHASE 1 - S.R. 435 STA. 90+50 TO STA. 101+50

DESIGN AGENCY


Palmer
 ENGINEERING
 8350 E. KEMPER RD.
 SUITE B
 CINCINNATI, OH 45249
 513-469-1600

DESIGNER
DPF



REVIEWER
DCJ MM-DD-YY

PROJECT ID
117955

SHEET TOTAL
 P. 35 | 228

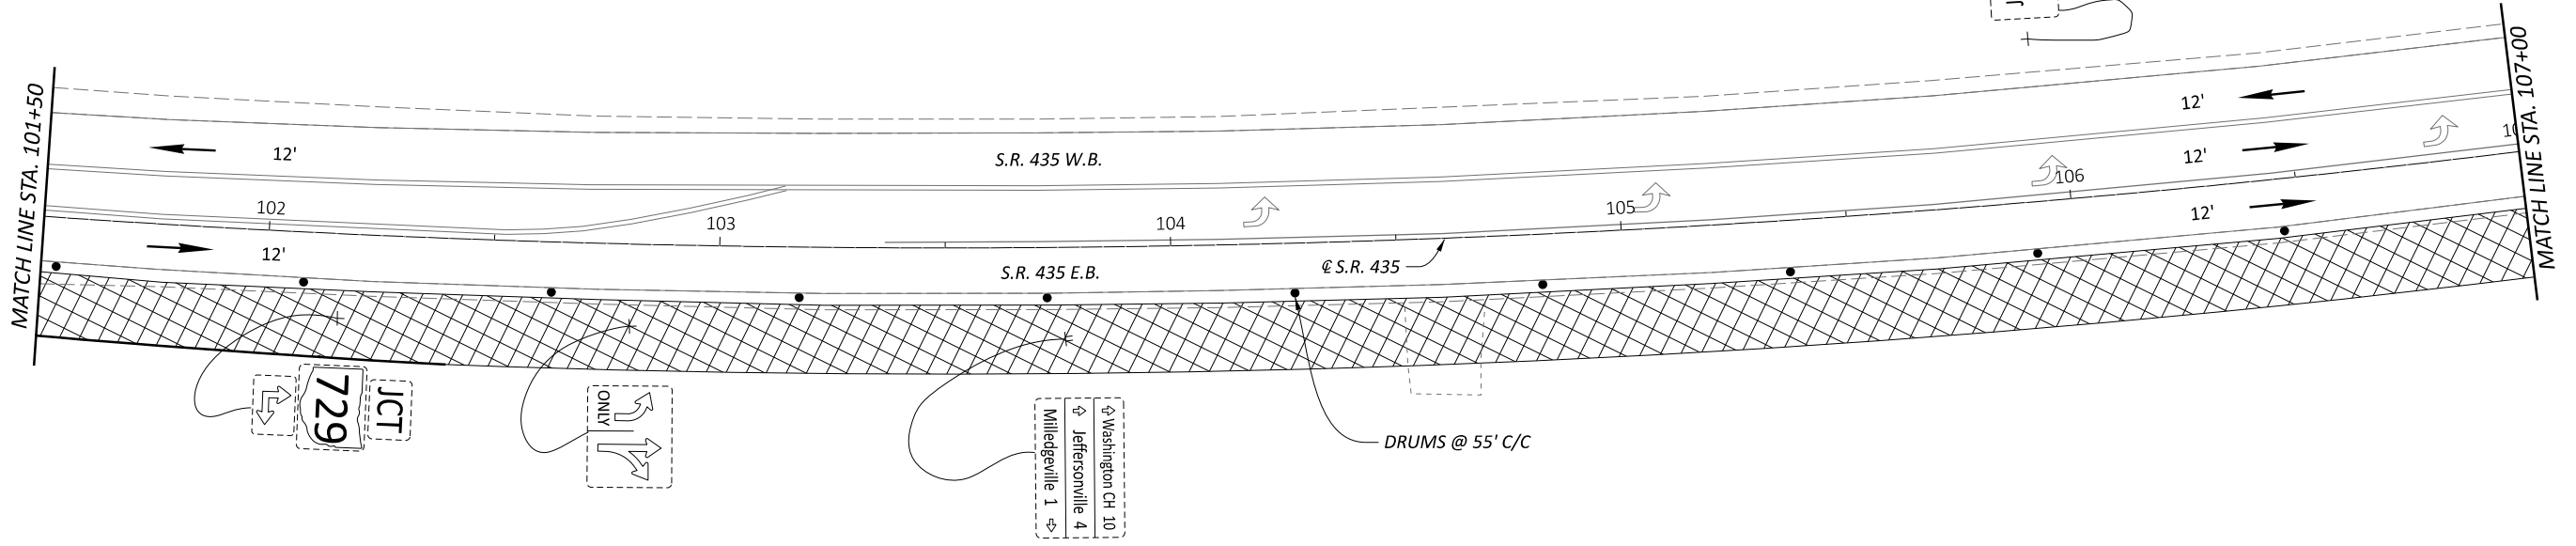



SEE SHEET P.0 FOR LEGEND

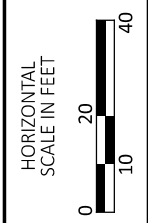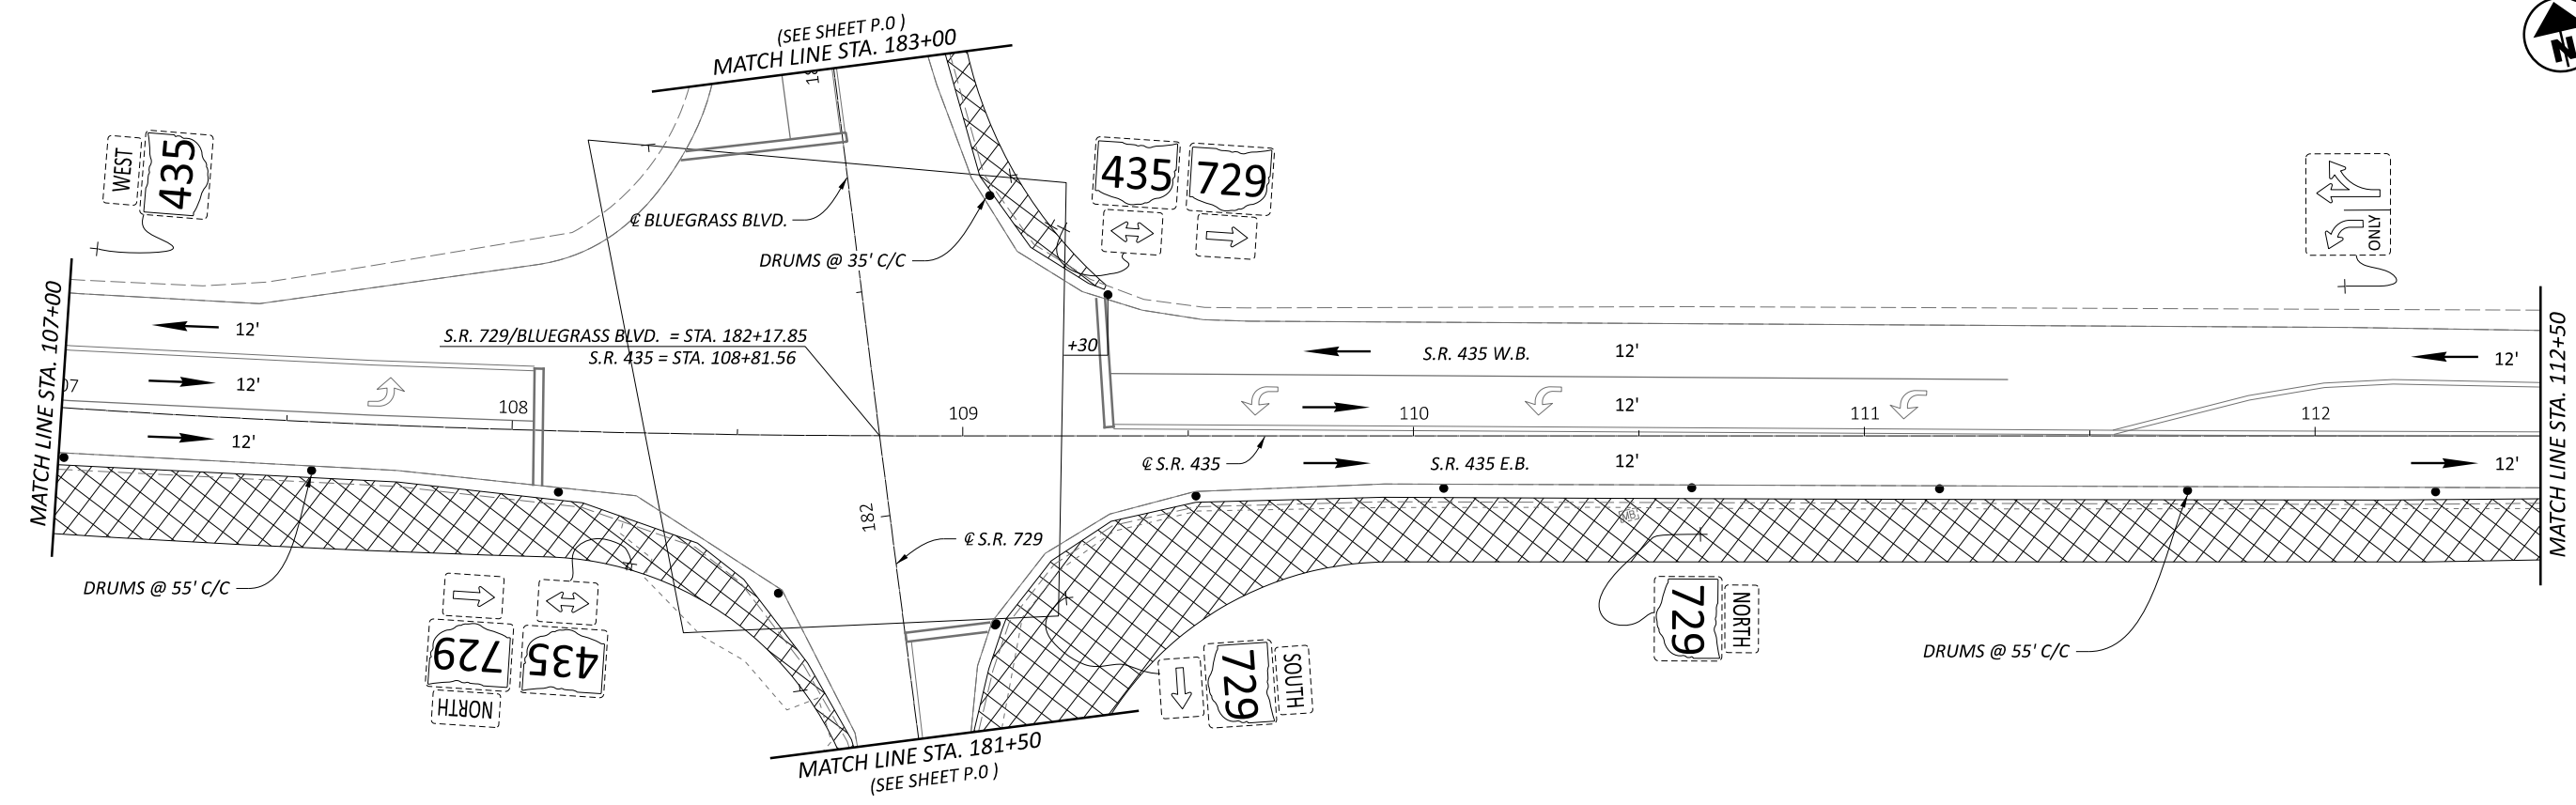

MAINTENANCE OF TRAFFIC (BU-5)
 PHASE 1 - S.R. 435 STA. 101+50 TO STA. 112+50

DESIGN AGENCY
Palmer
 ENGINEERING
 8350 E. KEMPER RD.
 SUITE B
 CINCINNATI, OH 45249
 513-469-1600

DESIGNER	DPF
REVIEWER	DCJ MM-DD-YY
PROJECT ID	117955
SHEET TOTAL	P. 29 228

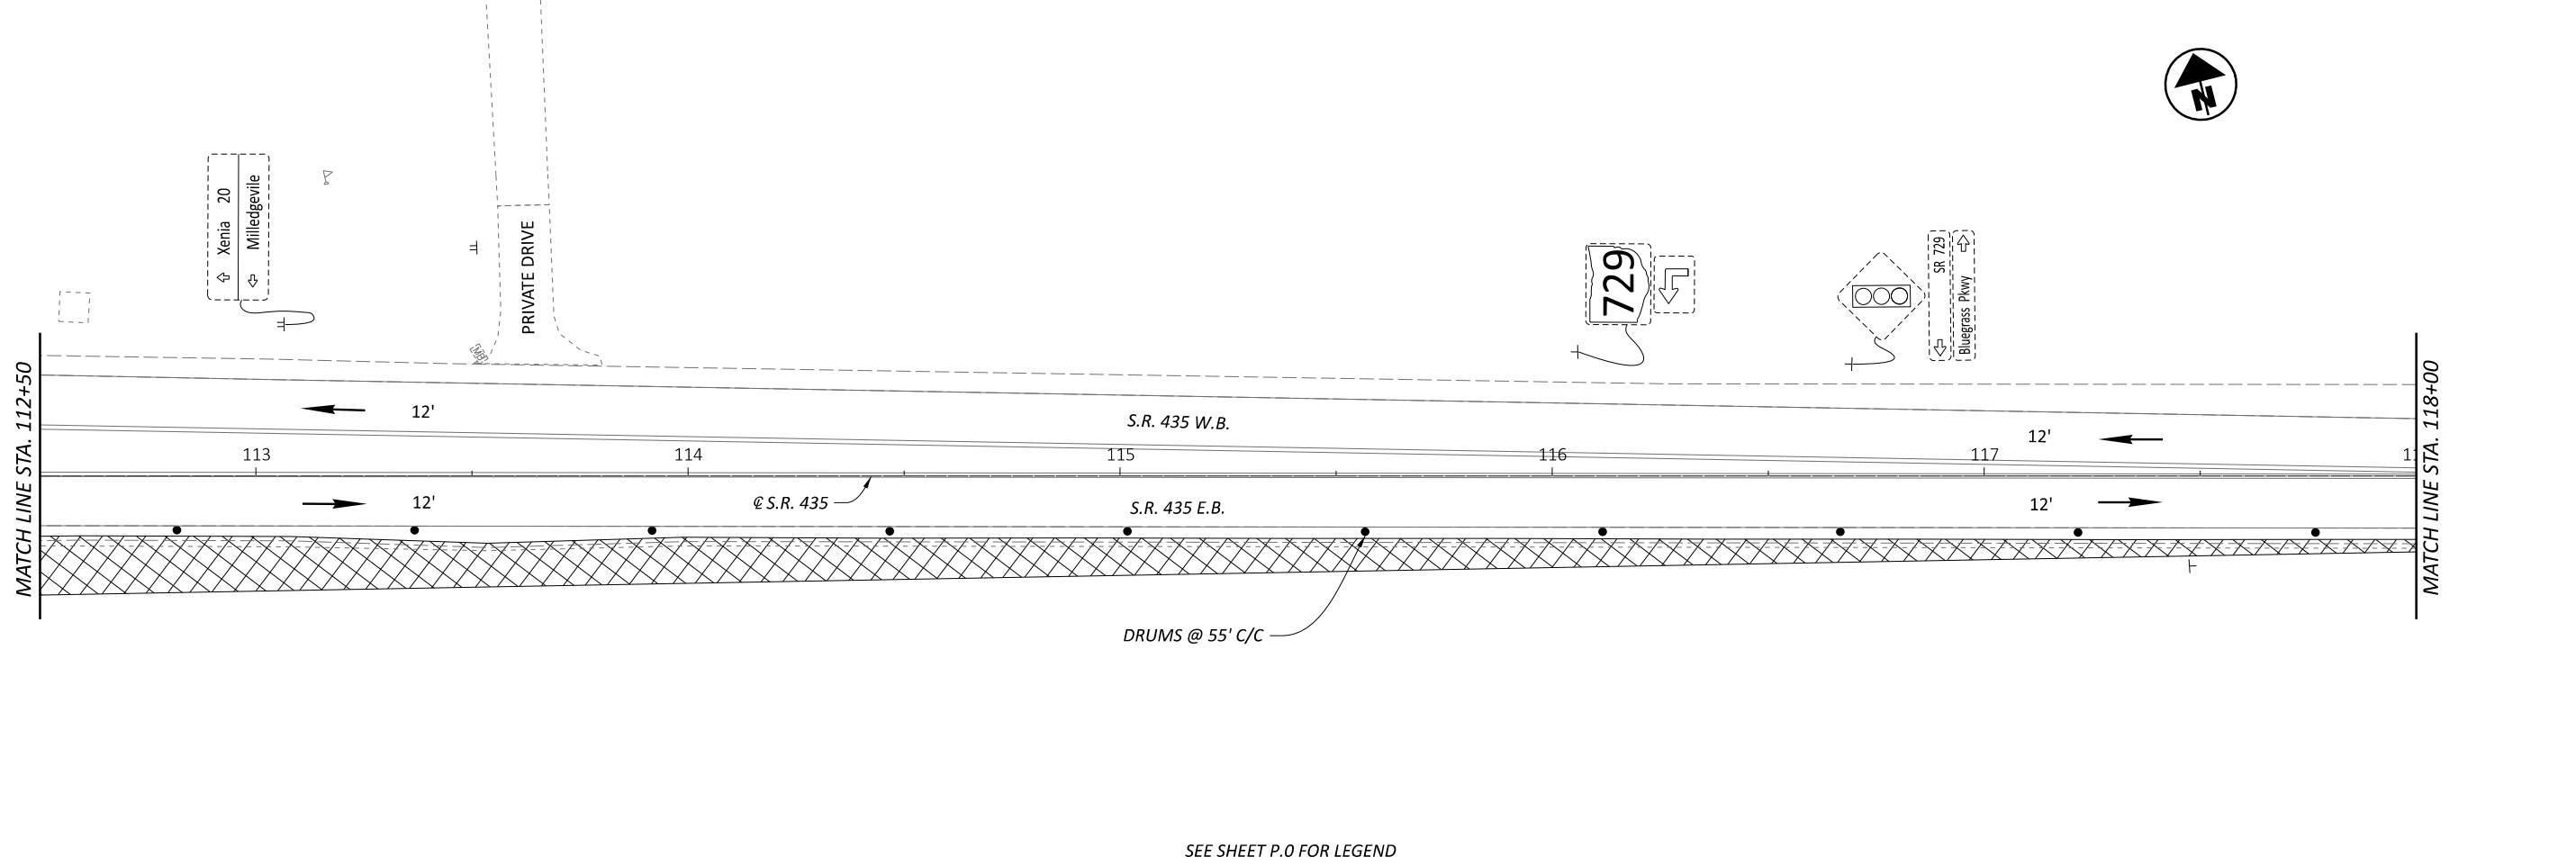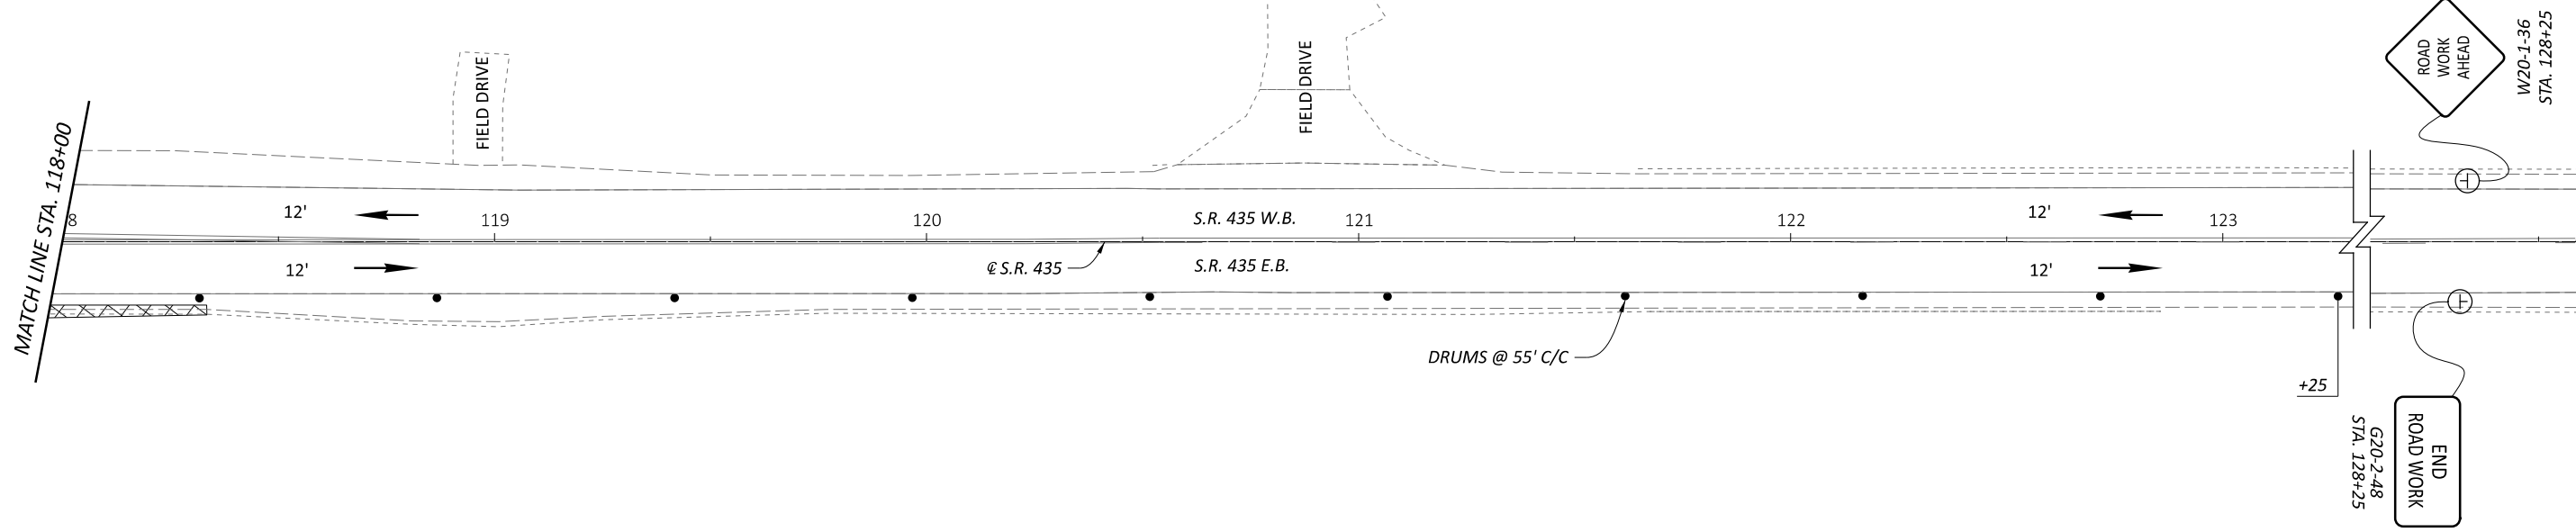

SEE SHEET P.0 FOR LEGEND



MAINTENANCE OF TRAFFIC (BU-5)
PHASE 1 - S.R. 435 STA. 112+50 TO STA. 128+25



DESIGN AGENCY

Palmer
ENGINEERING
8350 E. KEMPER RD.
SUITE B
CINCINNATI, OH 45249
513-469-1600

DESIGNER

DPF

REVIEWER




DCJ MM-DD-YY

PROJECT ID

117955


SHEET TOTAL

P. 30 | 228

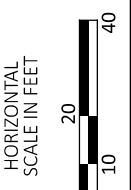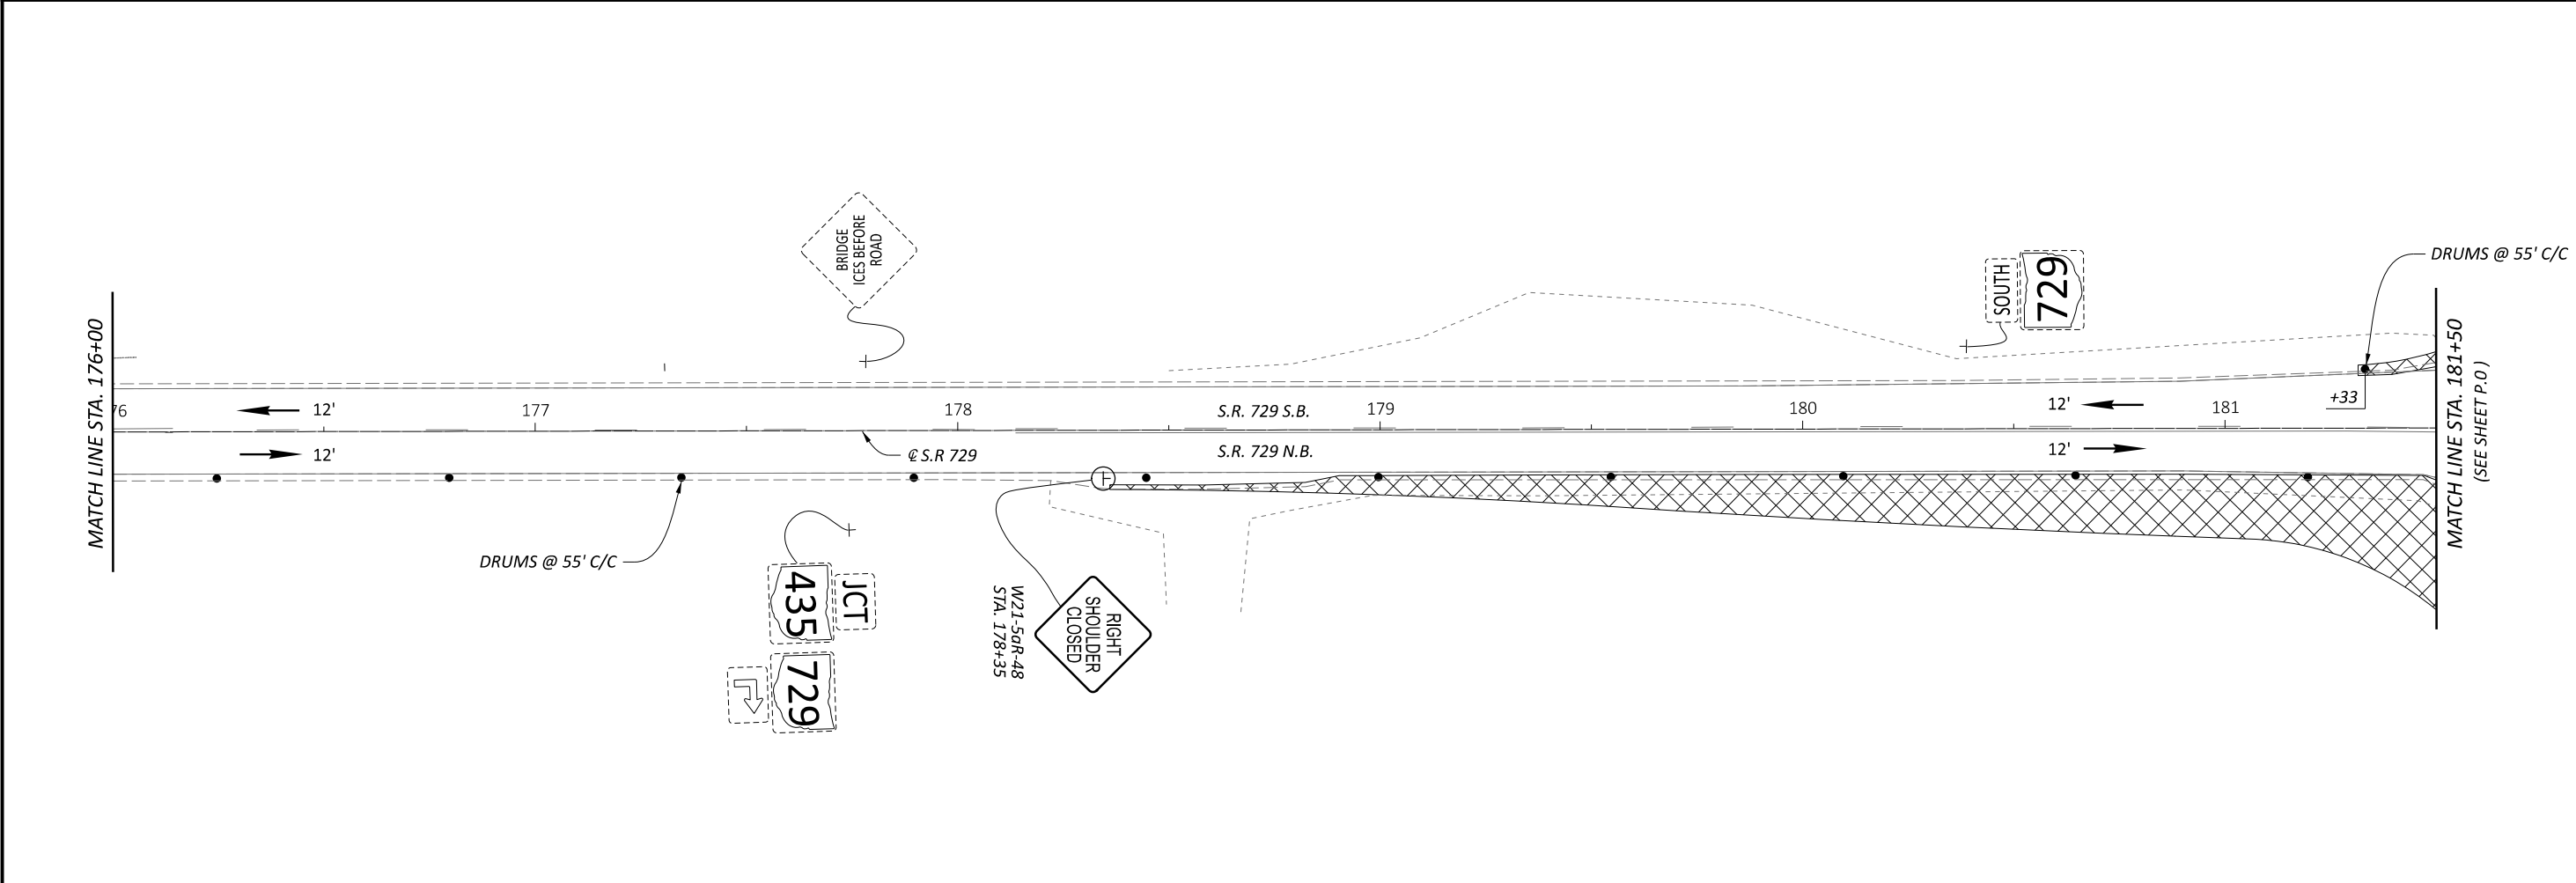
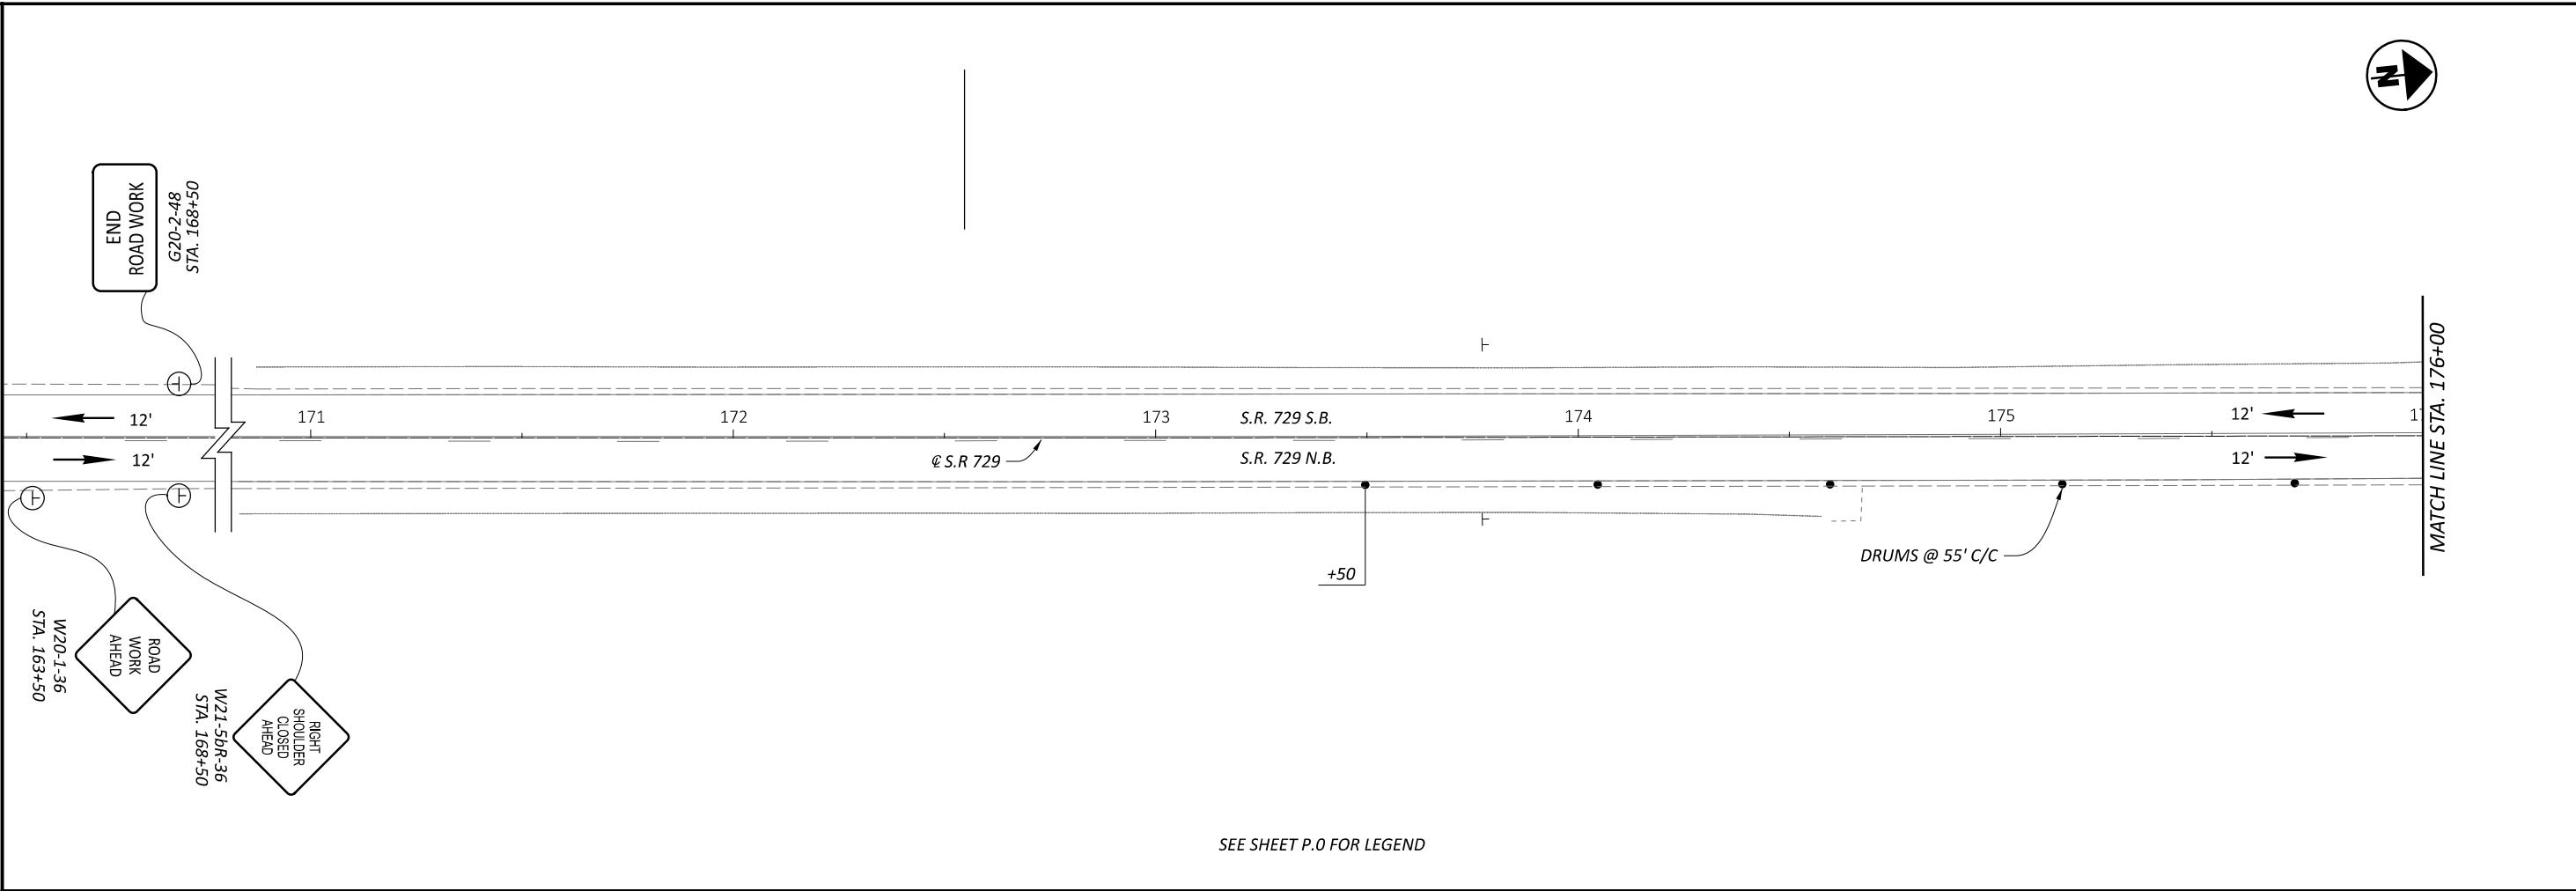


MAINTENANCE OF TRAFFIC (BU-5)
PHASE 1 - S.R. 729 STA. 163+50 TO STA. 181+50

DESIGN AGENCY	Palmer ENGINEERING
DESIGNER	DPF
REVIEWER	DCJ MM-DD-YY
PROJECT ID	117955
SHEET TOTAL	P. 31 228

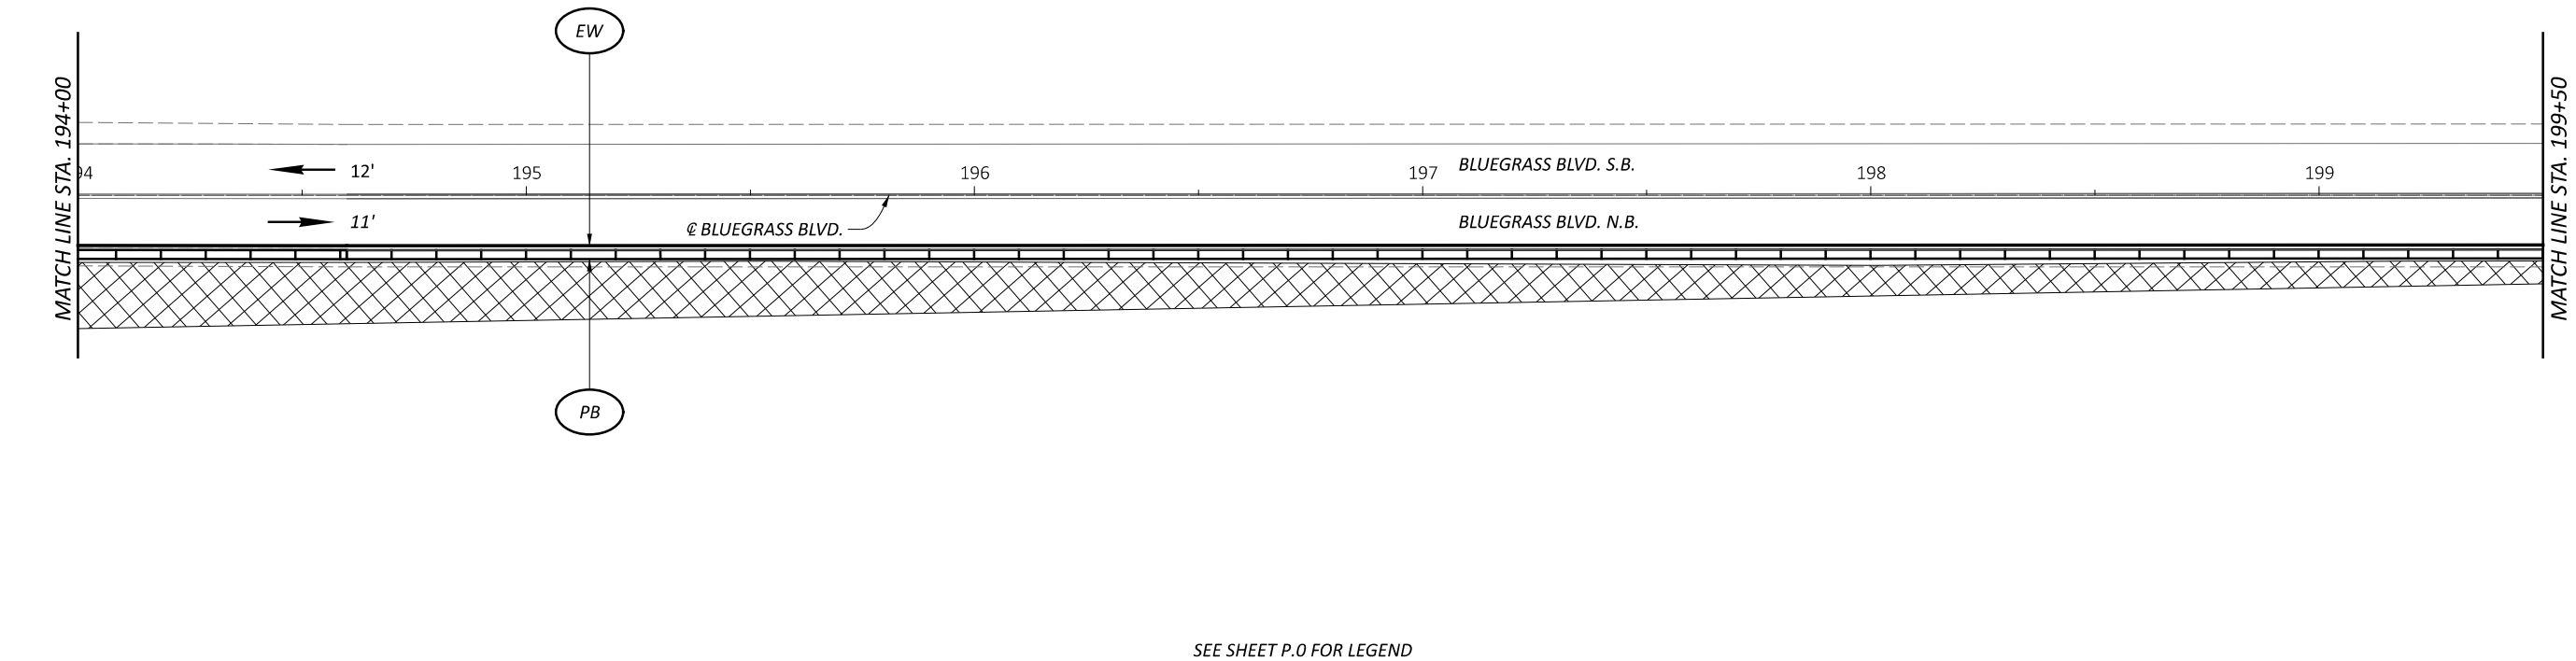


SEE SHEET P.0 FOR LEGEND

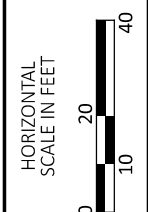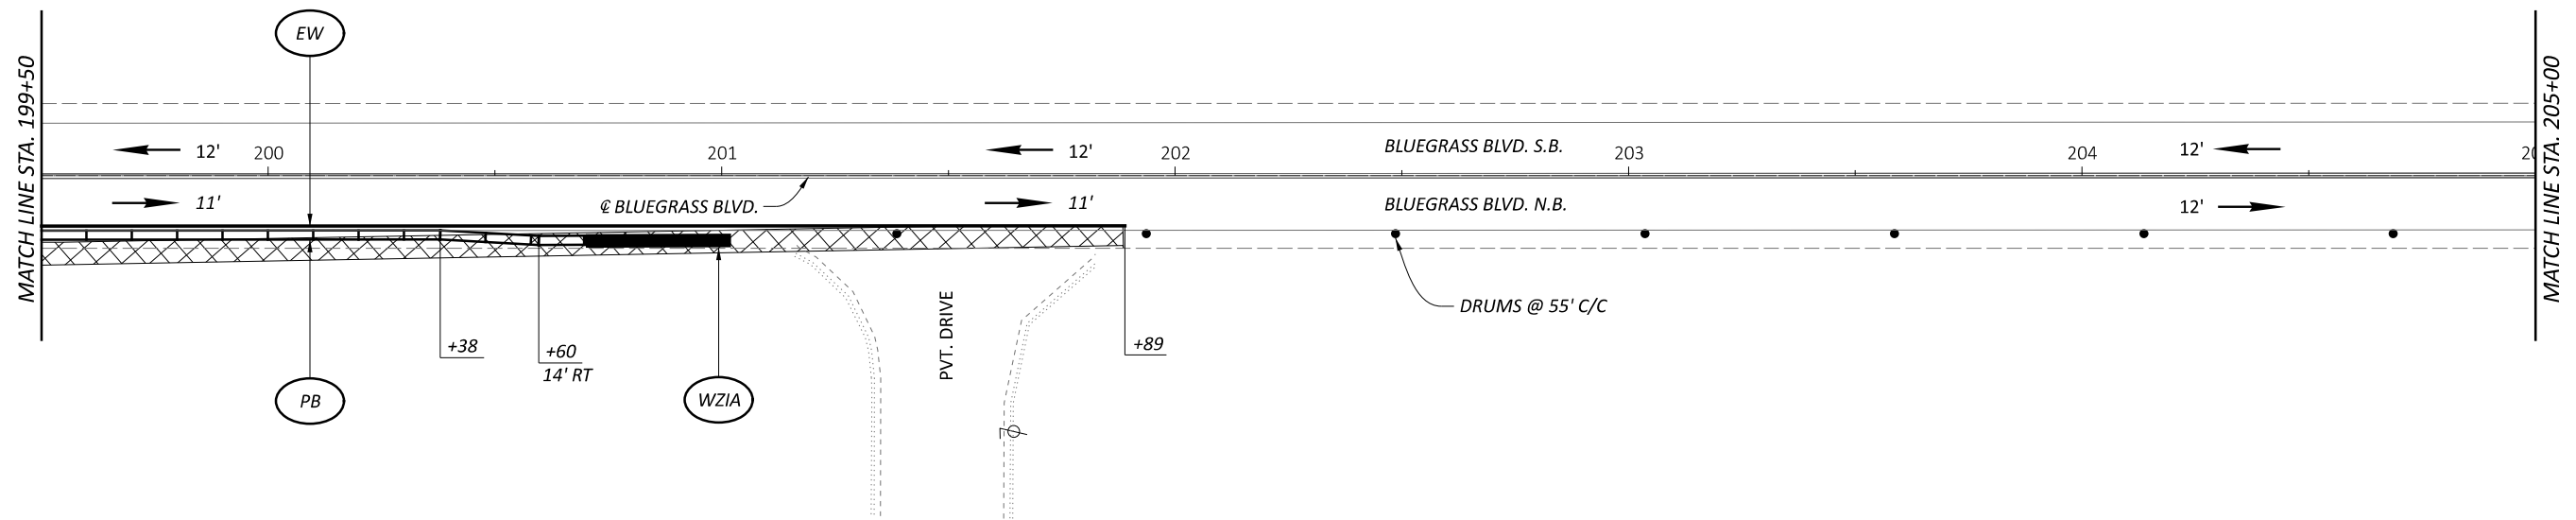


MAINTENANCE OF TRAFFIC (BU-5)
 PHASE 1 - BLUEGRASS BLVD. STA. 194+00 TO STA. 205+00

DESIGN AGENCY	
 8350 E. KEMPER RD. SUITE B CINCINNATI, OH 45249 513-469-1600	
DESIGNER	
DPF	
REVIEWER	
DCJ MM-DD-YY	
PROJECT ID	
117955	
SHEET	TOTAL
P. 33	228

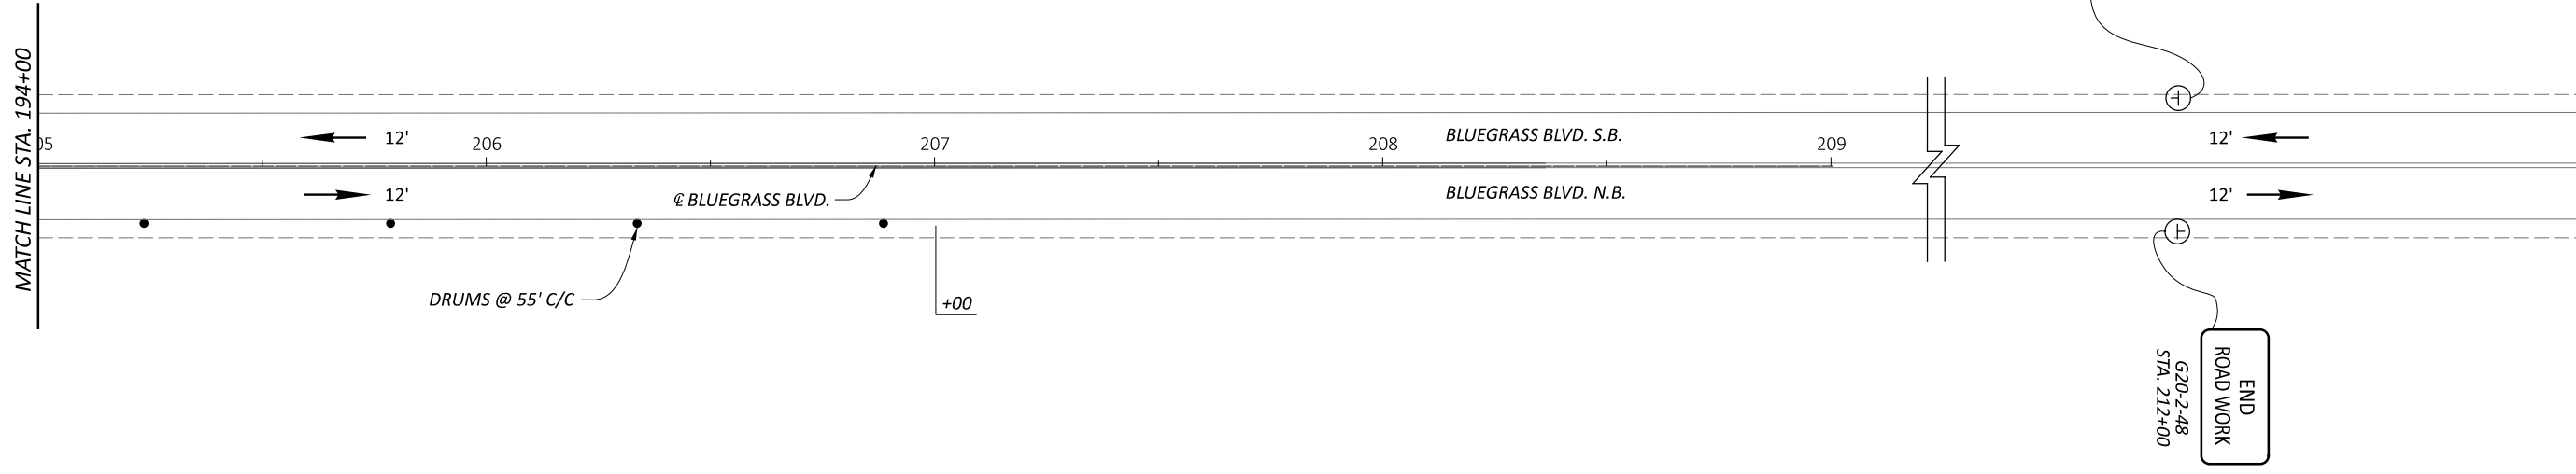

SEE SHEET P.0 FOR LEGEND

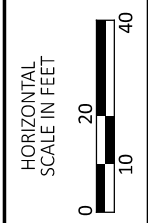

MAINTENANCE OF TRAFFIC (BU-5)
 PHASE 1 - BLUEGRASS BLVD. STA. 194+00 TO STA. 212+00

DESIGN AGENCY
Palmer
 ENGINEERING
 8350 E. KEMPER RD.
 SUITE B
 CINCINNATI, OH 45249
 513-469-1600

DESIGNER
 DPF

REVIEWER
 DCJ MM-DD-YY

PROJECT ID
 117955

SHEET TOTAL
 P. 34 | 228

HATCH LEGEND

	PROPOSED WORK ZONE
	PAVEMENT FOR M.O.T., CLASS A


SIGN LEGEND

	REMOVE AND DISPOSE OF EXISTING SIGN		EXISTING SIGN TO REMAIN
	PROPOSED SIGN		COVER EXISTING SIGN


xxx = REMOVAL OF EXISTING PAVEMENT MARKINGS

BALLOON LEGEND

	WORK ZONE EDGE LINE (Y), 4"		PORTABLE BARRIER, UNANCHORED		WORK ZONE DOTTED LINE, (W), 4"
	WORK ZONE EDGE LINE (W), 4"		WORK ZONE ISLAND MARKING		WORK ZONE DOTTED LINE, (Y), 4"
	WORK ZONE STOP LINE (W) 24"		WORK ZONE CHANNELIZING LINE, 8"		WORK ZONE IMPACT ATTENUATOR
	WORK ZONE DOUBLE SOLID LINE, (Y), 4"		WORK ZONE LANE ARROW		

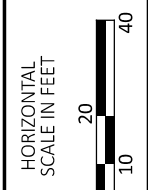

MAINTENANCE OF TRAFFIC (BU5)
 PHASE 2 - S.R. 435 STA. 57+00 TO STA. 68+50

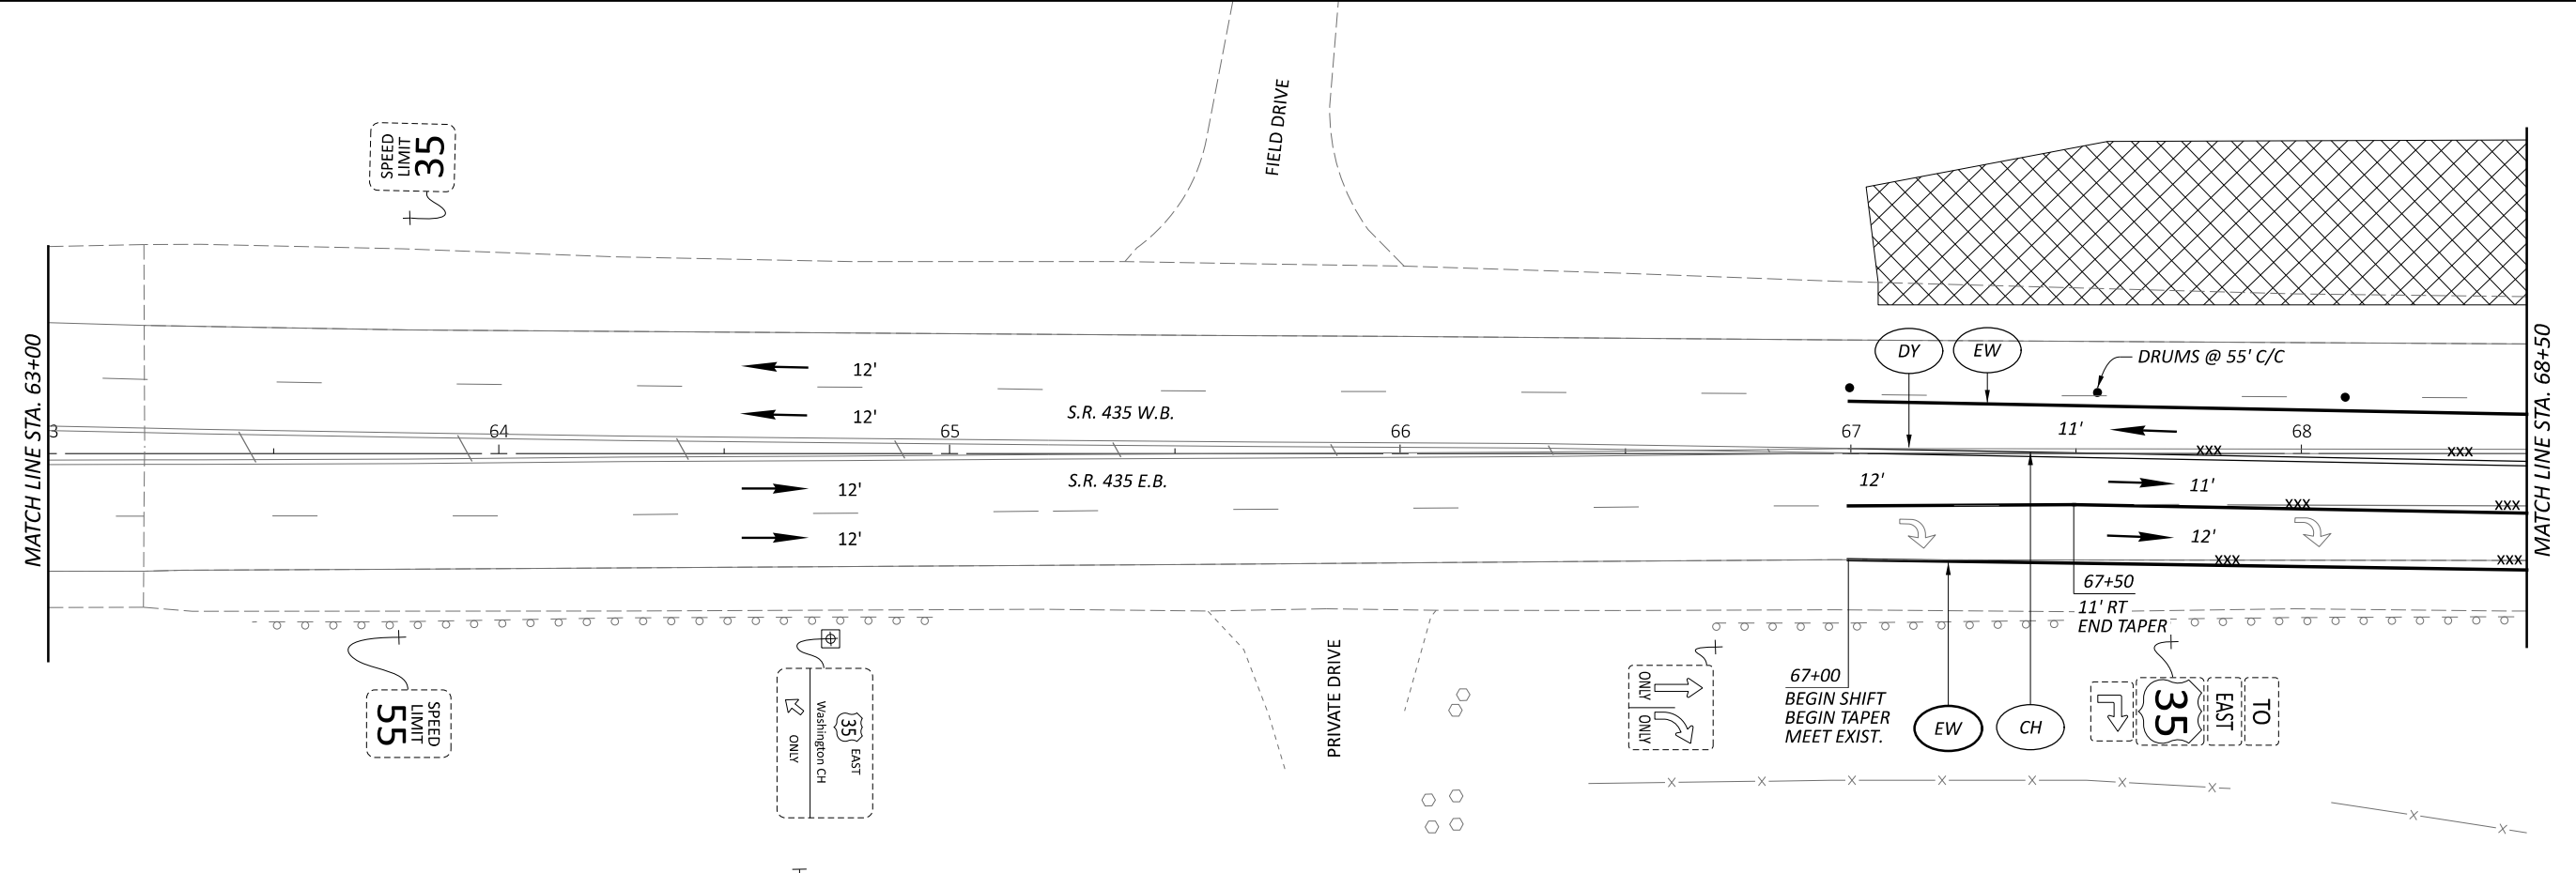

DESIGN AGENCY



Palmer ENGINEERING
 8350 E. KEMPER RD.
 SUITE B
 CINCINNATI, OH 45249
 513-469-1600

DESIGNER
DPF


REVIEWER
DCJ MM-DD-YY

PROJECT ID
117955

SHEET TOTAL
 P. 36 | 228

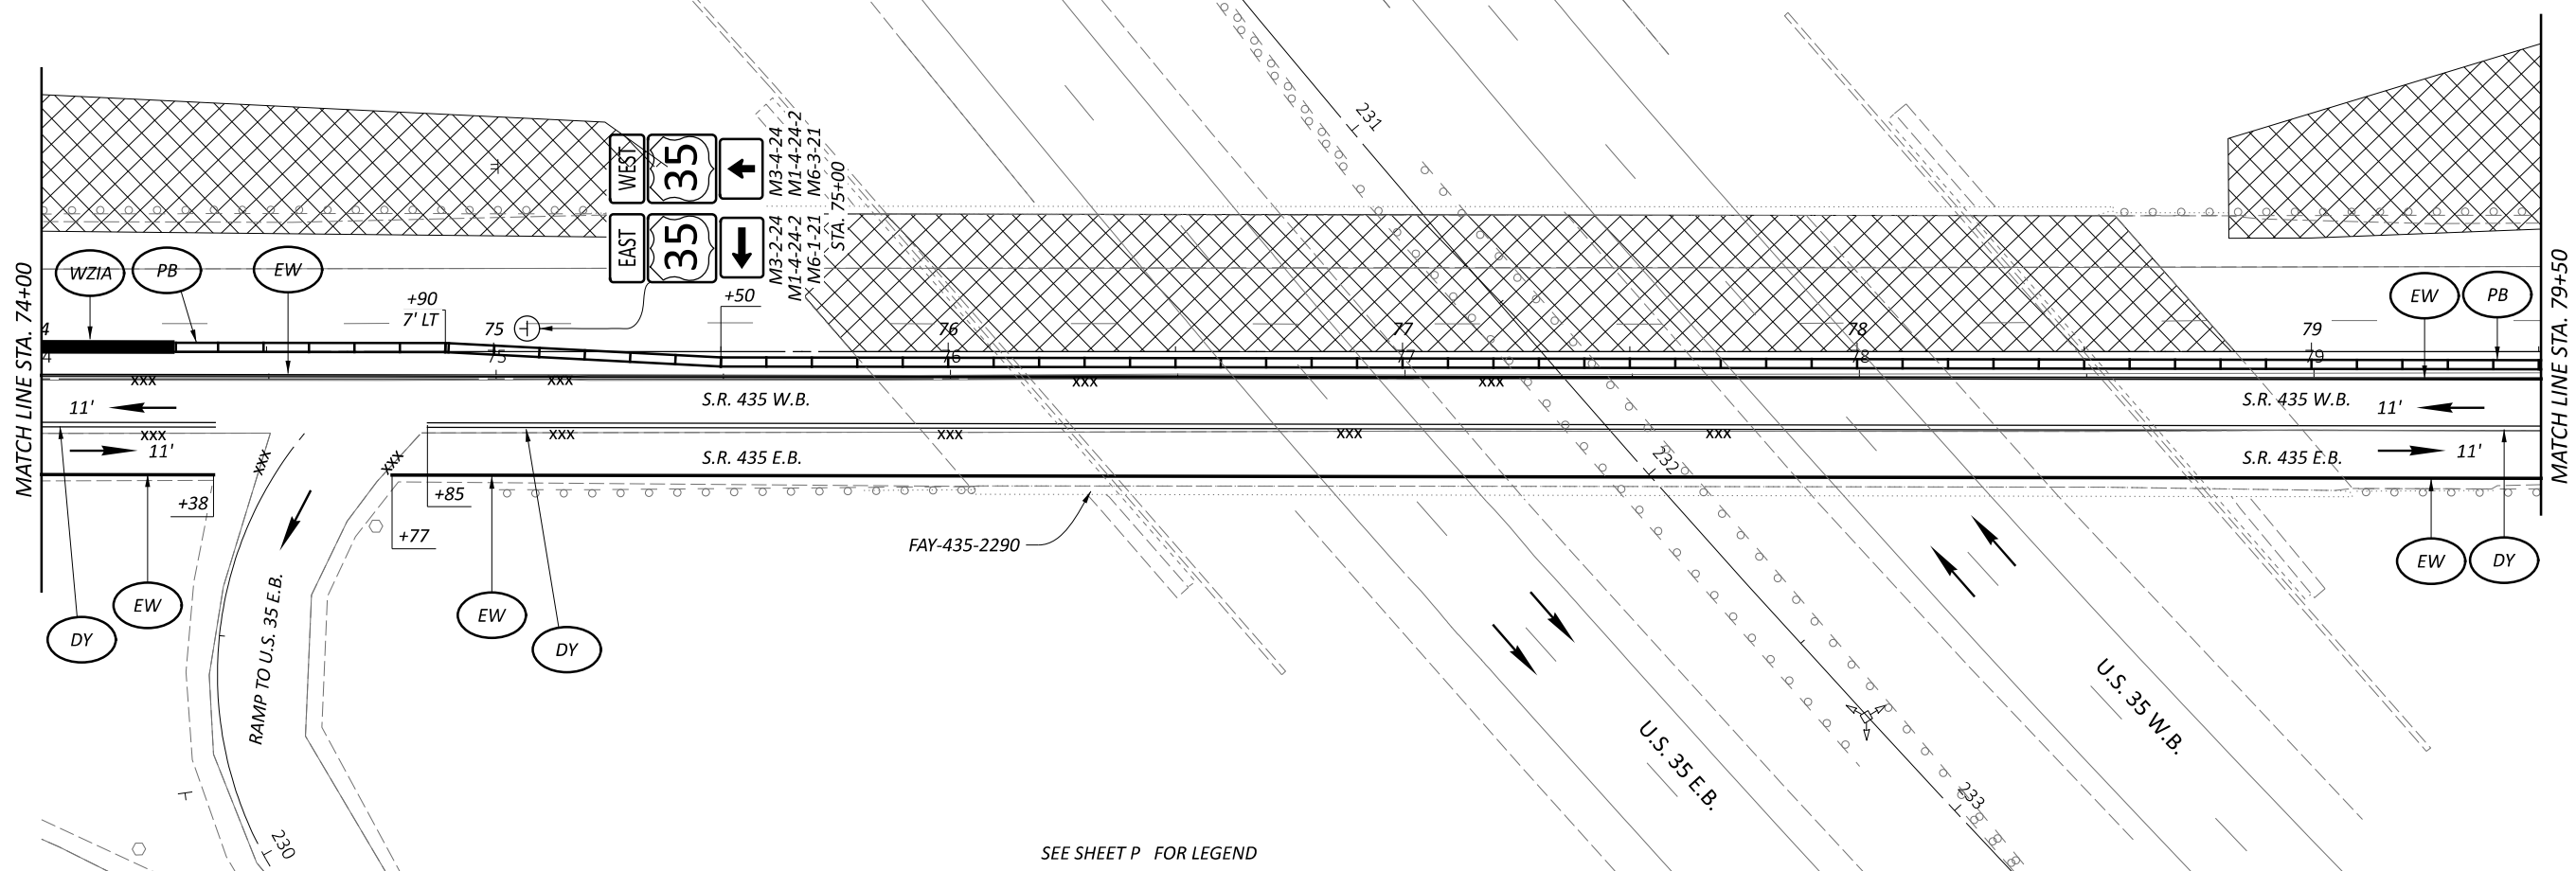
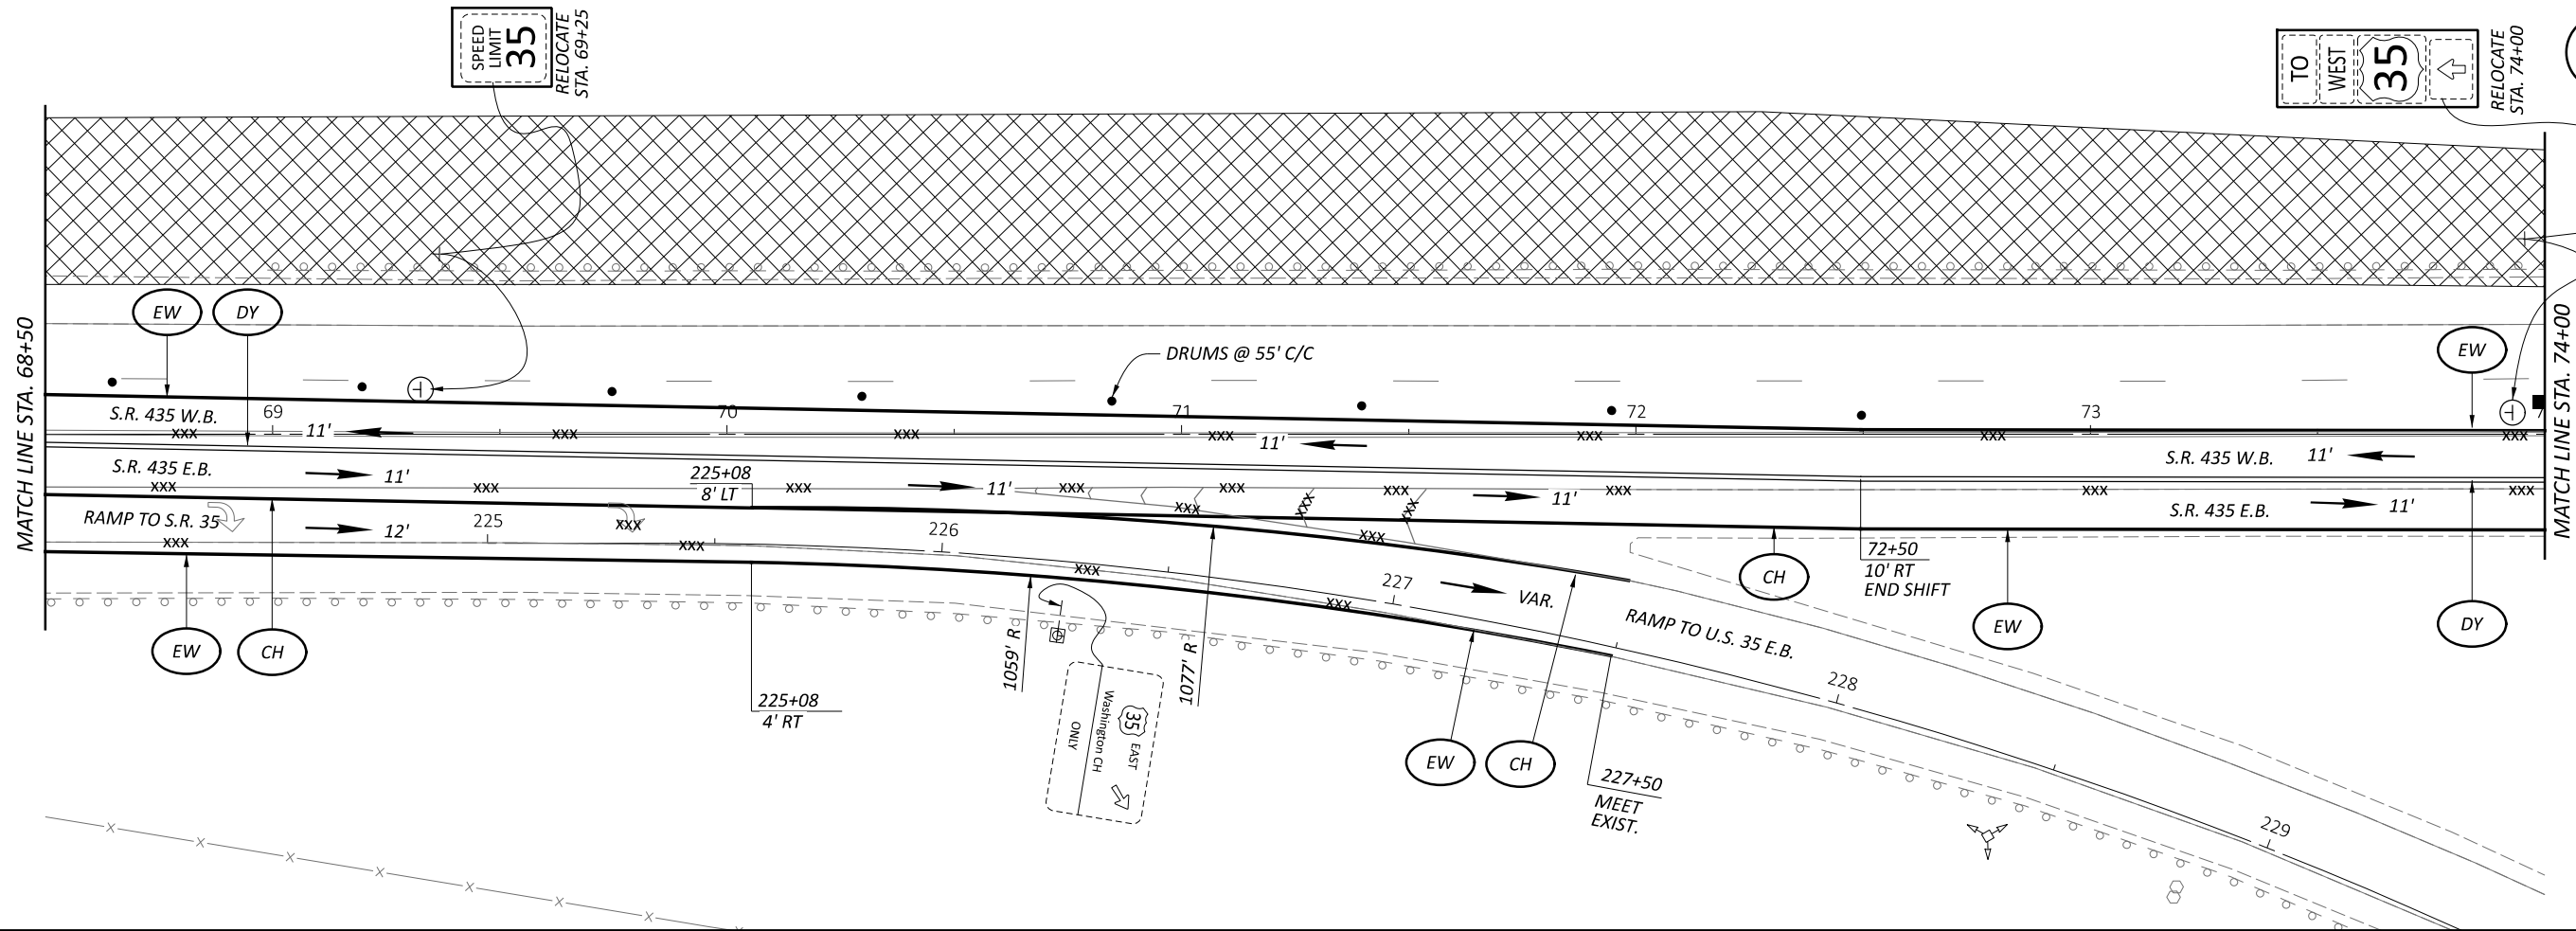


SEE SHEET P FOR LEGEND

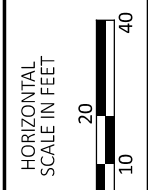


MAINTENANCE OF TRAFFIC (BU-5)
 PHASE 2 - S.R. 435 STA. 68+50 TO STA. 79+50

DESIGN AGENCY	
8350 E. KEMPER RD. SUITE B CINCINNATI, OH 45249 513-469-1600	
DESIGNER	
DPF	
REVIEWER	
DCJ MM-DD-YY	
PROJECT ID	
117955	
SHEET	TOTAL
P. 37	228

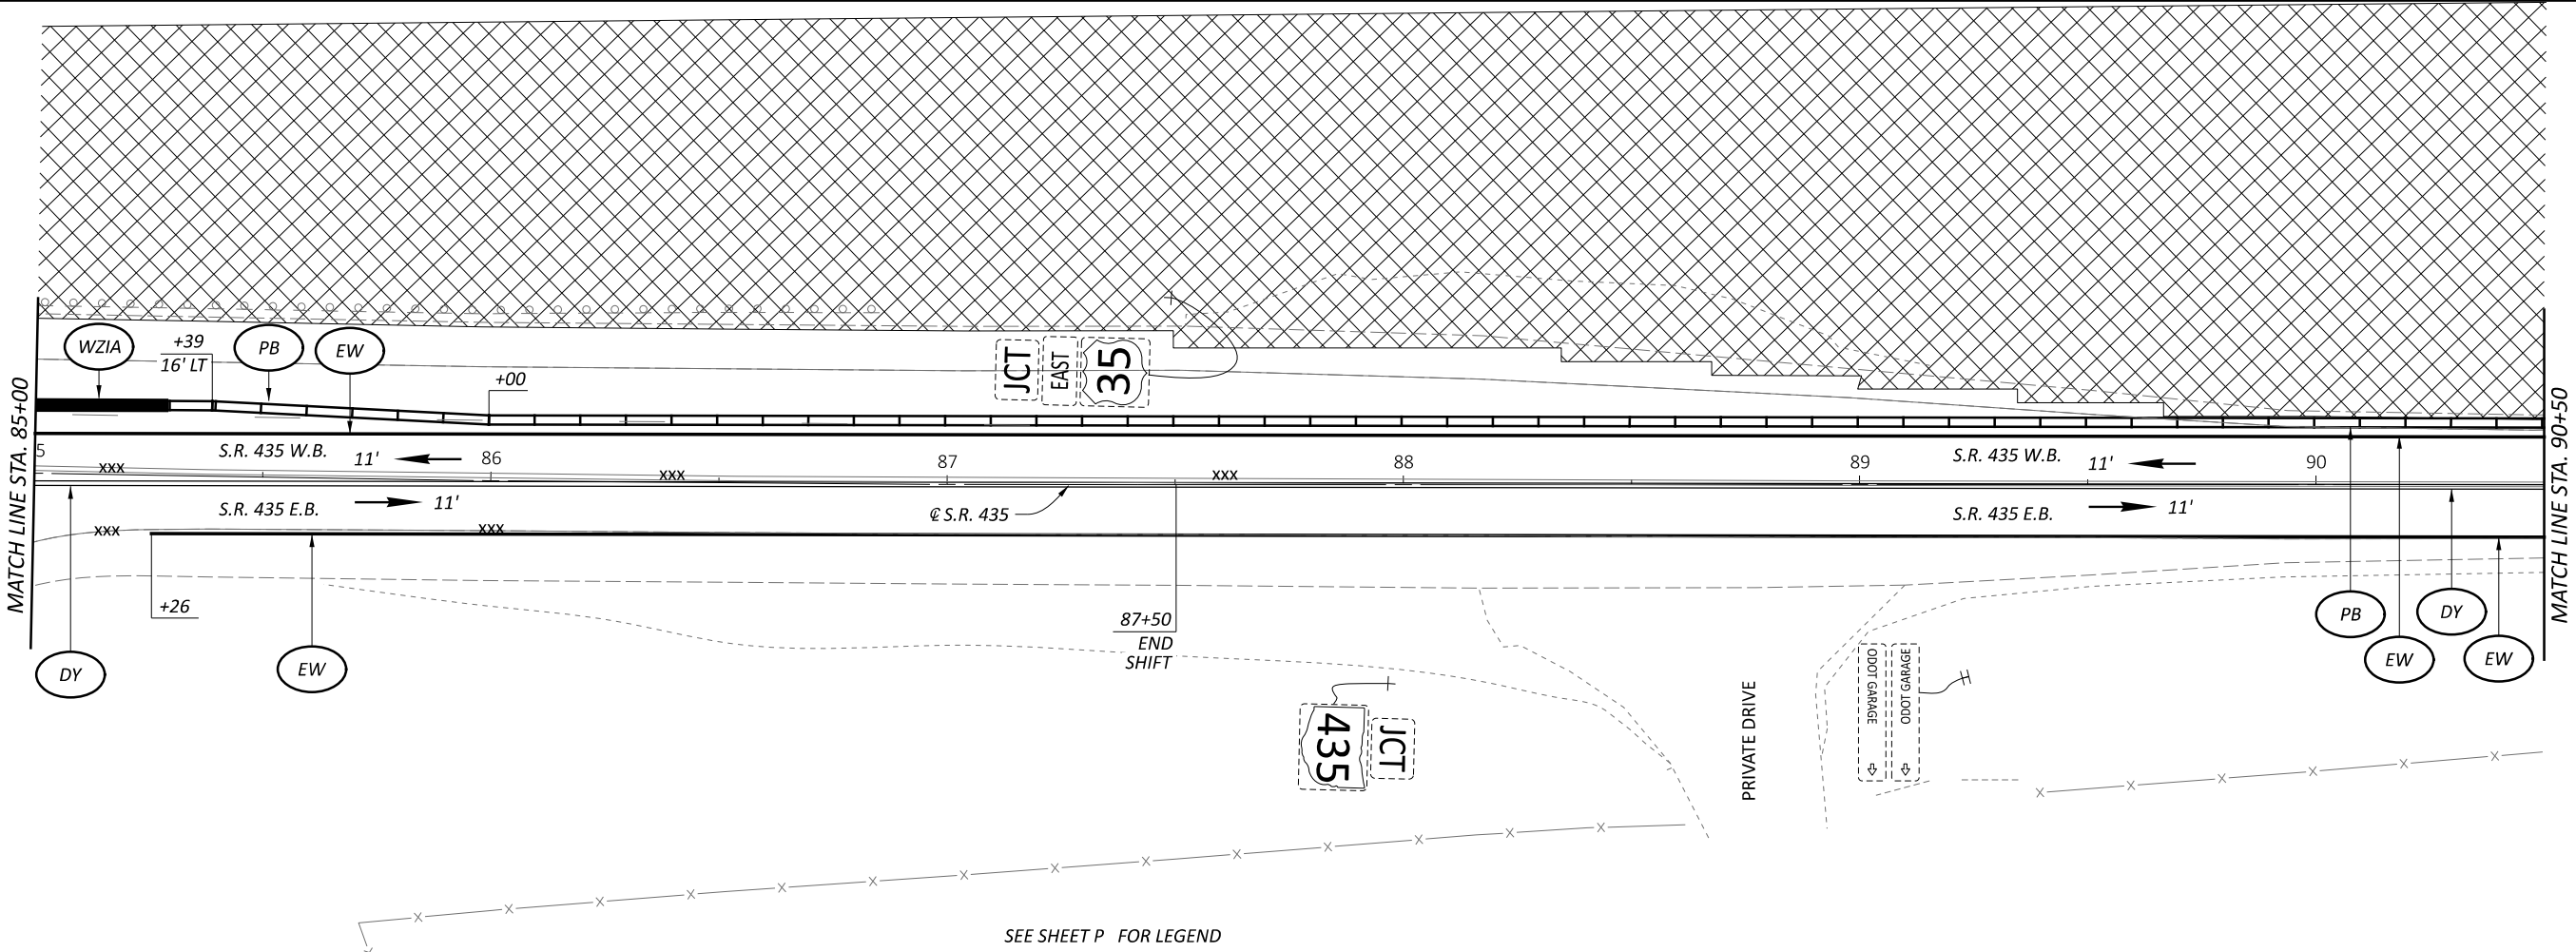
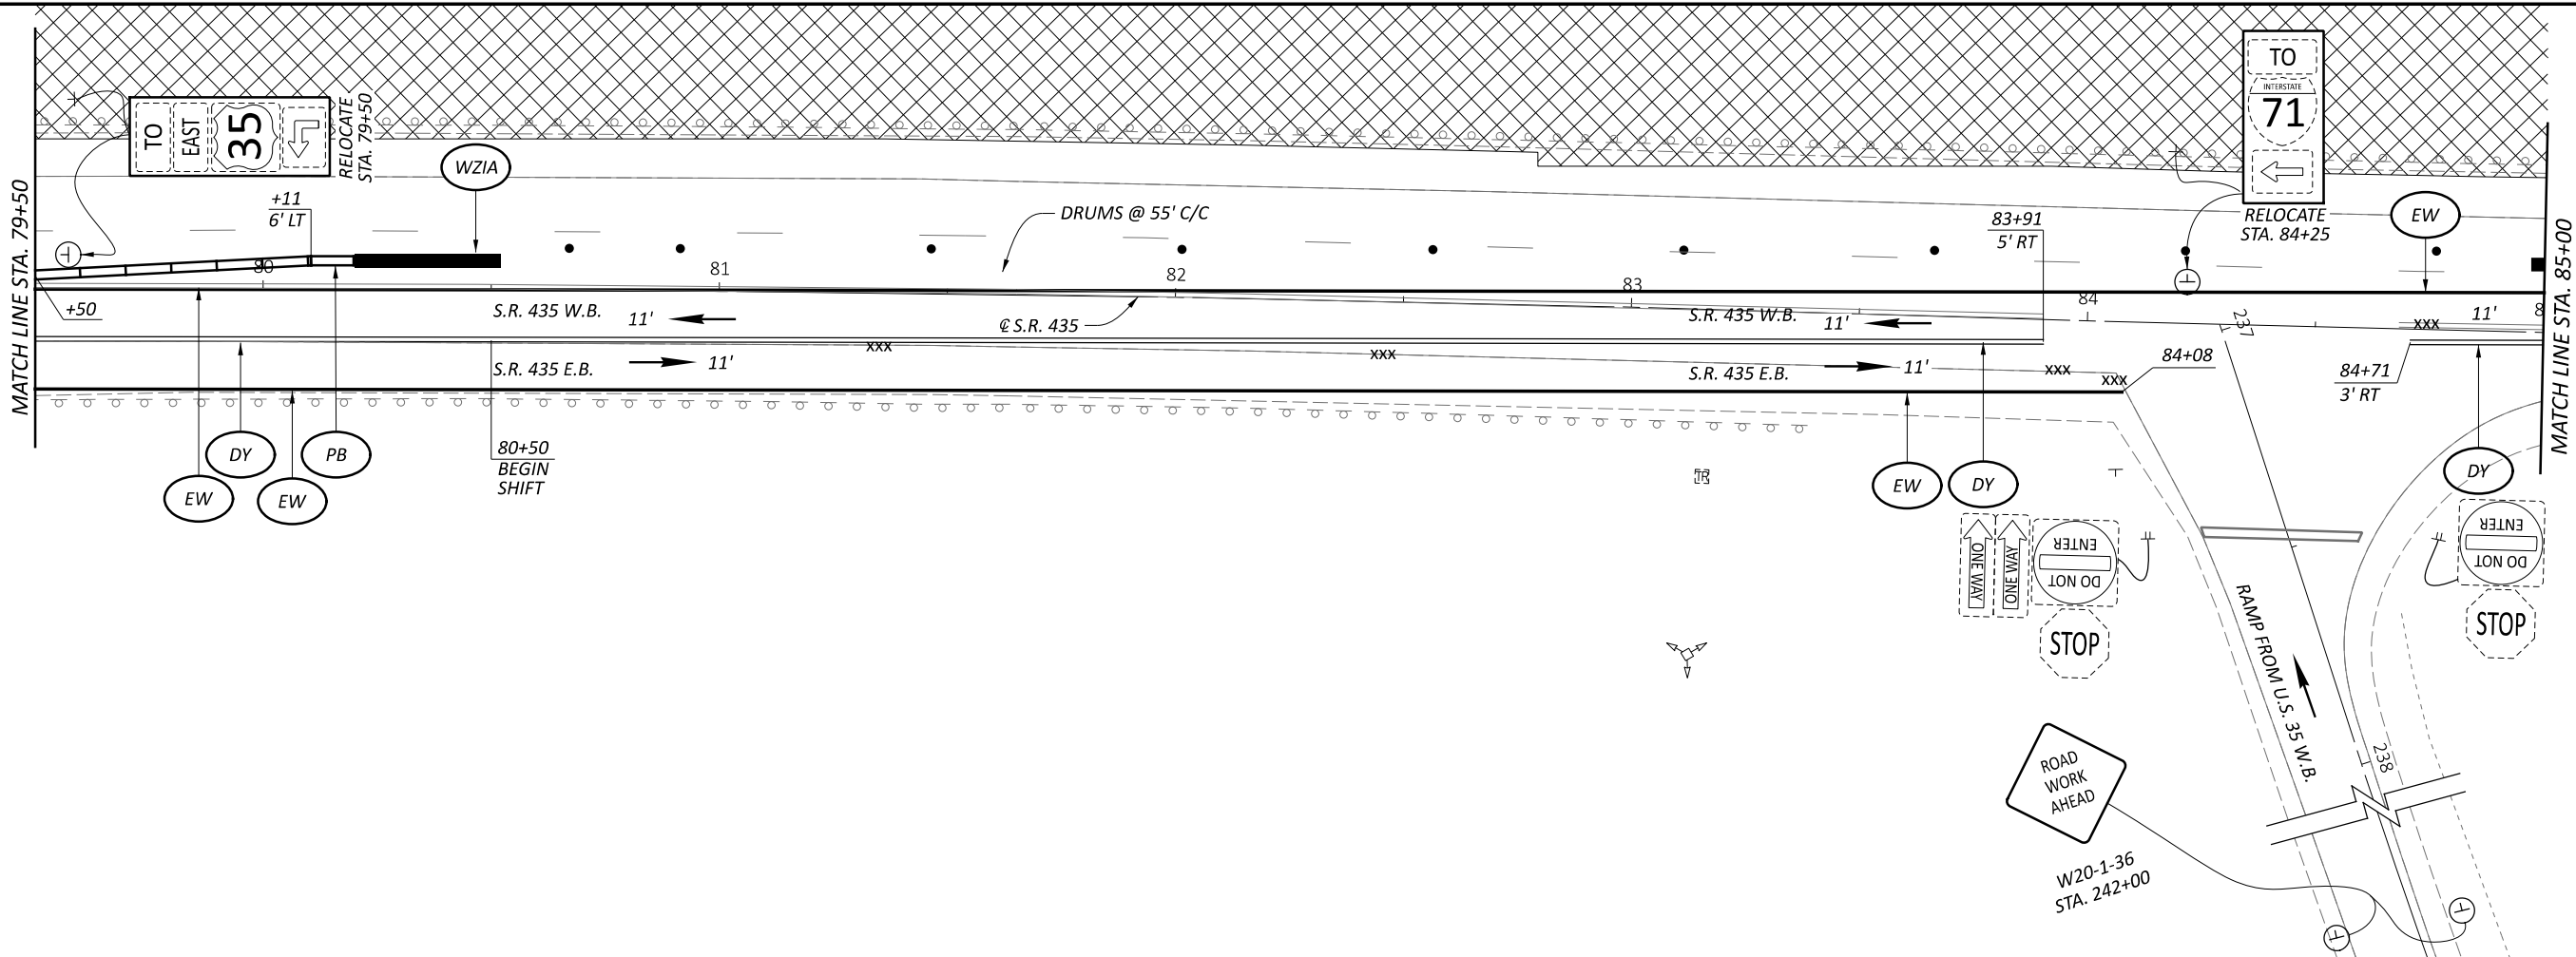


SEE SHEET P FOR LEGEND

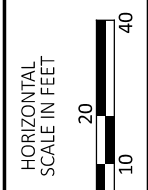

MAINTENANCE OF TRAFFIC (BU-5)
 PHASE 2 - S.R. 435 STA. 78+50 TO STA. 90+50

DESIGN AGENCY	
 8350 E. KEMPER RD. SUITE B CINCINNATI, OH 45249 513-469-1600	
DESIGNER	
DPF	
REVIEWER	
DCJ MM-DD-YY	
PROJECT ID	
117955	
SHEET	TOTAL
P. 38	228

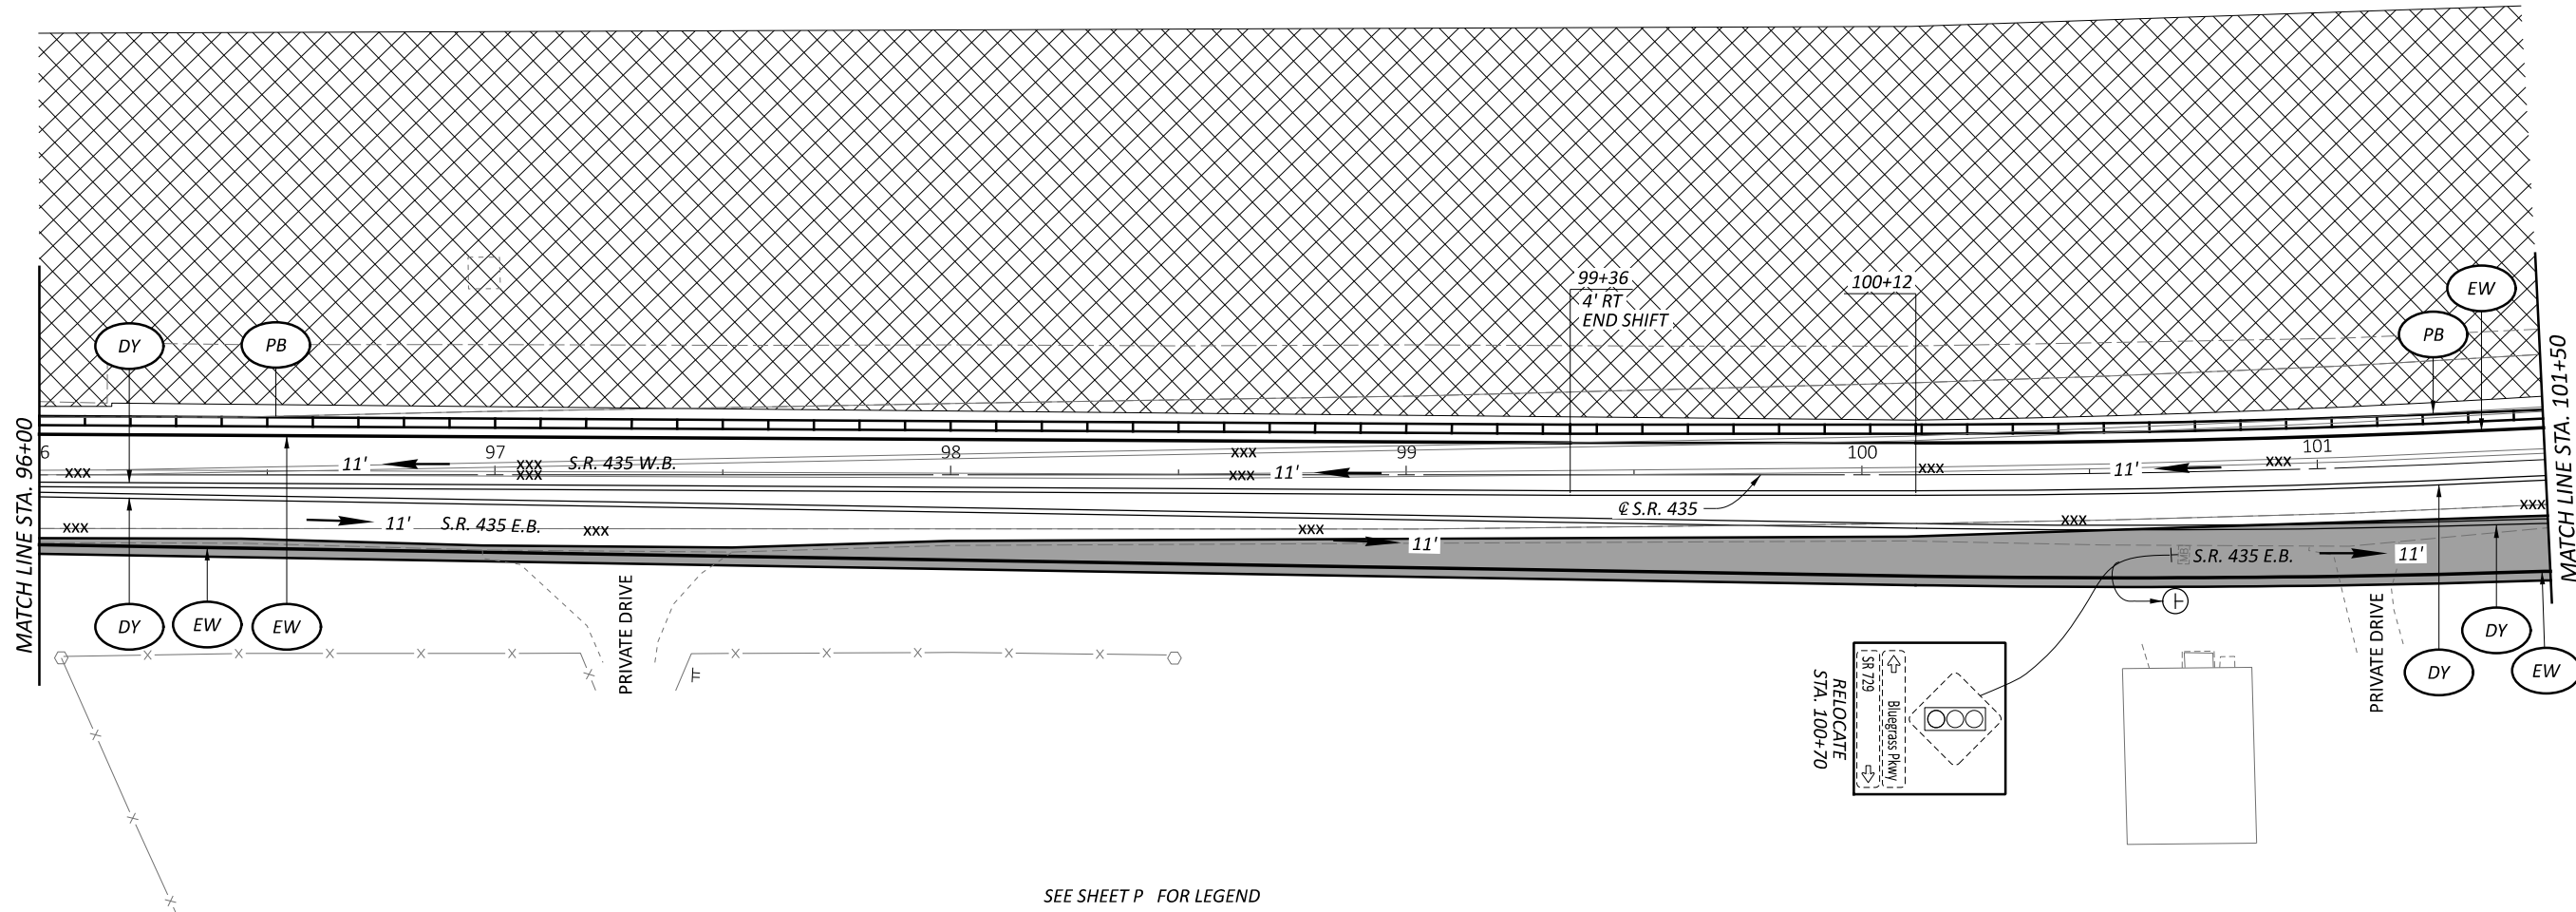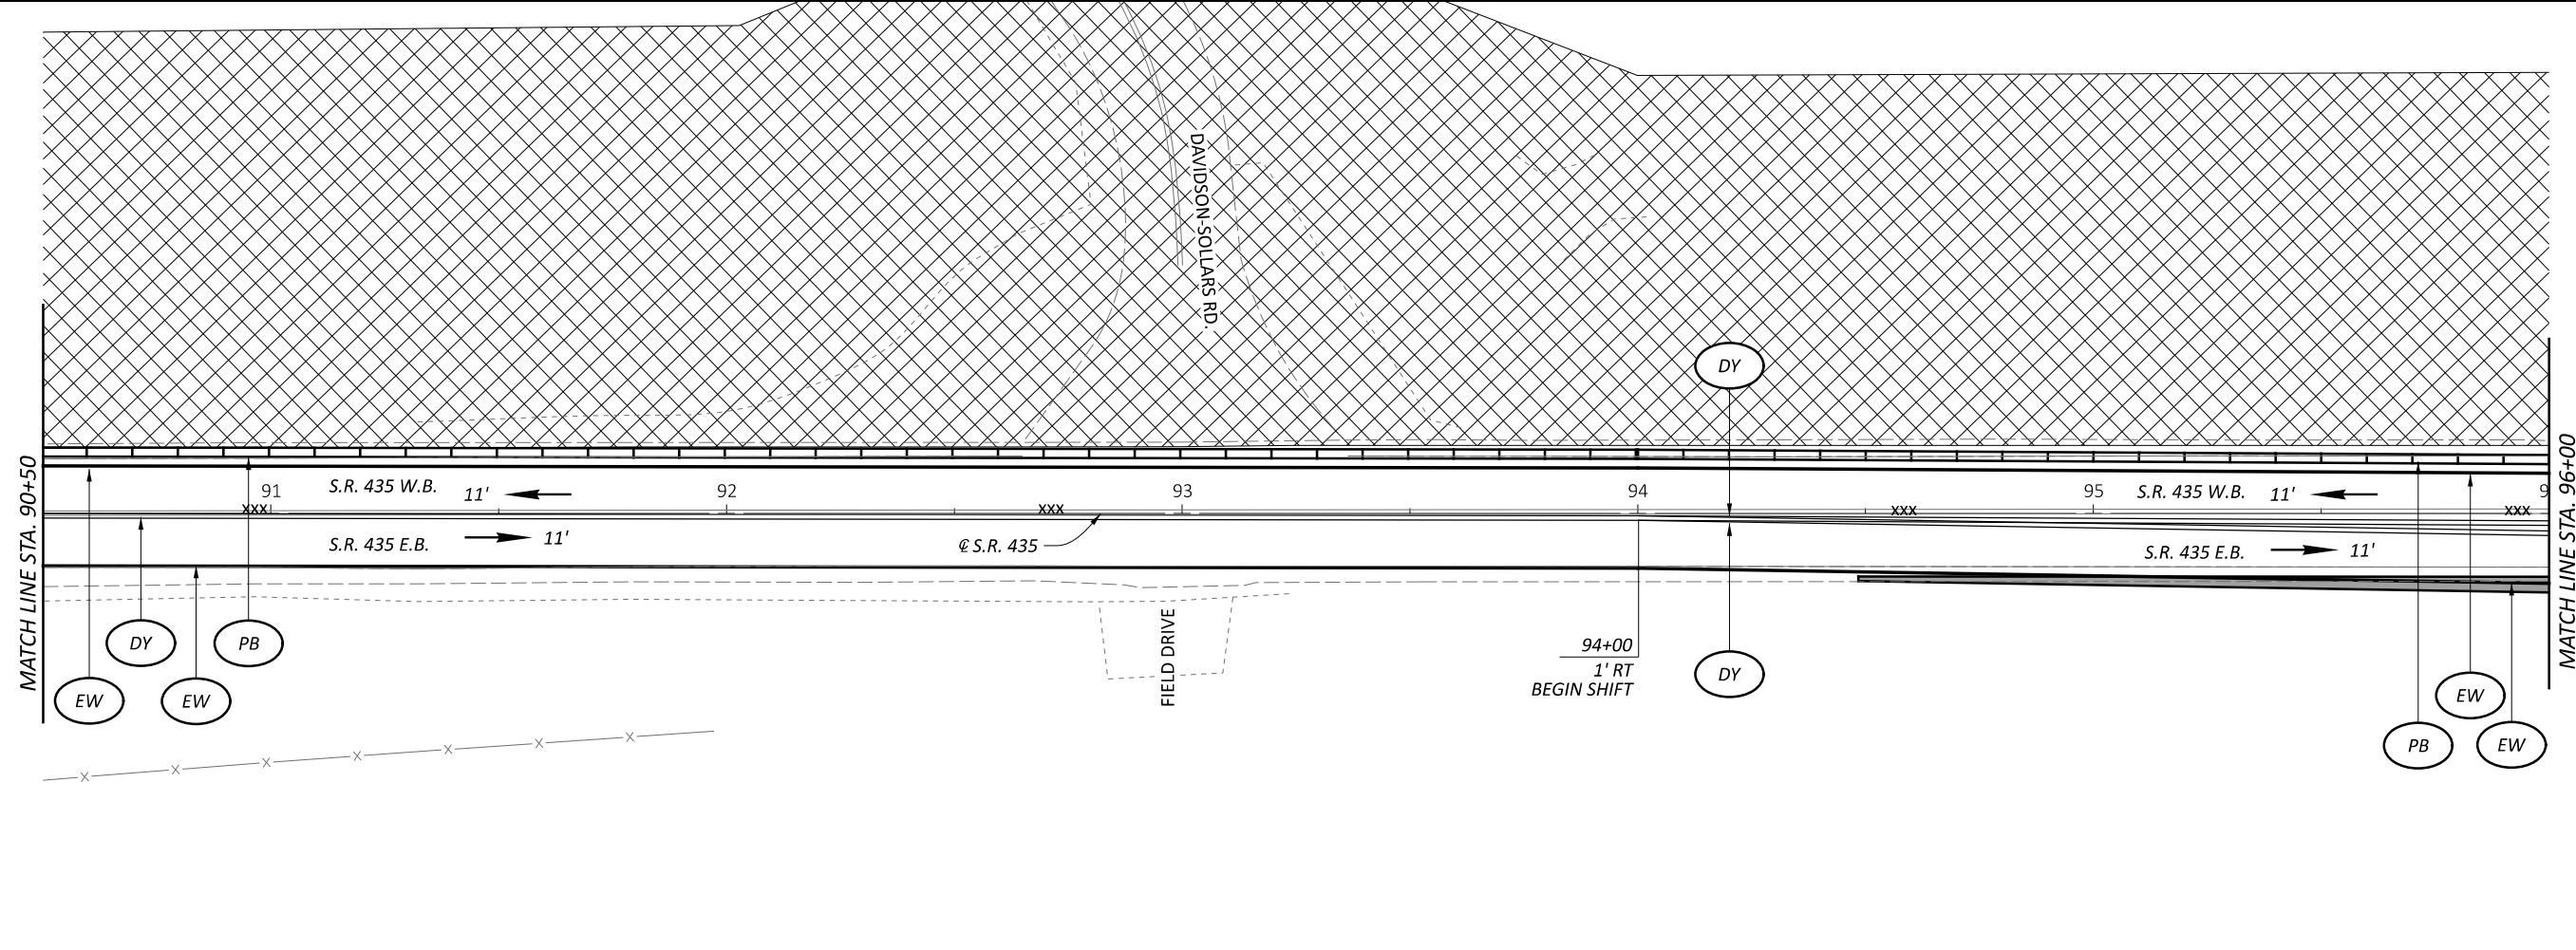

SEE SHEET P FOR LEGEND



MAINTENANCE OF TRAFFIC (BU-5)
 PHASE 2 - S.R. 435 STA. 90+50 TO STA. 101+50

DESIGN AGENCY




Palmer
 ENGINEERING
 8350 E. KEMPER RD.
 SUITE B
 CINCINNATI, OH 45249
 513-469-1600

DESIGNER
 DPF

REVIEWER
 DCJ MM-DD-YY

PROJECT ID
 117955




SHEET TOTAL
 P. 39 | 228

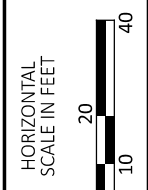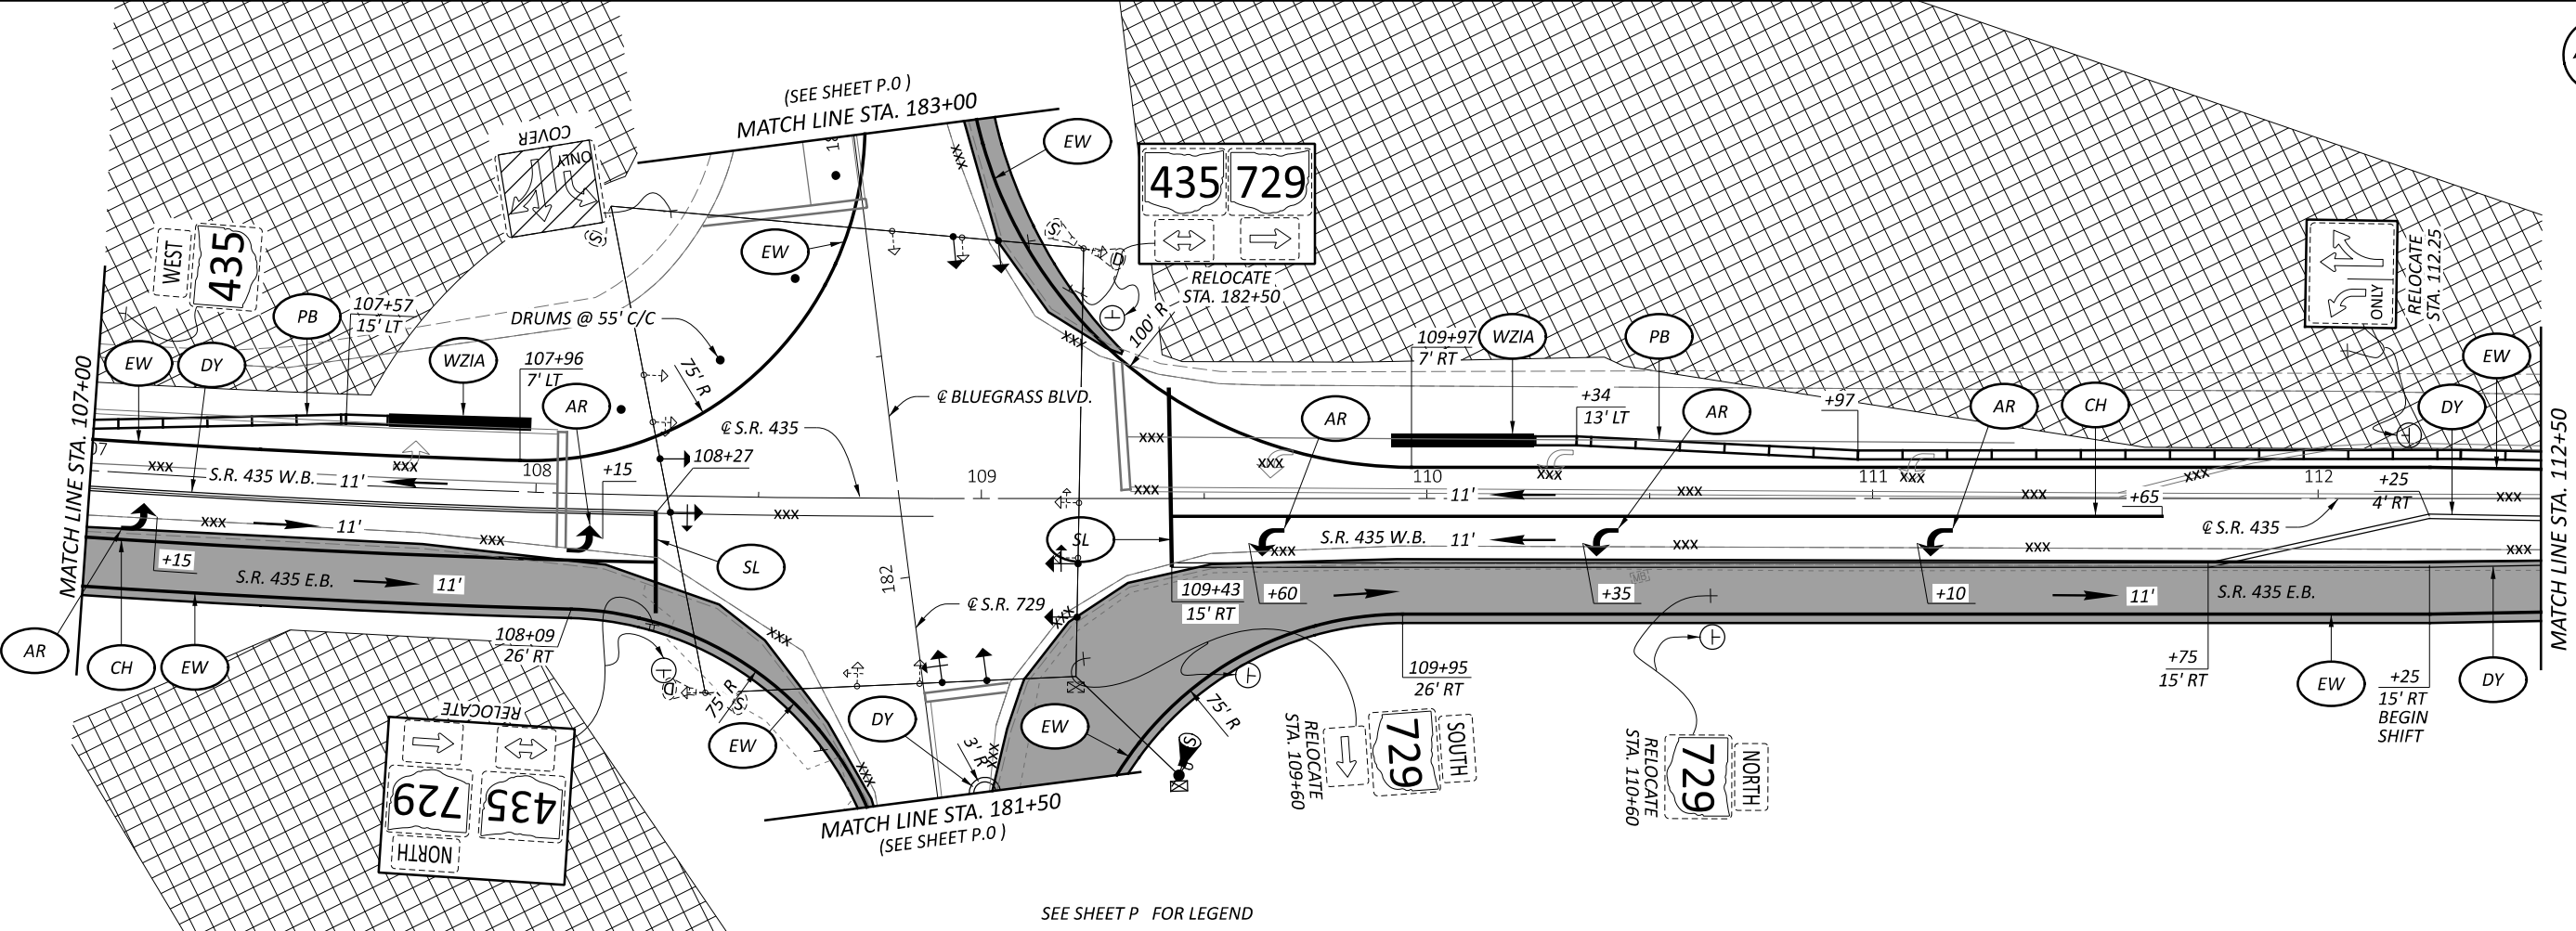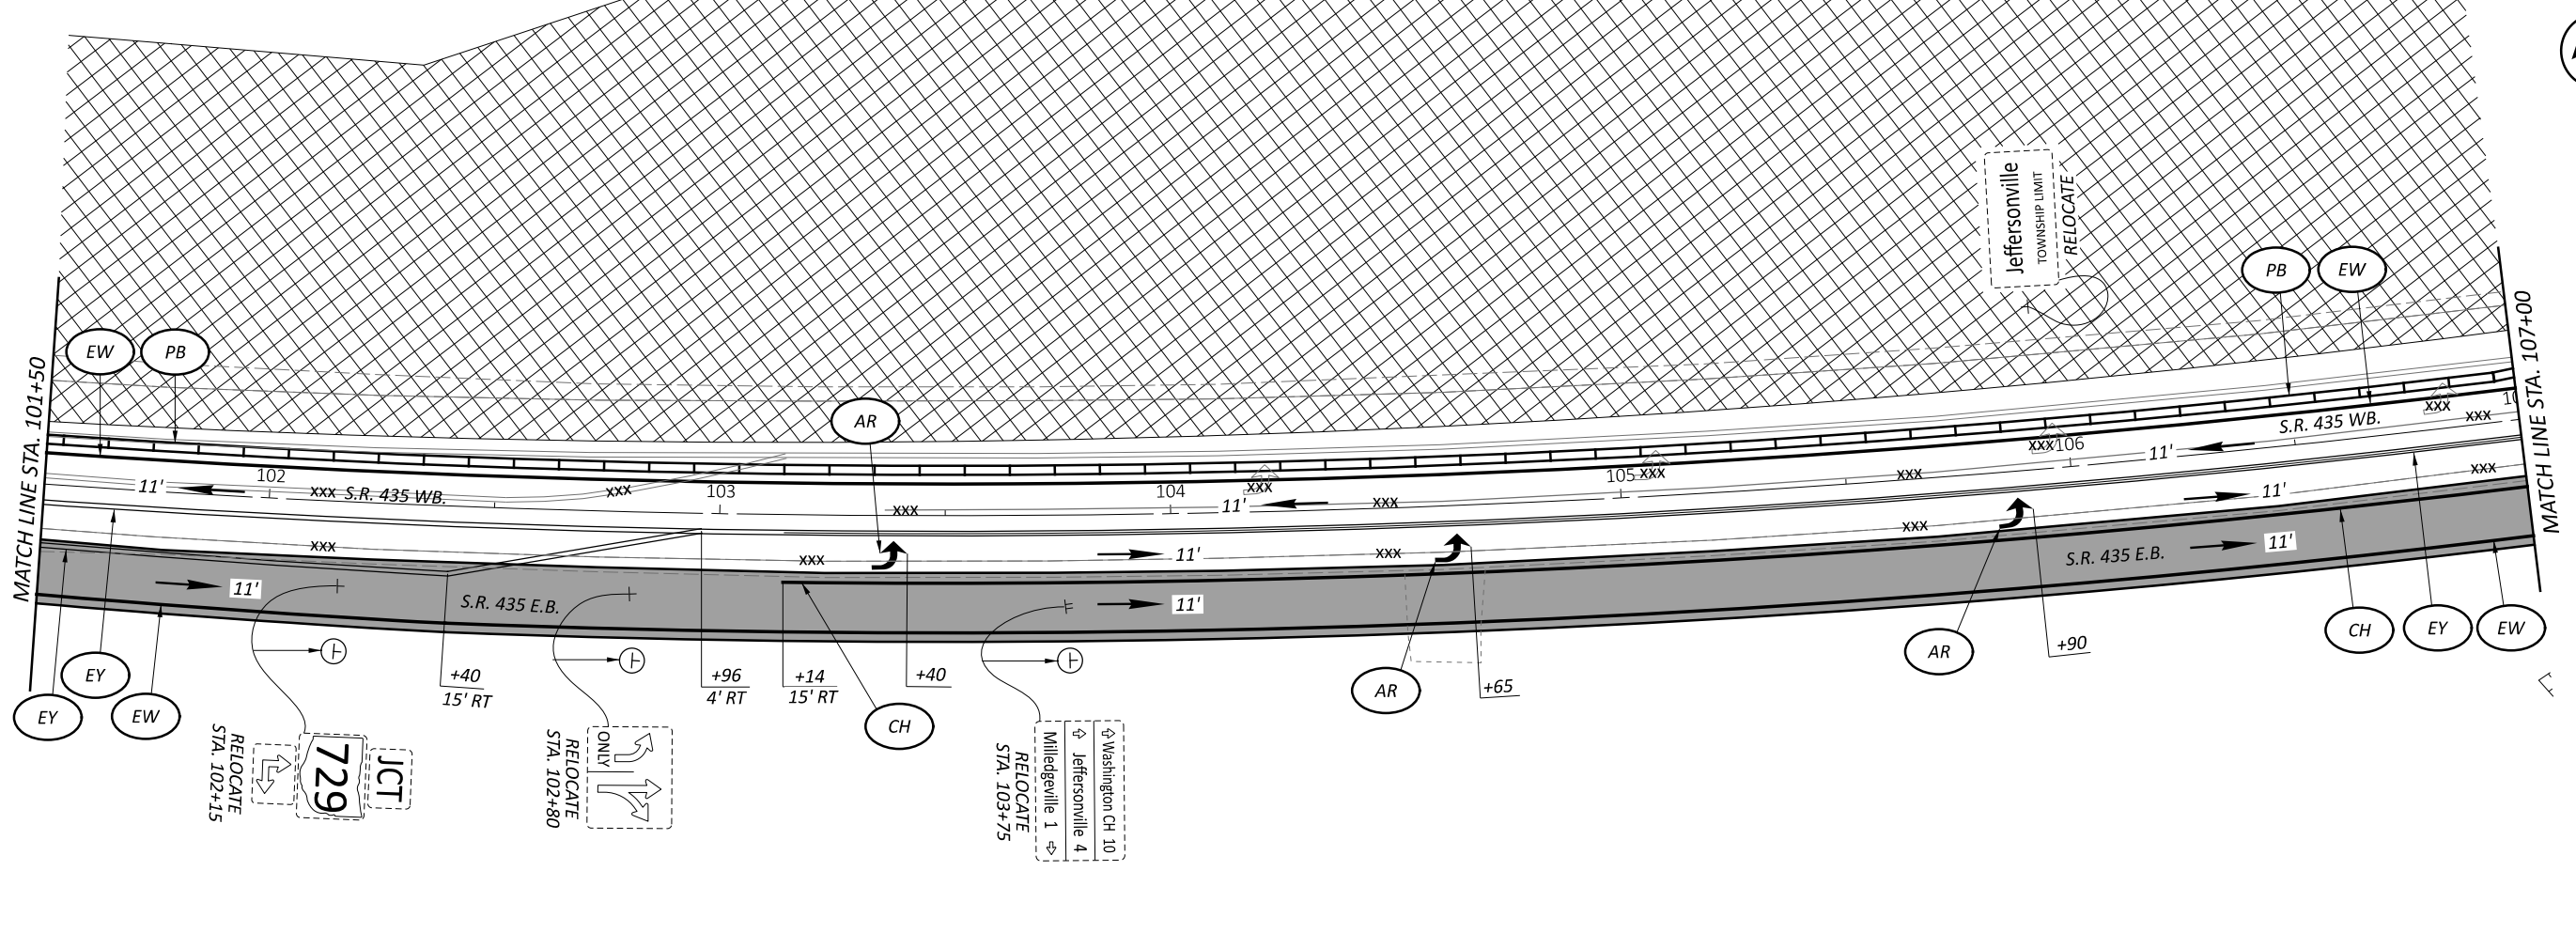

MAINTENANCE OF TRAFFIC (BU-5)
 PHASE 2 - S.R. 435 STA. 101+50 TO STA. 112+50

SEE SHEET P FOR LEGEND




DESIGN AGENCY	
Palmer ENGINEERING	
8350 E. KEMPER RD. SUITE B CINCINNATI, OH 45249 513-469-1600	
DESIGNER	
DPF	
REVIEWER	
DCJ MM-DD-YY	
PROJECT ID	
117955	
SHEET	TOTAL
P. 40	228

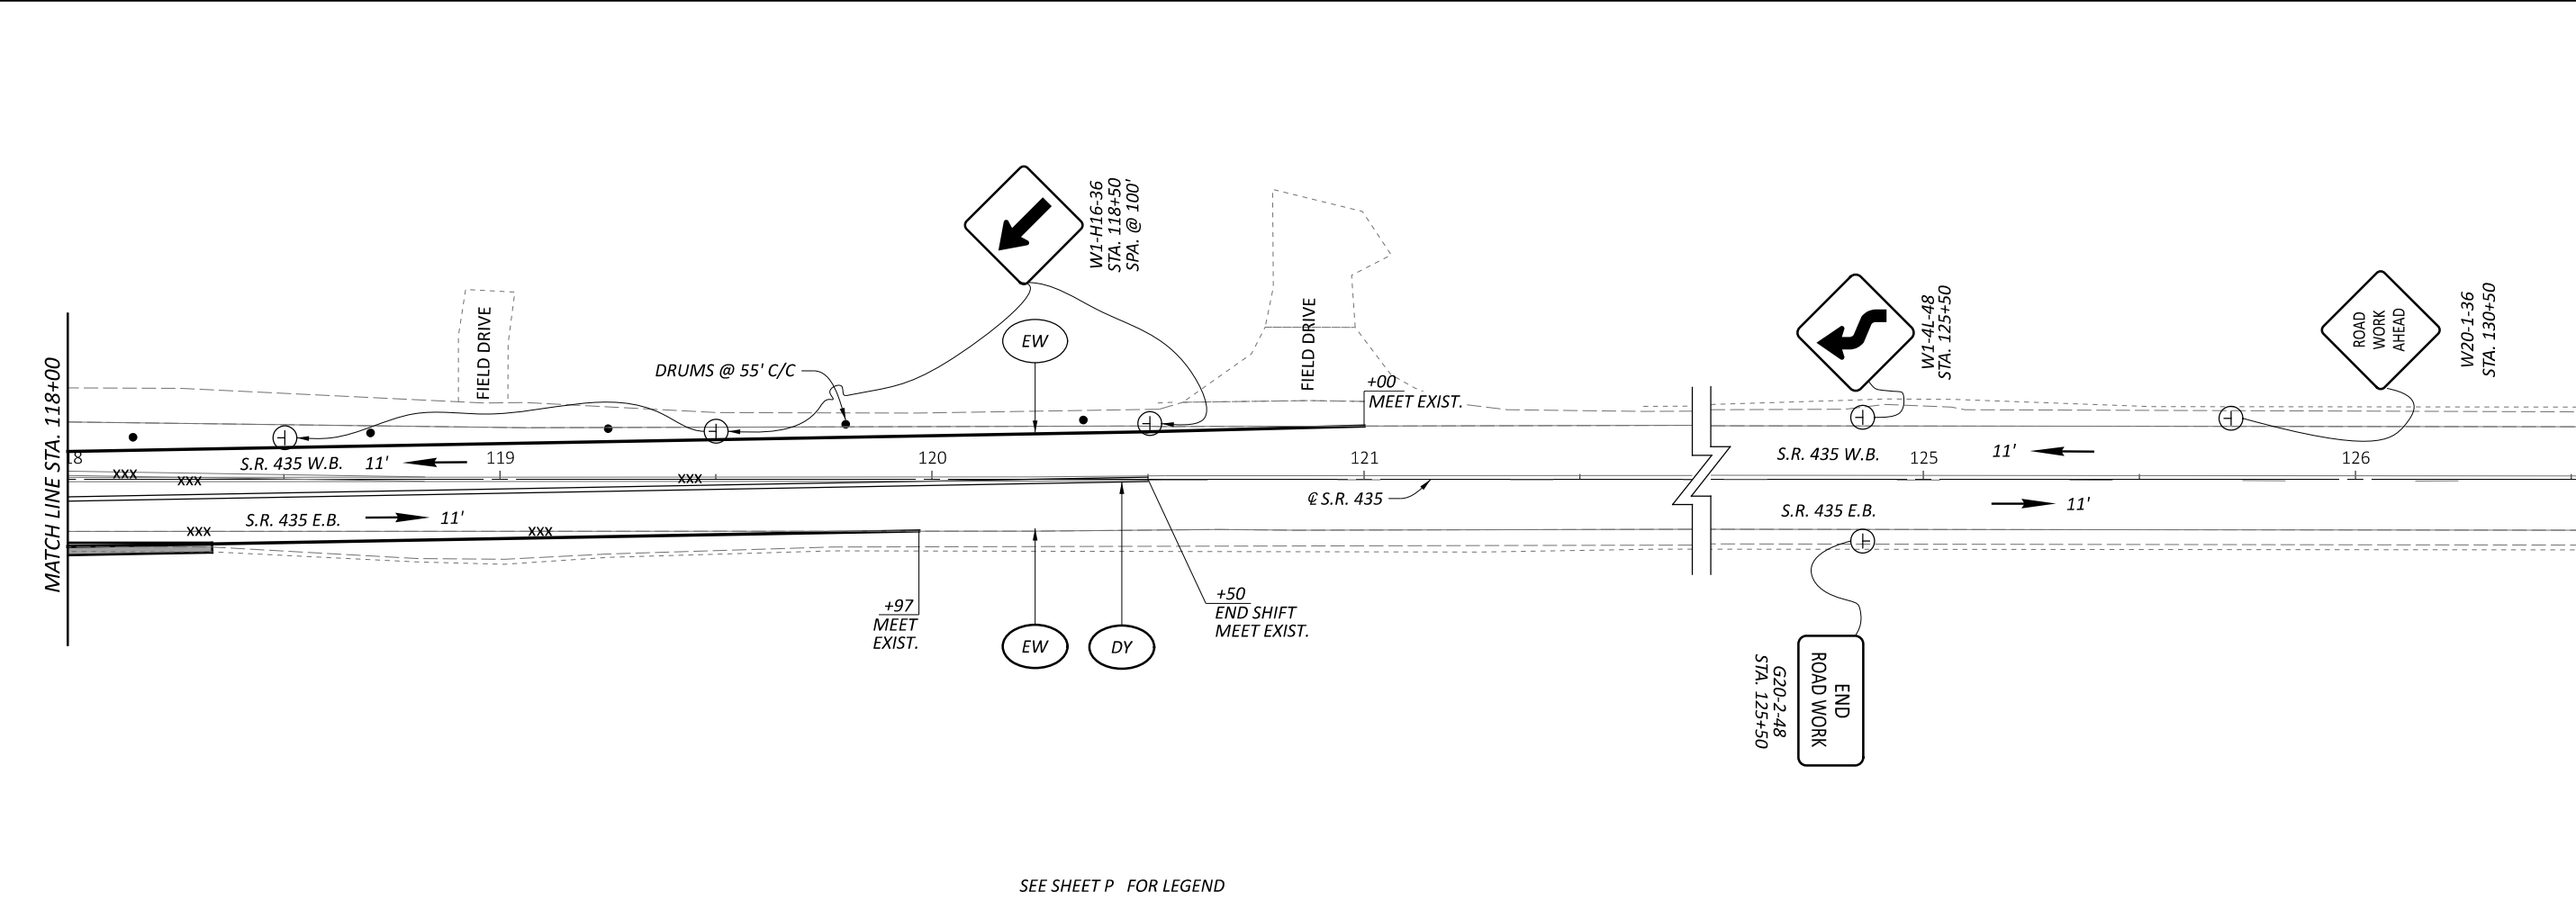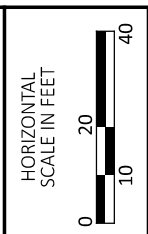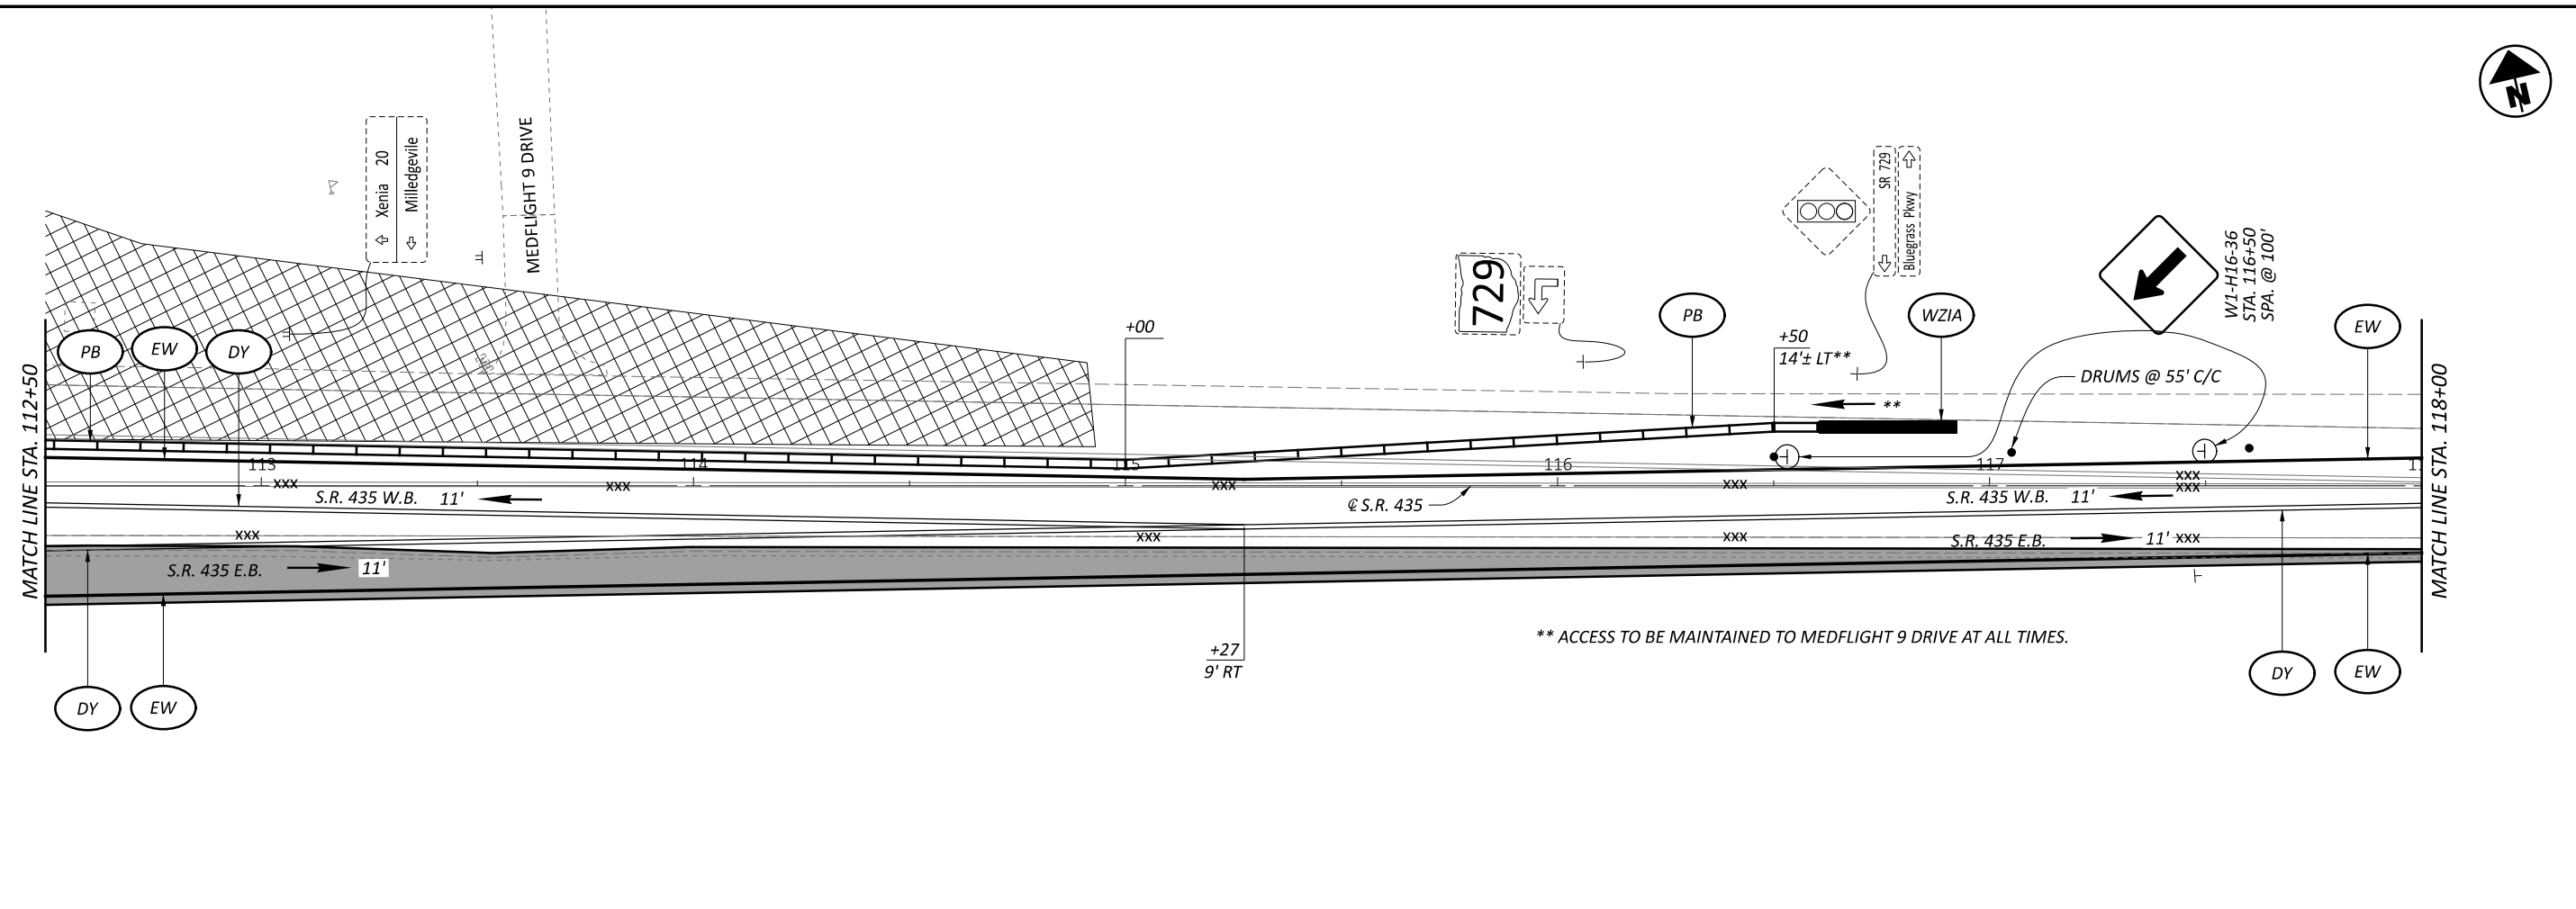

MAINTENANCE OF TRAFFIC (BU-5)
 PHASE 2 - S.R. 435 STA. 112+50 TO STA. 130+50

DESIGN AGENCY	
Palmer ENGINEERING	
8350 E. KEMPER RD. SUITE B CINCINNATI, OH 45249 513-469-1600	
DESIGNER	DPF
REVIEWER	DCJ MM-DD-YY
PROJECT ID	117955
SHEET	TOTAL
P. 41	228


SEE SHEET P FOR LEGEND

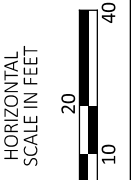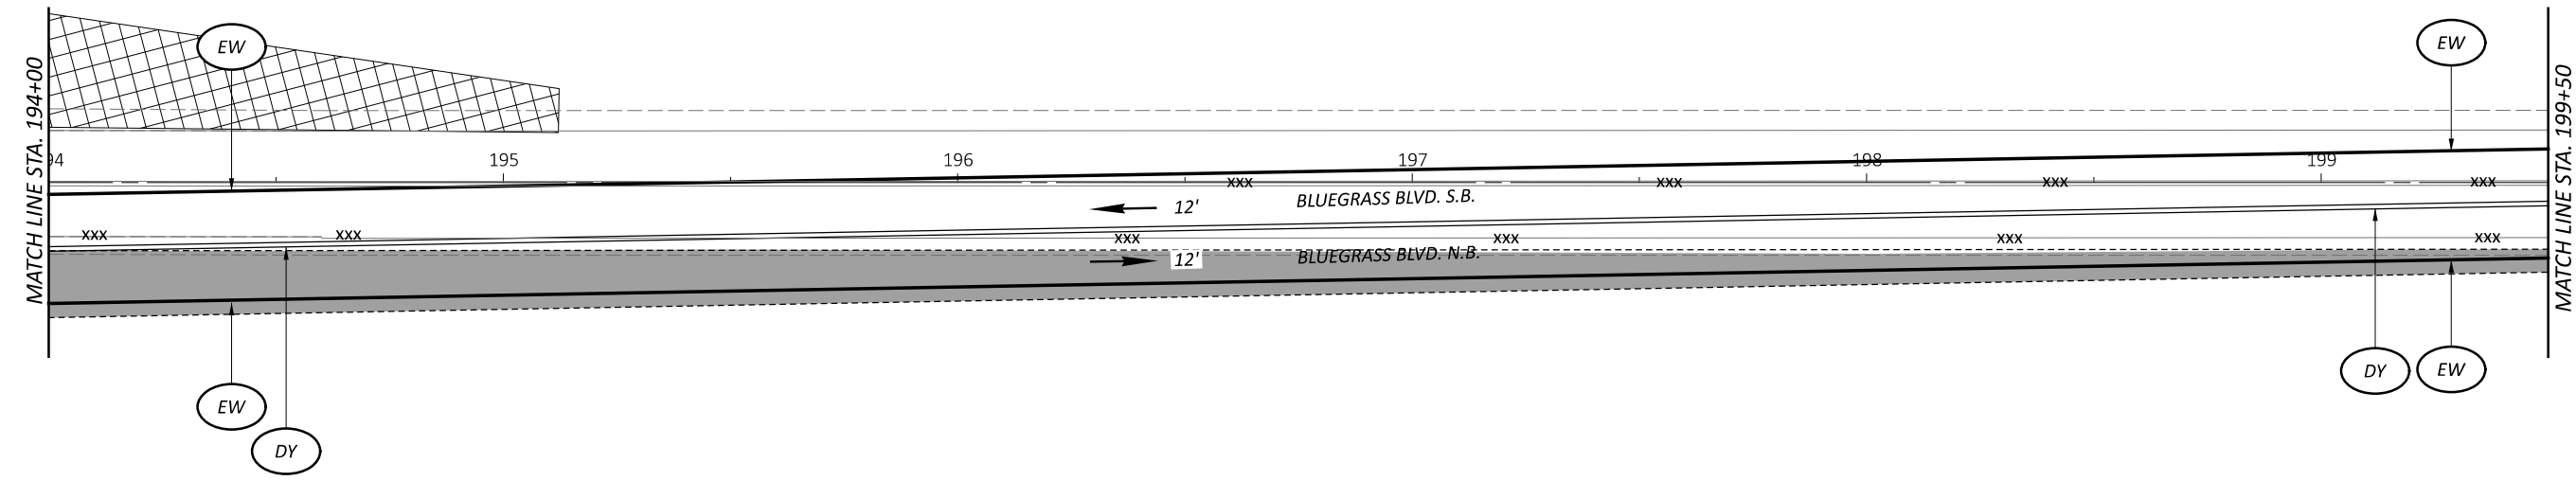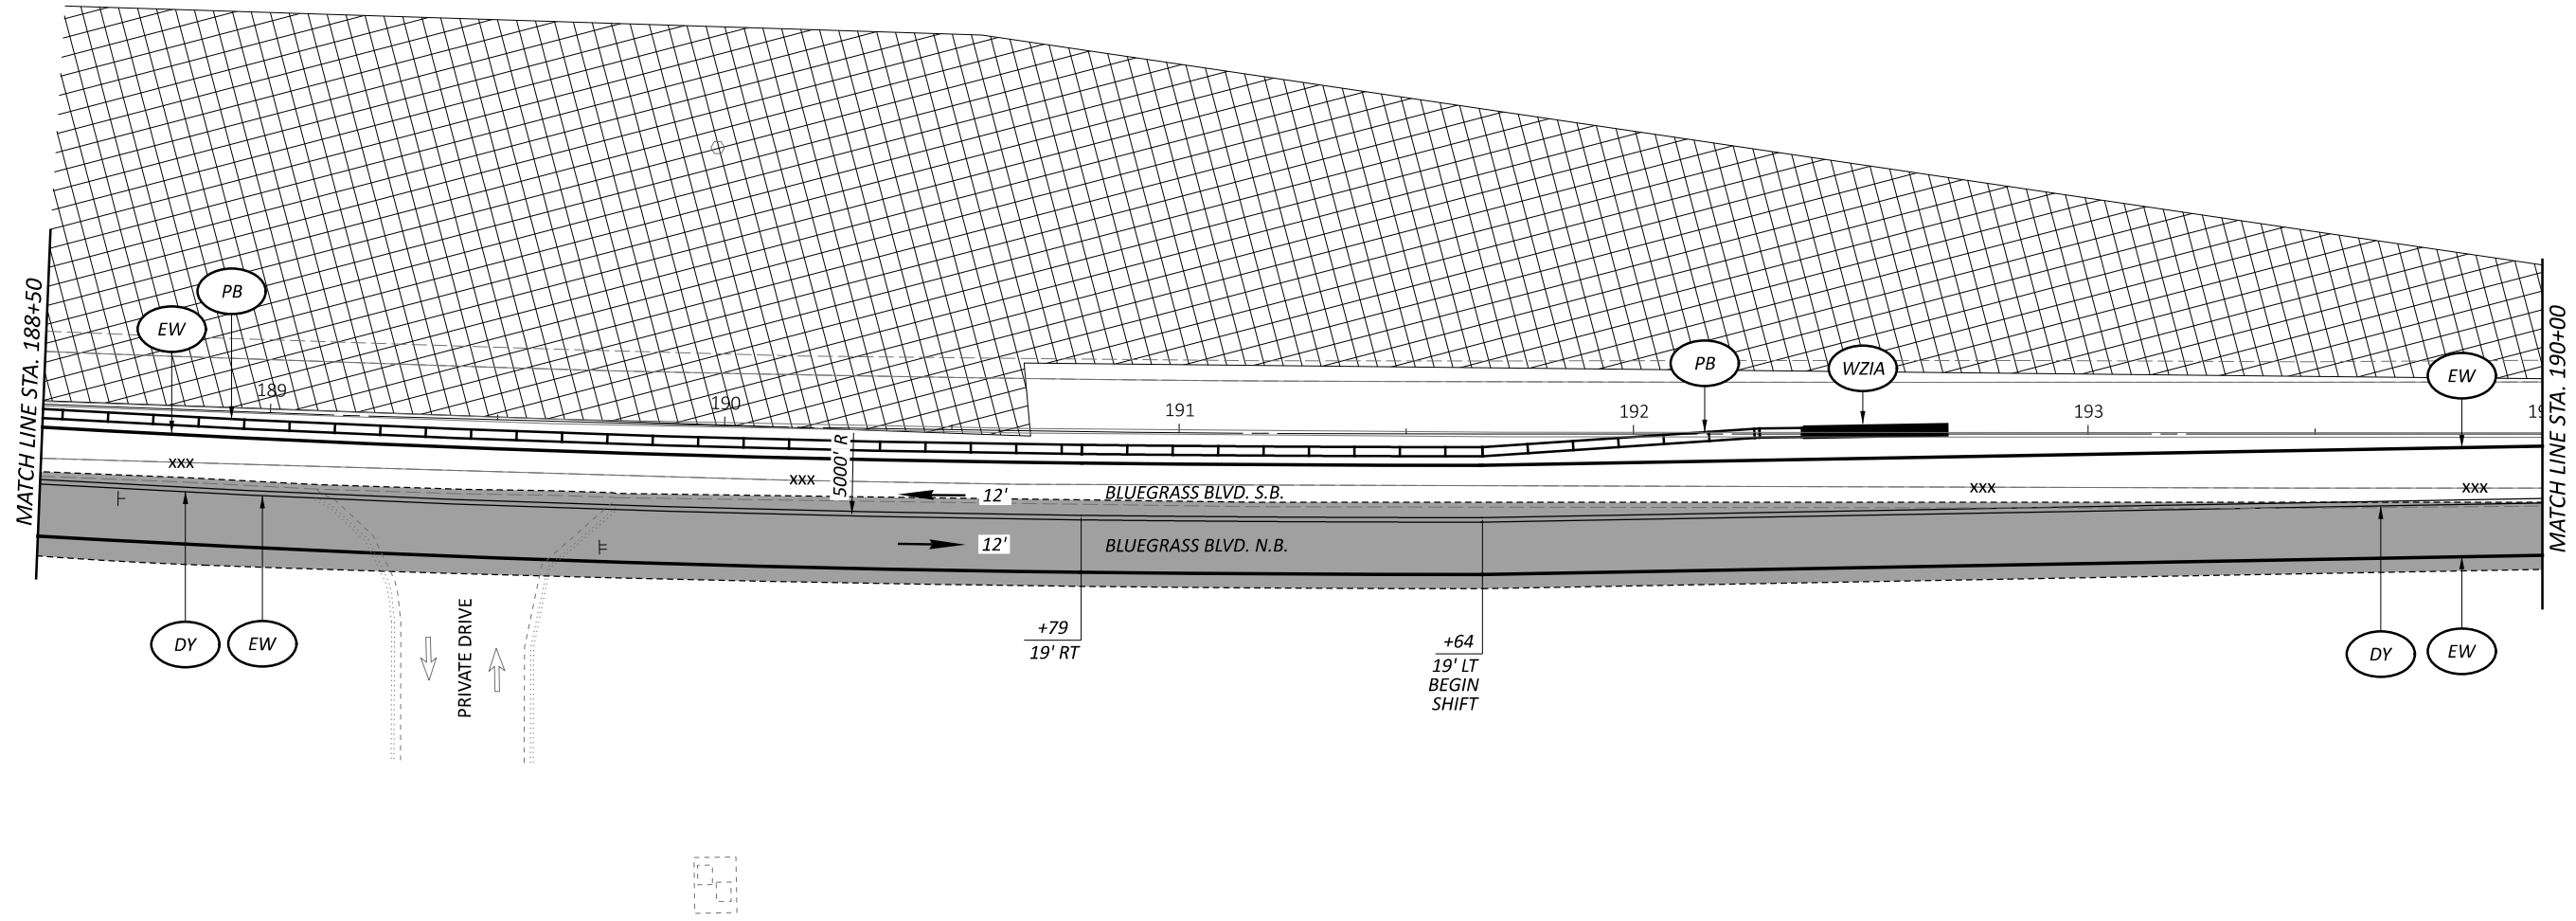


MAINTENANCE OF TRAFFIC (BU-5)
 PHASE 2 - BLUEGRASS BLVD. STA. 188+50 TO STA. 199+50

SEE SHEET P FOR LEGEND

DESIGN AGENCY	
8350 E. KEMPER RD. SUITE B CINCINNATI, OH 45249 513-469-1600	
DESIGNER	
DPF	
REVIEWER	
DCJ MM-DD-YY	
PROJECT ID	
117955	
SHEET	TOTAL
P. 43	228

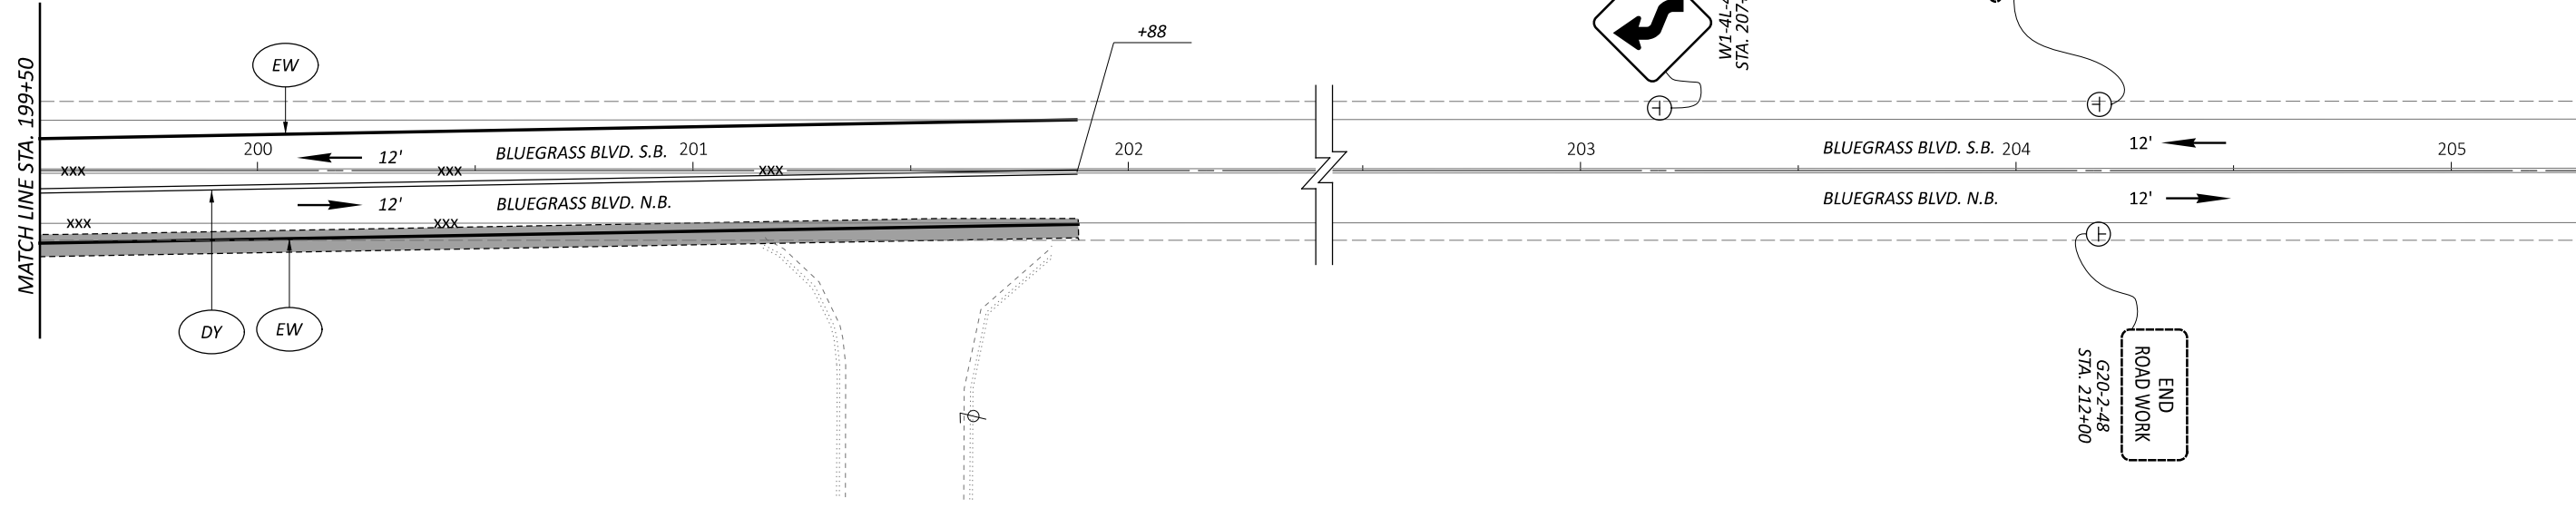

SEE SHEET P FOR LEGEND

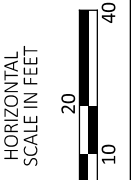

MAINTENANCE OF TRAFFIC (BU-5)
PHASE 2 - BLUEGRASS BLVD. STA. 199+50 TO STA. 212+00

DESIGN AGENCY



DESIGNER
DPF

REVIEWER
DCJ MM-DD-YY

PROJECT ID
117955

SHEET	TOTAL
P. 44	228

HATCH LEGEND

	PROPOSED WORK ZONE
	PAVEMENT FOR M.O.T., CLASS A




SIGN LEGEND

	REMOVE AND DISPOSE OF EXISTING SIGN		EXISTING SIGN TO REMAIN
	PROPOSED SIGN		COVER EXISTING SIGN

xxx = REMOVAL OF EXISTING PAVEMENT MARKINGS

BALLOON LEGEND

	WORK ZONE EDGE LINE (Y), 4"		PORTABLE BARRIER, UNANCHORED		WORK ZONE DOTTED LINE, (W), 4"
	WORK ZONE EDGE LINE (W), 4"		WORK ZONE ISLAND MARKING		WORK ZONE DOTTED LINE, (Y), 4"
	WORK ZONE STOP LINE (W) 24"		WORK ZONE CHANNELIZING LINE, 8"		WORK ZONE YIELD LINE, (W)
	WORK ZONE DOUBLE SOLID LINE, (Y), 4"		WORK ZONE LANE ARROW		WORK ZONE IMPACT ATTENUATOR

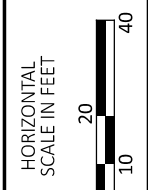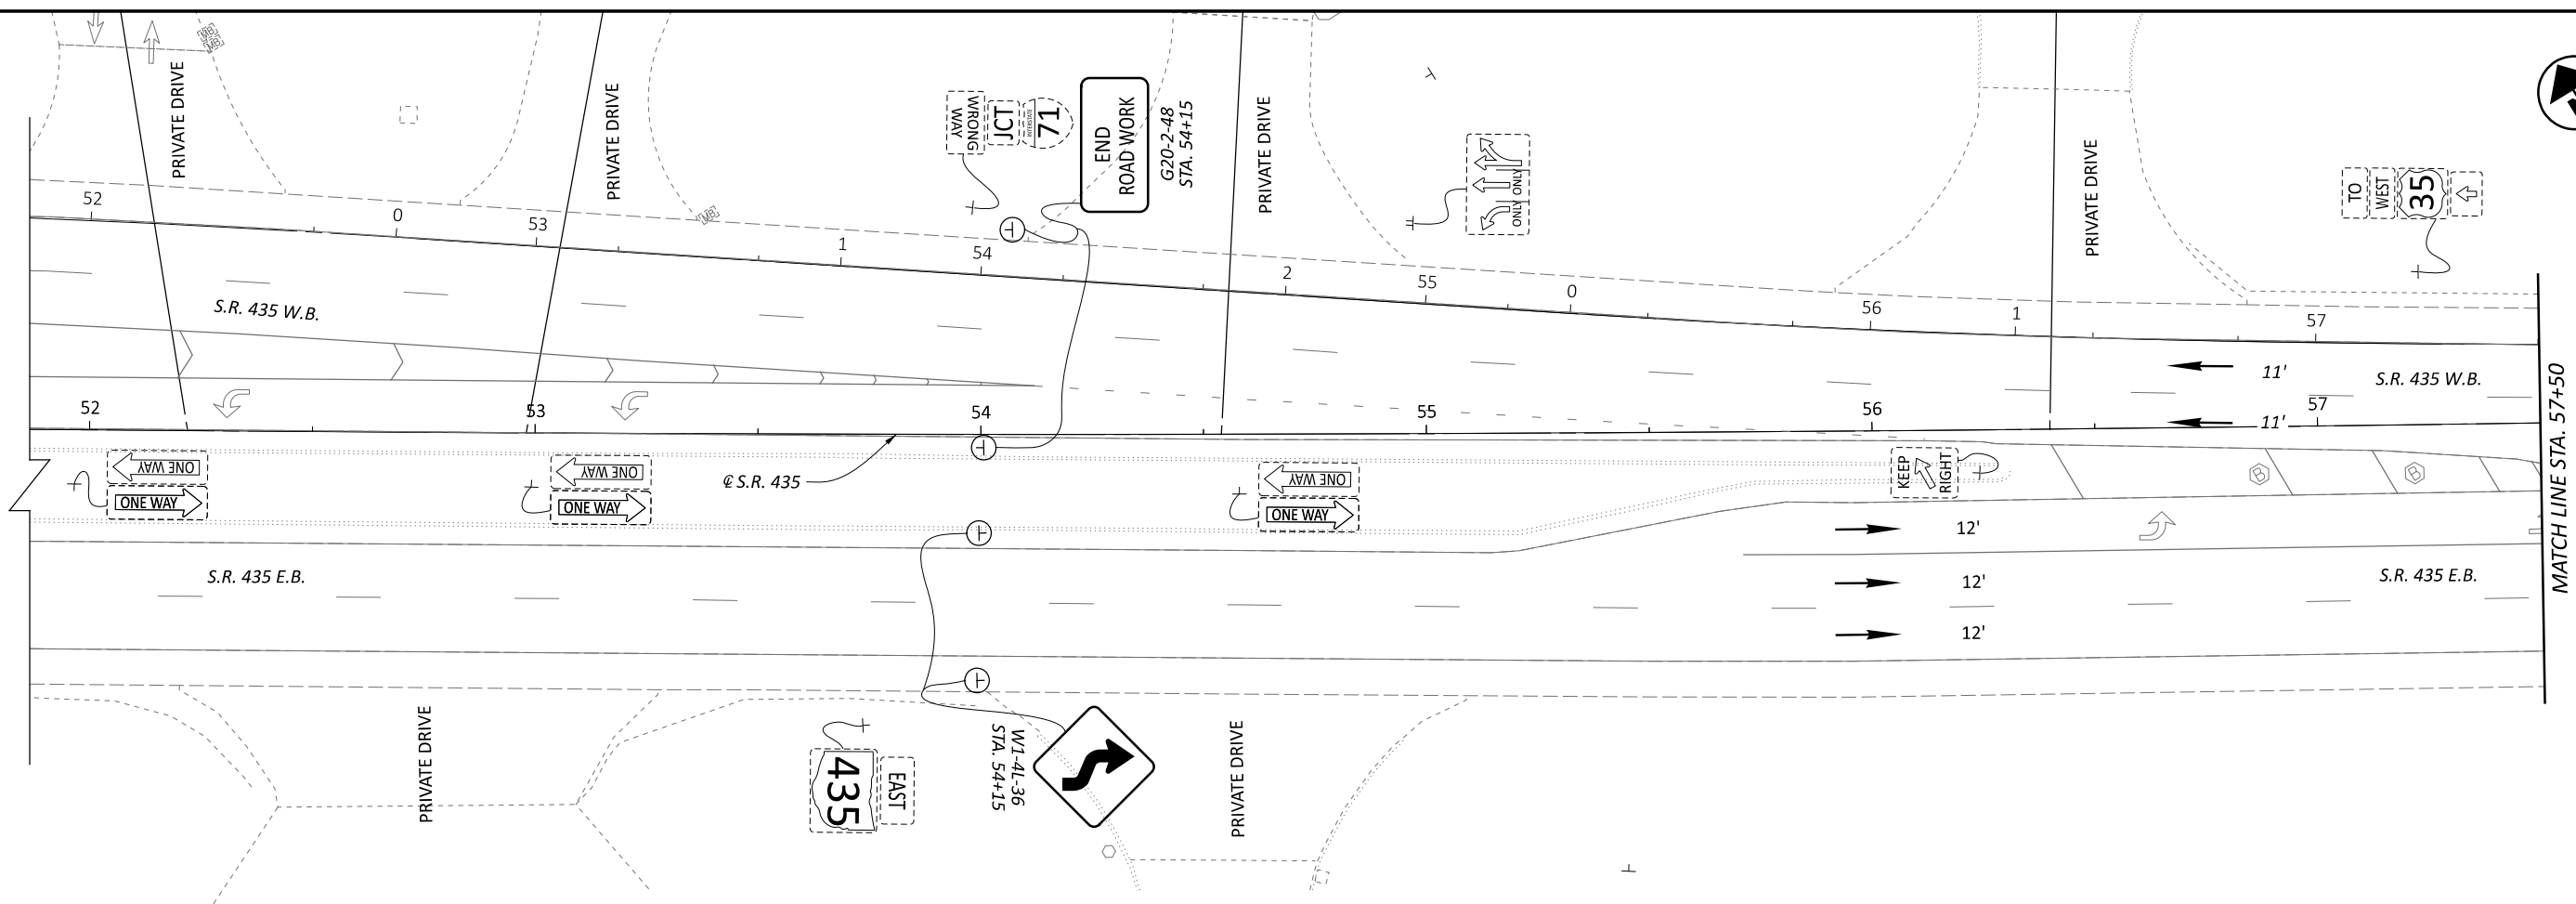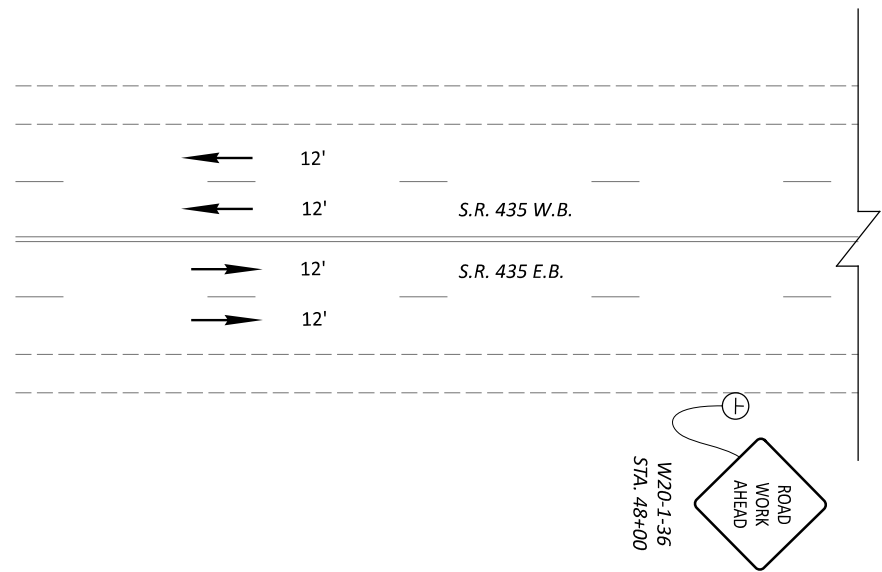

MAINTENANCE OF TRAFFIC (BU5)
 PHASE 3 - S.R. 435 STA. 48+00 TO STA. 57+50

DESIGN AGENCY



Palmer
 ENGINEERING
 8350 E. KEMPER RD.
 SUITE B
 CINCINNATI, OH 45249
 513-469-1600

DESIGNER
 DPF


REVIEWER
 DCJ MM-DD-YY

PROJECT ID
 117955

SHEET TOTAL
 P. 45 | 228

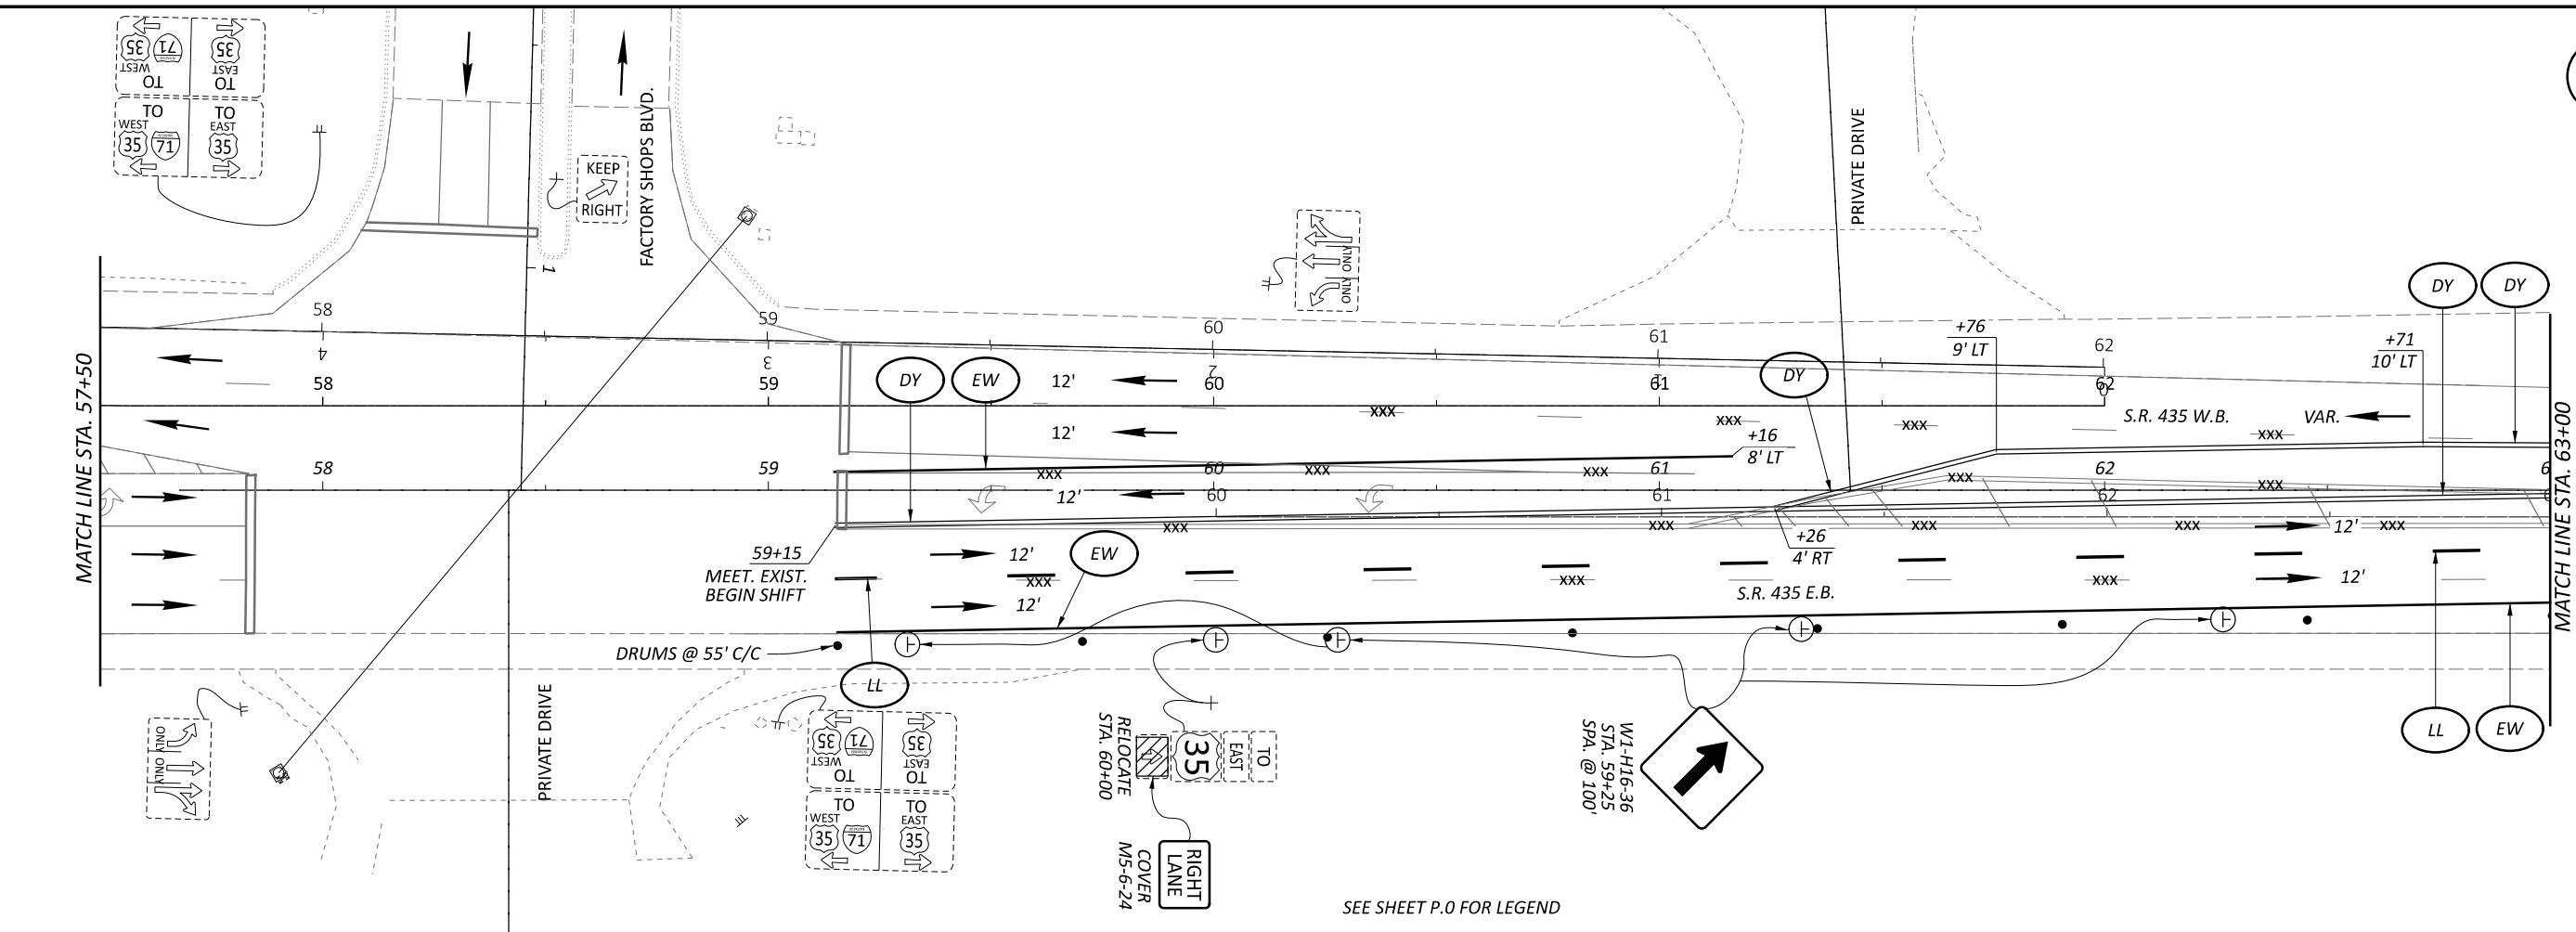
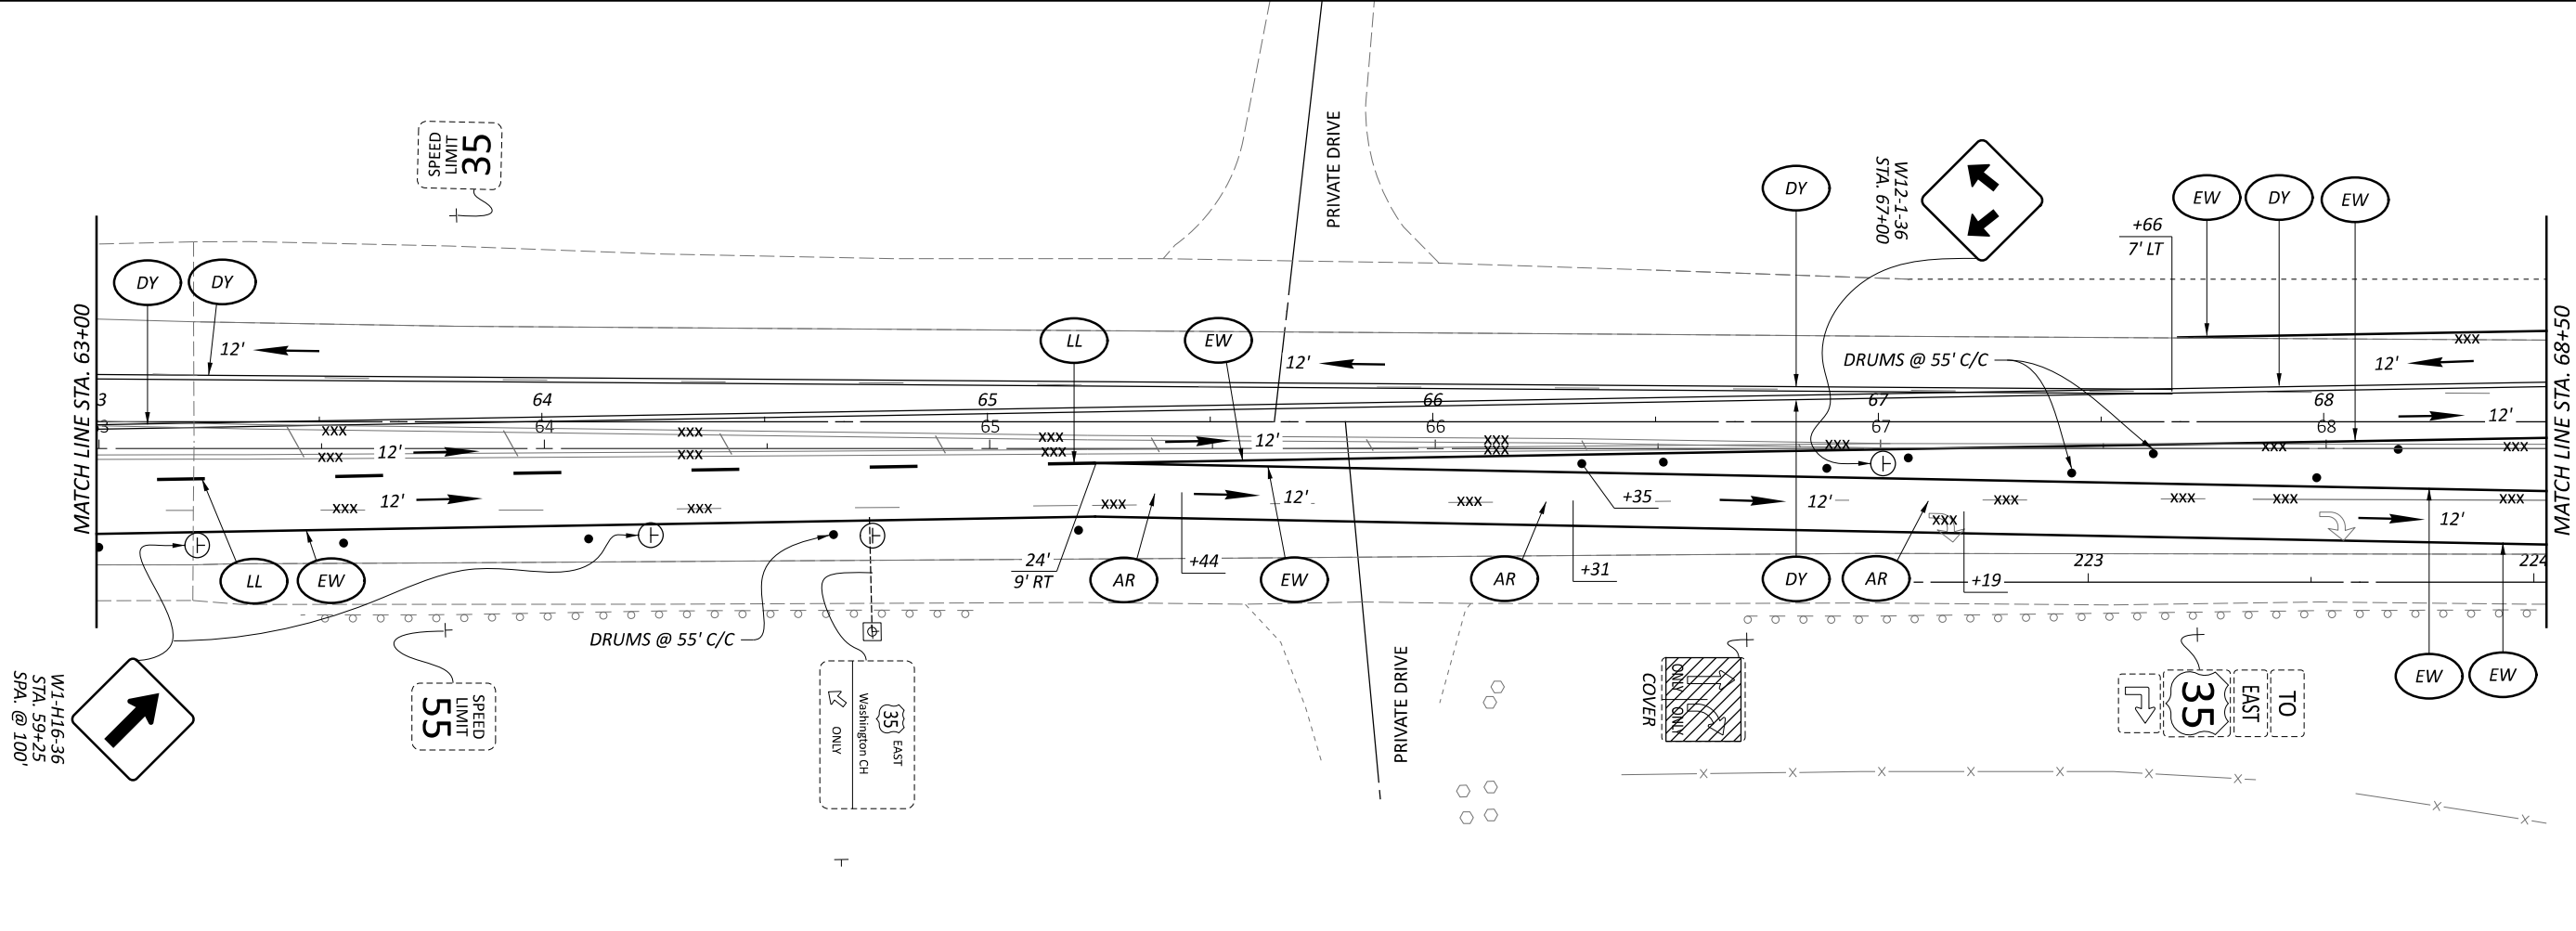


SEE SHEET P.O FOR LEGEND

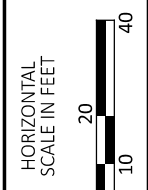


MAINTENANCE OF TRAFFIC (BU5)
 PHASE 3 - S.R. 435 STA. 57+50 TO STA. 68+50

DESIGN AGENCY	
8350 E. KEMPER RD. SUITE B CINCINNATI, OH 45249 513-469-1600	
DESIGNER	DPF
REVIEWER	DCJ MM-DD-YY
PROJECT ID	117955
SHEET	TOTAL
P. 46	228

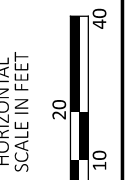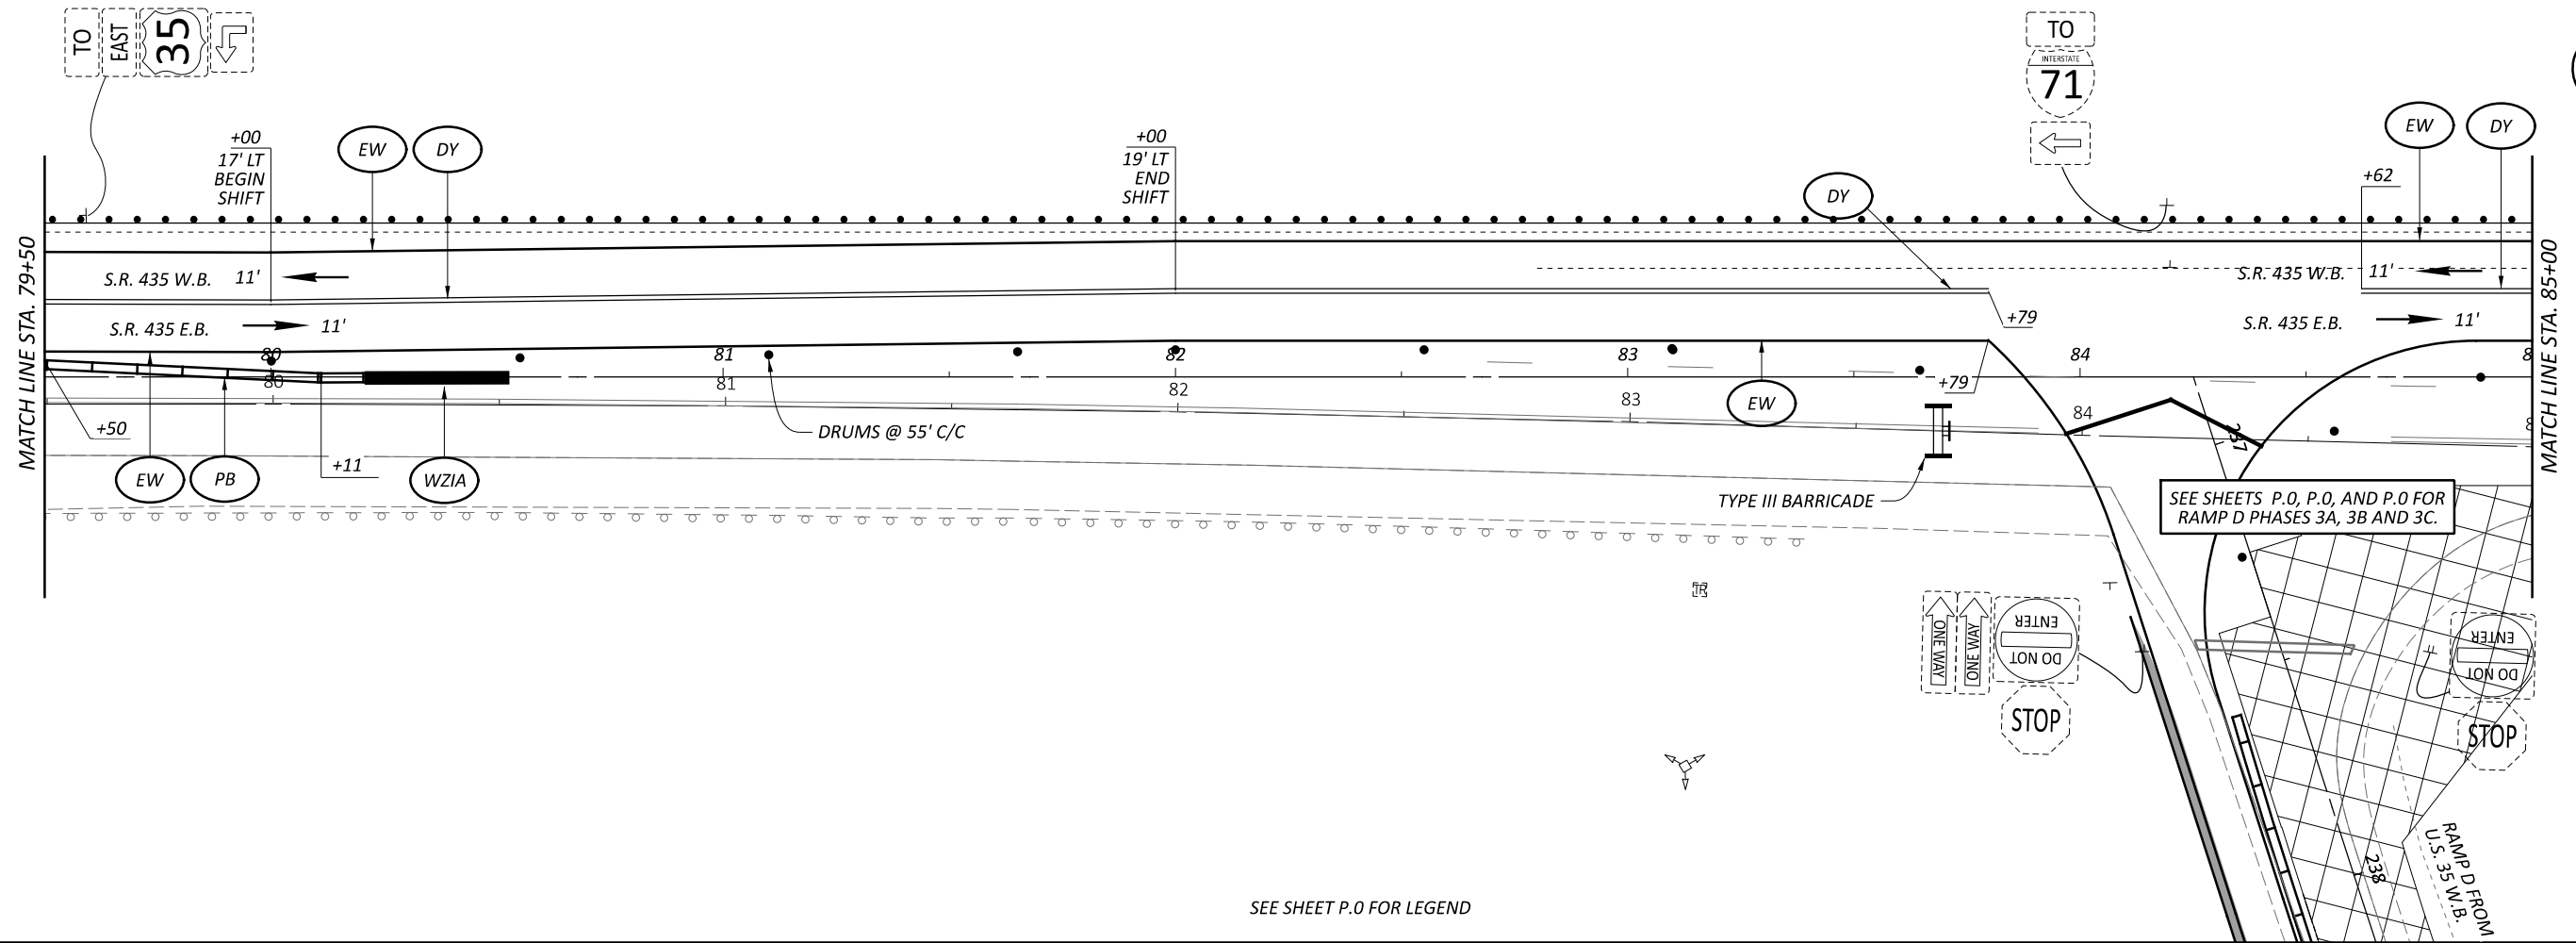

SEE SHEET P.O FOR LEGEND

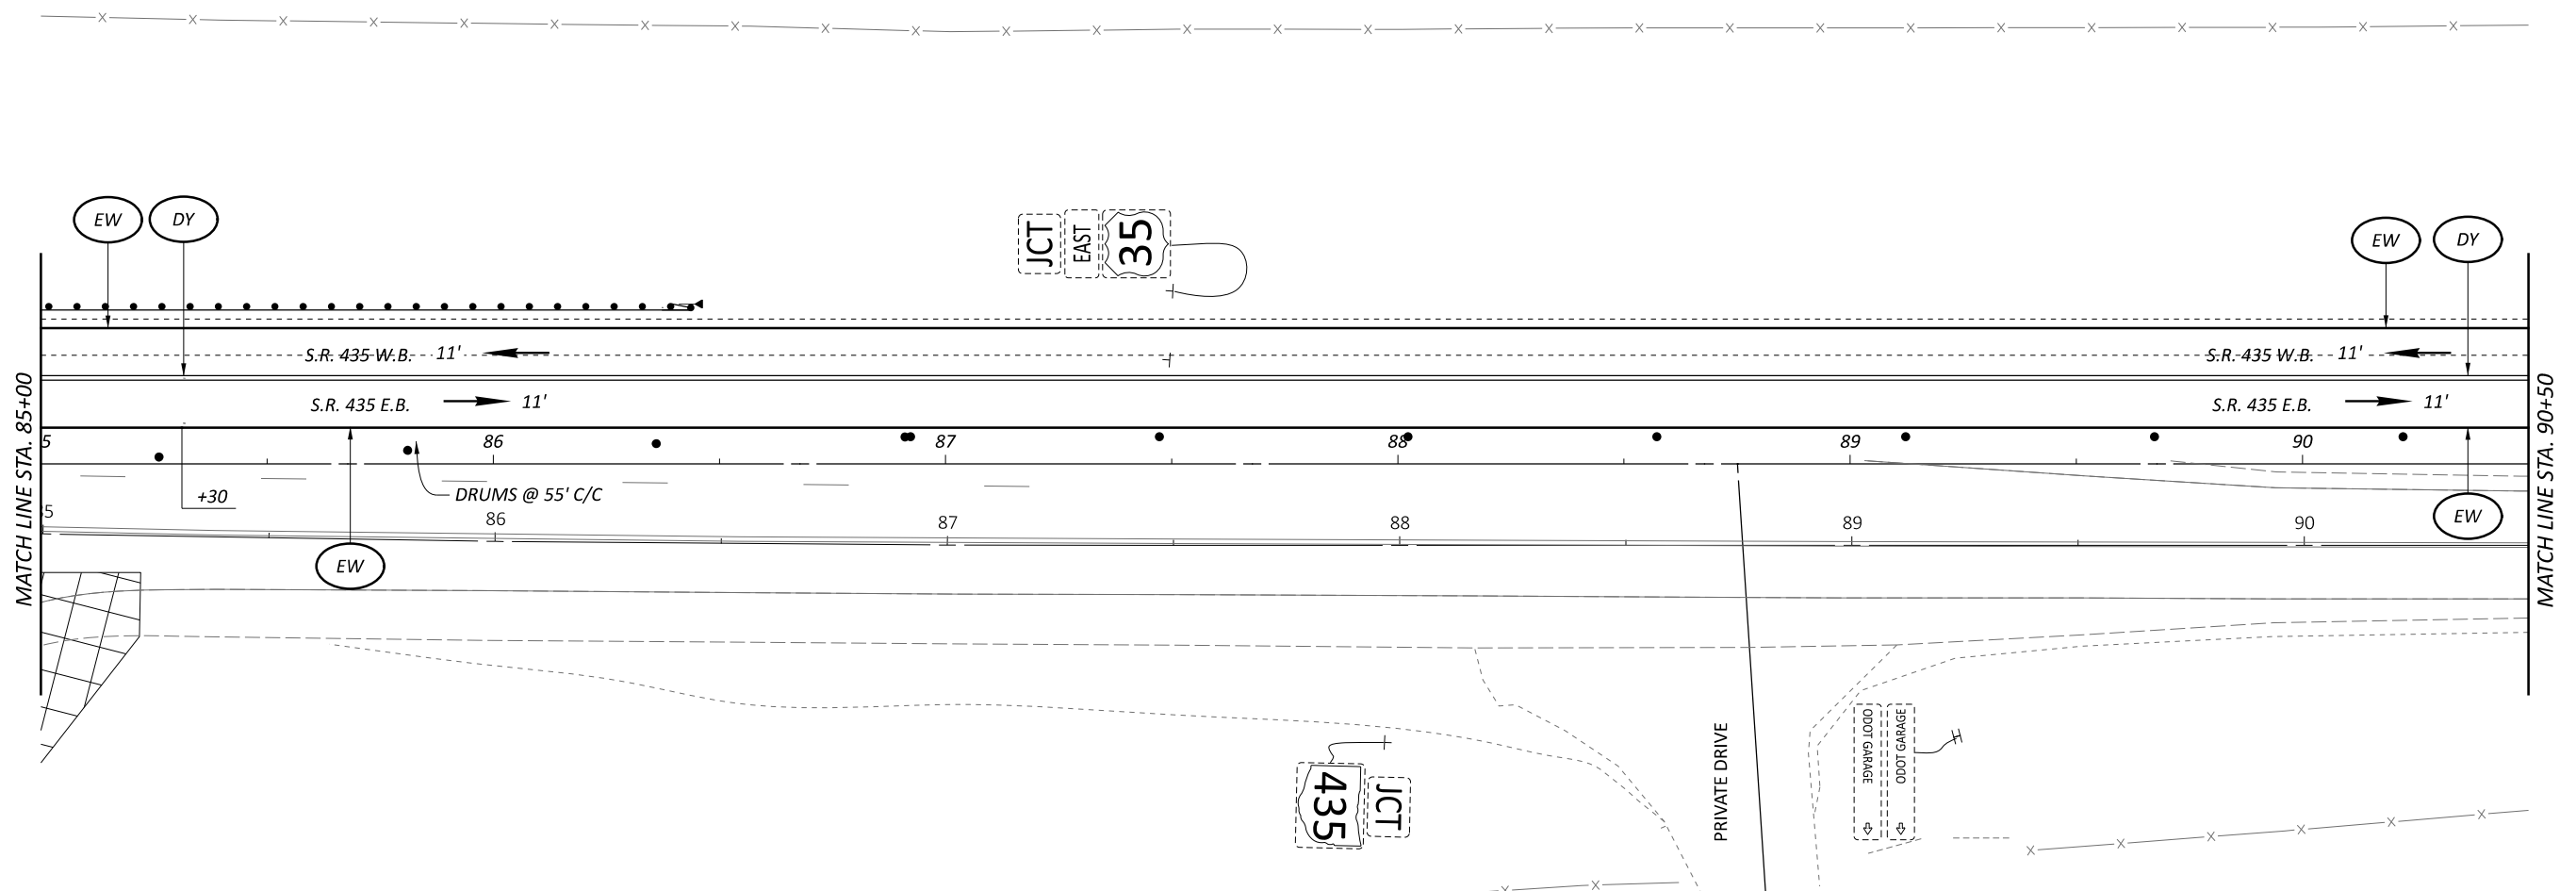

MAINTENANCE OF TRAFFIC (BU5)
 PHASE 3 - S.R. 435 STA. 79+50 TO STA. 90+50

DESIGN AGENCY


Palmer
 ENGINEERING
 8350 E. KEMPER RD.
 SUITE B
 CINCINNATI, OH 45249
 513-469-1600

DESIGNER
 DPF


REVIEWER
 DCJ MM-DD-YY

PROJECT ID
 117955

SHEET TOTAL
 P. 48 | 228

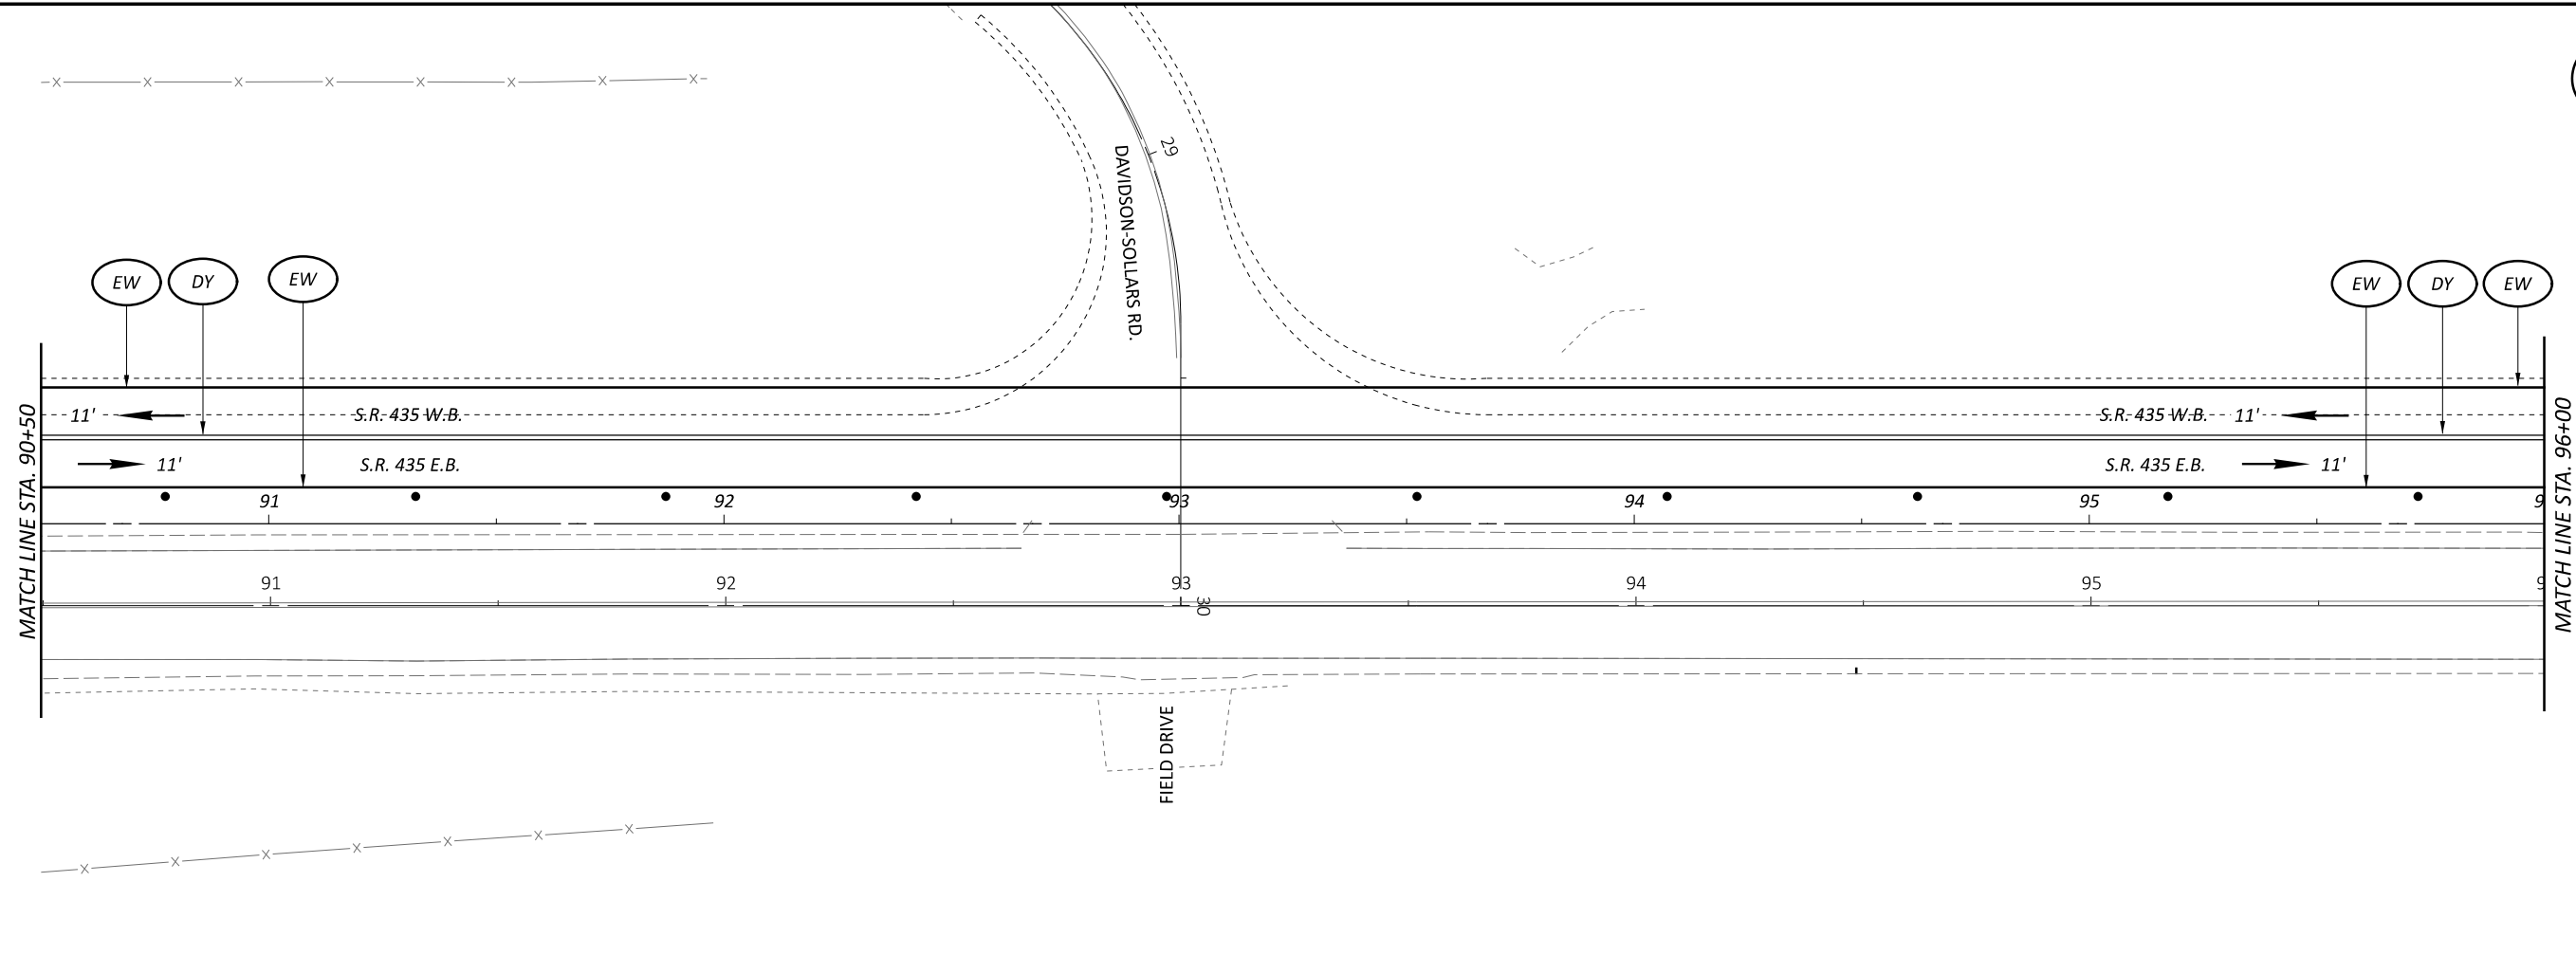

SEE SHEET P.0 FOR LEGEND

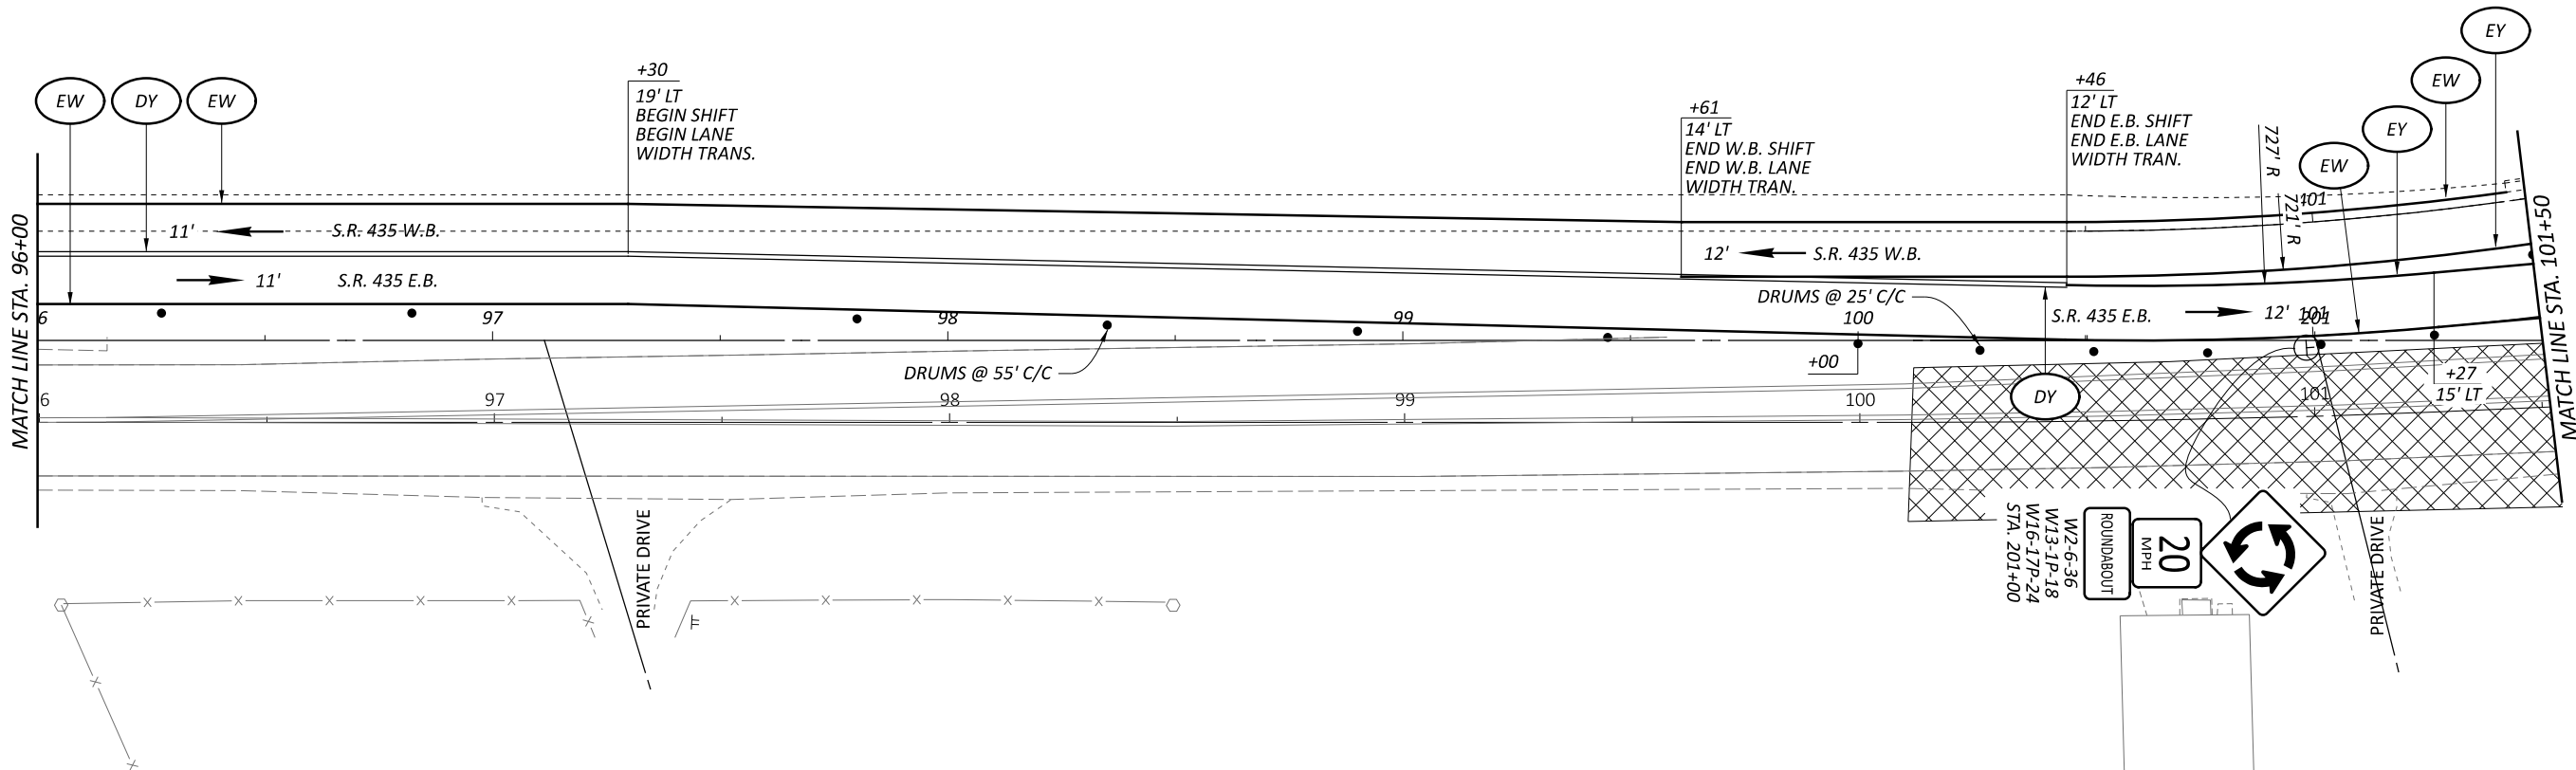

MAINTENANCE OF TRAFFIC (BU5)
 PHASE 3 - S.R. 435 STA. 90+50 TO STA. 101+50

DESIGN AGENCY

Palmer
 ENGINEERING
 8350 E. KEMPER RD.
 SUITE B
 CINCINNATI, OH 45249
 513-469-1600

DESIGNER

DPF

REVIEWER


DCJ MM-DD-YY

PROJECT ID


117955

SHEET TOTAL

P. 49 | 228

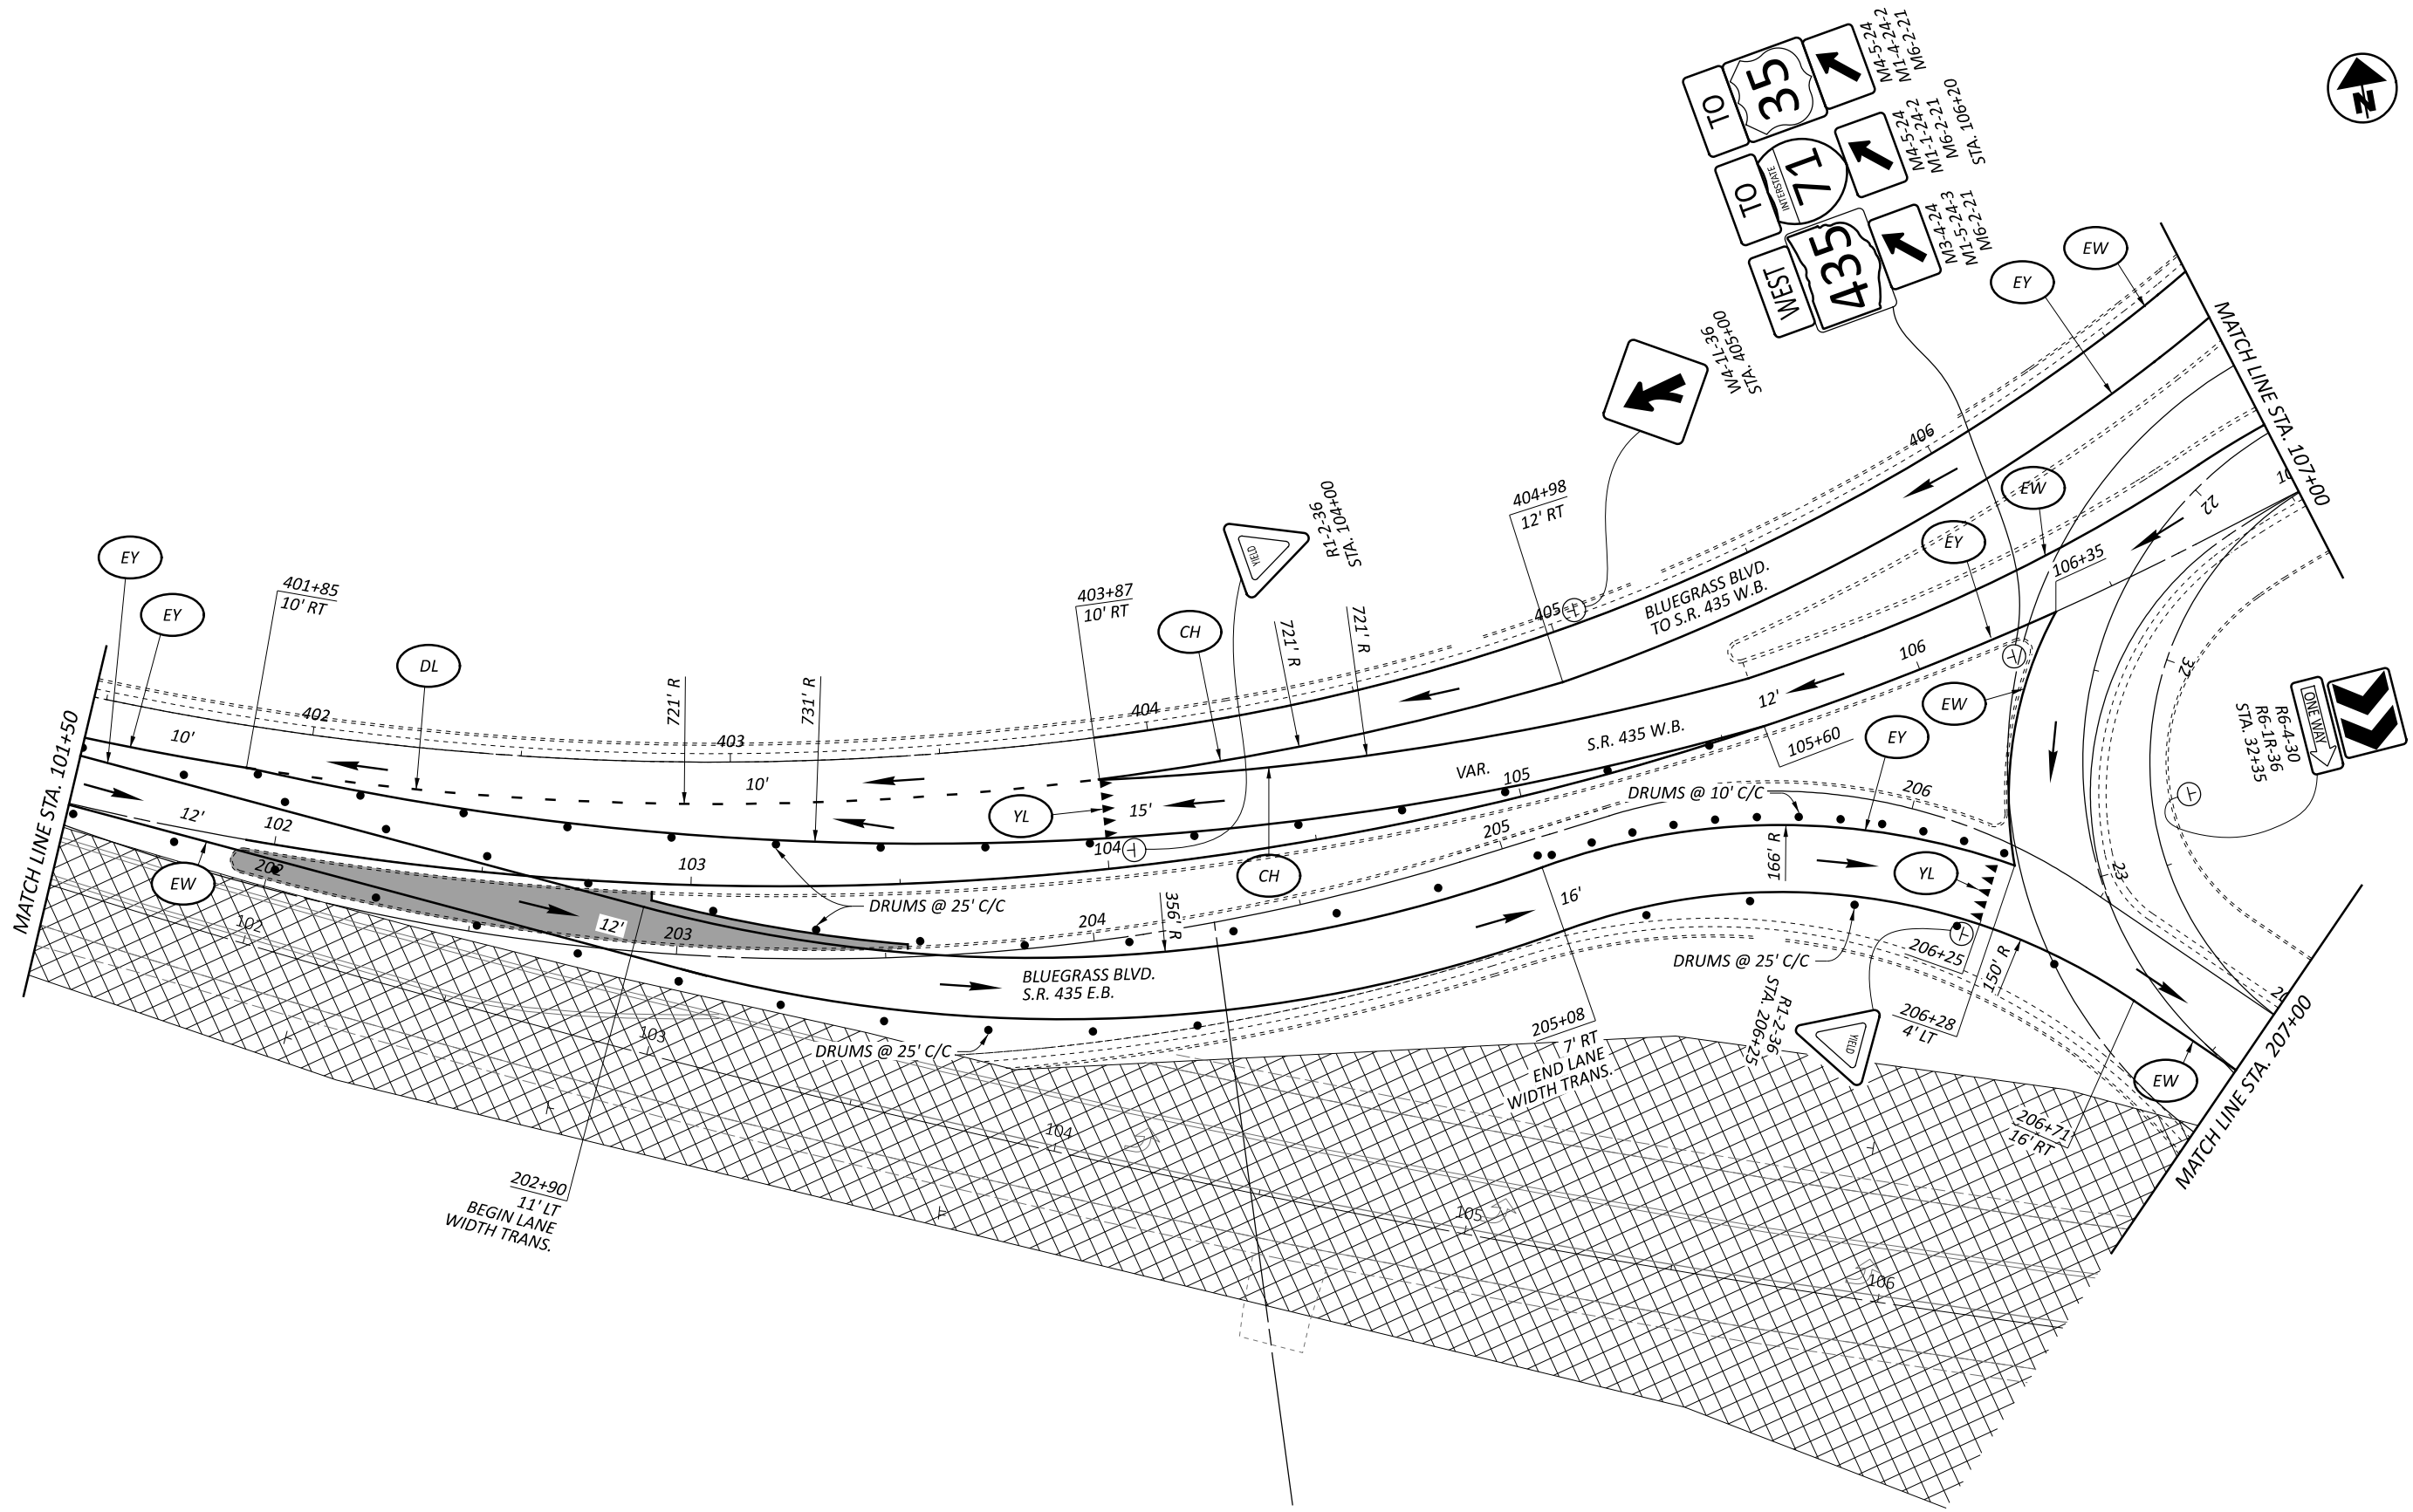



SEE SHEET P.O FOR LEGEND

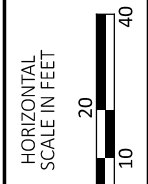

MAINTENANCE OF TRAFFIC (BU5)
 PHASE 3 - S.R. 435 STA. 101+50 TO ROUNDABOUT


DESIGN AGENCY
Palmer
 ENGINEERING
 8350 E. KEMPER RD.
 SUITE B
 CINCINNATI, OH 45249
 513-469-1600

DESIGNER	DPF
REVIEWER	DCJ MM-DD-YY
PROJECT ID	117955
SHEET TOTAL	P. 50 228

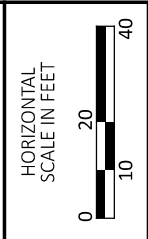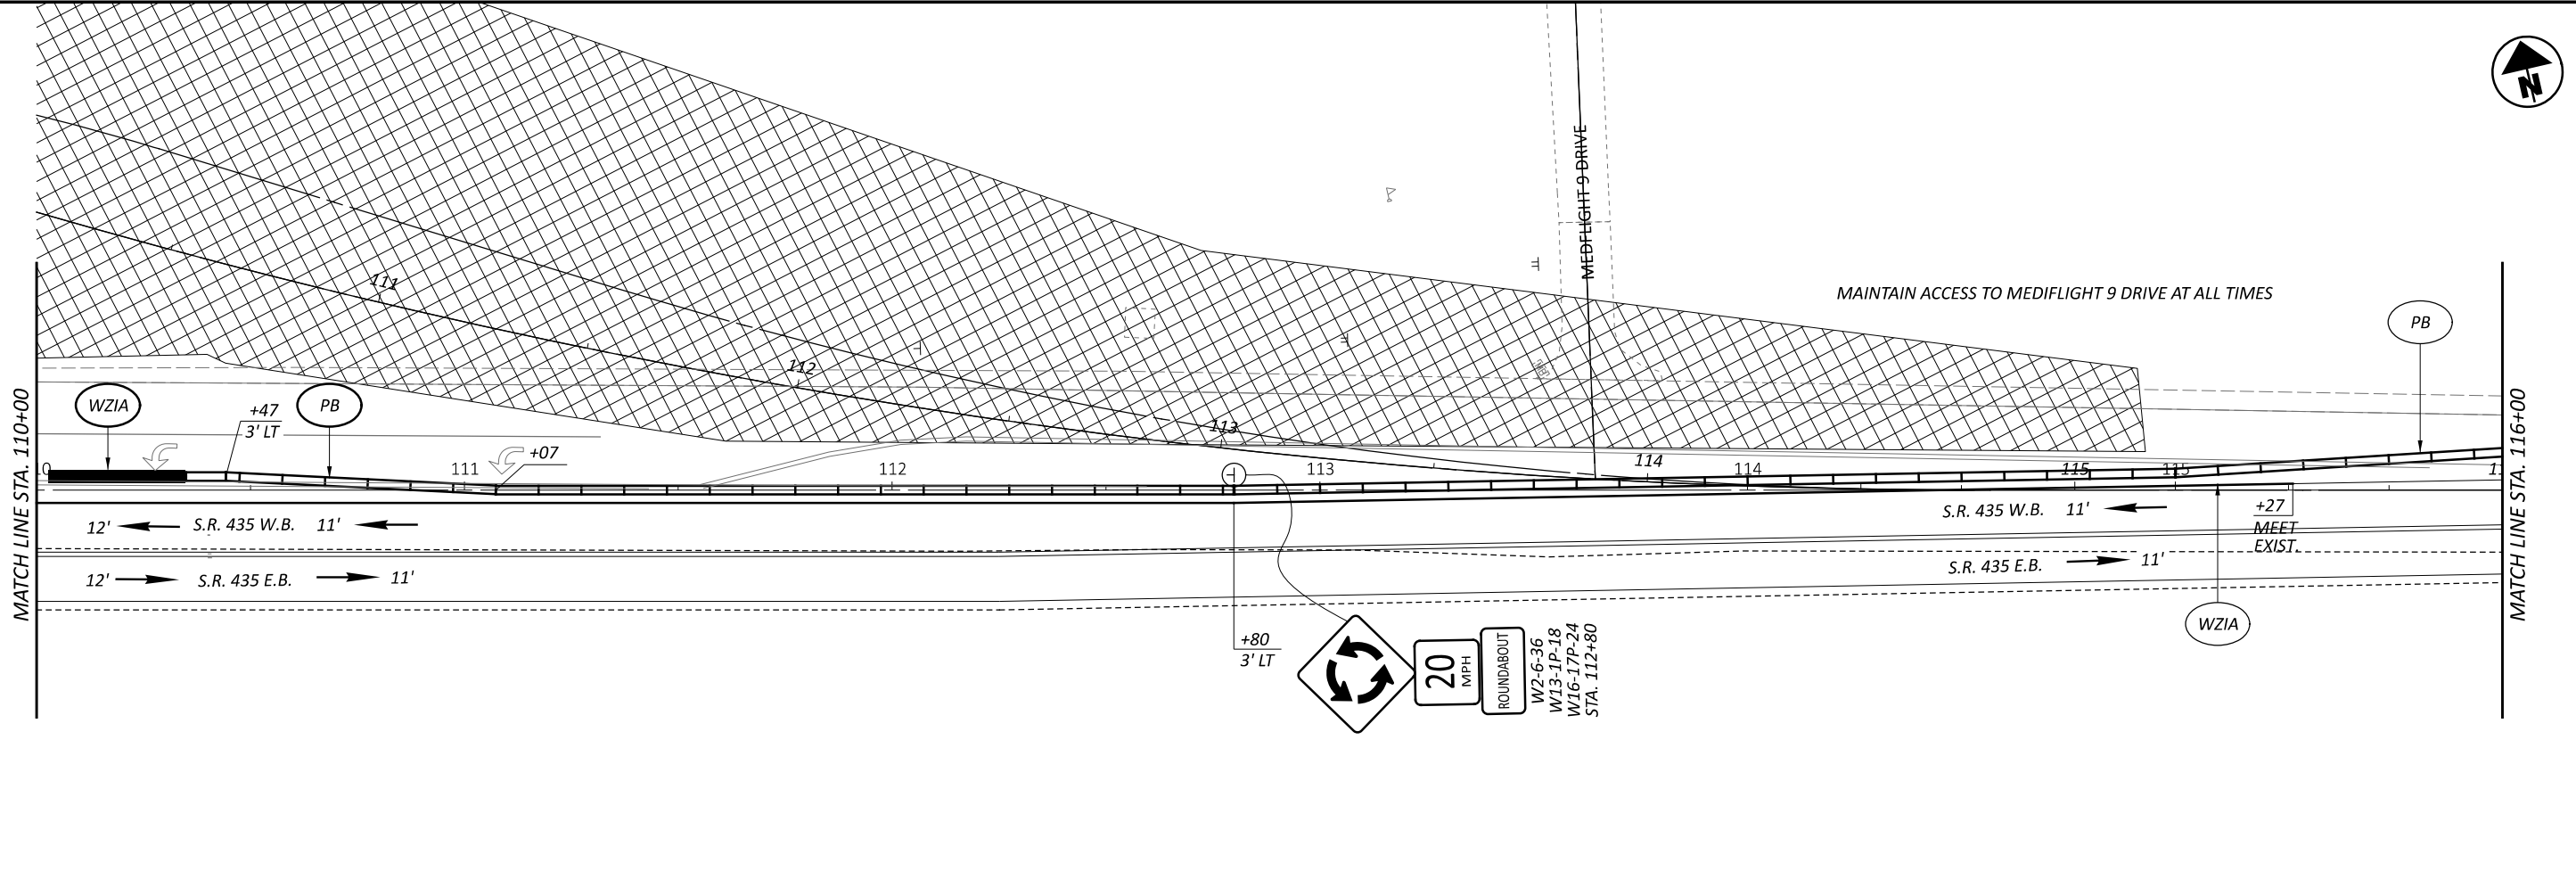


MAINTENANCE OF TRAFFIC (BU5)
 PHASE 3 - S.R. 435 STA. 110+00 TO STA. 130+50



SEE SHEET P.0 FOR LEGEND

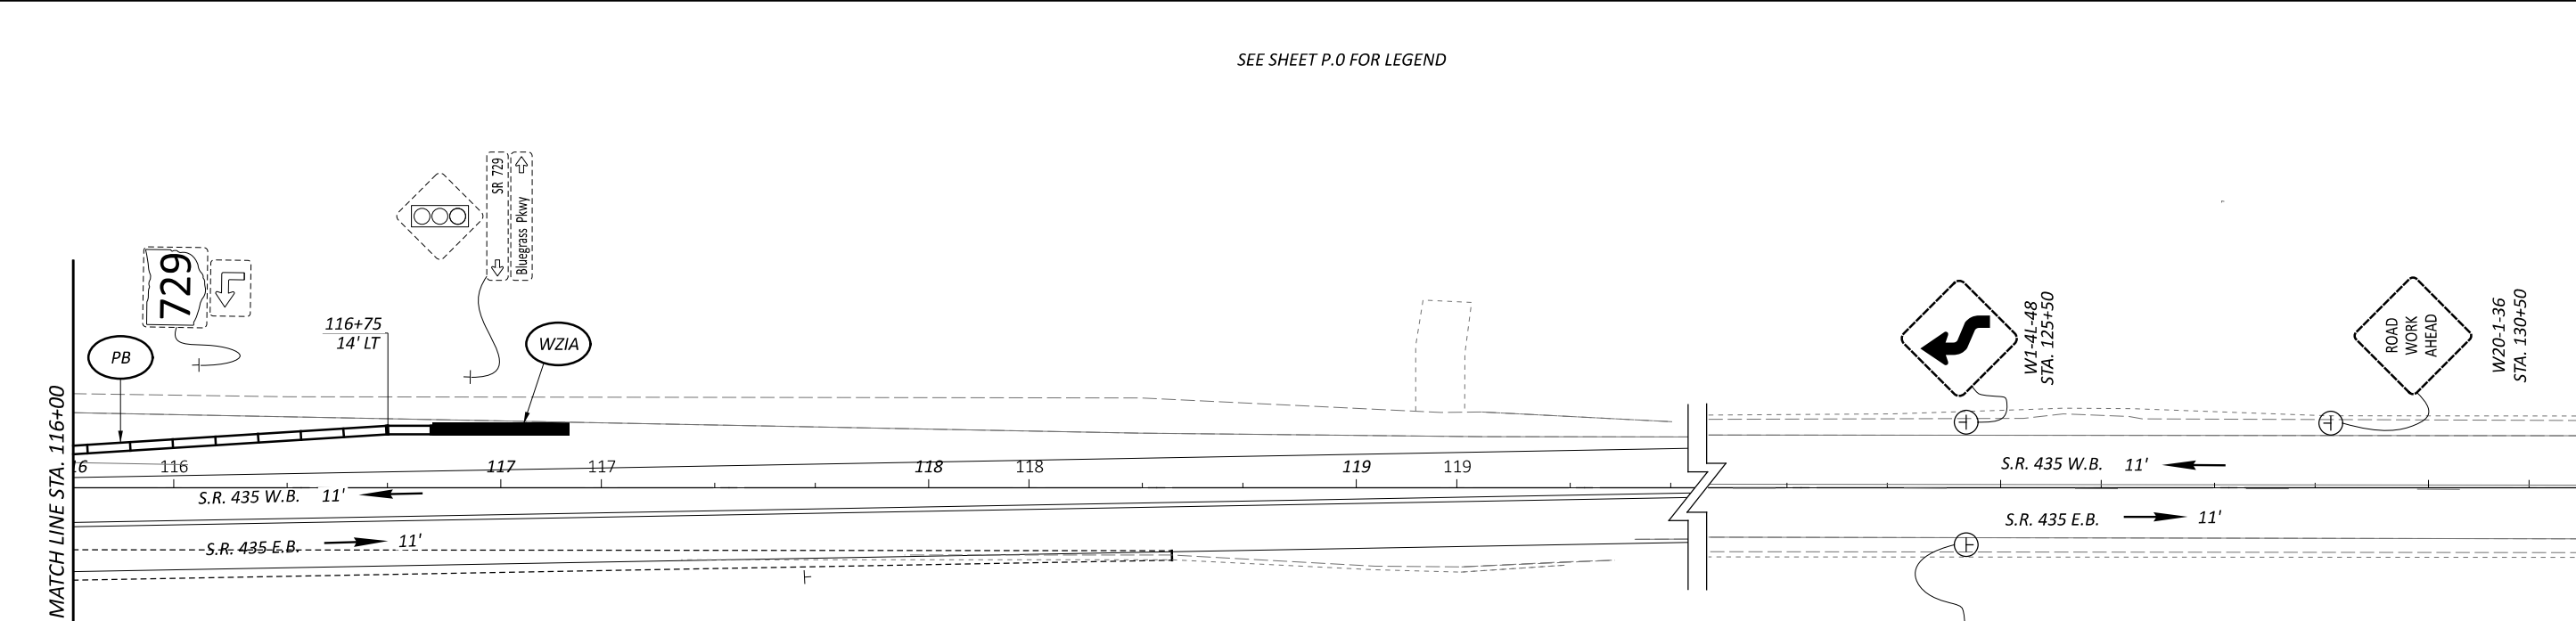

DESIGN AGENCY	
 8350 E. KEMPER RD. SUITE B CINCINNATI, OH 45249 513-469-1600	
DESIGNER	
DPF	
REVIEWER	
DCJ MM-DD-YY	
PROJECT ID	
117955	
SHEET	TOTAL
P. 52	228

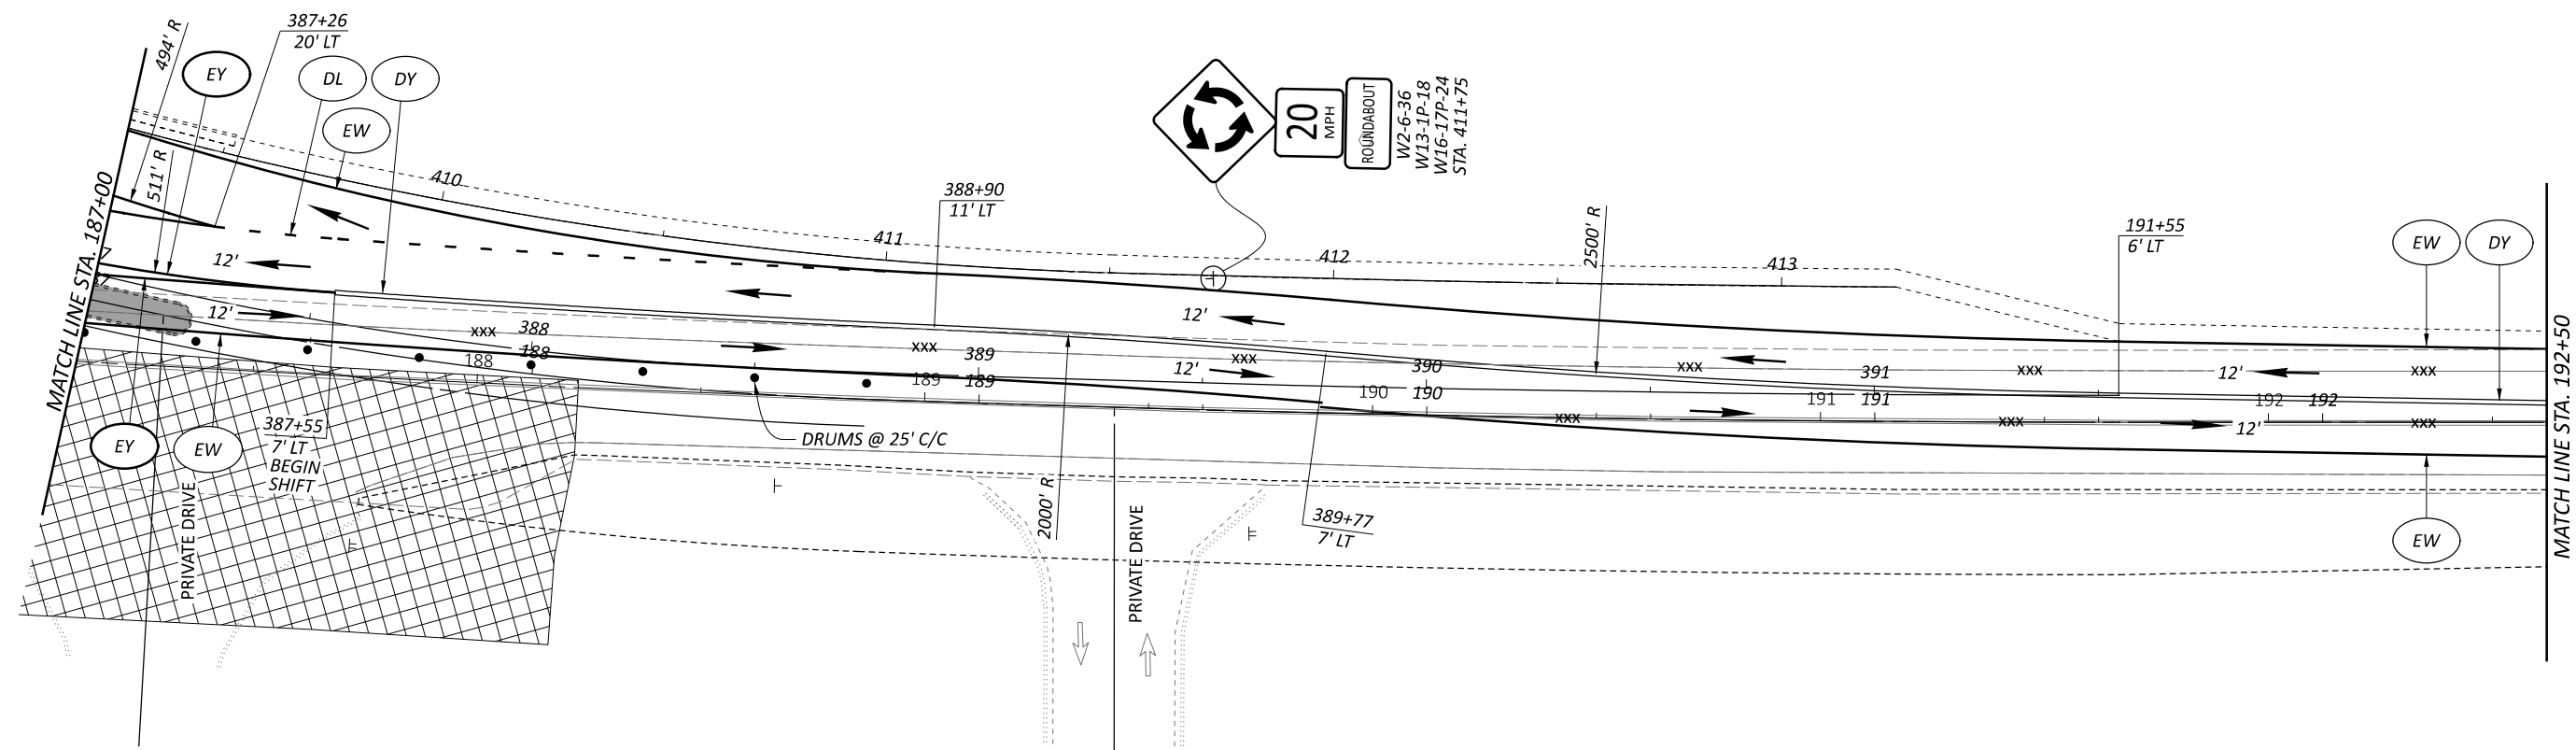

SEE SHEET P.O FOR LEGEND


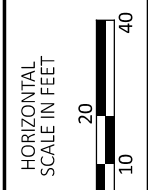
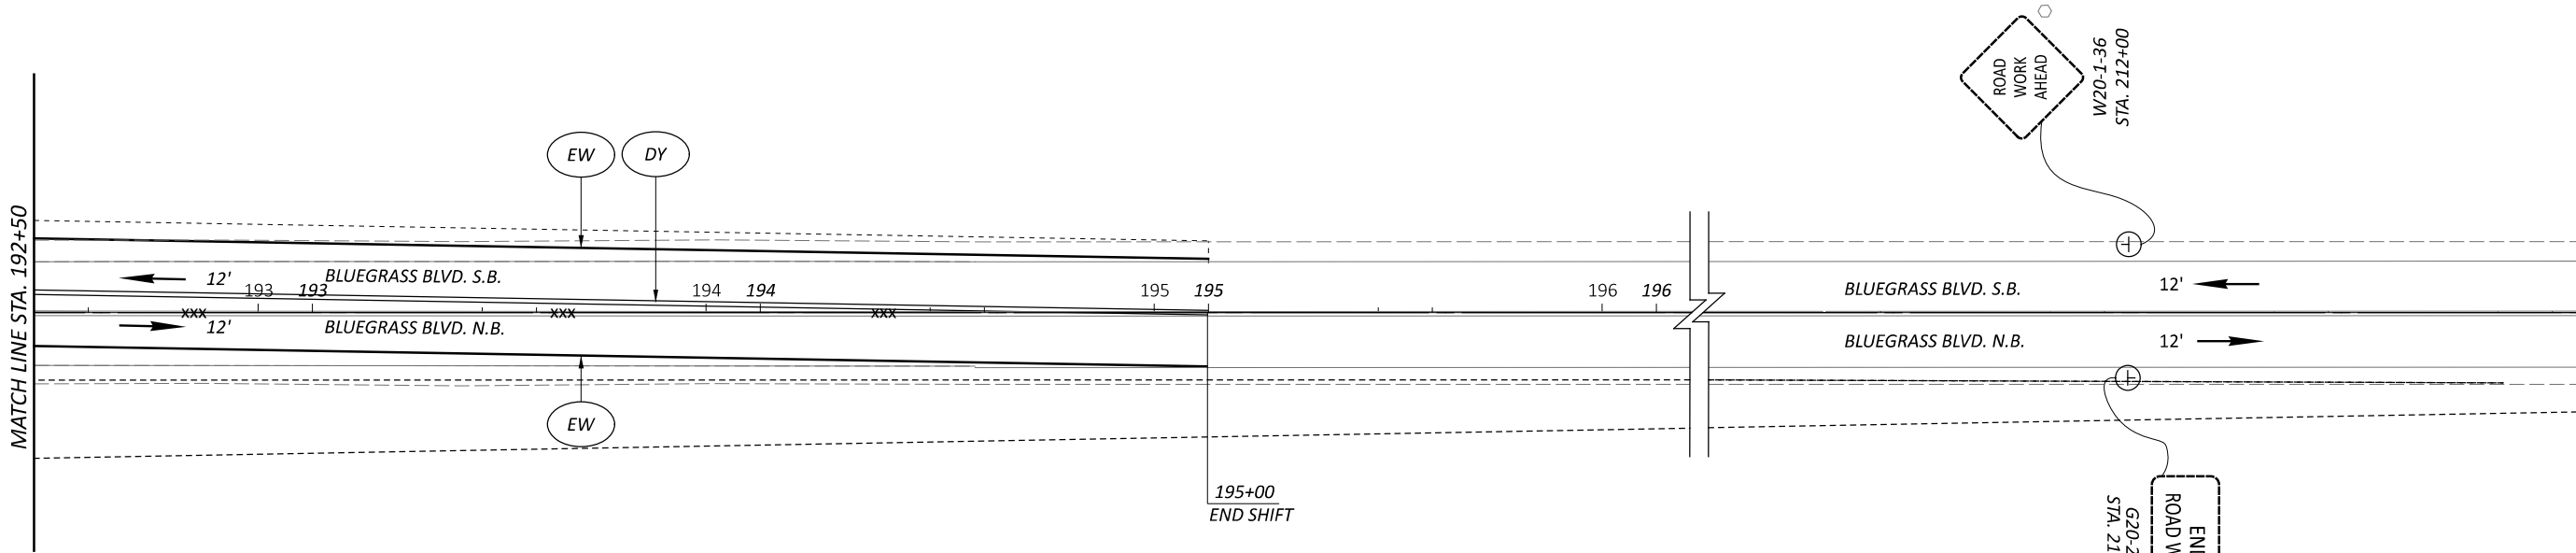


MAINTENANCE OF TRAFFIC (BU5)
 PHASE 3 - BLUEGRASS BLVD. STA. 187+00 TO STA. 212+00

DESIGN AGENCY	
8350 E. KEMPER RD. SUITE B CINCINNATI, OH 45249 513-469-1600	
DESIGNER	DPF
REVIEWER	DCJ MM-DD-YY
PROJECT ID	117955
SHEET	TOTAL
P. 53	228




BALLOON LEGEND					
(EY)	WORK ZONE EDGE LINE (Y), 4"	(PB)	PORTABLE BARRIER, UNANCHORED	(WD)	WORK ZONE DOTTED LINE, (W), 4"
(EW)	WORK ZONE EDGE LINE (W), 4"	(IM)	WORK ZONE ISLAND MARKING	(YD)	WORK ZONE DOTTED LINE, (Y), 4"
(SL)	WORK ZONE STOP LINE (W) 24"	(CH)	WORK ZONE CHANNELIZING LINE, 8"	(YL)	WORK ZONE YIELD LINE, (W)
(DY)	WORK ZONE DOUBLE SOLID LINE, (Y), 4"	(AR)	WORK ZONE LANE ARROW	(WZIA)	WORK ZONE IMPACT ATTENUATOR

HATCH LEGEND	
	PROPOSED WORK ZONE
	PAVEMENT FOR M.O.T., CLASS A

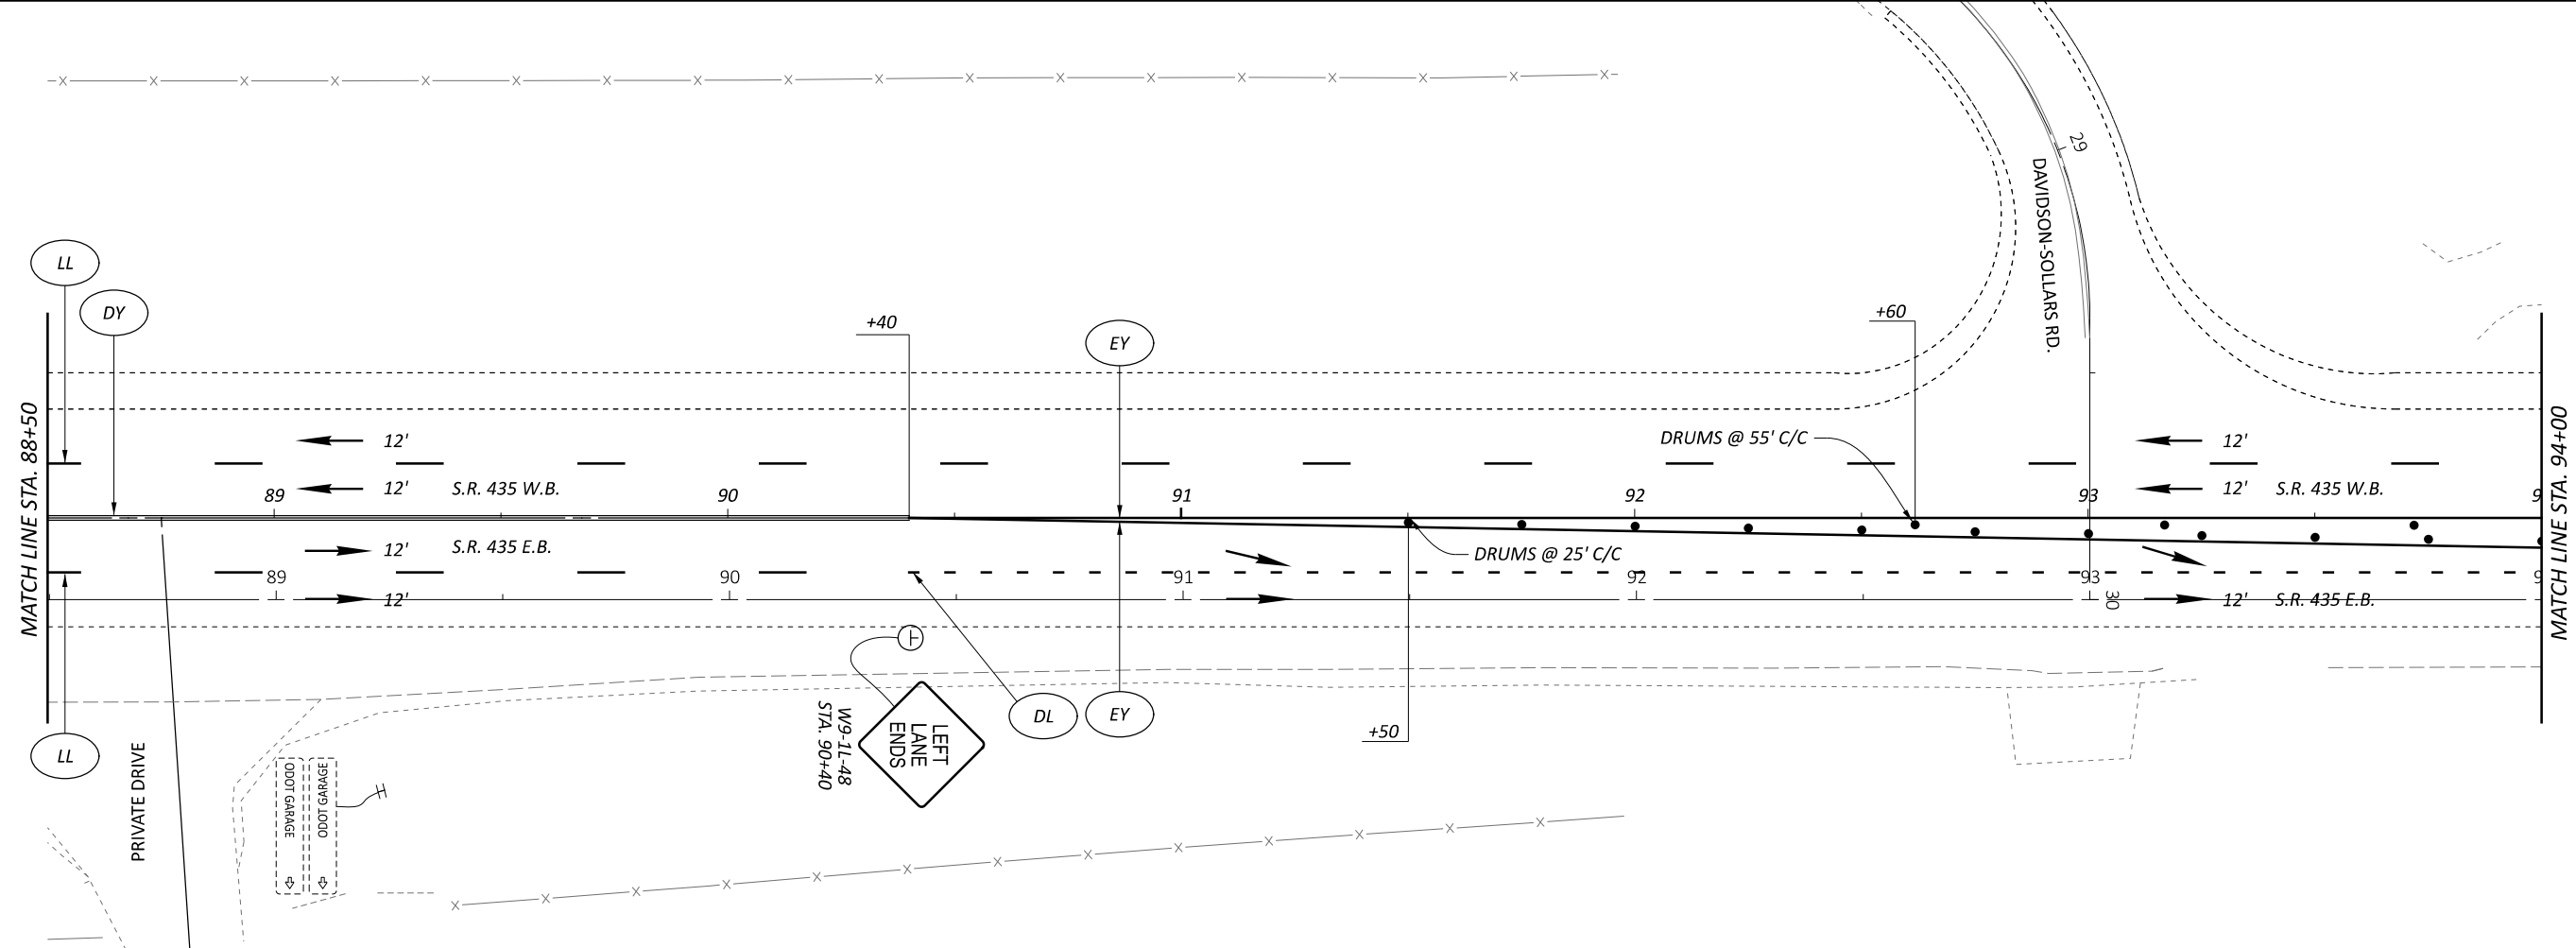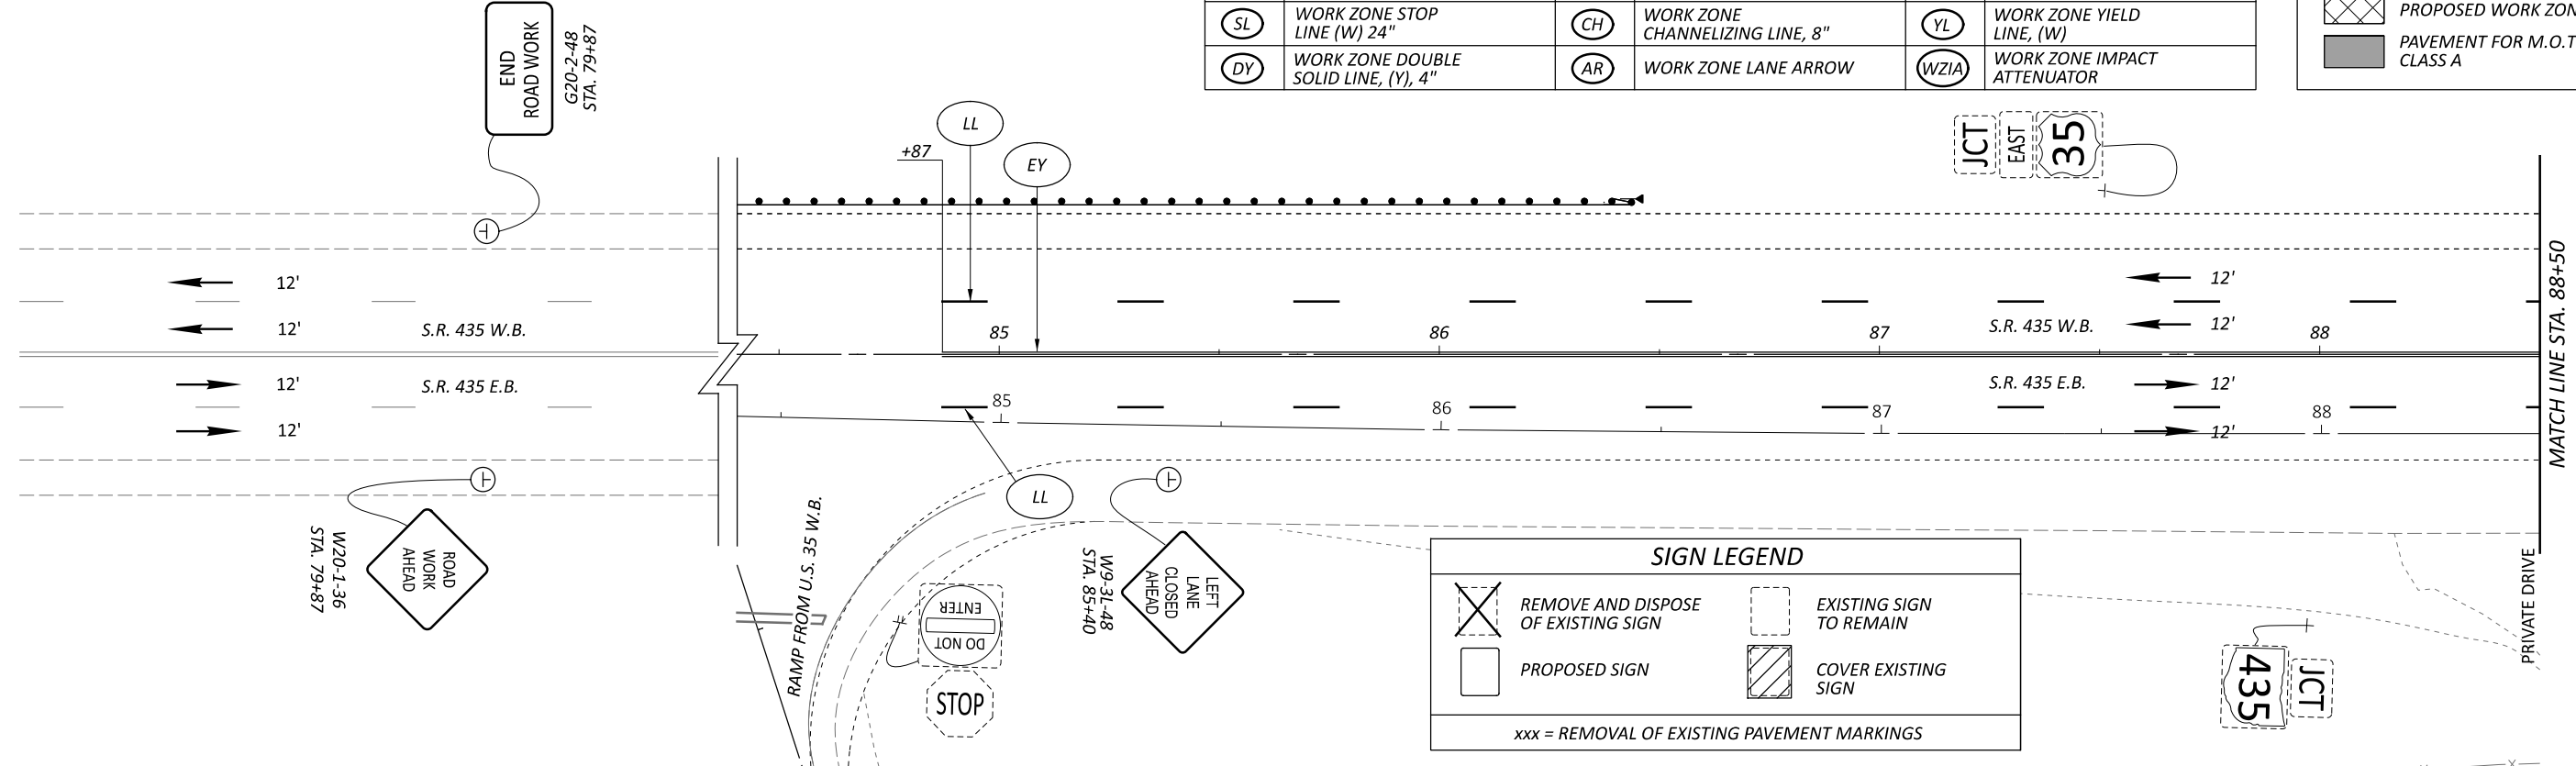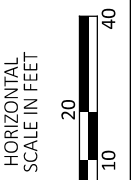



MAINTENANCE OF TRAFFIC (BU5)
 PHASE 4 - S.R. 435 STA. 79+87 TO STA. 94+00

DESIGN AGENCY	
8350 E. KEMPER RD. SUITE B CINCINNATI, OH 45249 513-469-1600	
DESIGNER	
DPF	
REVIEWER	
DCJ MM-DD-YY	
PROJECT ID	
117955	
SHEET	TOTAL
P. 54	228

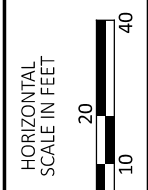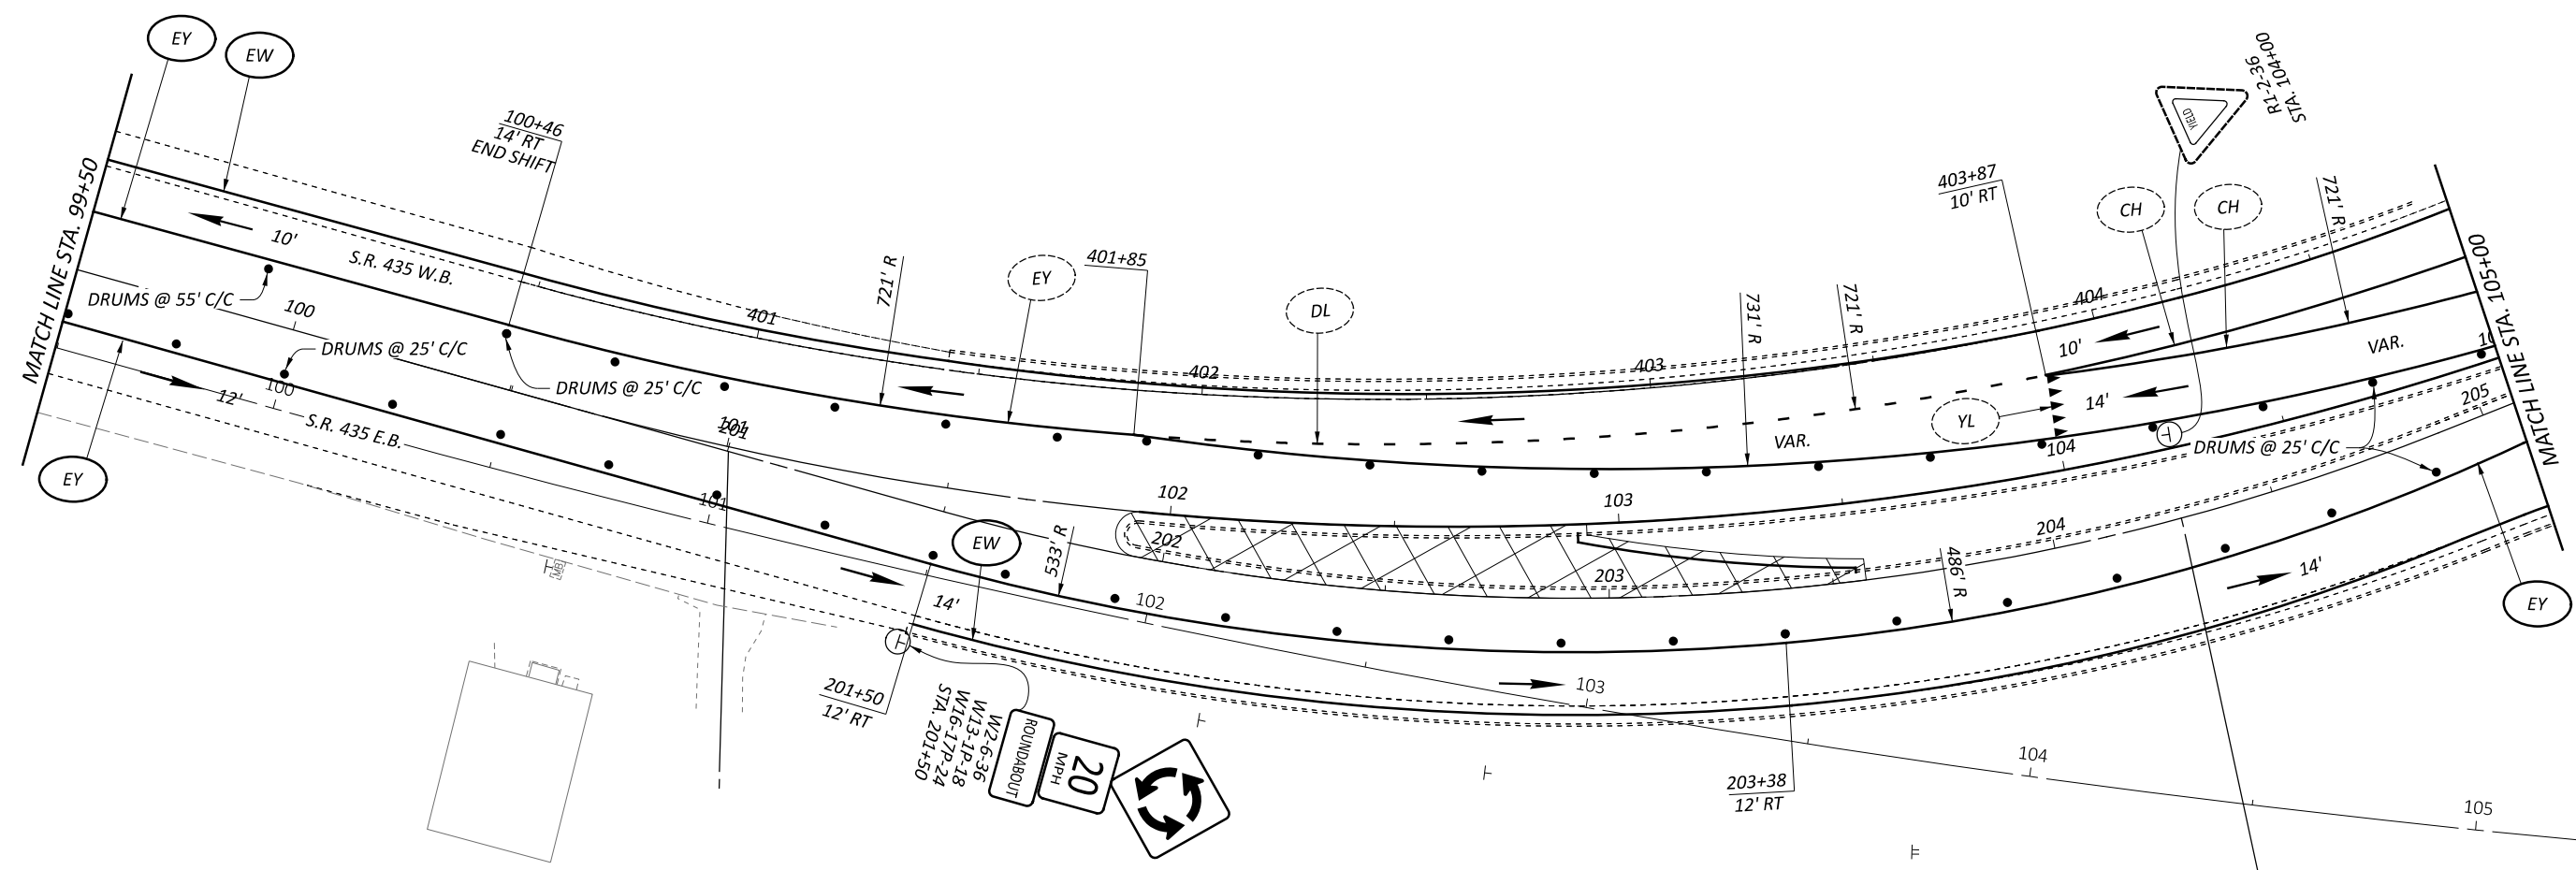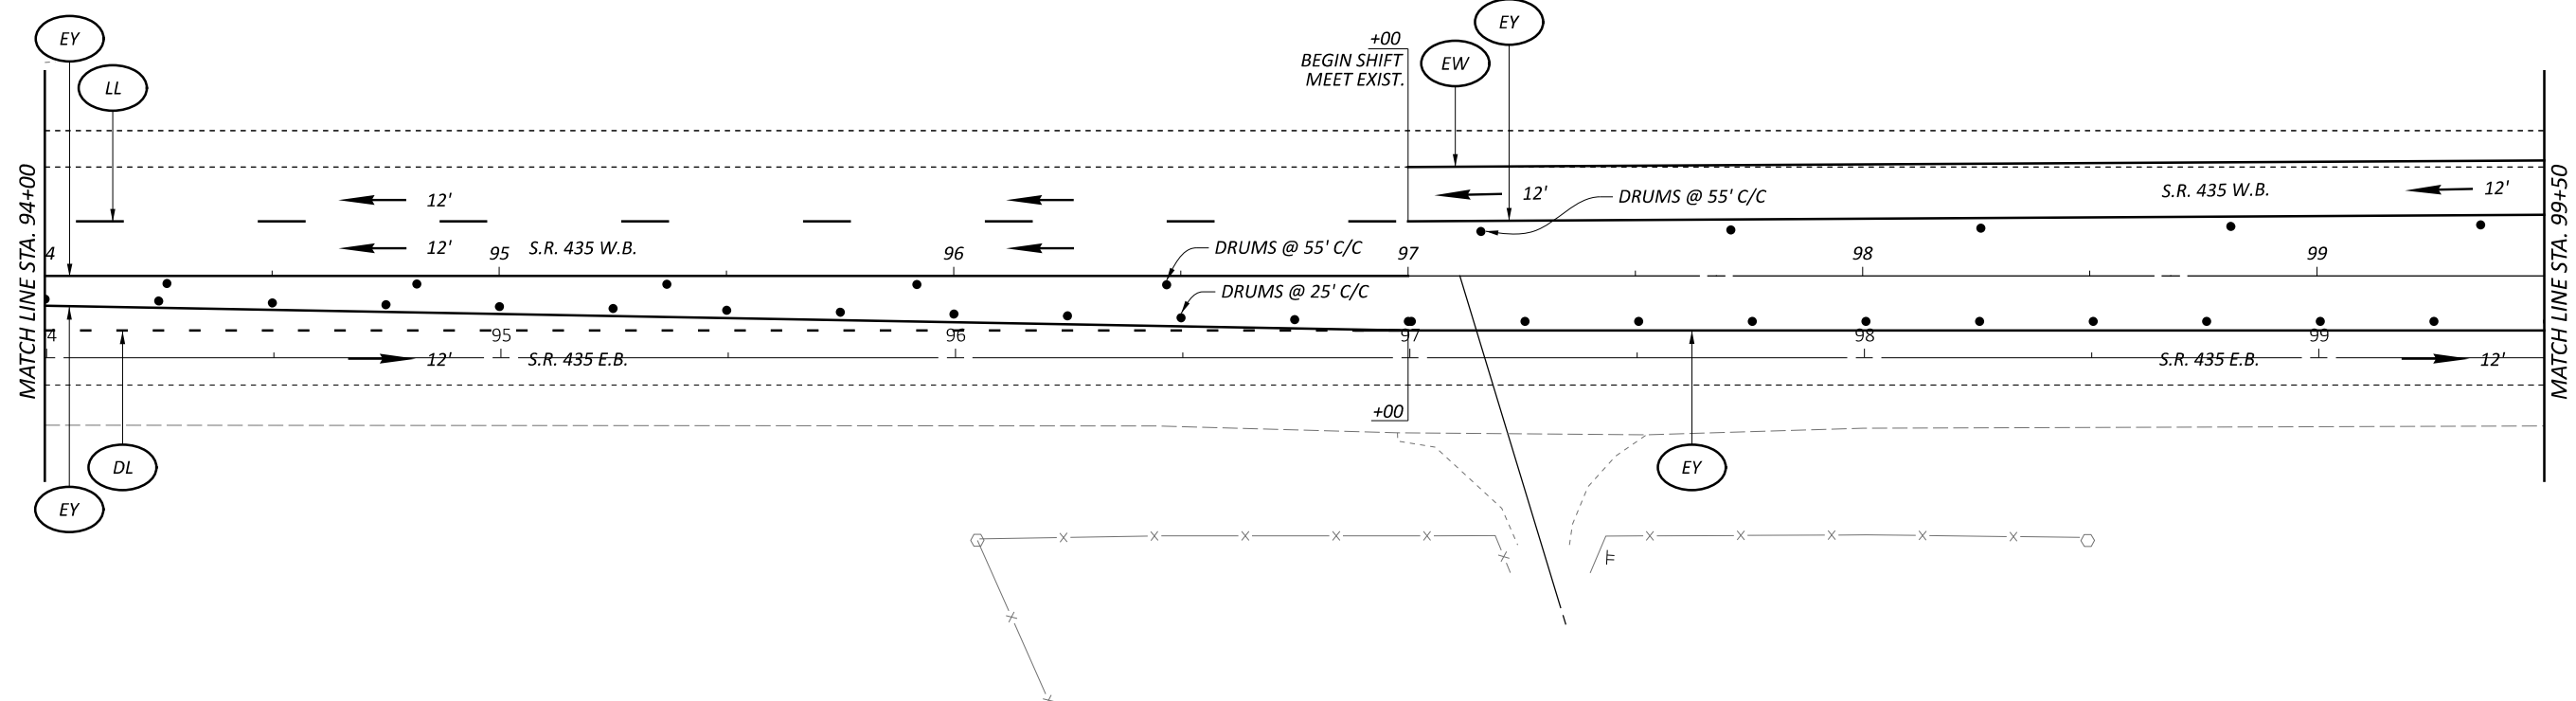

MAINTENANCE OF TRAFFIC (BU5)
 PHASE 4 - S.R. 435 STA. 94+00 TO STA. 105+00



DESIGN AGENCY	
8350 E. KEMPER RD. SUITE B CINCINNATI, OH 45249 513-469-1600	
DESIGNER	
DPF	
REVIEWER	
DCJ MM-DD-YY	
PROJECT ID	
117955	
SHEET	TOTAL
P. 55	228

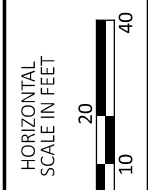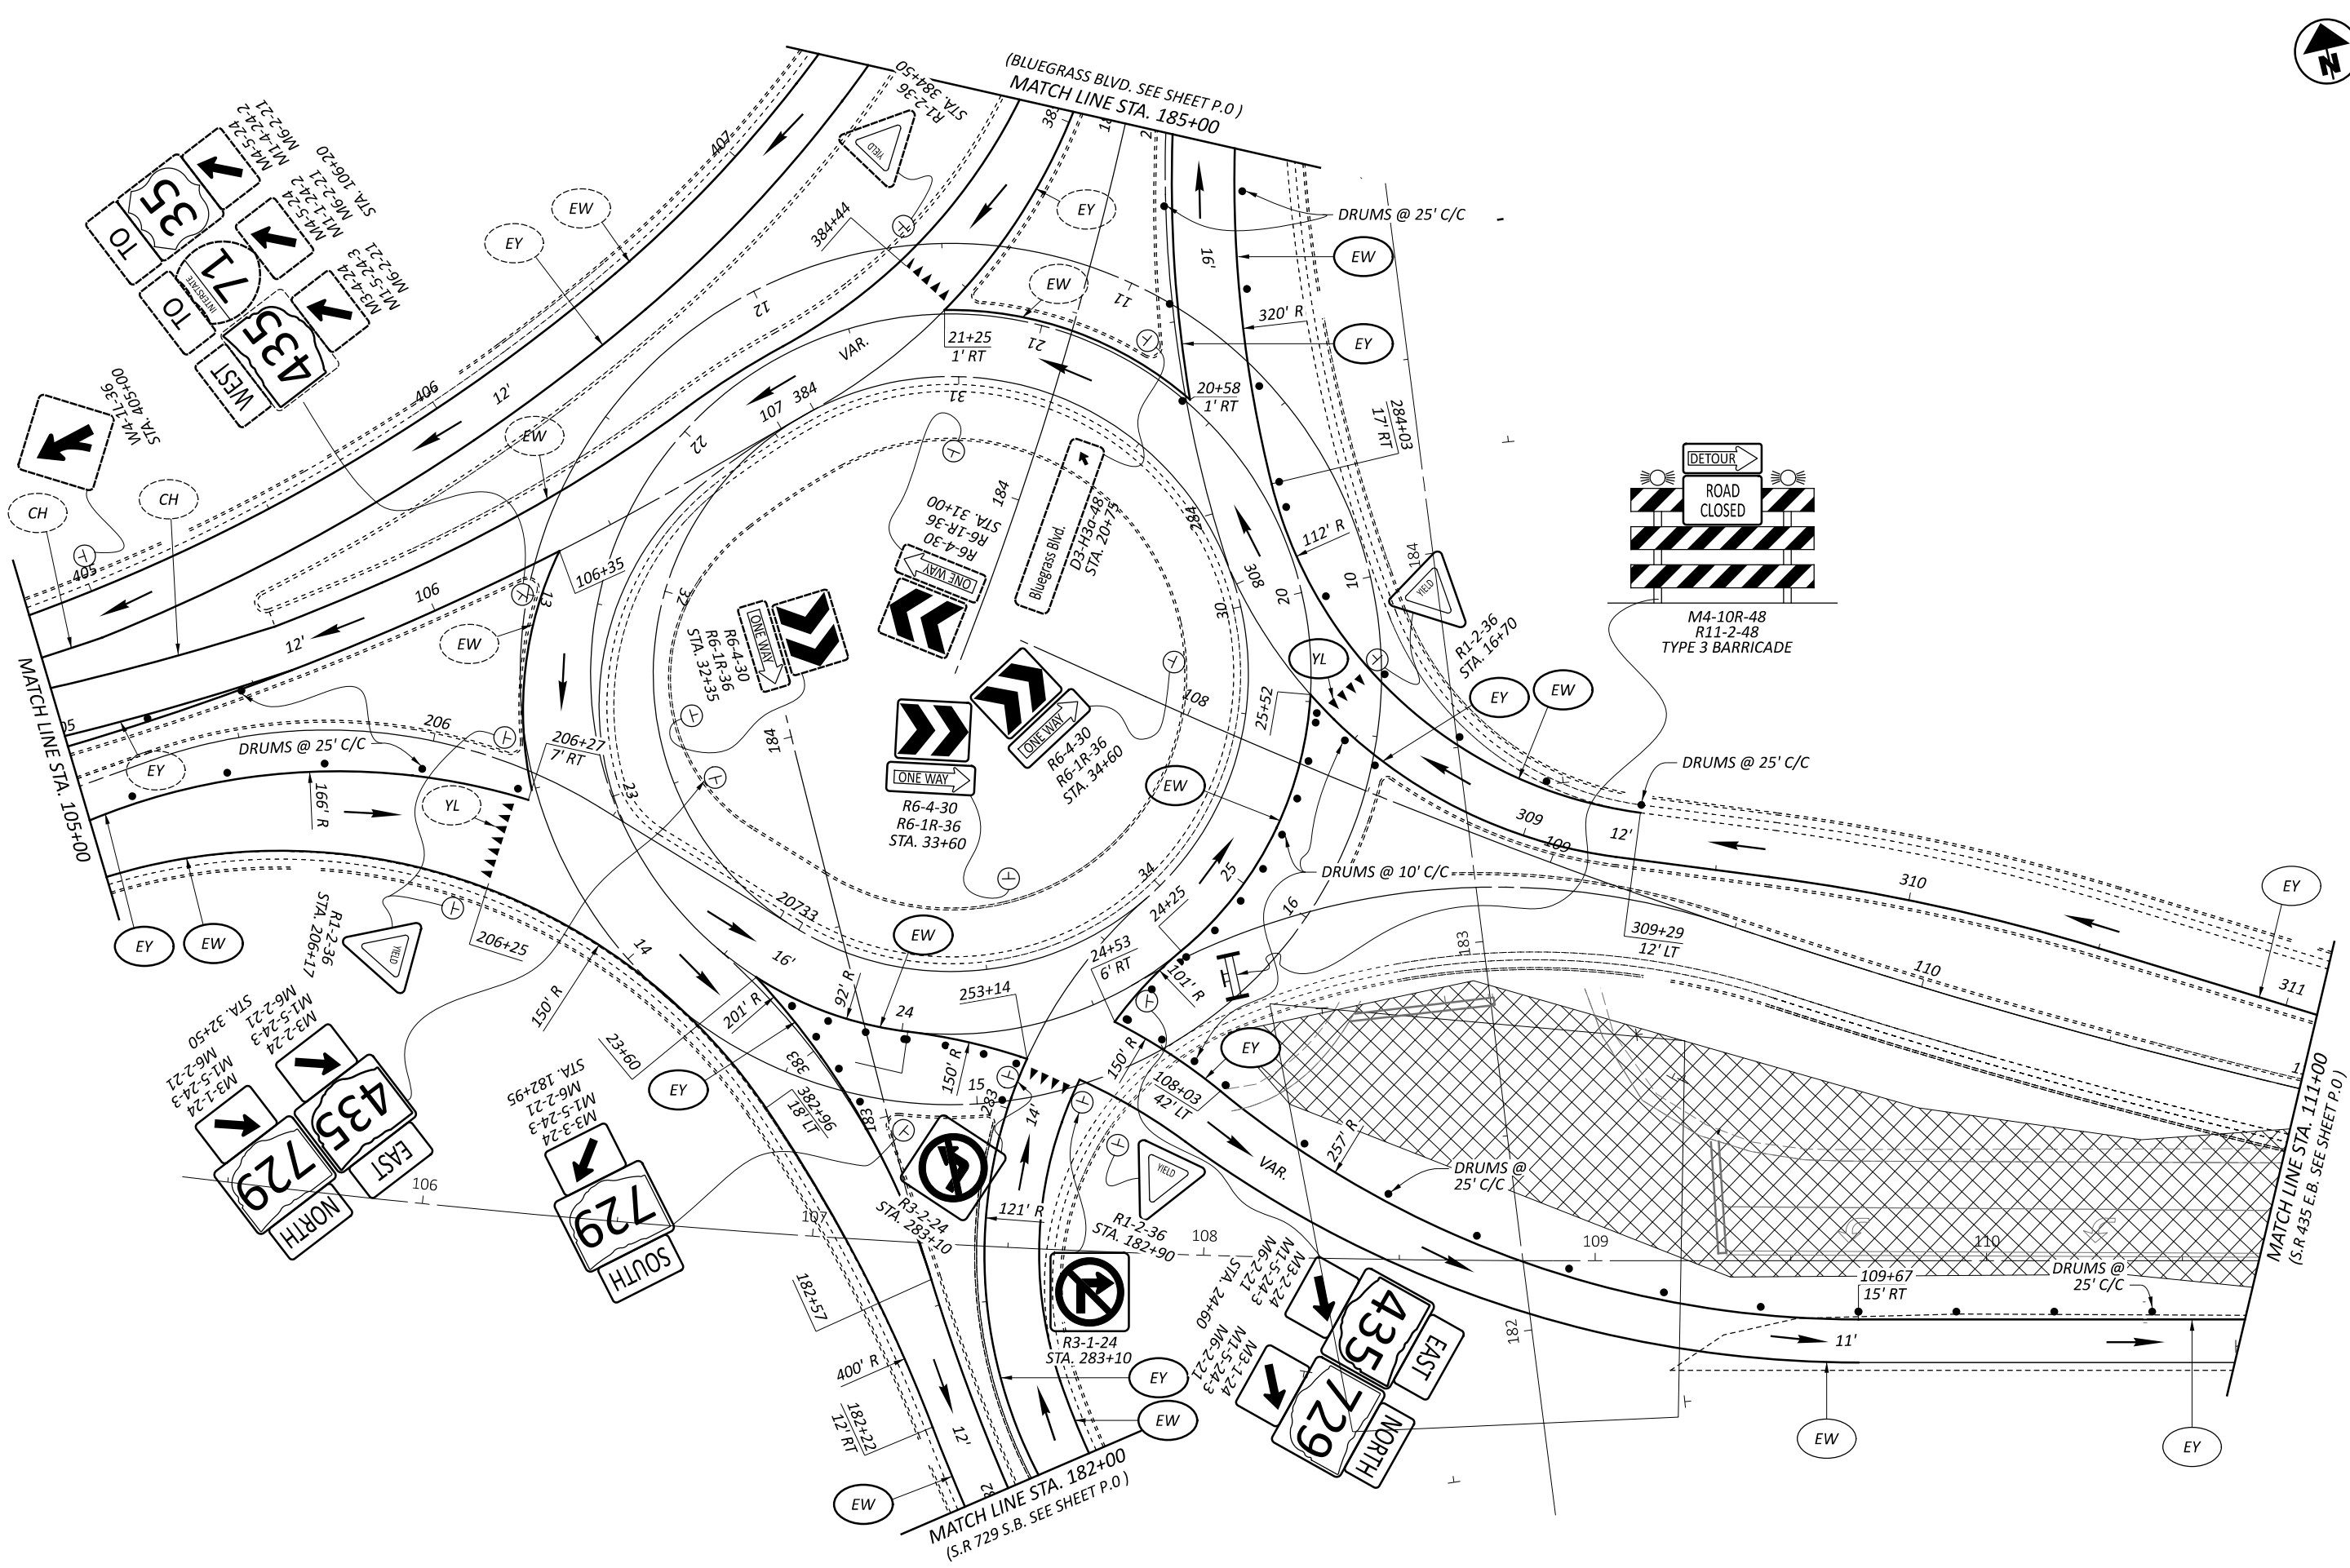

**MAINTENANCE OF TRAFFIC (BU5)
PHASE 4 - S.R. 435 STA. 105+00 TO STA. 111+00**

DESIGN AGENCY
Palmer
 ENGINEERING
 8350 E. KEMPER RD.
 SUITE B
 CINCINNATI, OH 45249
 513-469-1600




DESIGNER	DPF
REVIEWER	DCJ MM-DD-YY
PROJECT ID	117955
SHEET TOTAL	P. 56 228

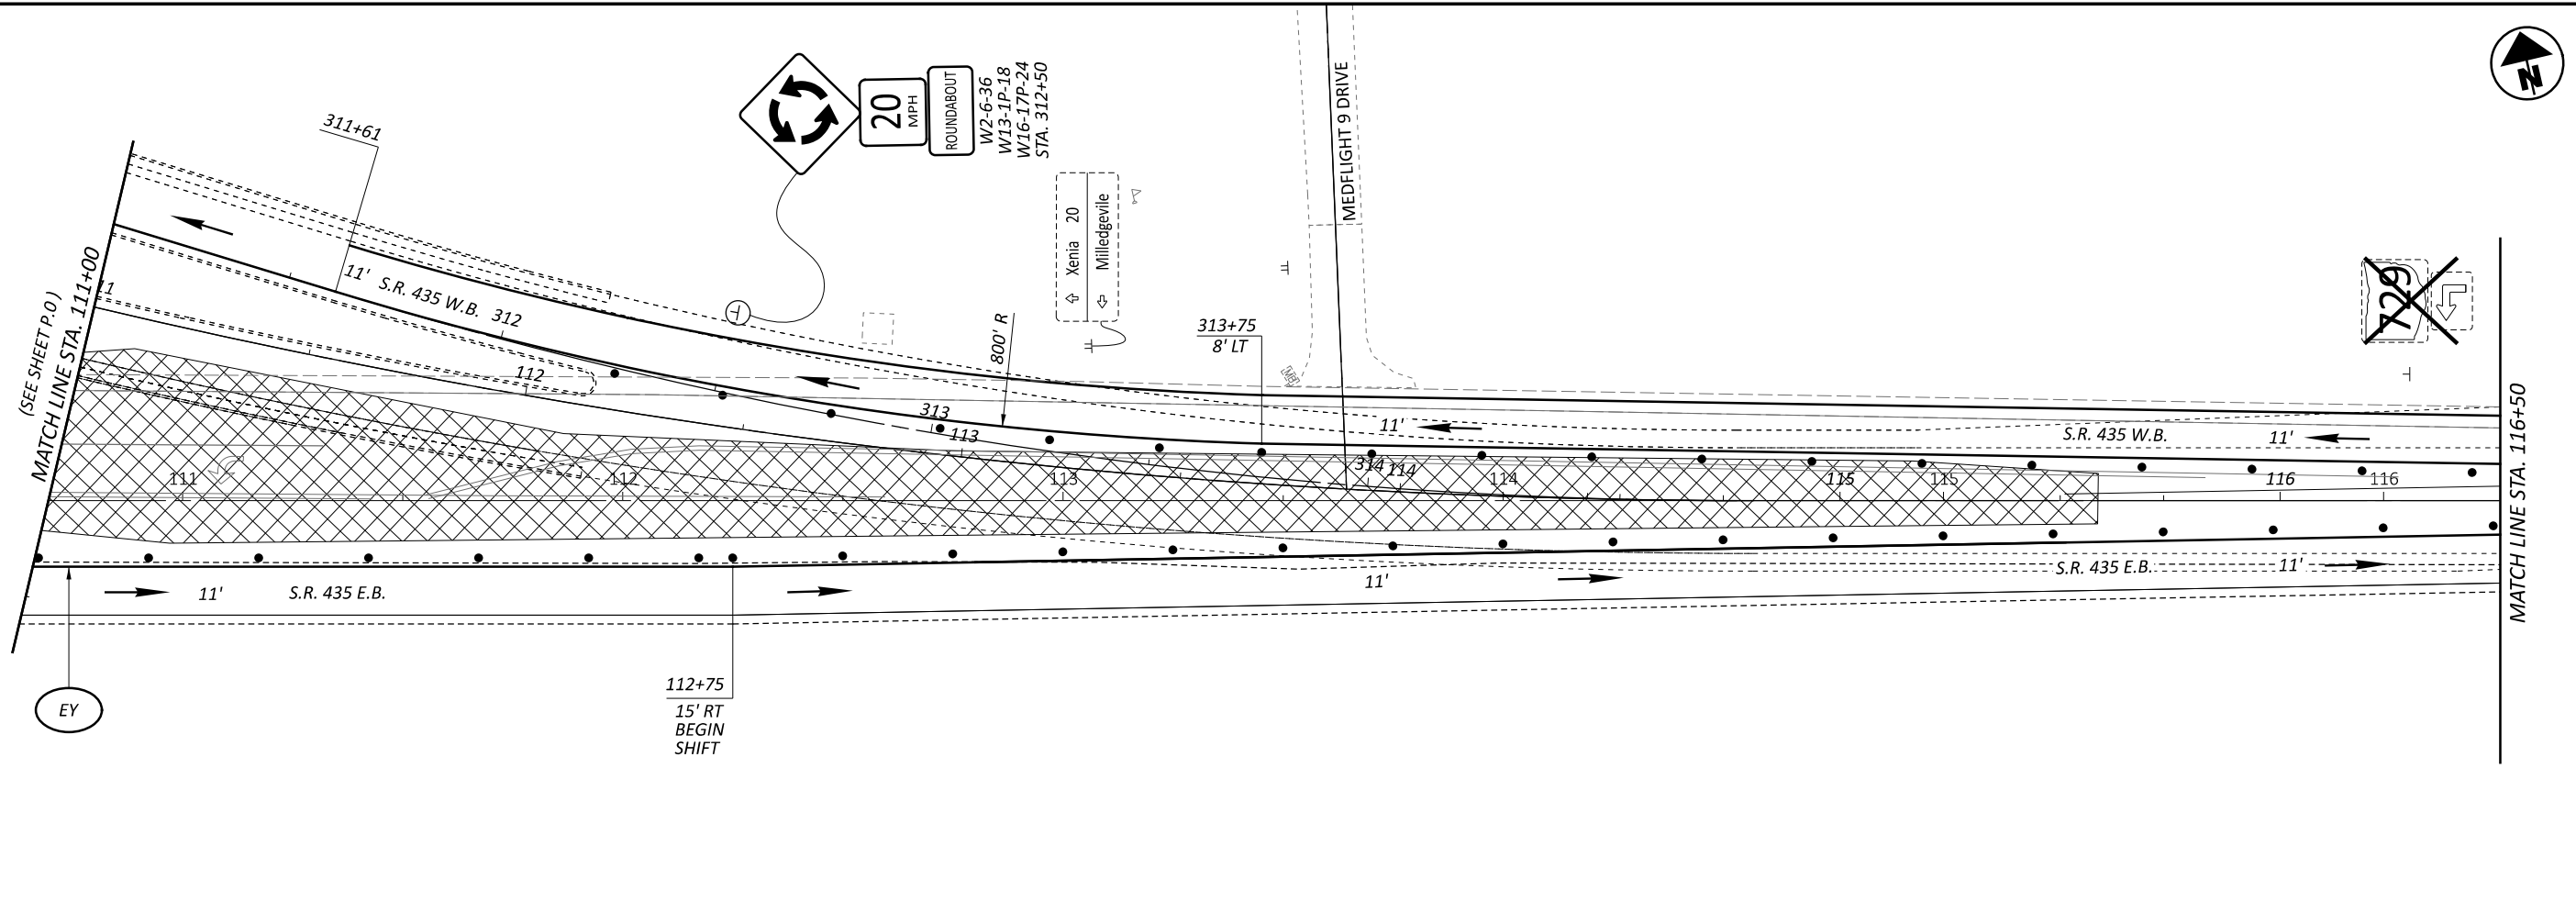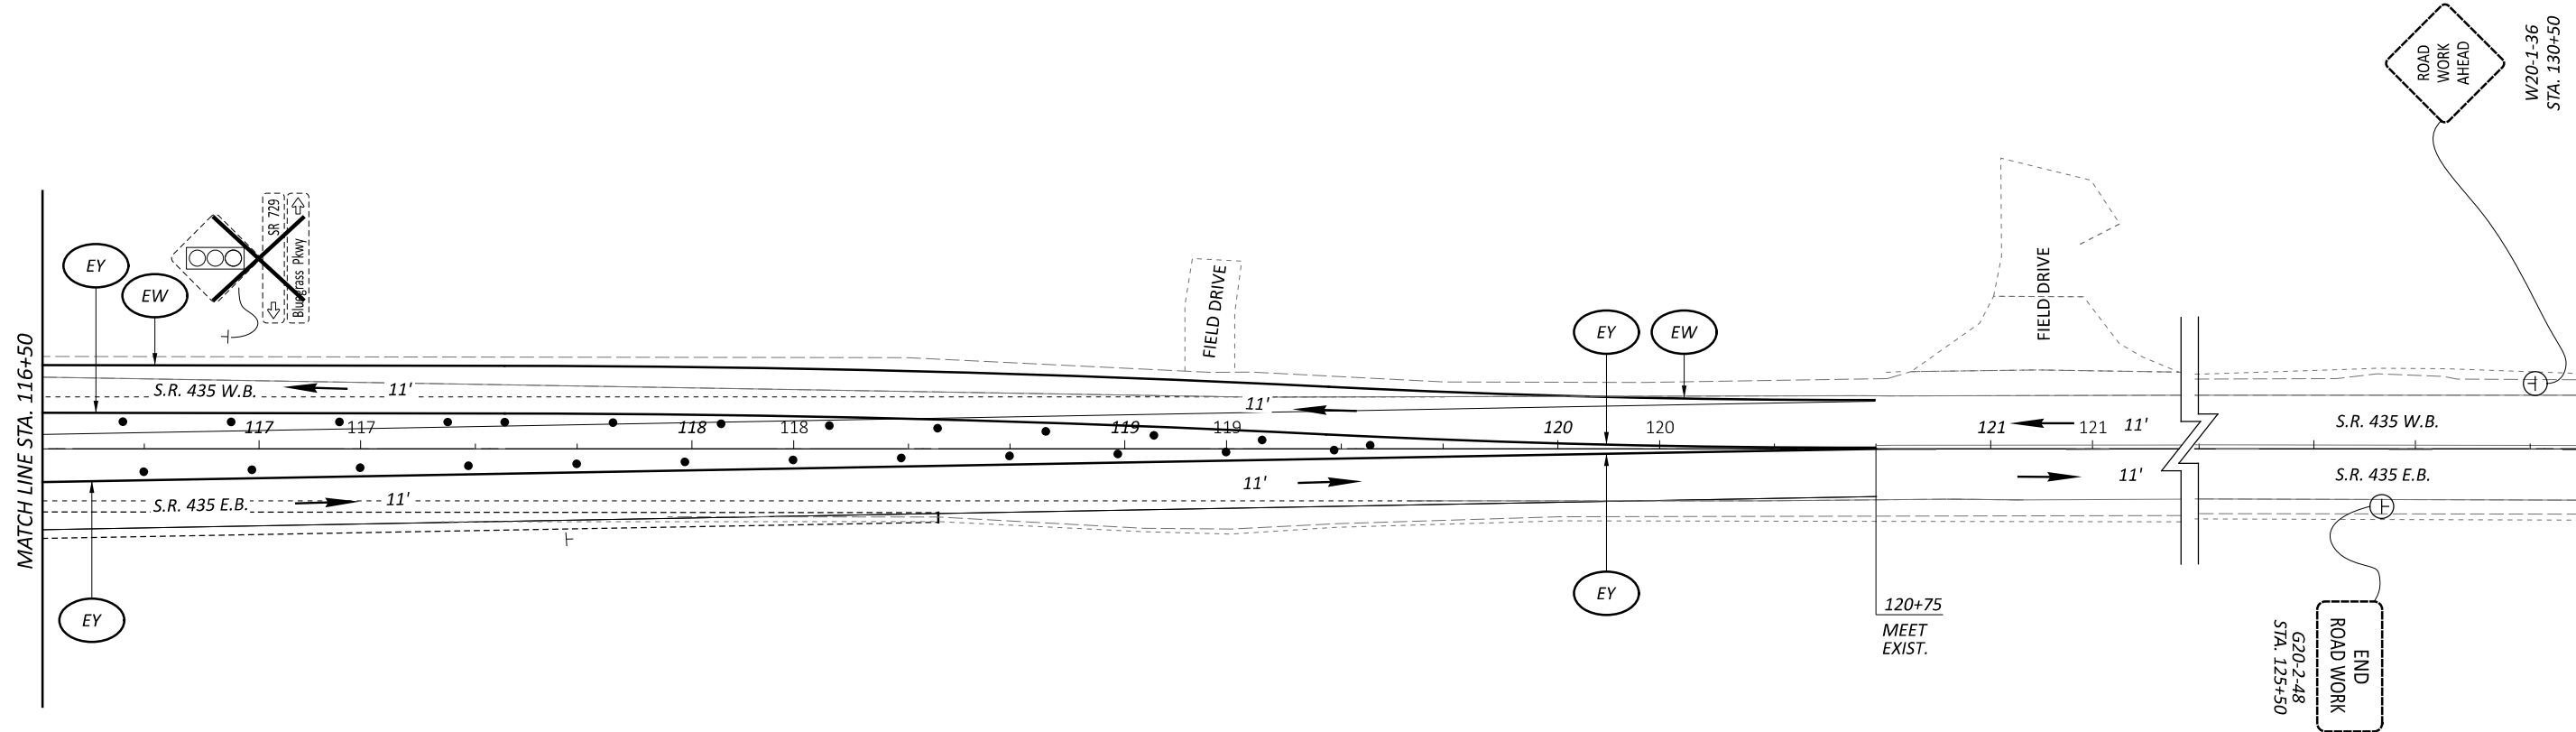

MAINTENANCE OF TRAFFIC (BU5)
 PHASE 4 - S.R. 435 STA. 111+00 TO STA. 130+50




DESIGN AGENCY
Palmer
 ENGINEERING
 8350 E. KEMPER RD.
 SUITE B
 CINCINNATI, OH 45249
 513-469-1600

DESIGNER	DPF
REVIEWER	DCJ MM-DD-YY
PROJECT ID	117955
SHEET TOTAL	P. 57 228

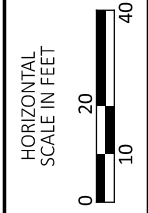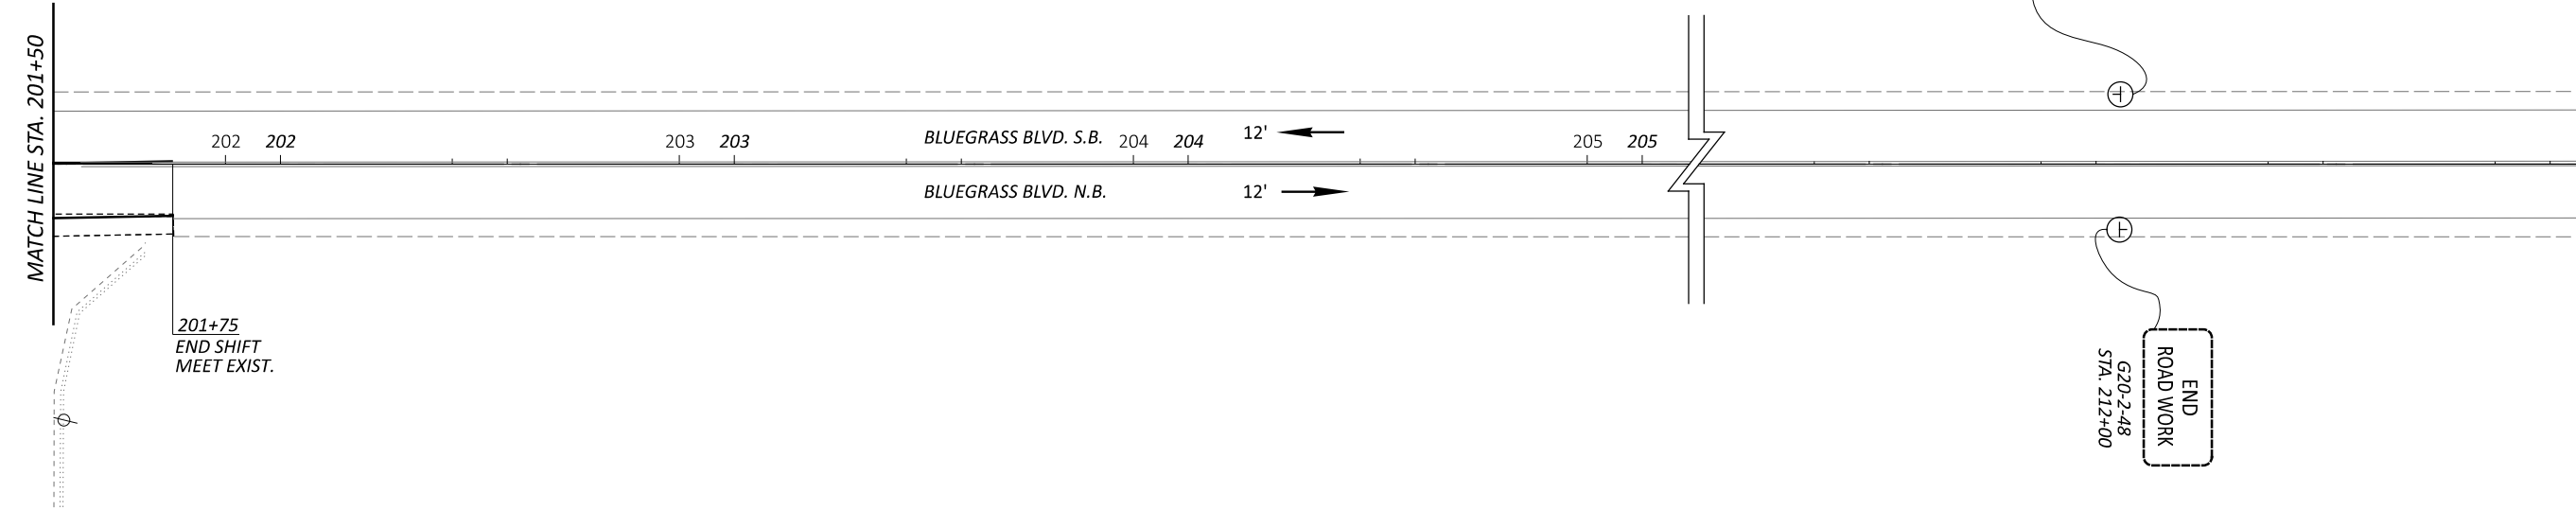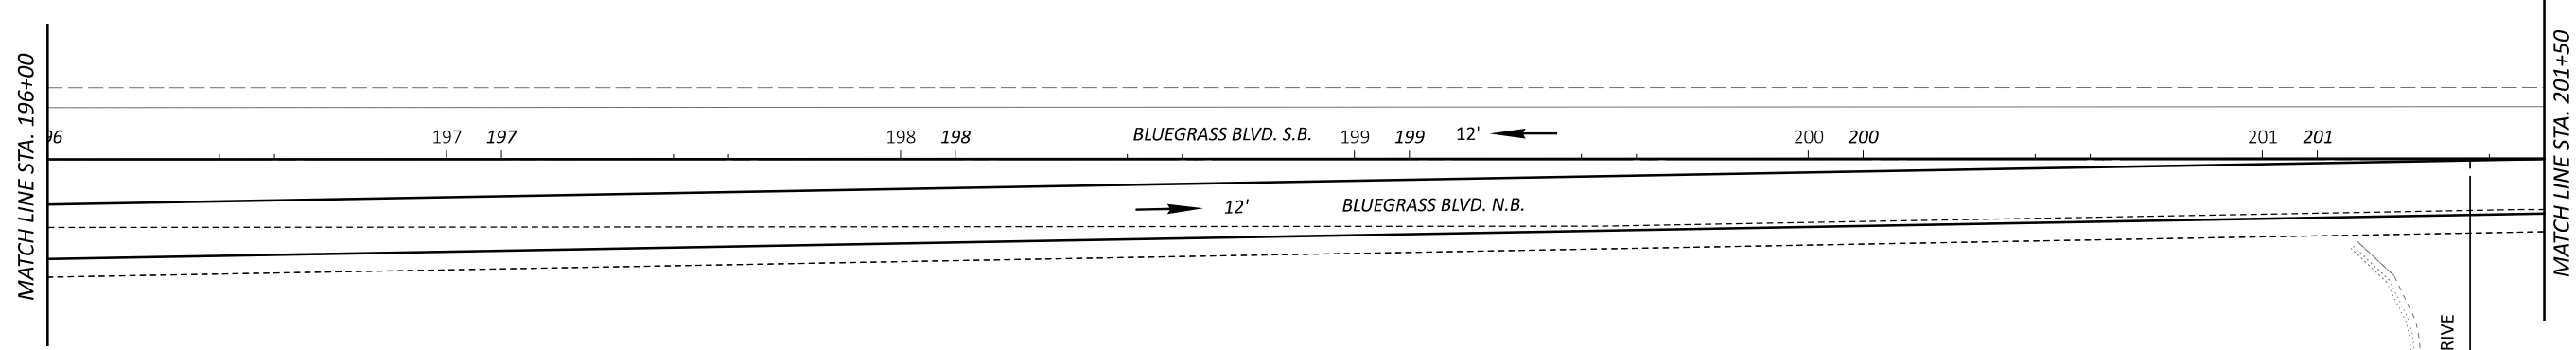

MAINTENANCE OF TRAFFIC (BU5)
PHASE 4 - BLUEGRASS BLVD. STA. 196+00 TO STA. 212+00




DESIGN AGENCY	
 Palmer ENGINEERING 8350 E. KEMPER RD. SUITE B CINCINNATI, OH 45249 513-469-1600	
DESIGNER	
DPF	
REVIEWER	
DCJ MM-DD-YY	
PROJECT ID	
117955	
SHEET	TOTAL
P. 59	228

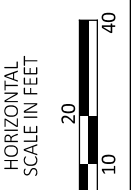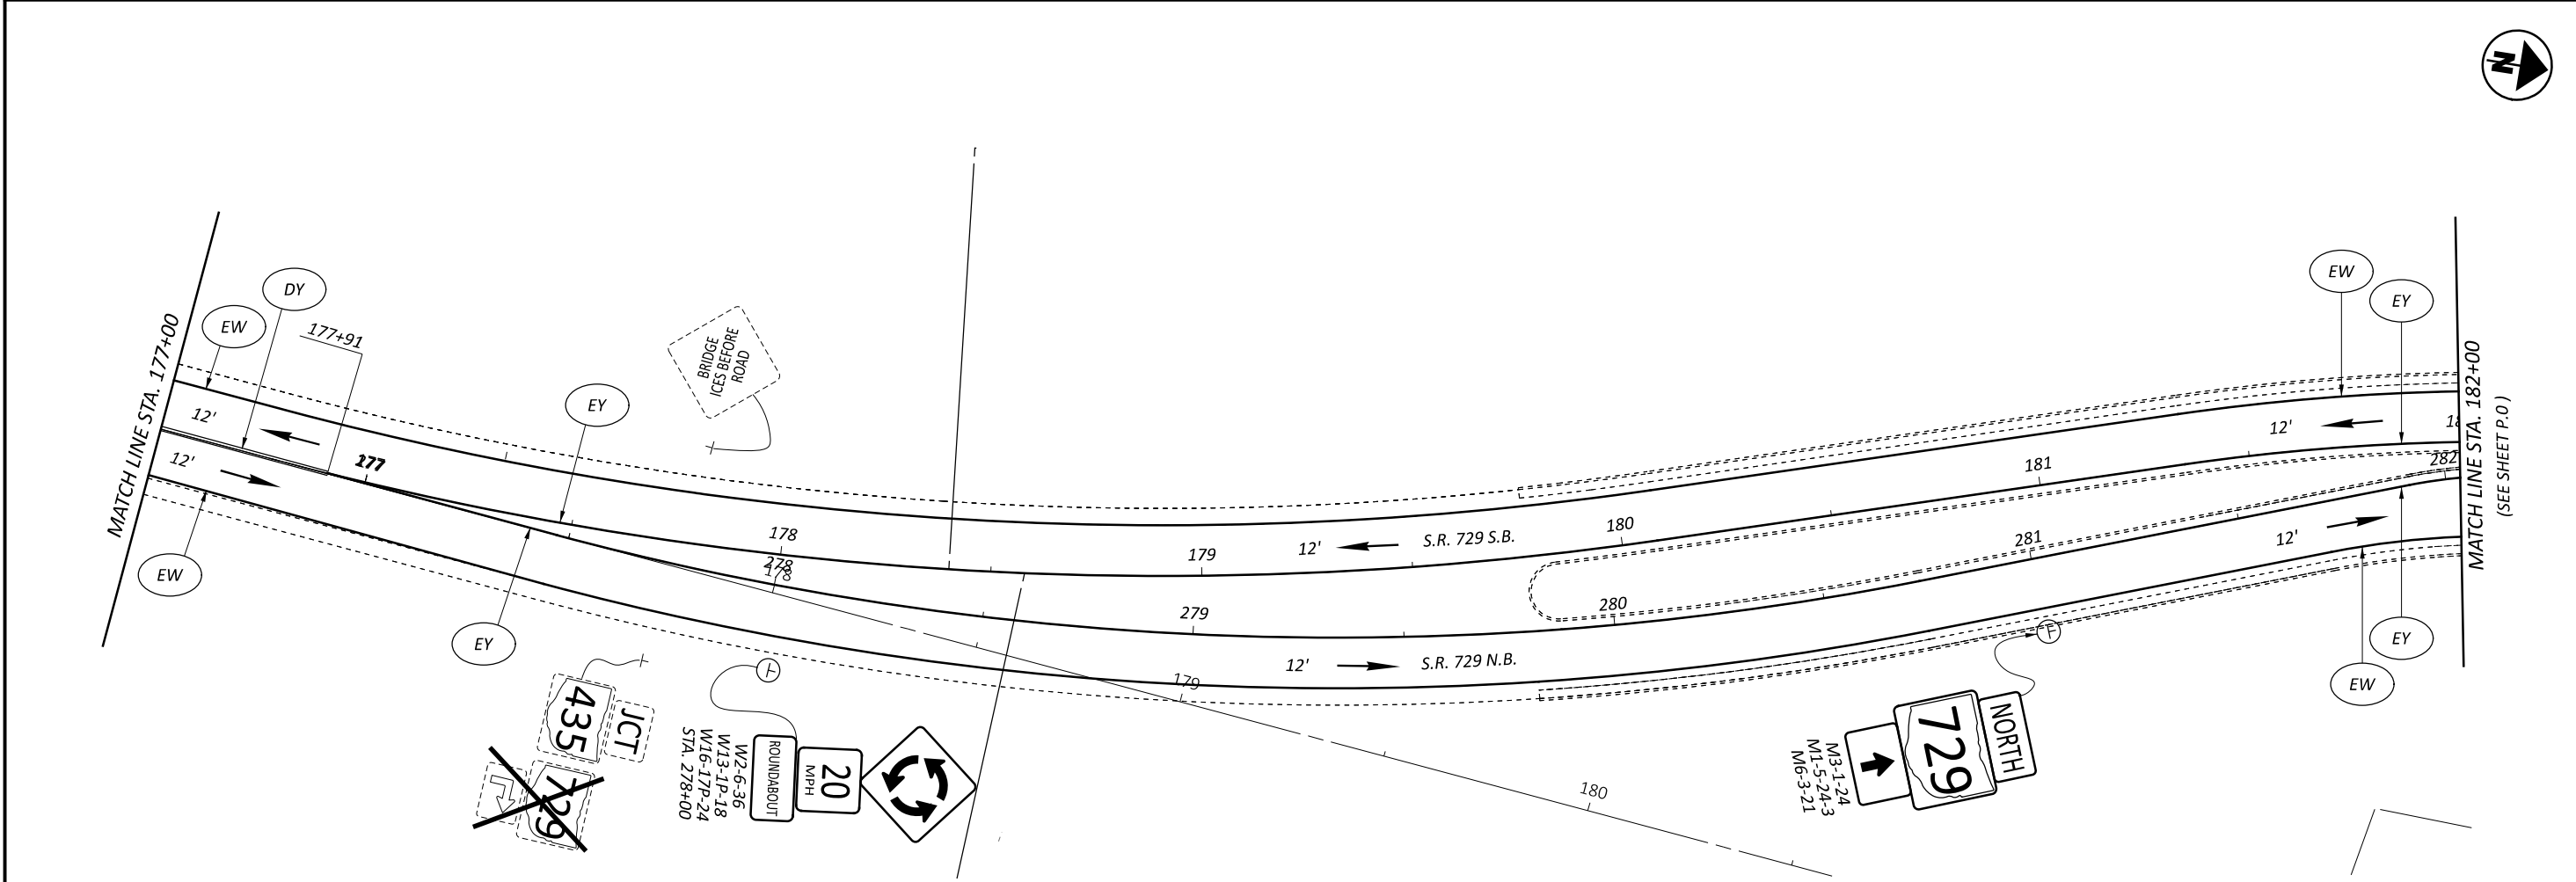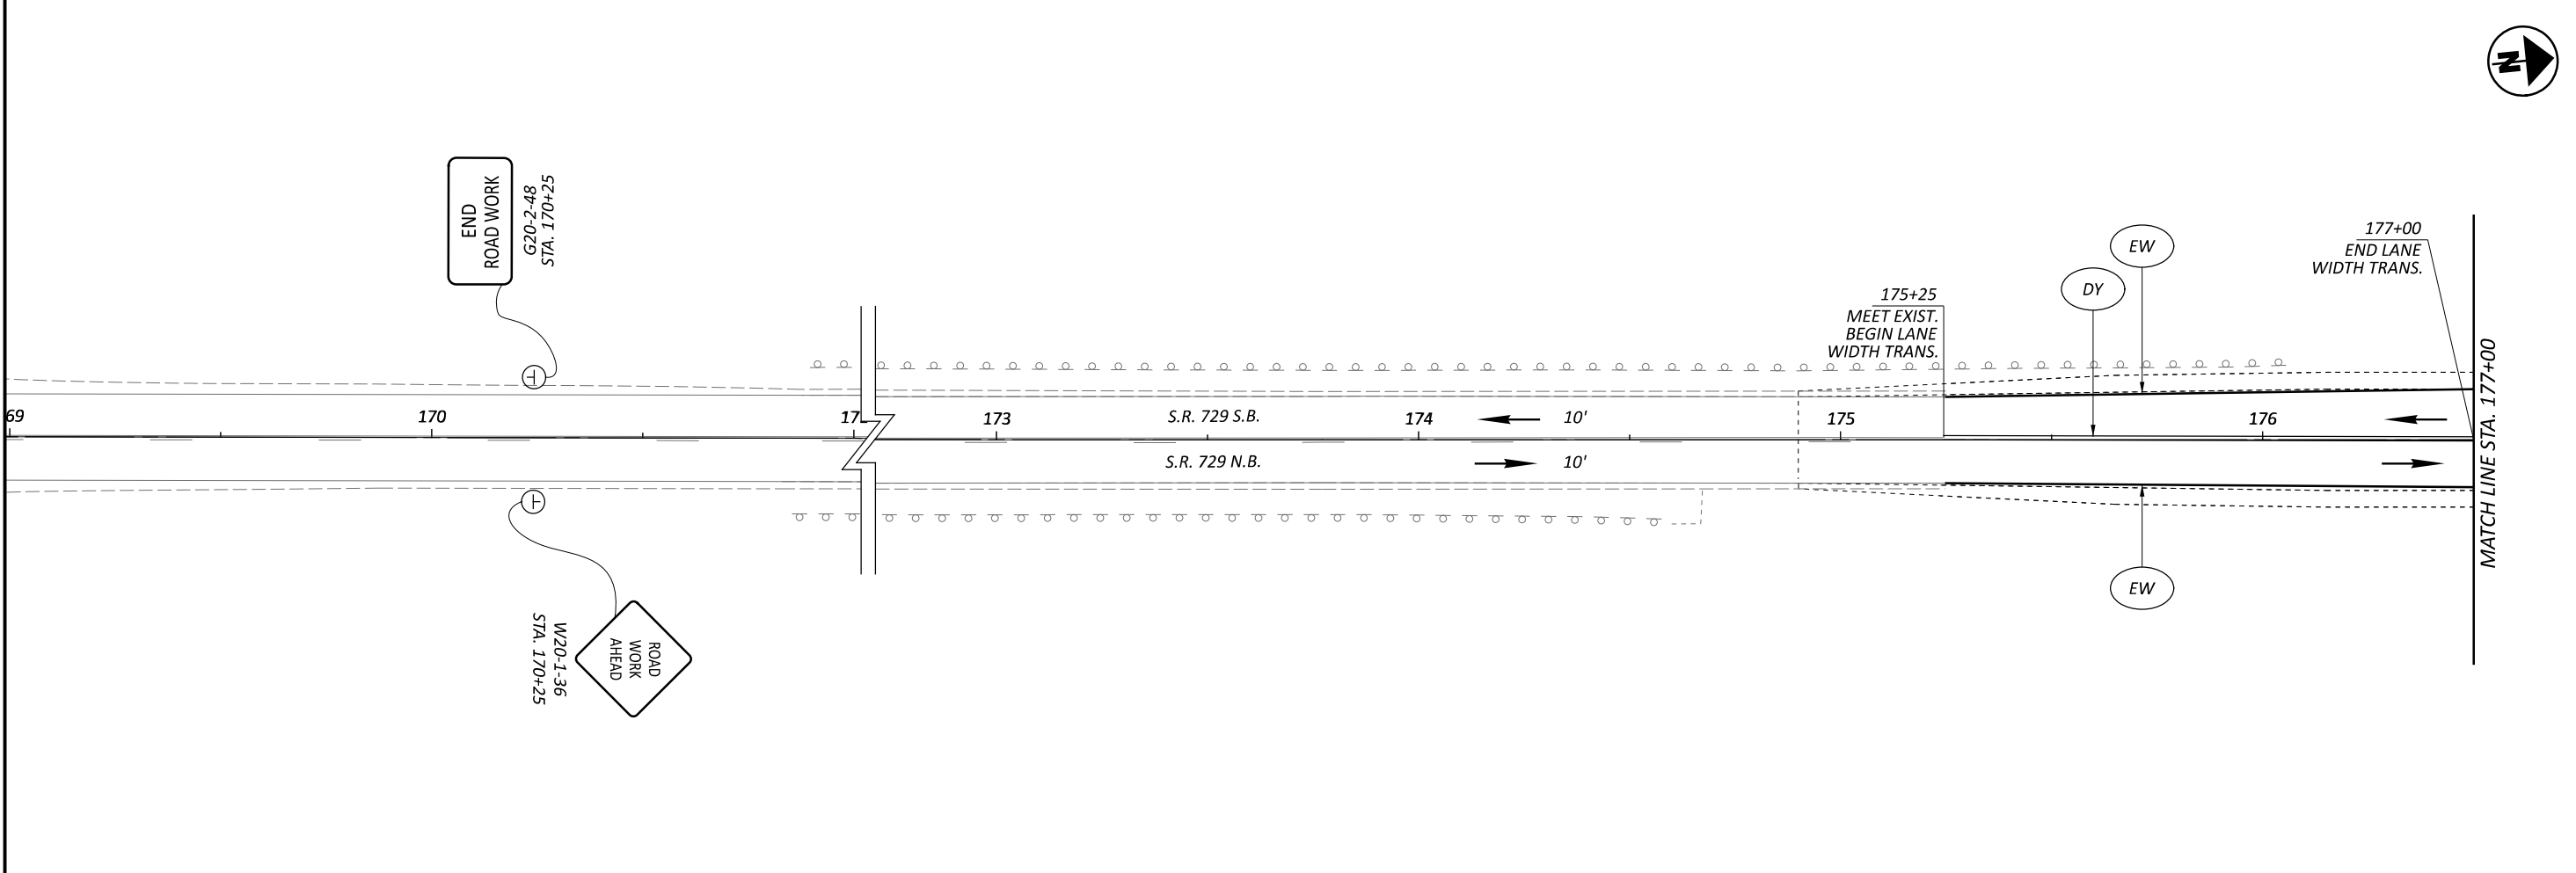

MAINTENANCE OF TRAFFIC (BU5)
 PHASE 4 - S.R. 729 STA. 170+25 TO STA. 182+00




DESIGN AGENCY	
 PALMER ENGINEERING 8350 E. KEMPER RD. SUITE B CINCINNATI, OH 45249 513-469-1600	
DESIGNER	
DPF	
REVIEWER	
DCJ MM-DD-YY	
PROJECT ID	
117955	
SHEET	TOTAL
P. 60	228

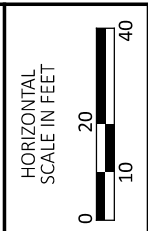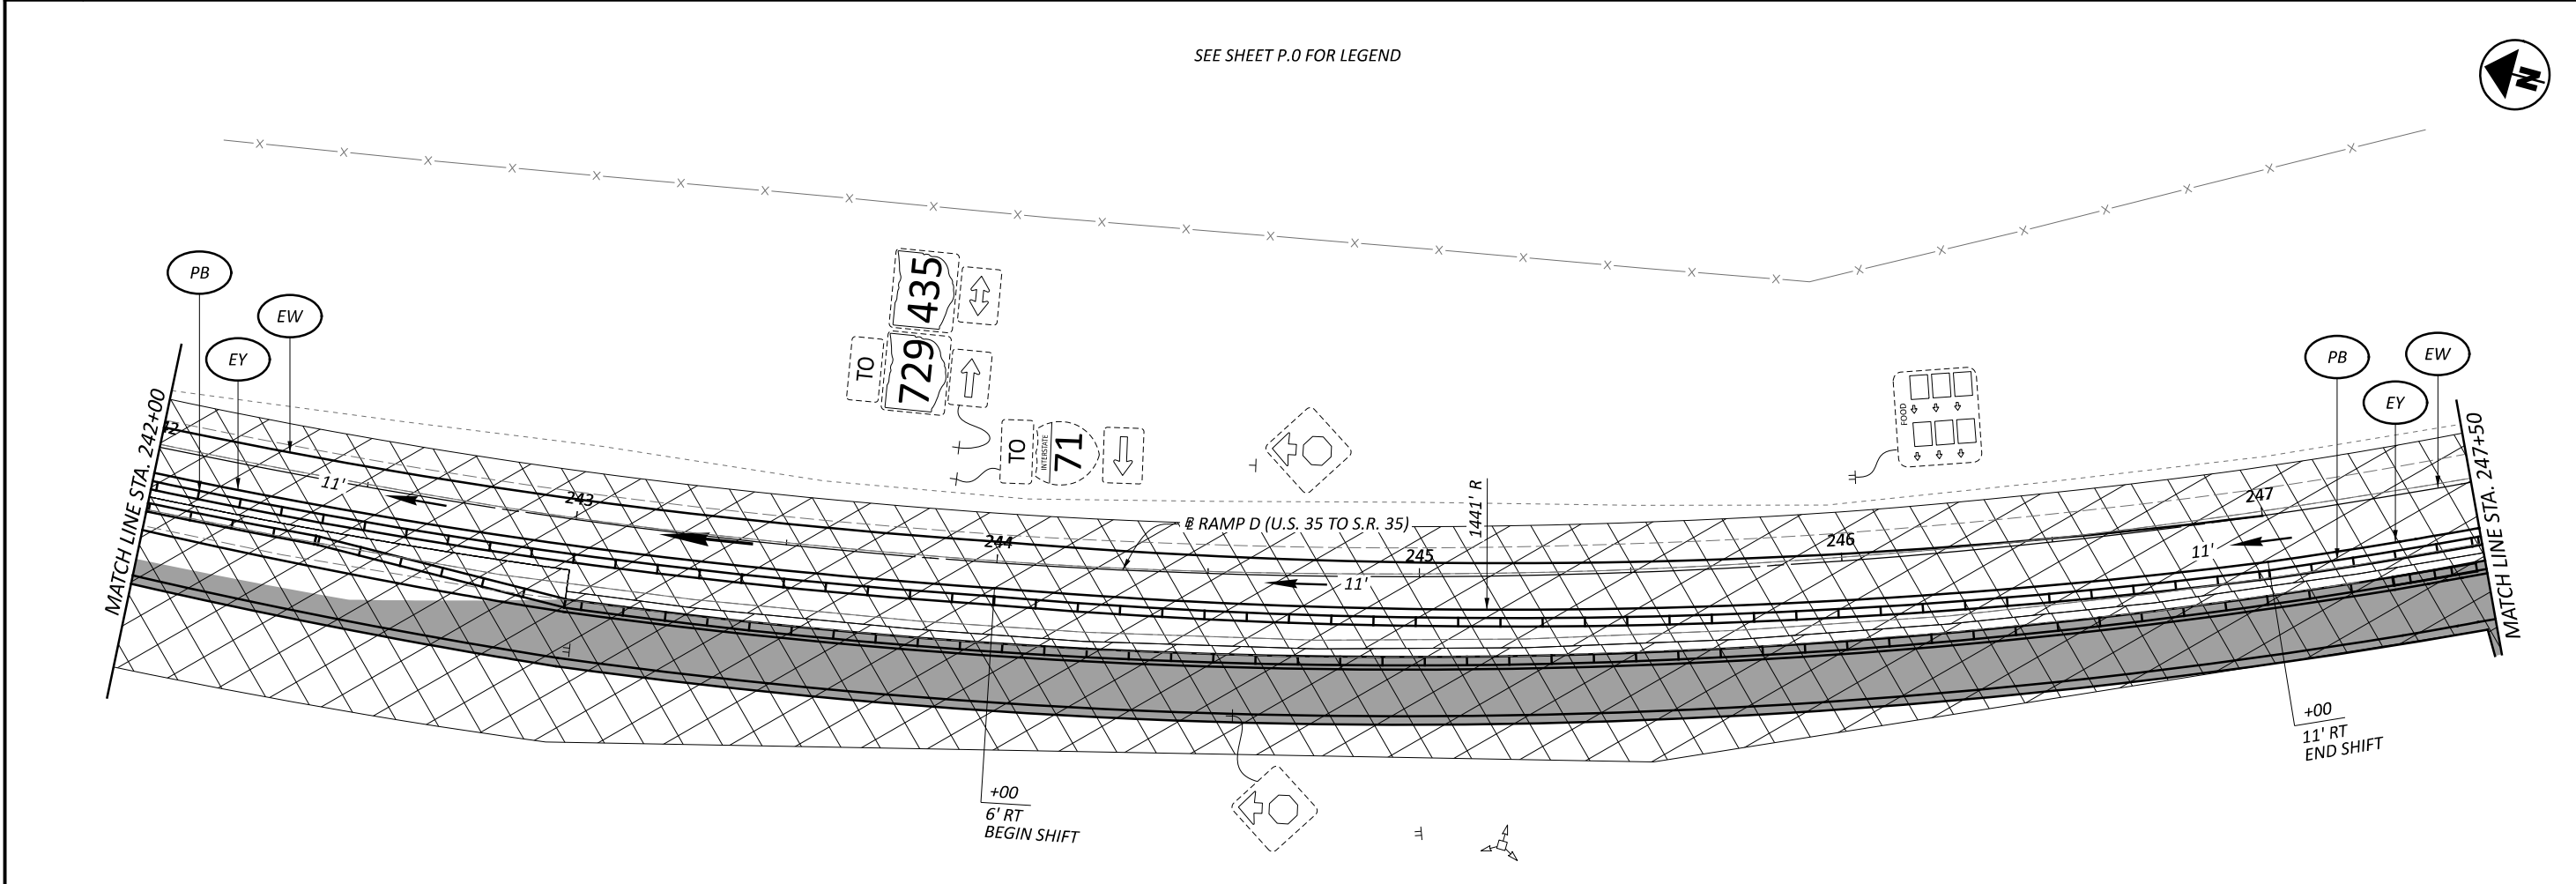
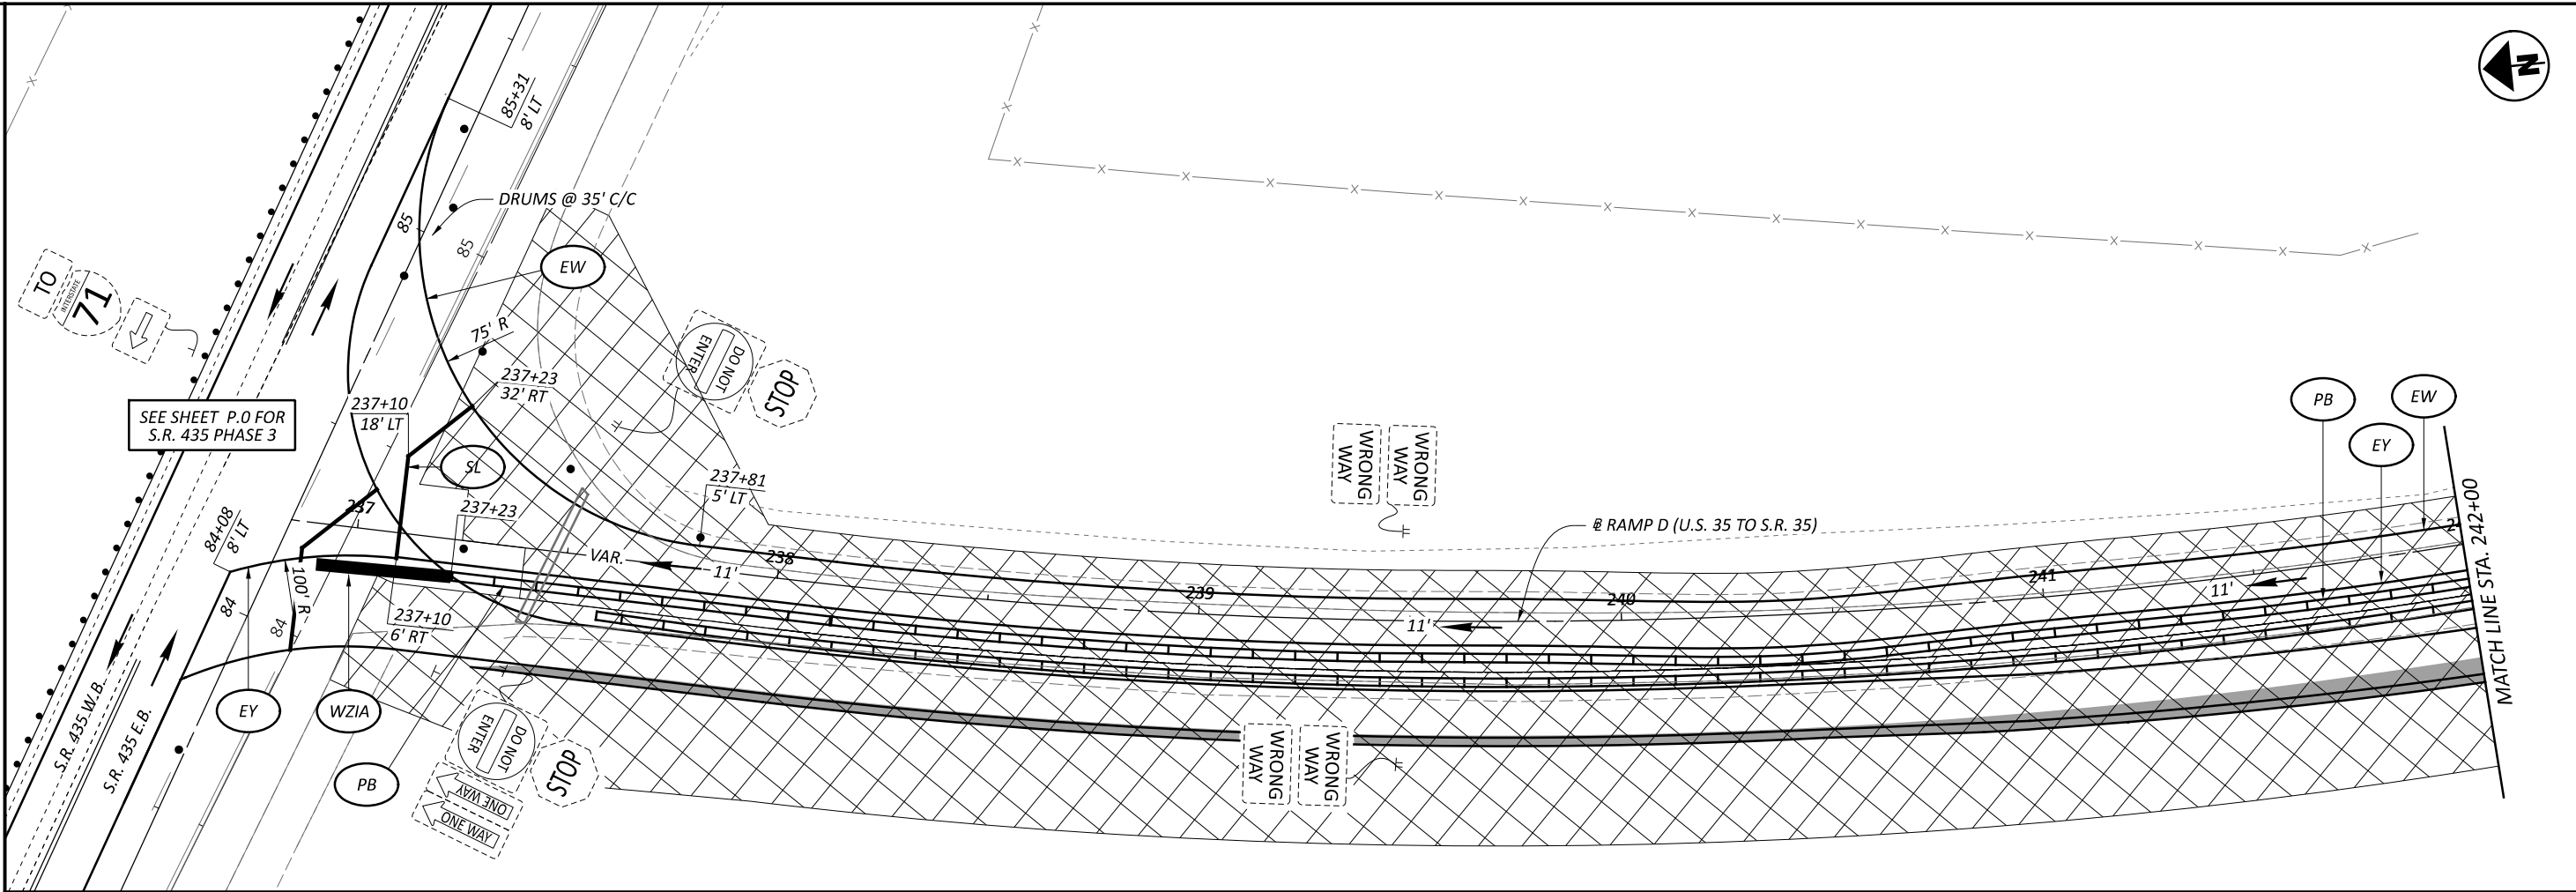


MAINTENANCE OF TRAFFIC (BU5)
 PHASE 3A - RAMP D (U.S. 35 TO S.R. 435) STA. 236+84 TO STA. 247+50

DESIGN AGENCY	
 PALMER ENGINEERING 8350 E. KEMPER RD. SUITE B CINCINNATI, OH 45249 513-469-1600	
DESIGNER	DPF
REVIEWER	DCJ MM-DD-YY
PROJECT ID	117955
SHEET	TOTAL
P. 61	228


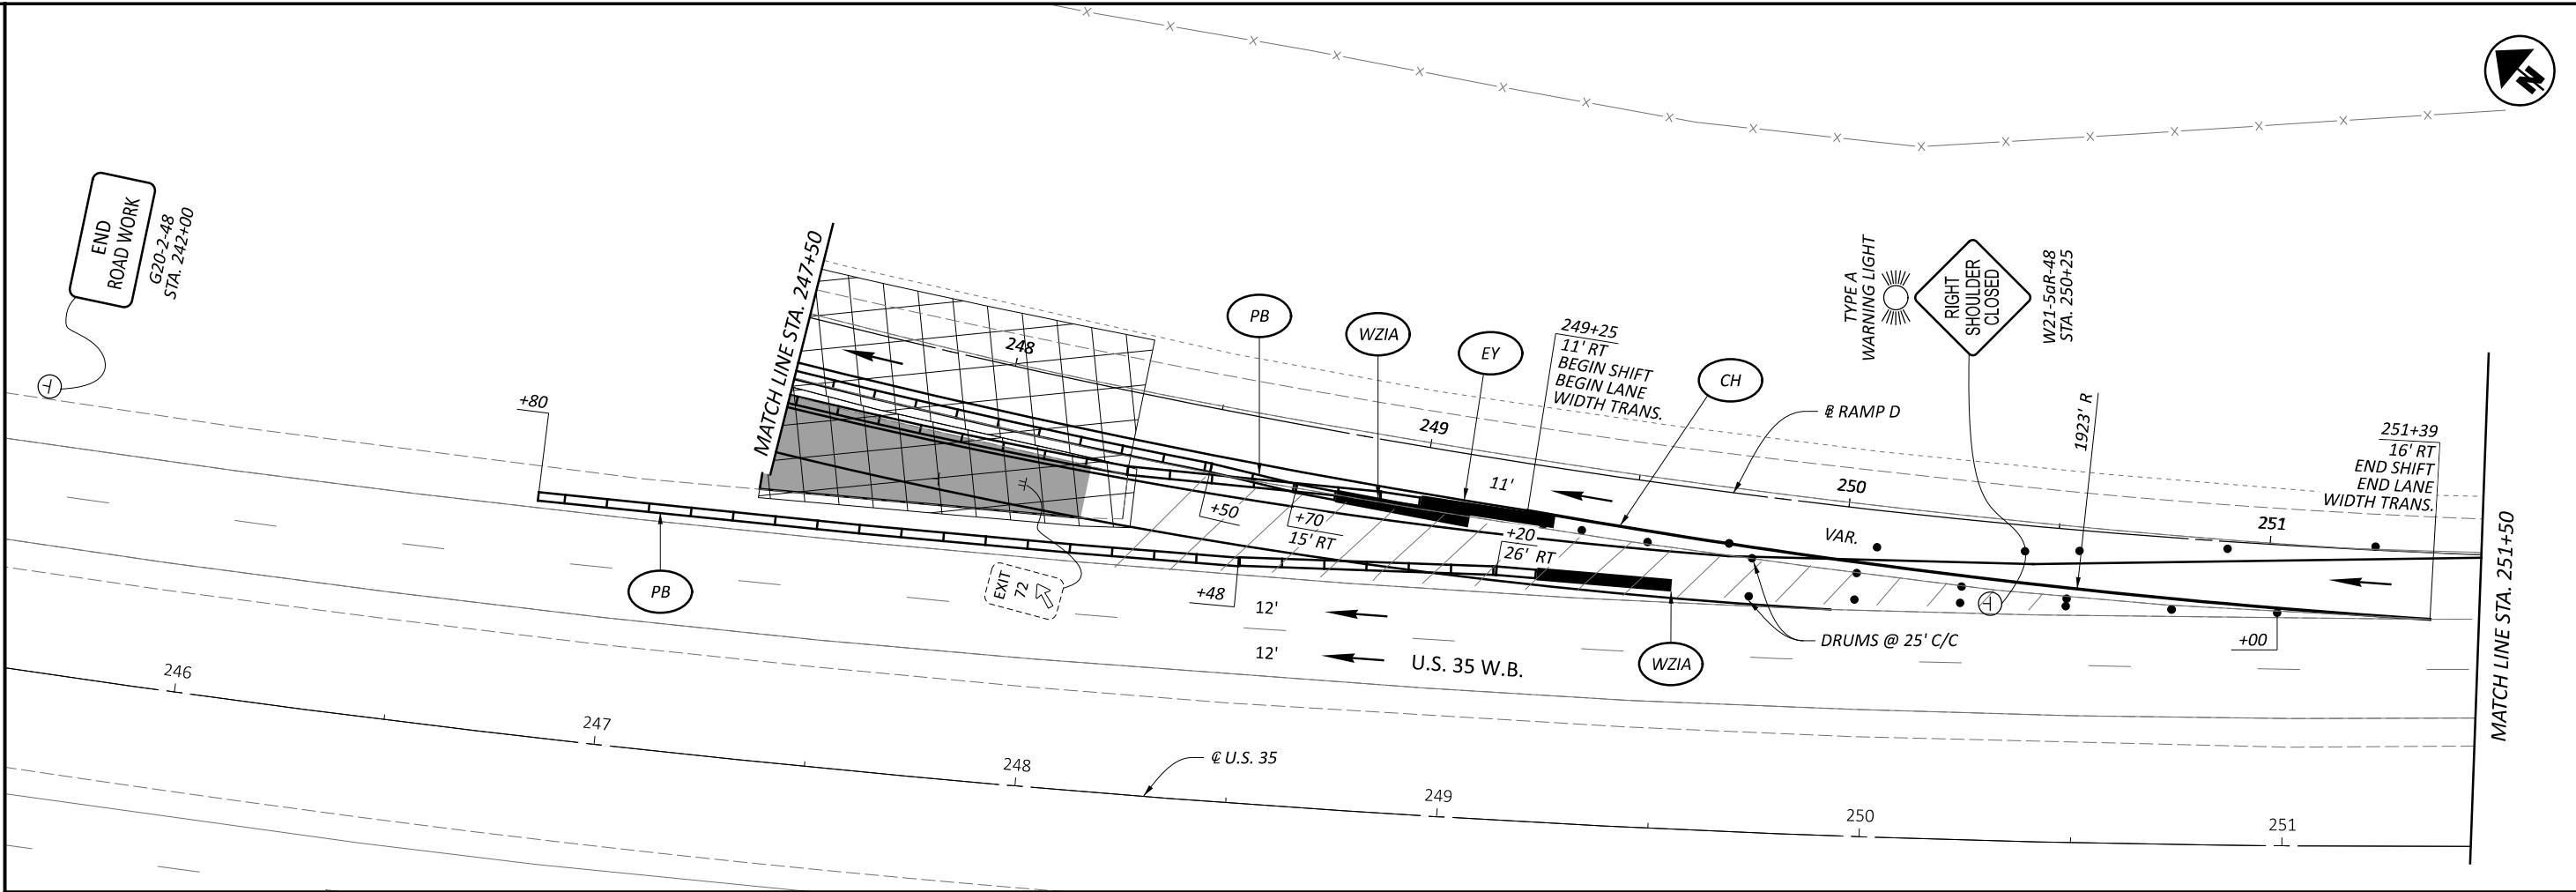


SEE SHEET P.O FOR LEGEND

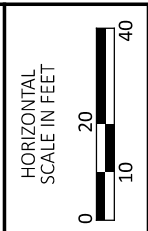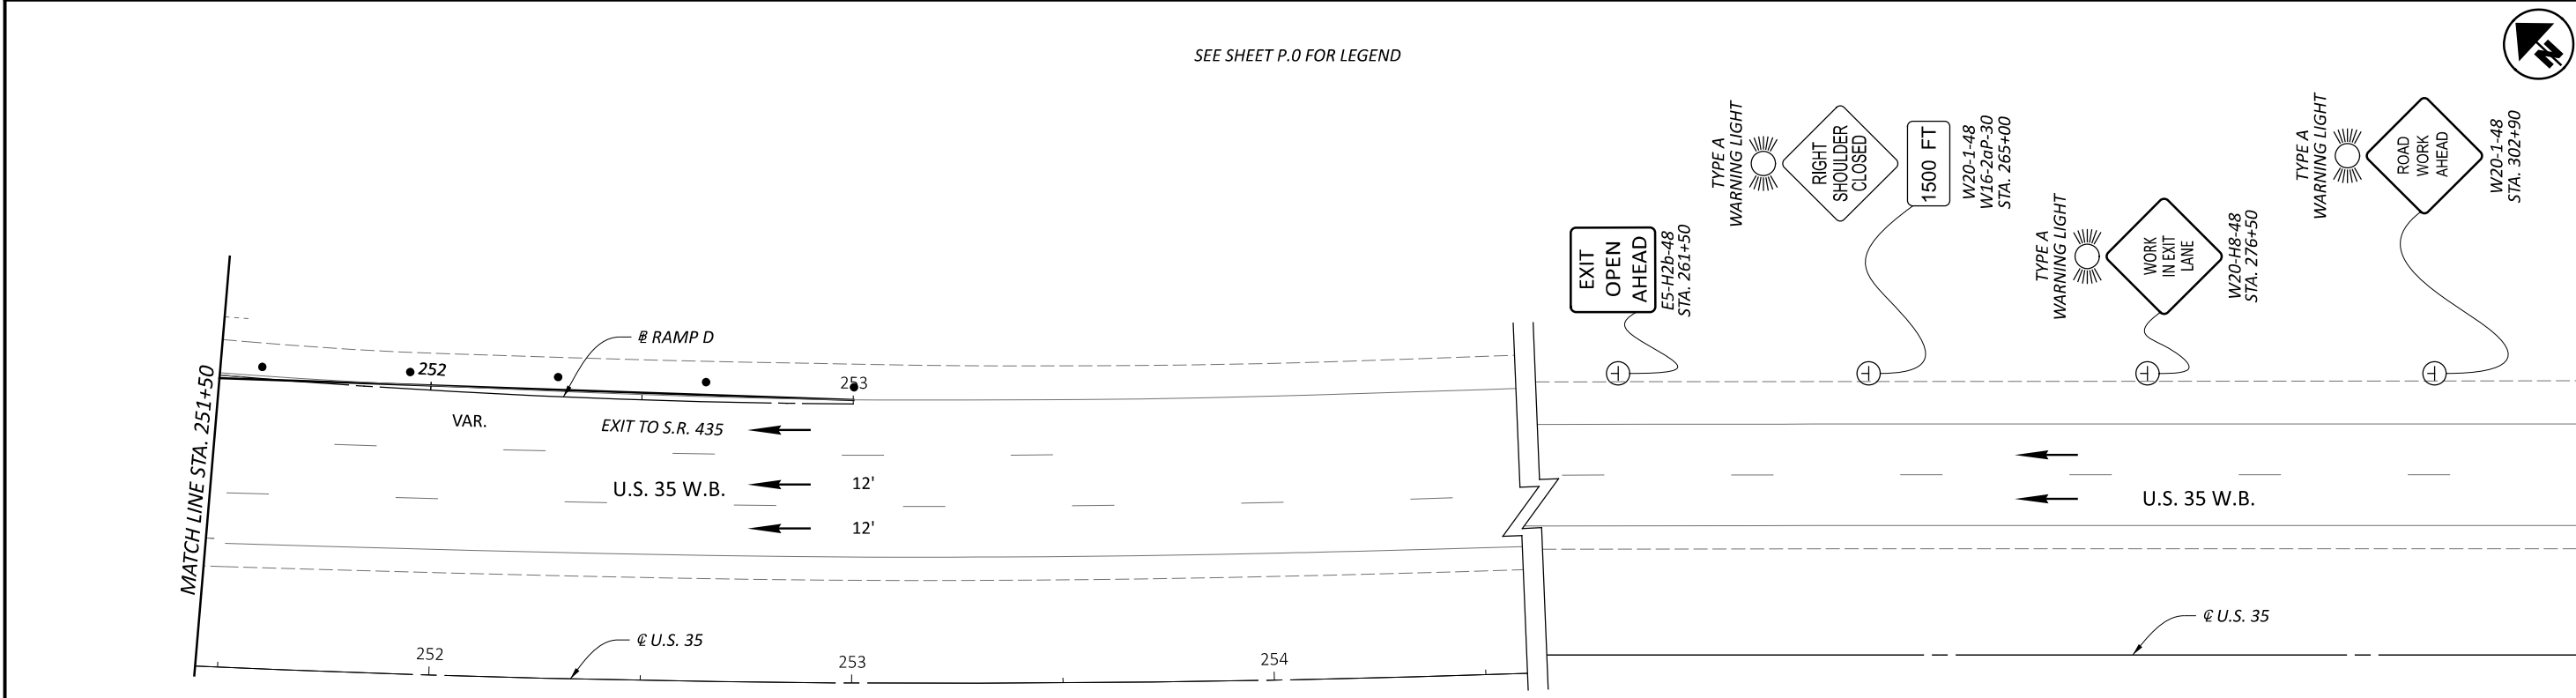


MAINTENANCE OF TRAFFIC (BU5)
 PHASE 3A - RAMP D (U.S. 35 TO S.R. 435) STA. 247+50 TO STA. 302+90

DESIGN AGENCY	
Palmer ENGINEERING 8350 E. KEMPER RD. SUITE B CINCINNATI, OH 45249 513-469-1600	
DESIGNER	
DPF	
REVIEWER	
DCJ MM-DD-YY	
PROJECT ID	
117955	
SHEET	TOTAL
P. 62	228

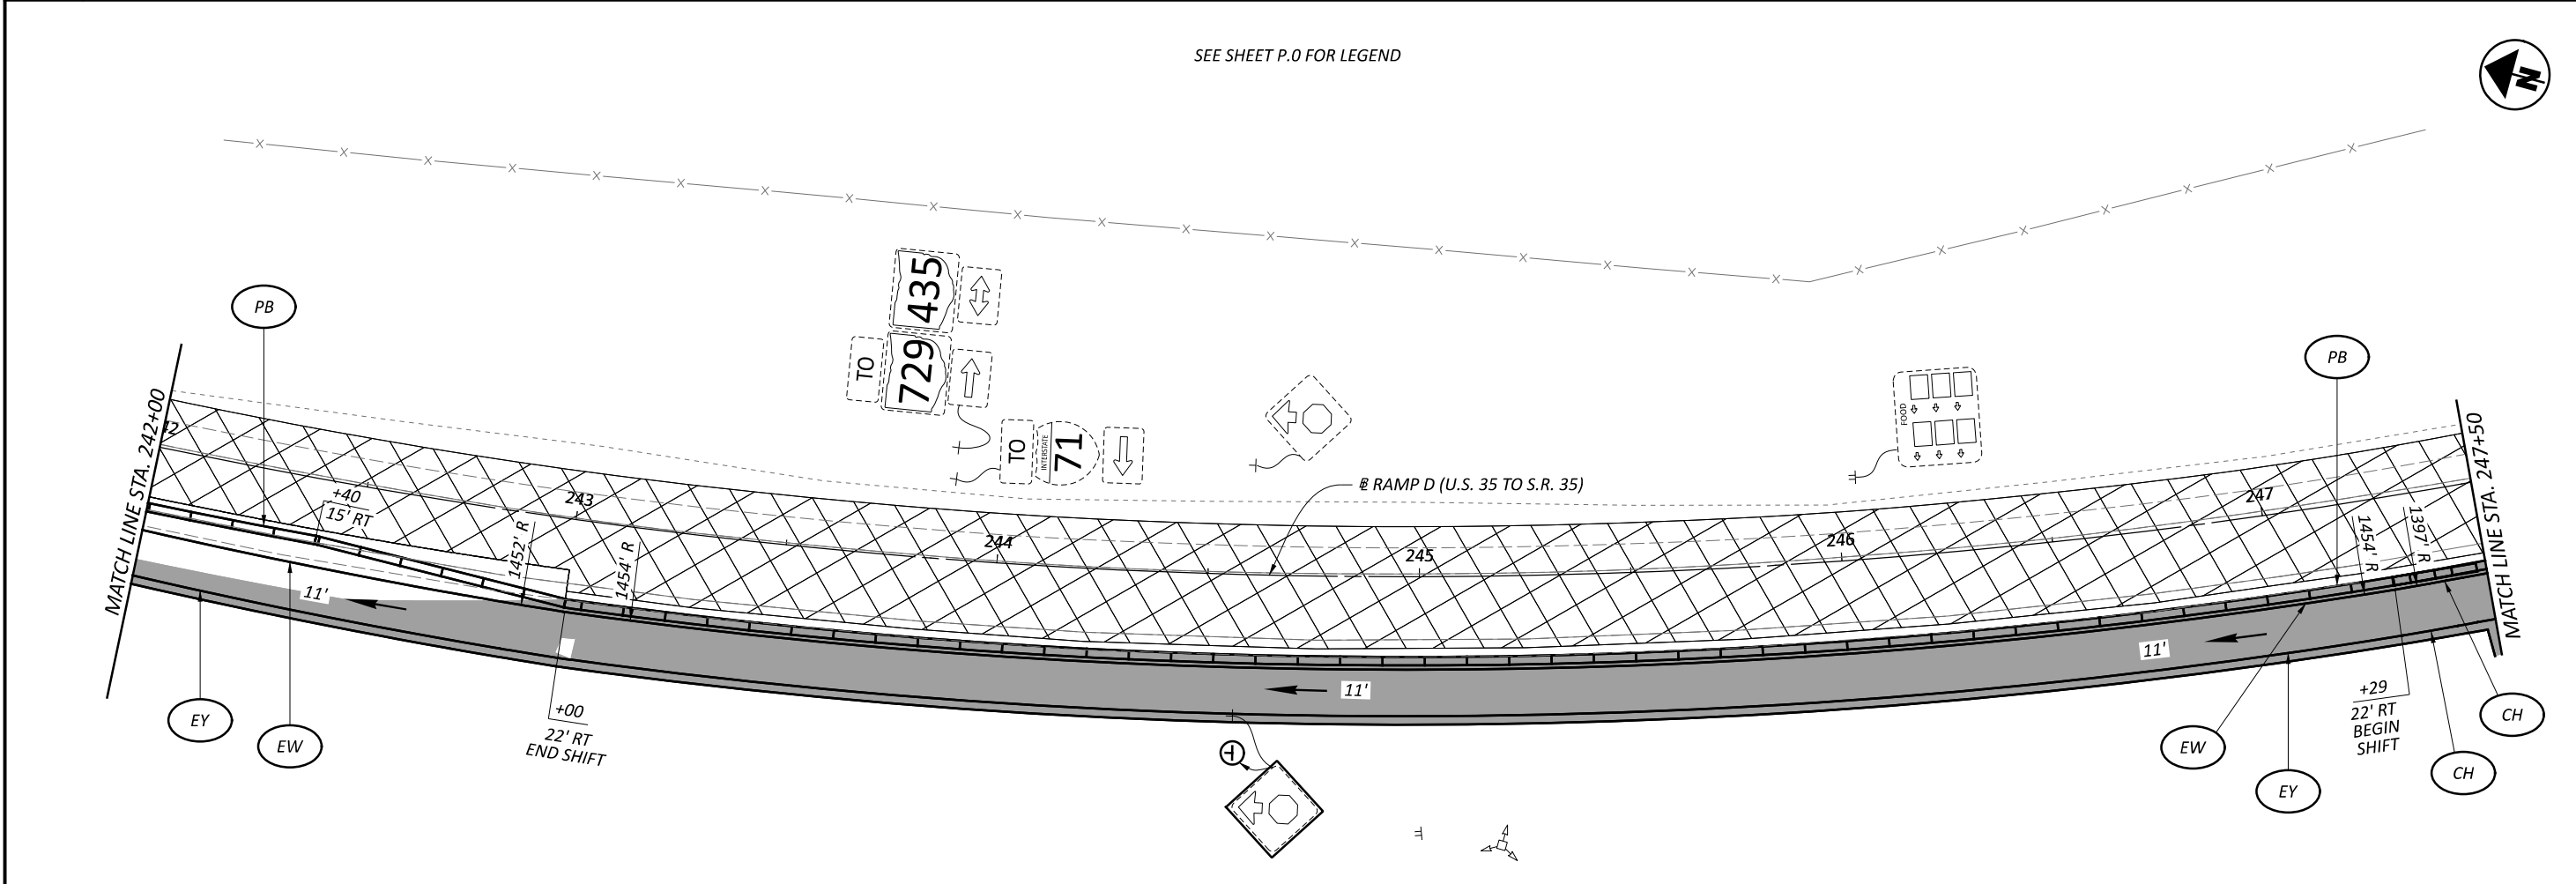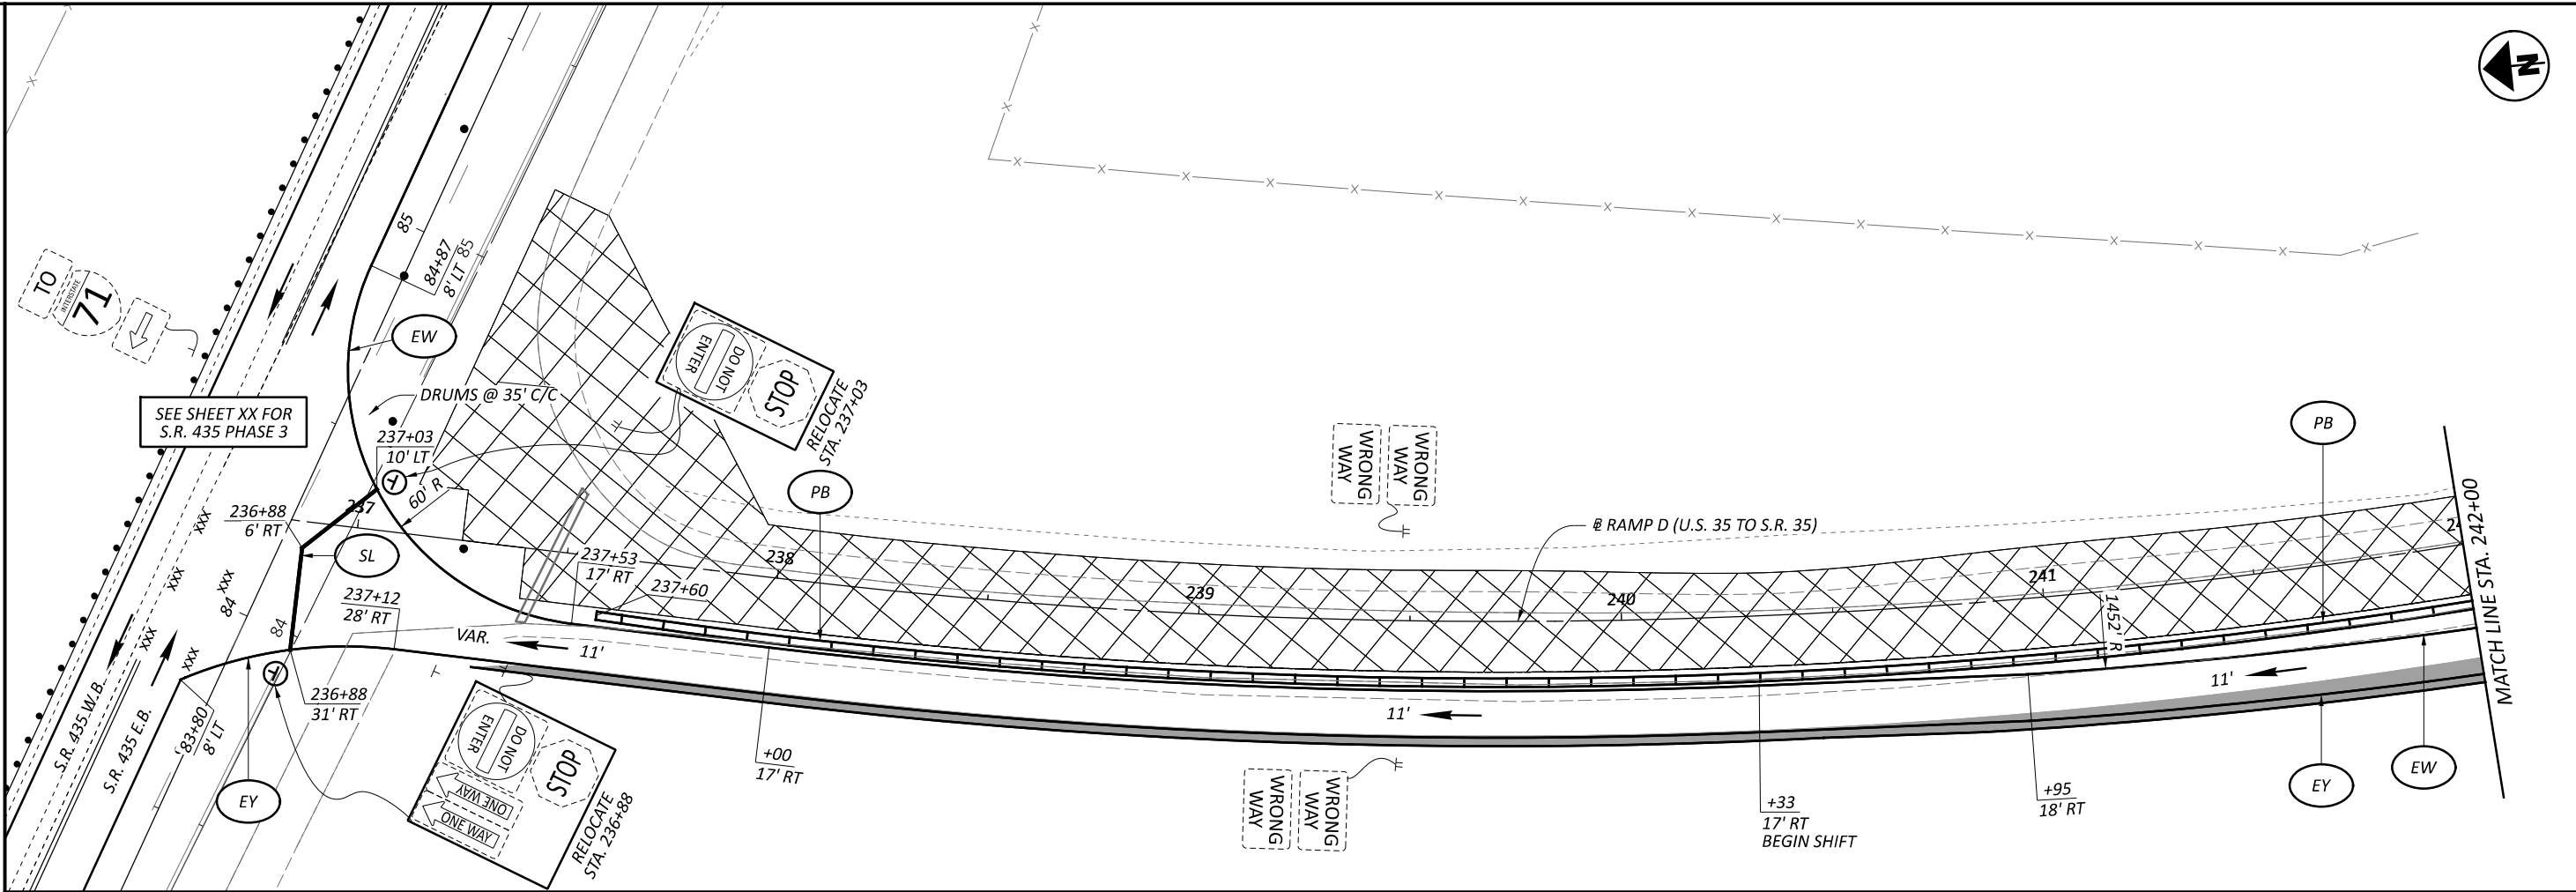


SEE SHEET P.O FOR LEGEND


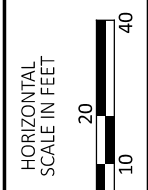


MAINTENANCE OF TRAFFIC (BU5)
 PHASE 3B - RAMP D (U.S. 35 TO S.R. 435) STA. 236+84 TO STA. 247+50

DESIGN AGENCY	
Palmer ENGINEERING	
8350 E. KEMPER RD. SUITE B CINCINNATI, OH 45249 513-469-1600	
DESIGNER	
DPF	
REVIEWER	
DCJ MM-DD-YY	
PROJECT ID	
117955	
SHEET	TOTAL
P. 63	228


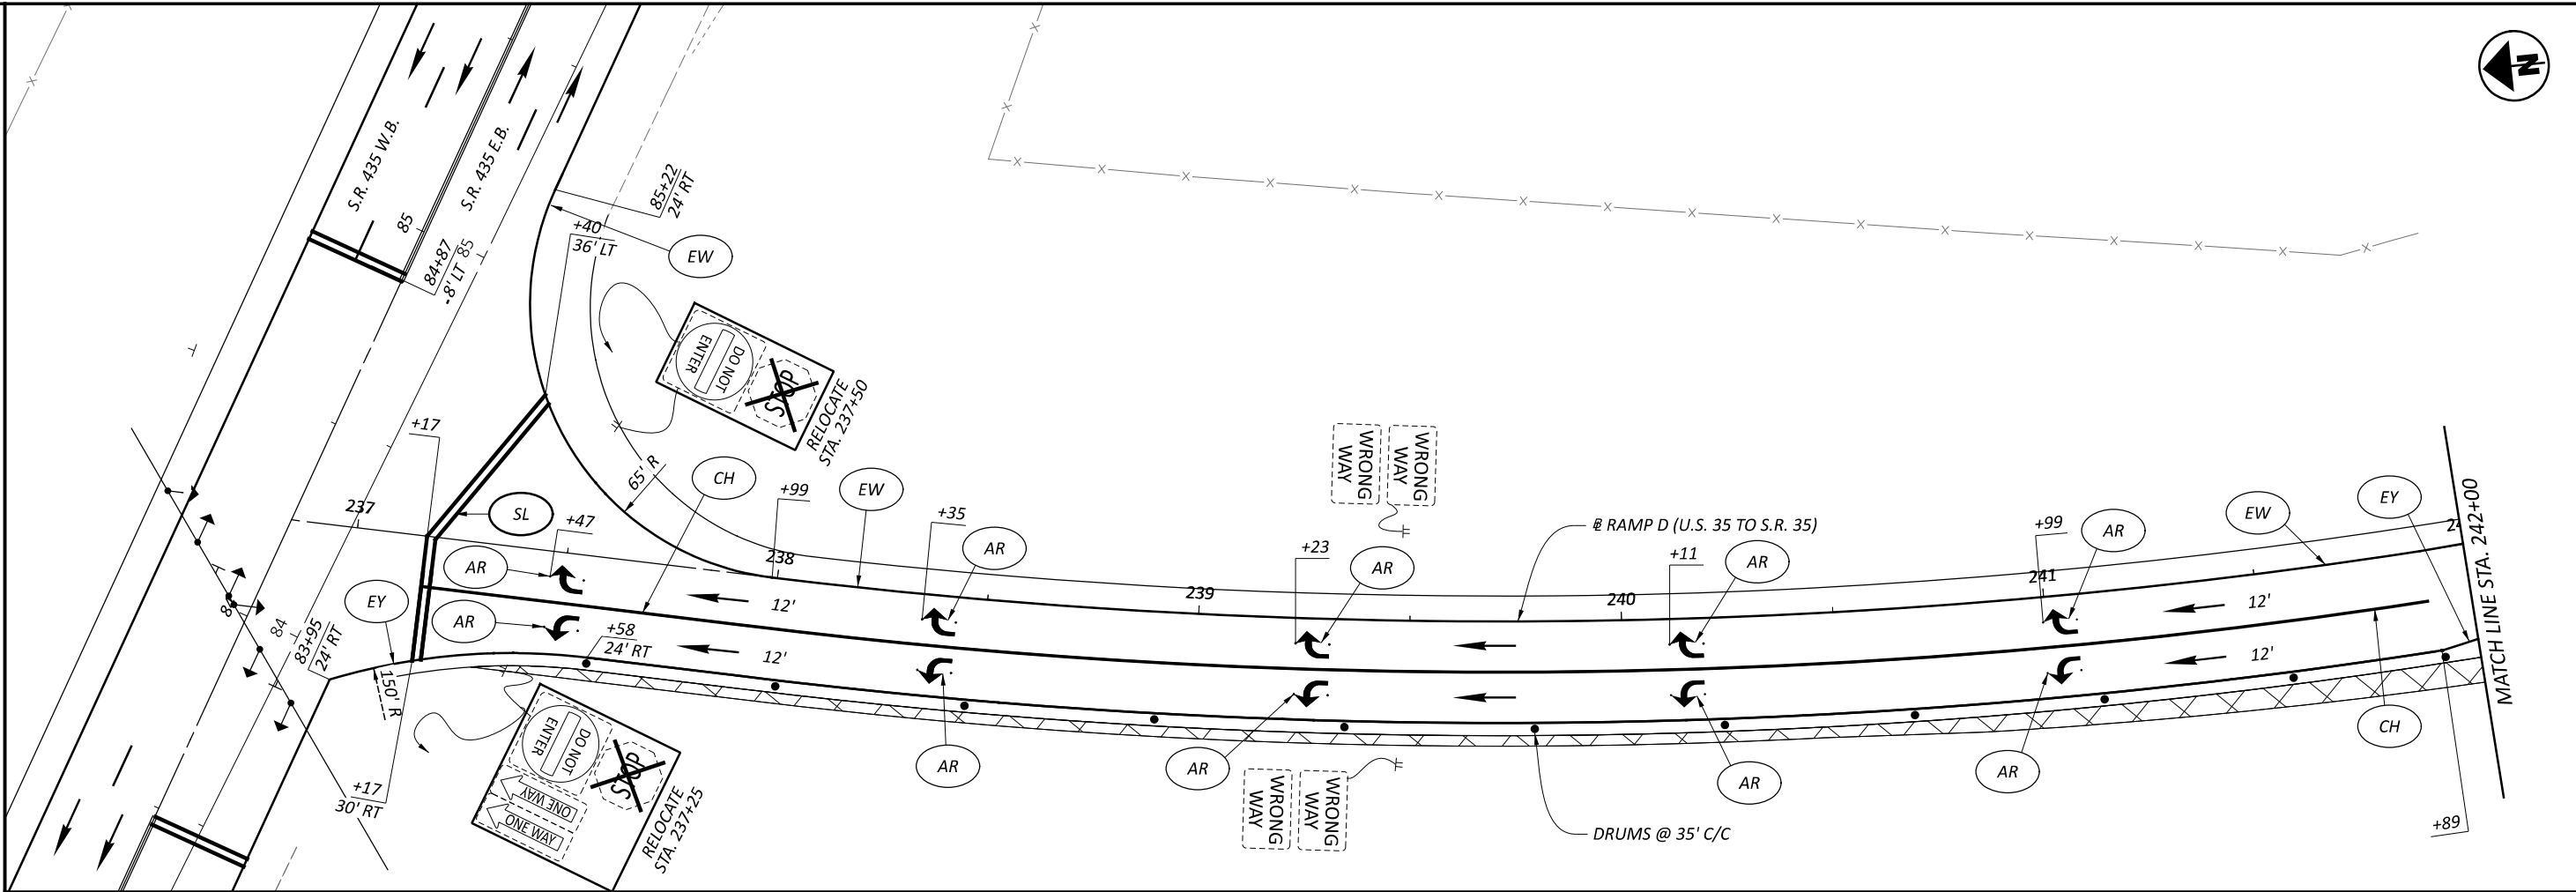


SEE SHEET P.O FOR LEGEND

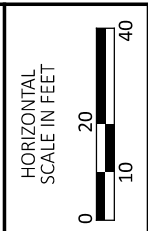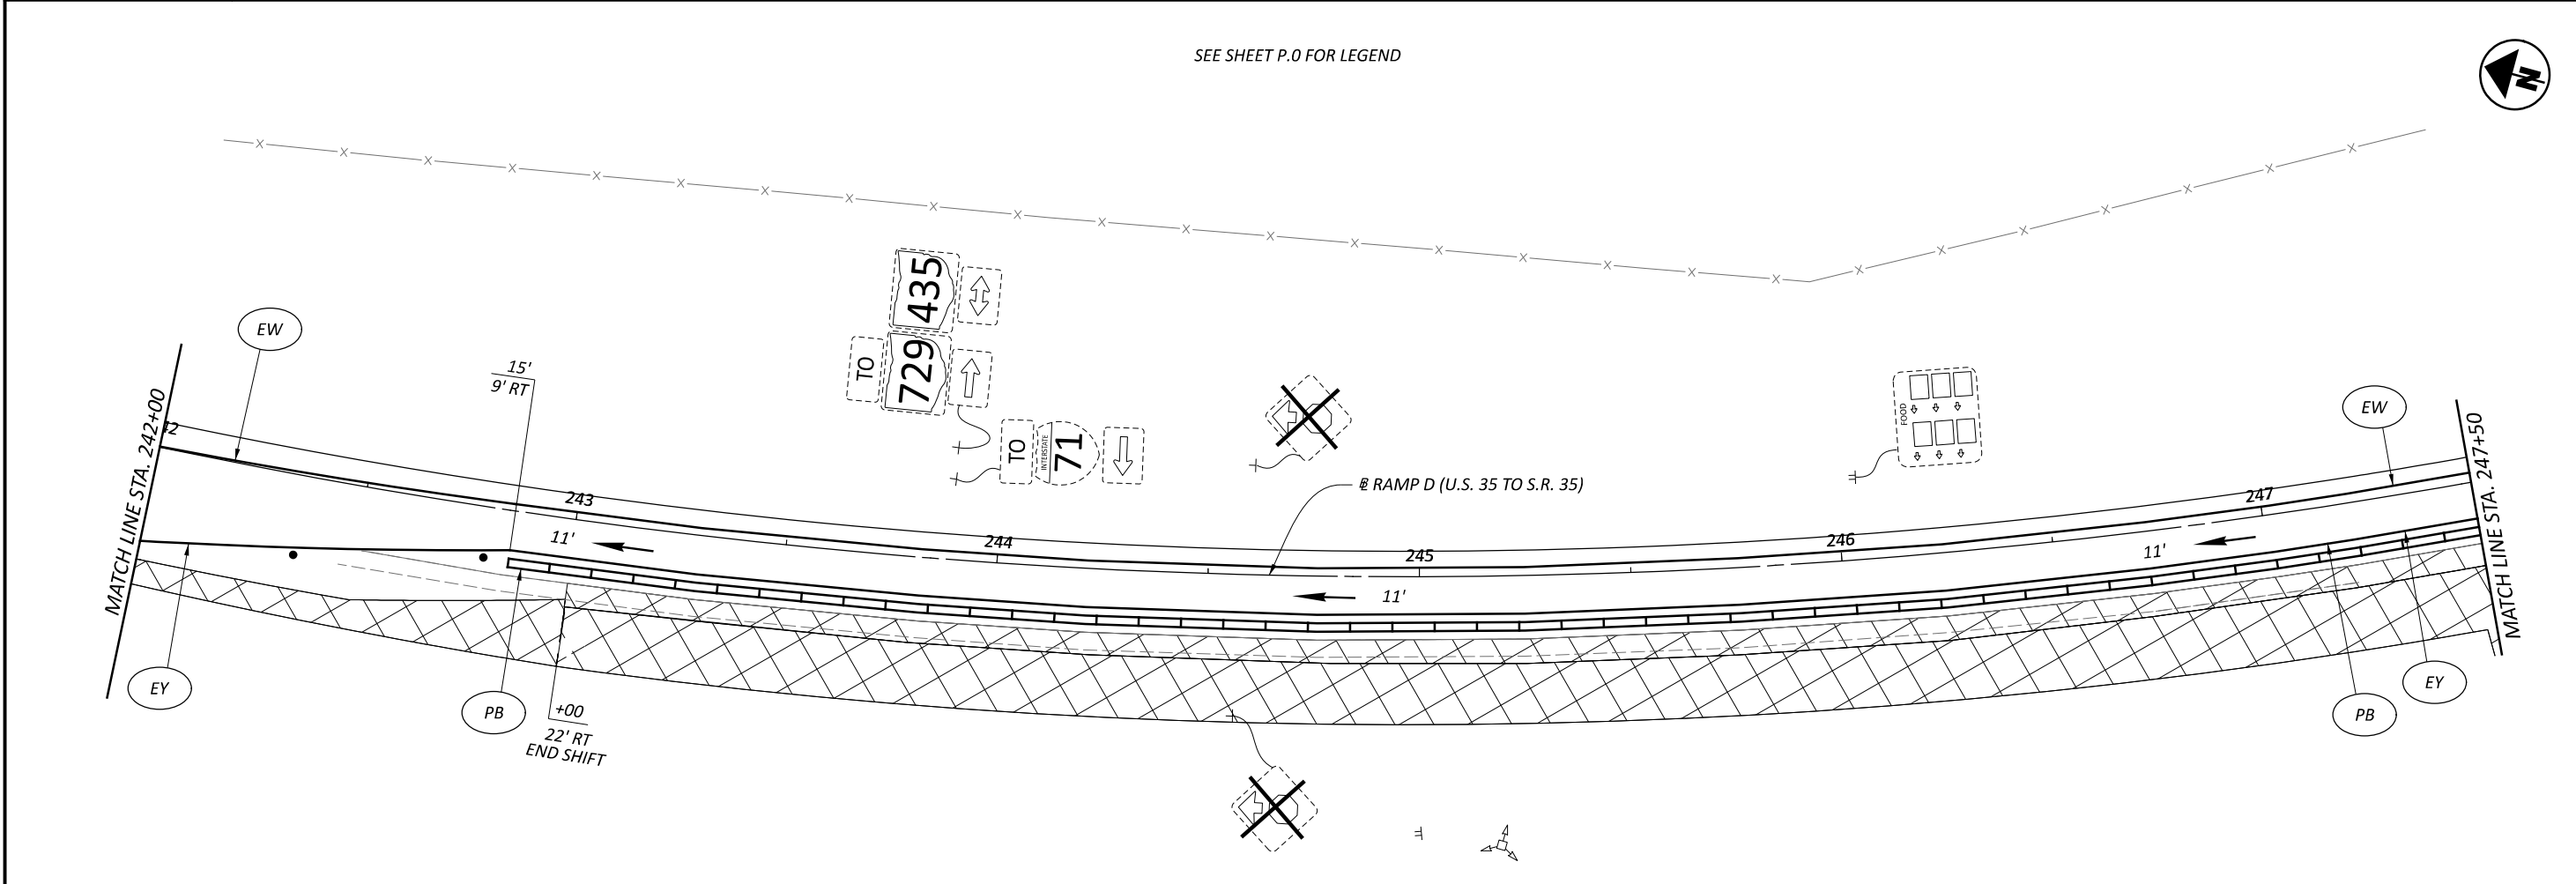


MAINTENANCE OF TRAFFIC (BU5)
 PHASE 3C - RAMP D (U.S. 35 TO S.R. 435) STA. 236+84 TO STA. 247+50

DESIGN AGENCY	
Palmer ENGINEERING 8350 E. KEMPER RD. SUITE B CINCINNATI, OH 45249 513-469-1600	
DESIGNER	DPF
REVIEWER	DCJ MM-DD-YY
PROJECT ID	117955
SHEET	TOTAL
P. 65	228

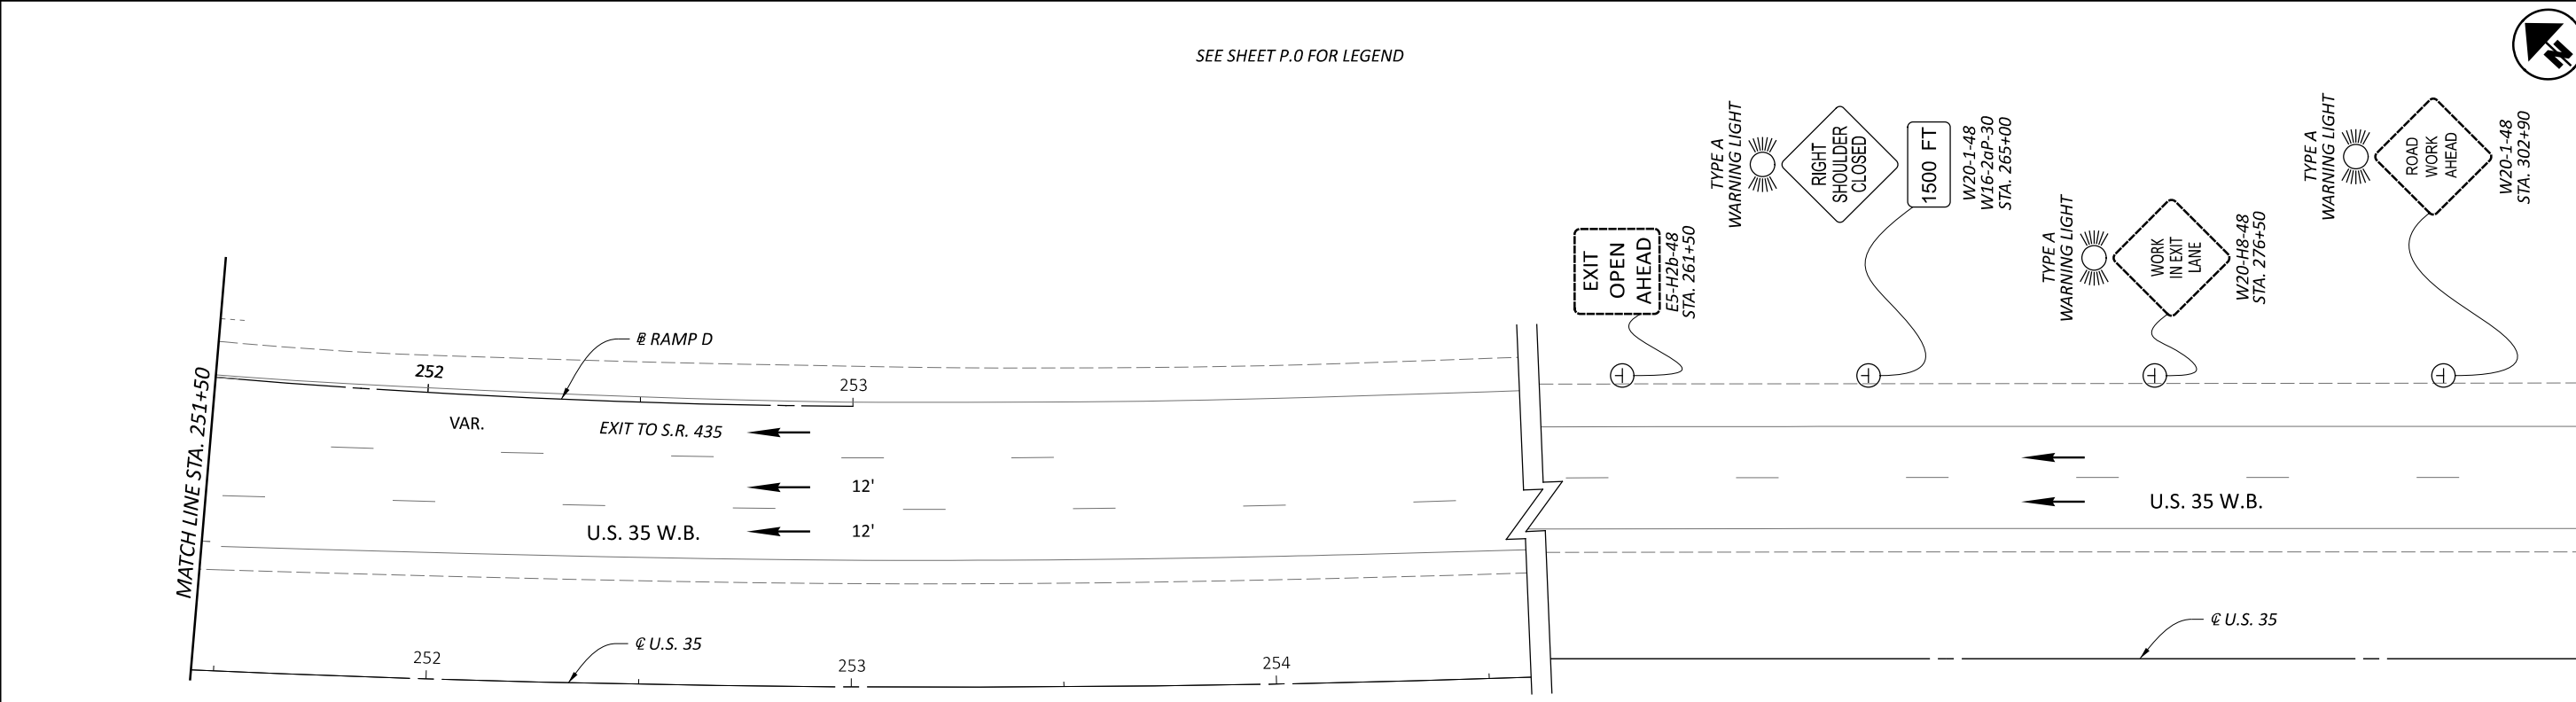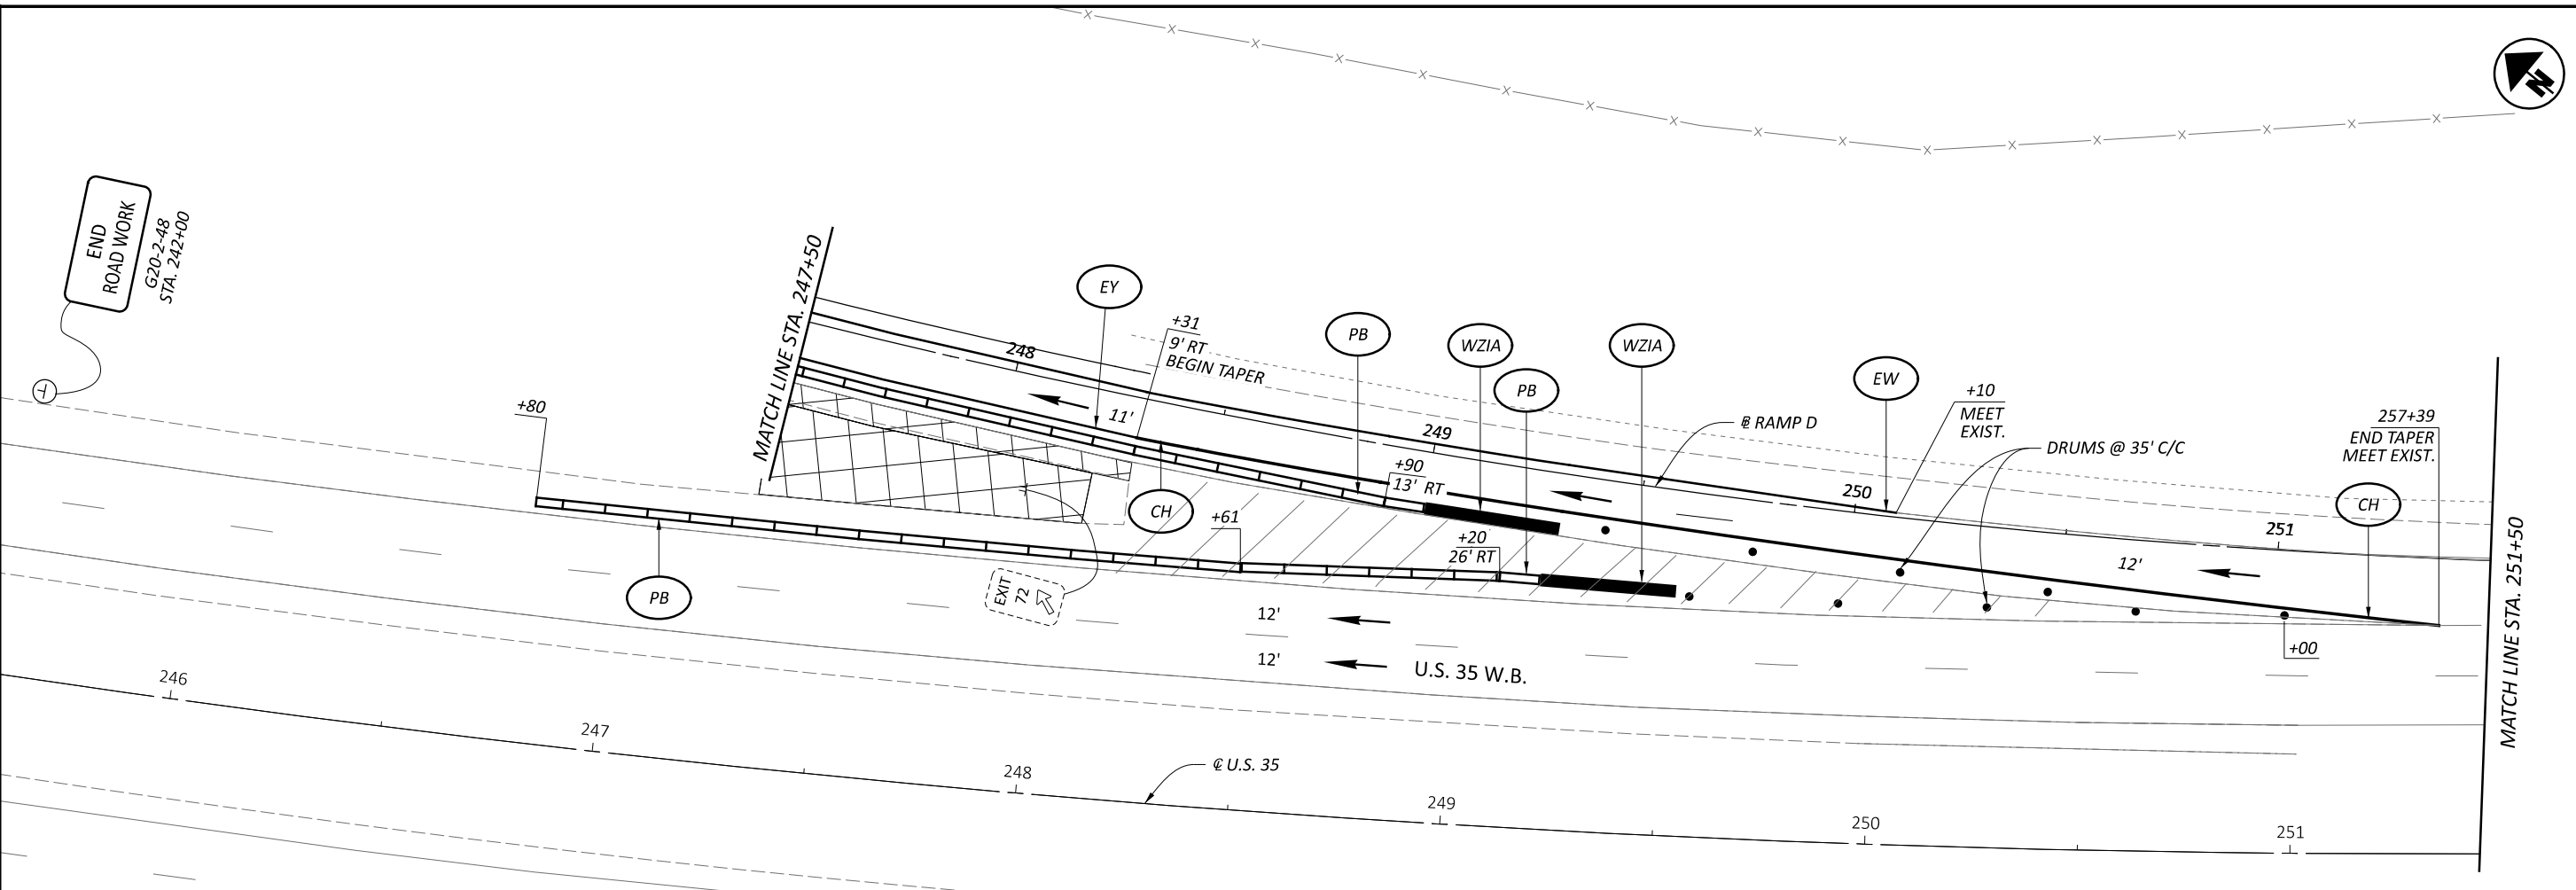


SEE SHEET P.O FOR LEGEND

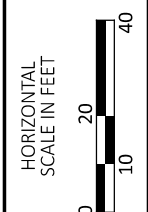

MAINTENANCE OF TRAFFIC (BU5)
PHASE 3C - RAMP D (U.S. 35 TO S.R. 435) STA. 247+50 TO STA. 302+90

DESIGN AGENCY	
Palmer ENGINEERING 8350 E. KEMPER RD. SUITE B CINCINNATI, OH 45249 513-469-1600	
DESIGNER	
DPF	
REVIEWER	
DCJ MM-DD-YY	
PROJECT ID	
117955	
SHEET	TOTAL
P. 66	228

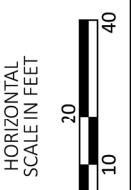

TEMPORARY TRAFFIC SIGNAL PLAN
 SR-435 & US 35 WB RAMP D


DESIGN AGENCY	TEC
DESIGNER	TEC
REVIEWER	MJH
DATE	03/20/24
PROJECT ID	117955
SHEET	TOTAL
P. 67	-

SPAN WIRE PLAN VIEW DETAIL


SIGNAL HEAD REQUIREMENTS

- 17' - 19' CLEARANCE PER TC-85.22
- TETHERED PER TC-85.21

- MOT PHASE 3
- RELOCATE ALL SIGNAL HEADS AND SIGNS AS SHOWN.

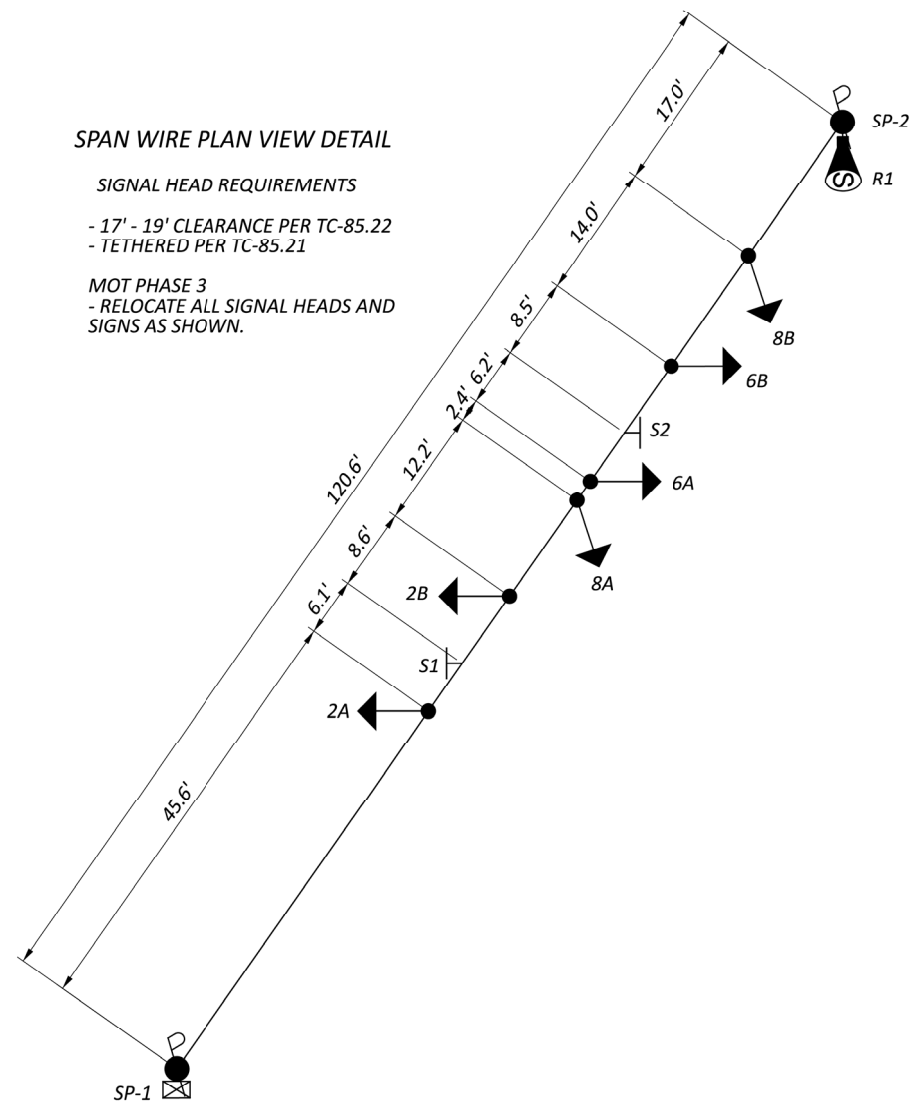

PLAN VIEW

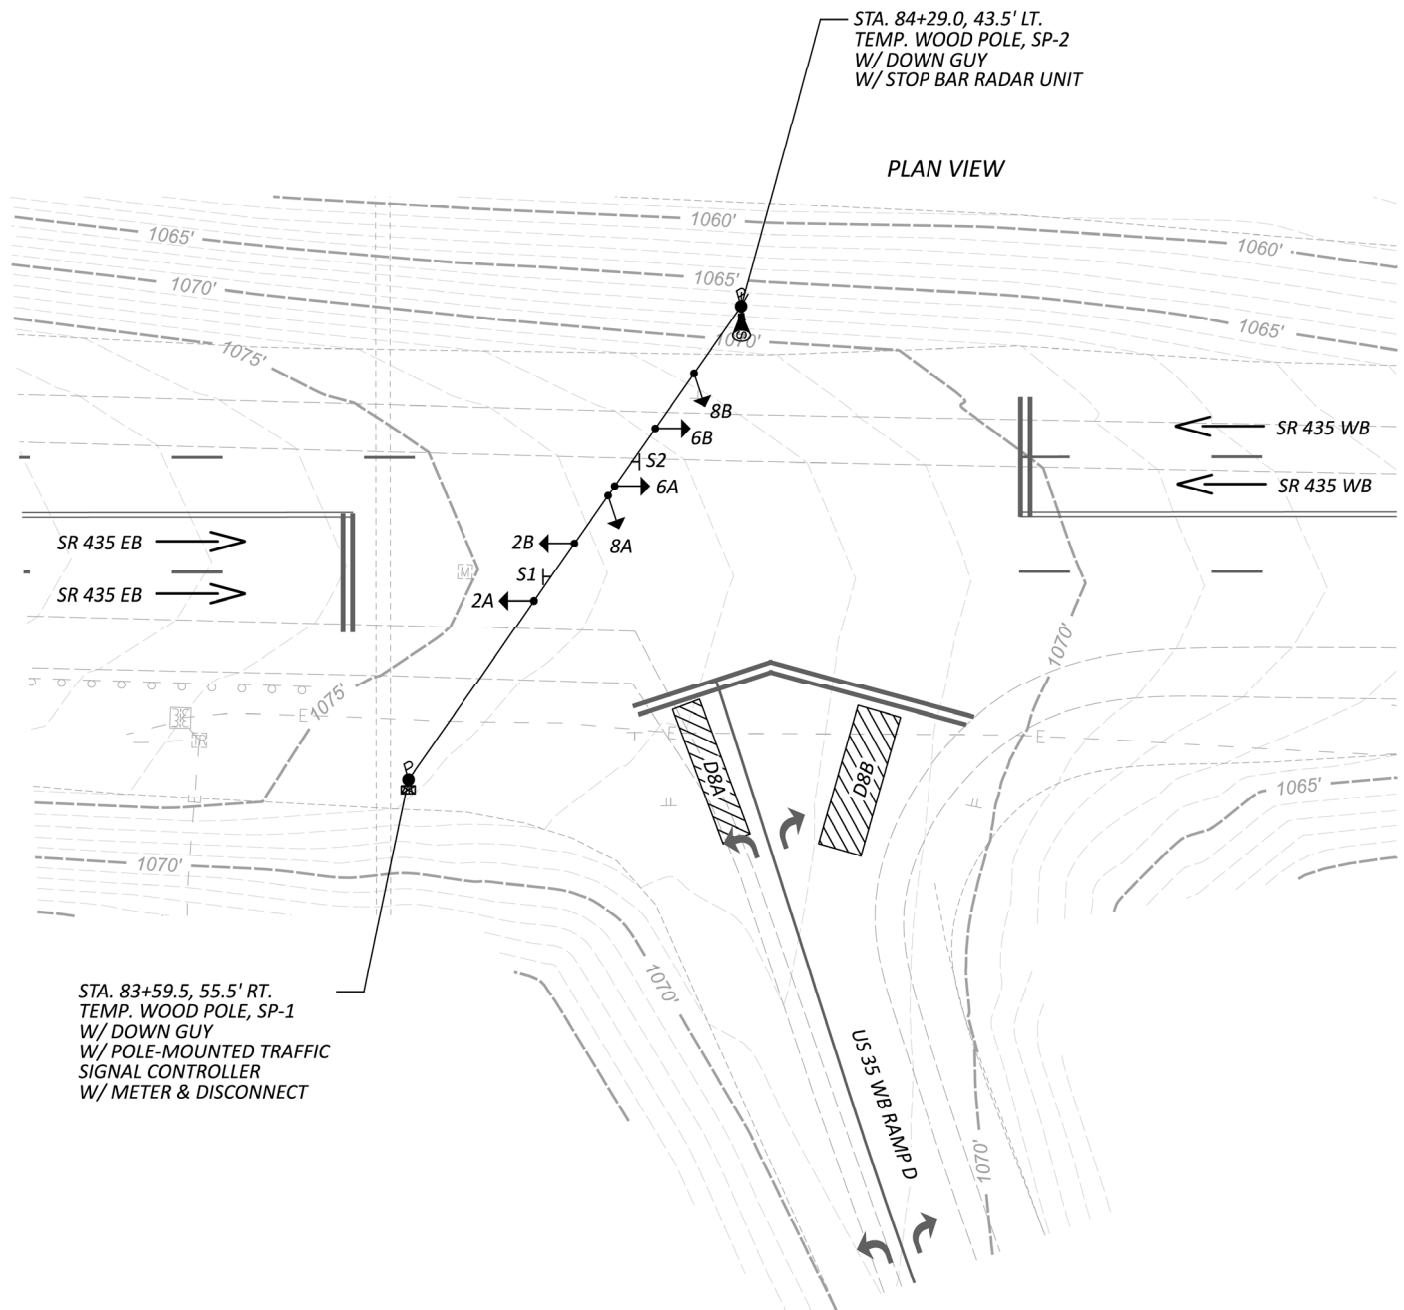


STA. 83+59.5, 55.5' RT.
 TEMP. WOOD POLE, SP-1
 W/ DOWN GUY
 W/ POLE-MOUNTED TRAFFIC
 SIGNAL CONTROLLER
 W/ METER & DISCONNECT

STA. 84+29.0, 43.5' LT.
 TEMP. WOOD POLE, SP-2
 W/ DOWN GUY
 W/ STOP BAR RADAR UNIT

LEGEND

	PROP	EXIST
TRAFFIC SIGNAL, 3 UNIT HEAD, 12"		
WOOD POLE		
SIGN		
CONTROLLER CABINET POLE MOUNTED		
ADVANCE RADAR DETECTION UNIT		
STOP LINE RADAR DETECTION UNIT		
DETECTION ZONE		

PROPOSED SIGNAL HEADS*

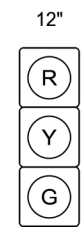

2A, 2B, 6A,
 6B, 8A, 8B

* - VEHICLE SIGNAL HEADS DO NOT INCLUDE BACKPLATES

PROPOSED SIGNS



R3-1-36
 (36" x 36")

S1



R3-2-36
 (36" x 36")

S2


NOTES

1. INSTALL 2 TEMPORARY WOOD POLES WITH DOWN GUY AT THE LOCATIONS SHOWN.
2. INSTALL MESSENGER WIRE AND TETHER WIRE AS SHOWN.
3. INSTALL 6 VEHICULAR SIGNAL HEADS AND 5/C SIGNAL CABLE FOR EACH APPROACH.
4. INSTALL 1 STOP BAR RADAR UNIT AS SHOWN.
5. INSTALL A TEMPORARY POLE MOUNTED SIGNAL CABINET AND RISER ON POLE, SP-1. INCLUDE ALL REQUIRED EQUIPMENT TO OPERATE THE TRAFFIC SIGNAL AS SHOWN IN THE PLANS.
6. CONTACT AES OHIO TO PROVIDE TEMPORARY 120V ELECTRIC POWER. ROUTE AERIAL SERVICE TO TEMPORARY METER AND DISCONNECT MOUNTED ON WOOD POLE, SP-1.
6. PLACE IN NORMAL OPERATION PER SCD MT-120.00.

SIGNAL TIMING CHART

INTERSECTION: SR 435 & US 35 WB RAMP D								
MAINTAINING AGENCY: ODOT								
START UP	DUAL ENTRY: ON		PHASES: 2 & 6					
	REST IN RED:		RING 1	-	RING 2	-		
	OVERLAP		-	-	-	-		
START IN:	ALL RED FLASH							
TIME FOR FLASH, ALL RED:	5 SEC							
FIRST PHASE(S):	2 & 6							
COLOR DISPLAYED:	GREEN							
INTERVAL OR FEATURE	CONTROLLER MOVEMENT NO.							
INTERSECTION MOVEMENT (PHASE)	1	2	3	4	5	6	7	8
DIRECTION	-	EB	-	-	-	WB	-	NB
MINIMUM GREEN (INITIAL) (SEC.)	-	23	-	-	-	20	-	10
ADDED INITIAL *(SEC./ACTUATION)	-	-	-	-	-	-	-	-
MAXIMUM INITIAL *(SEC.)	-	-	-	-	-	-	-	-
PASSAGE TIME (PRESET GAP) (SEC.)	-	-	-	-	-	-	-	-
TIME BEFORE REDUCTION *(SEC.)	-	-	-	-	-	-	-	-
MINIMUM GAP *(SEC.)	-	2	-	-	-	2	-	4
TIME TO REDUCE *(SEC.)	-	-	-	-	-	-	-	-
MAXIMUM GREEN I (SEC.)	-	60	-	-	-	60	-	40
MAXIMUM GREEN II (SEC.)	-	60	-	-	-	60	-	40
YELLOW CHANGE (SEC.)	-	5.6	-	-	-	5.6	-	4.8
ALL RED CLEARANCE (SEC.)	-	1.0	-	-	-	1.0	-	1.0
WALK (SEC.)	-	-	-	-	-	-	-	-
PEDESTRIAN CLEARANCE (SEC.)	-	-	-	-	-	-	-	-
RECALL	MAXIMUM (ON/OFF)	-	OFF	-	-	OFF	-	OFF
	MINIMUM (ON/OFF)	-	ON	-	-	ON	-	OFF
	PEDESTRIAN (ON/OFF)	-	OFF	-	-	OFF	-	OFF
MEMORY (ON/OFF)	-	-	-	-	-	-	-	-


SIGNAL PHASING DIAGRAM

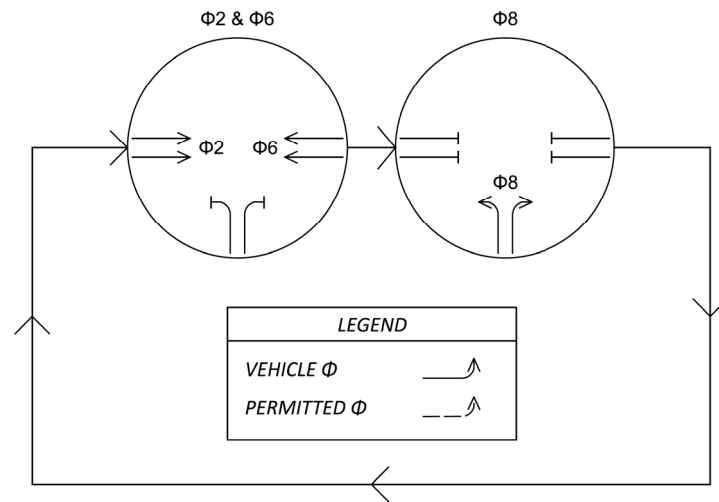

FIELD WIRING HOOK-UP CHART

SIGNAL HEAD	INDICATION	FIELD TERMINAL	FLASH
2A, 2B (EB)	R	Φ 2R	R
	Y	Φ 2Y	
	G	Φ 2G	
6A, 6B (WB)	R	Φ 6R	R
	Y	Φ 6Y	
	G	Φ 6G	
8A, 8B (NB)	R	Φ 8R	R
	Y	Φ 8Y	
	G	Φ 8G	

WIRING DIAGRAM

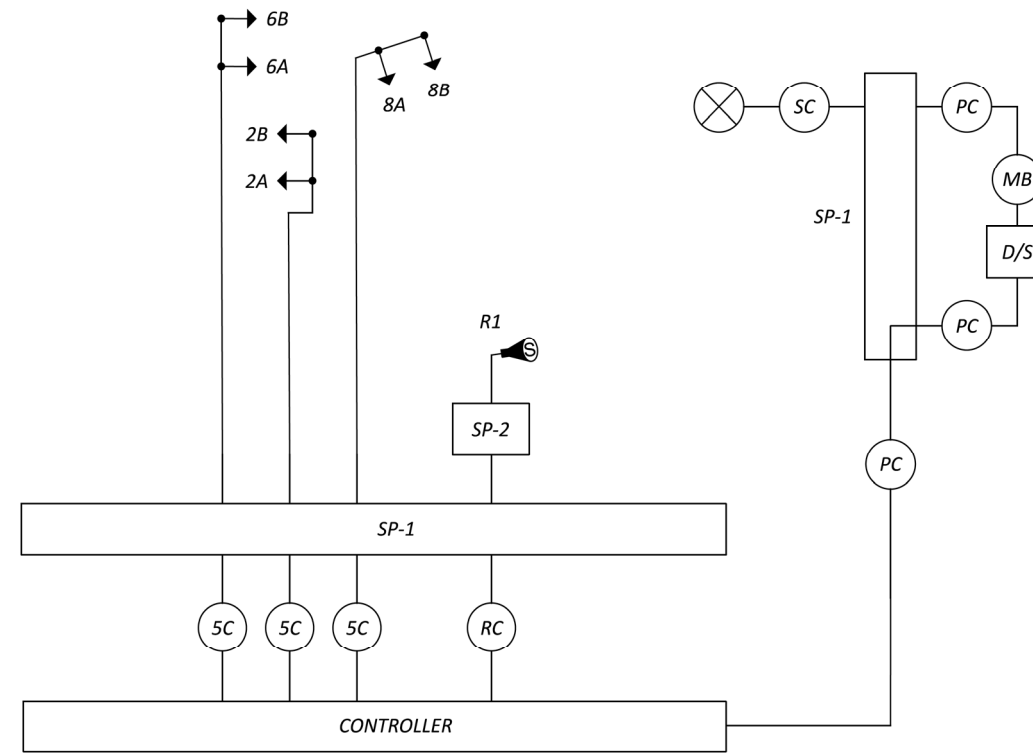


WIRING DIAGRAM LEGEND



	3-SECTION VEHICULAR SIGNAL HEAD, 1-WAY		SIGNAL CABLE, # CONDUCTOR, NO. 14 AWG
	3-SECTION VEHICULAR SIGNAL HEAD, 1-WAY, ARROWS		RADAR DETECTION CABLE
	STOP LINE RADAR DETECTOR UNIT		POWER SOURCE
	ADVANCE RADAR DETECTOR UNIT		POWER CABLE, (3) 1C-NO. 6 AWG SERVICE CABLE, 3C-NO. 6 AWG
	SIGNAL SUPPORT POLE, NO. __		METER BASE
	SIGNAL DISCONNECT SWITCH		

DETECTOR TABLE

DETECTION ZONE	MOVEMENT	PULSE OR PRESENCE	ASSOCIATED PHASE	LOCK/ NON-LOCK	EXTEND (SEC)	DELAY IN CONTROLLER (SEC)	DELAY INHIBIT PHASE	PURPOSE	DETECTION ZONE LENGTH (FT)
D8A	NB LT	PRESENCE	8	NON-LOCK	0	0	8	CALL/EXTEND PHASE 8	30
D8B	NB RT	PRESENCE	8	NON-LOCK	0	10	8	CALL/EXTEND PHASE 8	30

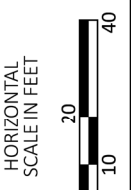


TEMPORARY TRAFFIC SIGNAL PLAN
 MOT PHASE 1 - SR-435 & BLUEGRASS BLVD.

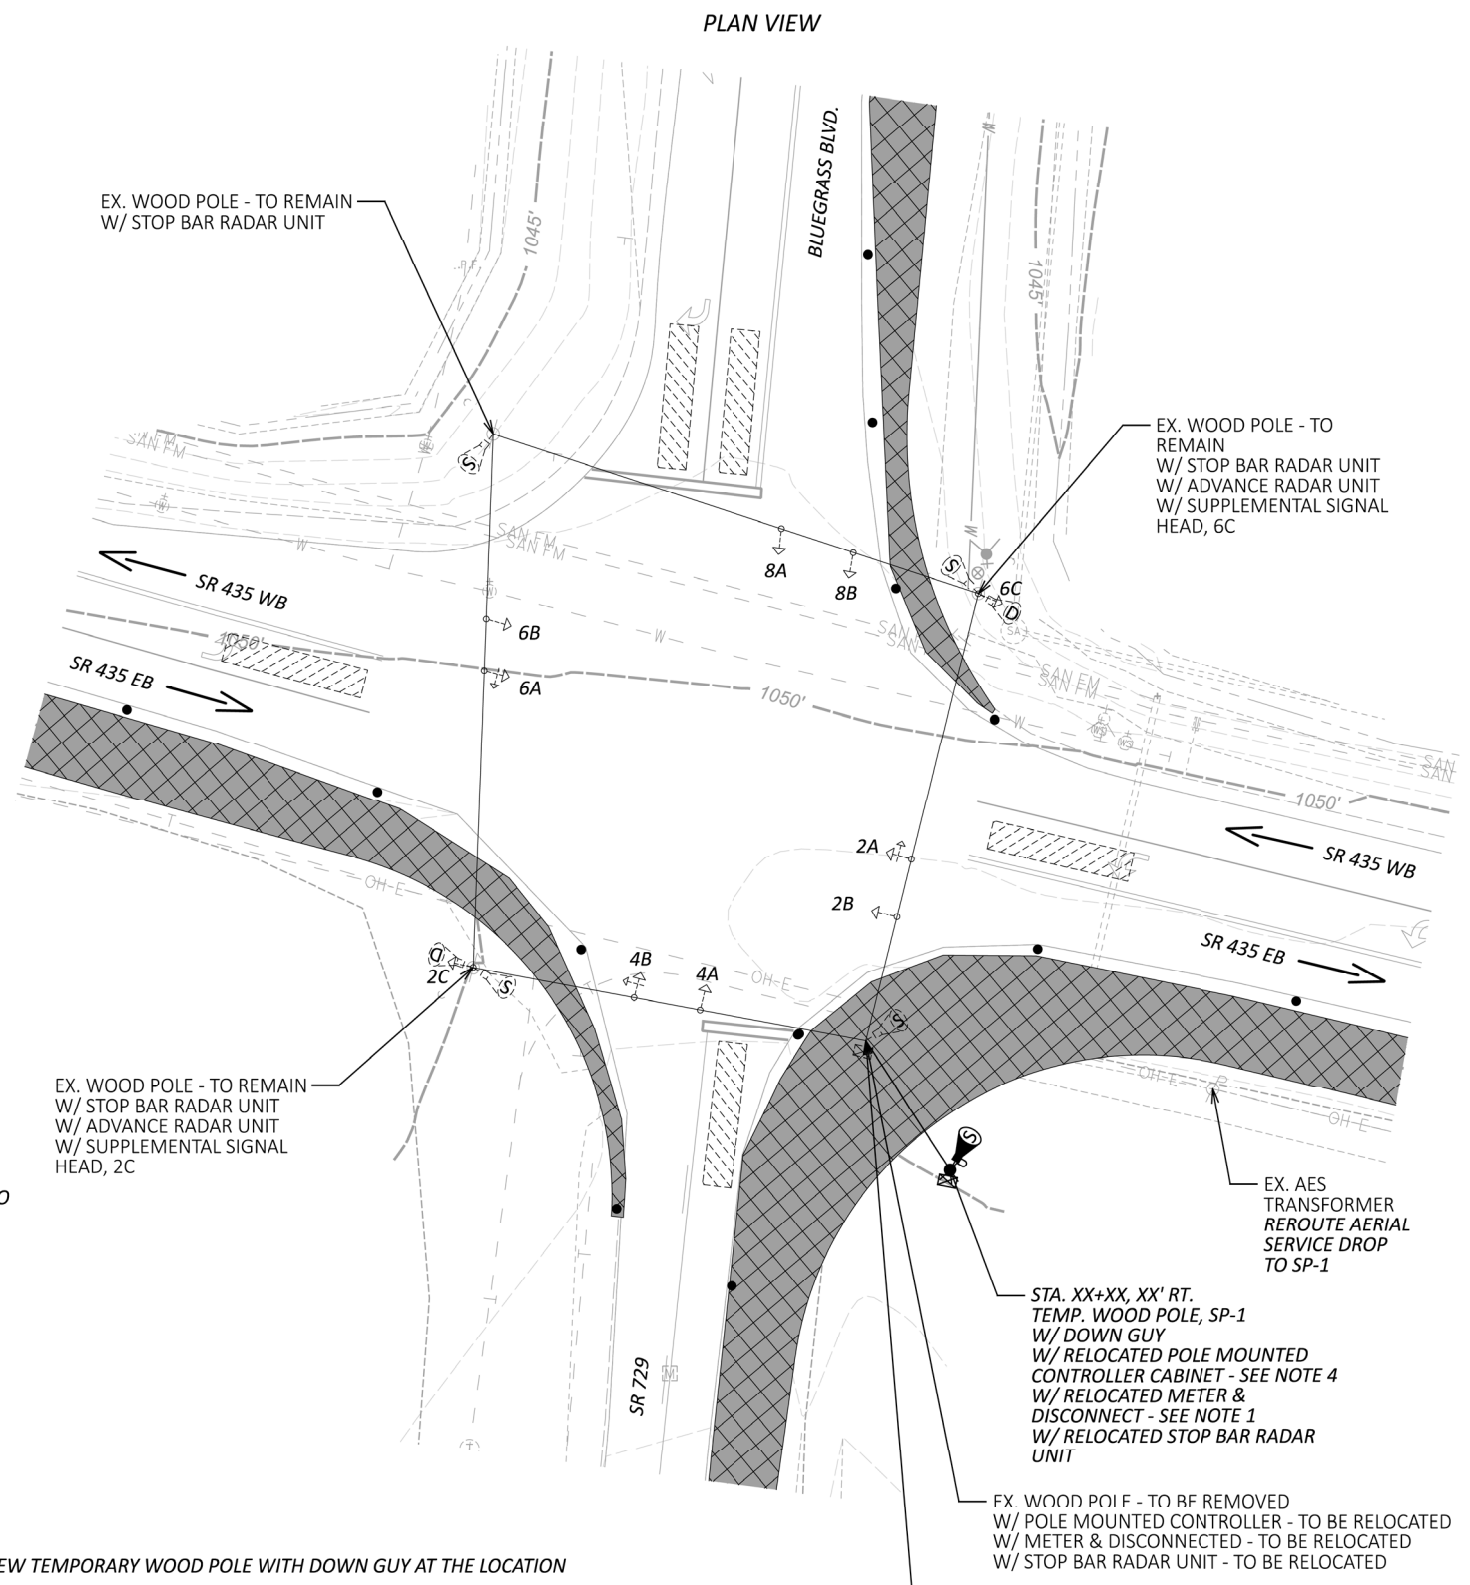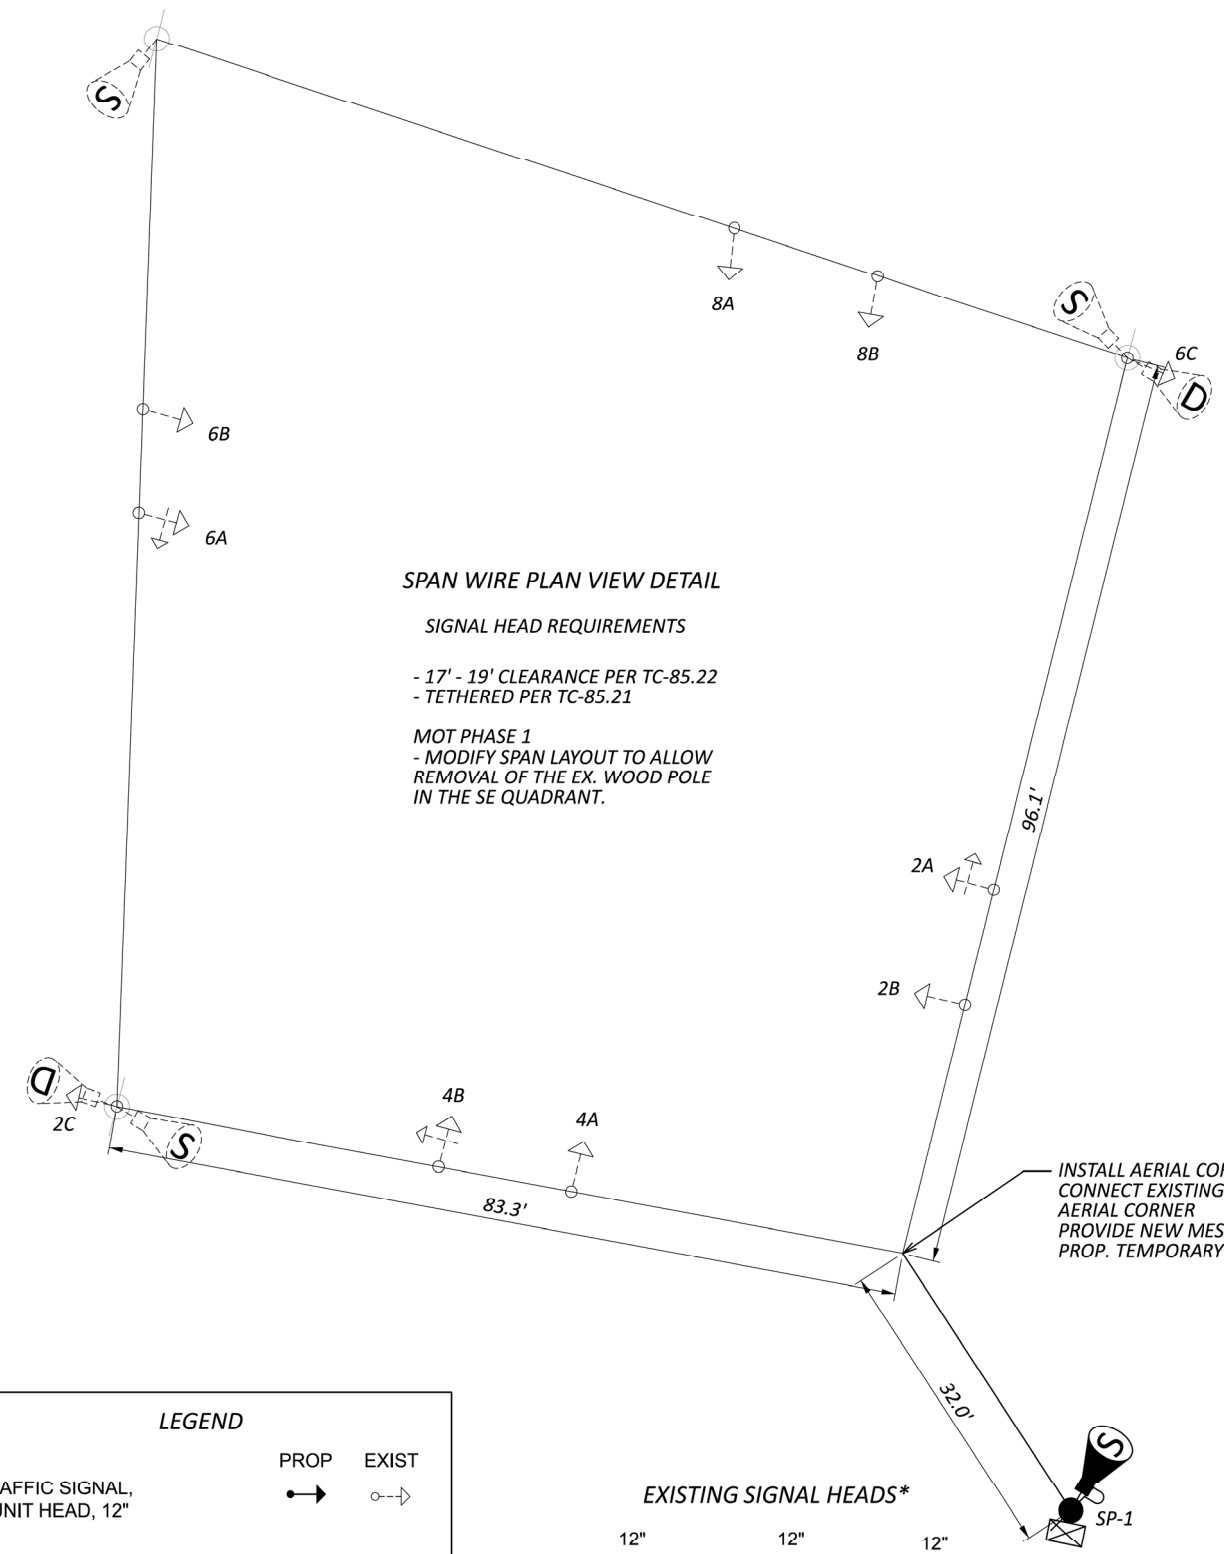

LEGEND

	PROP	EXIST
TRAFFIC SIGNAL, 3 UNIT HEAD, 12"		
WOOD POLE		
SIGN		
CONTROLLER CABINET POLE MOUNTED		
ADVANCE RADAR DETECTION UNIT		
STOP LINE RADAR DETECTION UNIT		
DETECTION ZONE		

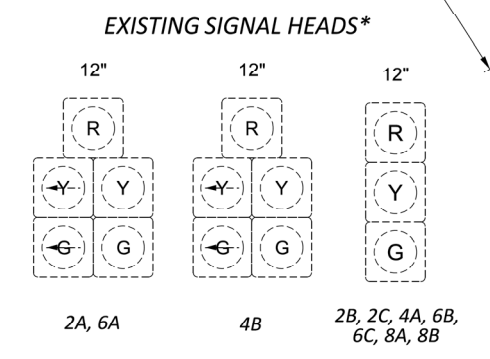

* - VEHICLE SIGNAL HEADS DO NOT INCLUDE BACKPLATES


NOTES

1. INSTALL NEW TEMPORARY WOOD POLE WITH DOWN GUY AT THE LOCATION SHOWN.
2. INSTALL NEW MESSENGER WIRE, TETHER WIRE, AND AERIAL BULL RING AS SHOWN TO MAINTAIN THE EXISTING SPAN LAYOUT.
3. RELOCATE EXISTING POLE MOUNTED CONTROLLER CABINET TO SP-1. REUSE, EXTEND, OR REPLACE EXISTING 7/C SIGNAL CABLE AND RADAR CABLE AS NEEDED TO MAINTAIN EX. OPERATION.
4. REROUTE EXISTING AERIAL SERVICE FEED TO THE RELOCATED METER AND DISCONNECT ON SP-1.
5. EXISTING CONTROLLER SETTINGS INCLUDING TIMING, PHASING, AND DETECTOR SETTINGS SHALL REMAIN UNCHANGED.

DESIGN AGENCY



DESIGNER	TEC
REVIEWER	MJH
DATE	03/20/24
PROJECT ID	117955
SHEET	P. 69
TOTAL	-

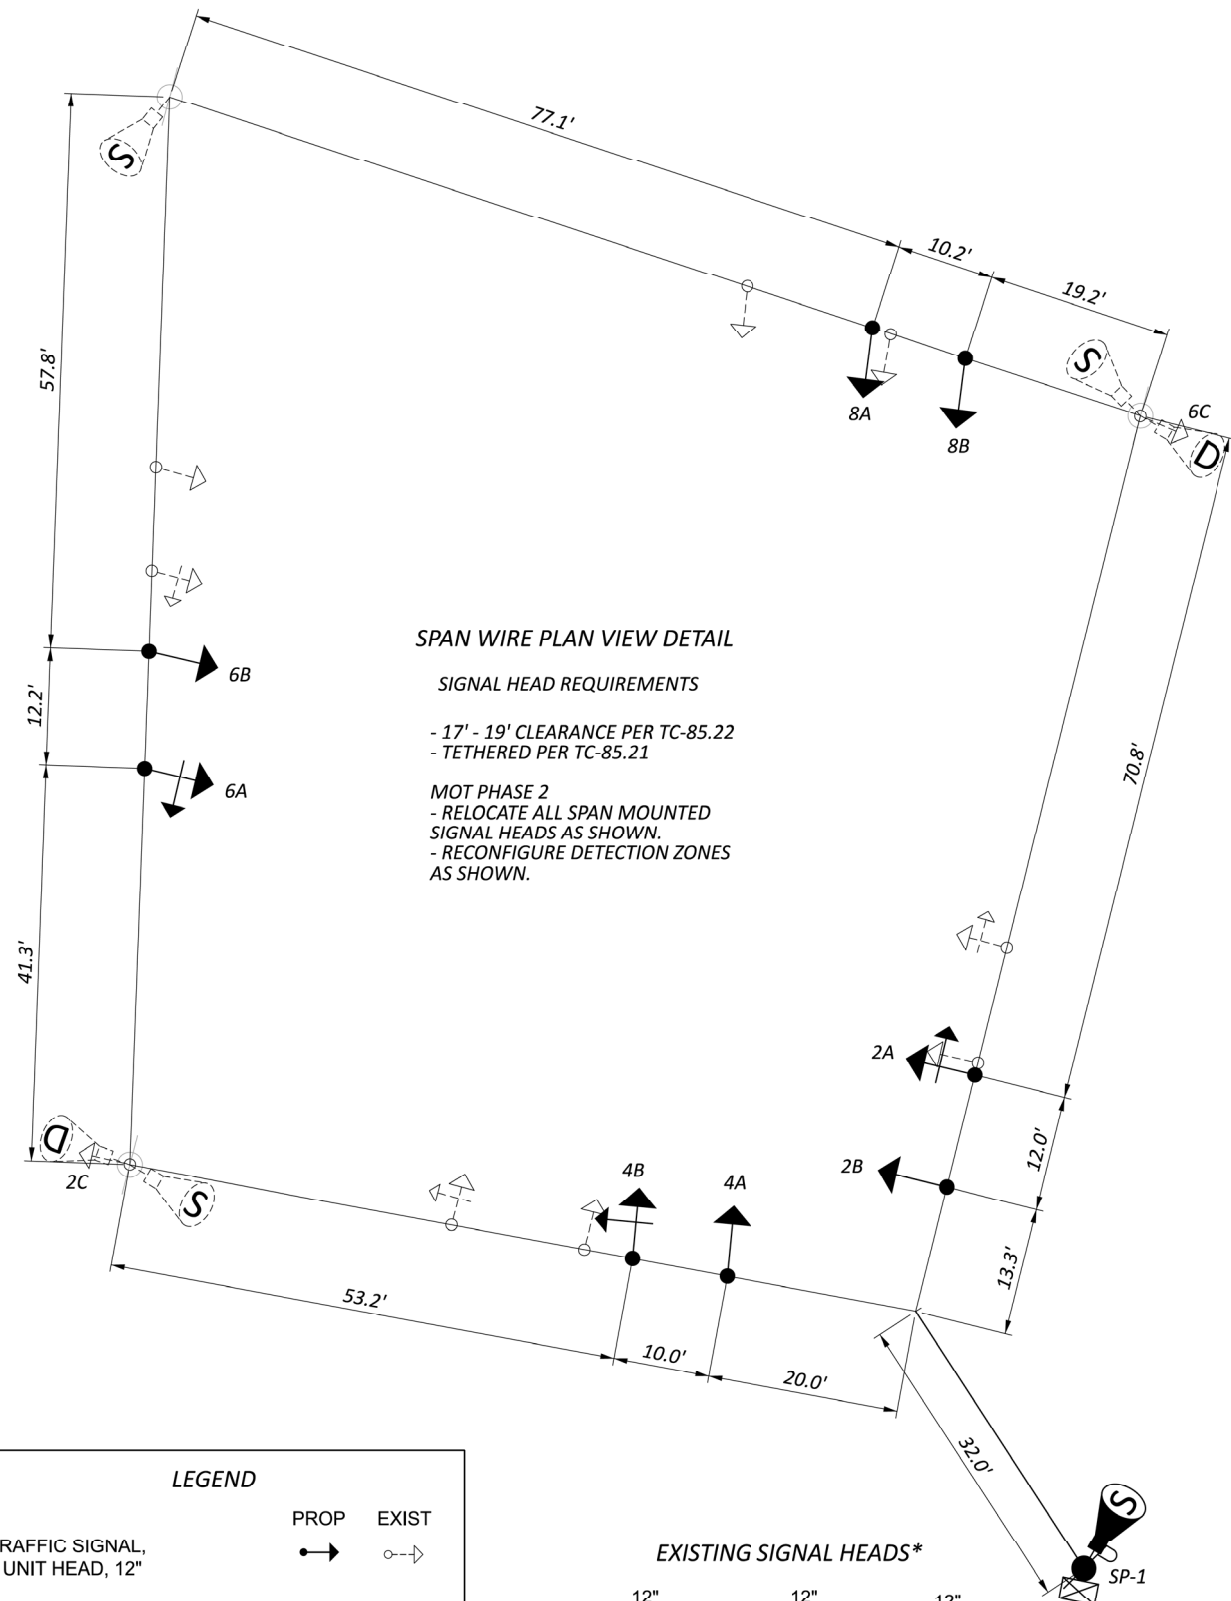

SPAN WIRE PLAN VIEW DETAIL


SIGNAL HEAD REQUIREMENTS
 - 17' - 19' CLEARANCE PER TC-85.22
 - TETHERED PER TC-85.21

MOT PHASE 2
 - RELOCATE ALL SPAN MOUNTED SIGNAL HEADS AS SHOWN.
 - RECONFIGURE DETECTION ZONES AS SHOWN.

LEGEND

	PROP	EXIST
TRAFFIC SIGNAL, 3 UNIT HEAD, 12"		
WOOD POLE		
SIGN		
CONTROLLER CABINET POLE MOUNTED		
ADVANCE RADAR DETECTION UNIT		
STOP LINE RADAR DETECTION UNIT		
DETECTION ZONE		

EXISTING SIGNAL HEADS*


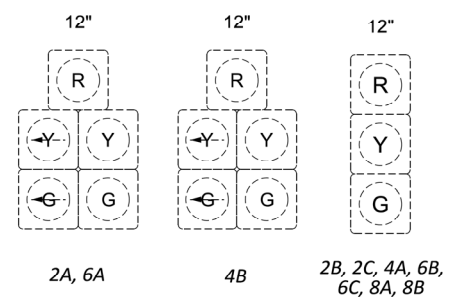


* - VEHICLE SIGNAL HEADS DO NOT INCLUDE BACKPLATES

NOTES

1. ADJUST VEHICULAR SIGNAL HEAD LOCATIONS AND DETECTION ZONES AS NEEDED BASED ON THE MOT PHASE AND LANE RESTRICTIONS PROPOSED.
2. SLACK SIGNAL CABLE SHALL BE COILED AND MOUNTED SECURELY TO THE MESSENGER WIRE NEAR WOOD POLE SP-1 WHEN NOT NEEDED.
3. EXISTING CONTROLLER SETTINGS INCLUDING TIMING, PHASING, AND DETECTOR SETTINGS SHALL REMAIN UNCHANGED.

PLAN VIEW

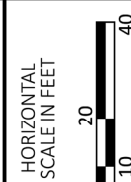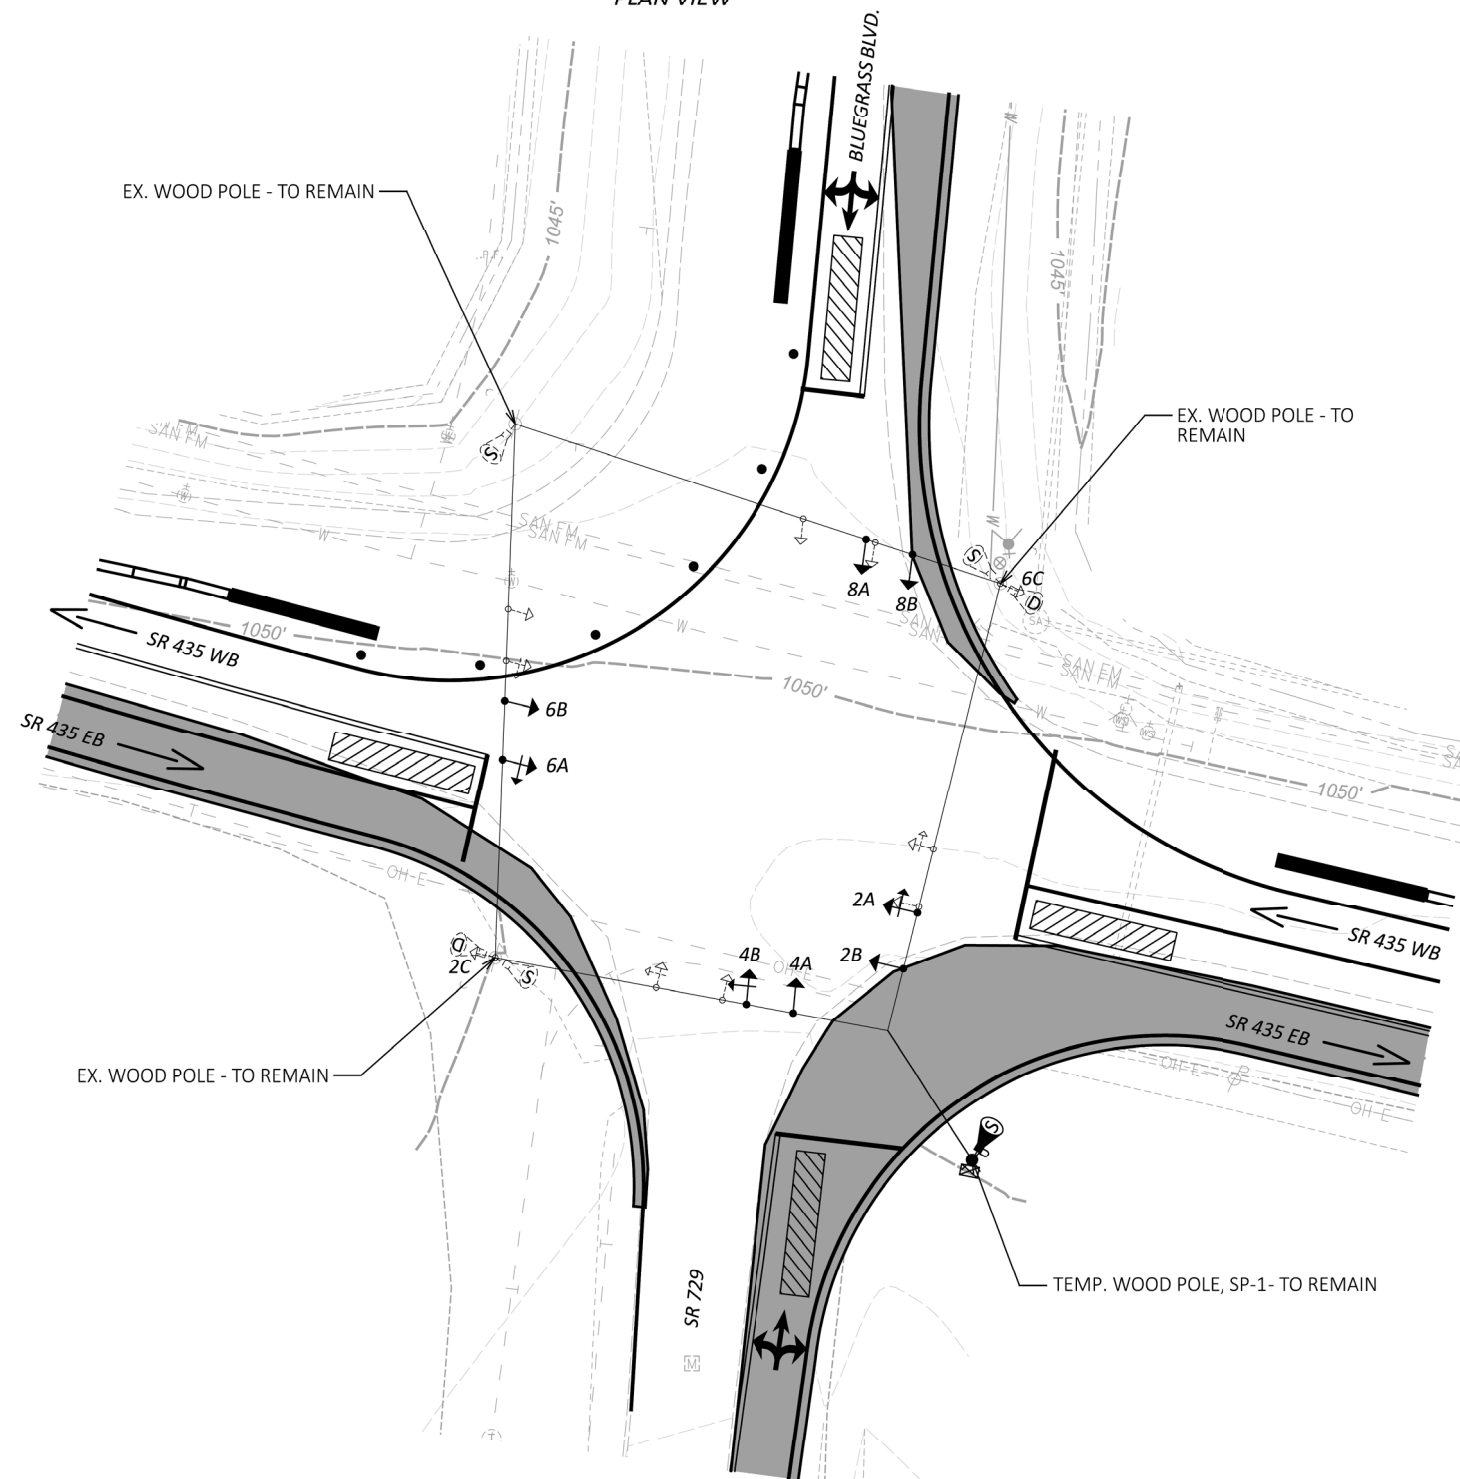

**TEMPORARY TRAFFIC SIGNAL PLAN
 MOT PHASE 2 - SR-435 & BLUEGRASS BLVD.**

DESIGN AGENCY



DESIGNER

TEC

REVIEWER

MJH 03/20/24

PROJECT ID


117955

SHEET



P.70

TOTAL

-

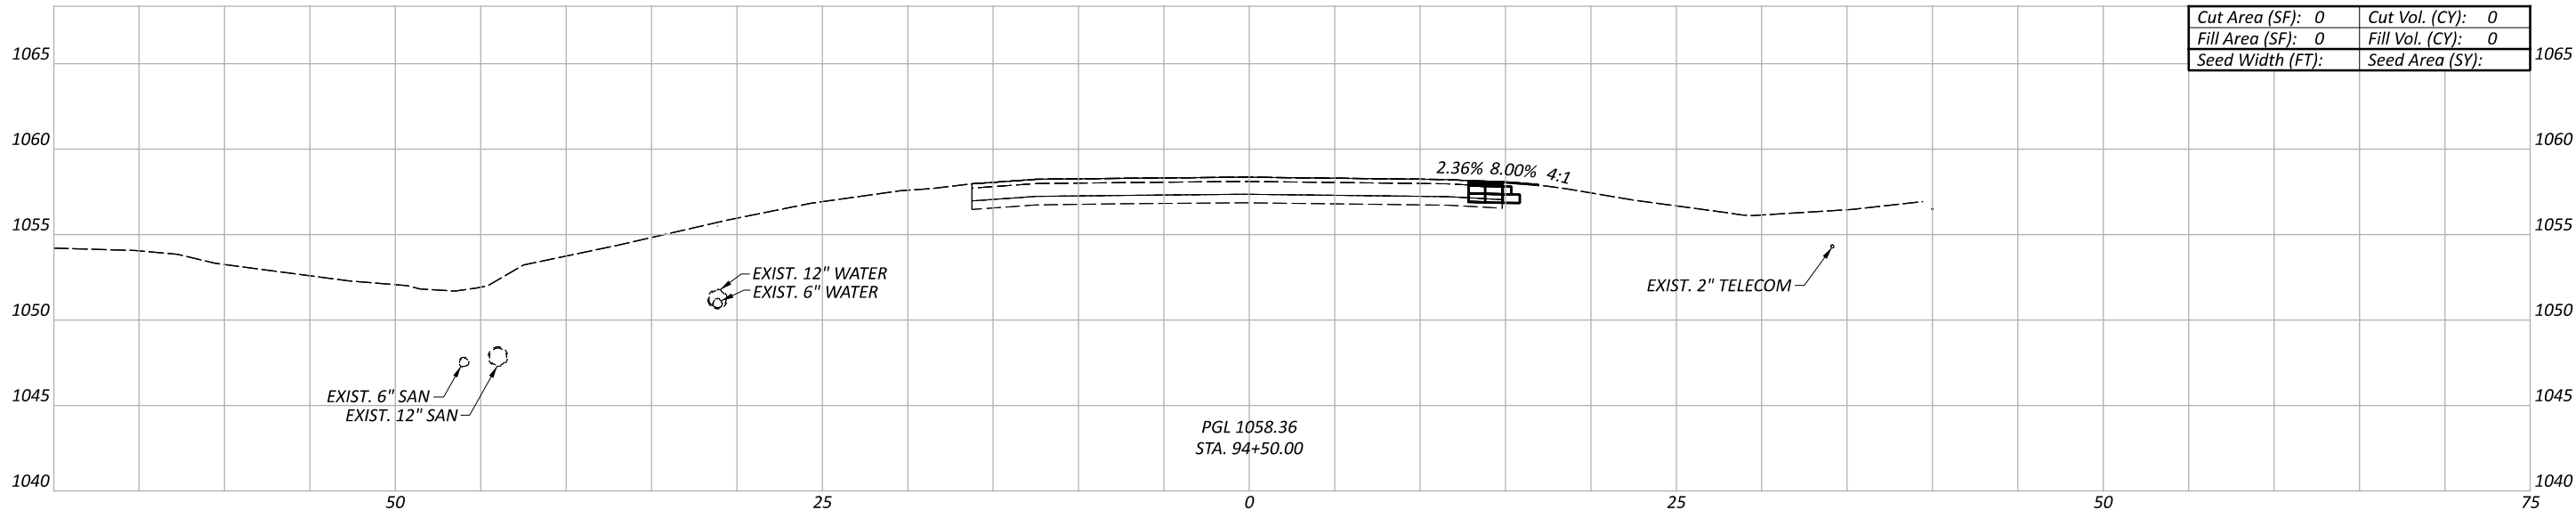

Cut Area (SF):	0	Cut Vol. (CY):	0
Fill Area (SF):	0	Fill Vol. (CY):	0
Seed Width (FT):		Seed Area (SY):	

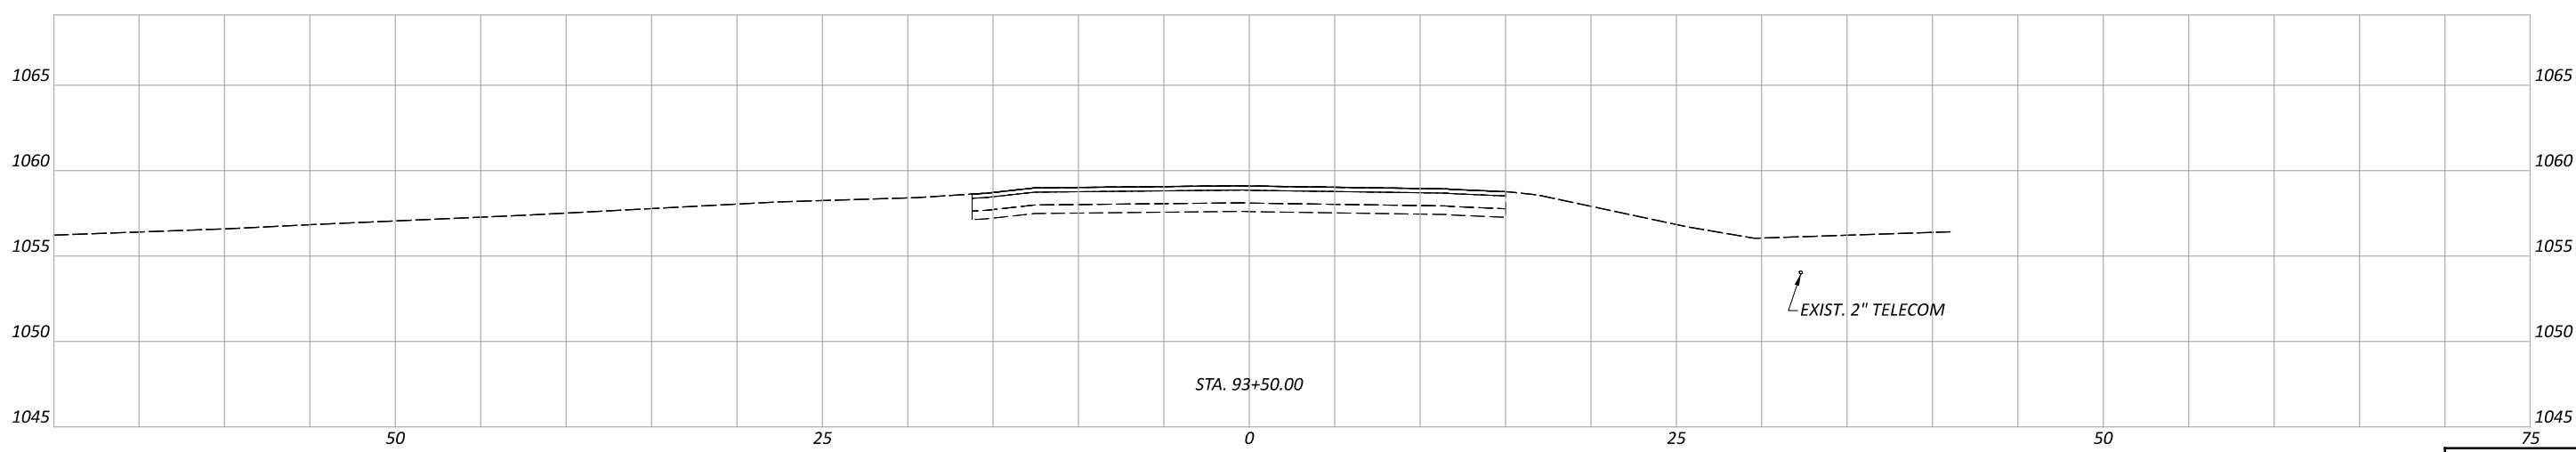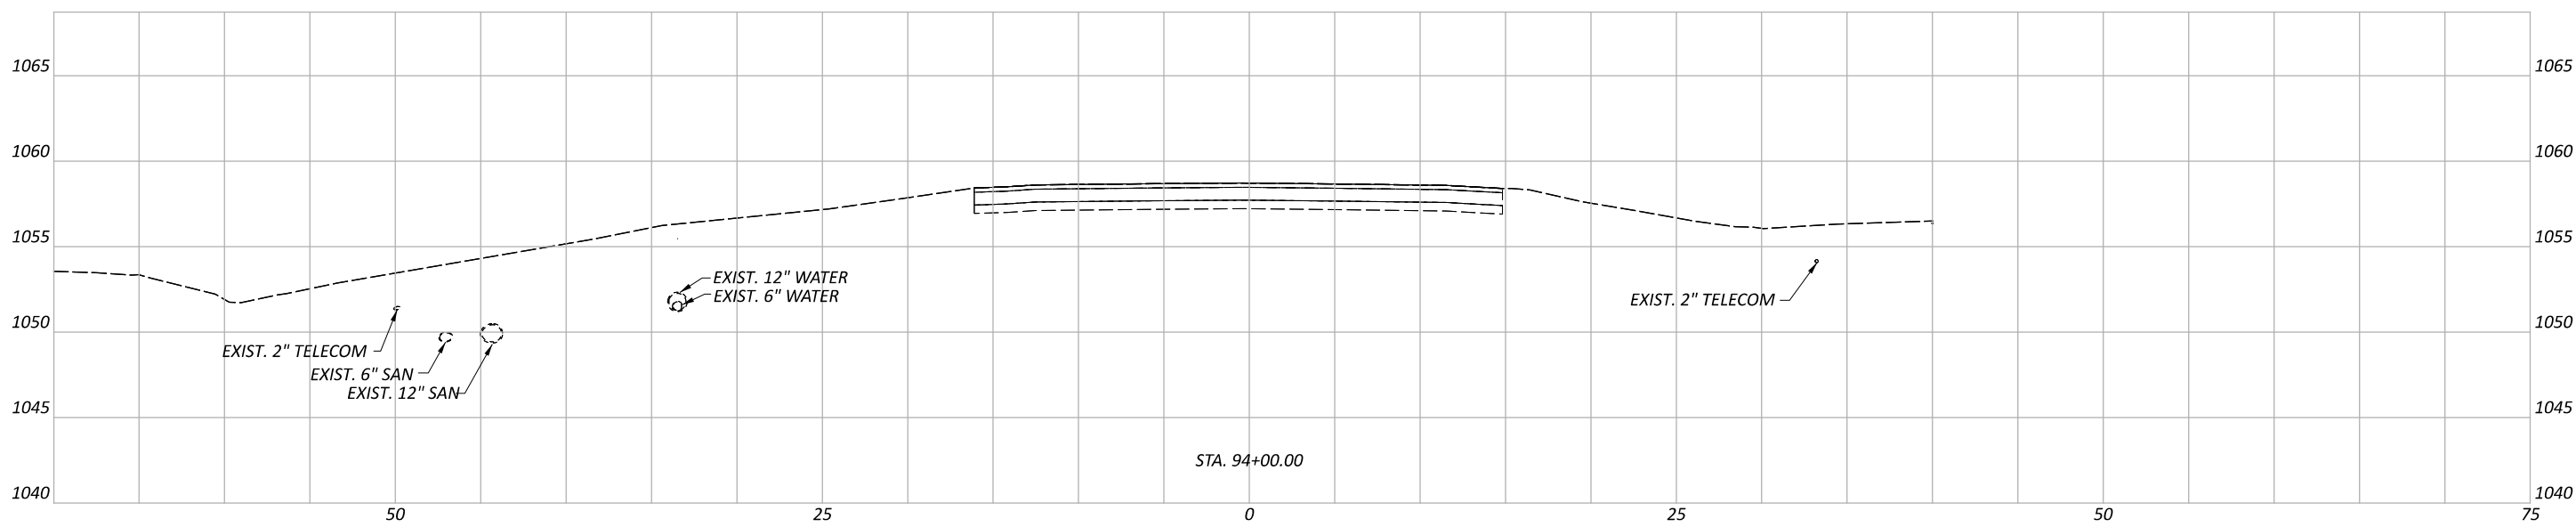


CROSS SECTIONS - PAVEMENT FOR M.O.T.
 SR 435 STA. 93+50 TO STA. 94+50


DESIGN AGENCY
Palmer
 ENGINEERING
 8350 E. KEMPER RD.
 SUITE B
 CINCINNATI, OH 45249
 513-469-1600

DESIGNER
 DPF
 REVIEWER
 DCJ MM-DD-YY
 PROJECT ID
 117955


Sheet Totals			117955
Seeding	Cut	Fill	SHEET TOTAL
			P. 72 228

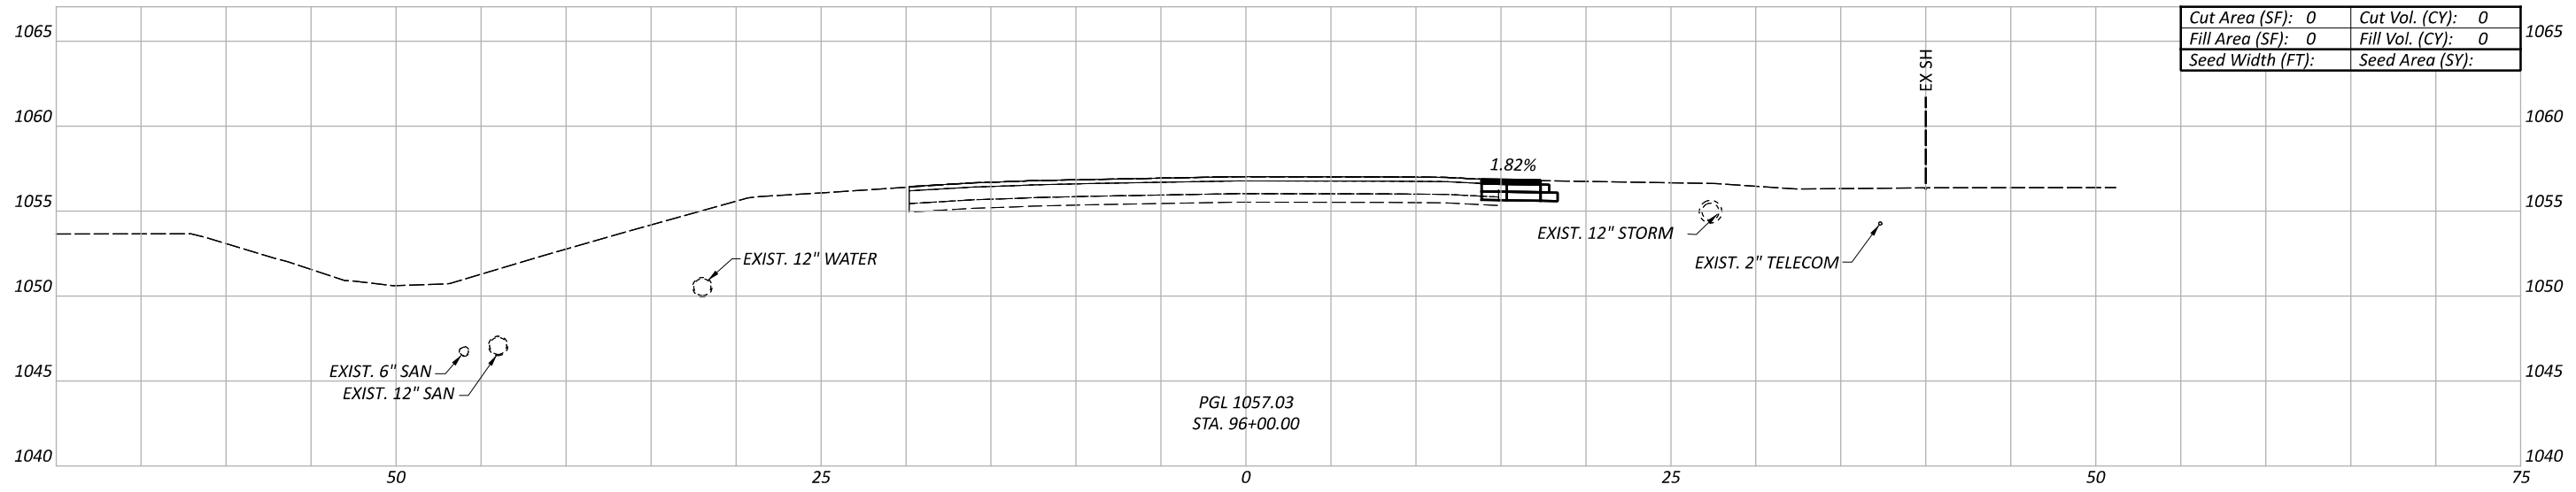

Cut Area (SF):	0	Cut Vol. (CY):	0
Fill Area (SF):	0	Fill Vol. (CY):	0
Seed Width (FT):		Seed Area (SY):	

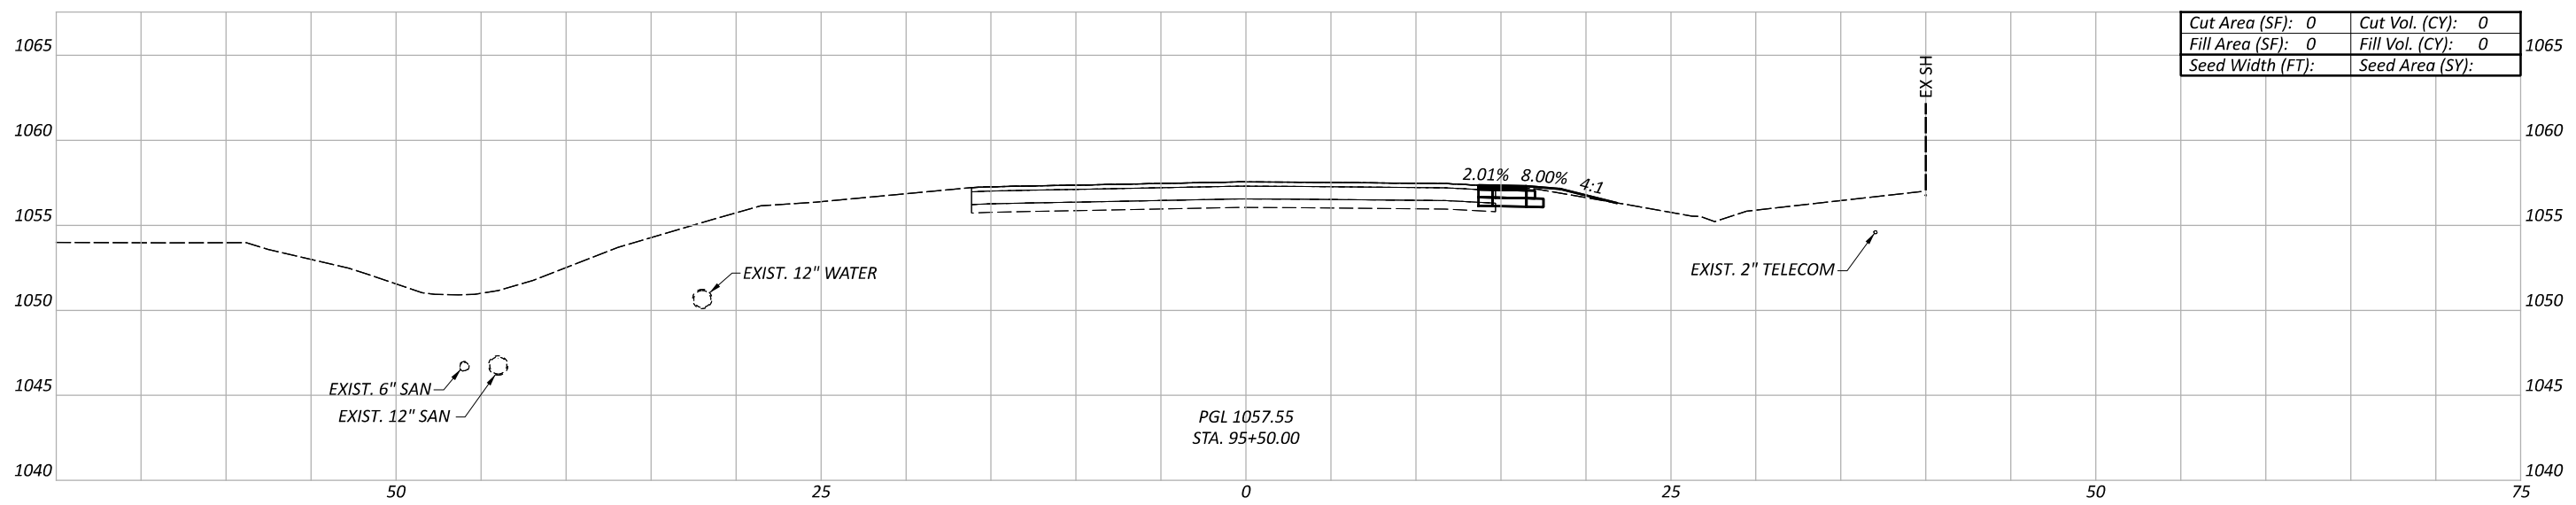

Cut Area (SF):	0	Cut Vol. (CY):	0
Fill Area (SF):	0	Fill Vol. (CY):	0
Seed Width (FT):		Seed Area (SY):	

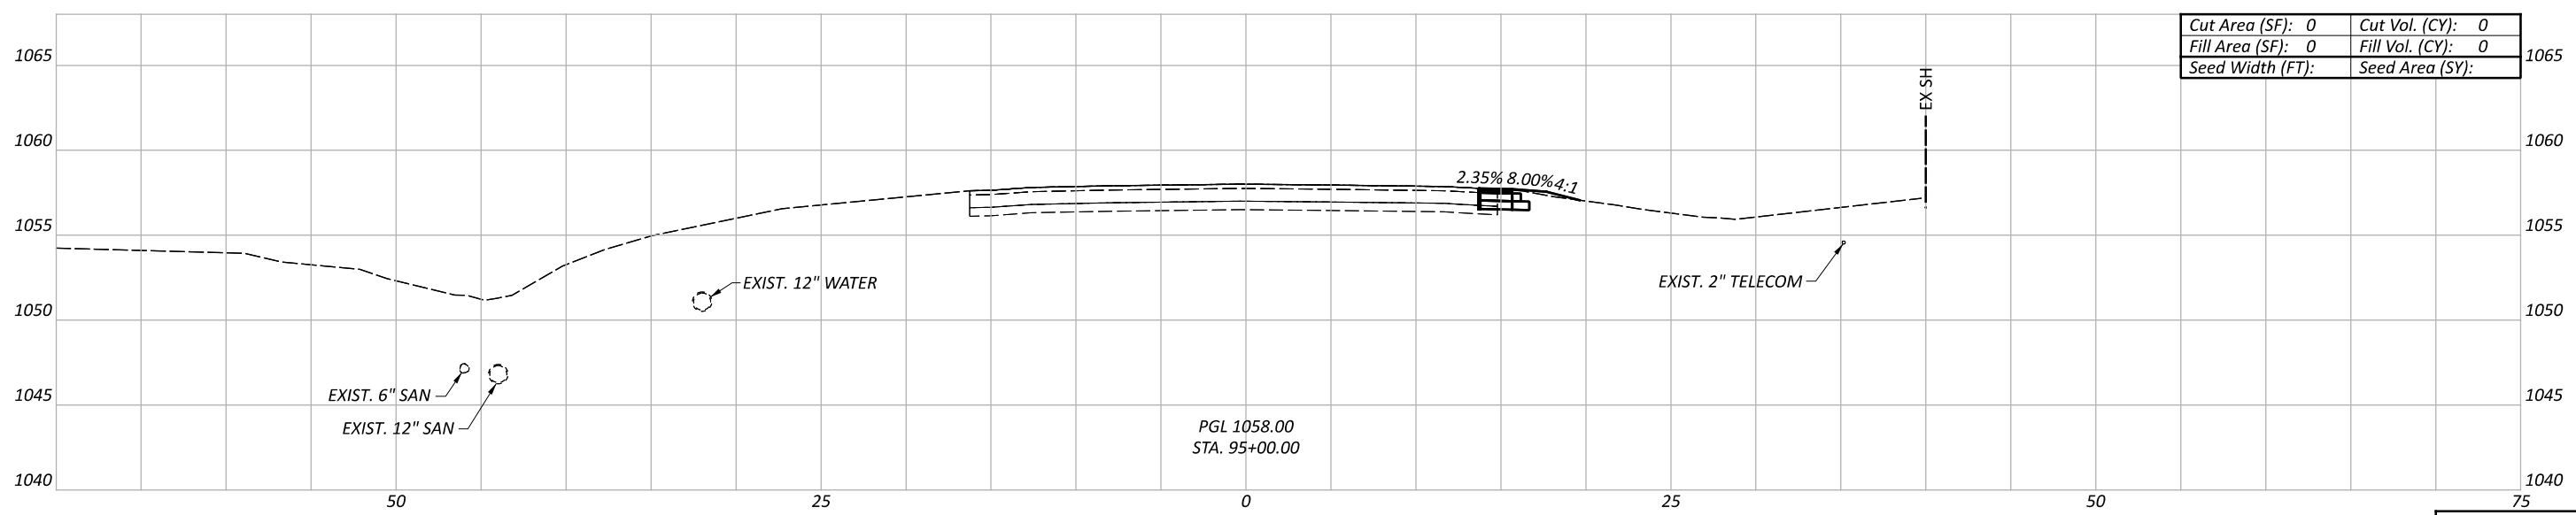


Cut Area (SF):	0	Cut Vol. (CY):	0
Fill Area (SF):	0	Fill Vol. (CY):	0
Seed Width (FT):		Seed Area (SY):	

CROSS SECTIONS - PAVEMENT FOR M.O.T.
 SR 435 STA. 95+00 TO STA. 96+00


DESIGN AGENCY
Palmer
 ENGINEERING
 8350 E. KEMPER RD.
 SUITE B
 CINCINNATI, OH 45249
 513-469-1600

DESIGNER
 DPF
 REVIEWER
 DCJ MM-DD-YY
 PROJECT ID


Sheet Totals			117955
Seeding	Cut	Fill	SHEET TOTAL
			P. 73 228

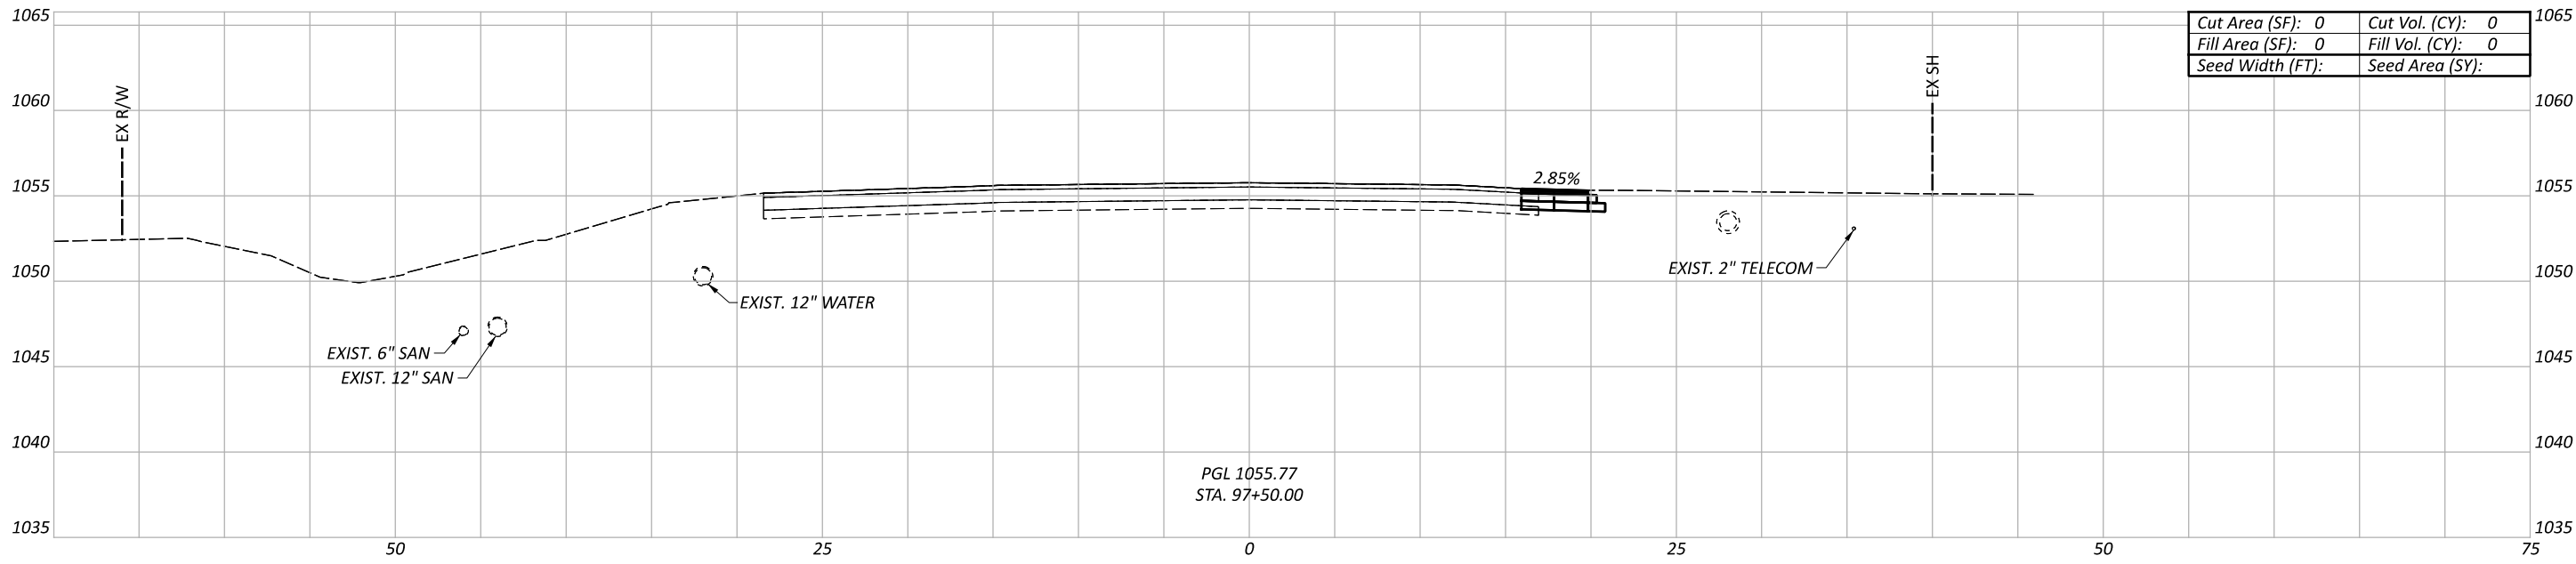

Cut Area (SF):	0	Cut Vol. (CY):	0
Fill Area (SF):	0	Fill Vol. (CY):	0
Seed Width (FT):		Seed Area (SY):	

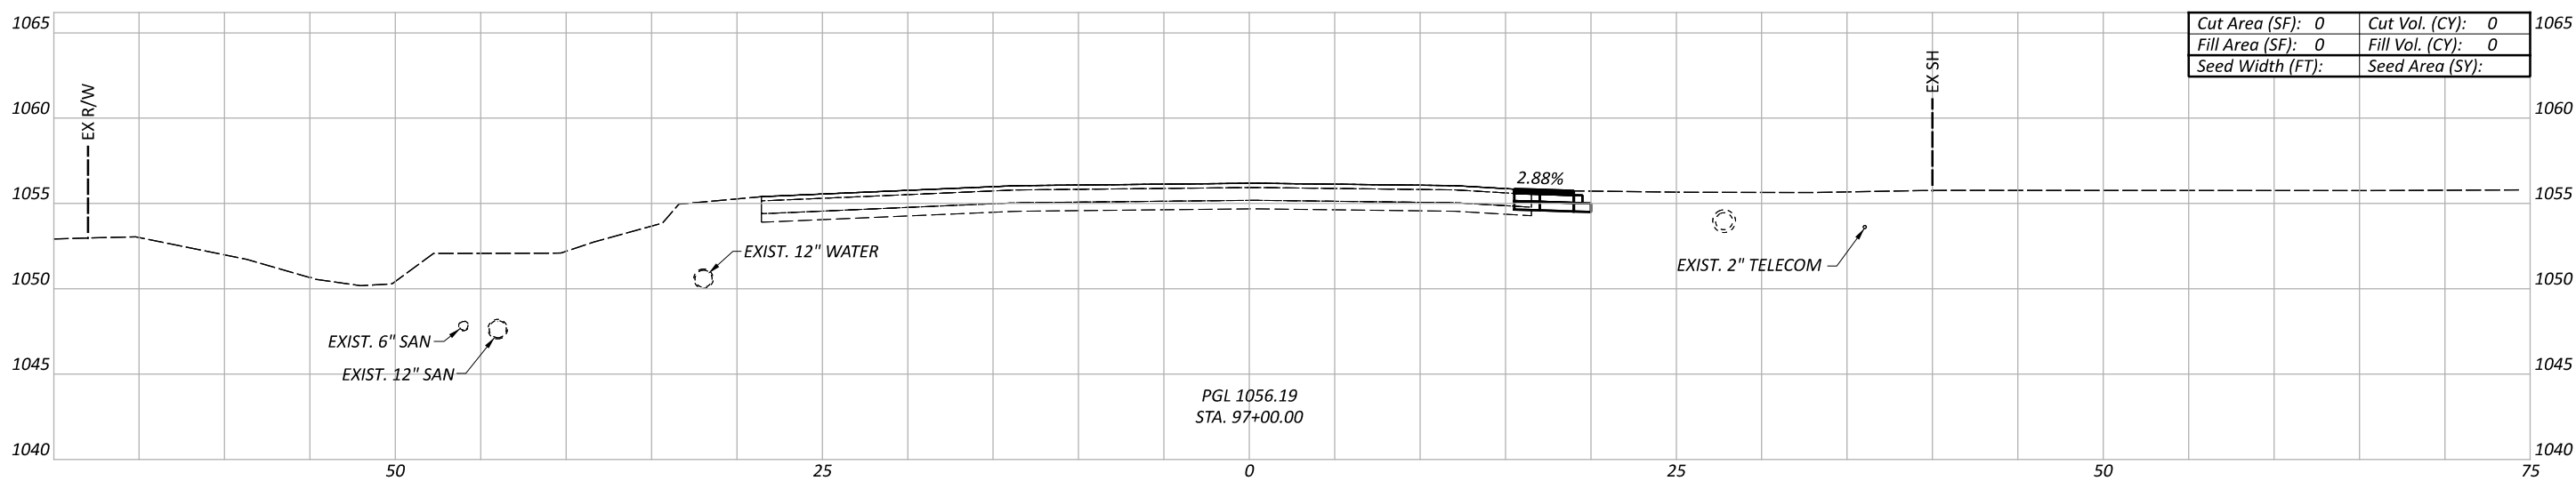

Cut Area (SF):	0	Cut Vol. (CY):	0
Fill Area (SF):	0	Fill Vol. (CY):	0
Seed Width (FT):		Seed Area (SY):	

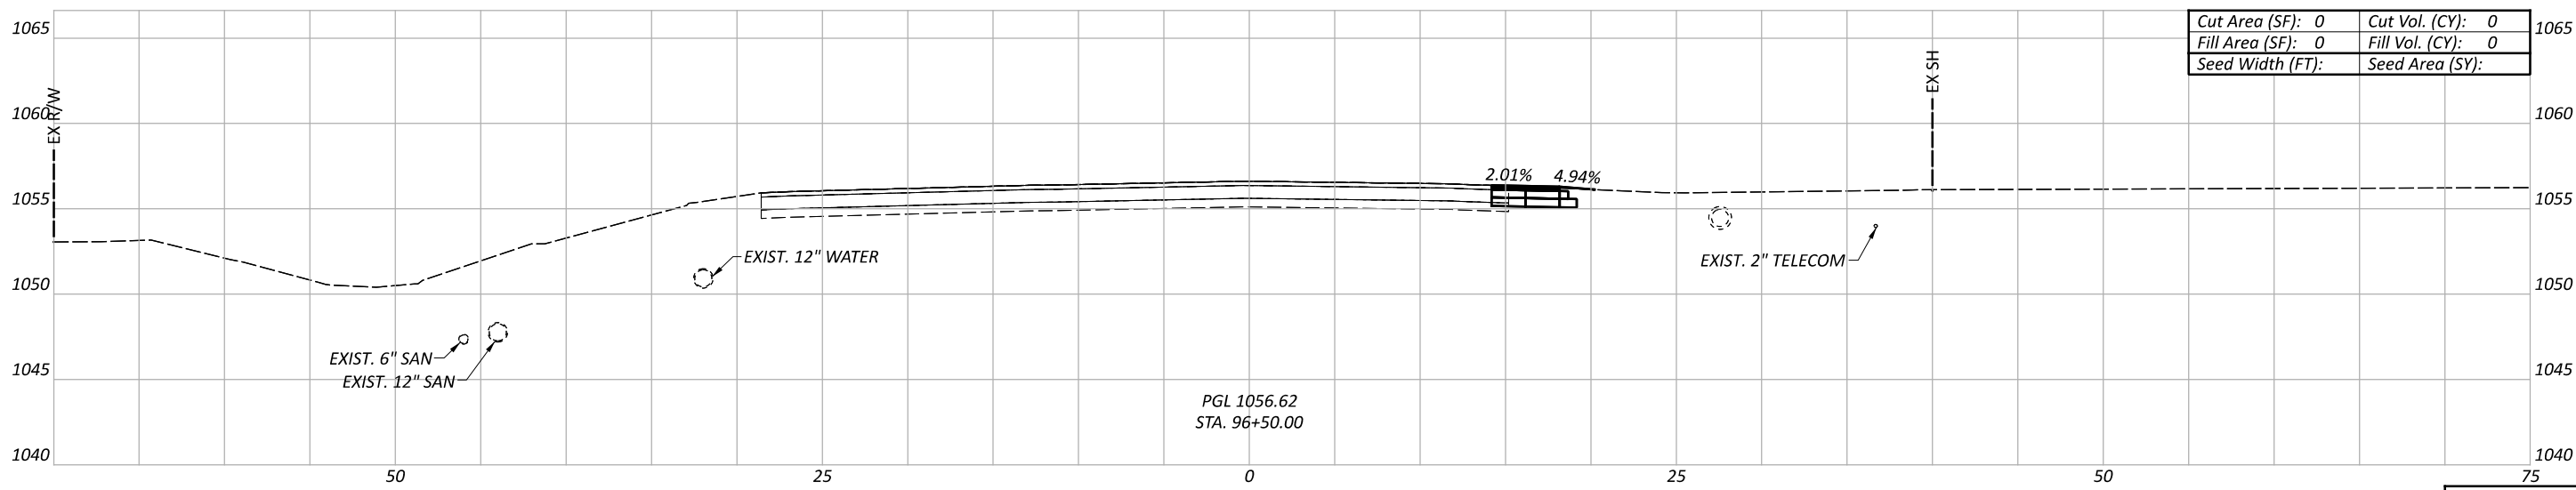




Cut Area (SF):	0	Cut Vol. (CY):	0
Fill Area (SF):	0	Fill Vol. (CY):	0
Seed Width (FT):		Seed Area (SY):	

CROSS SECTIONS - PAVEMENT FOR M.O.T.
 SR 435 STA. 96+50 TO STA. 97+50

DESIGN AGENCY
Palmer
 ENGINEERING
 8350 E. KEMPER RD.
 SUITE B
 CINCINNATI, OH 45249
 513-469-1600

DESIGNER
DPF
 REVIEWER
DCJ MM-DD-YY
 PROJECT ID

Sheet Totals			117955
Seeding	Cut	Fill	SHEET TOTAL
			P. 74 228

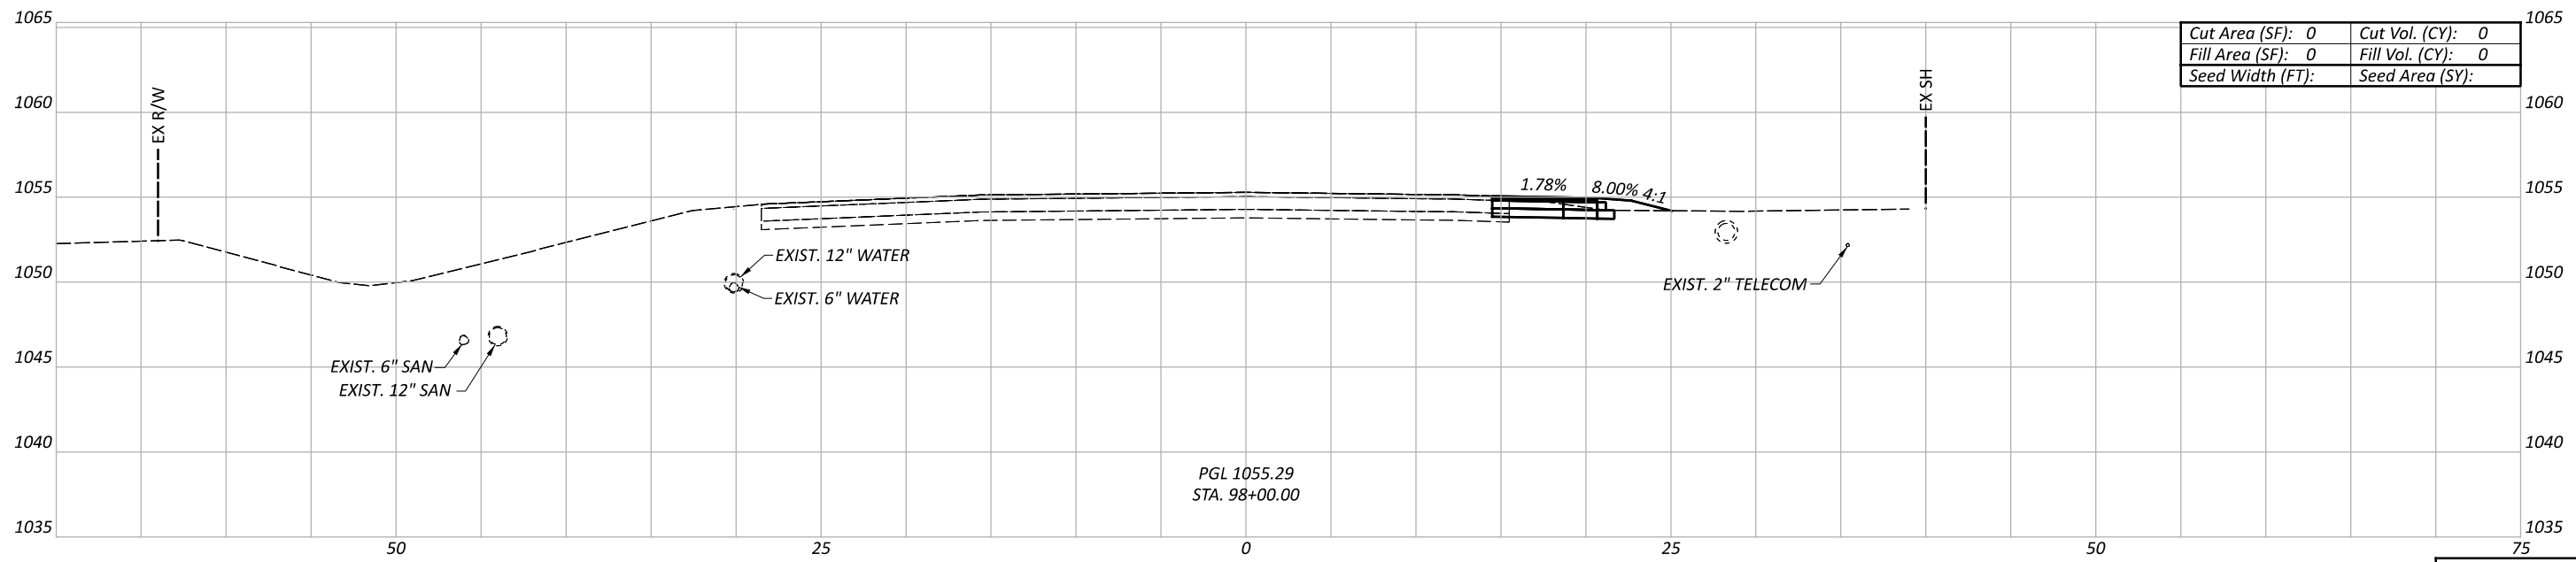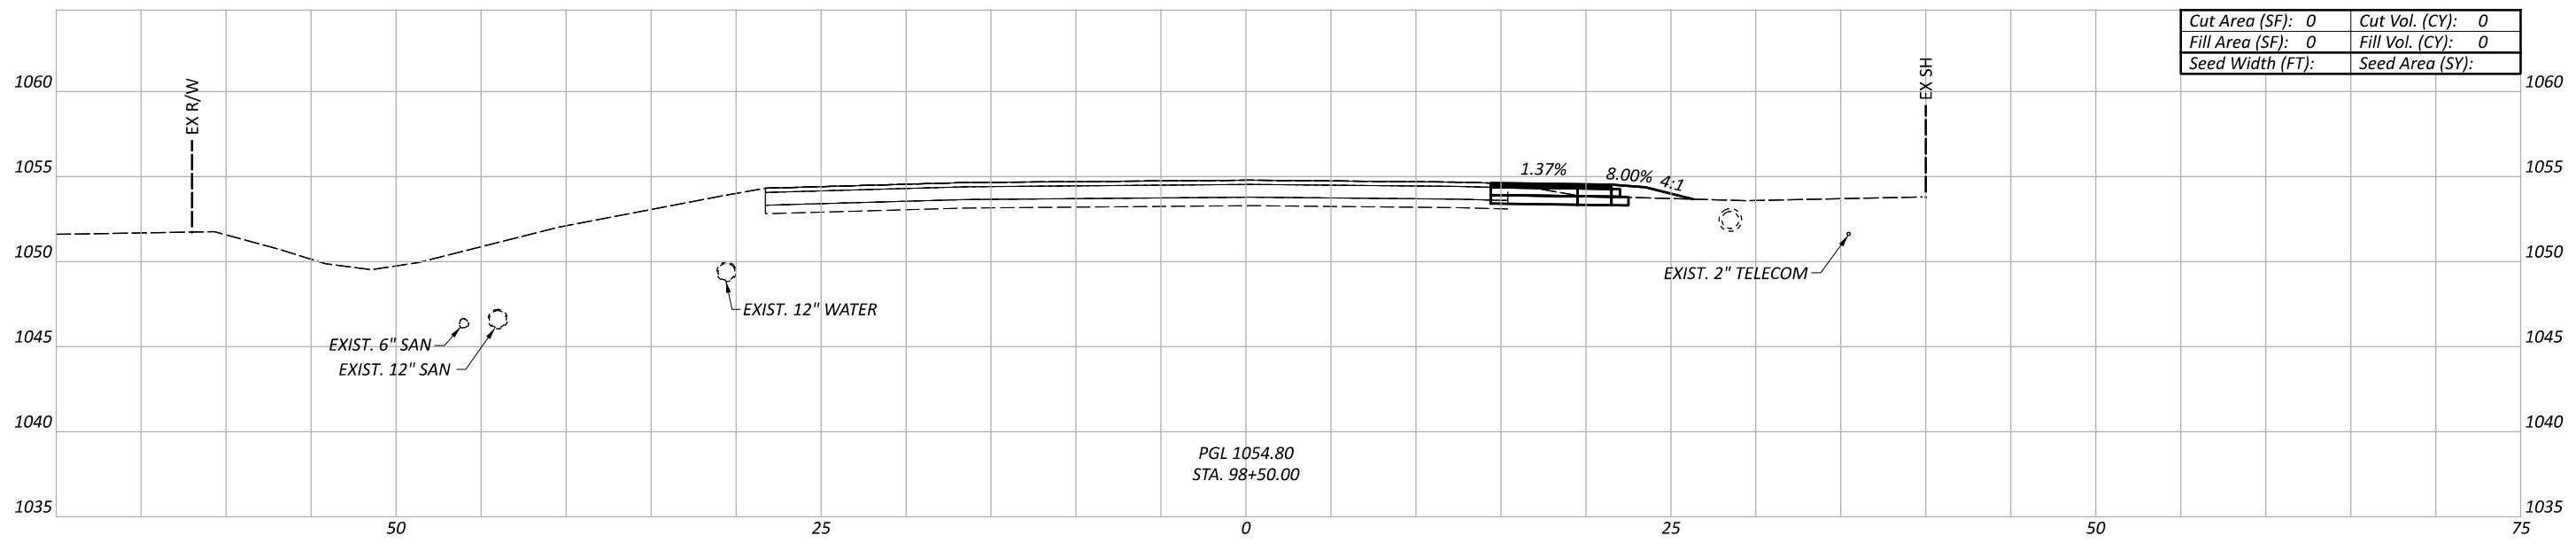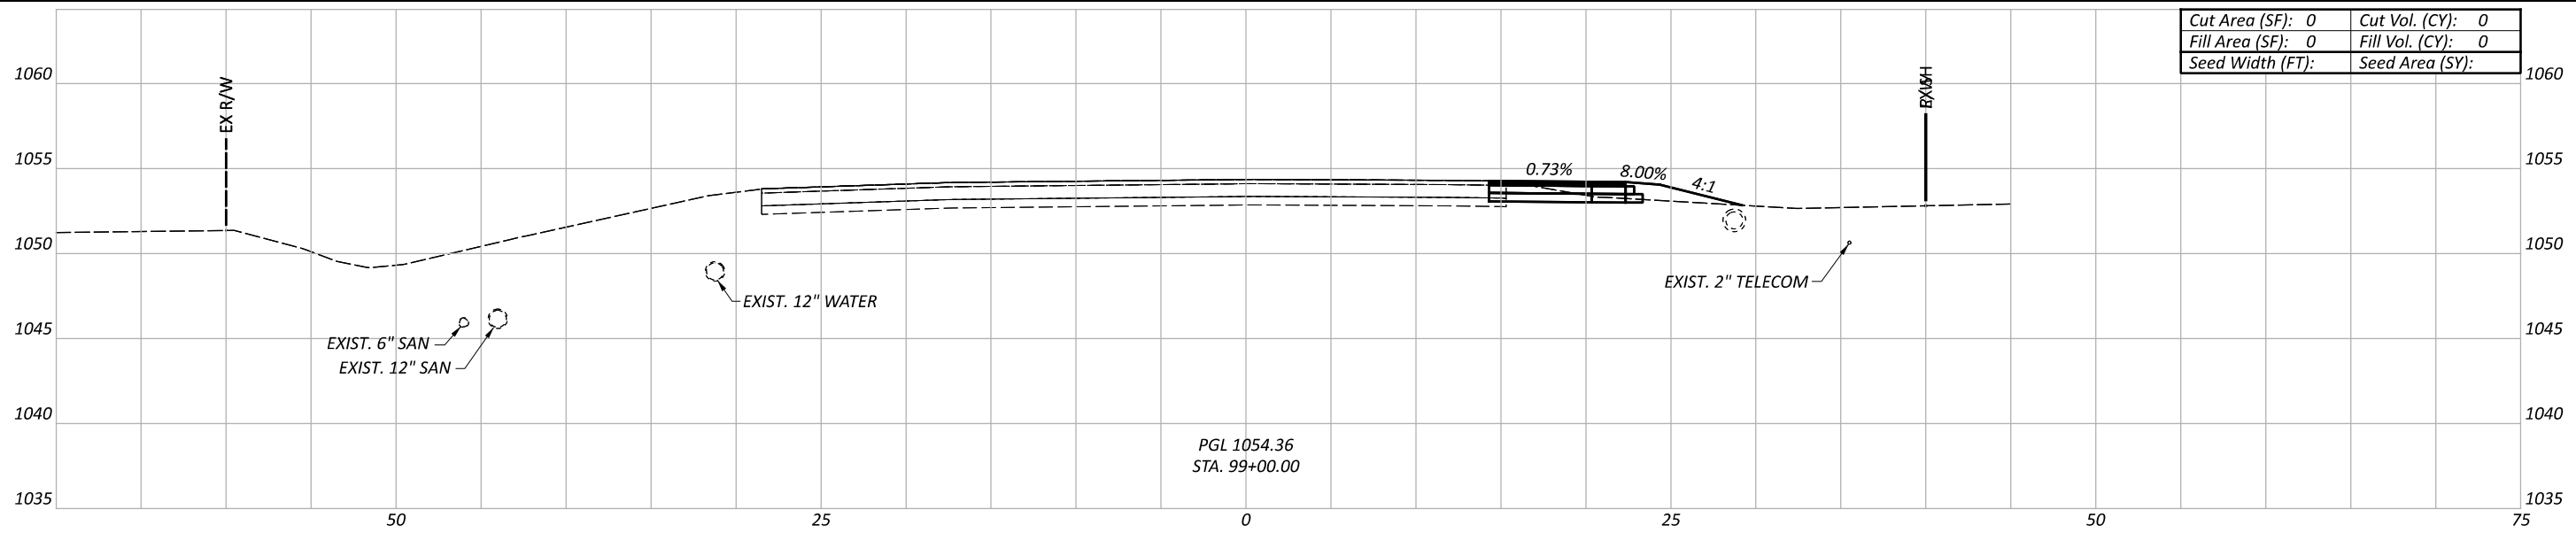

CROSS SECTIONS - PAVEMENT FOR M.O.T.
 SR 435 STA. 98+00 TO STA. 99+00

DESIGN AGENCY




DESIGNER

REVIEWER


PROJECT ID

117955


Sheet Totals			117955
Seeding	Cut	Fill	SHEET TOTAL
			P. 75 228

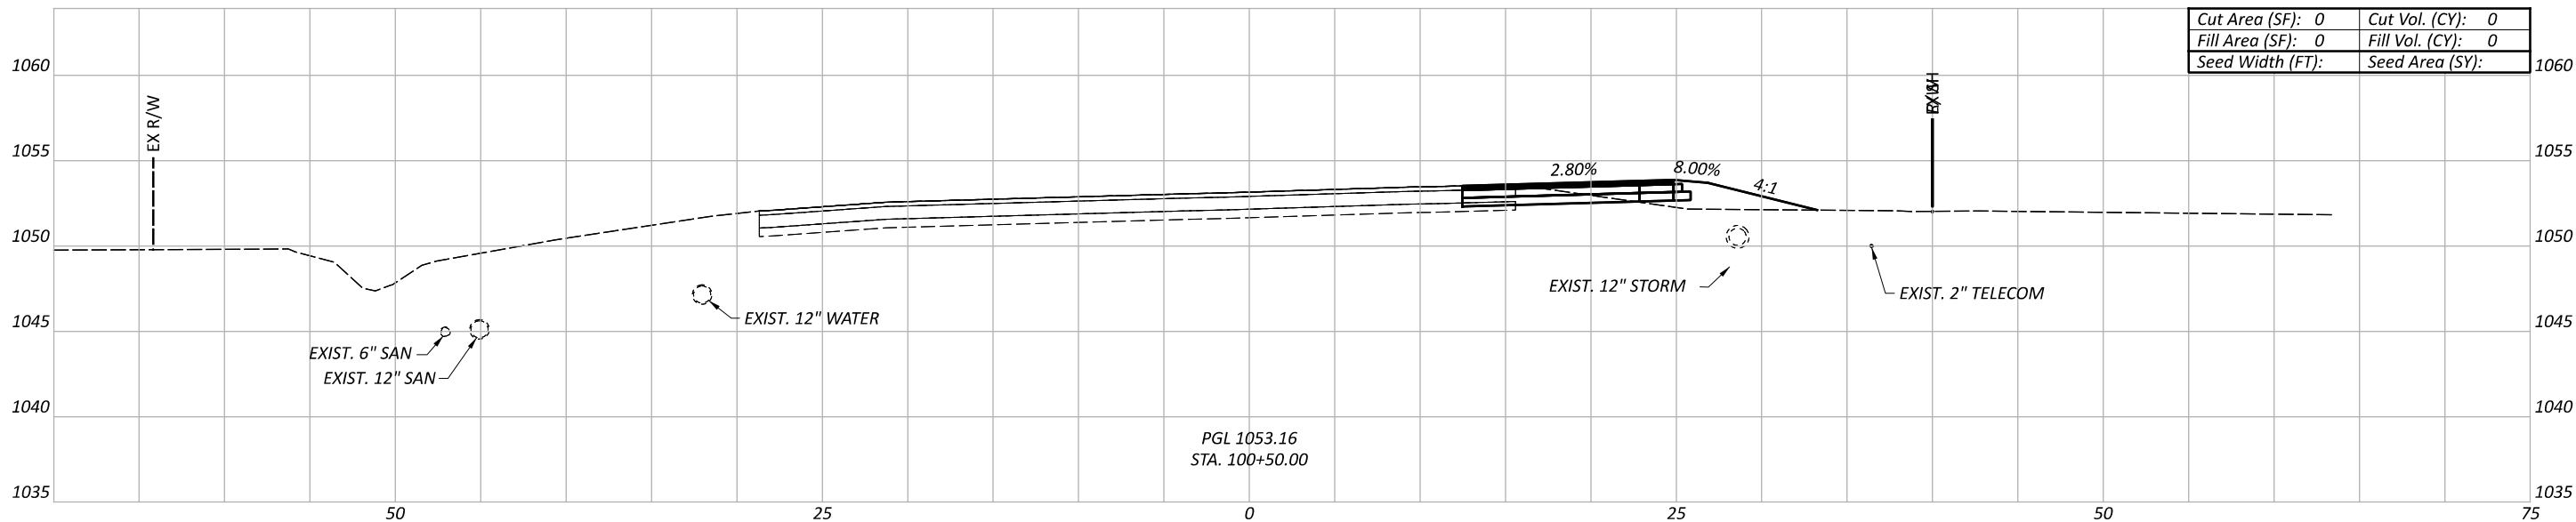

Cut Area (SF):	0	Cut Vol. (CY):	0
Fill Area (SF):	0	Fill Vol. (CY):	0
Seed Width (FT):		Seed Area (SY):	

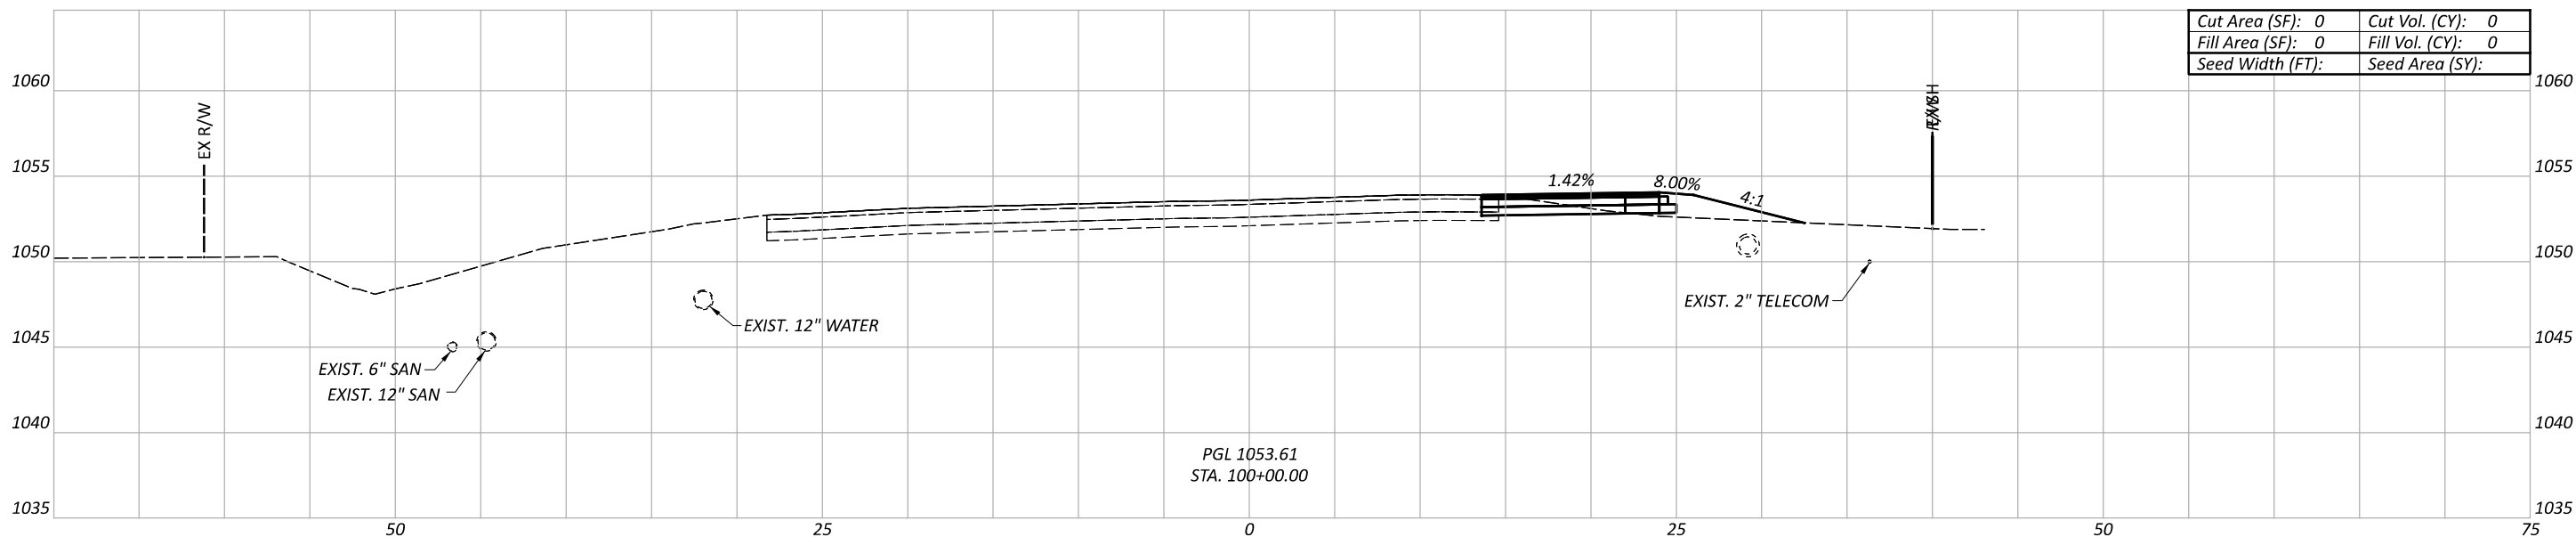

Cut Area (SF):	0	Cut Vol. (CY):	0
Fill Area (SF):	0	Fill Vol. (CY):	0
Seed Width (FT):		Seed Area (SY):	

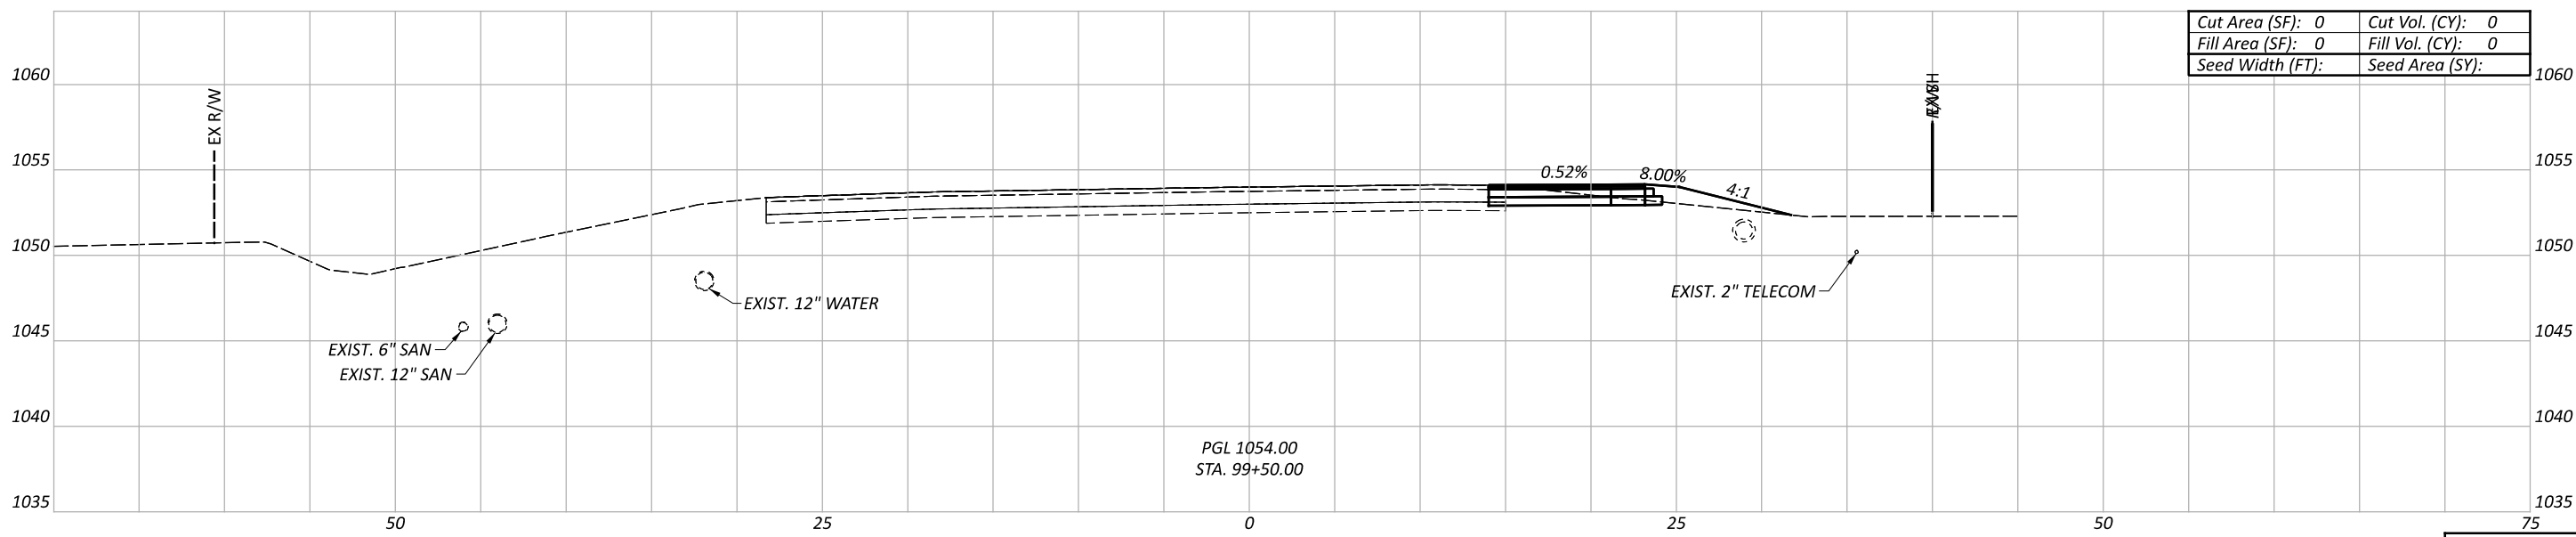

Cut Area (SF):	0	Cut Vol. (CY):	0
Fill Area (SF):	0	Fill Vol. (CY):	0
Seed Width (FT):		Seed Area (SY):	

CROSS SECTIONS - PAVEMENT FOR M.O.T.
 SR 435 STA. 99+50 TO STA. 100+50


DESIGN AGENCY
Palmer
 ENGINEERING
 8350 E. KEMPER RD.
 SUITE B
 CINCINNATI, OH 45249
 513-469-1600

DESIGNER
 DPF


REVIEWER
 DCJ MM-DD-YY

PROJECT ID
 117955


Sheet Totals			117955
Seeding	Cut	Fill	TOTAL
			P. 76 228

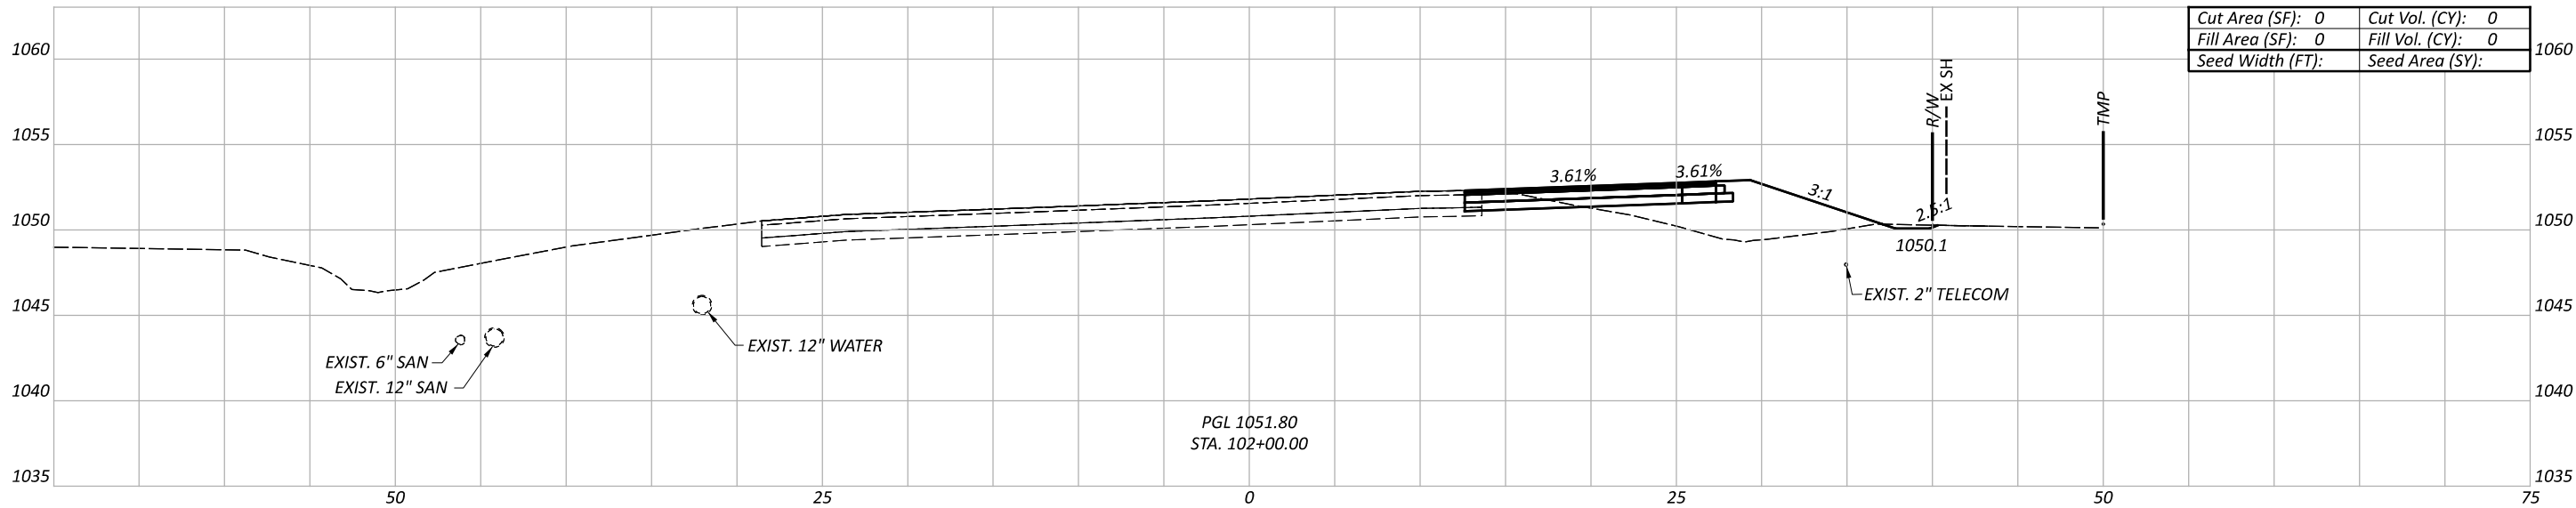

Cut Area (SF):	0	Cut Vol. (CY):	0
Fill Area (SF):	0	Fill Vol. (CY):	0
Seed Width (FT):		Seed Area (SY):	

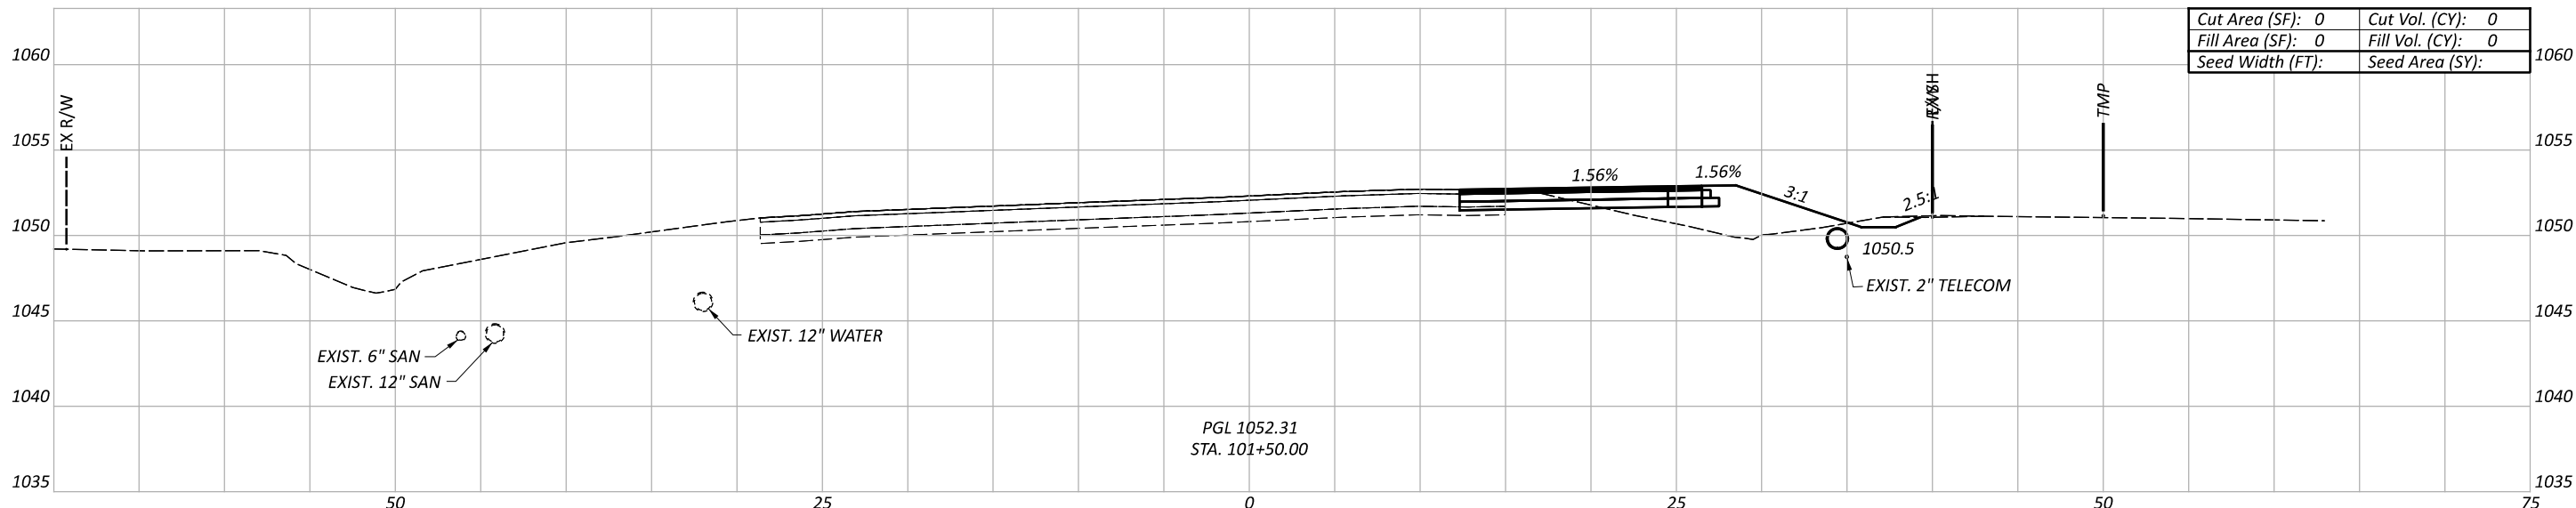

Cut Area (SF):	0	Cut Vol. (CY):	0
Fill Area (SF):	0	Fill Vol. (CY):	0
Seed Width (FT):		Seed Area (SY):	

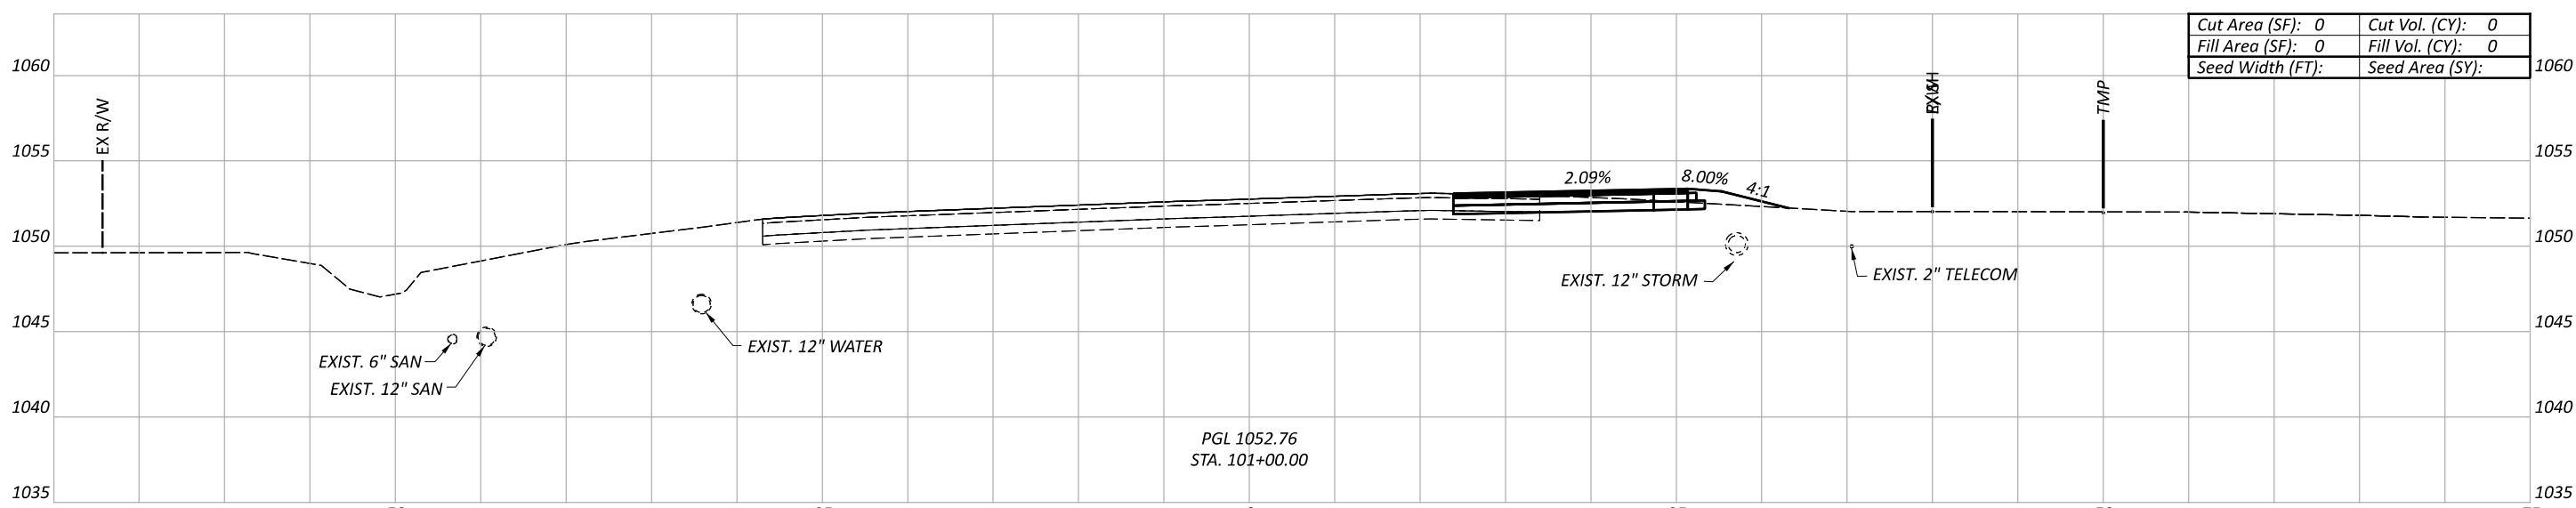

Cut Area (SF):	0	Cut Vol. (CY):	0
Fill Area (SF):	0	Fill Vol. (CY):	0
Seed Width (FT):		Seed Area (SY):	

CROSS SECTIONS - PAVEMENT FOR M.O.T.
 SR 435 STA. 101+00 TO STA. 102+00


DESIGN AGENCY
Palmer
 ENGINEERING
 8350 E. KEMPER RD.
 SUITE B
 CINCINNATI, OH 45249
 513-469-1600

DESIGNER
 DPF


REVIEWER
 DCJ MM-DD-YY

PROJECT ID
 117955


Sheet Totals			117955
Seeding	Cut	Fill	TOTAL
			P. 77 228

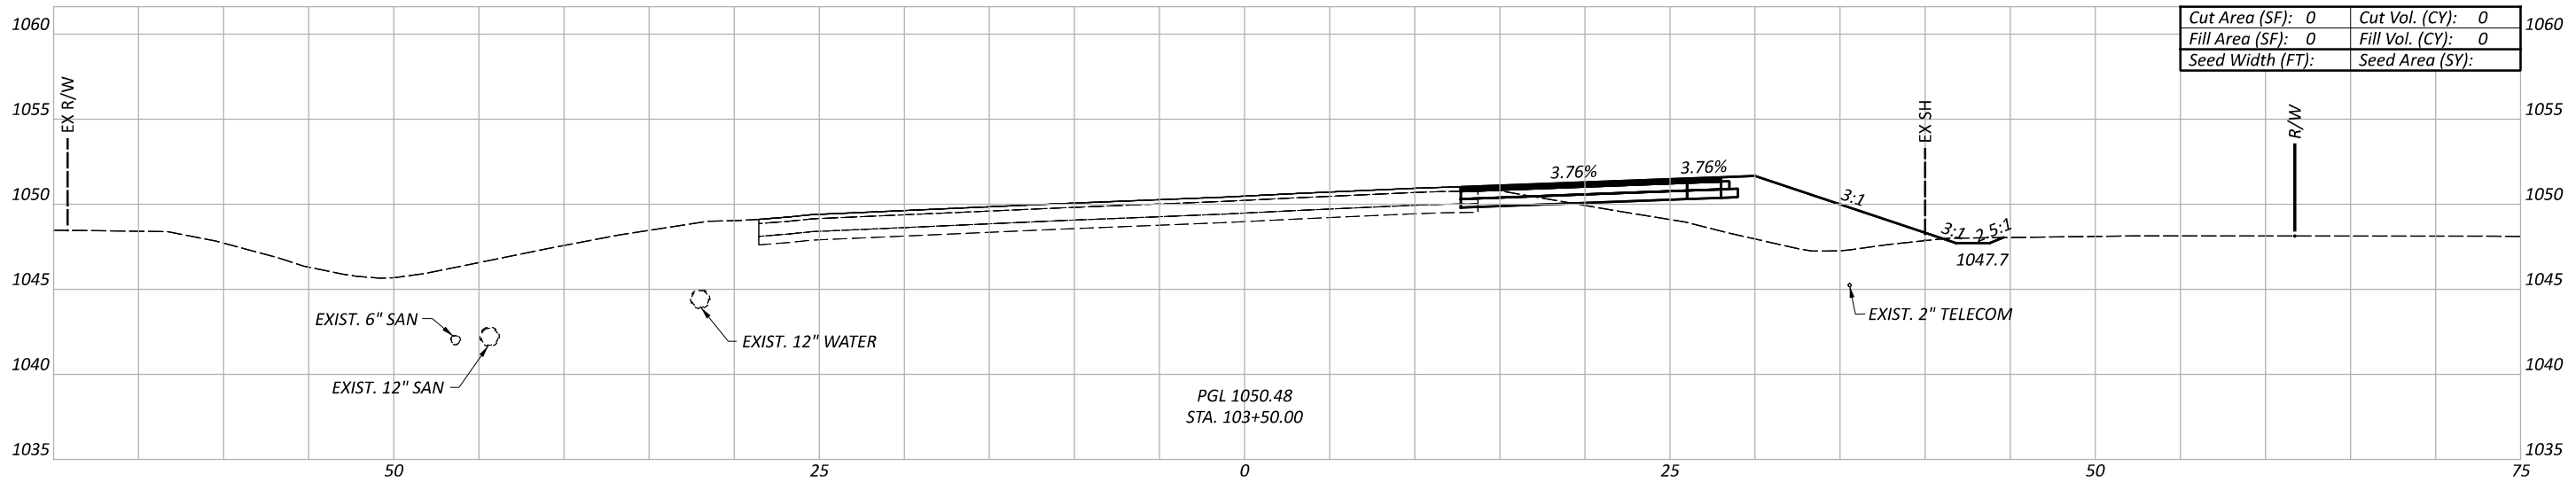

Cut Area (SF):	0	Cut Vol. (CY):	0
Fill Area (SF):	0	Fill Vol. (CY):	0
Seed Width (FT):		Seed Area (SY):	

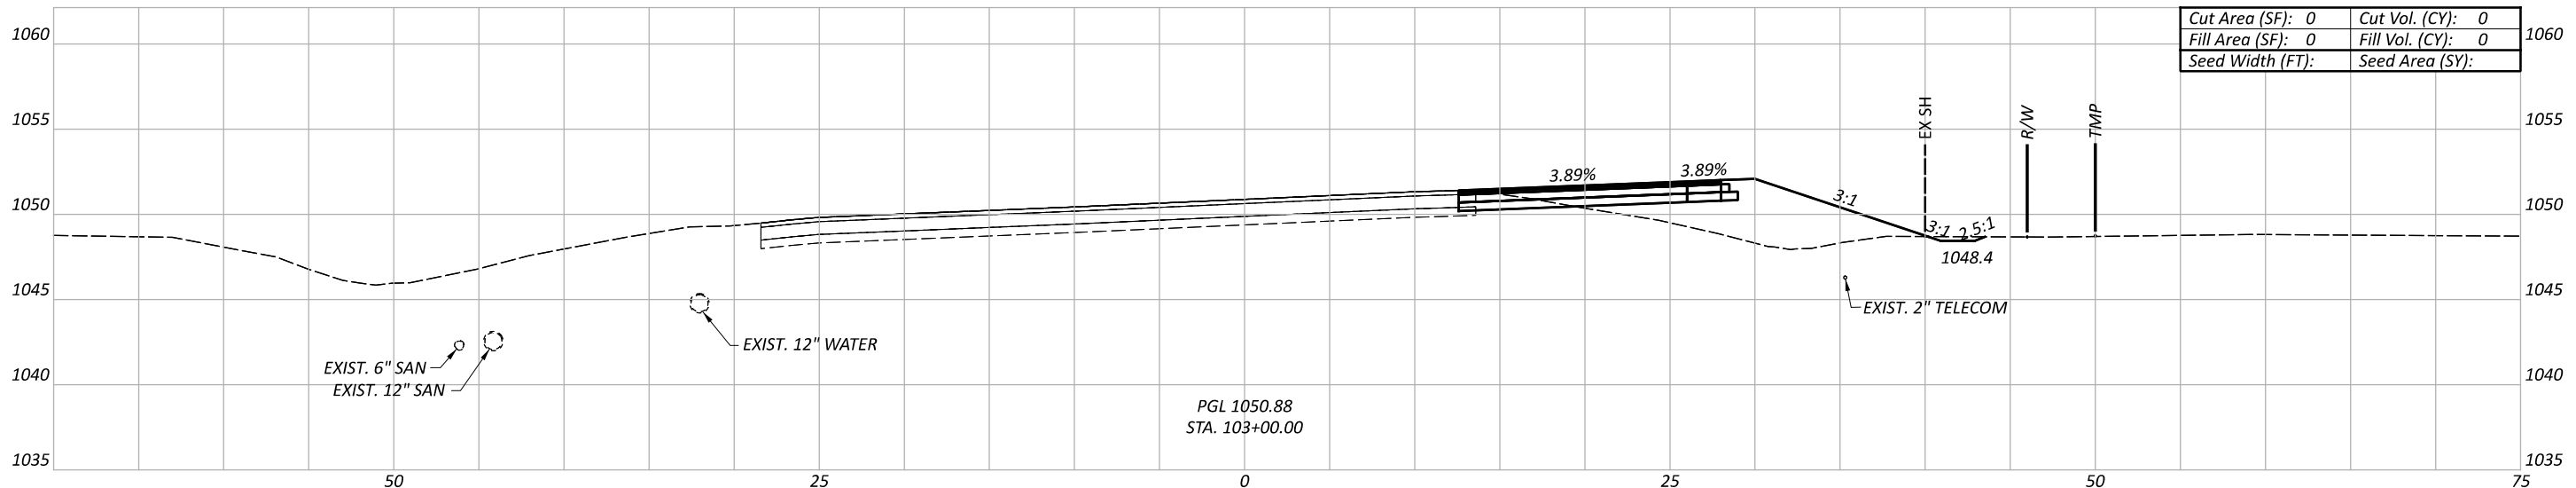

Cut Area (SF):	0	Cut Vol. (CY):	0
Fill Area (SF):	0	Fill Vol. (CY):	0
Seed Width (FT):		Seed Area (SY):	

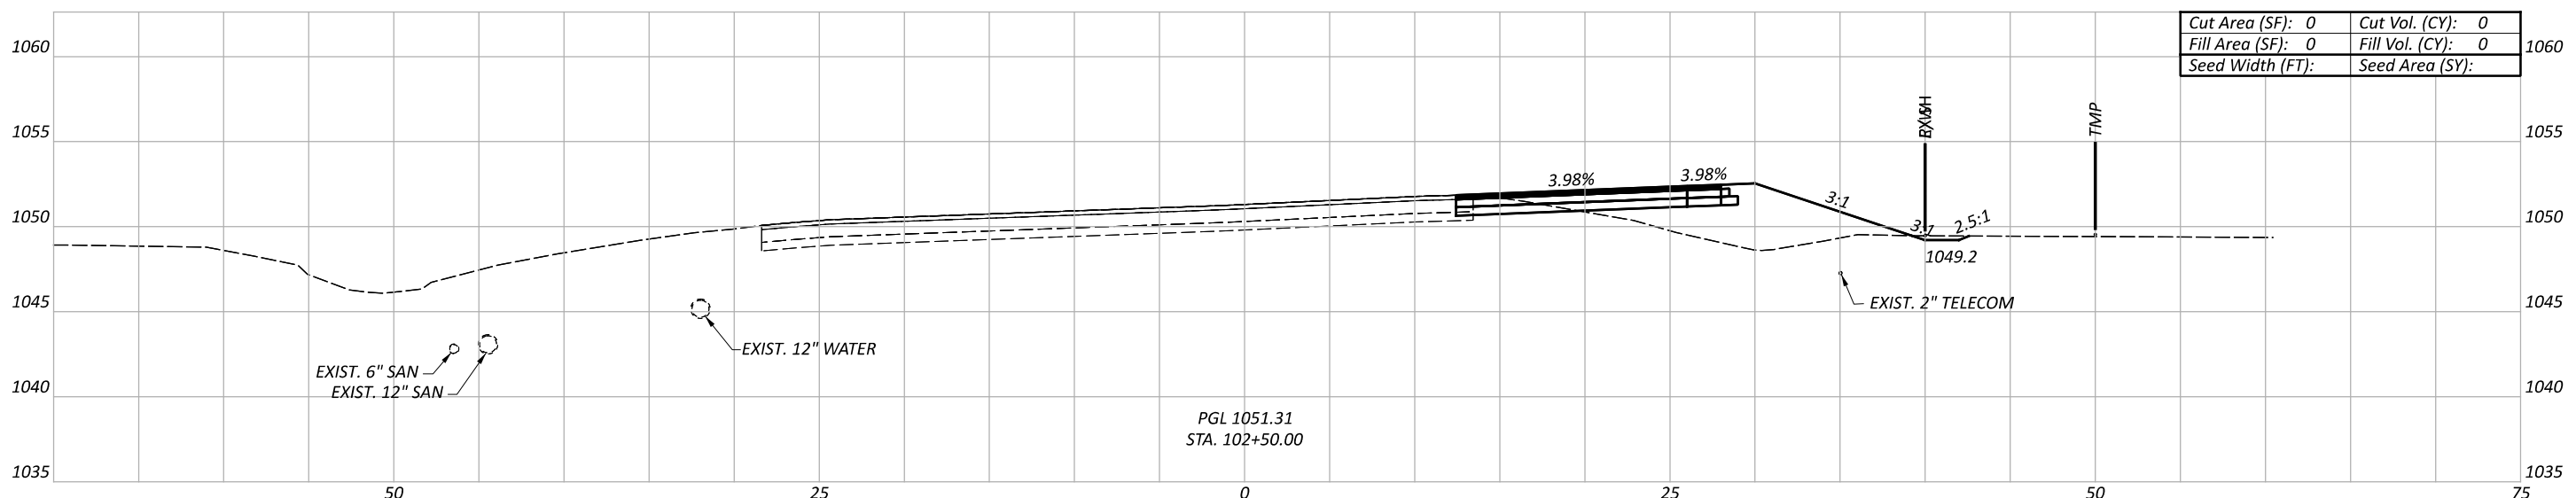

Cut Area (SF):	0	Cut Vol. (CY):	0
Fill Area (SF):	0	Fill Vol. (CY):	0
Seed Width (FT):		Seed Area (SY):	

CROSS SECTIONS - PAVEMENT FOR M.O.T.
 SR 435 STA. 102+50 TO STA. 103+50

DESIGN AGENCY

Palmer
 ENGINEERING
 8350 E. KEMPER RD.
 SUITE B
 CINCINNATI, OH 45249
 513-469-1600

DESIGNER



REVIEWER

DCJ MM-DD-YY

PROJECT ID

117955

Sheet Totals			117955
Seeding	Cut	Fill	SHEET TOTAL
			P. 78 228

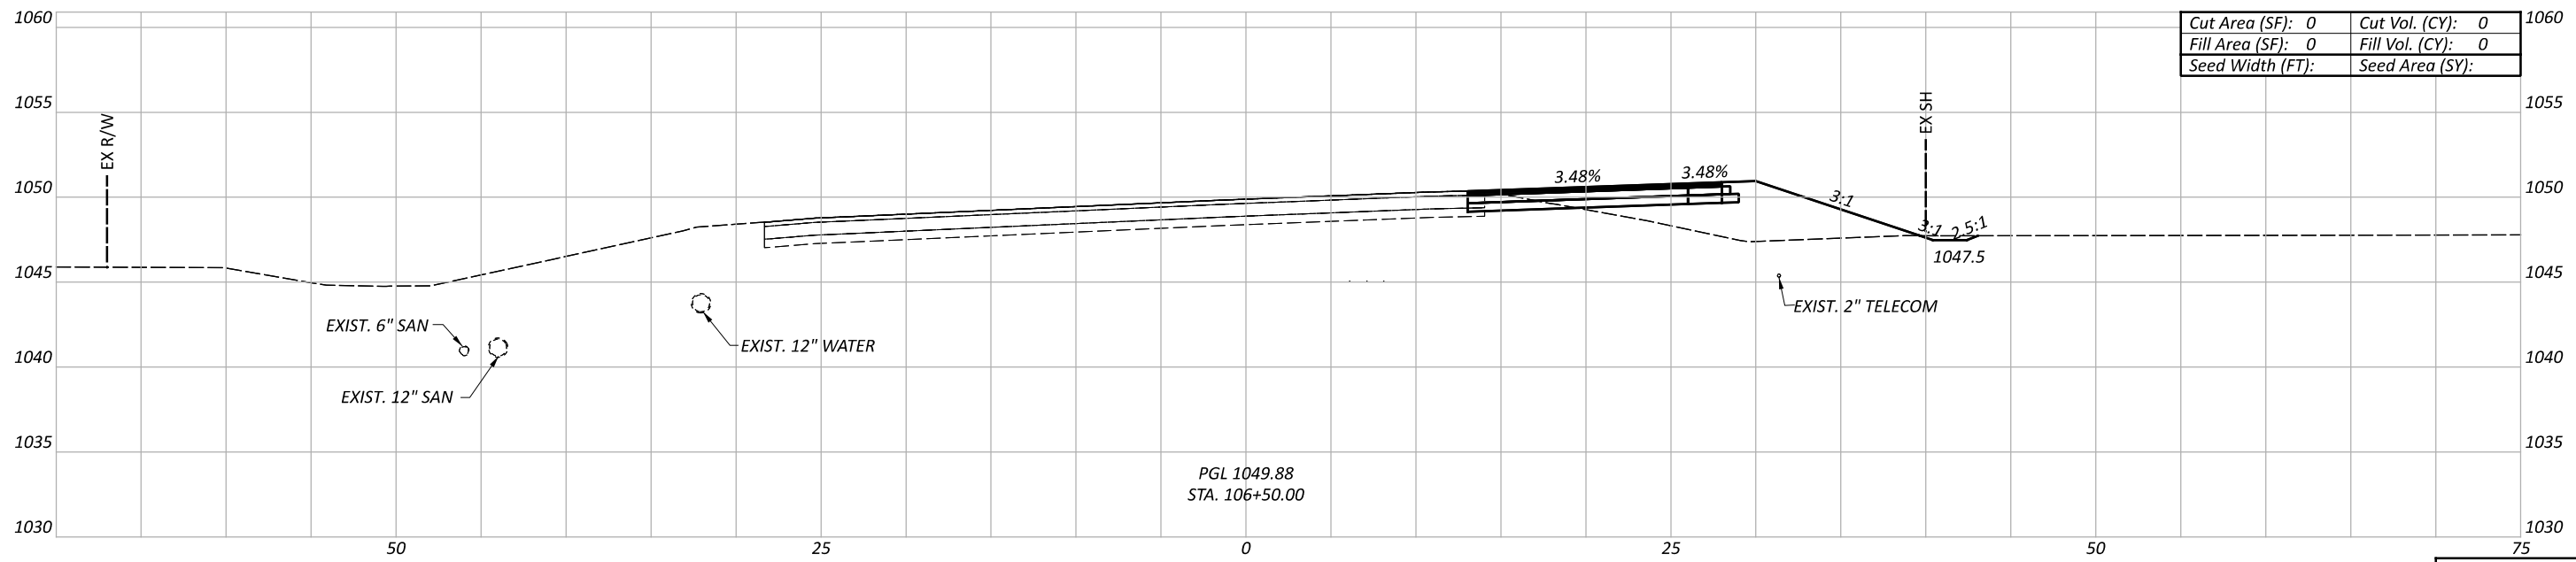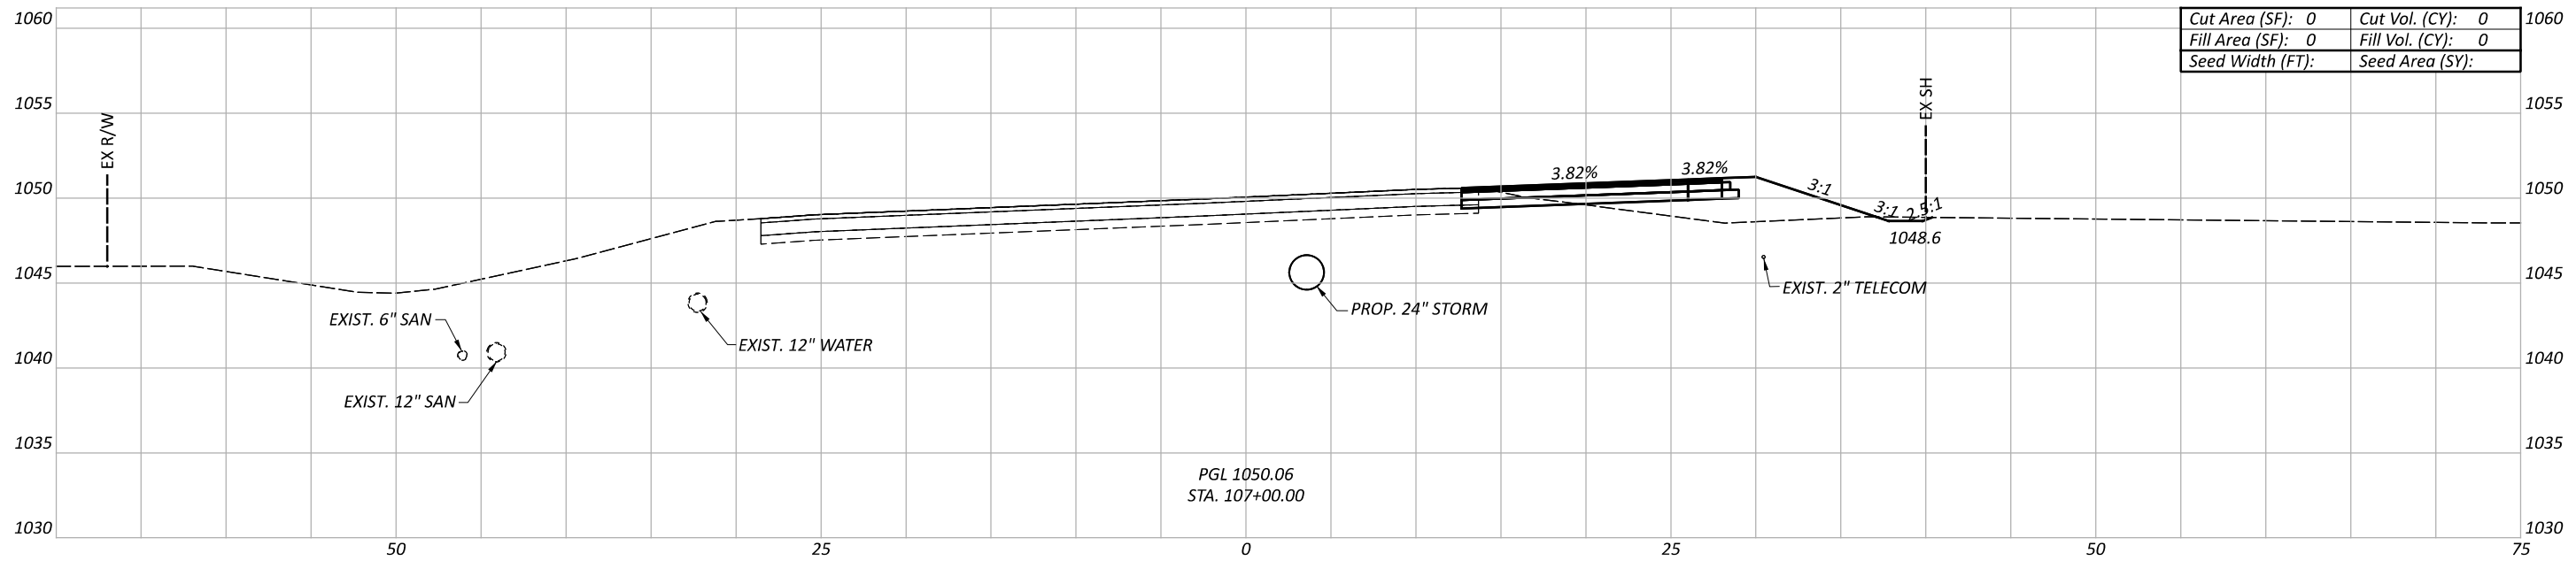

Sheet Totals			117955
Seeding	Cut	Fill	TOTAL
			P. 81 228

CROSS SECTIONS - PAVEMENT FOR M.O.T.
 SR 435 STA. 106+50 TO STA. 107+00

DESIGN AGENCY






8350 E. KEMPER RD.
 SUITE B
 CINCINNATI, OH 45249
 513-469-1600

DESIGNER
 DPF

REVIEWER
 DCJ MM-DD-YY

PROJECT ID
 117955

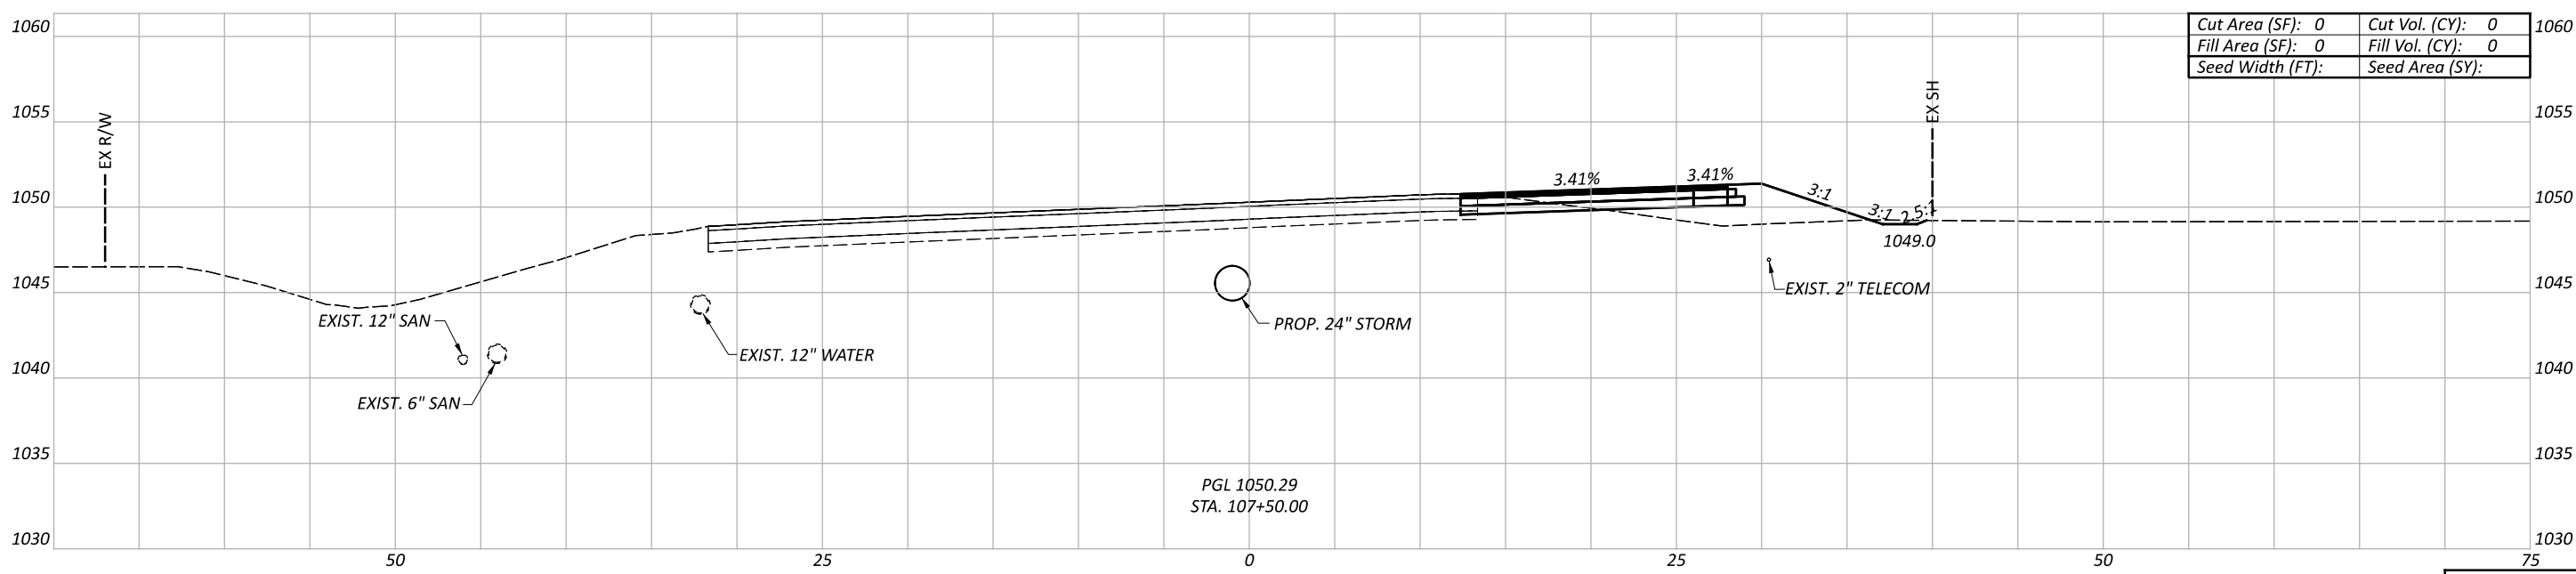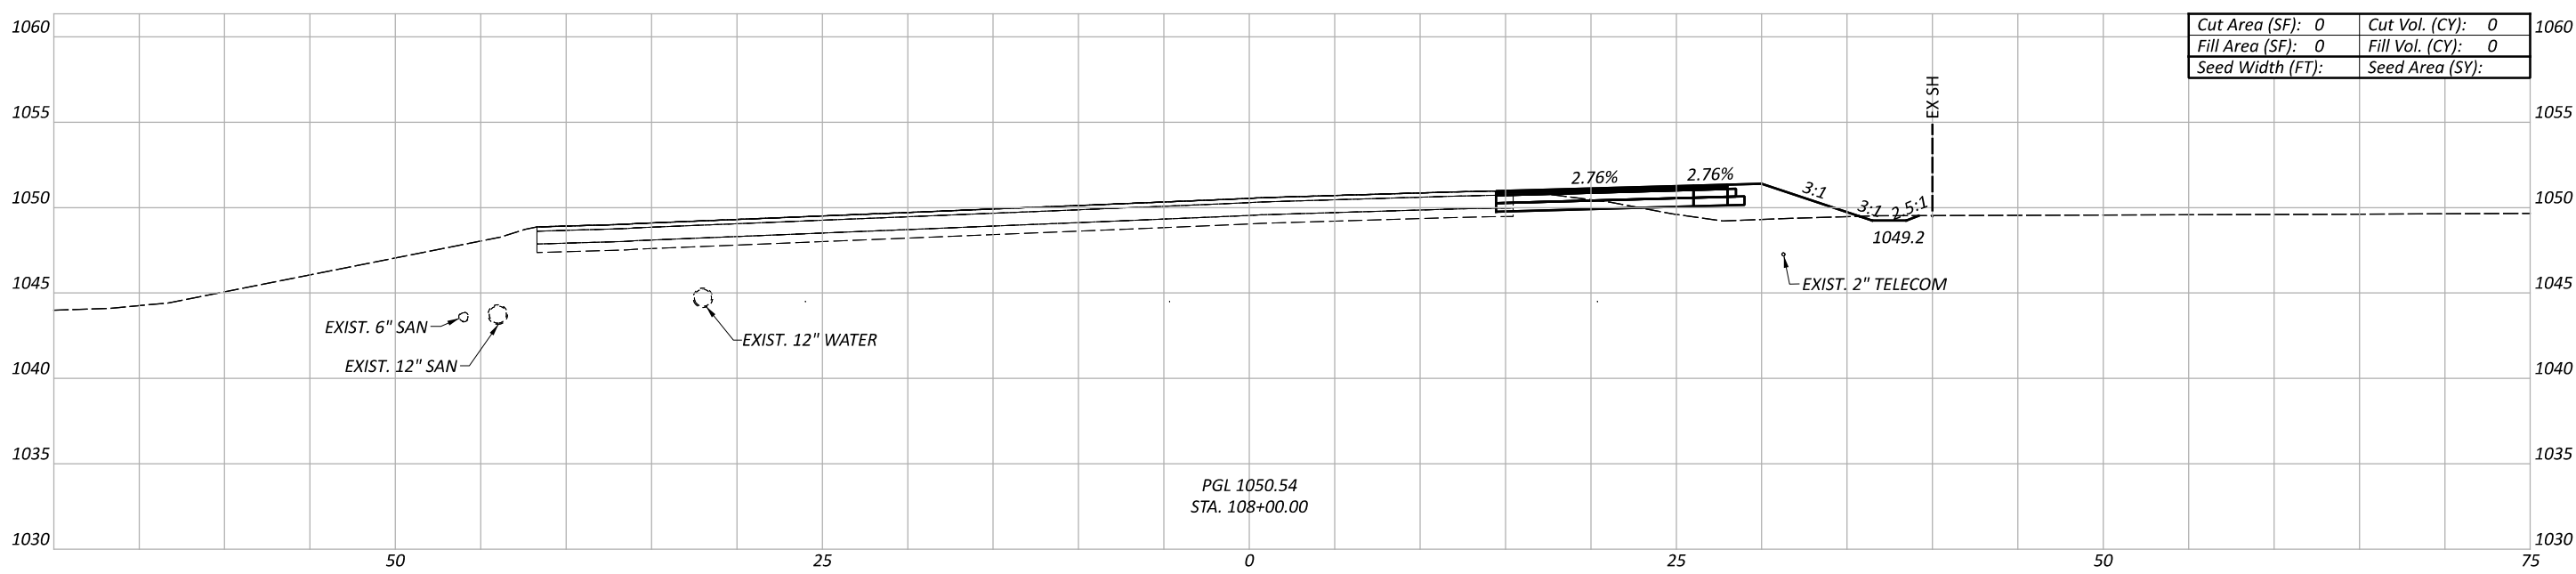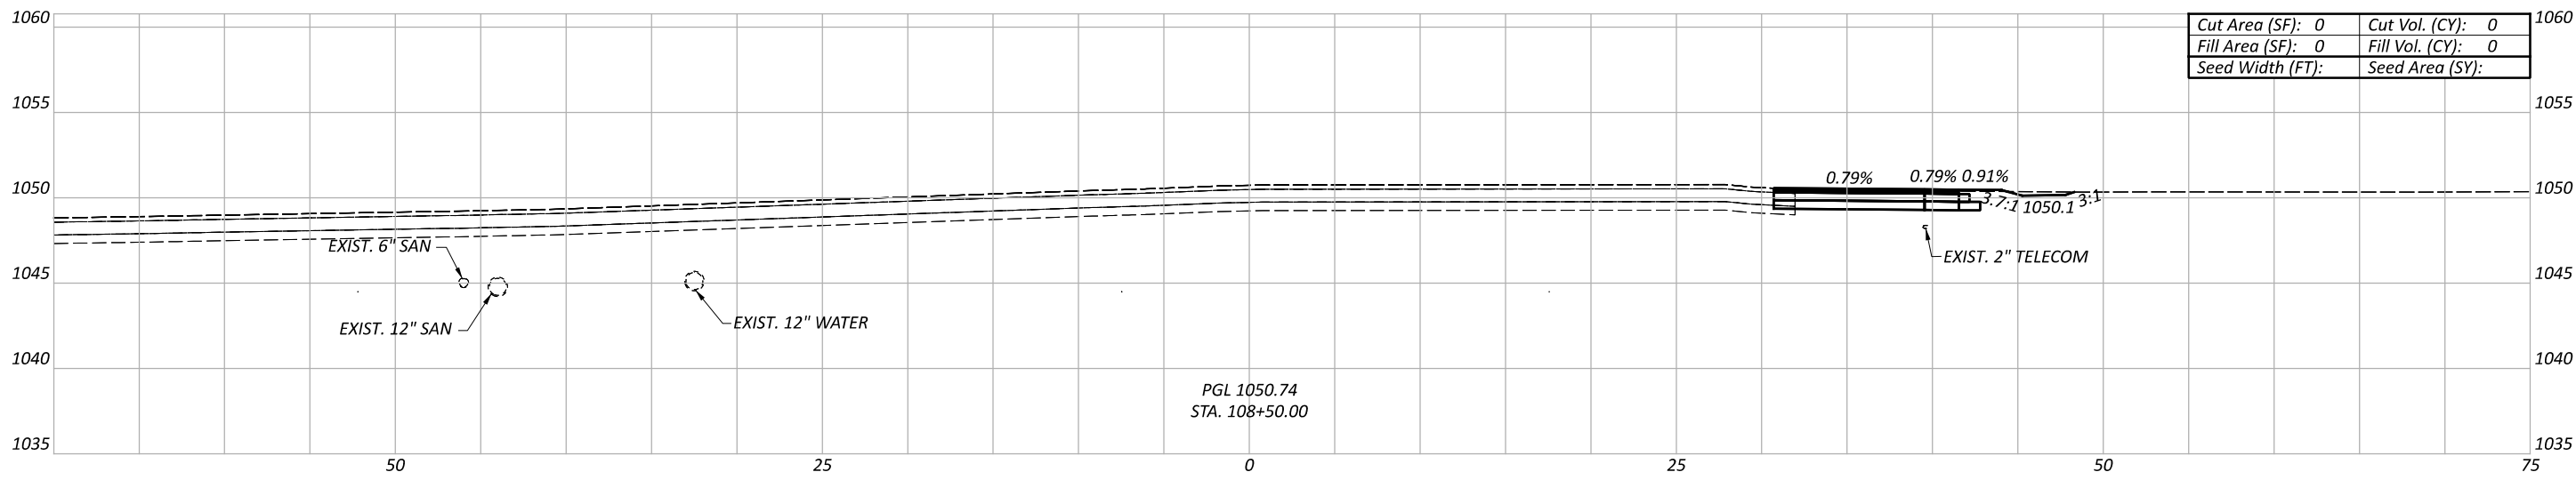

CROSS SECTIONS - PAVEMENT FOR M.O.T.
 SR 435 STA. 107+50 TO STA. 108+50

DESIGN AGENCY

Palmer
 ENGINEERING
 8350 E. KEMPER RD.
 SUITE B
 CINCINNATI, OH 45249
 513-469-1600

DESIGNER

DPF

REVIEWER


DCJ MM-DD-YY

PROJECT ID


117955

Sheet Totals		
Seeding	Cut	Fill


SHEET	TOTAL
P. 82	228

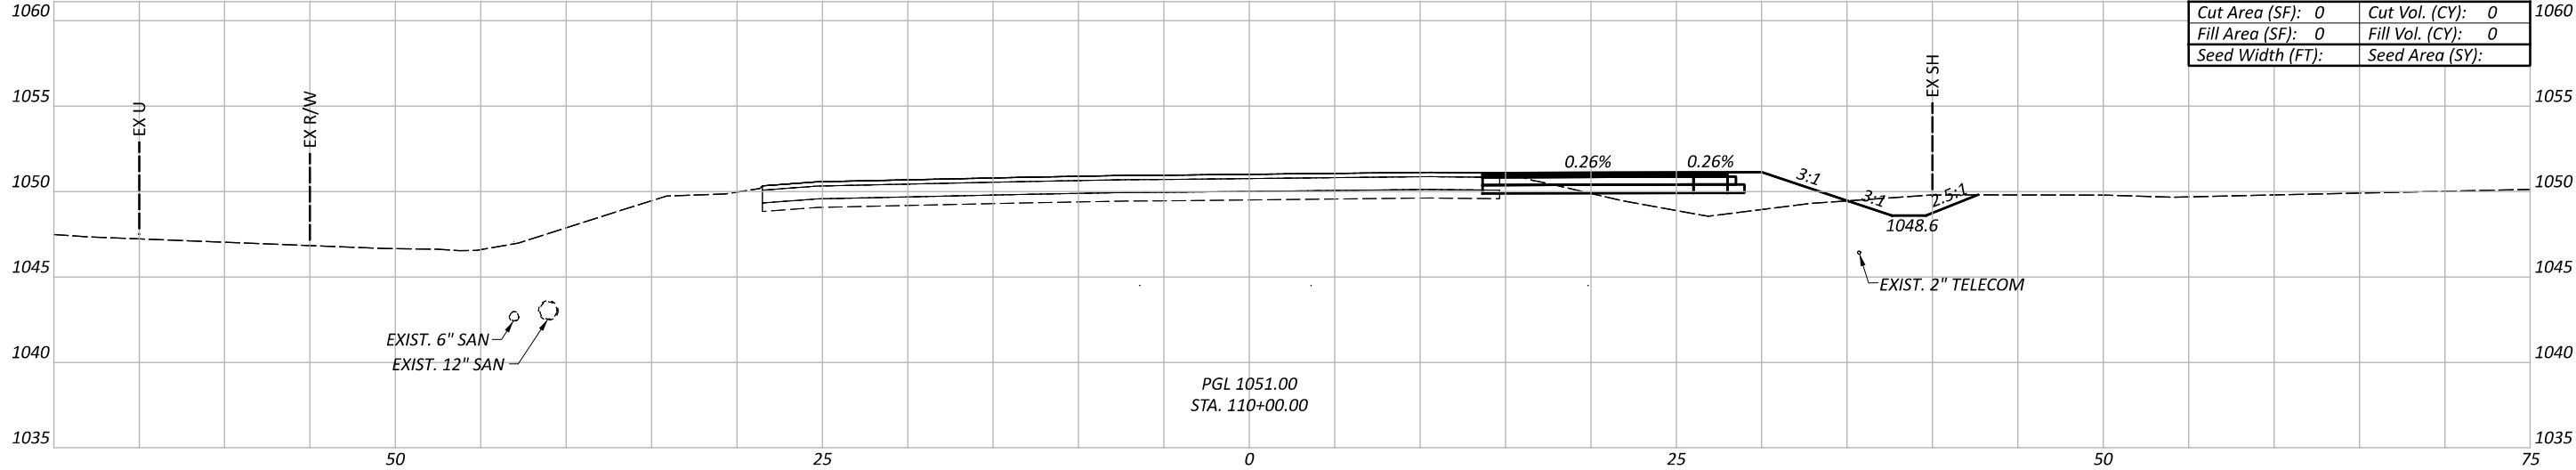

Cut Area (SF):	0	Cut Vol. (CY):	0
Fill Area (SF):	0	Fill Vol. (CY):	0
Seed Width (FT):		Seed Area (SY):	

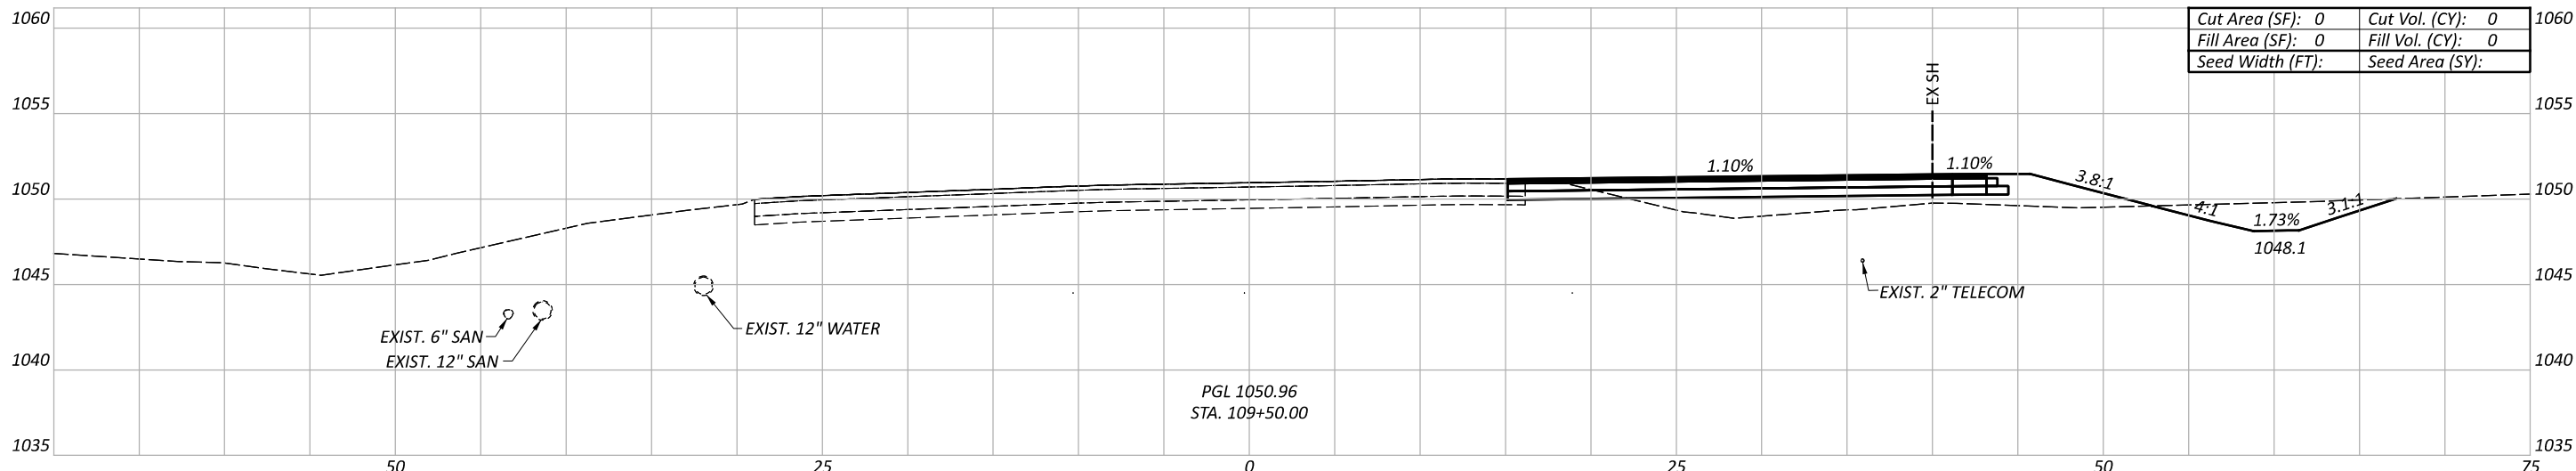

Cut Area (SF):	0	Cut Vol. (CY):	0
Fill Area (SF):	0	Fill Vol. (CY):	0
Seed Width (FT):		Seed Area (SY):	

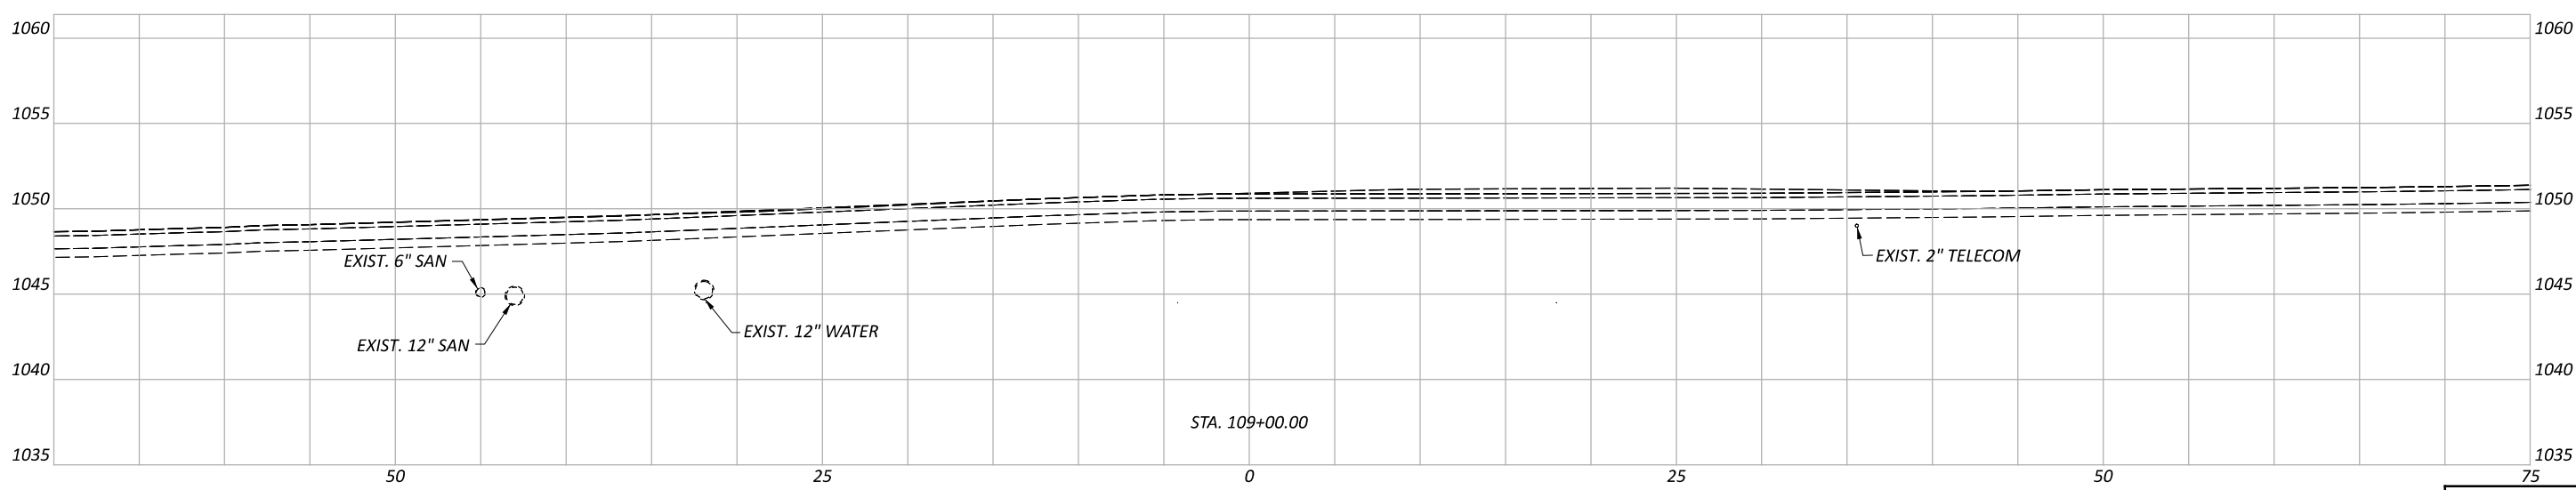


Sheet Totals			117955
Seeding	Cut	Fill	TOTAL
			P. 83 228

CROSS SECTIONS - PAVEMENT FOR M.O.T.
 SR 435 STA. 109+00 TO STA. 110+00


DESIGN AGENCY
Palmer
 ENGINEERING
 8350 E. KEMPER RD.
 SUITE B
 CINCINNATI, OH 45249
 513-469-1600

DESIGNER
 DPF
 REVIEWER
 DCJ MM-DD-YY


PROJECT ID
 117955

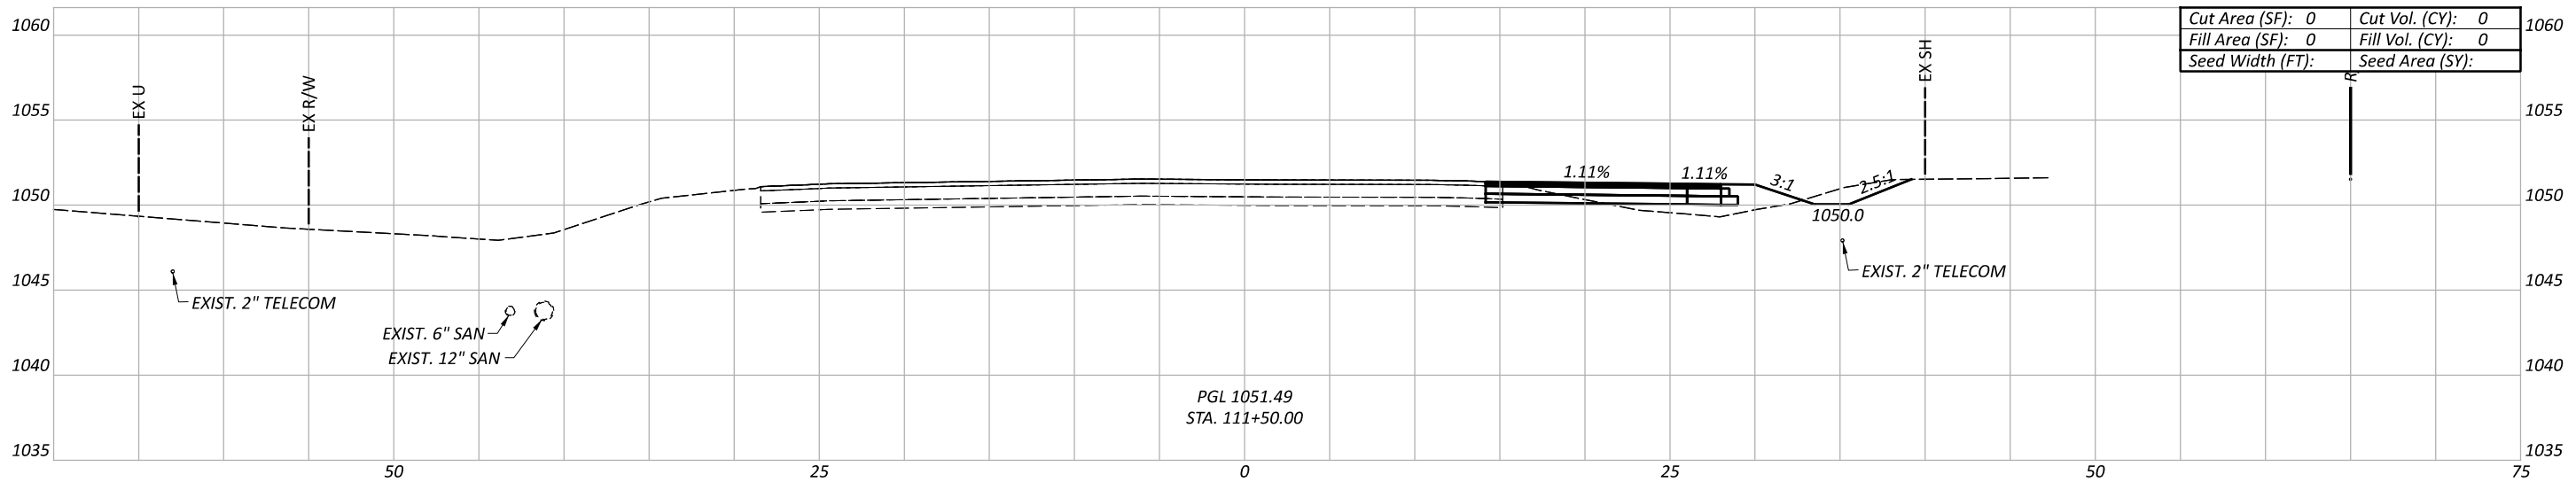

Cut Area (SF):	0	Cut Vol. (CY):	0
Fill Area (SF):	0	Fill Vol. (CY):	0
Seed Width (FT):		Seed Area (SY):	

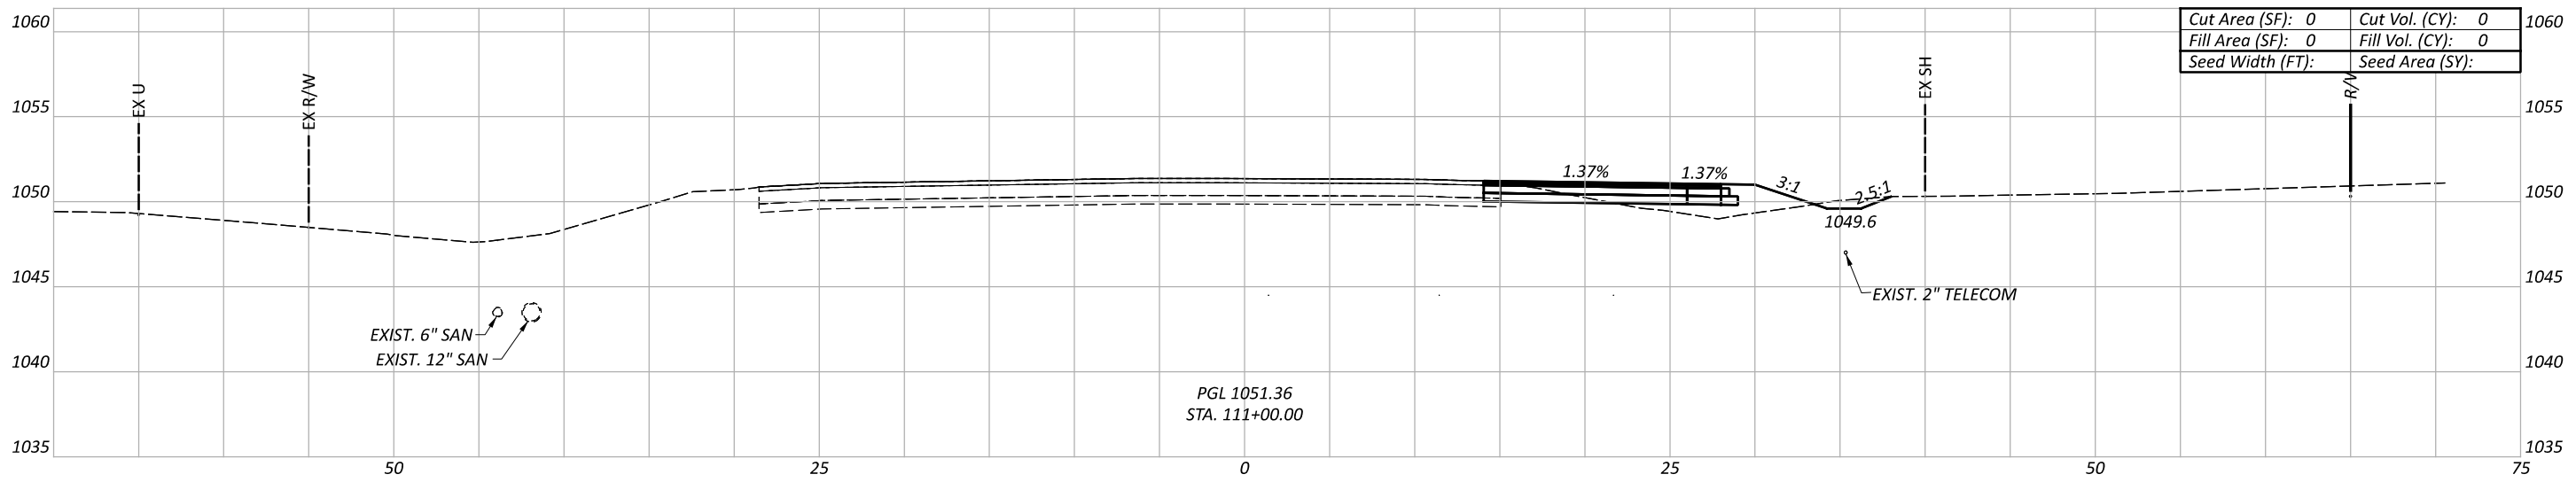

Cut Area (SF):	0	Cut Vol. (CY):	0
Fill Area (SF):	0	Fill Vol. (CY):	0
Seed Width (FT):		Seed Area (SY):	

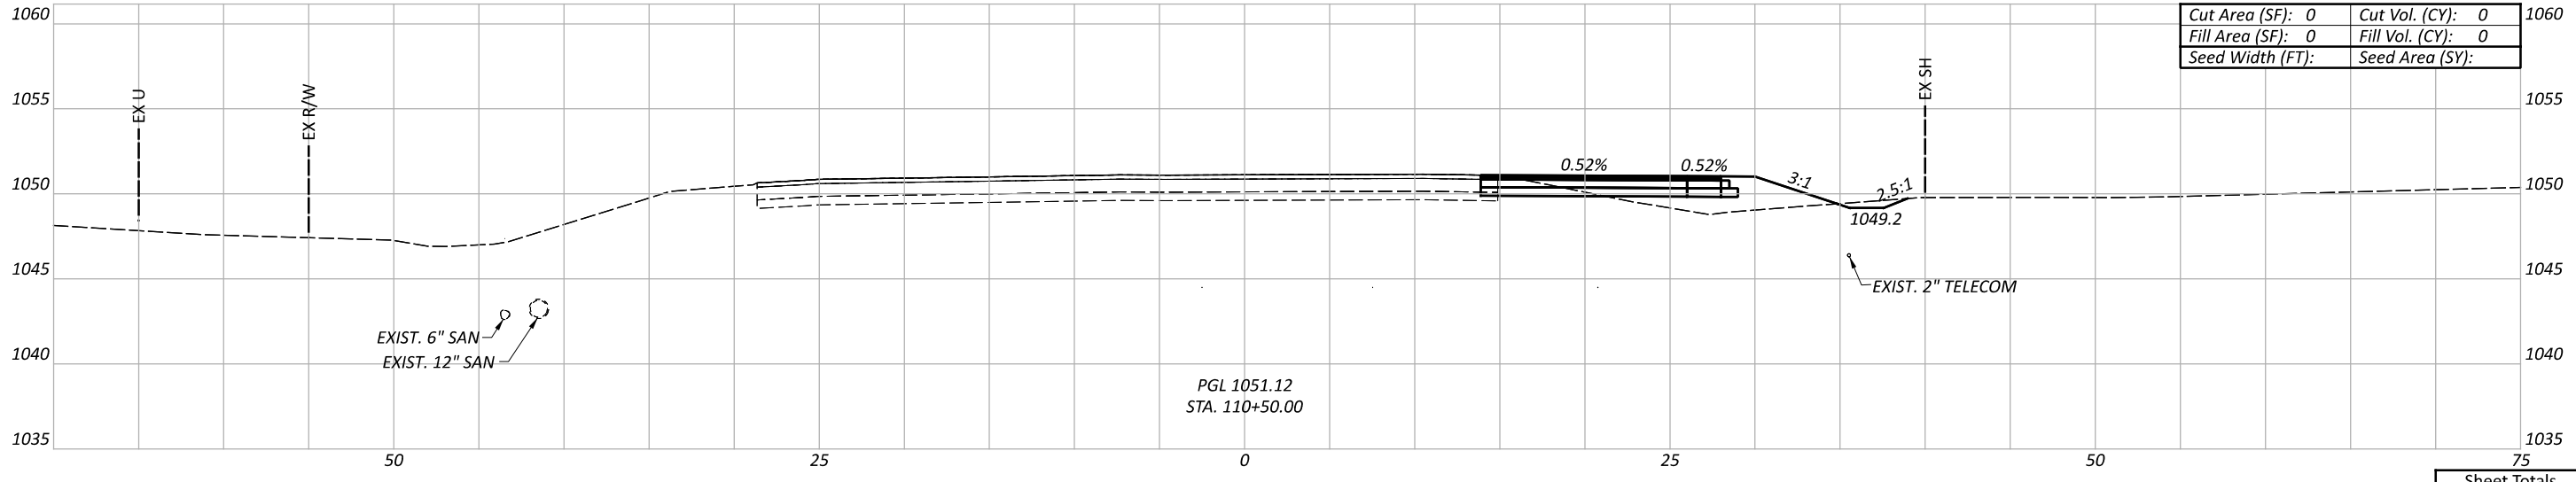

Cut Area (SF):	0	Cut Vol. (CY):	0
Fill Area (SF):	0	Fill Vol. (CY):	0
Seed Width (FT):		Seed Area (SY):	

CROSS SECTIONS - PAVEMENT FOR M.O.T.
 SR 435 STA. 110+50 TO STA. 111+50

DESIGN AGENCY






DESIGNER
 DPF

REVIEWER
 DCJ MM-DD-YY


PROJECT ID
 117955


Sheet Totals			117955
Seeding	Cut	Fill	TOTAL
			P. 84 228

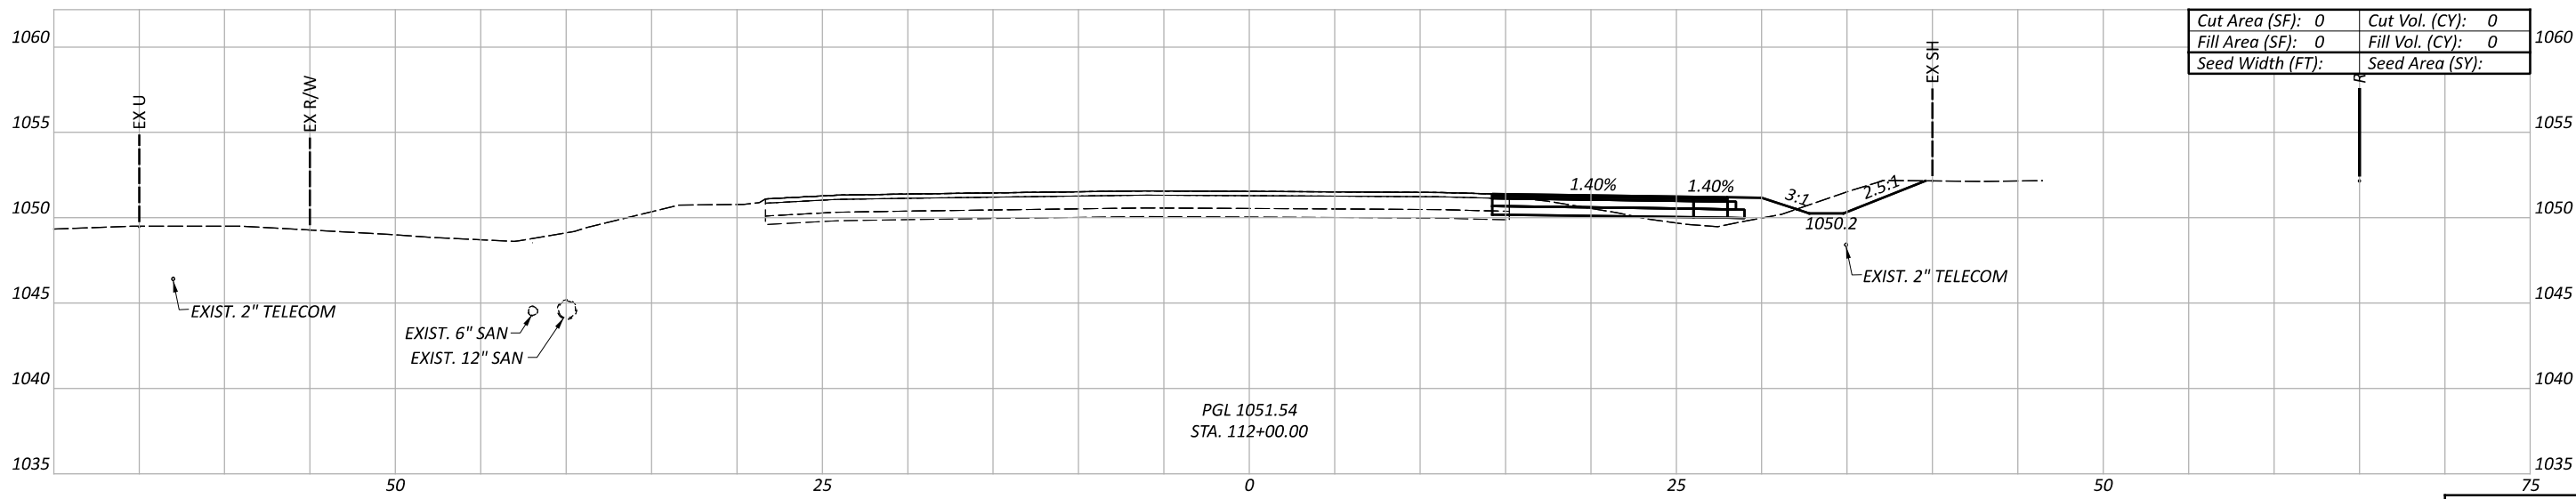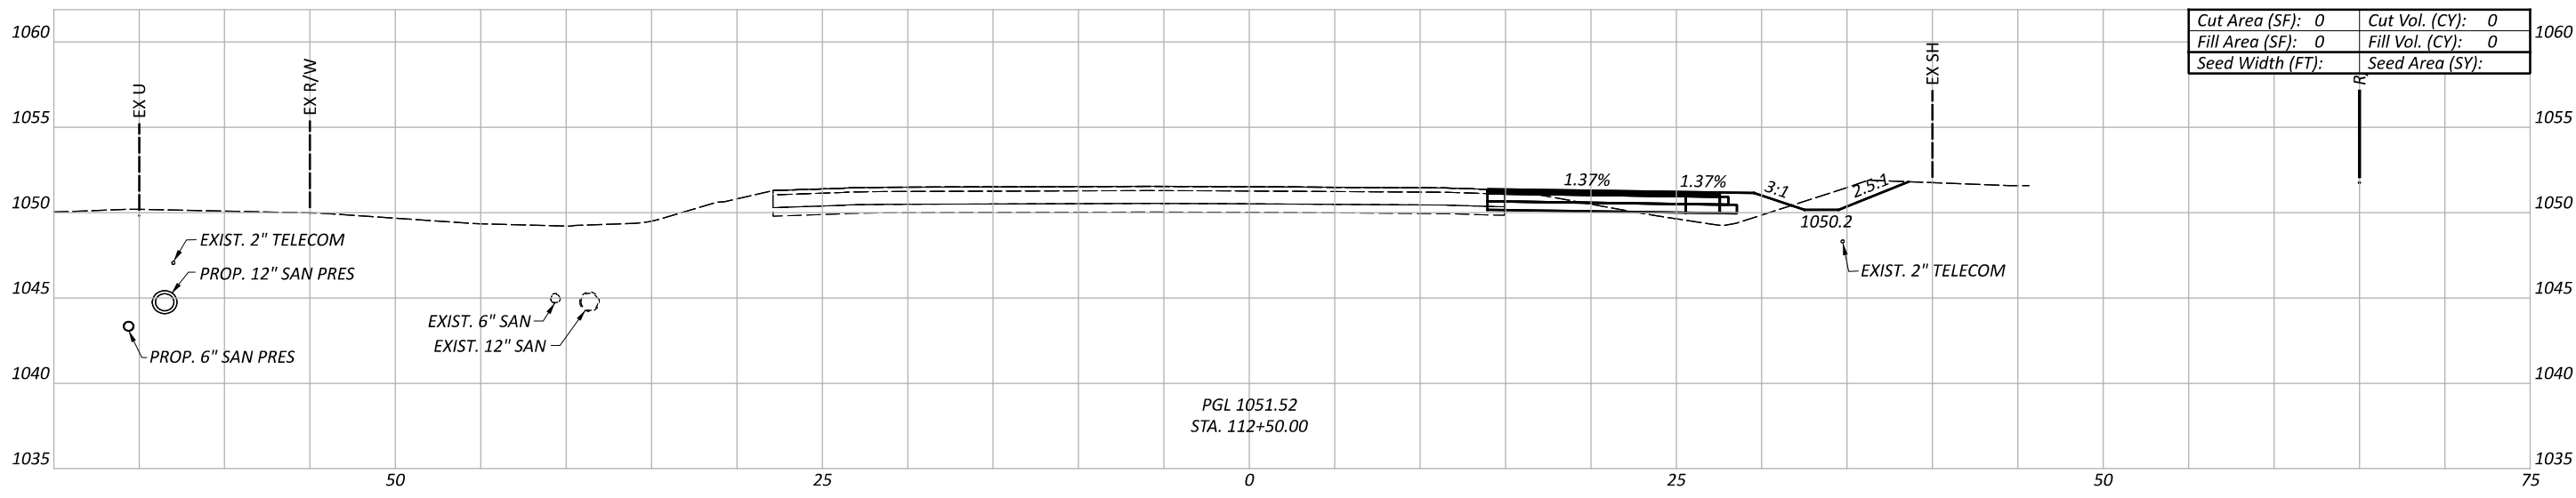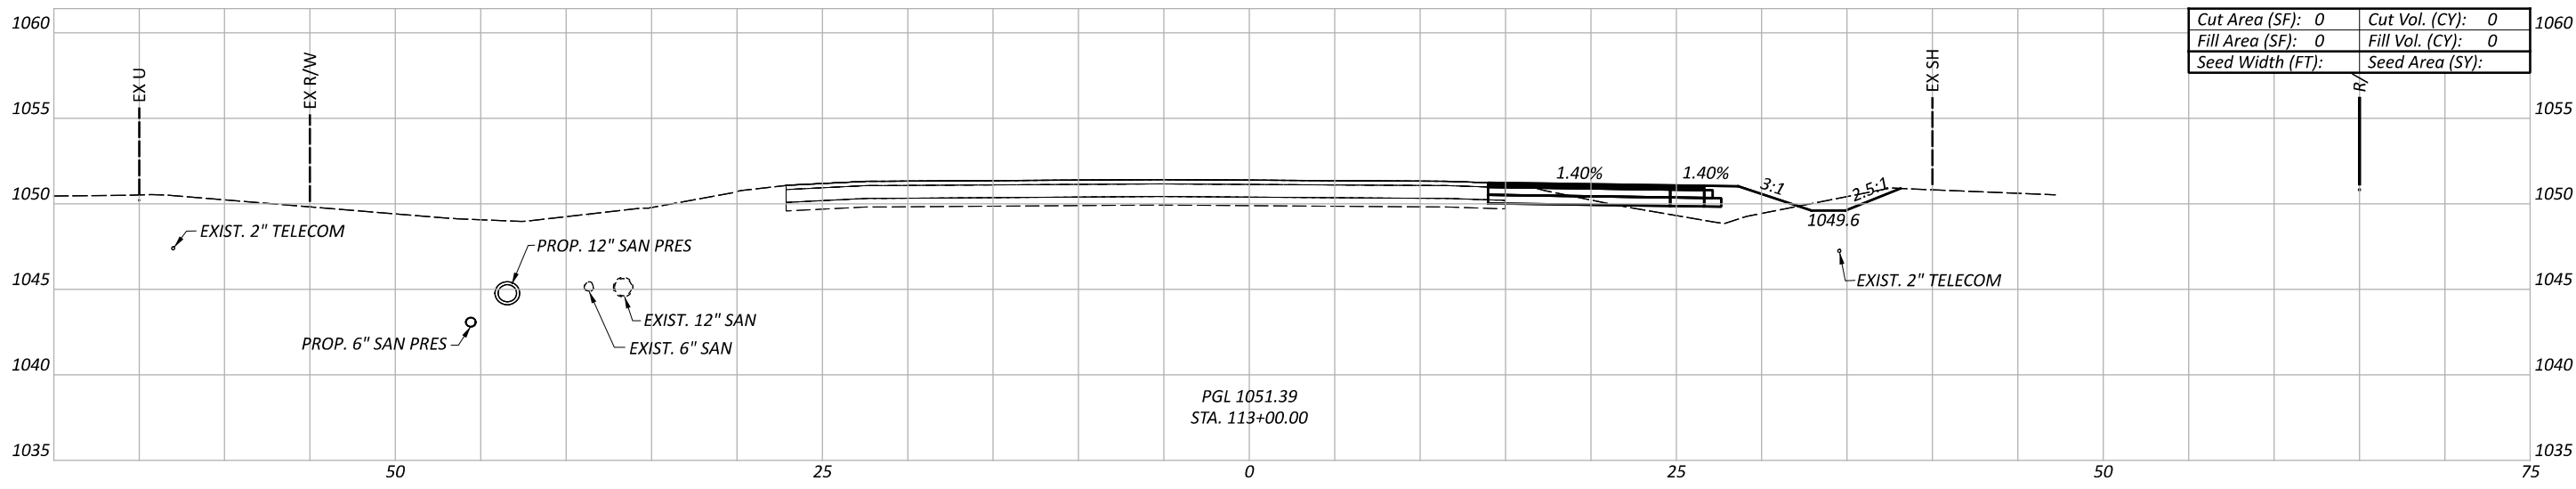


Sheet Totals			117955
Seeding	Cut	Fill	SHEET TOTAL
			P. 85 228

CROSS SECTIONS - PAVEMENT FOR M.O.T.
SR 435 STA. 112+00 TO STA. 113+00


DESIGN AGENCY

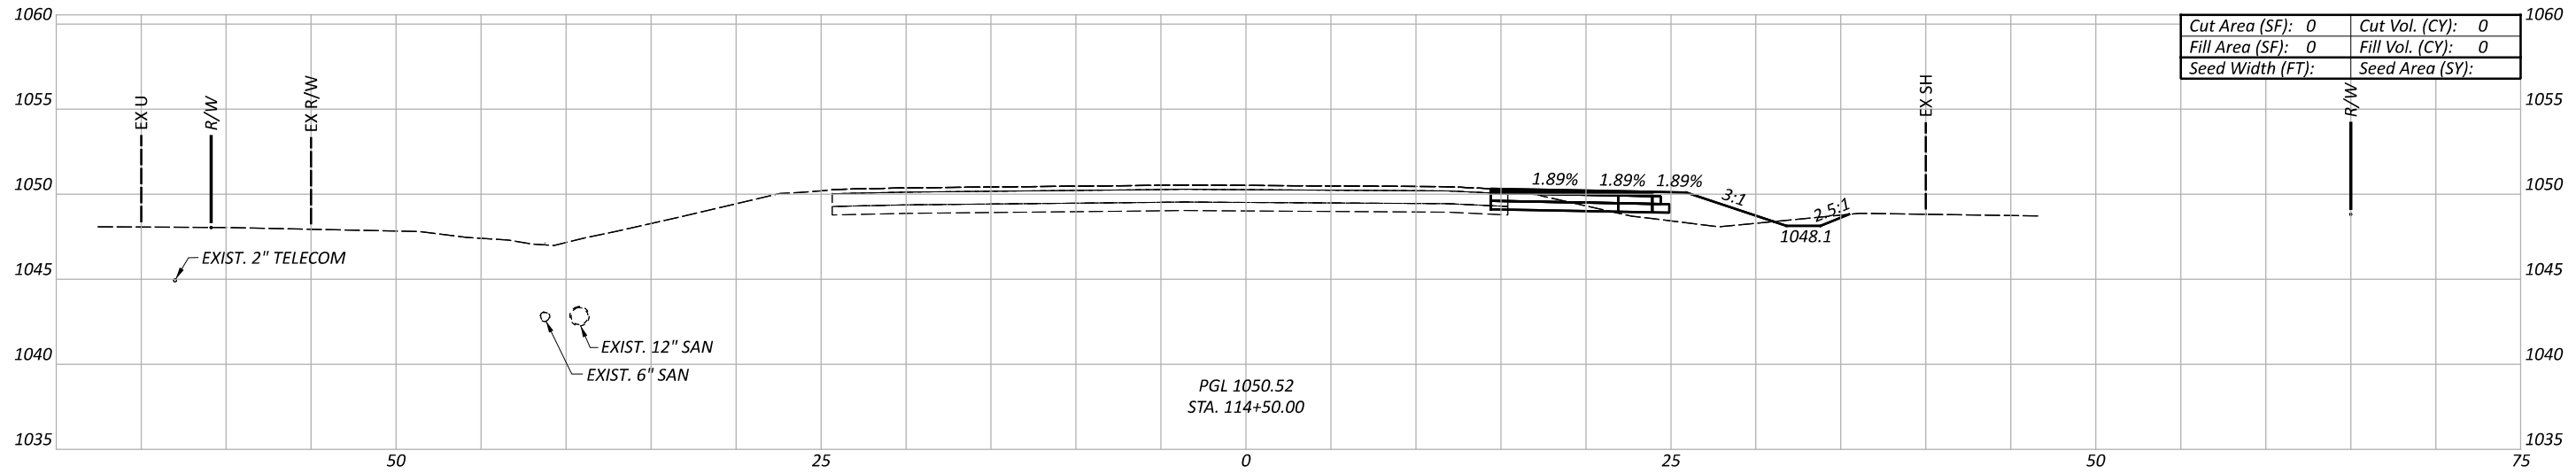 8350 E. KEMPER RD.
 SUITE B
 CINCINNATI, OH 45249
 513-469-1600
 DESIGNER
 DPF
 REVIEWER
 DCJ MM-DD-YY
 PROJECT ID
 117955

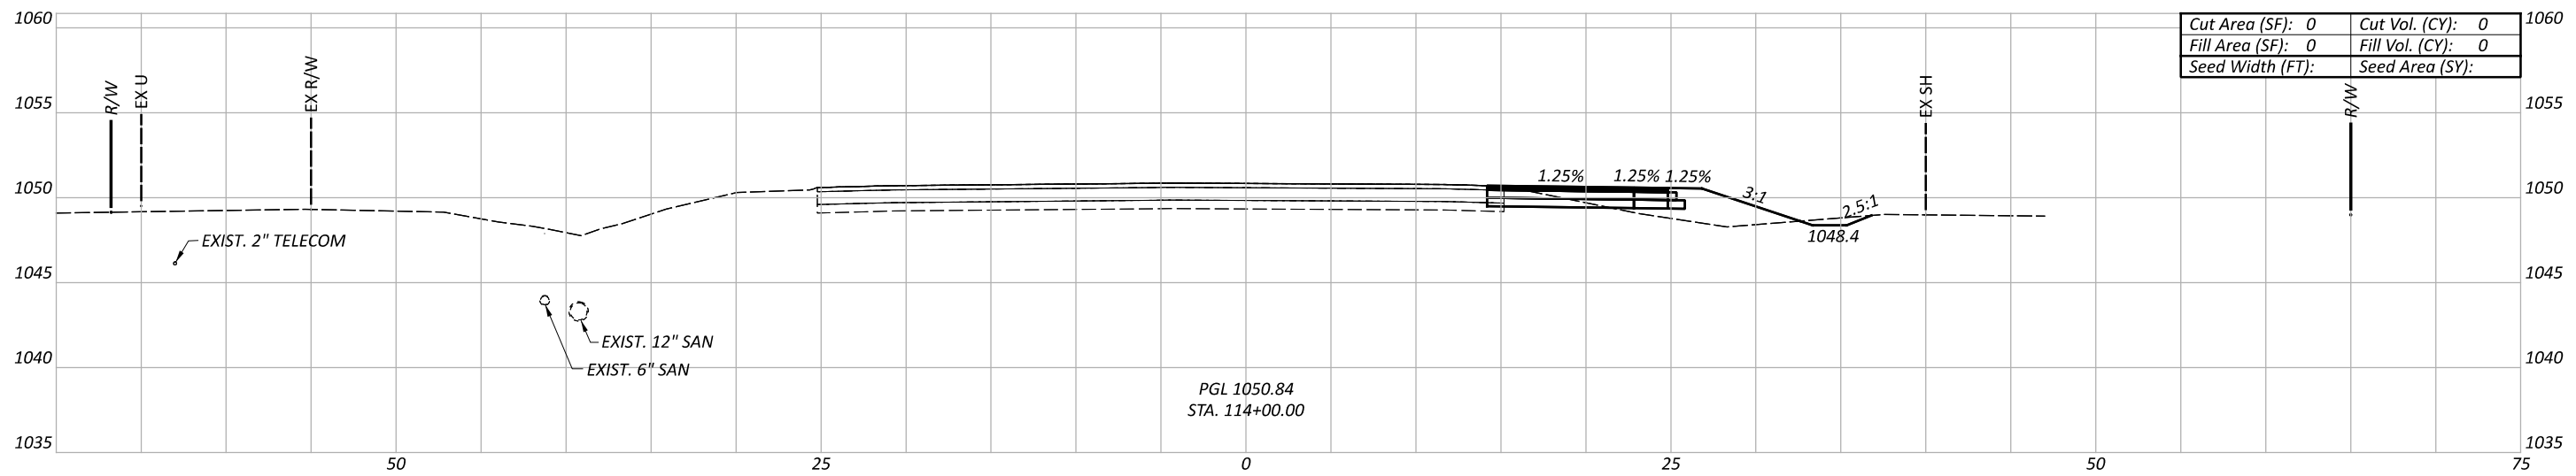

Cut Area (SF): 0	Cut Vol. (CY): 0
Fill Area (SF): 0	Fill Vol. (CY): 0
Seed Width (FT):	Seed Area (SY):

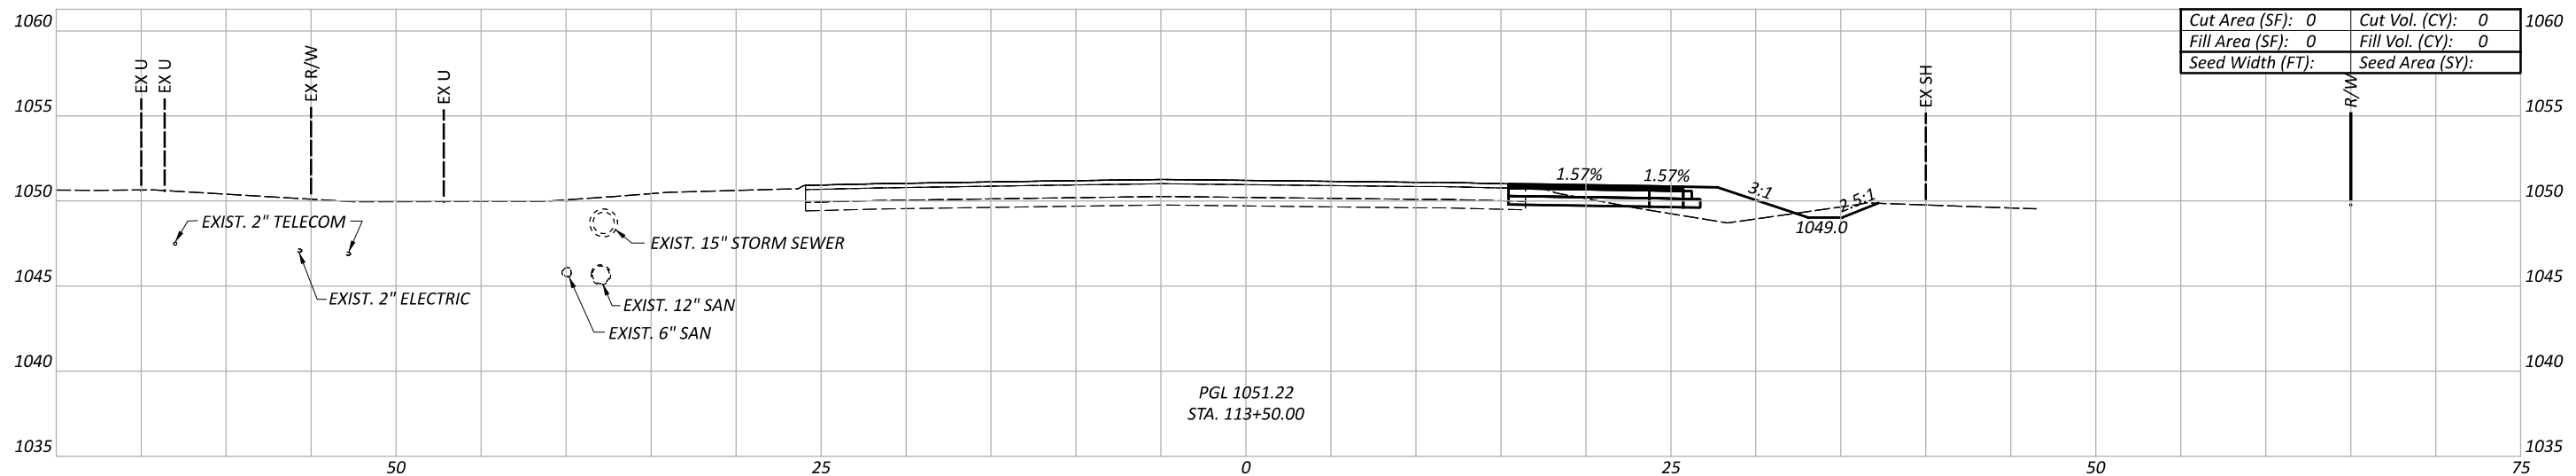

Cut Area (SF): 0	Cut Vol. (CY): 0
Fill Area (SF): 0	Fill Vol. (CY): 0
Seed Width (FT):	Seed Area (SY):



Cut Area (SF): 0	Cut Vol. (CY): 0
Fill Area (SF): 0	Fill Vol. (CY): 0
Seed Width (FT):	Seed Area (SY):

CROSS SECTIONS - PAVEMENT FOR M.O.T.
 SR 435 STA. 113+50 TO STA. 114+50

DESIGN AGENCY

Palmer
 ENGINEERING
 8350 E. KEMPER RD.
 SUITE B
 CINCINNATI, OH 45249
 513-469-1600

DESIGNER

DPF


REVIEWER

DCJ MM-DD-YY


PROJECT ID

117955


Sheet Totals			TOTAL	
Seeding	Cut	Fill	P. 86	228

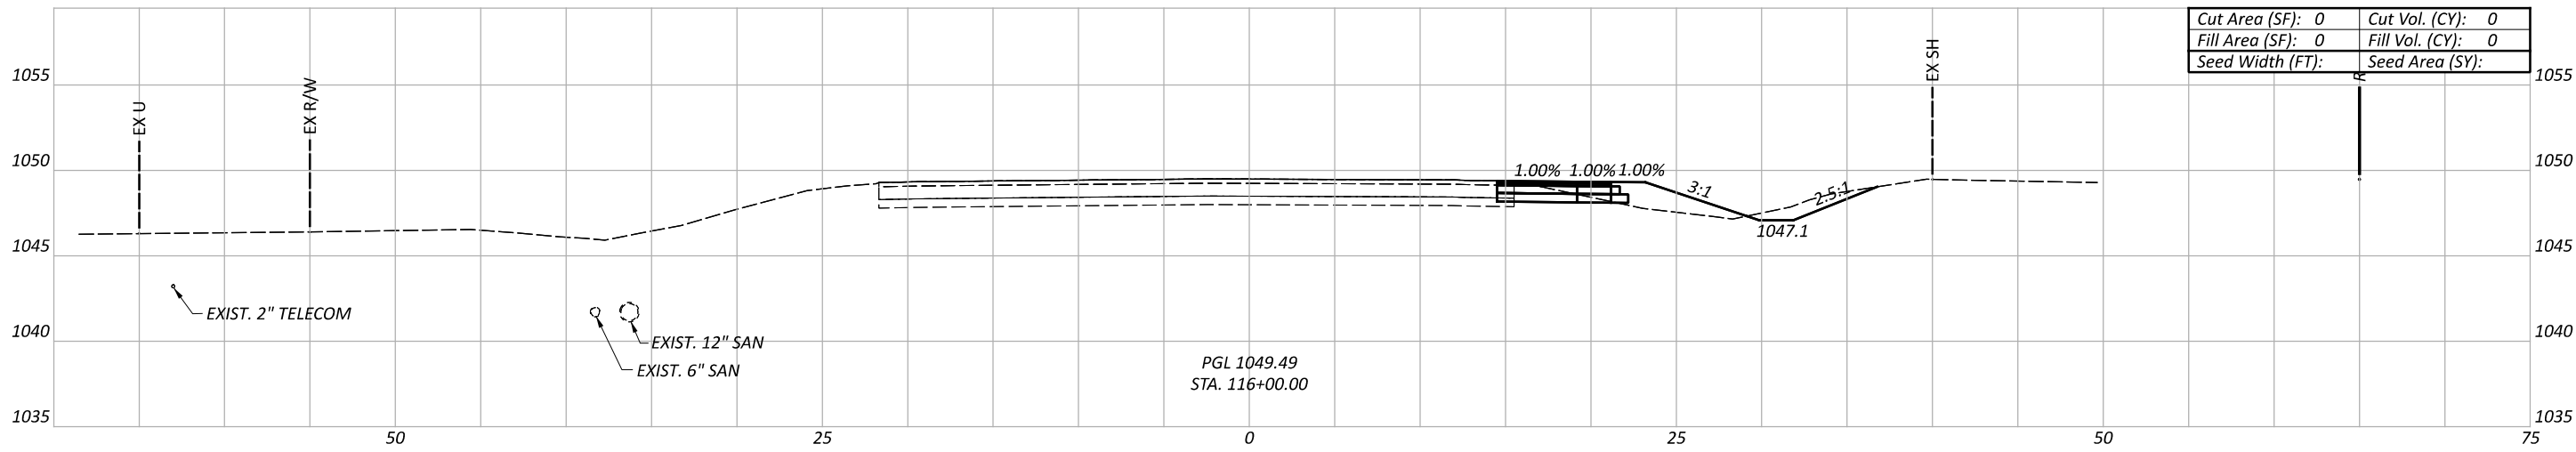

Cut Area (SF):	0	Cut Vol. (CY):	0
Fill Area (SF):	0	Fill Vol. (CY):	0
Seed Width (FT):		Seed Area (SY):	

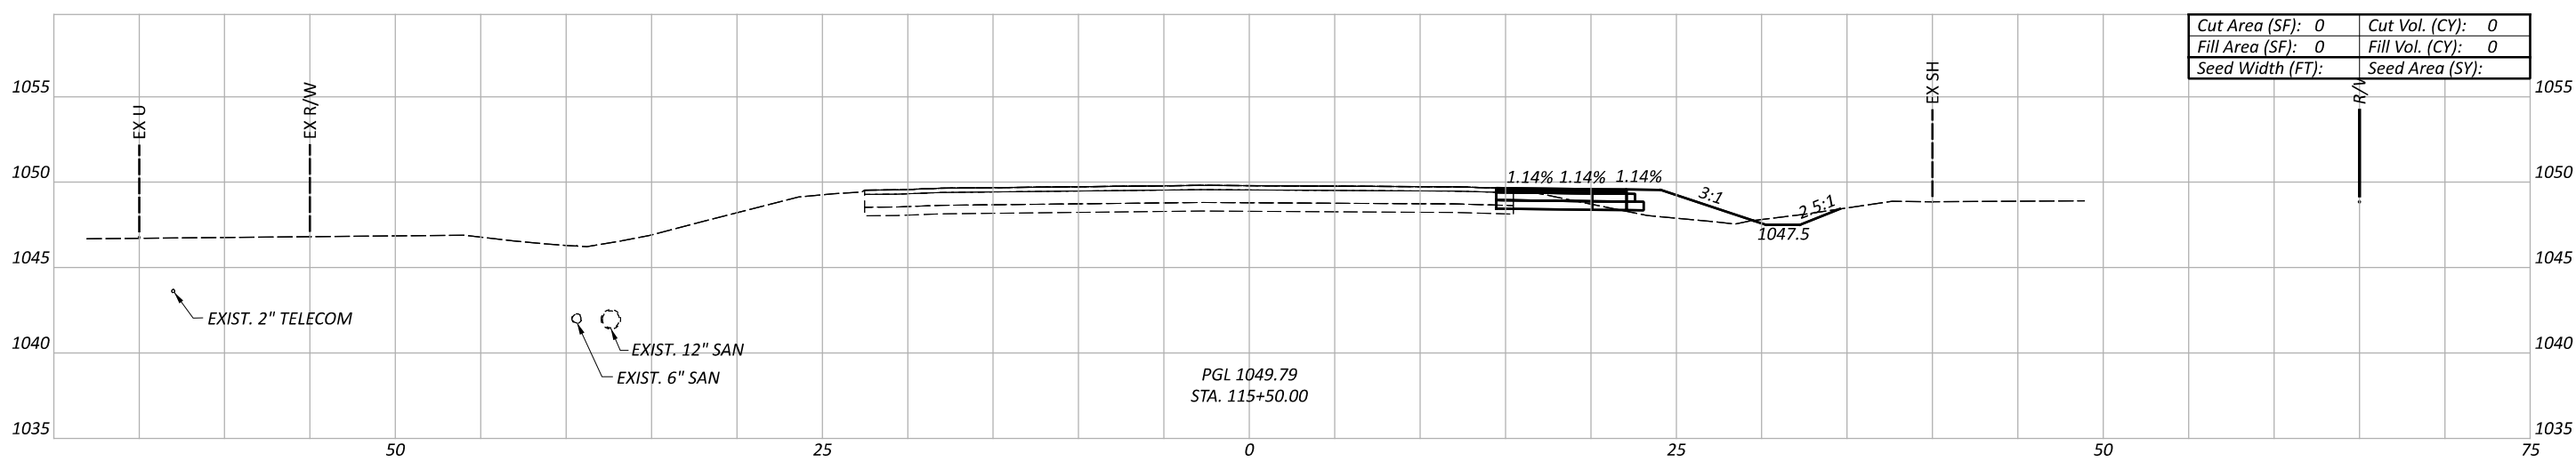

Cut Area (SF):	0	Cut Vol. (CY):	0
Fill Area (SF):	0	Fill Vol. (CY):	0
Seed Width (FT):		Seed Area (SY):	

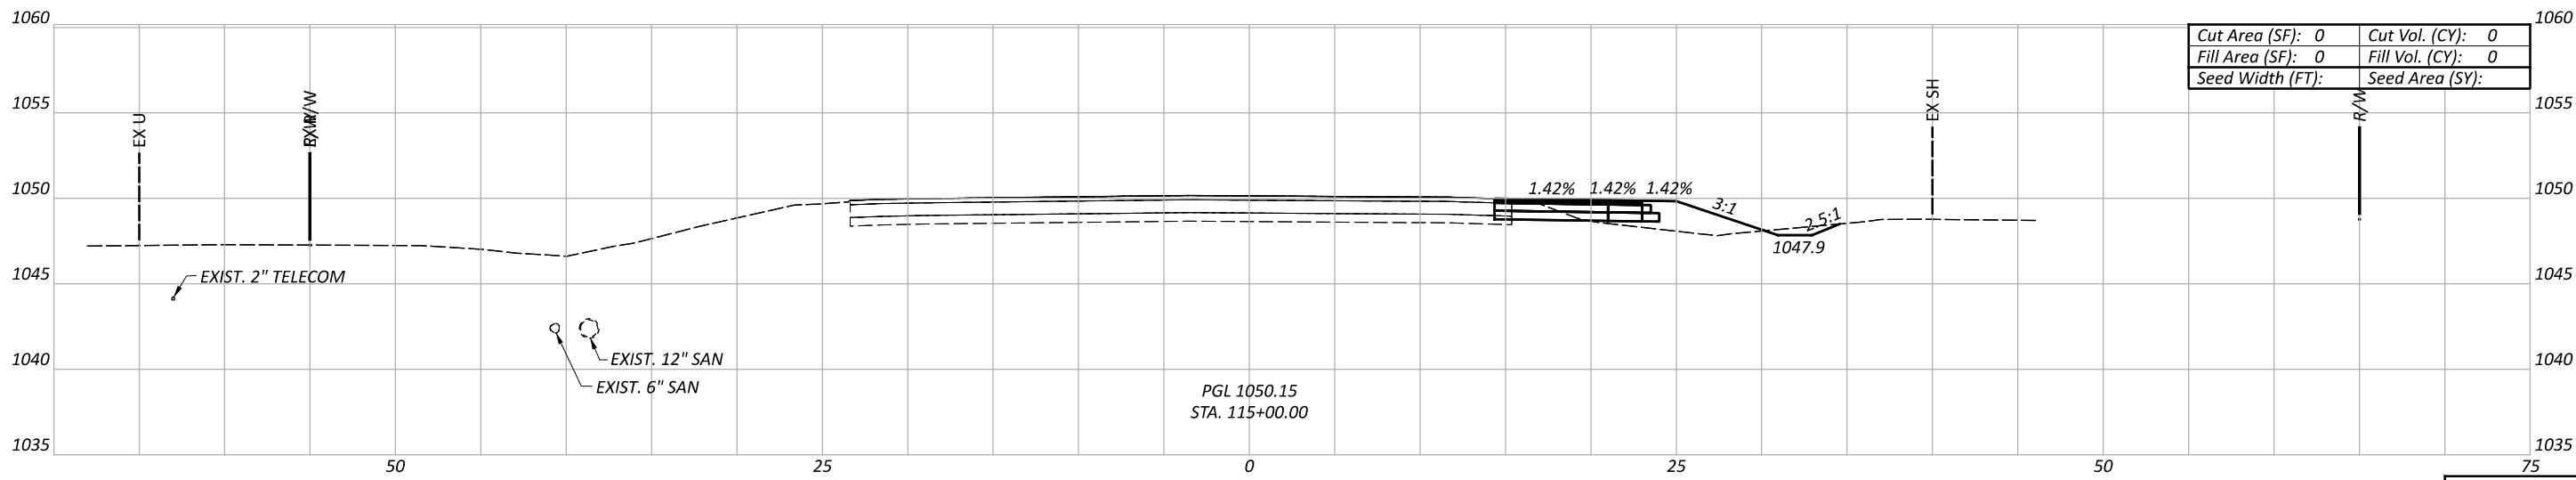

Cut Area (SF):	0	Cut Vol. (CY):	0
Fill Area (SF):	0	Fill Vol. (CY):	0
Seed Width (FT):		Seed Area (SY):	

CROSS SECTIONS - PAVEMENT FOR M.O.T.
 SR 435 STA. 115+00 TO STA. 116+00

DESIGN AGENCY

 8350 E. KEMPER RD.
 SUITE B
 CINCINNATI, OH 45249
 513-469-1600


DESIGNER
 DPF

REVIEWER
 DCJ MM-DD-YY


PROJECT ID
 117955

Sheet Totals		
Seeding	Cut	Fill


SHEET TOTAL
 P. 87 | 228

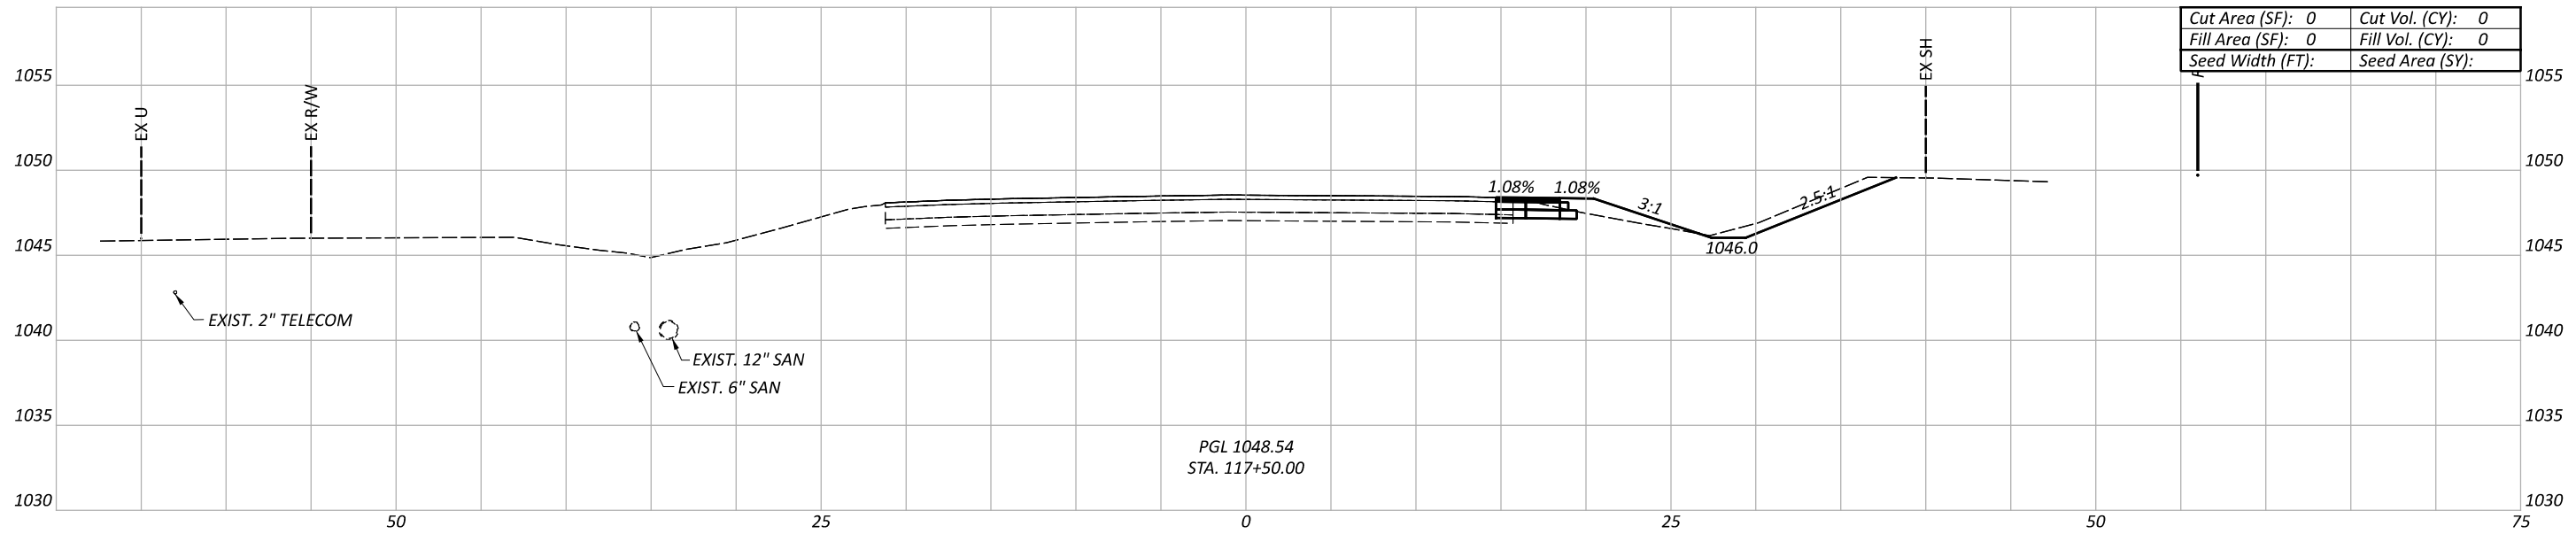

Cut Area (SF):	0	Cut Vol. (CY):	0
Fill Area (SF):	0	Fill Vol. (CY):	0
Seed Width (FT):		Seed Area (SY):	

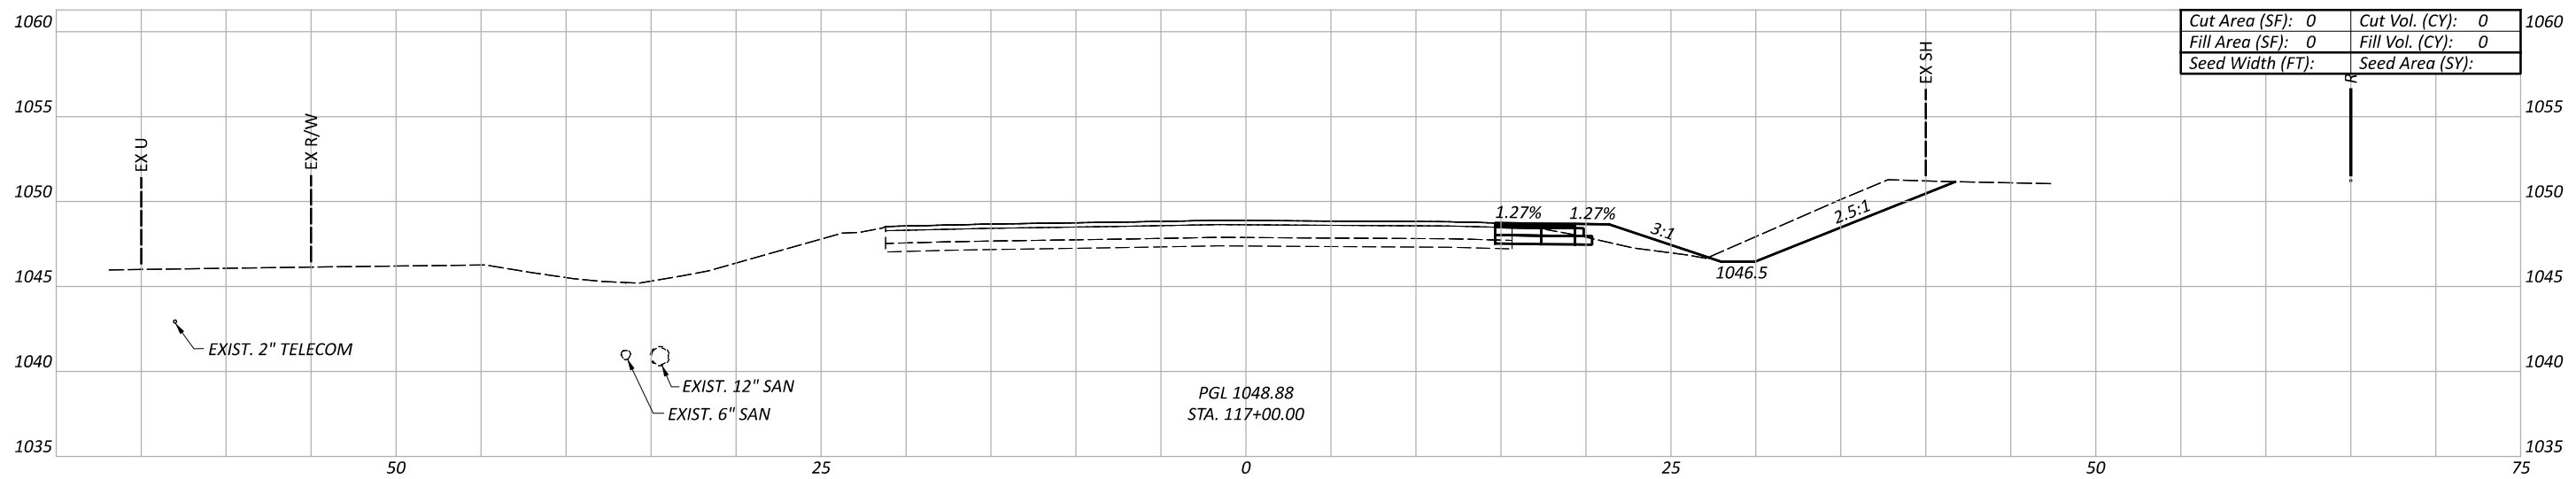

Cut Area (SF):	0	Cut Vol. (CY):	0
Fill Area (SF):	0	Fill Vol. (CY):	0
Seed Width (FT):		Seed Area (SY):	

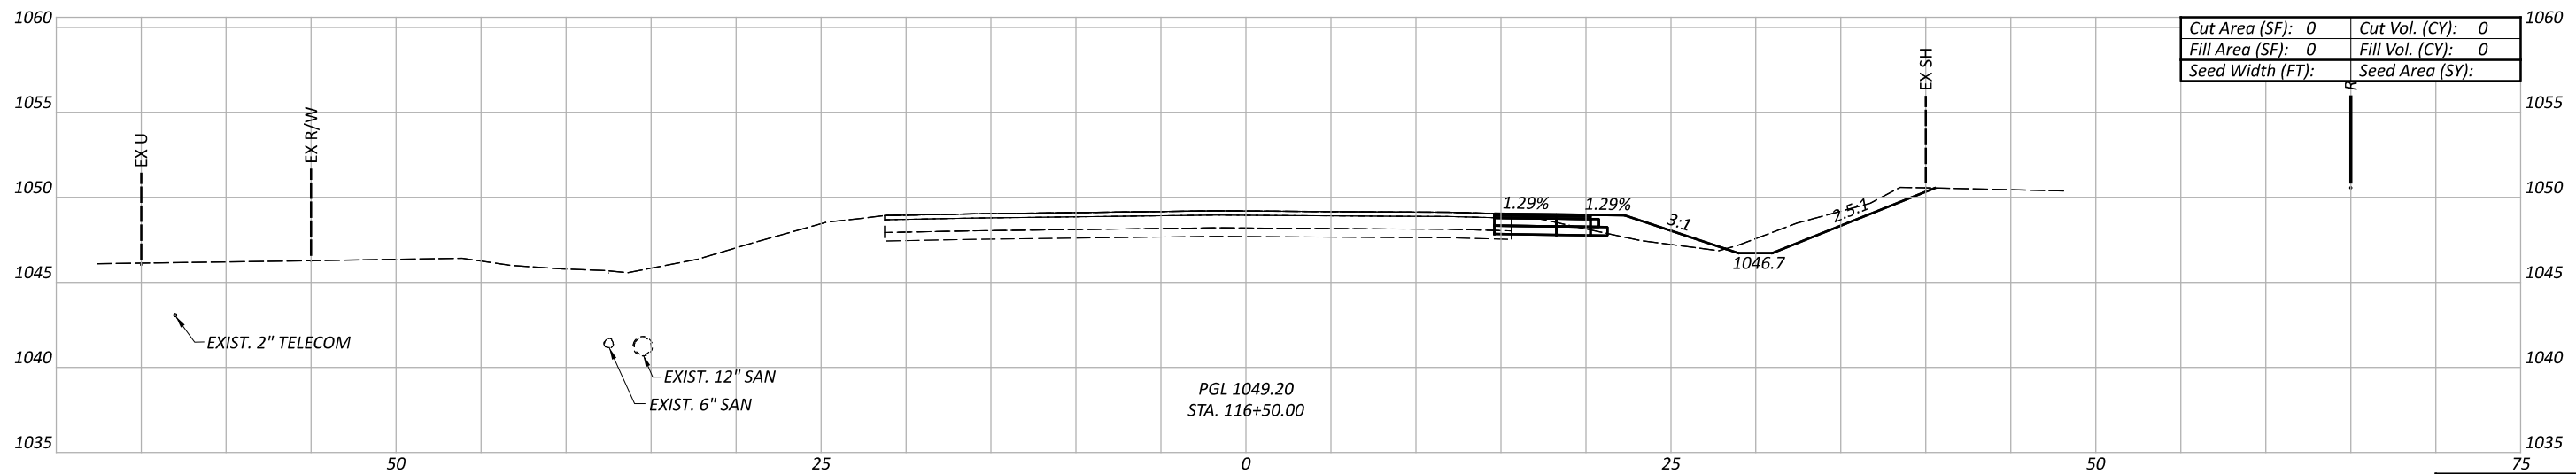

Cut Area (SF):	0	Cut Vol. (CY):	0
Fill Area (SF):	0	Fill Vol. (CY):	0
Seed Width (FT):		Seed Area (SY):	

CROSS SECTIONS - PAVEMENT FOR M.O.T.
 SR 435 STA. 116+50 TO STA. 117+50

DESIGN AGENCY



DESIGNER

DPF




REVIEWER

DCJ MM-DD-YY

PROJECT ID

117955

Sheet Totals			117955	
Seeding	Cut	Fill	SHEET	TOTAL
			P. 88	228

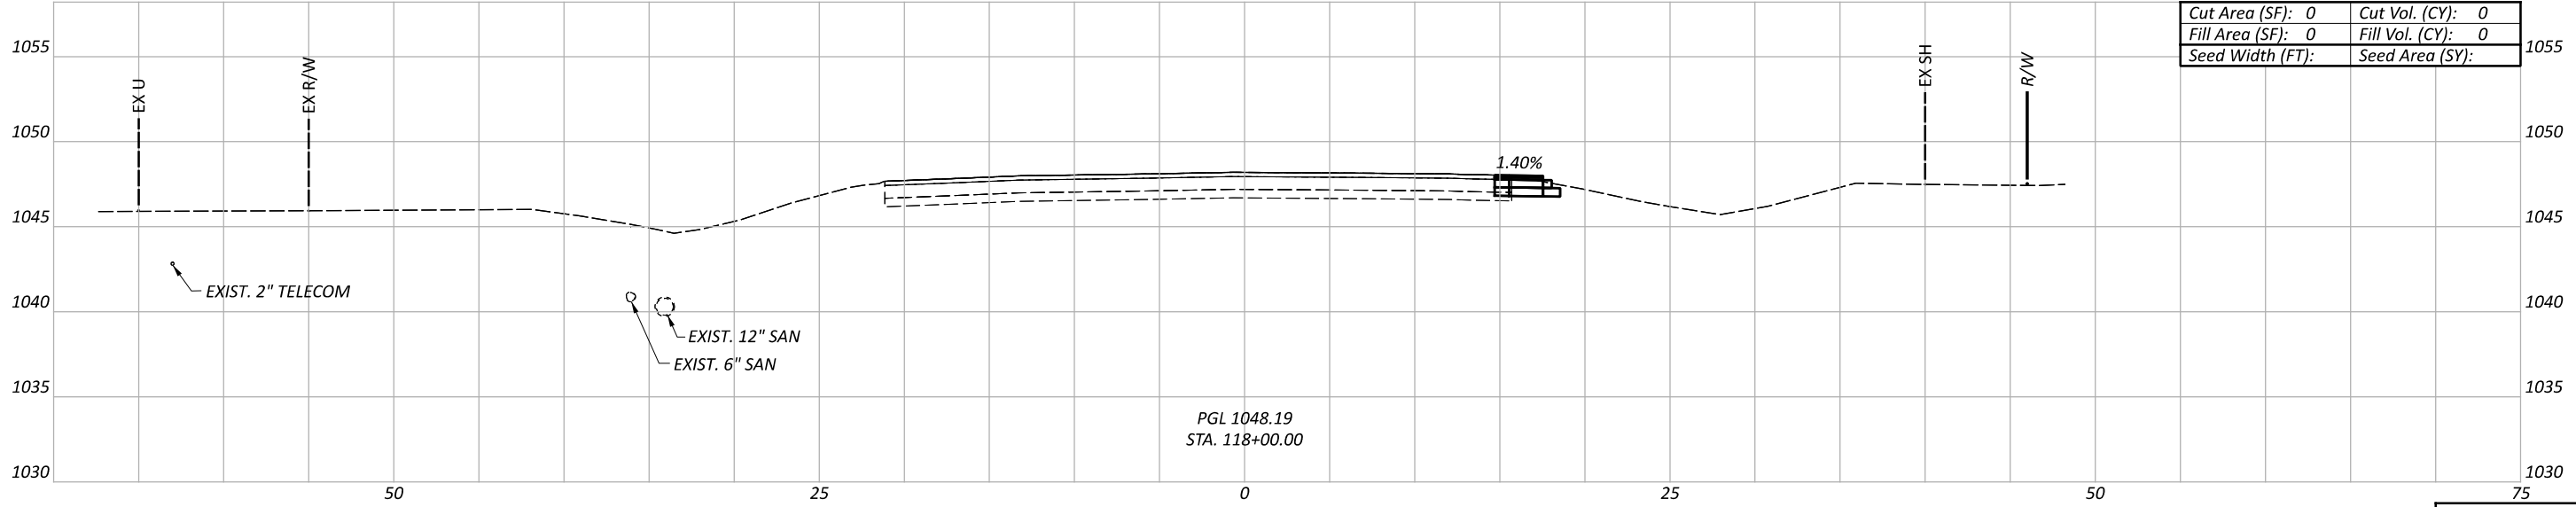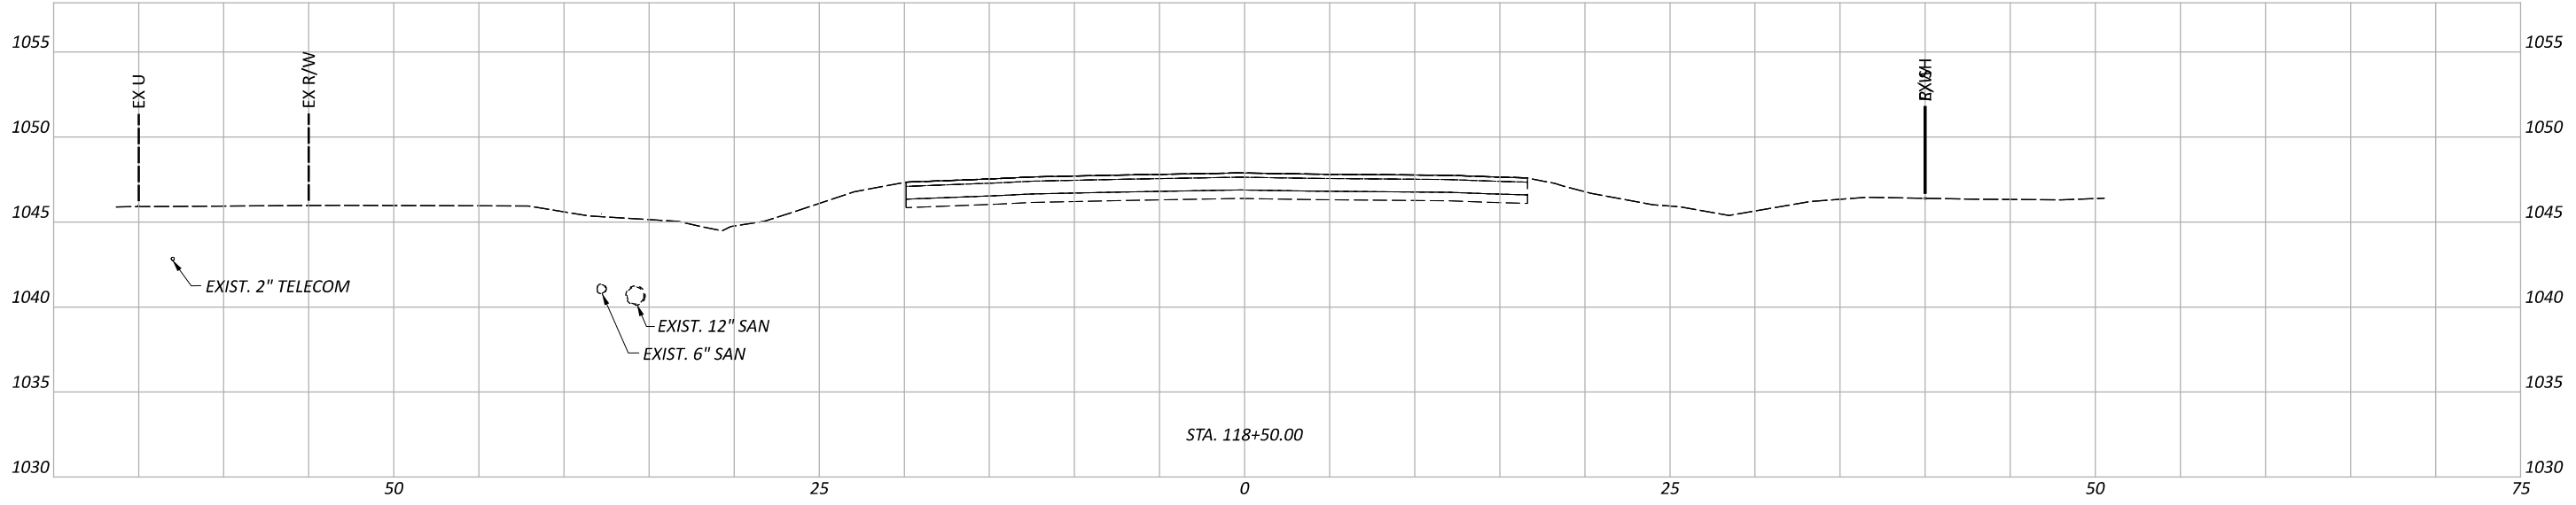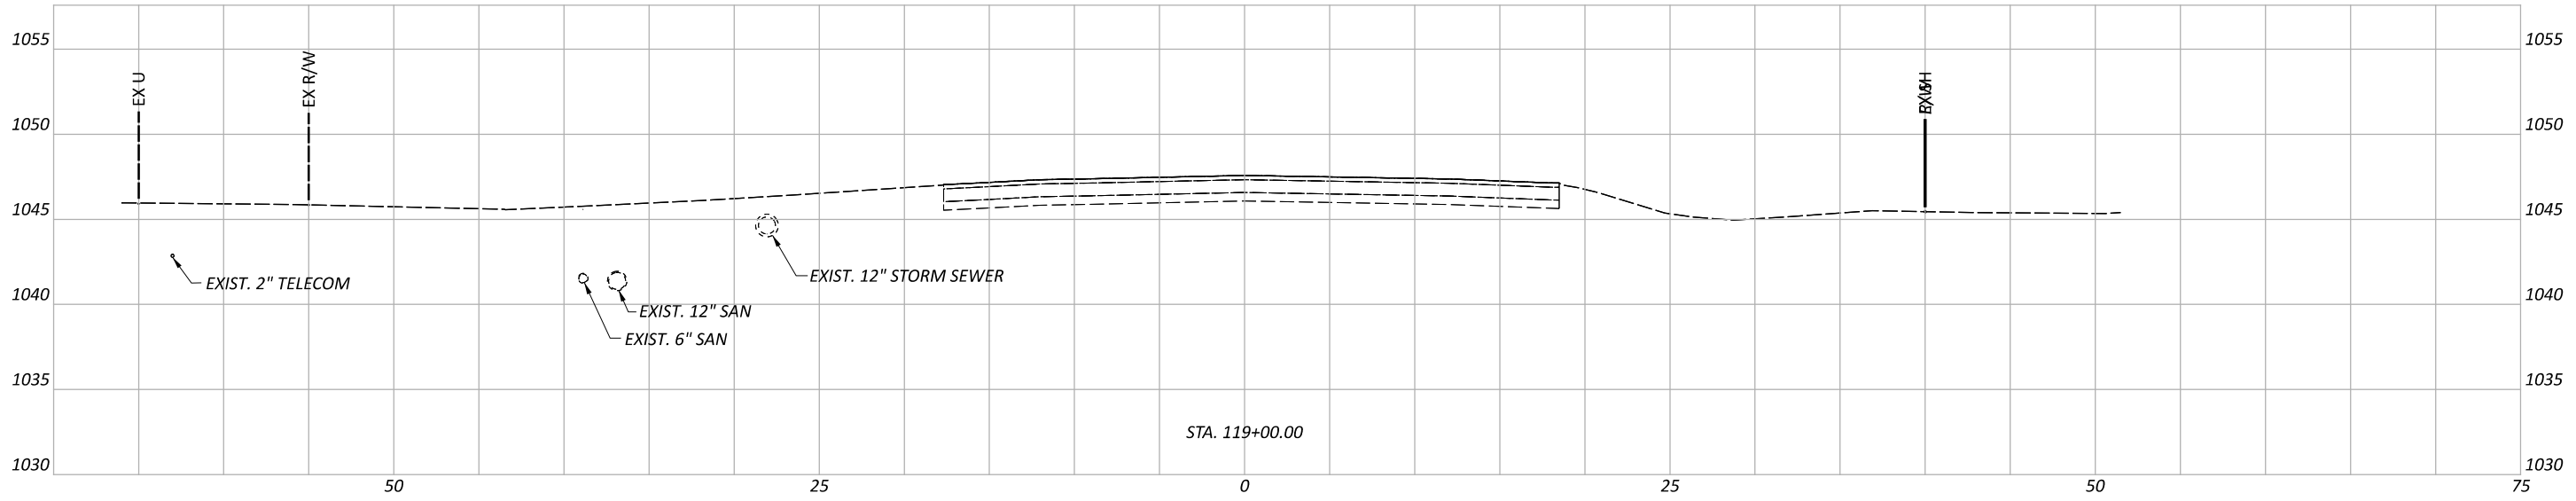

Cut Area (SF):	0	Cut Vol. (CY):	0
Fill Area (SF):	0	Fill Vol. (CY):	0
Seed Width (FT):		Seed Area (SY):	

CROSS SECTIONS - PAVEMENT FOR M.O.T.
 SR 435 STA. 118+00 TO STA. 119+00



DESIGN AGENCY
Palmer
 ENGINEERING
 8350 E. KEMPER RD.
 SUITE B
 CINCINNATI, OH 45249
 513-469-1600

DESIGNER
 DPF

REVIEWER
 DCJ MM-DD-YY

PROJECT ID
 117955

Sheet Totals			117955	
Seeding	Cut	Fill	SHEET	TOTAL
			P. 89	228

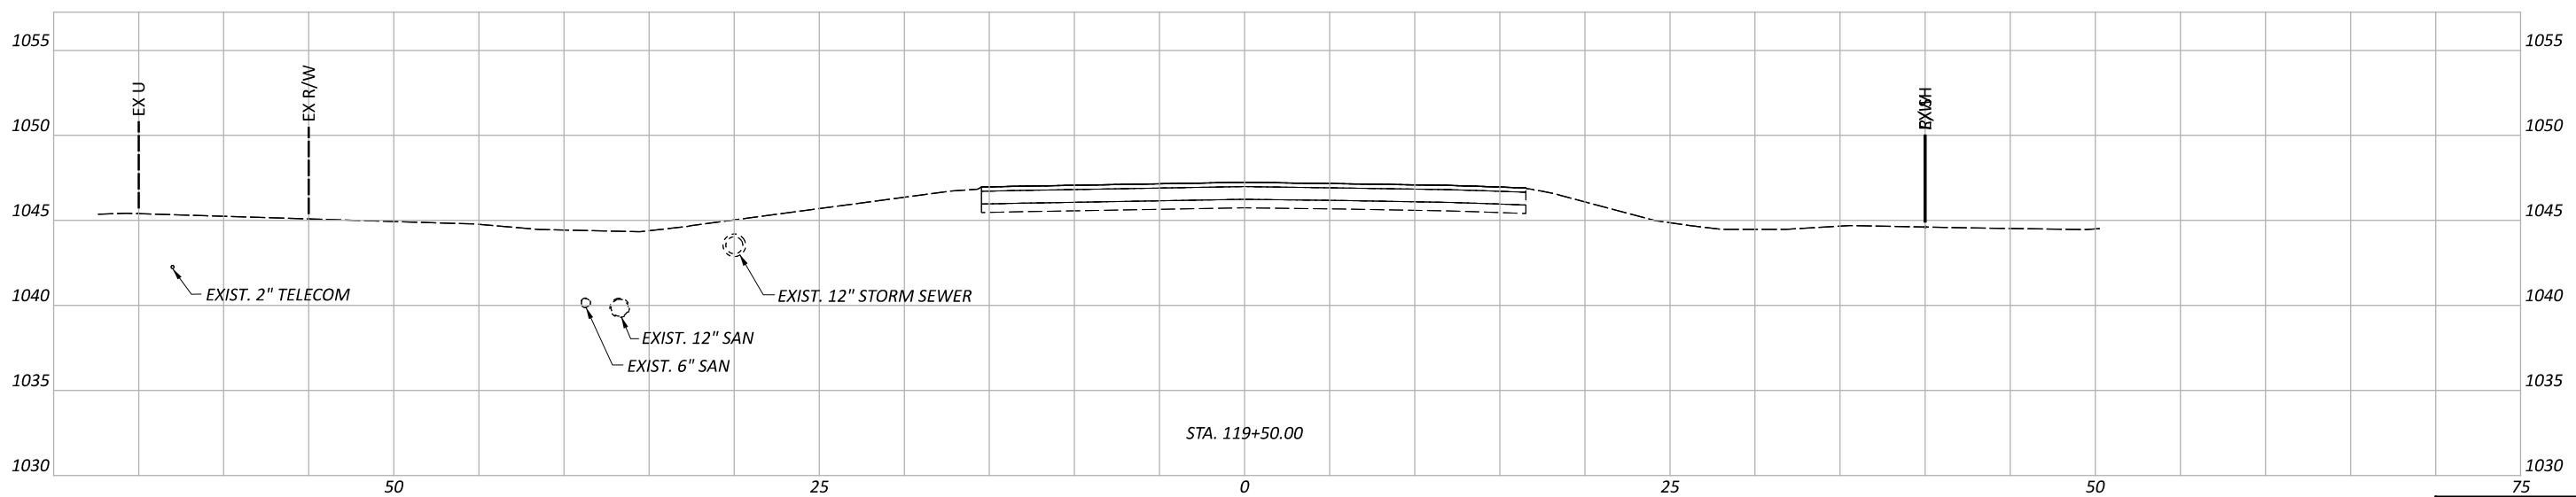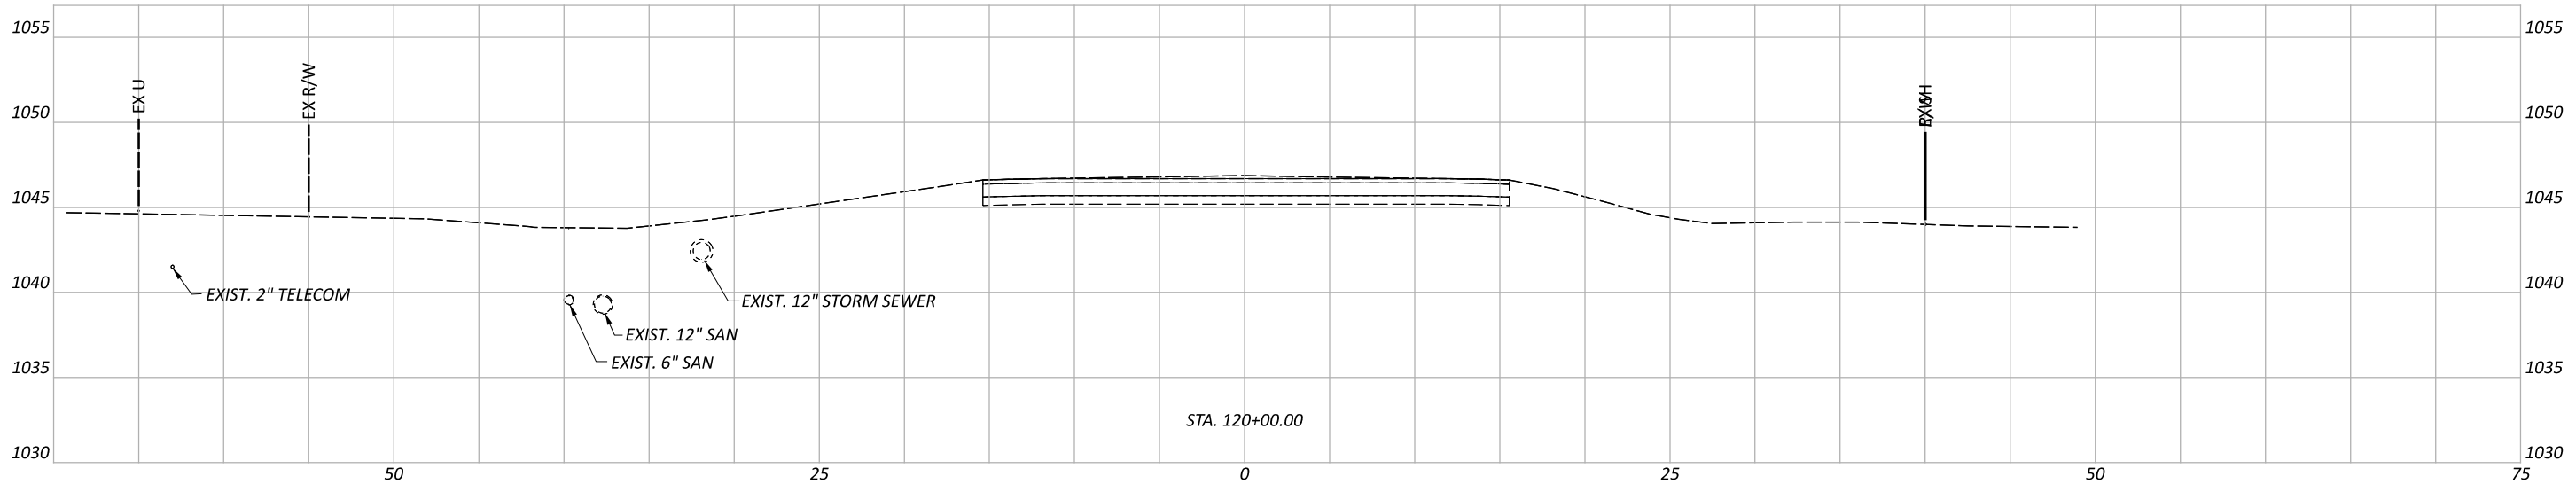

CROSS SECTIONS - PAVEMENT FOR M.O.T.
 SR 435 STA. 119+50 TO STA. 120+00

DESIGN AGENCY



DESIGNER

DPF

REVIEWER

DCJ MM-DD-YY




PROJECT ID

117955

Sheet Totals

Seeding	Cut	Fill

SHEET	TOTAL
P. 90	228

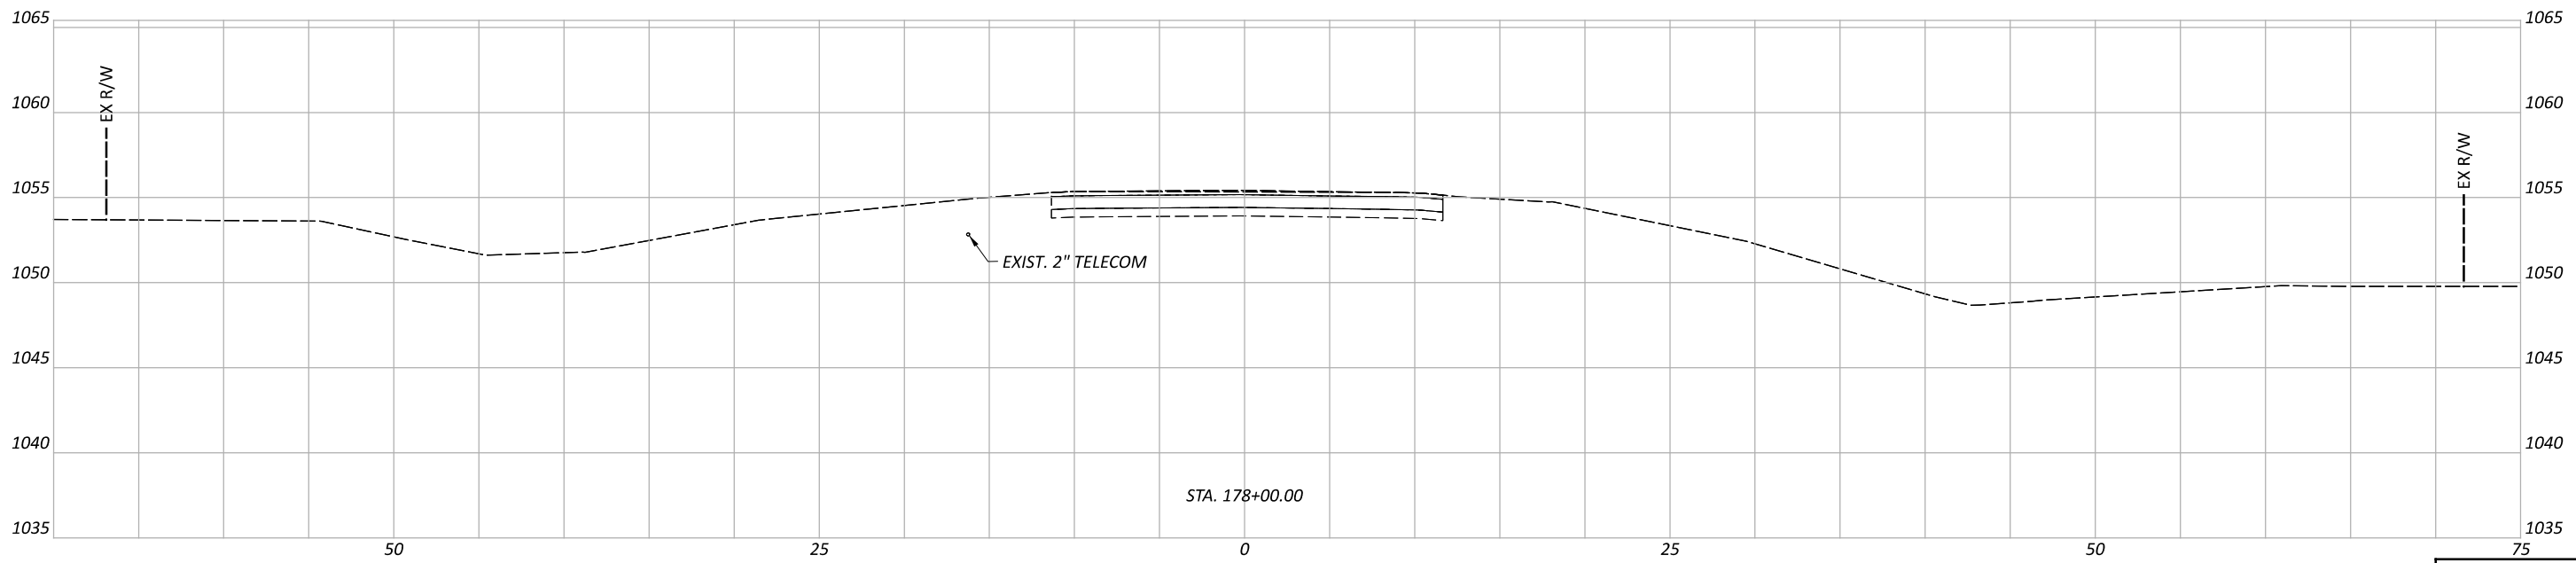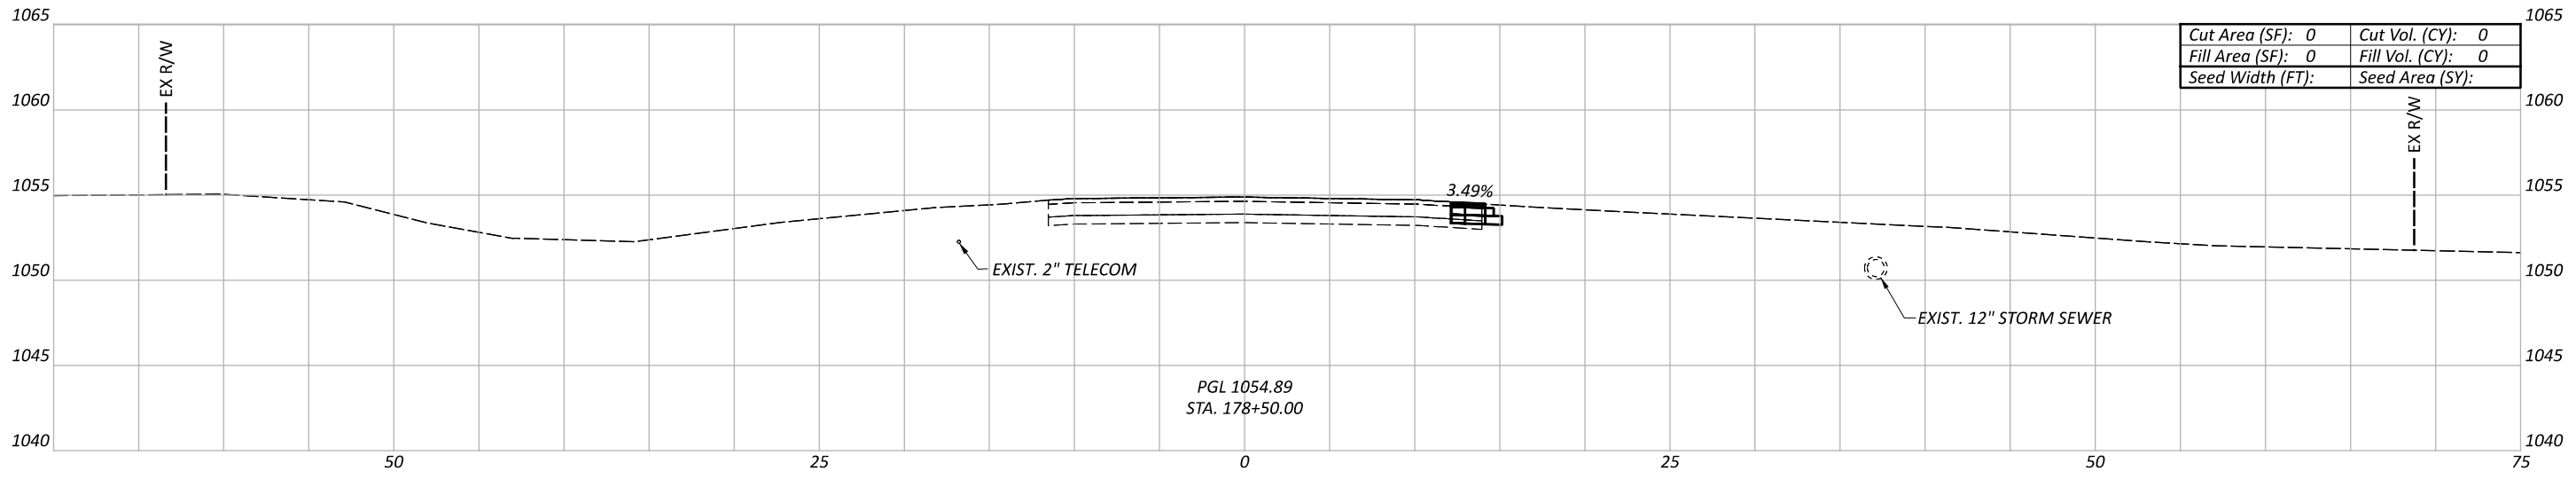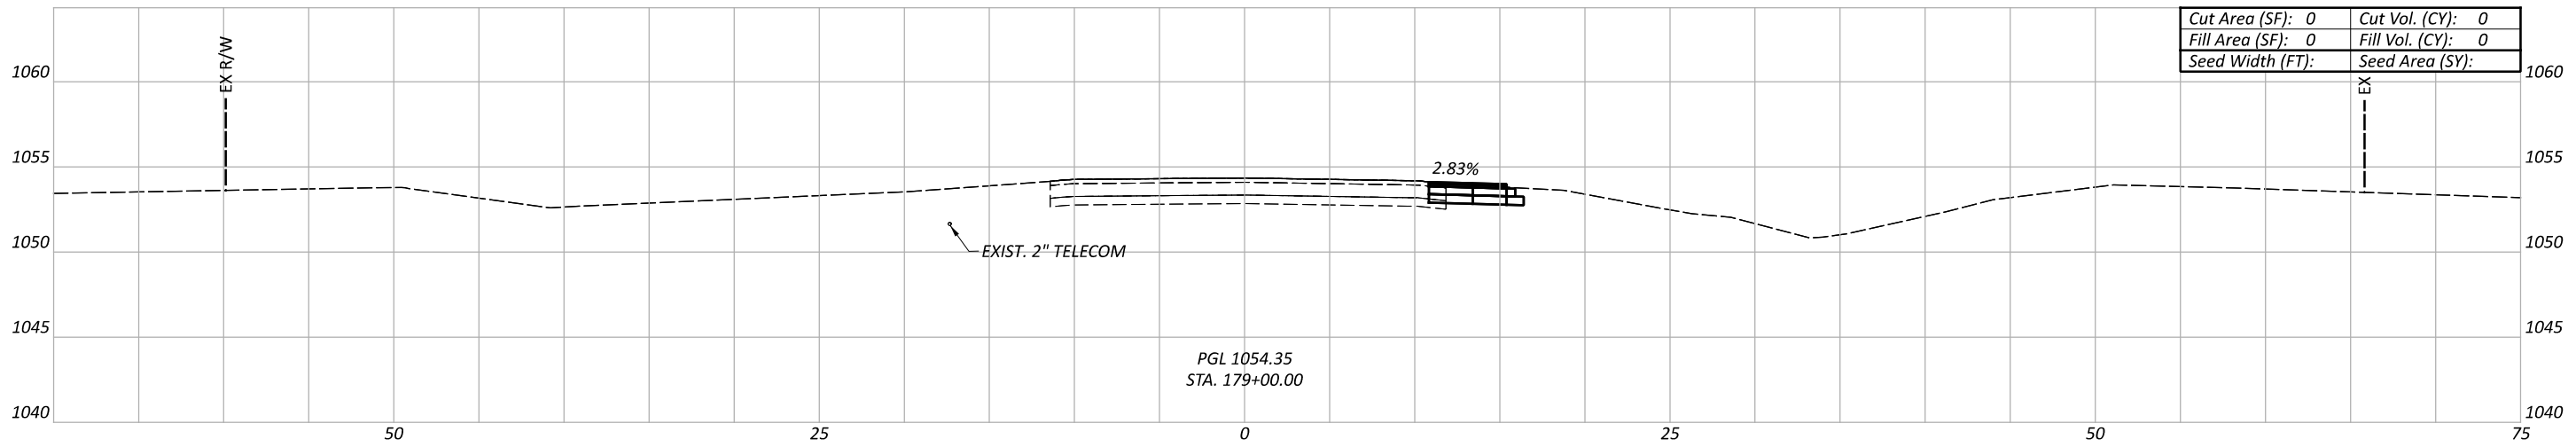

CROSS SECTIONS - PAVEMENT FOR M.O.T.
 SR 435 STA. 178+00 TO STA. 179+00

DESIGN AGENCY



DESIGNER

DPF


REVIEWER

DCJ MM-DD-YY

PROJECT ID

117955

Sheet Totals		
Seeding	Cut	Fill

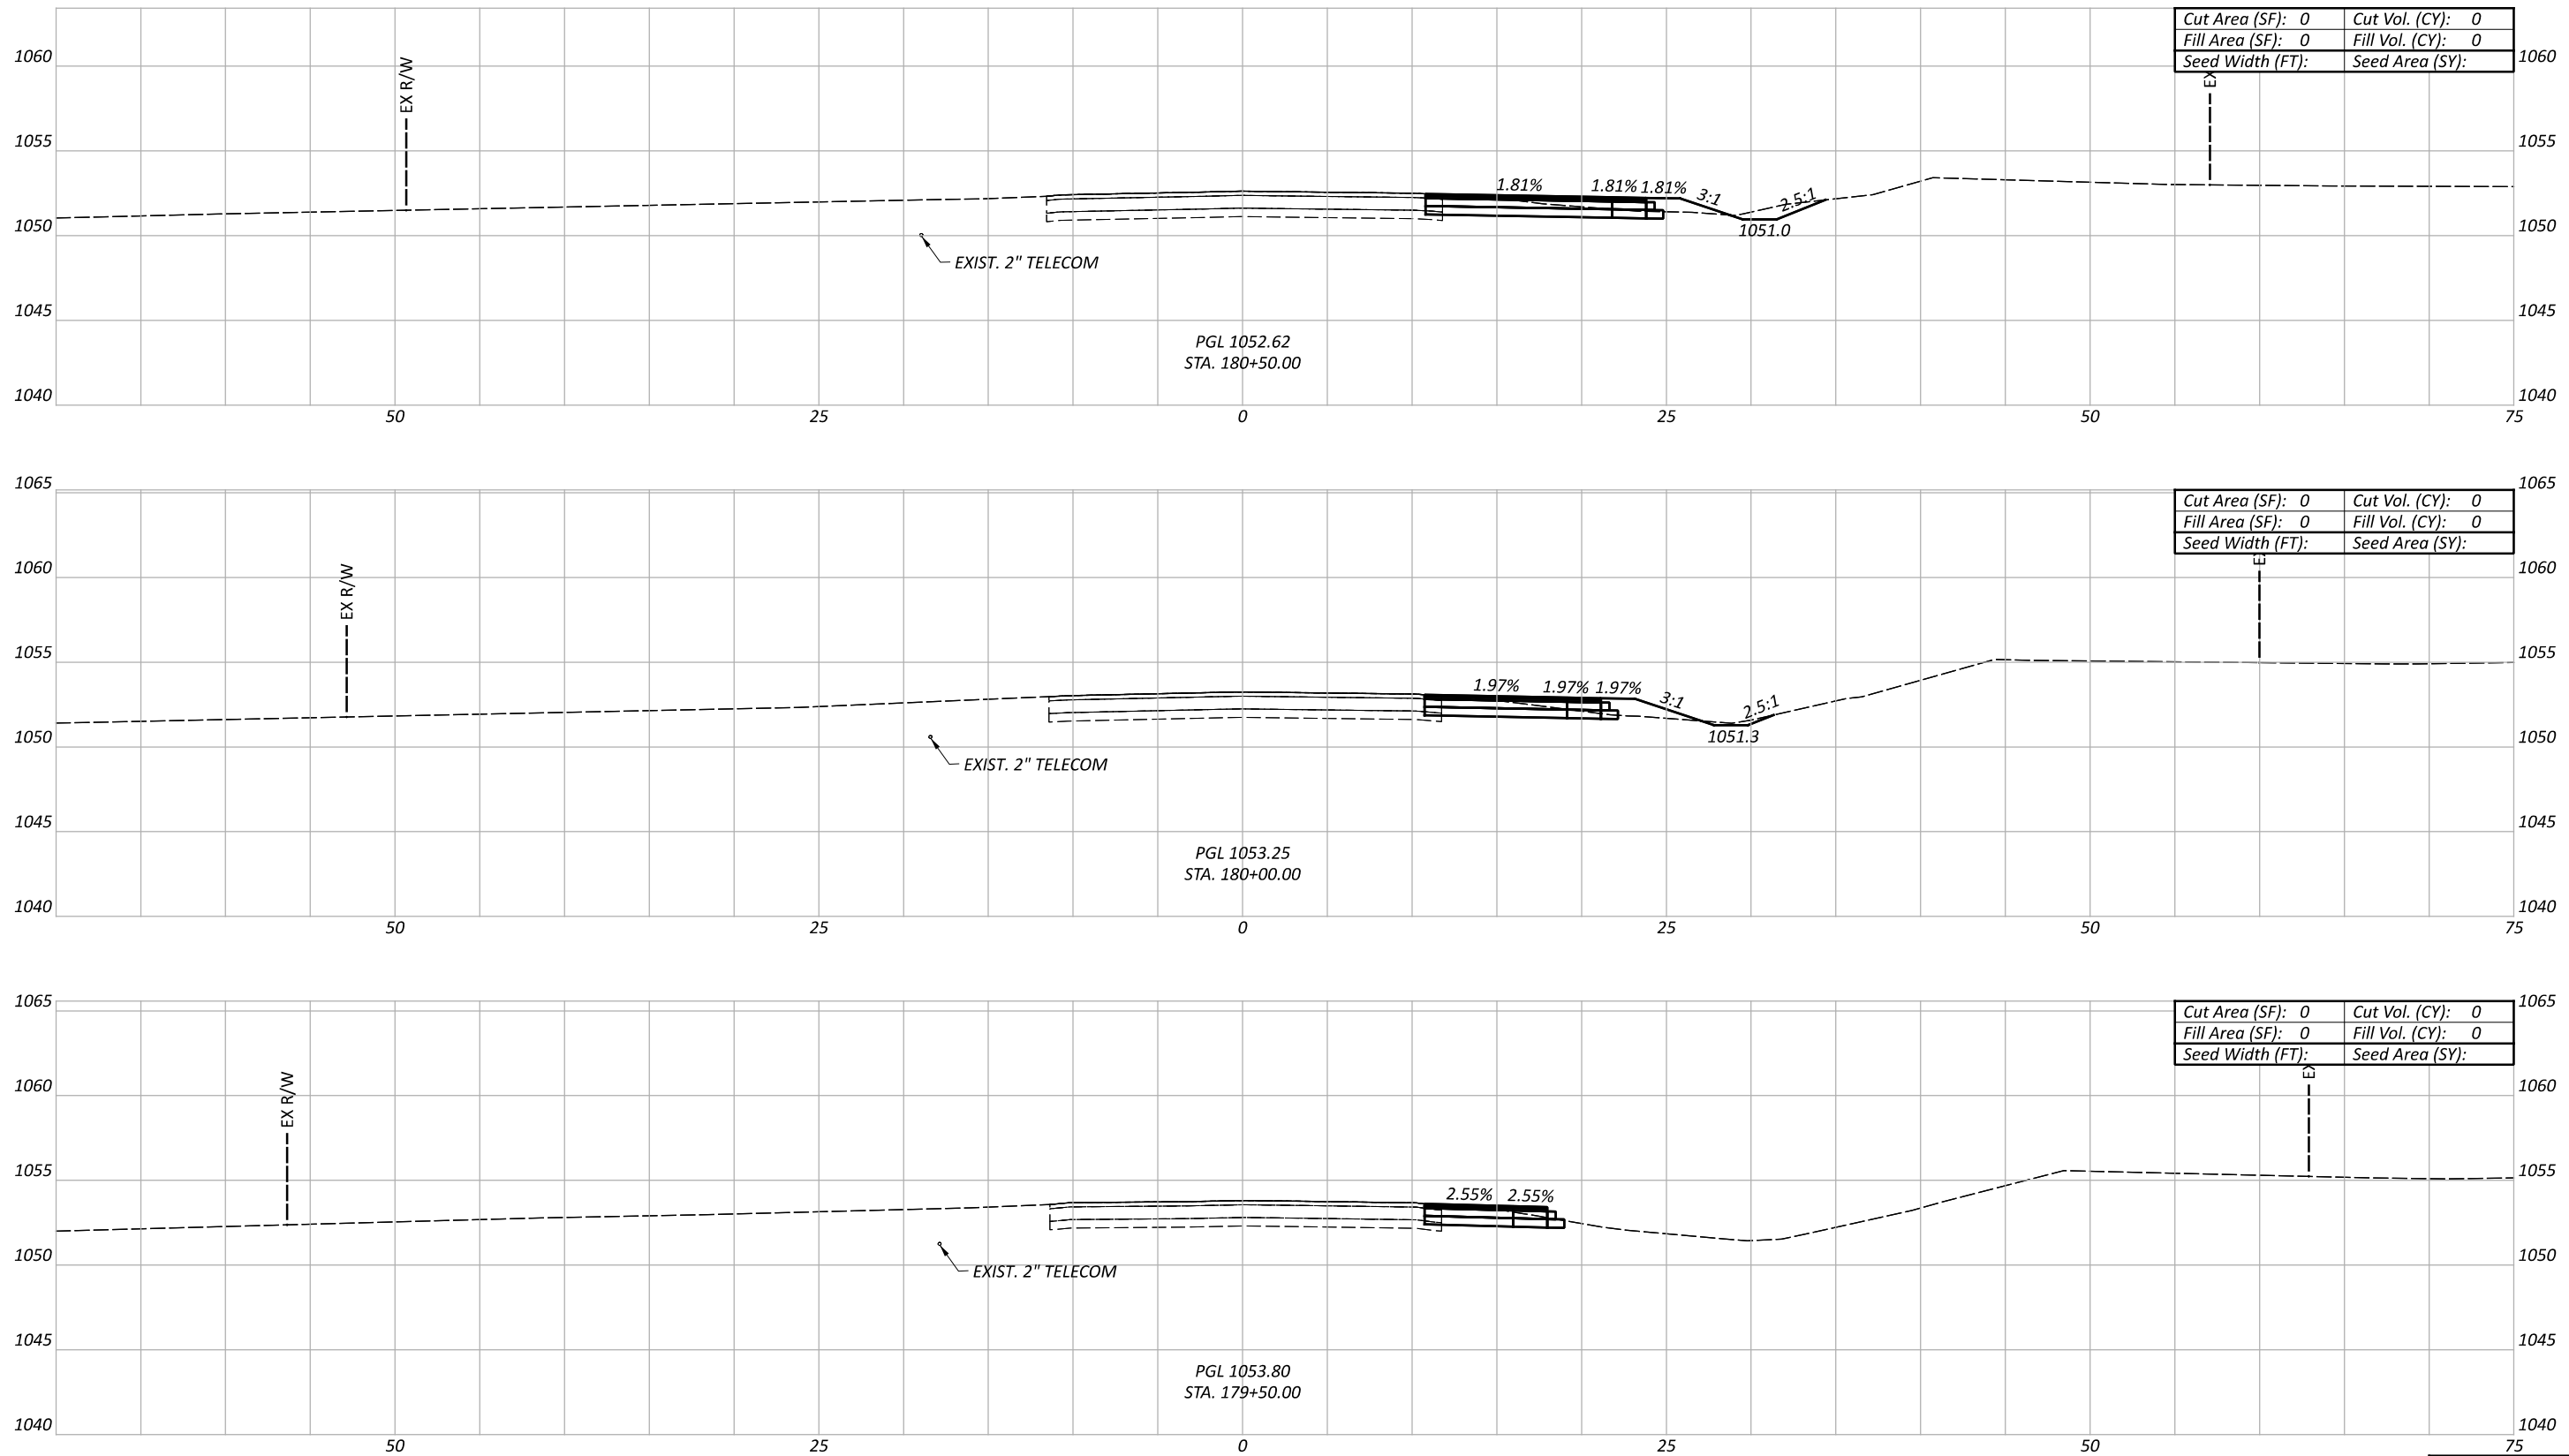

CROSS SECTIONS - PAVEMENT FOR M.O.T.
 SR 729 STA. 179+50 TO STA. 180+50

DESIGN AGENCY




DESIGNER
 DPF


REVIEWER
 DCJ MM-DD-YY

PROJECT ID
 117955

Sheet Totals			117955
Seeding	Cut	Fill	TOTAL
			P. 92 228

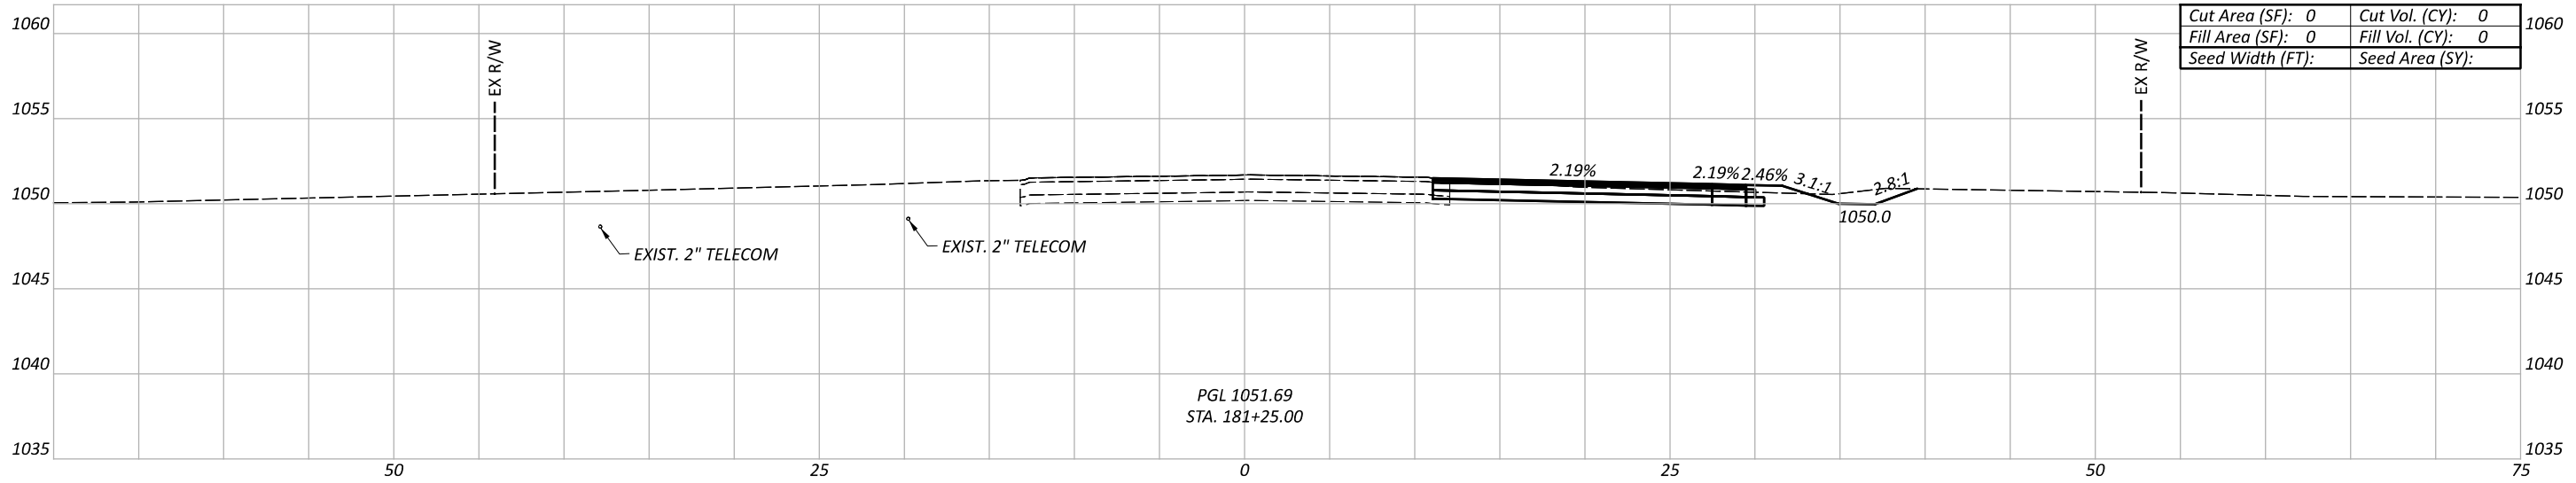

Cut Area (SF):	0	Cut Vol. (CY):	0
Fill Area (SF):	0	Fill Vol. (CY):	0
Seed Width (FT):		Seed Area (SY):	

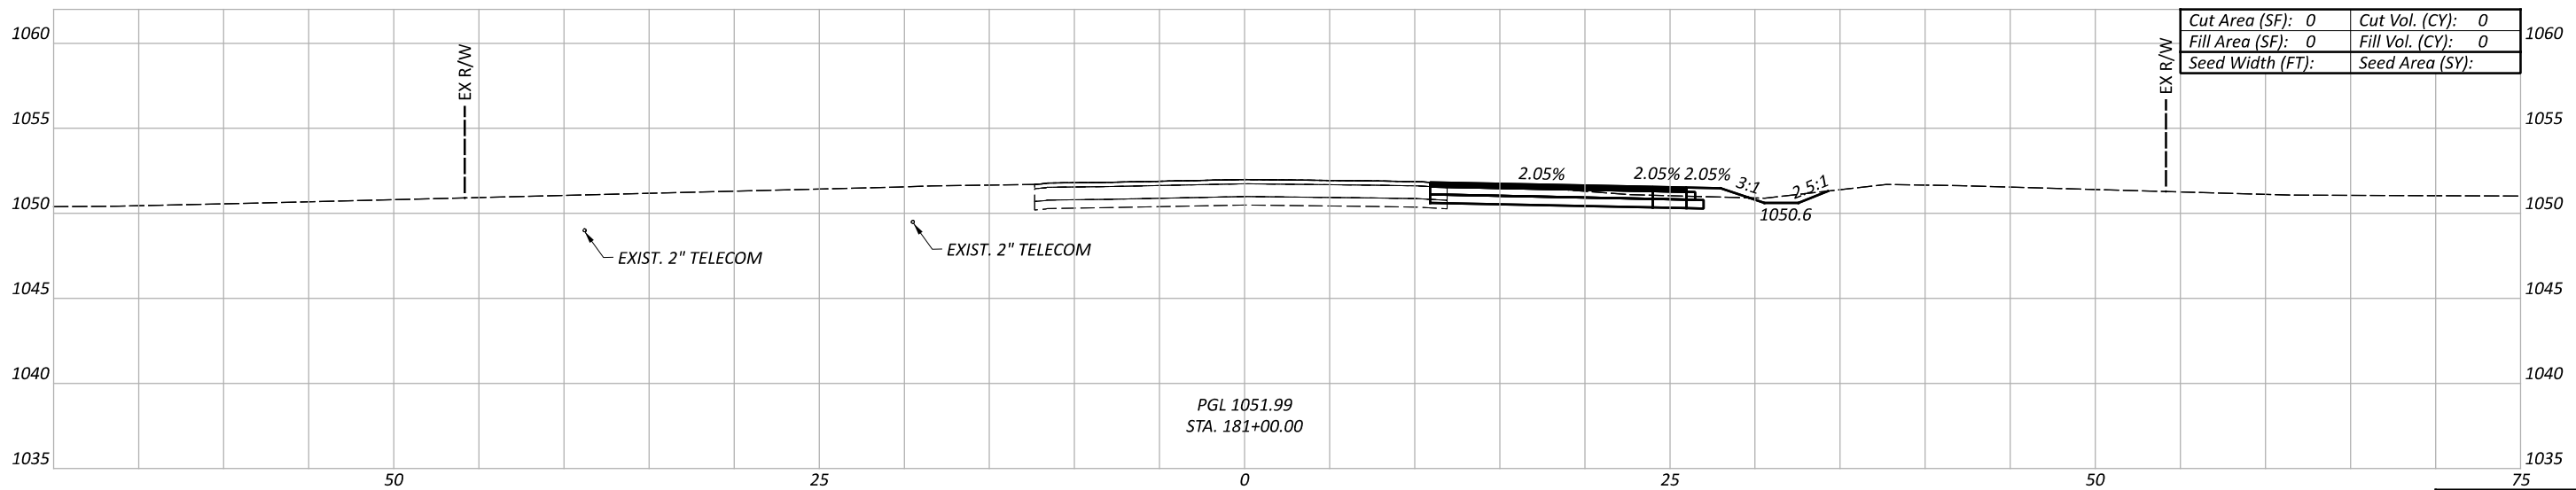

Cut Area (SF):	0	Cut Vol. (CY):	0
Fill Area (SF):	0	Fill Vol. (CY):	0
Seed Width (FT):		Seed Area (SY):	

CROSS SECTIONS - PAVEMENT FOR M.O.T.
 SR 729 STA. 181+00 TO STA. 181+25

DESIGN AGENCY






DESIGNER
 DPF

REVIEWER
 DCJ MM-DD-YY

PROJECT ID
 117955

Sheet Totals			117955
Seeding	Cut	Fill	SHEET TOTAL
			P. 93 228

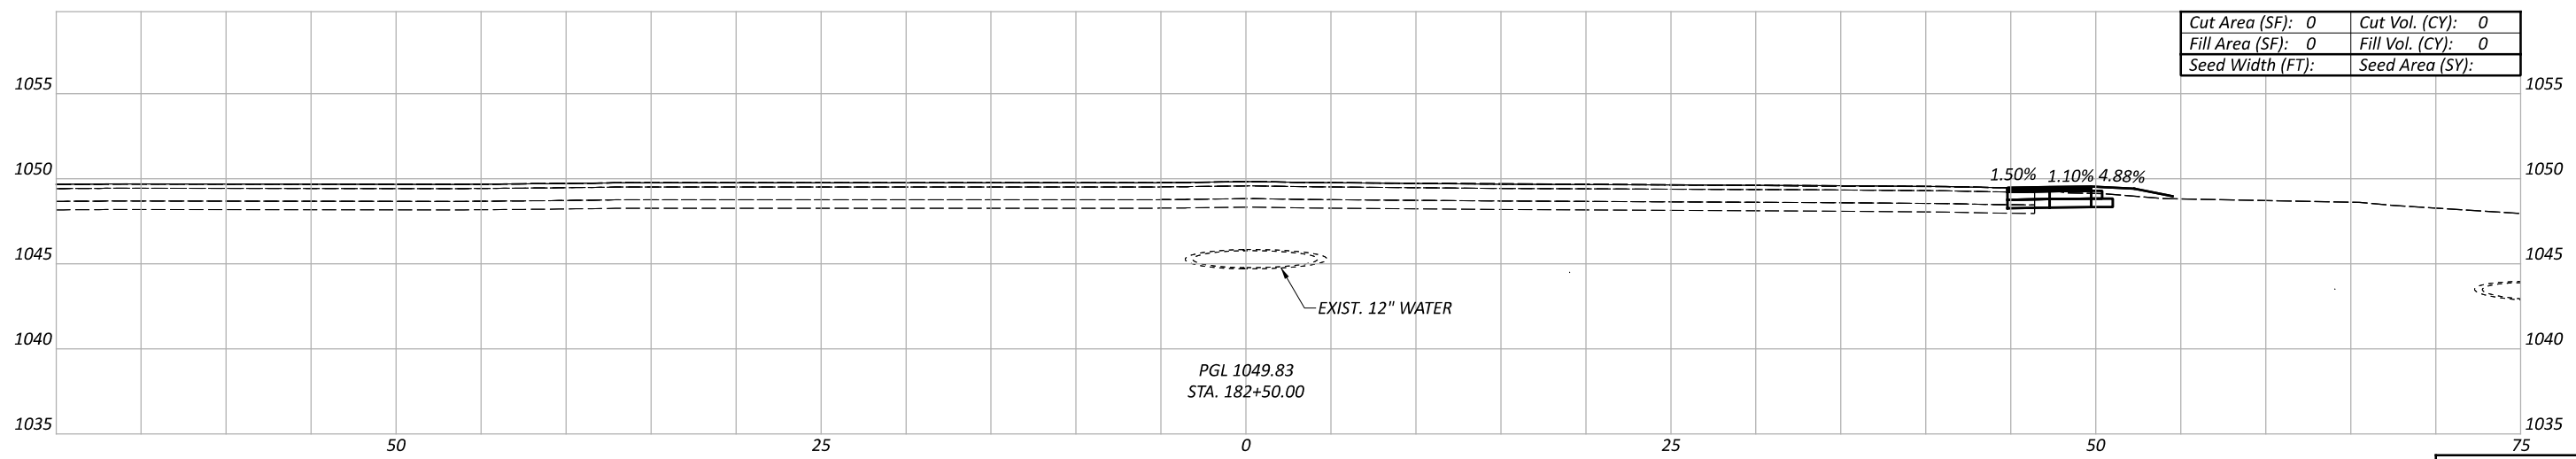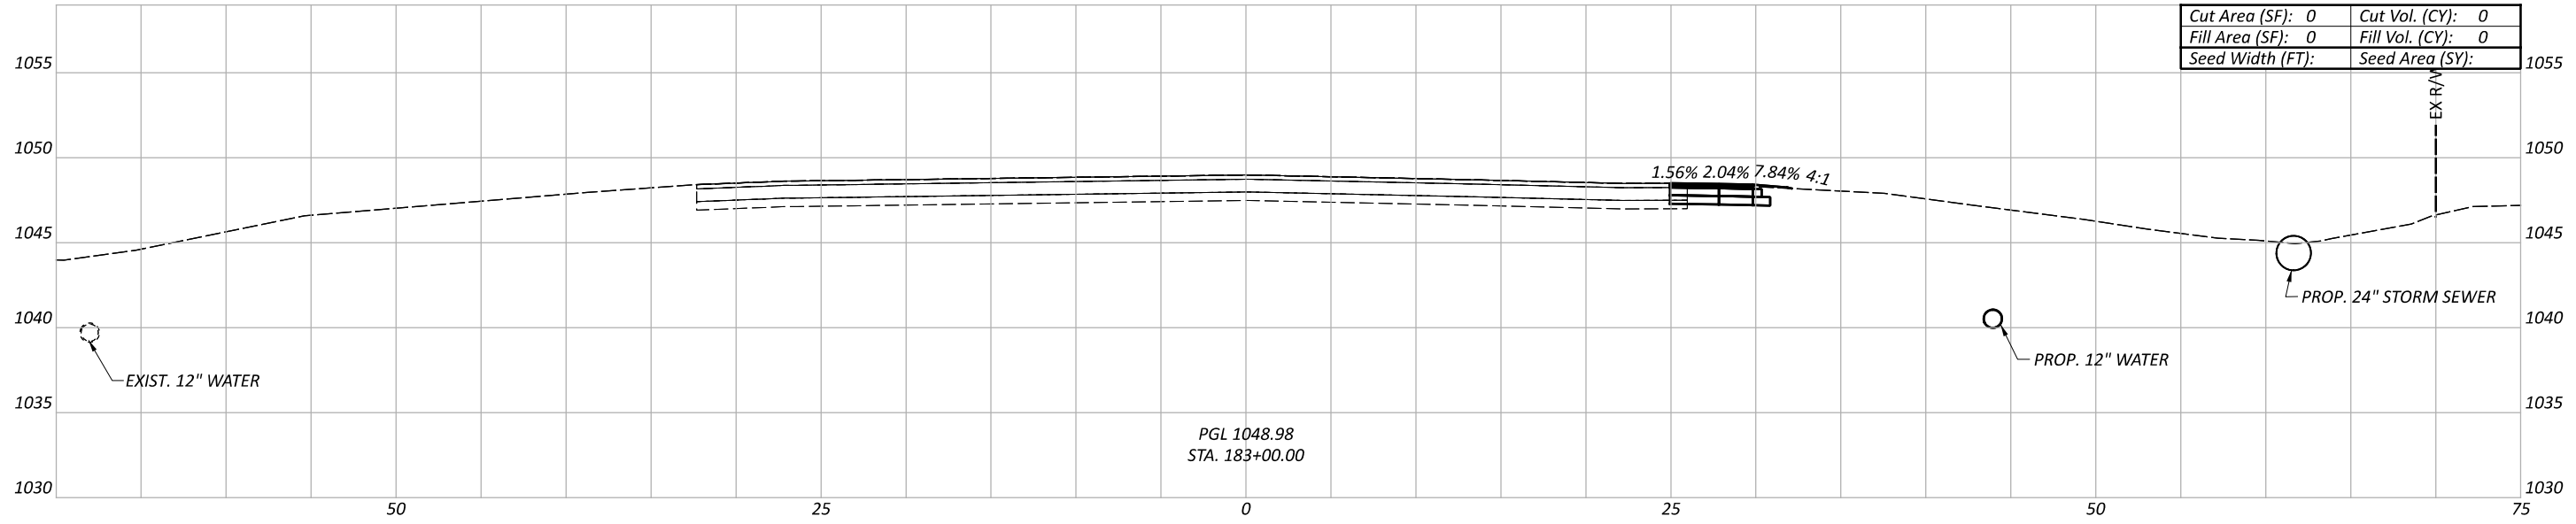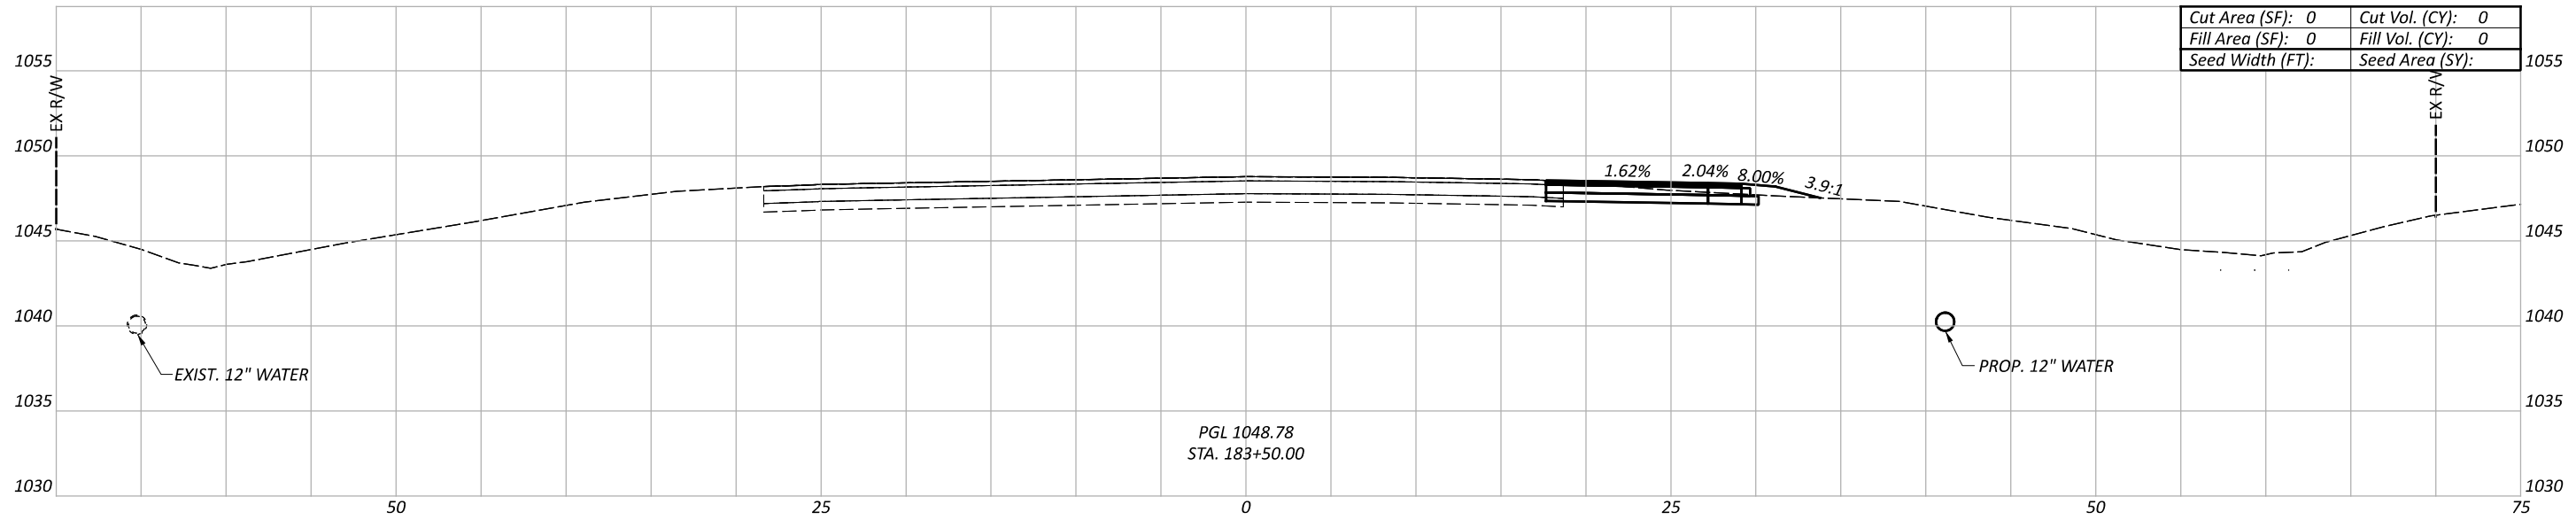


Sheet Totals			117955
Seeding	Cut	Fill	TOTAL
			P. 94 228

CROSS SECTIONS - PAVEMENT FOR M.O.T.
 BLUEGRASS BLVD. STA. 182+50 TO STA. 183+50


DESIGN AGENCY
Palmer
 ENGINEERING
 8350 E. KEMPER RD.
 SUITE B
 CINCINNATI, OH 45249
 513-469-1600

DESIGNER
 DPF
 REVIEWER
 DCJ MM-DD-YY

PROJECT ID
 117955

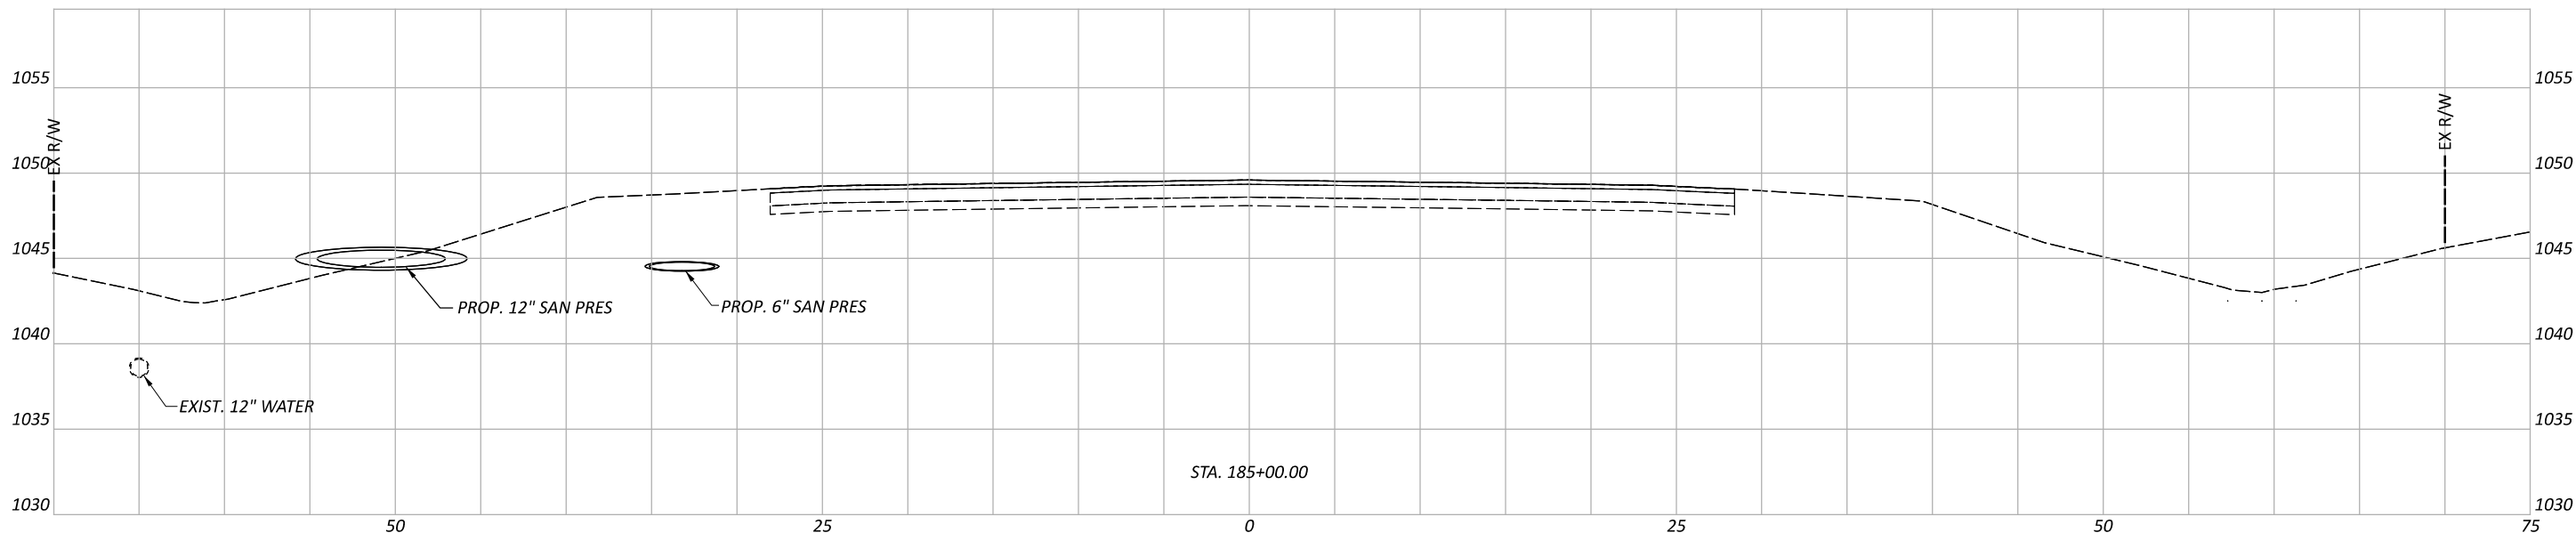


STA. 185+00.00

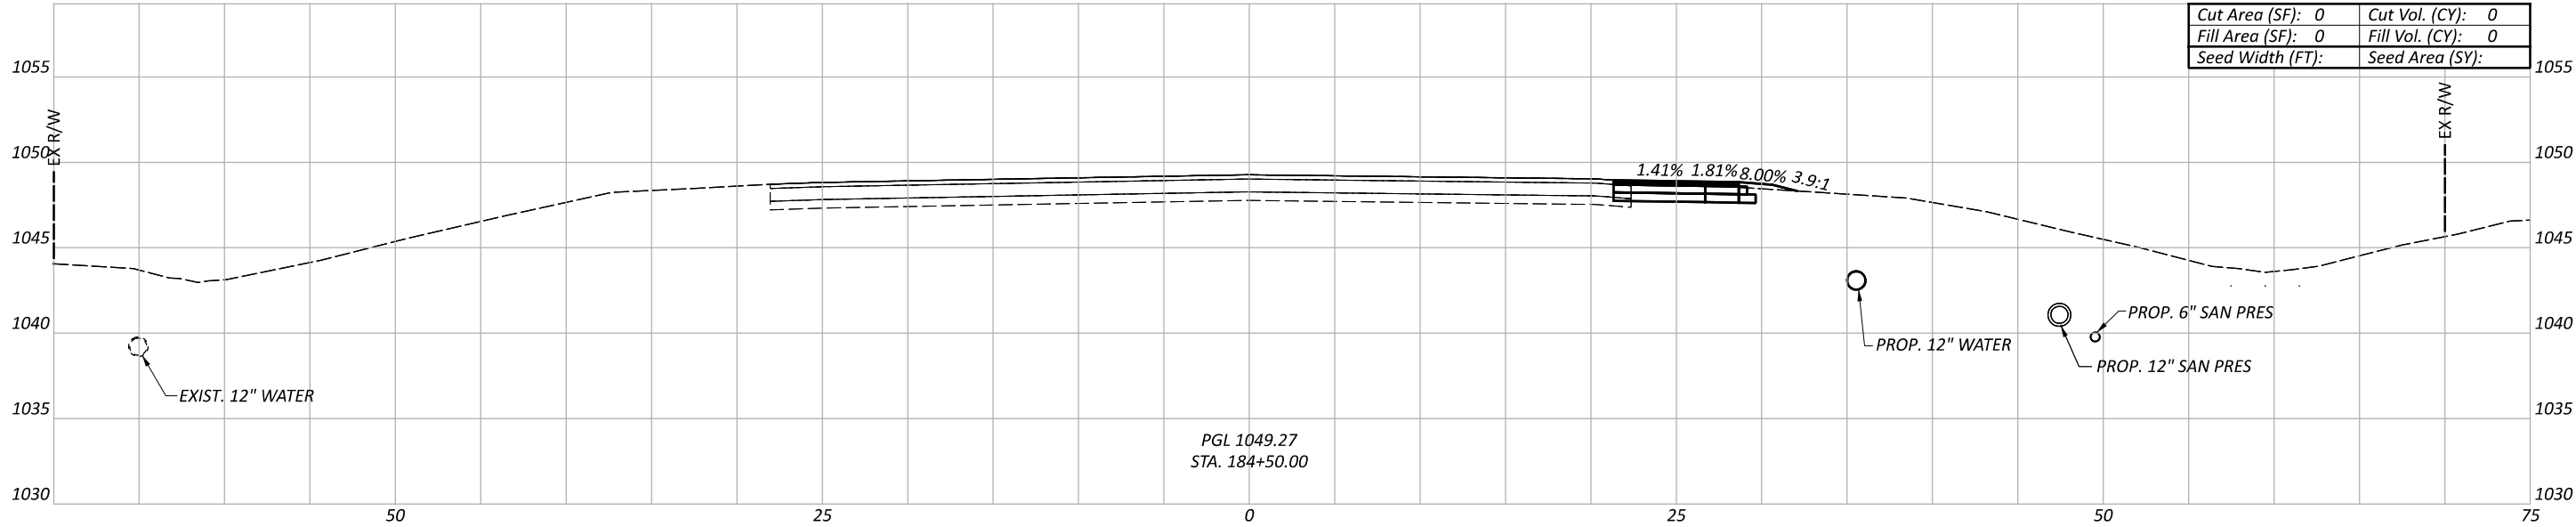

PGL 1049.27
STA. 184+50.00

Cut Area (SF): 0	Cut Vol. (CY): 0
Fill Area (SF): 0	Fill Vol. (CY): 0
Seed Width (FT):	Seed Area (SY):

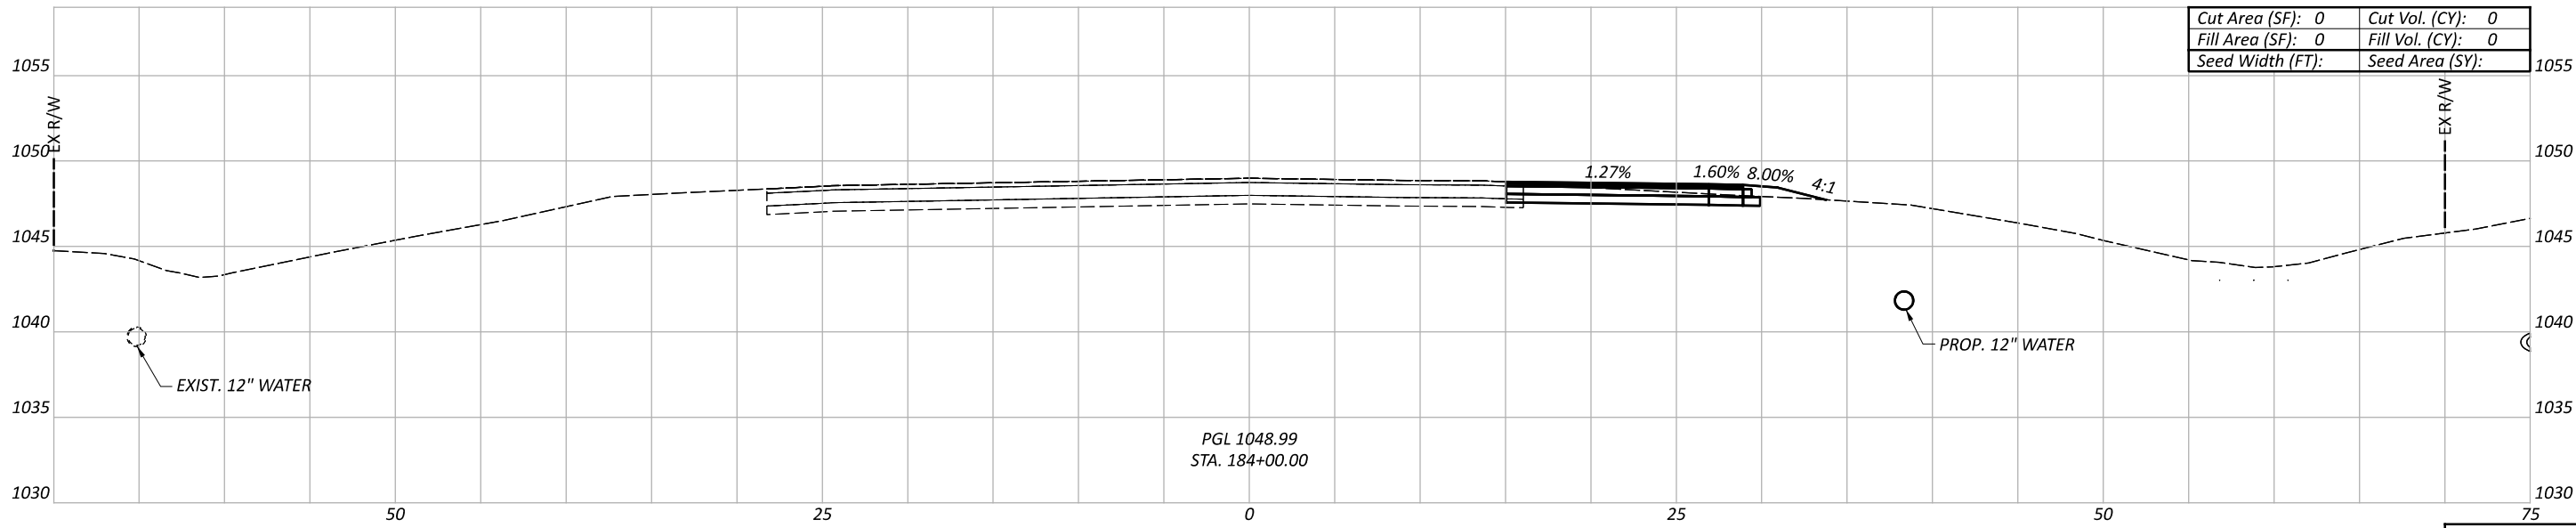

PGL 1048.99
STA. 184+00.00

Cut Area (SF): 0	Cut Vol. (CY): 0
Fill Area (SF): 0	Fill Vol. (CY): 0
Seed Width (FT):	Seed Area (SY):

CROSS SECTIONS - PAVEMENT FOR M.O.T.
 BLUEGRASS BLVD. STA. 184+00 TO STA. 185+00

DESIGN AGENCY


 8350 E. KEMPER RD.
 SUITE B
 CINCINNATI, OH 45249
 513-469-1600

DESIGNER
 DPF

REVIEWER
 DCJ MM-DD-YY

PROJECT ID
 117955

Sheet Totals		117955	
Seeding	Cut	Fill	TOTAL
			P. 95 228

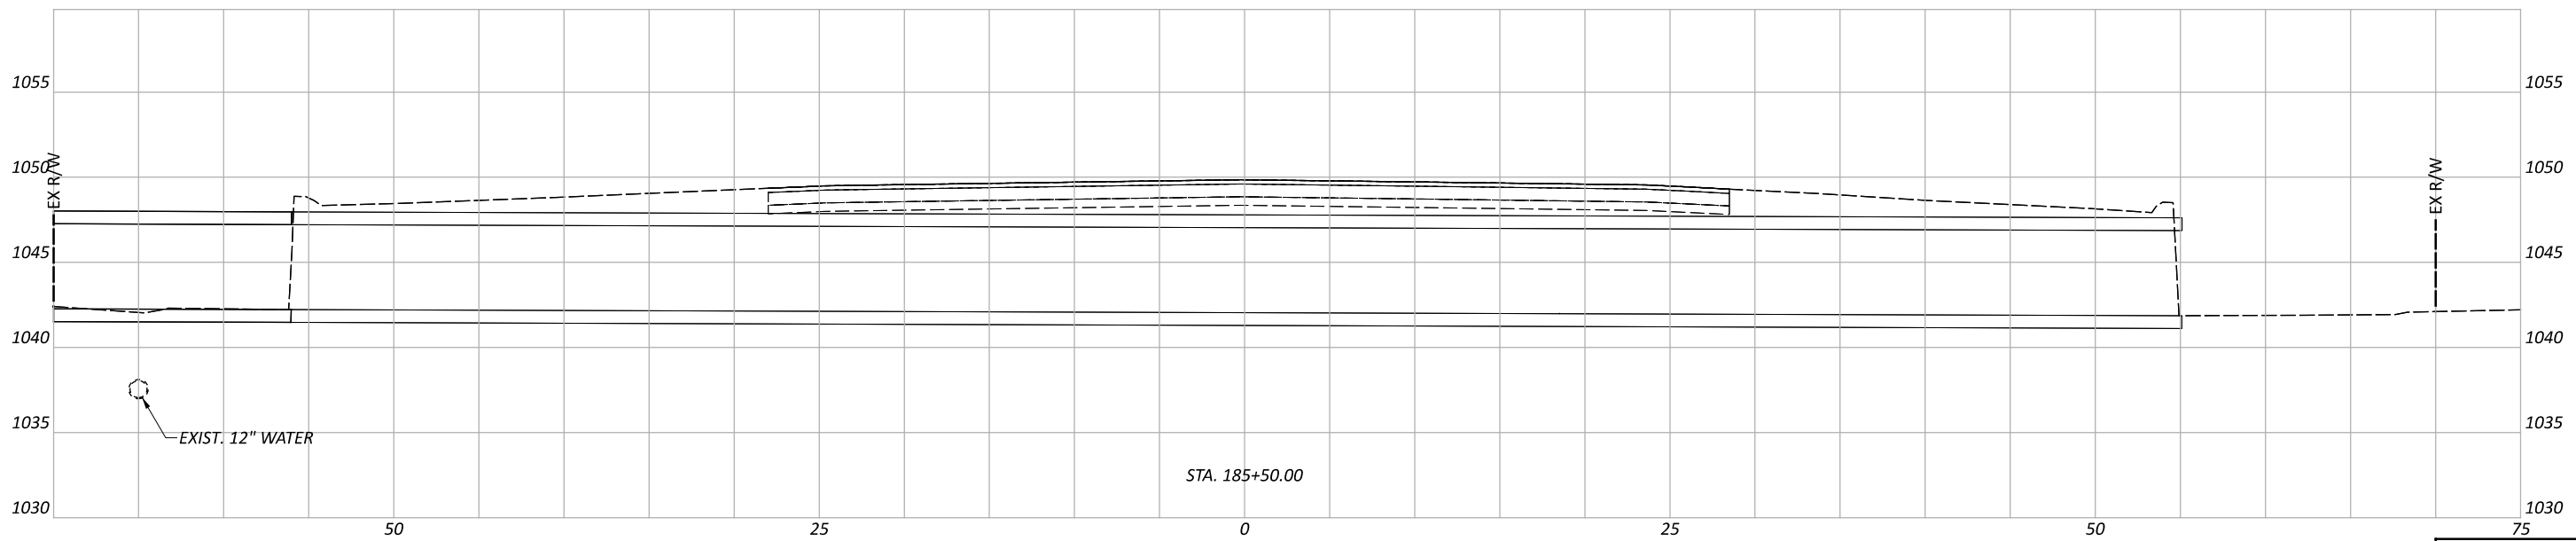

Sheet Totals		
Seeding	Cut	Fill

CROSS SECTIONS - PAVEMENT FOR M.O.T.
 BLUEGRASS BLVD. STA. 185+50

DESIGN AGENCY
Palmer
 ENGINEERING
 8350 E. KEMPER RD.
 SUITE B
 CINCINNATI, OH 45249
 513-469-1600

DESIGNER
 DPF

REVIEWER
 DCJ MM-DD-YY

PROJECT ID
 117955

LEGEND

(FOR SHEETS -)



FULL DEPTH PAVING (ROUNDAABOUT AND APPROACHES):
 ITEM 442 - 1½" ASPHALT CONCRETE SURFACE COURSE, 12.5MM, TYPE A (446)
 ITEM 442 - 1¾" ASPHALT CONCRETE INTERMEDIATE COURSE, 12.5MM*, TYPE A (449)
 ITEM 301 - 9" ASPHALT CONCRETE BASE, PG64-22, (449)
 ITEM 304 - 6" AGGREGATE BASE
 SUBGRADE TREATMENT PER SCOPE




FULL DEPTH PAVING:
 ITEM 442 - 1½" ASPHALT CONCRETE SURFACE COURSE, 12.5MM, TYPE A (446)
 ITEM 442 - 1¾" ASPHALT CONCRETE INTERMEDIATE COURSE, 12.5MM*, TYPE A (449)
 ITEM 301 - 7" ASPHALT CONCRETE BASE, PG64-22, (449)
 ITEM 304 - 6" AGGREGATE BASE
 SUBGRADE TREATMENT PER SCOPE




WEDGING AND RESURFACING:
 ITEM 442 - 1½" ASPHALT CONCRETE SURFACE COURSE, 12.5MM, TYPE A (446)
 ITEM 442 - VARIABLE DEPTH ASPHALT CONCRETE INTERMEDIATE COURSE, TYPE A (449)
 ITEM 302 - VARIABLE DEPTH ASPHALT CONCRETE BASE, PG 64-22 (449)
 ITEM 254 - PAVEMENT PLANING 1½" DEPTH



ROUNDAABOUT SPLITTER ISLANDS:
 ITEM 609 - 4" CONCRETE MEDIAN
 ITEM 304 - 4" AGGREGATE BASE

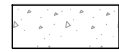

ROUNDAABOUT TRUCK APRON:
 ITEM 451 - 7" REINFORCED CONCRETE PAVEMENT, CLASS QC 1P
 ITEM 304 - 14" AGGREGATE BASE

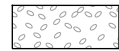

AGGREGATE DRIVES
 ITEM 304 - 8" AGGREGATE BASE



CONCRETE DRIVES
 ITEM 452 - 8" NON-REINFORCED CONCRETE PAVEMENT



ASPHALT DRIVES
 ITEM 442 - 1¼" ASPHALT CONCRETE SURFACE COURSE, TYPE 1 (449) DRIVEWAYS
 ITEM 304 - 5" ASPHALT CONCRETE BASE



PAVEMENT FOR MAINTENANCE OF TRAFFIC

US 35 RAMP D - SEE PLAN AND PROFILE SHEETS FOR LEGEND

LEGEND
 BUILDABLE UNIT 5

DESIGN AGENCY






DESIGNER
 DPF

REVIEWER
 DCJ MM-DD-YY




PROJECT ID
 117955

SHEET TOTAL
 P. 97 | 228

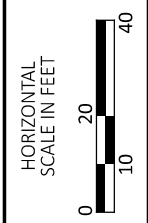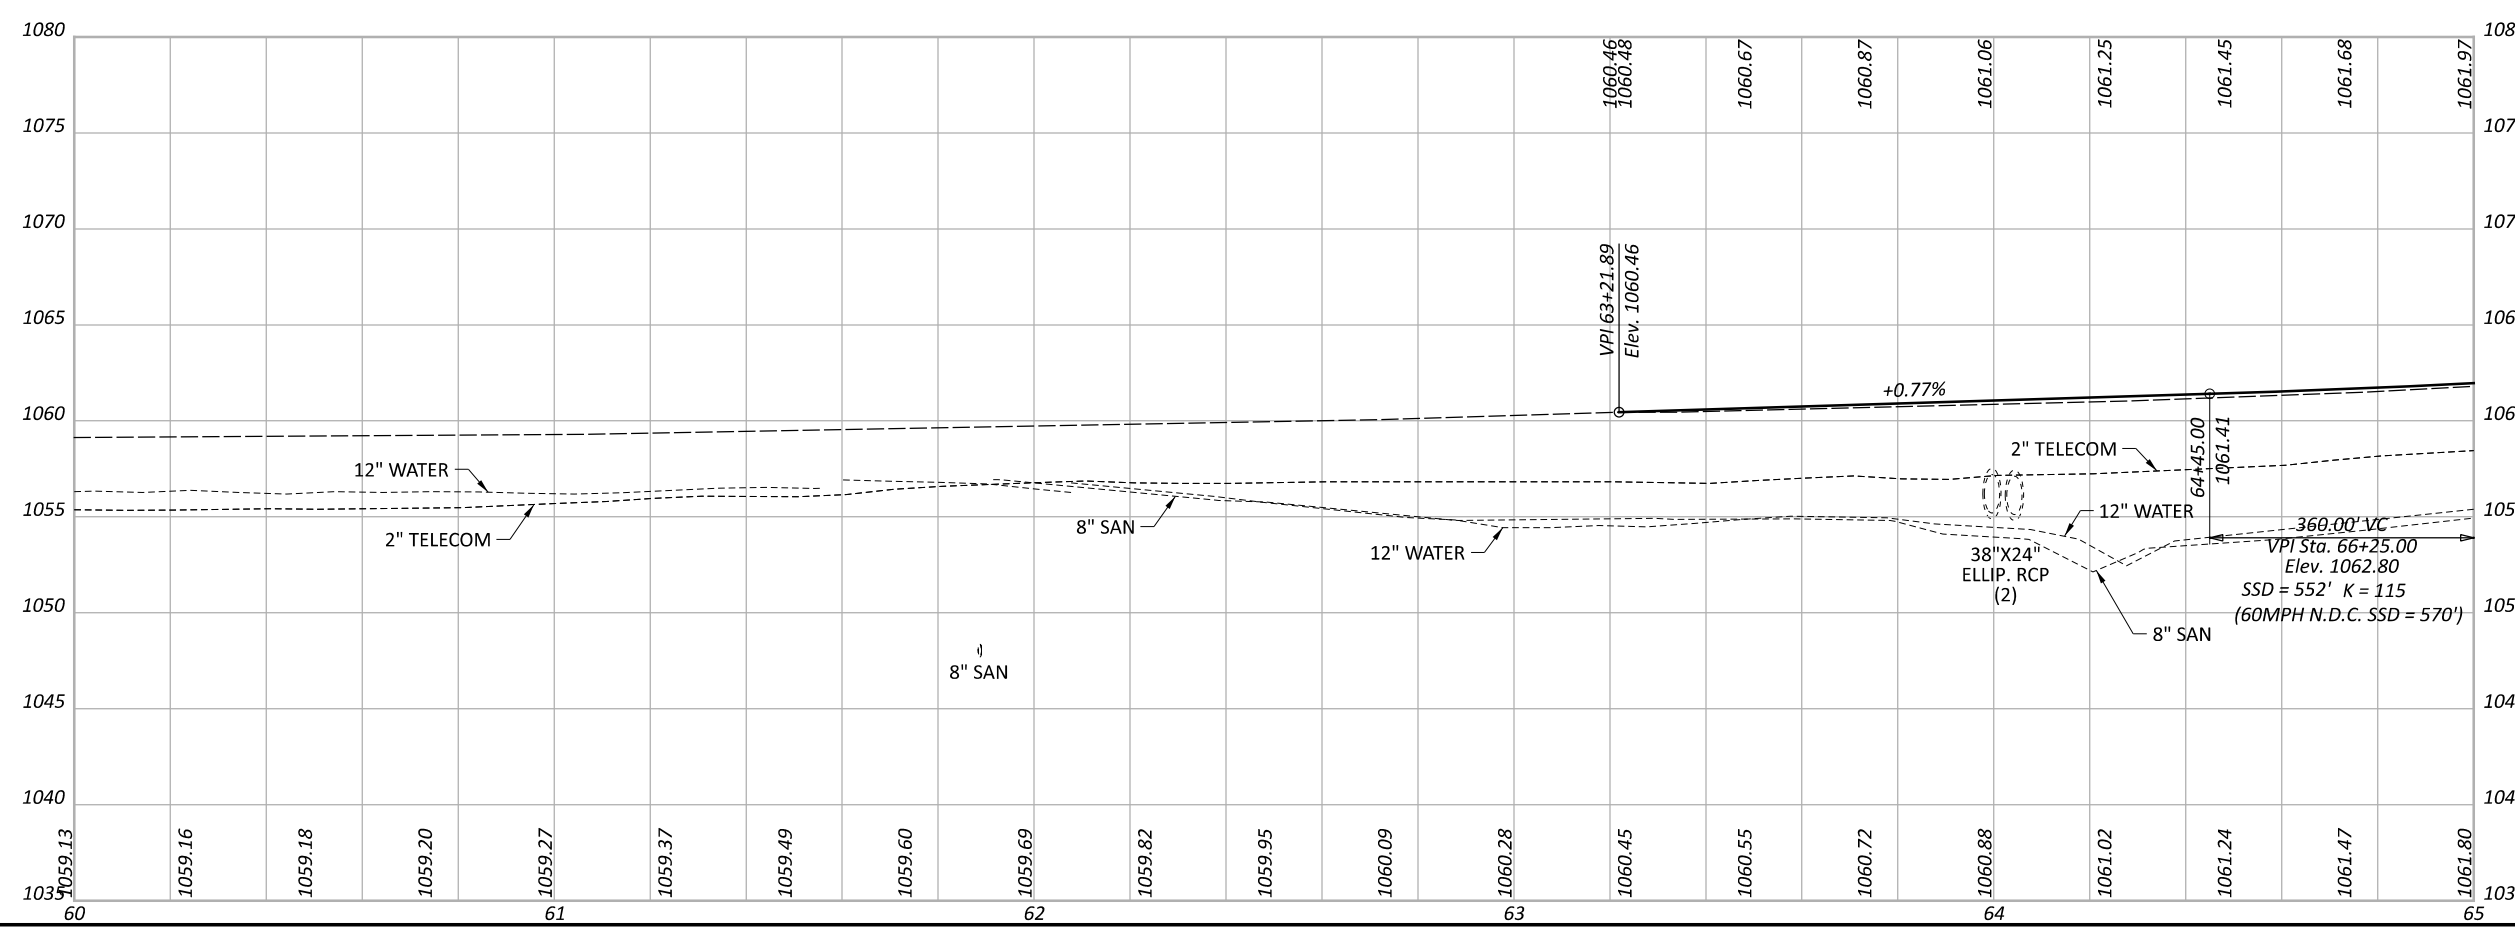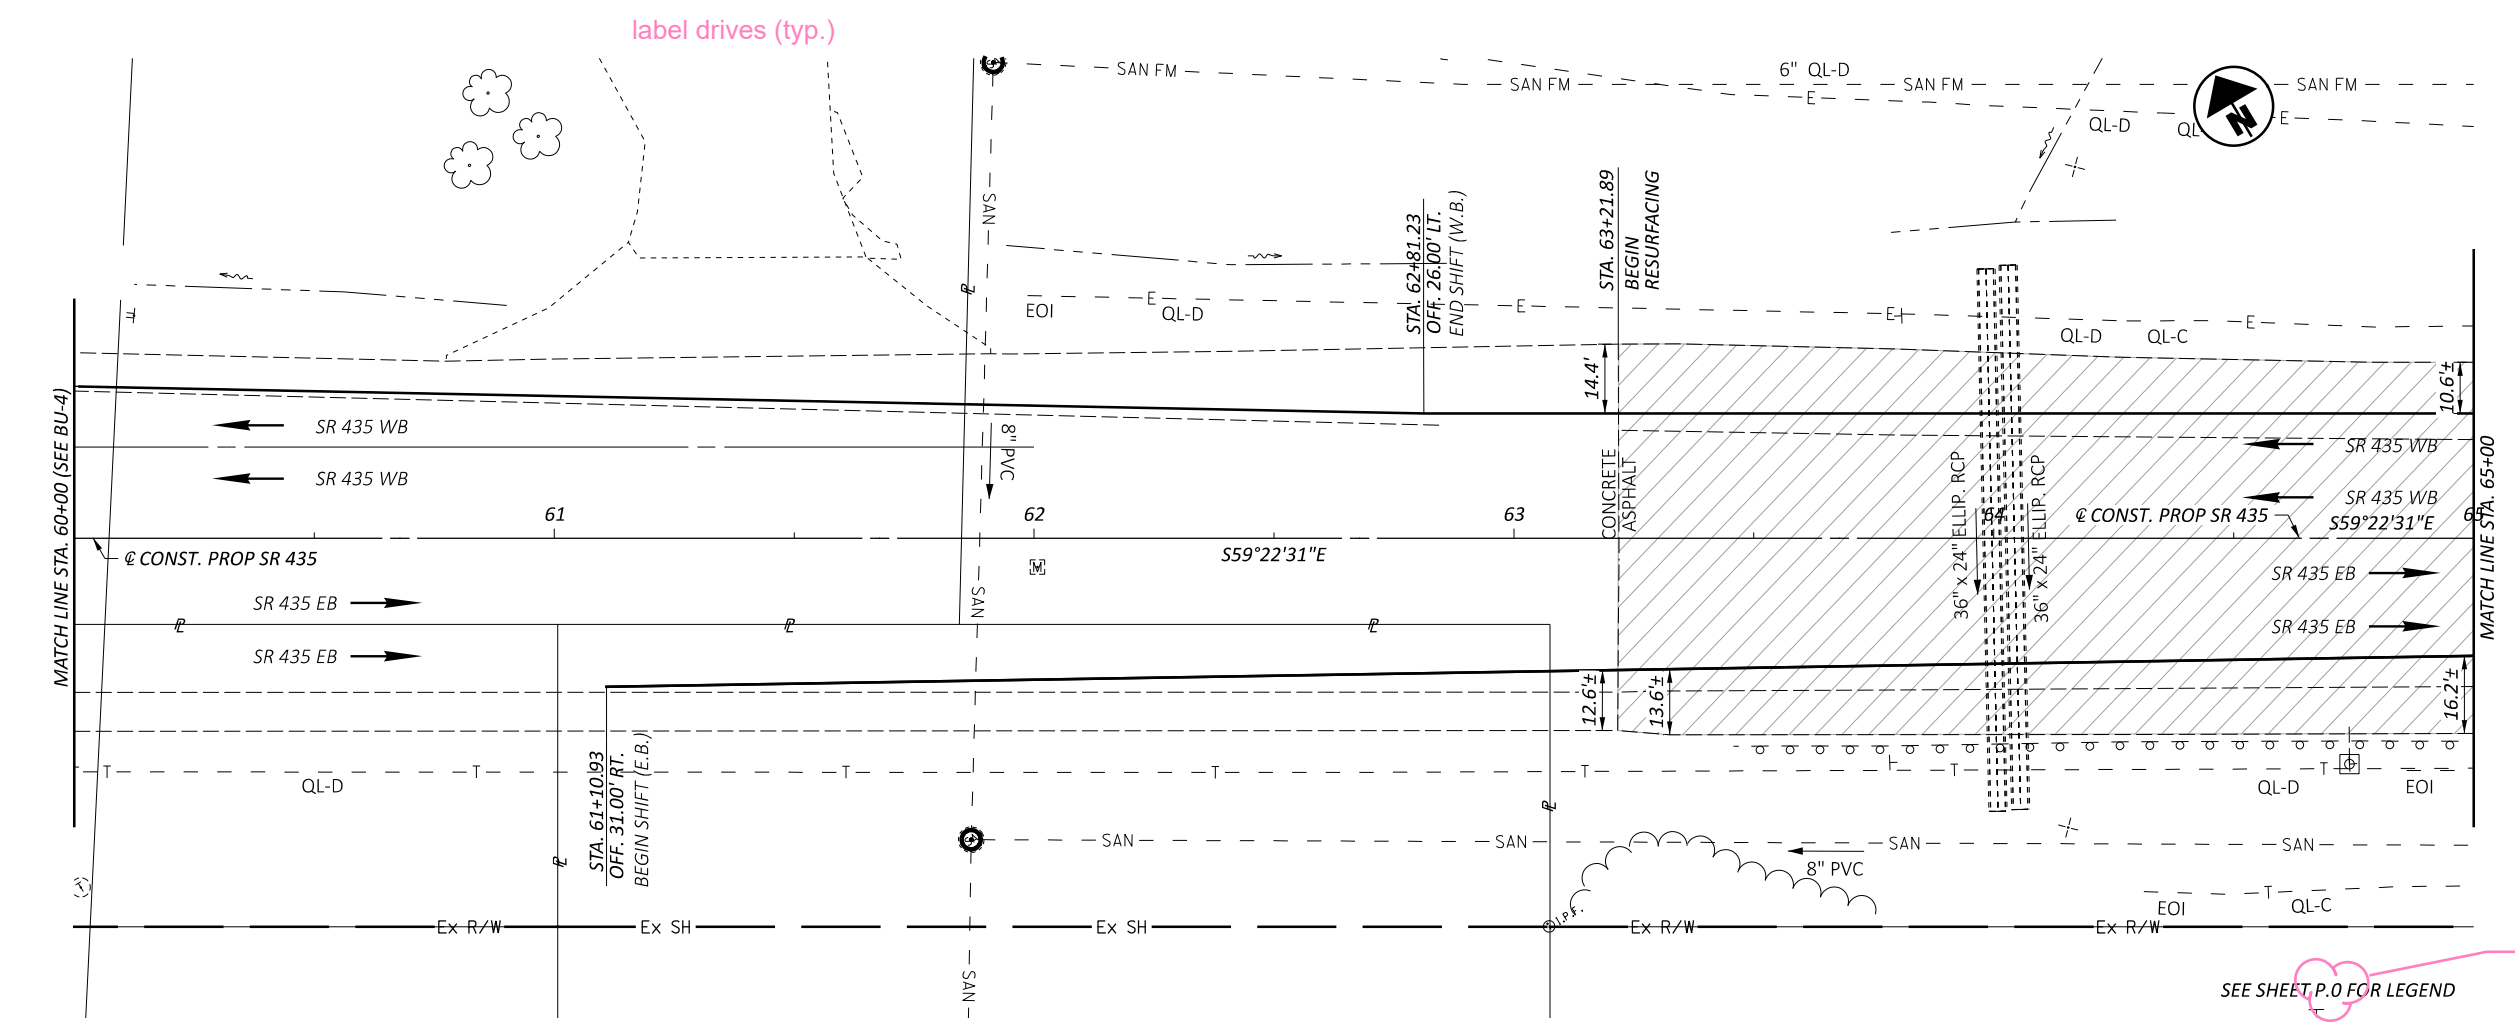


PLAN AND PROFILE
 S.R. 435 STA 60+00 TO STA 65+00

DESIGN AGENCY	Palmer ENGINEERING
DESIGNER	DPF
REVIEWER	DCJ MM-DD-YY
PROJECT ID	117955
SHEET	TOTAL
P. 98	228

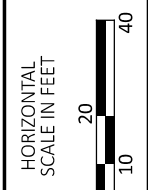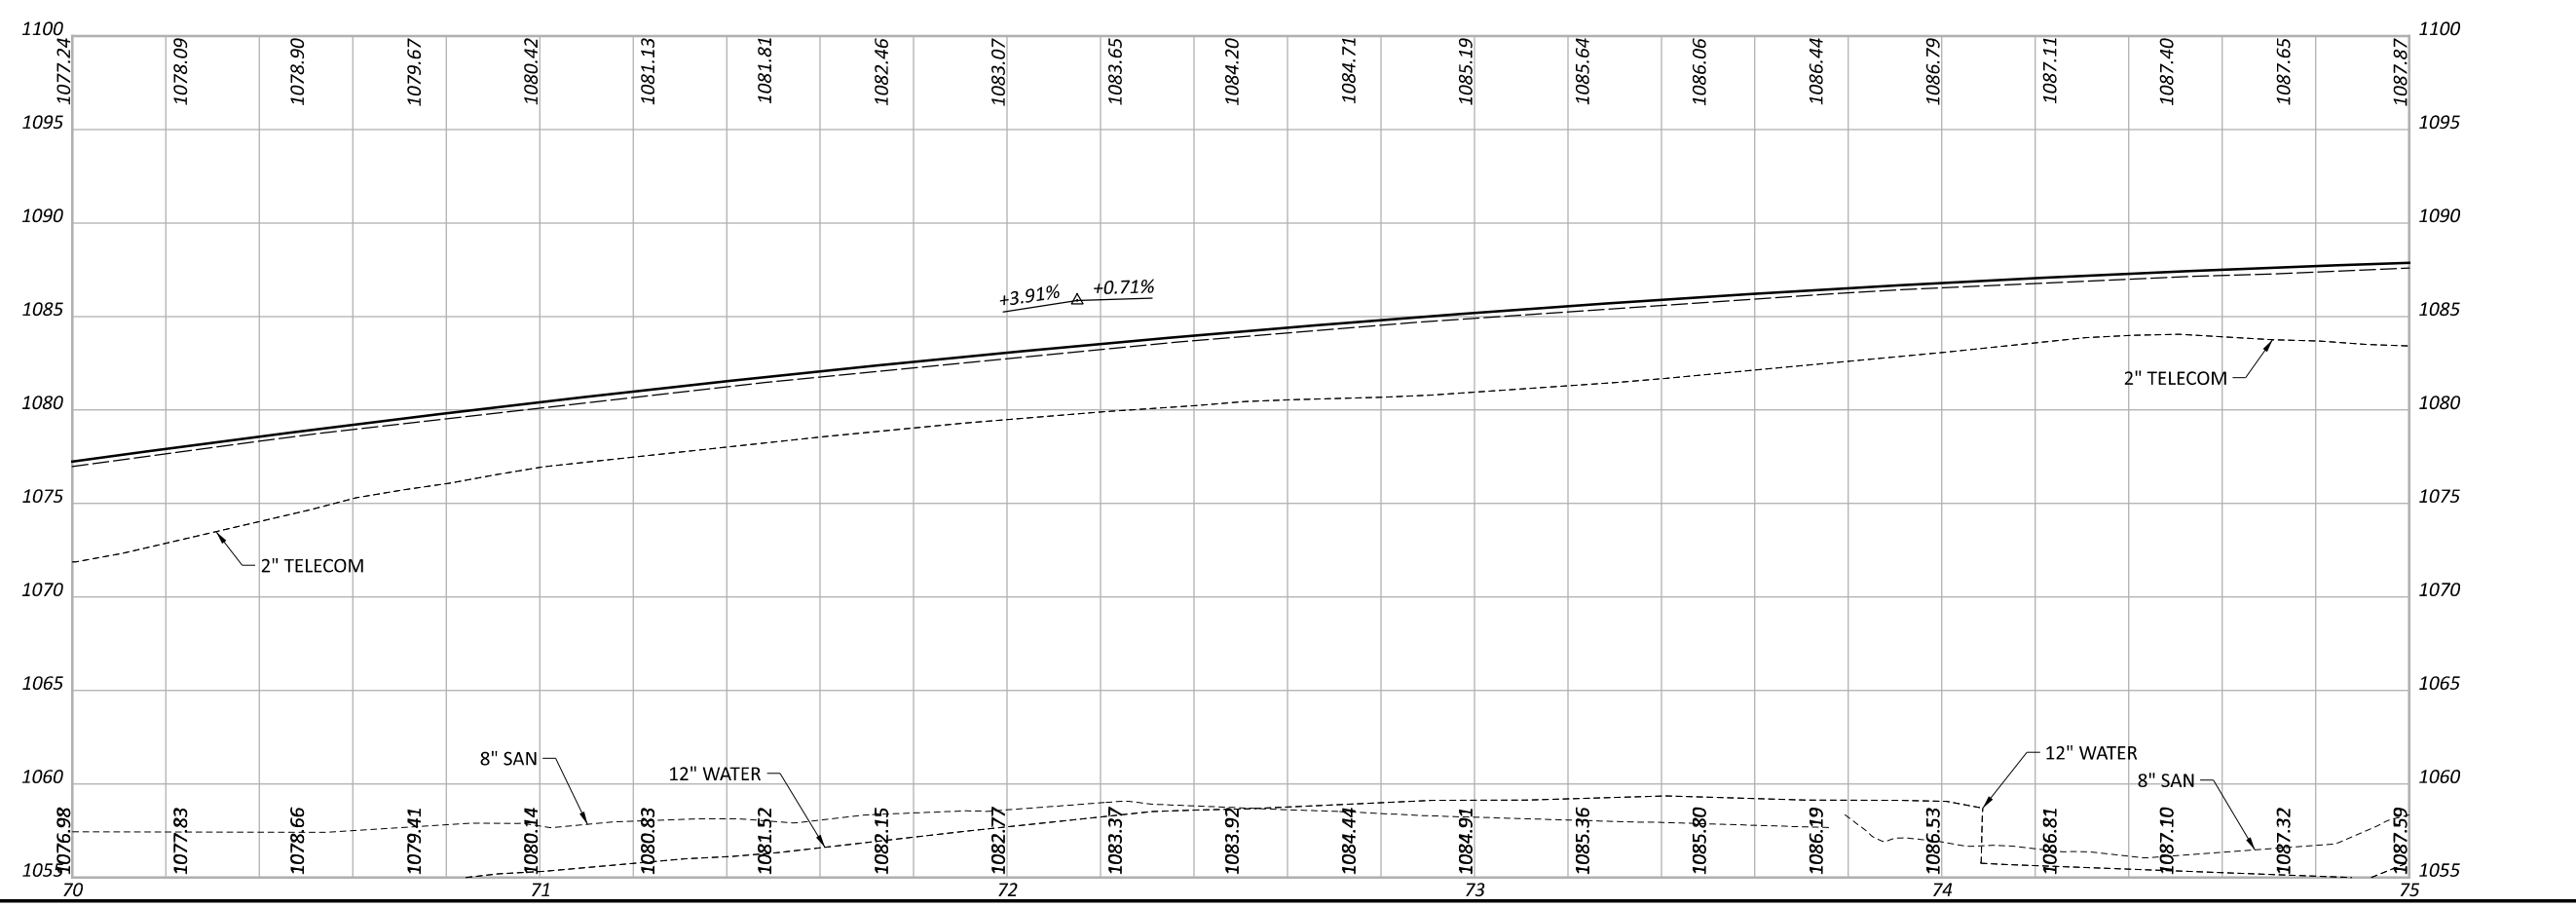
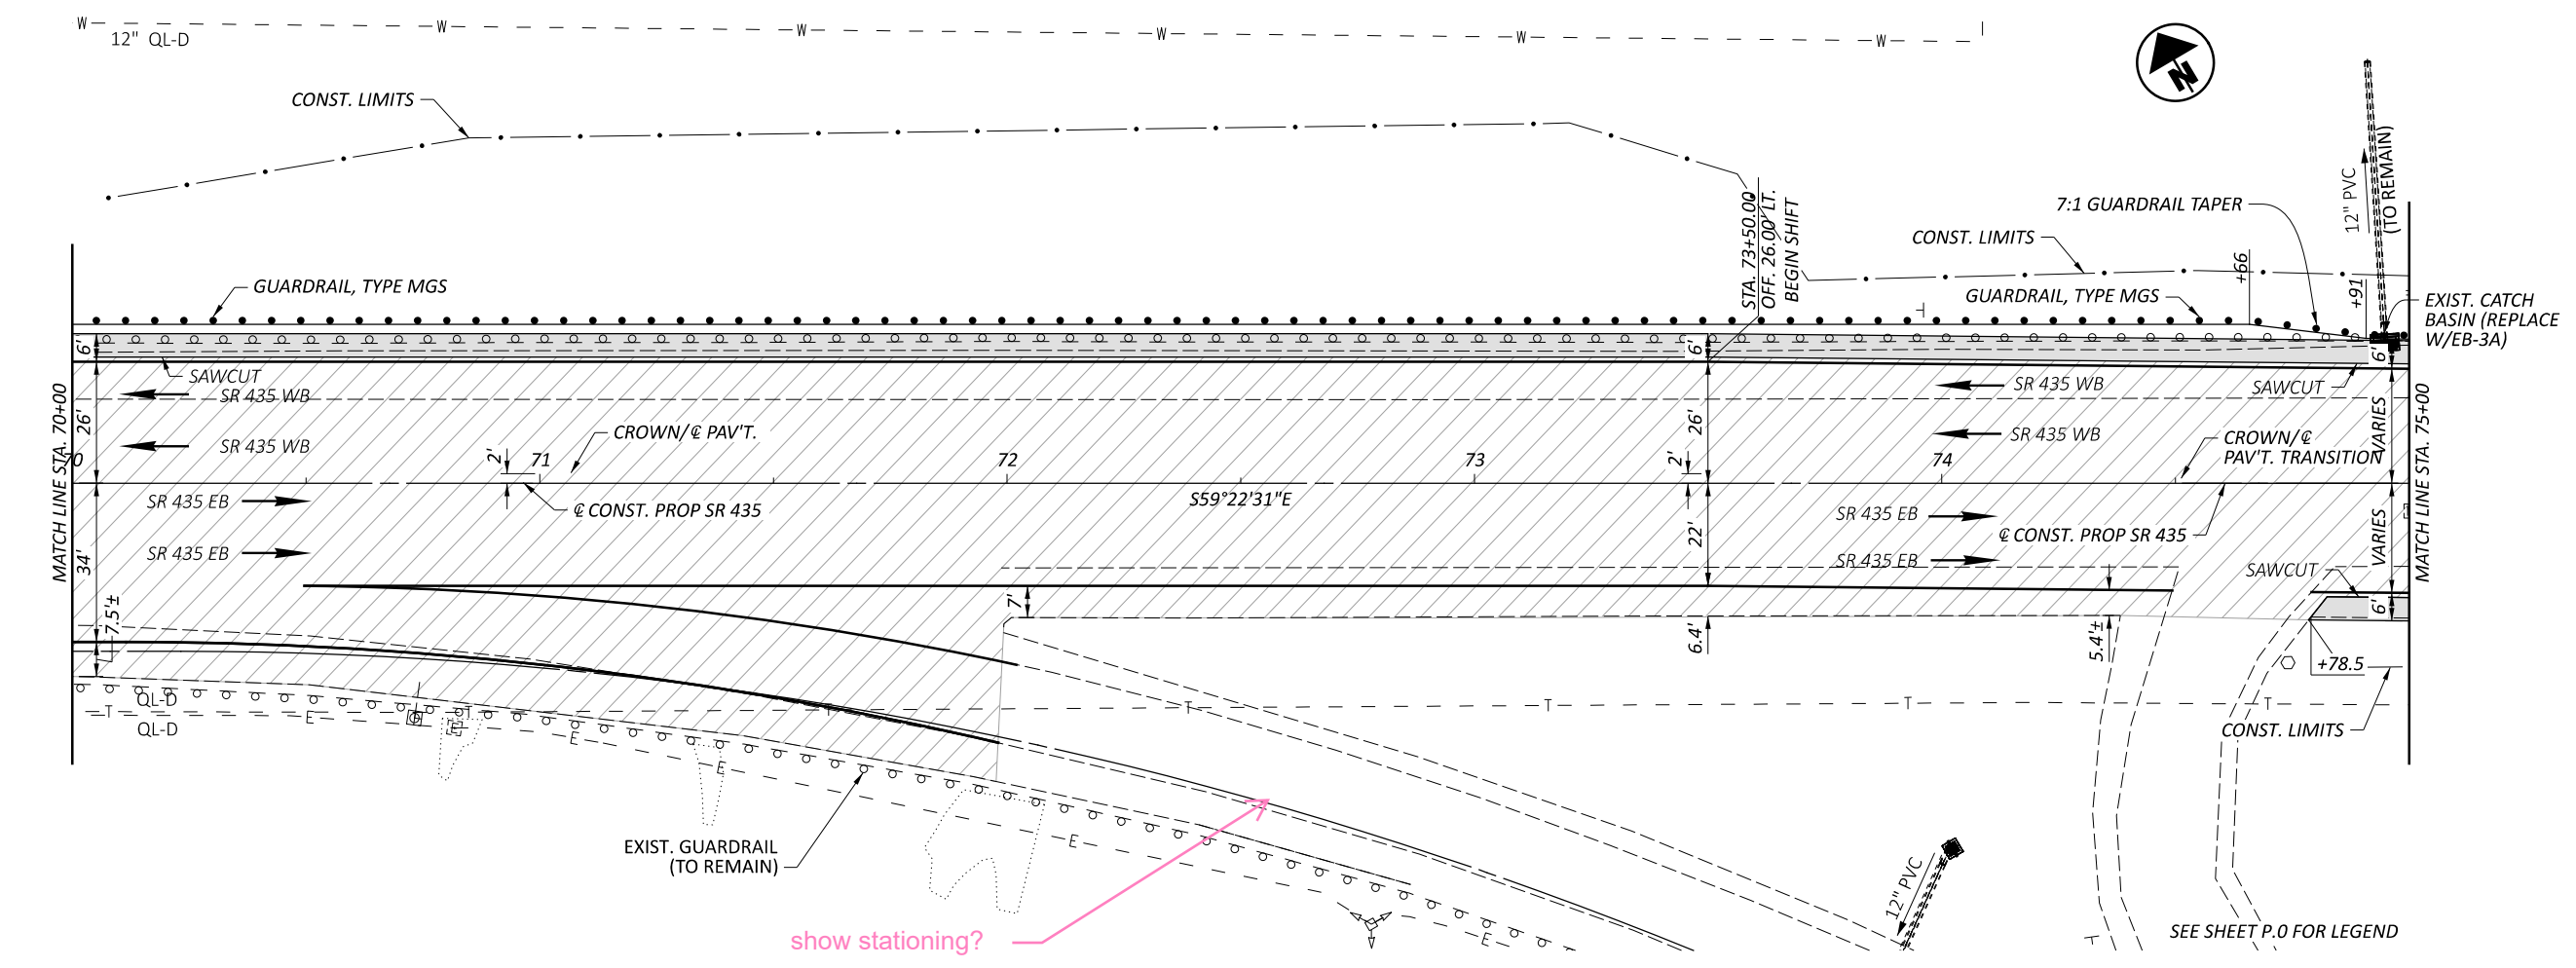


PLAN AND PROFILE
 S.R. 435 STA 70+00 TO STA 75+00

DESIGN AGENCY	
8350 E. KEMPER RD. SUITE B CINCINNATI, OH 45249 513-469-1600	
DESIGNER	DPF
REVIEWER	DCJ MM-DD-YY
PROJECT ID	117955
SHEET	TOTAL
P. 100	228

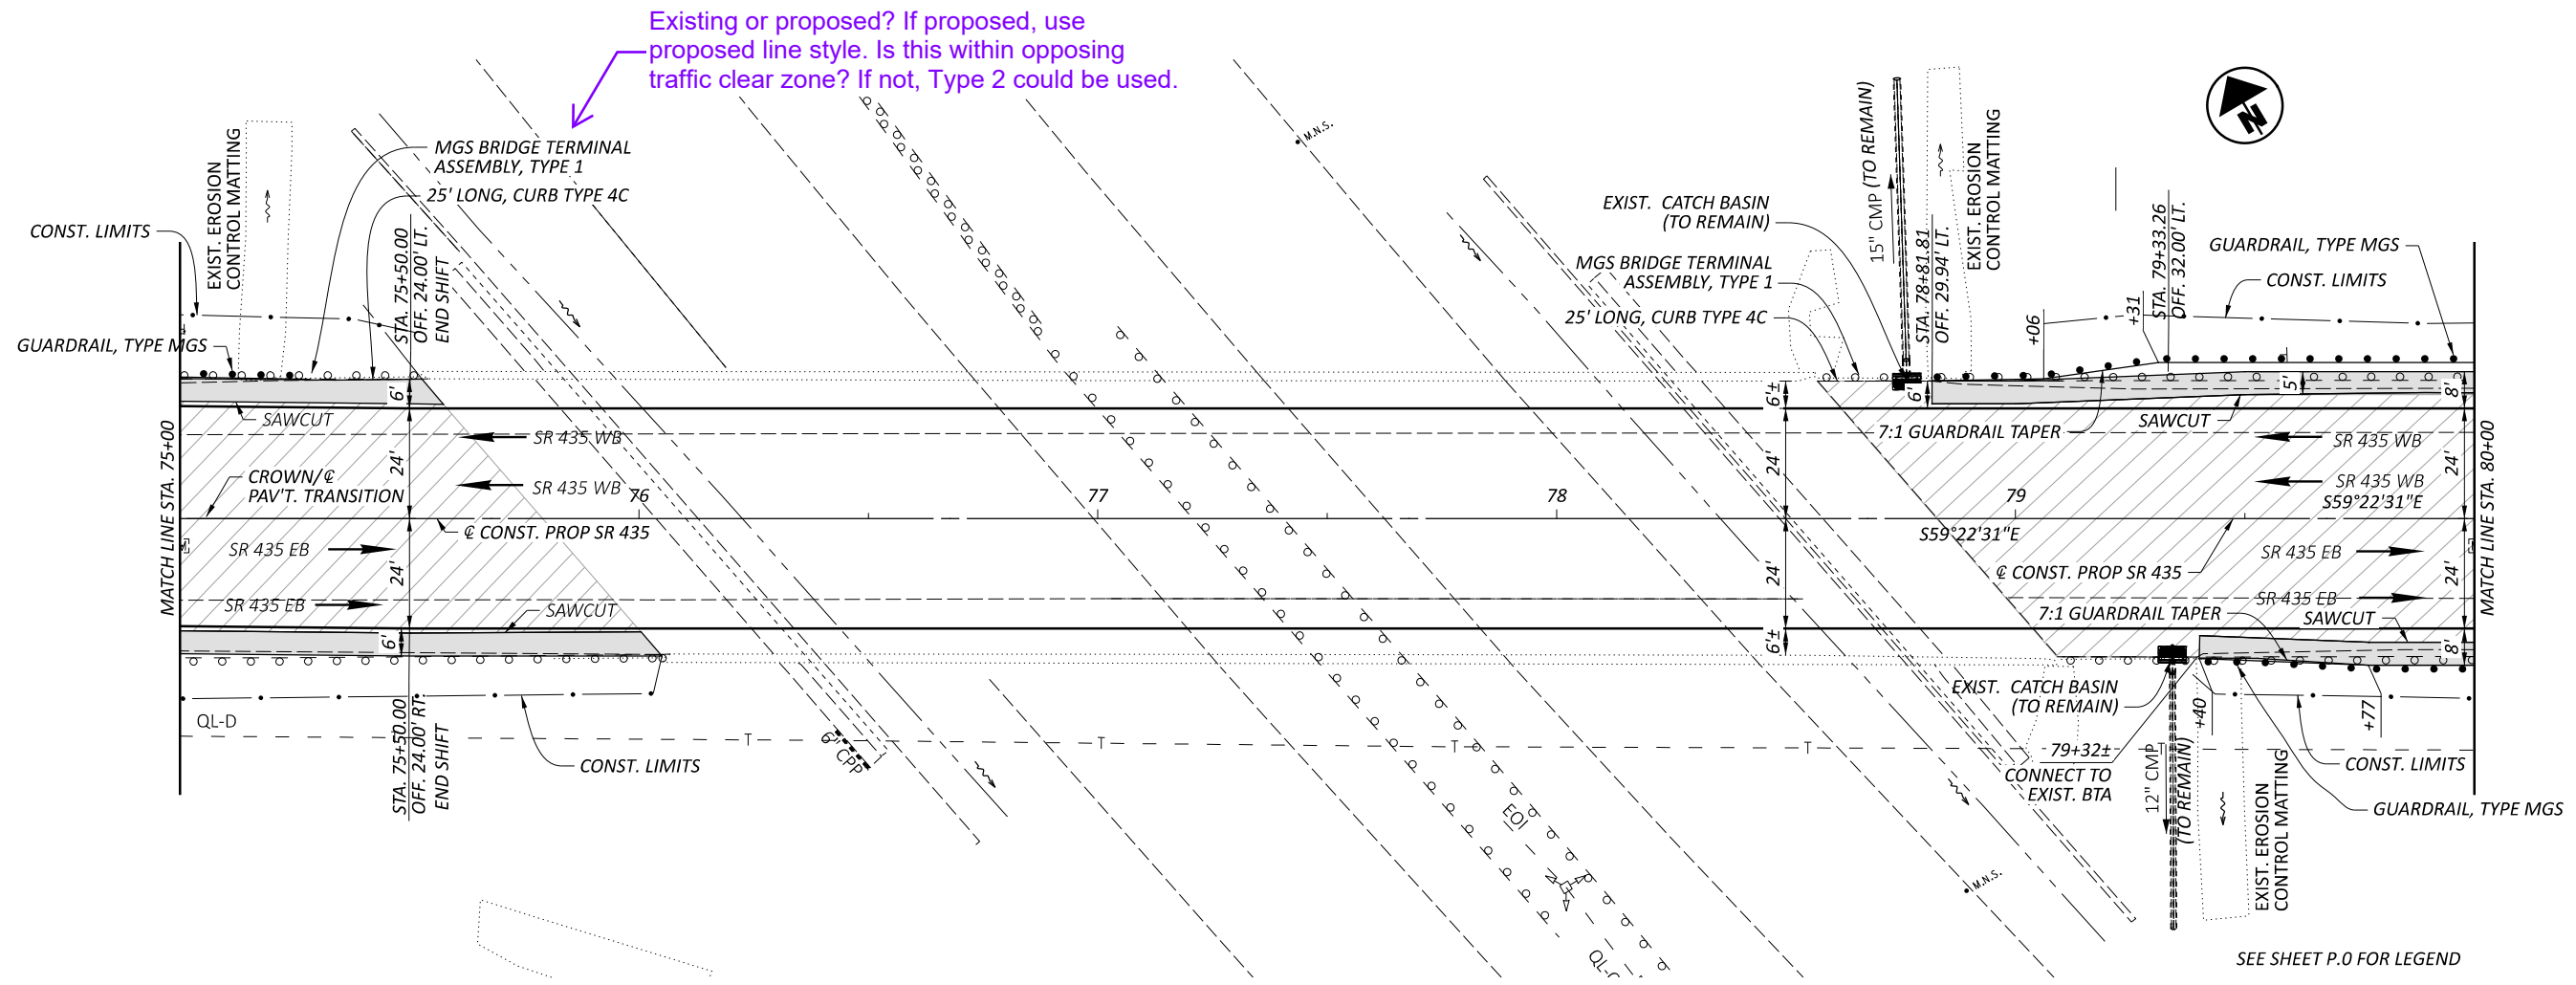

Existing or proposed? If proposed, use proposed line style. Is this within opposing traffic clear zone? If not, Type 2 could be used.

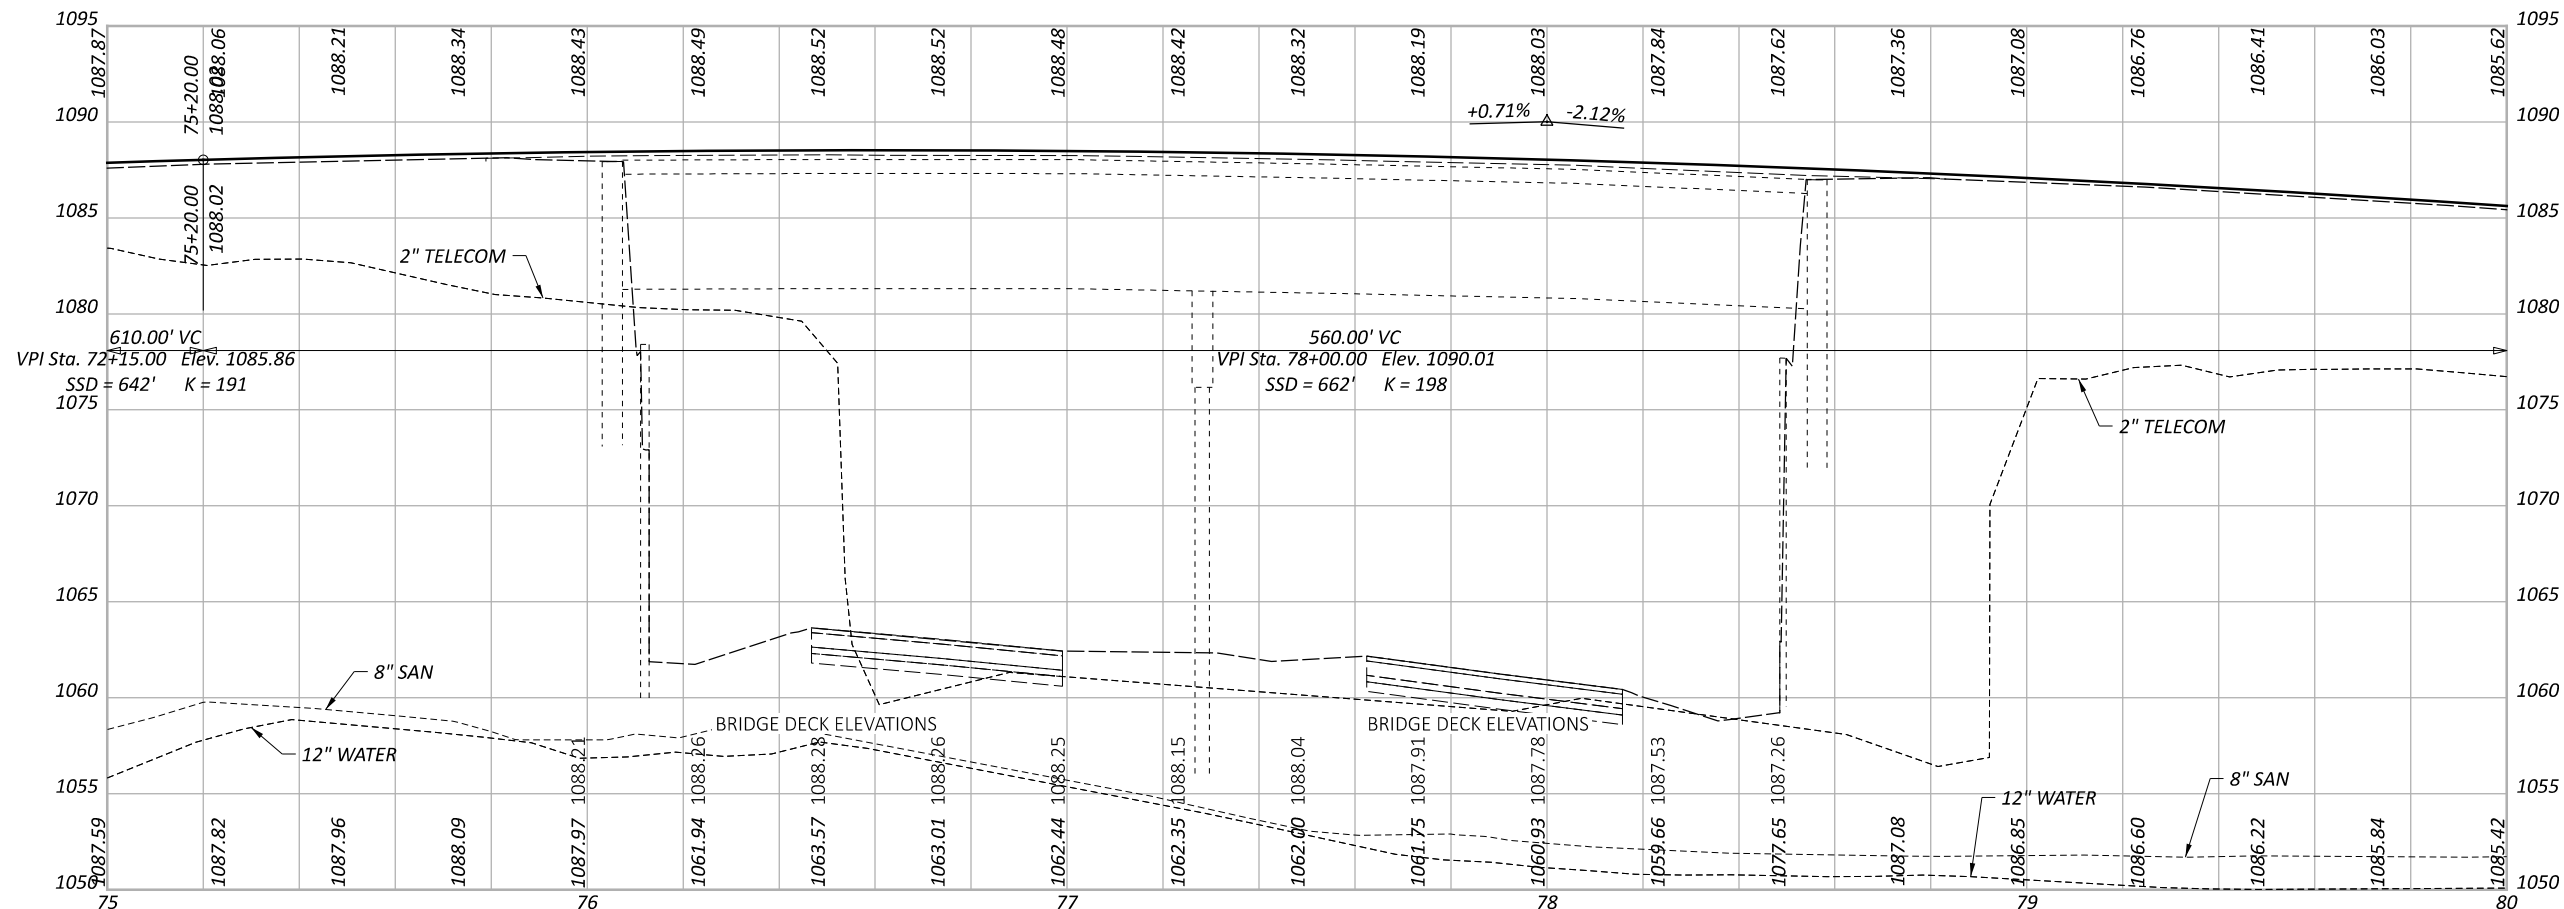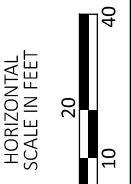

PLAN AND PROFILE
 S.R. 435 STA 75+00 TO STA 80+00


DESIGN AGENCY
Palmer
 ENGINEERING
 8350 E. KEMPER RD.
 SUITE B
 CINCINNATI, OH 45249
 513-469-1600

DESIGNER
 DPF


REVIEWER
 DCJ MM-DD-YY

PROJECT ID
 117955

SHEET TOTAL
 P. 101 228

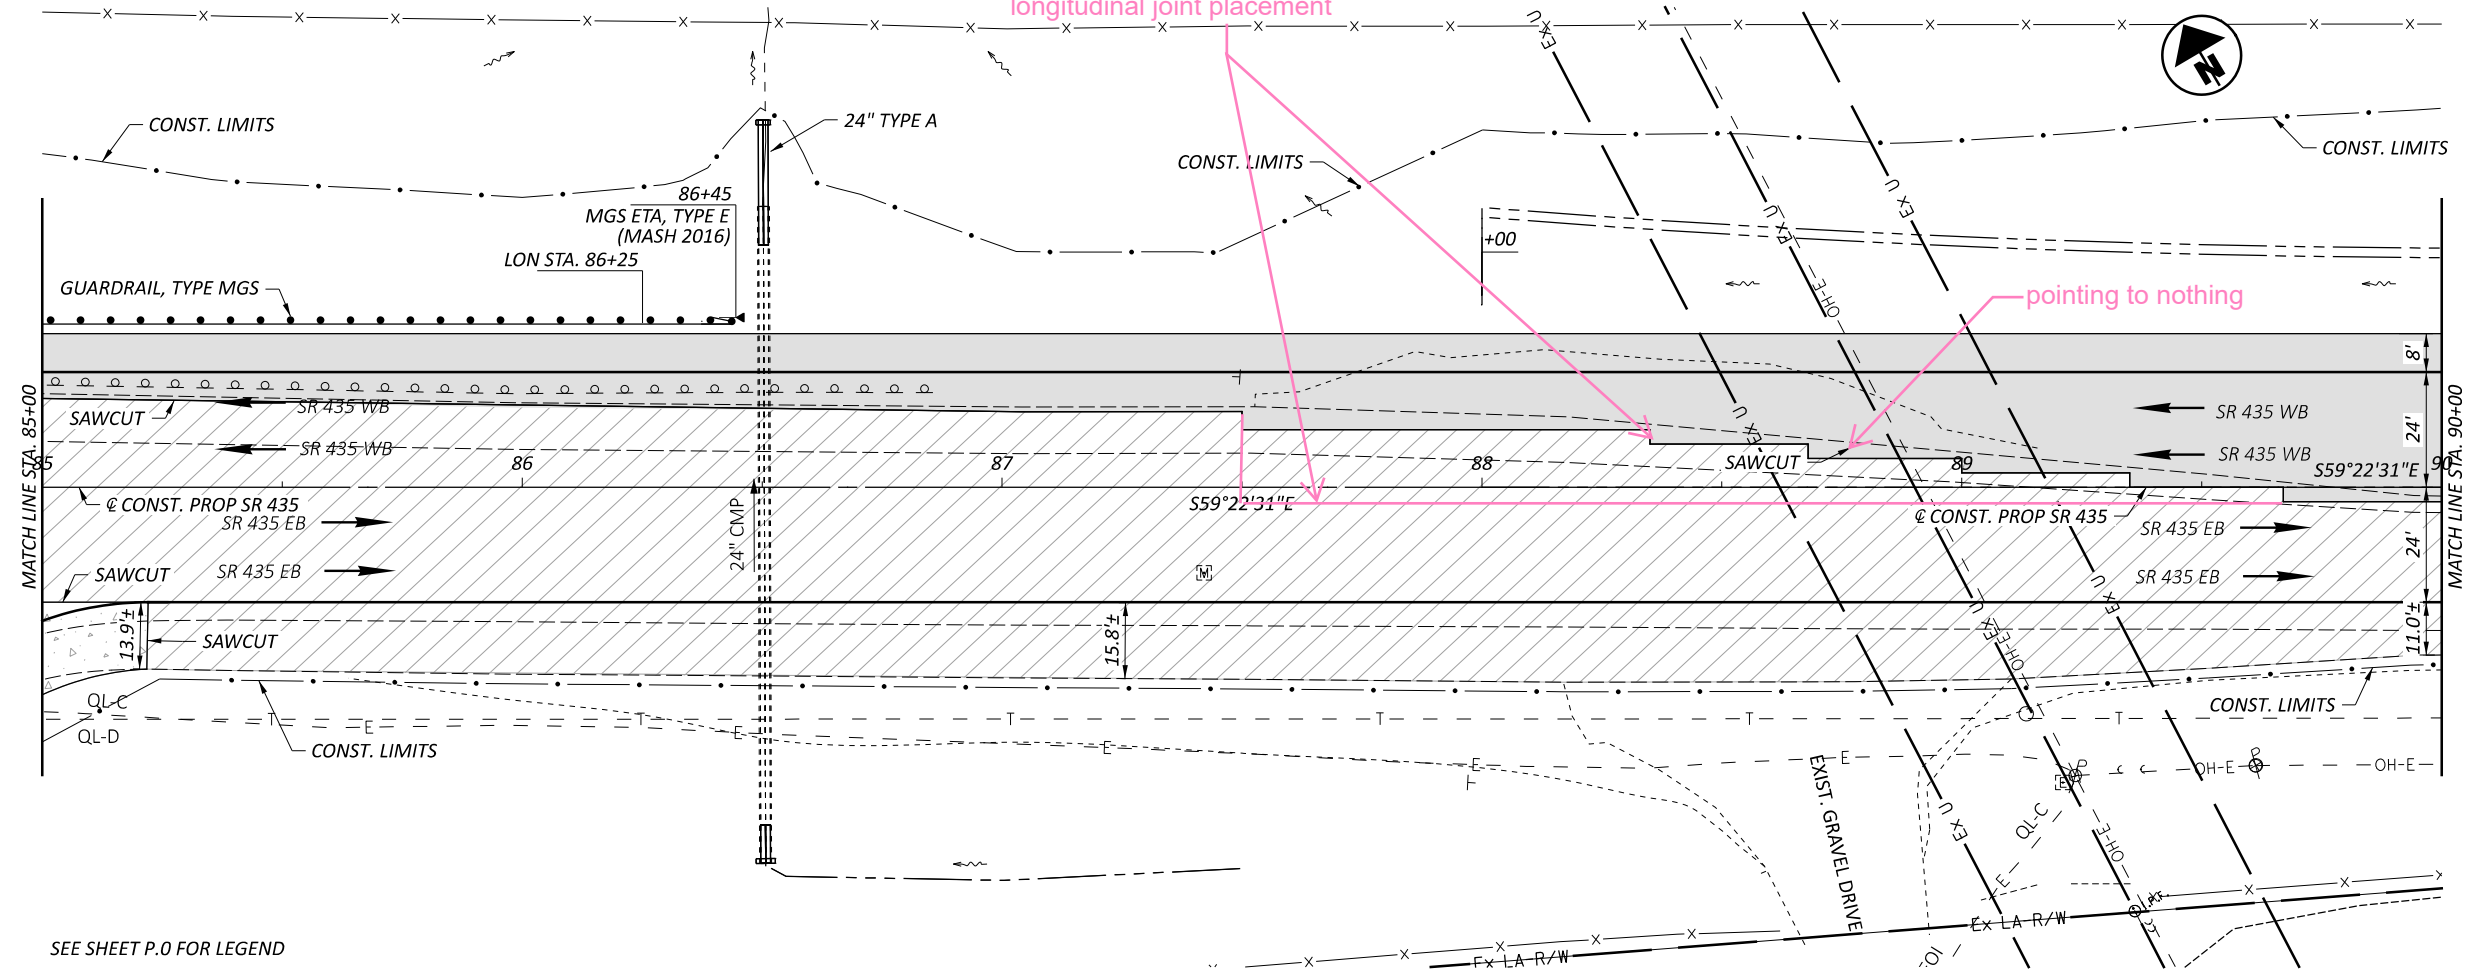


SEE SHEET P.O FOR LEGEND

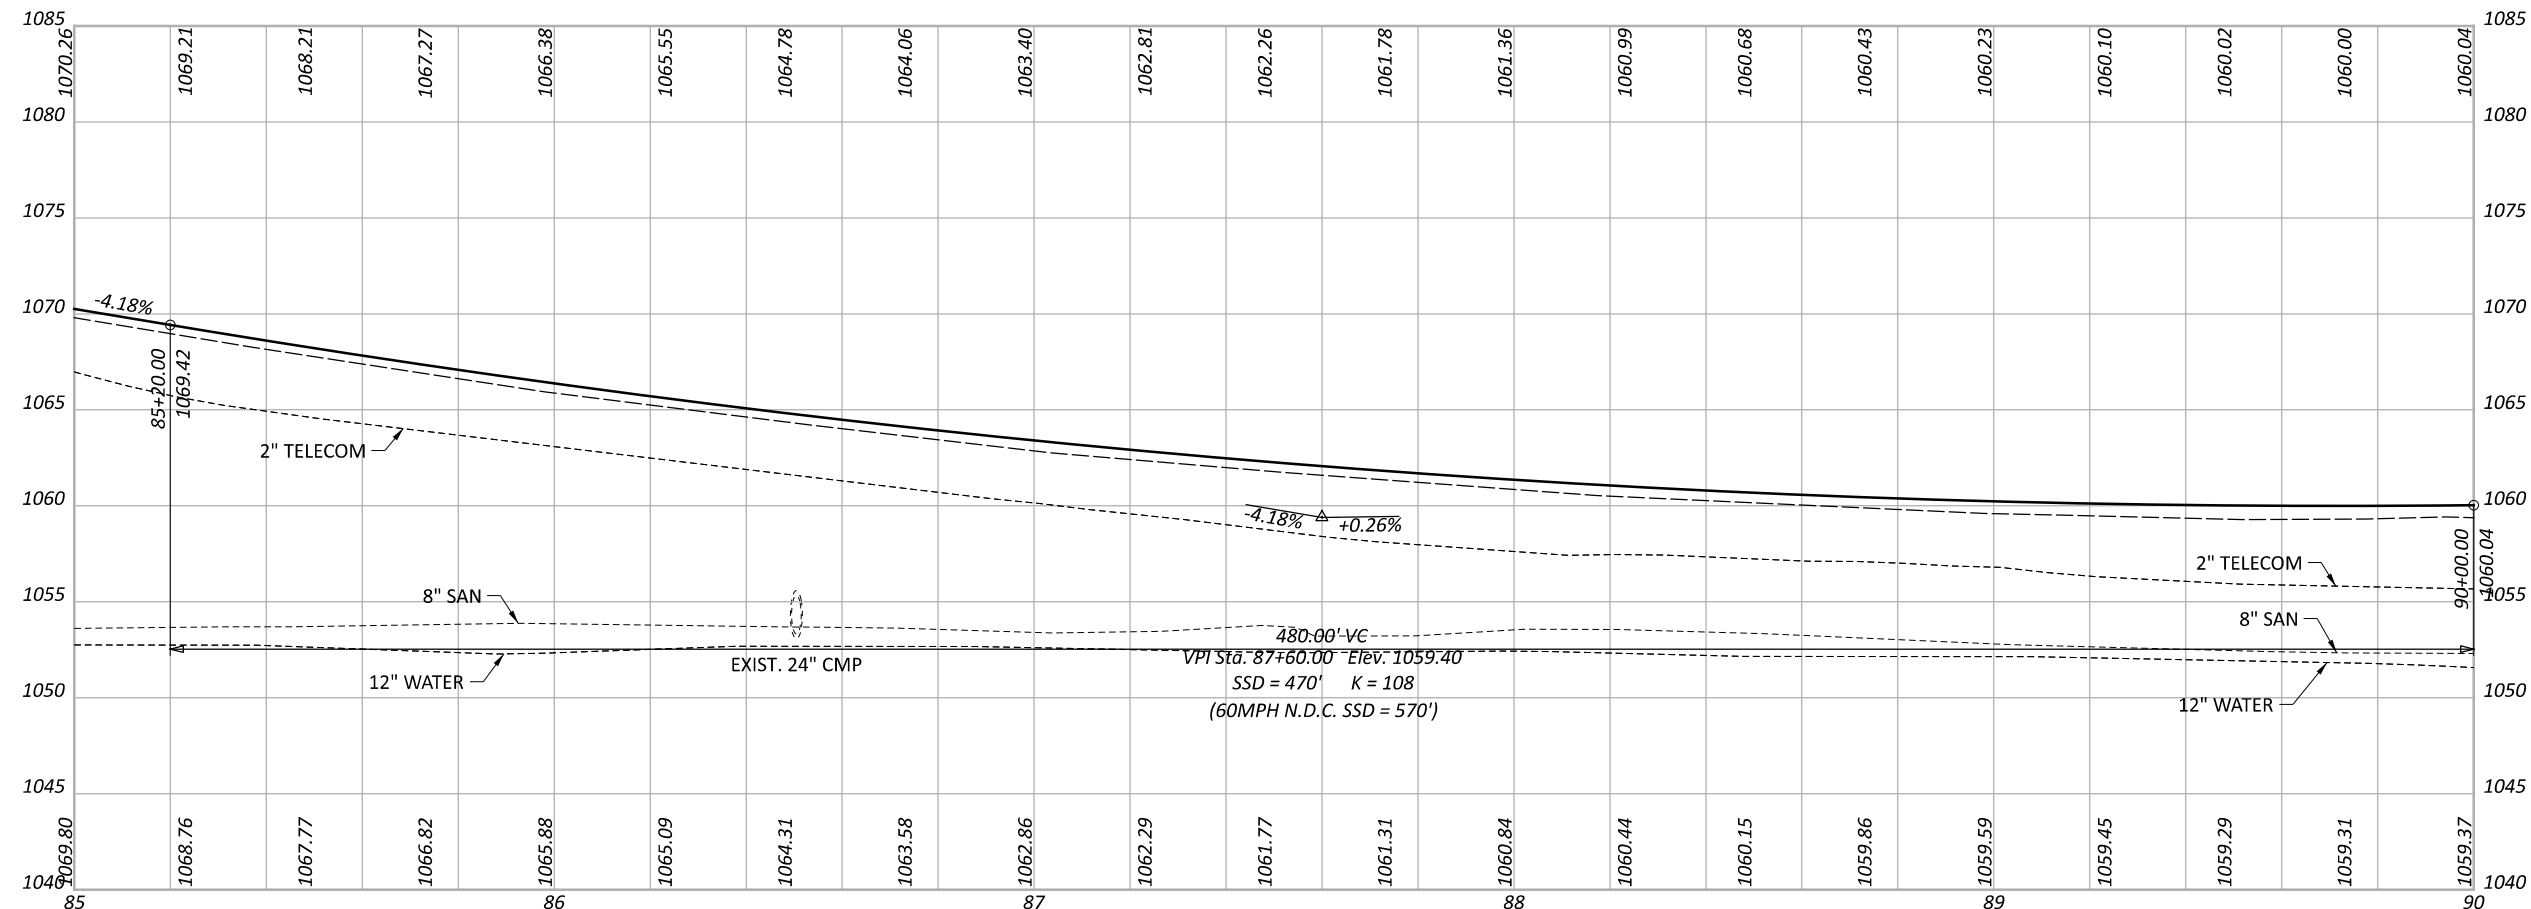

what is this stair step sawcut?

square it up and follow PDM on longitudinal joint placement

pointing to nothing

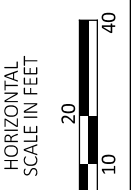

PLAN AND PROFILE
 S.R. 435 STA 85+00 TO STA 90+00

DESIGN AGENCY

Palmer
 ENGINEERING
 8350 E. KEMPER RD.
 SUITE B
 CINCINNATI, OH 45249
 513-469-1600

DESIGNER

DPF

REVIEWER


DCJ MM-DD-YY

PROJECT ID



117955

SHEET TOTAL

P. 103 228

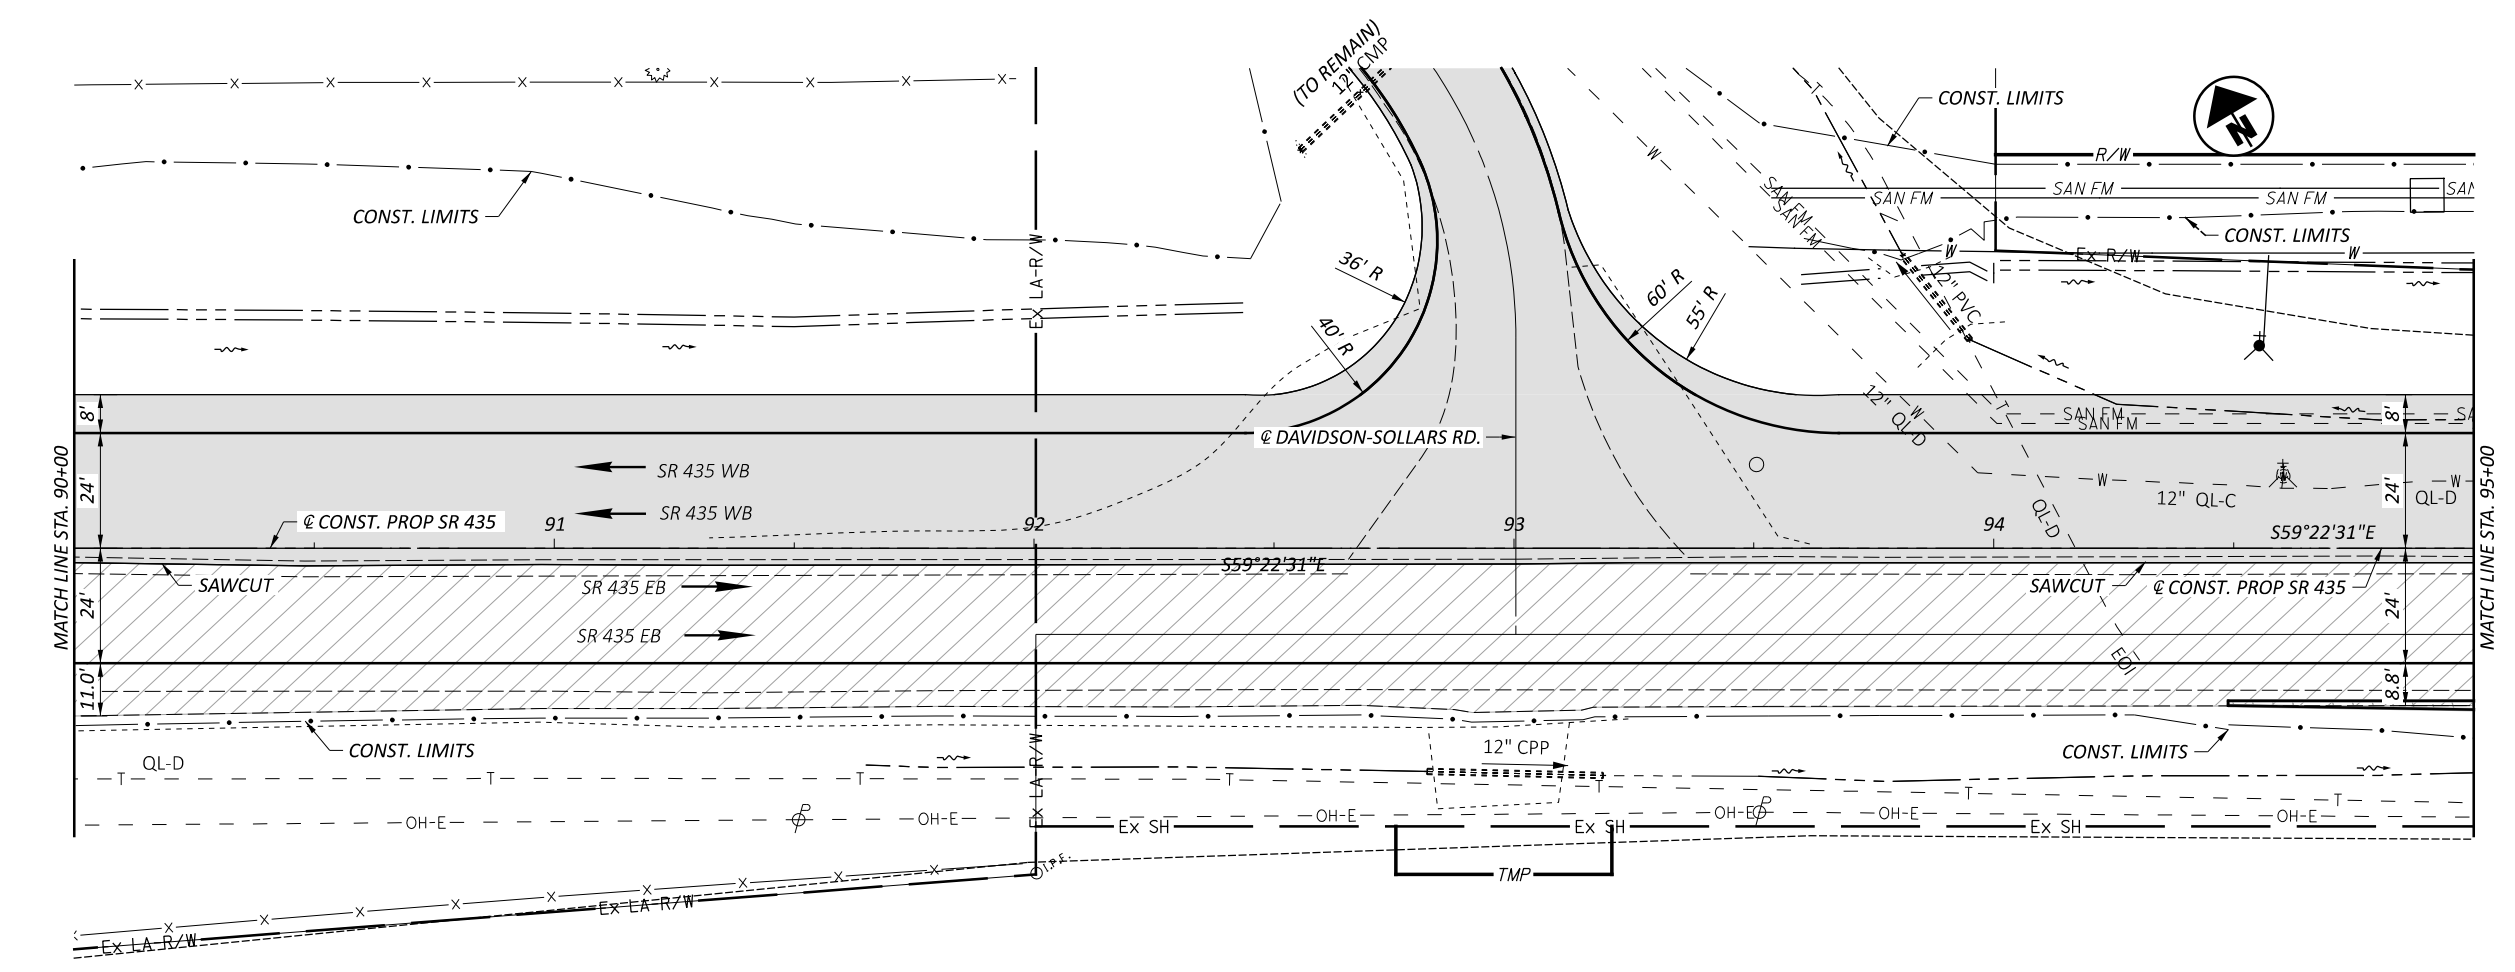


SEE SHEET P.0 FOR LEGEND

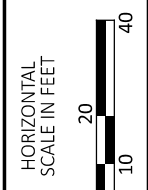
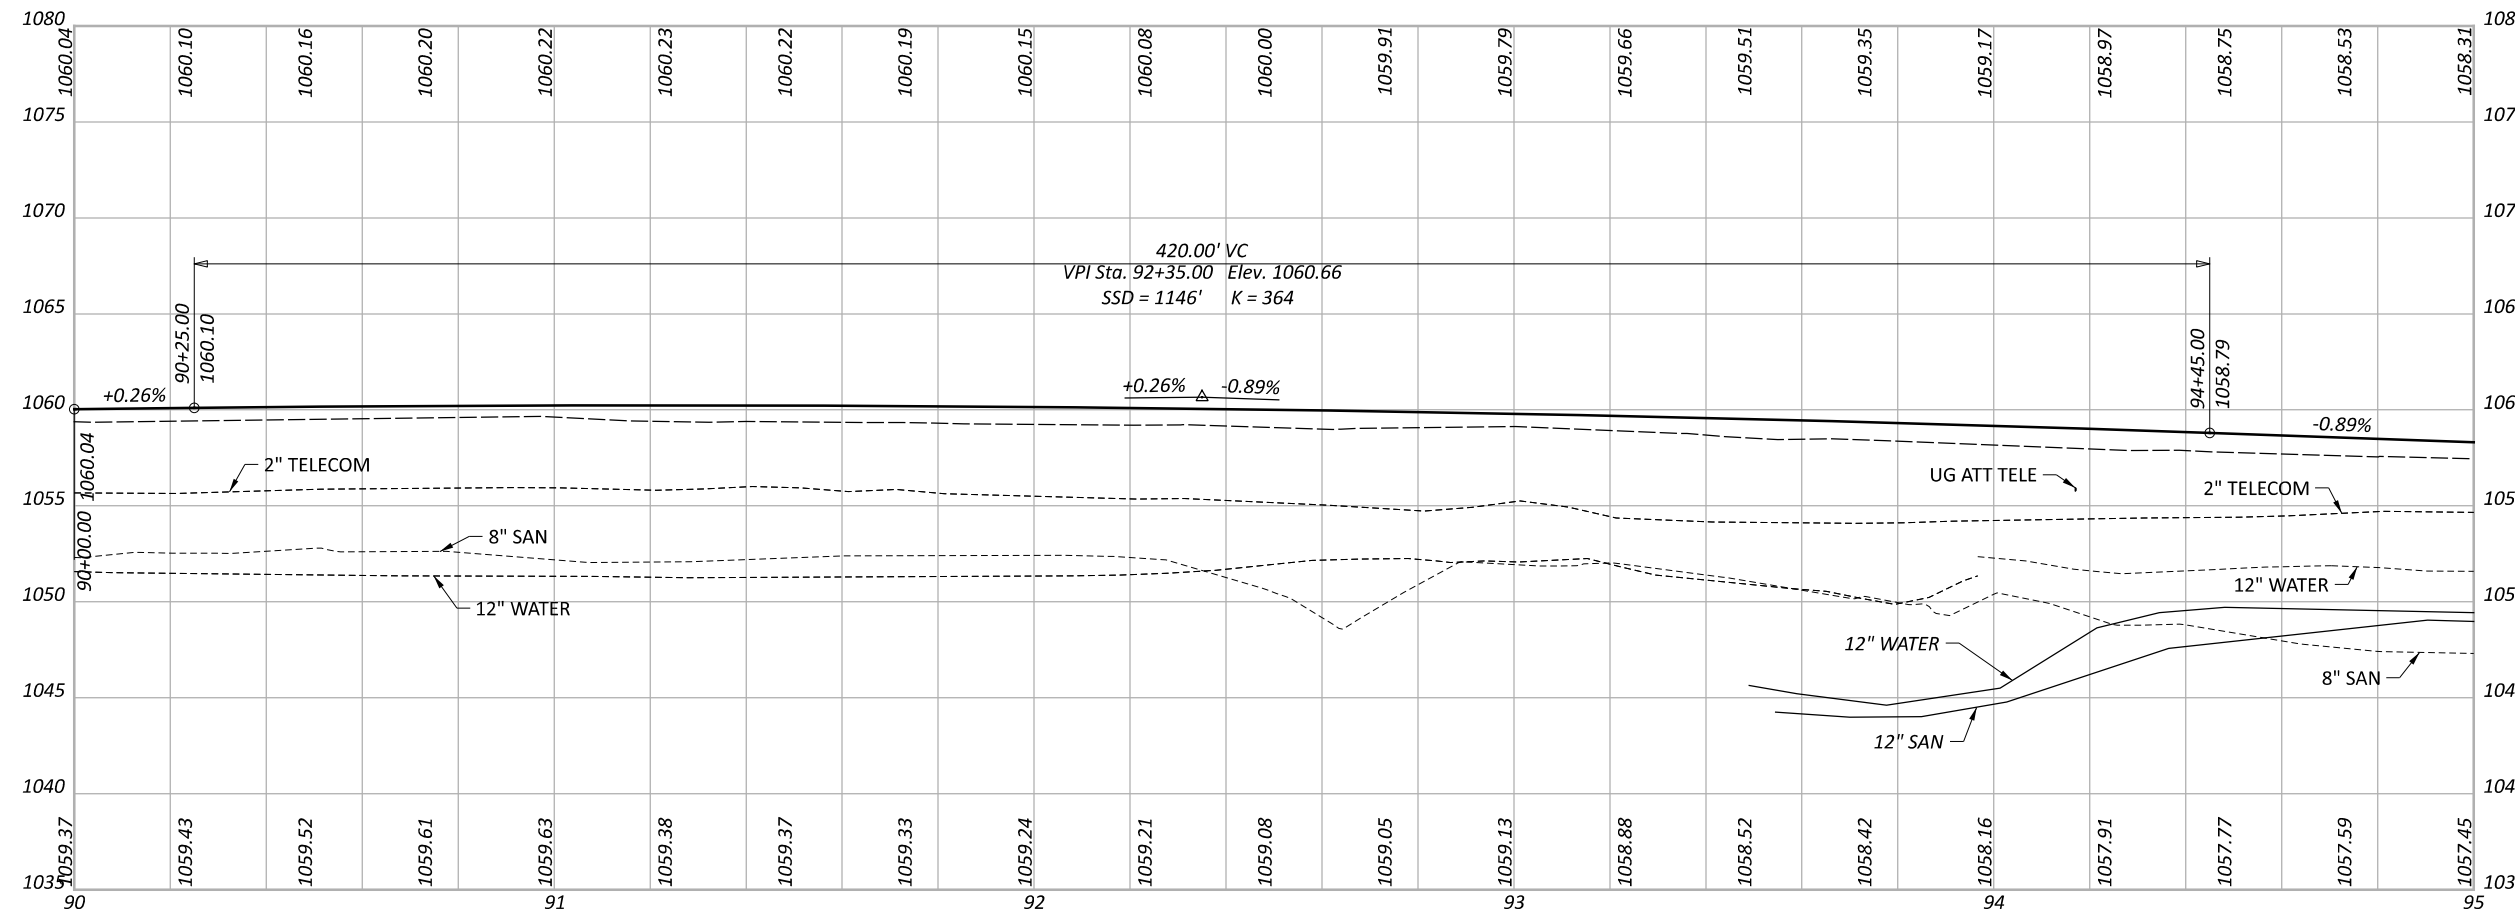


PLAN AND PROFILE
 S.R. 435 STA 90+00 TO STA 95+00

DESIGN AGENCY	
8350 E. KEMPER RD. SUITE B CINCINNATI, OH 45249 513-469-1600	
DESIGNER	
DPF	
REVIEWER	
DCJ MM-DD-YY	
PROJECT ID	
117955	
SHEET	TOTAL
P. 104	228

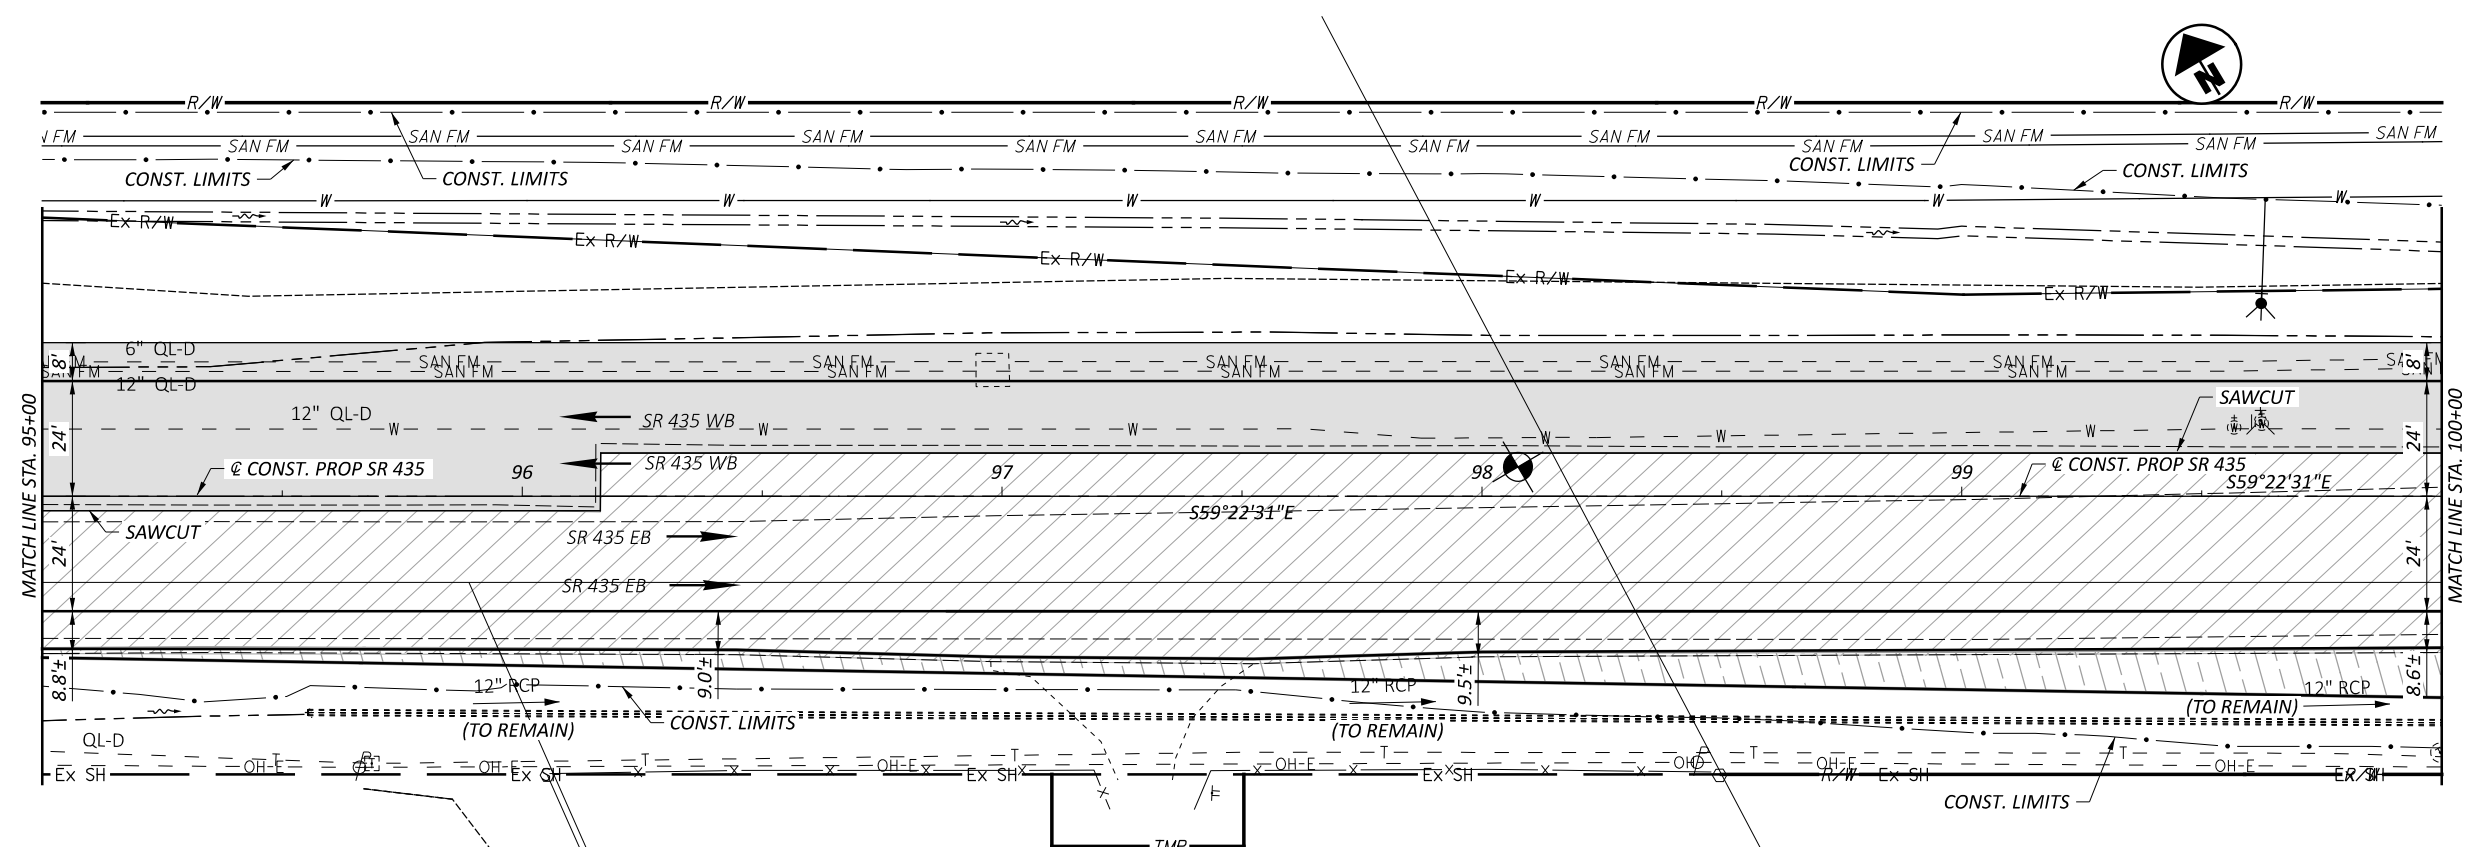


SEE SHEET P.0 FOR LEGEND

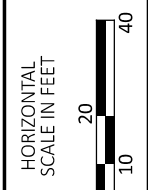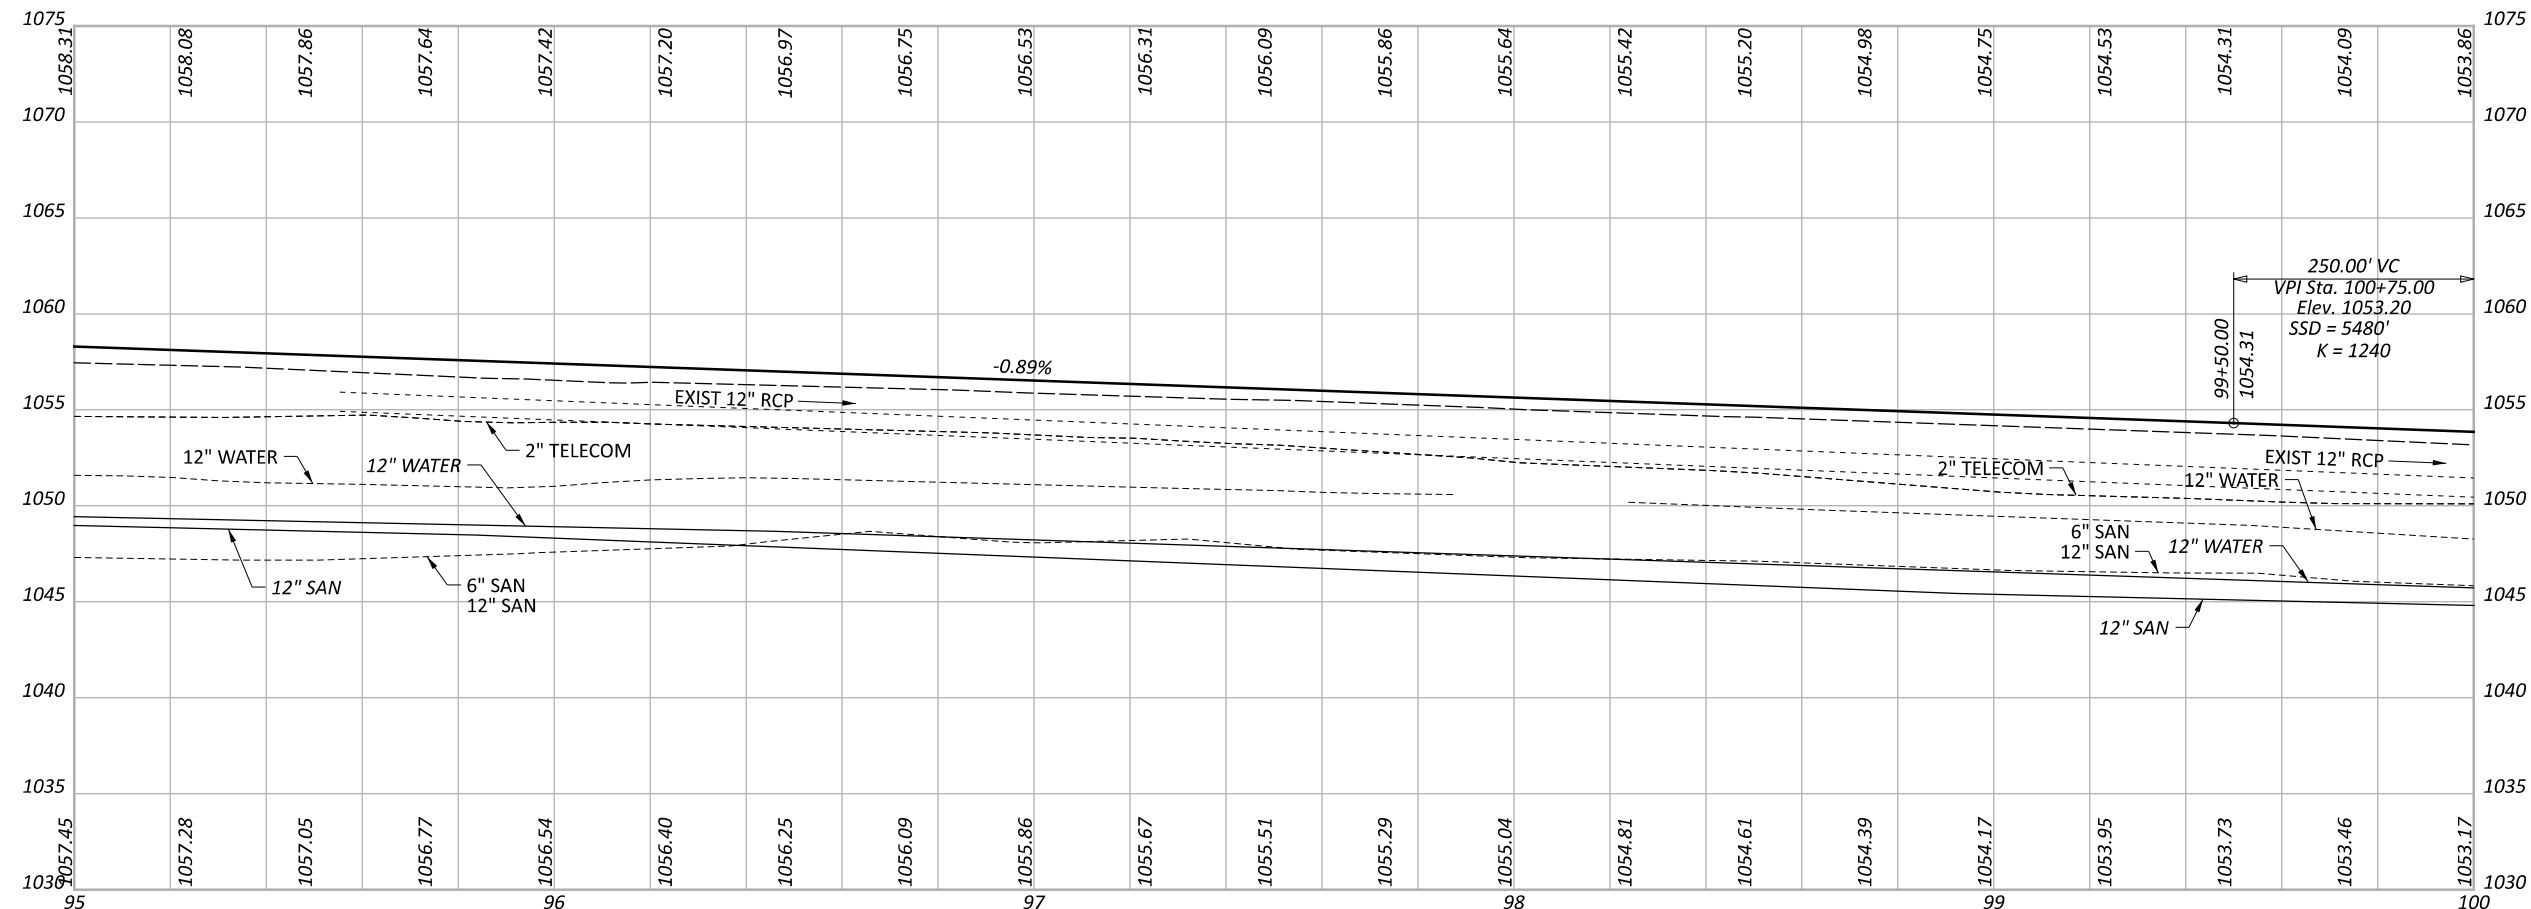

PLAN AND PROFILE
 S.R. 435 STA 95+00 TO STA 100+00

DESIGN AGENCY	
 8350 E. KEMPER RD. SUITE B CINCINNATI, OH 45249 513-469-1600	
DESIGNER	
DPF	
REVIEWER	
DCJ MM-DD-YY	
PROJECT ID	
117955	
SHEET	TOTAL
P. 105	228

SEE SHEET P.0 FOR LEGEND


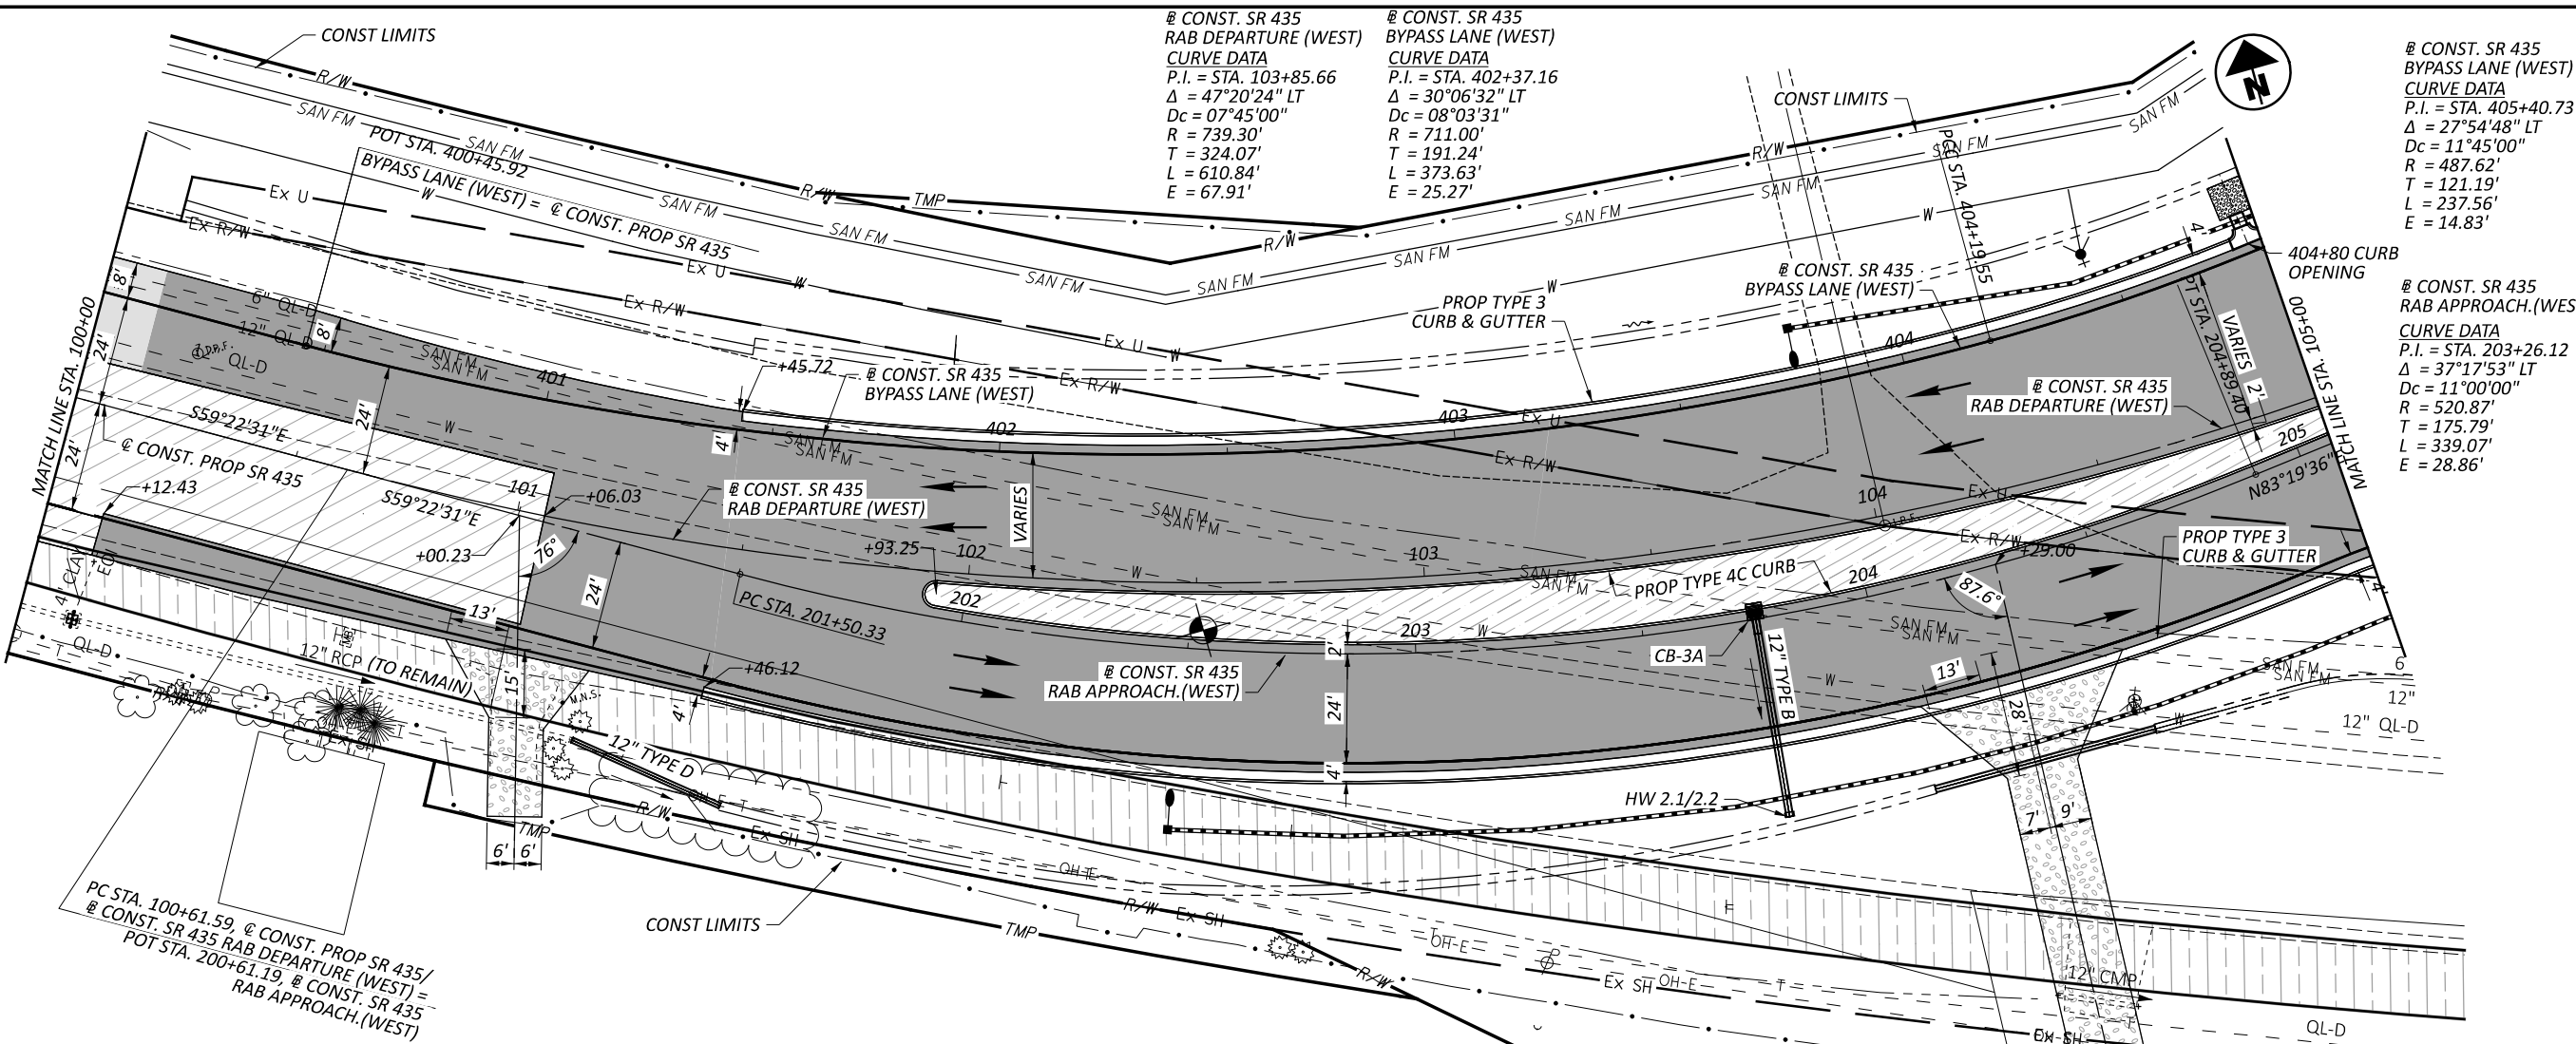


@ CONST. SR 435
 RAB DEPARTURE (WEST)
 CURVE DATA
 P.I. = STA. 103+85.66
 $\Delta = 47^{\circ}20'24''$ LT
 $Dc = 07^{\circ}45'00''$
 $R = 739.30'$
 $T = 324.07'$
 $L = 610.84'$
 $E = 67.91'$

@ CONST. SR 435
 BYPASS LANE (WEST)
 CURVE DATA
 P.I. = STA. 402+37.16
 $\Delta = 30^{\circ}06'32''$ LT
 $Dc = 08^{\circ}03'31''$
 $R = 711.00'$
 $T = 191.24'$
 $L = 373.63'$
 $E = 25.27'$

@ CONST. SR 435
 BYPASS LANE (WEST)
 CURVE DATA
 P.I. = STA. 405+40.73
 $\Delta = 27^{\circ}54'48''$ LT
 $Dc = 11^{\circ}45'00''$
 $R = 487.62'$
 $T = 121.19'$
 $L = 237.56'$
 $E = 14.83'$

@ CONST. SR 435
 RAB APPROACH (WEST)
 CURVE DATA
 P.I. = STA. 203+26.12
 $\Delta = 37^{\circ}17'53''$ LT
 $Dc = 11^{\circ}00'00''$
 $R = 520.87'$
 $T = 175.79'$
 $L = 339.07'$
 $E = 28.86'$

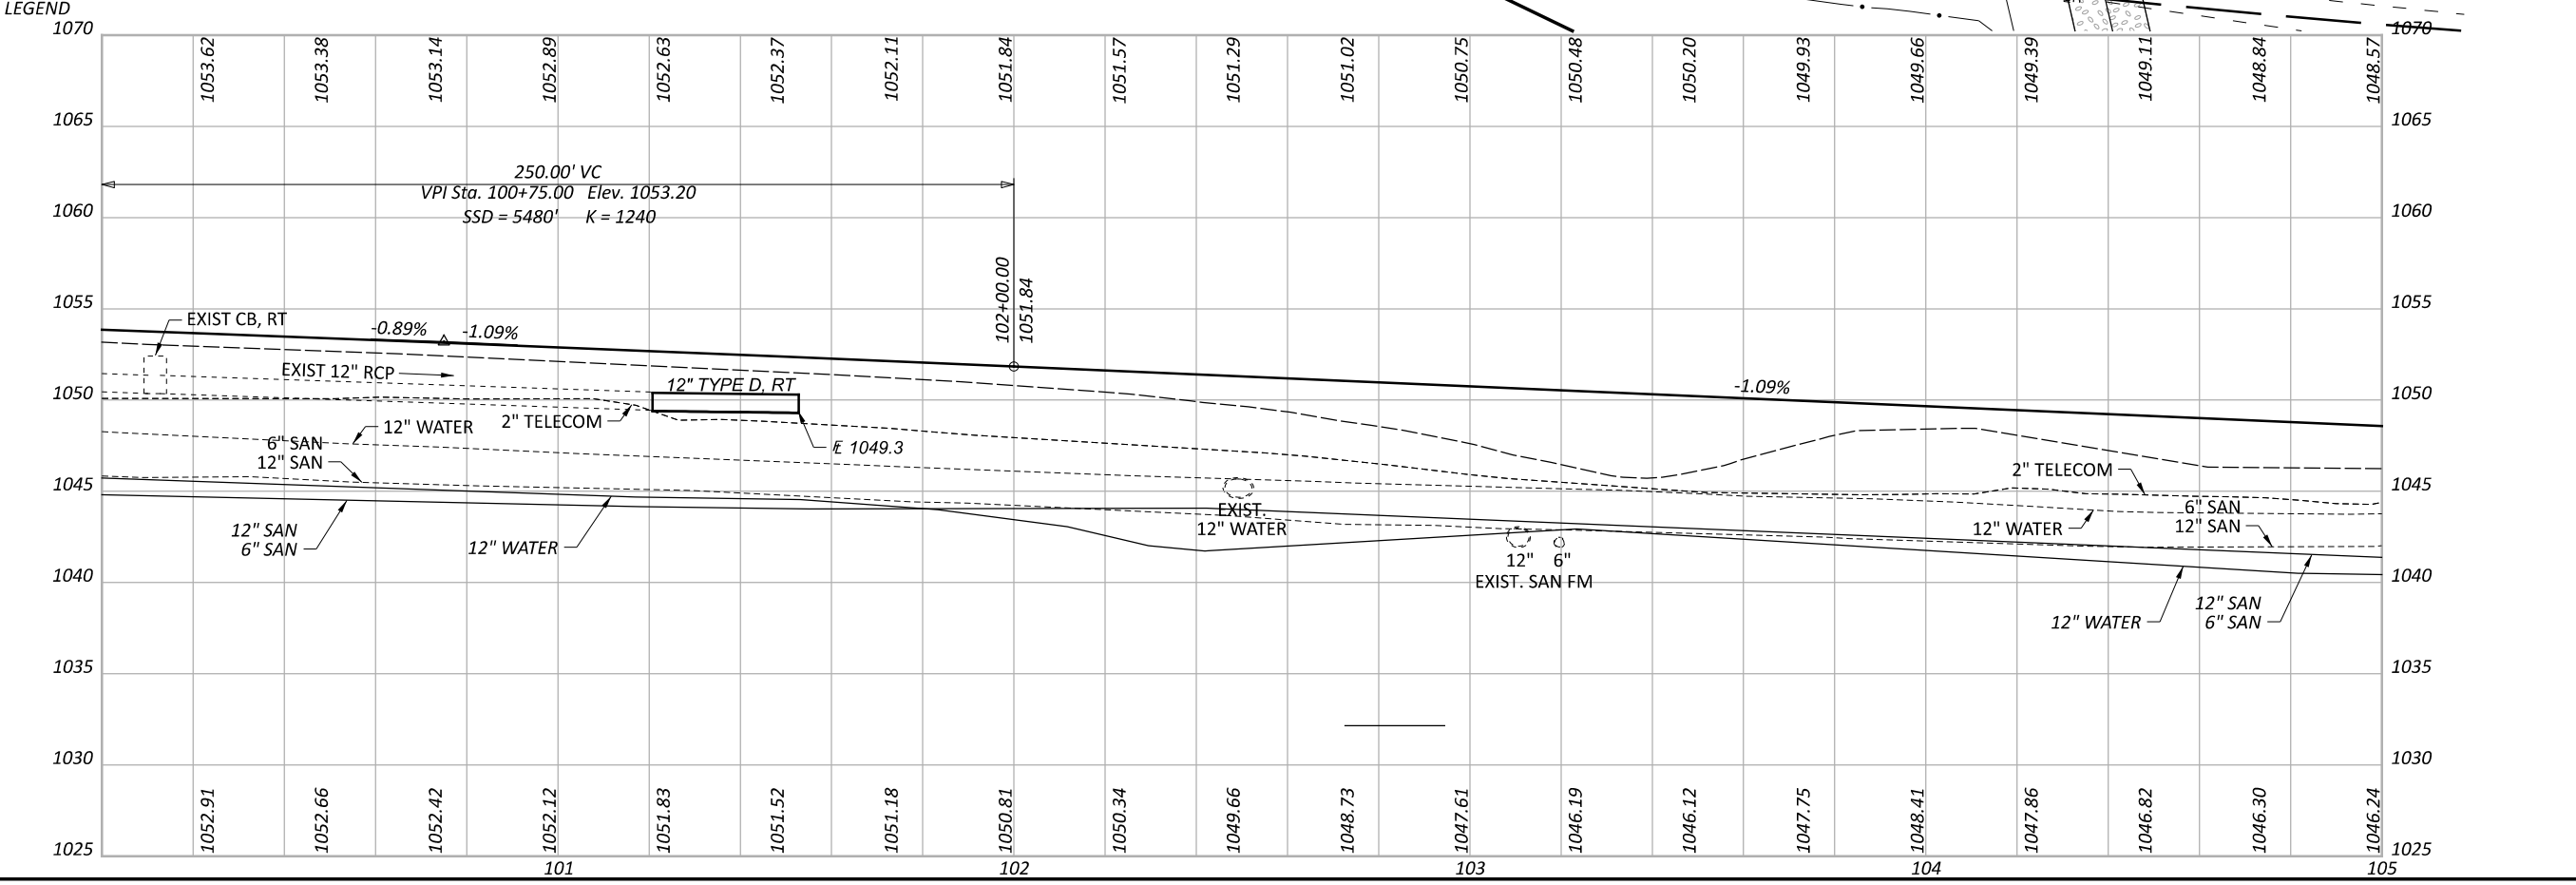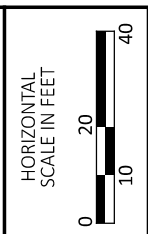

PLAN AND PROFILE
 S.R. 435 (RAB WEST) STA 100+00 TO STA 105+00



DESIGN AGENCY
Palmer
 ENGINEERING
 8350 E. KEMPER RD.
 SUITE B
 CINCINNATI, OH 45249
 513-469-1600

DESIGNER
 DPF

REVIEWER
 DCJ MM-DD-YY

PROJECT ID
 117955

SHEET TOTAL
 P. 106 | 228

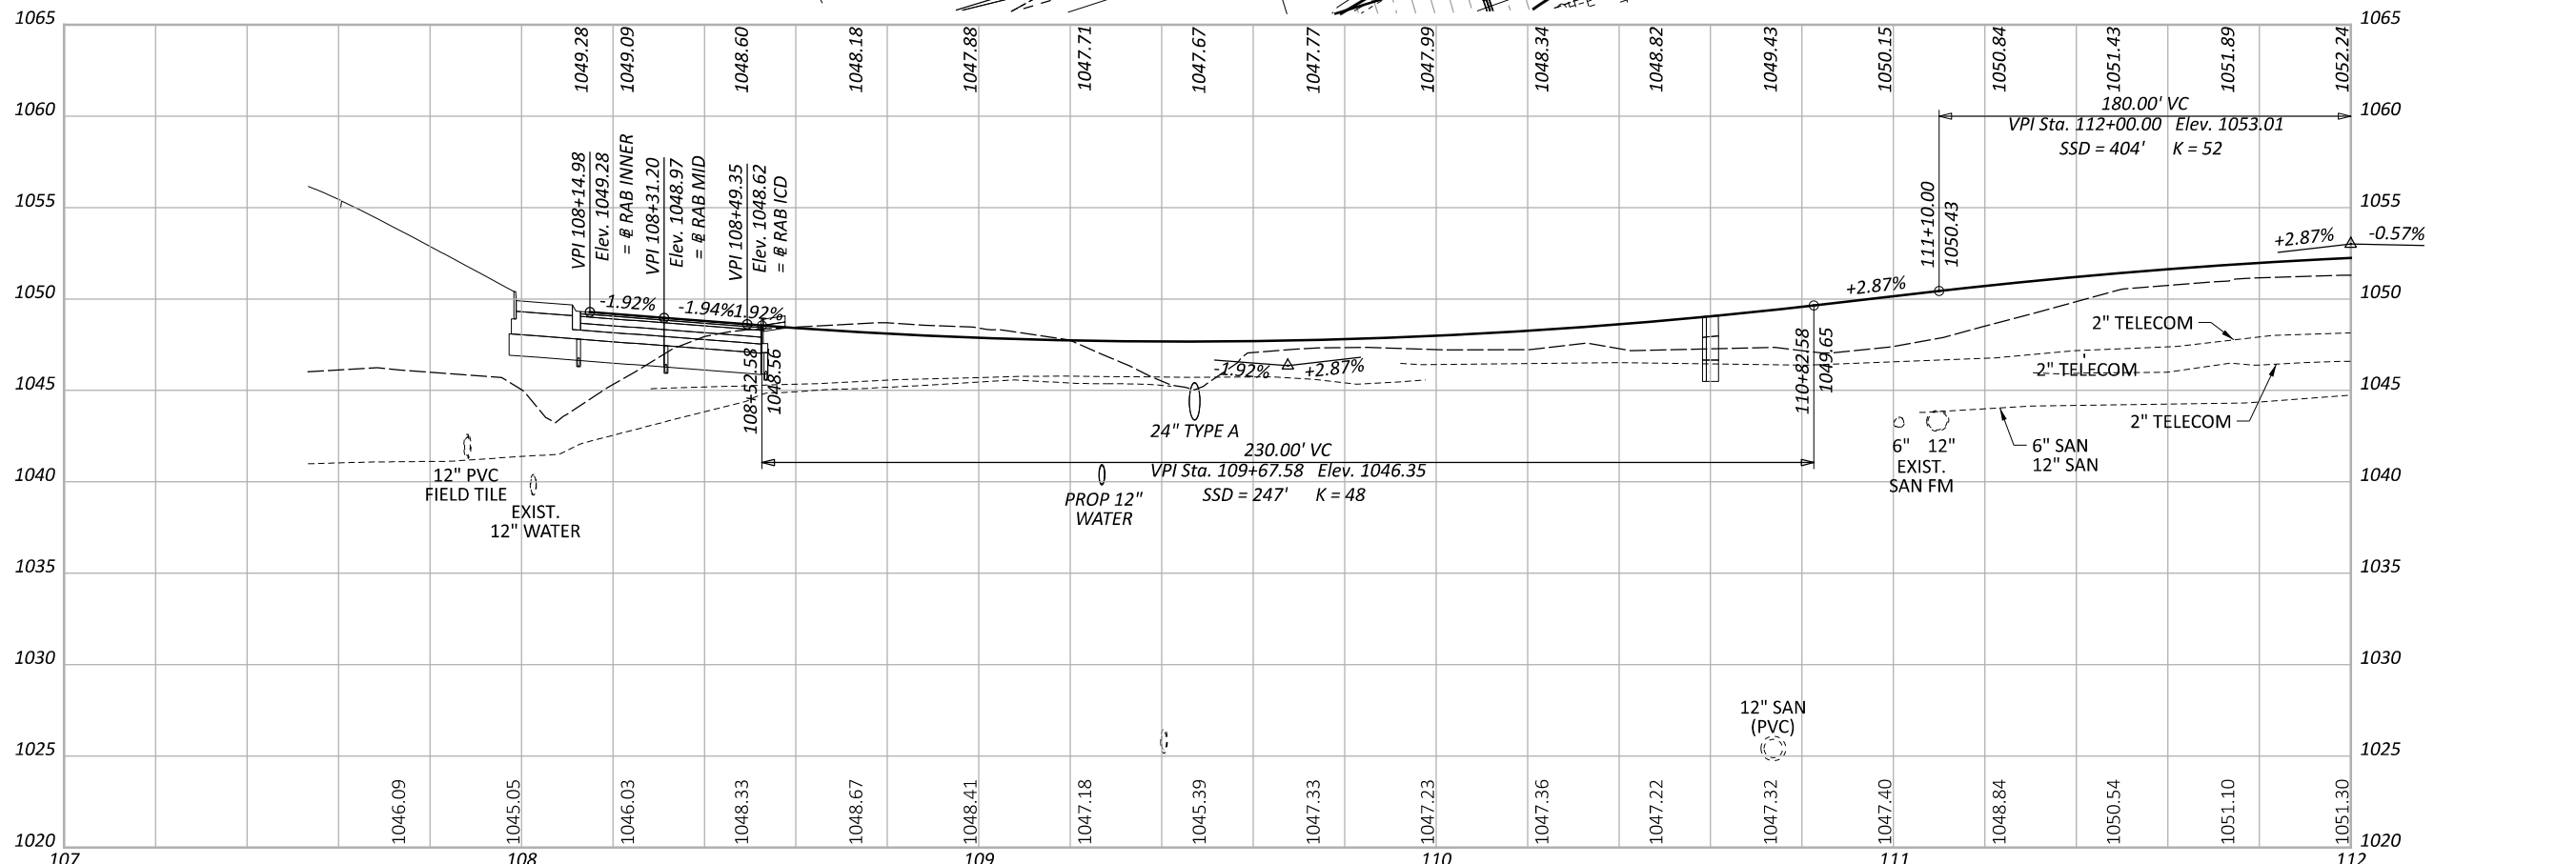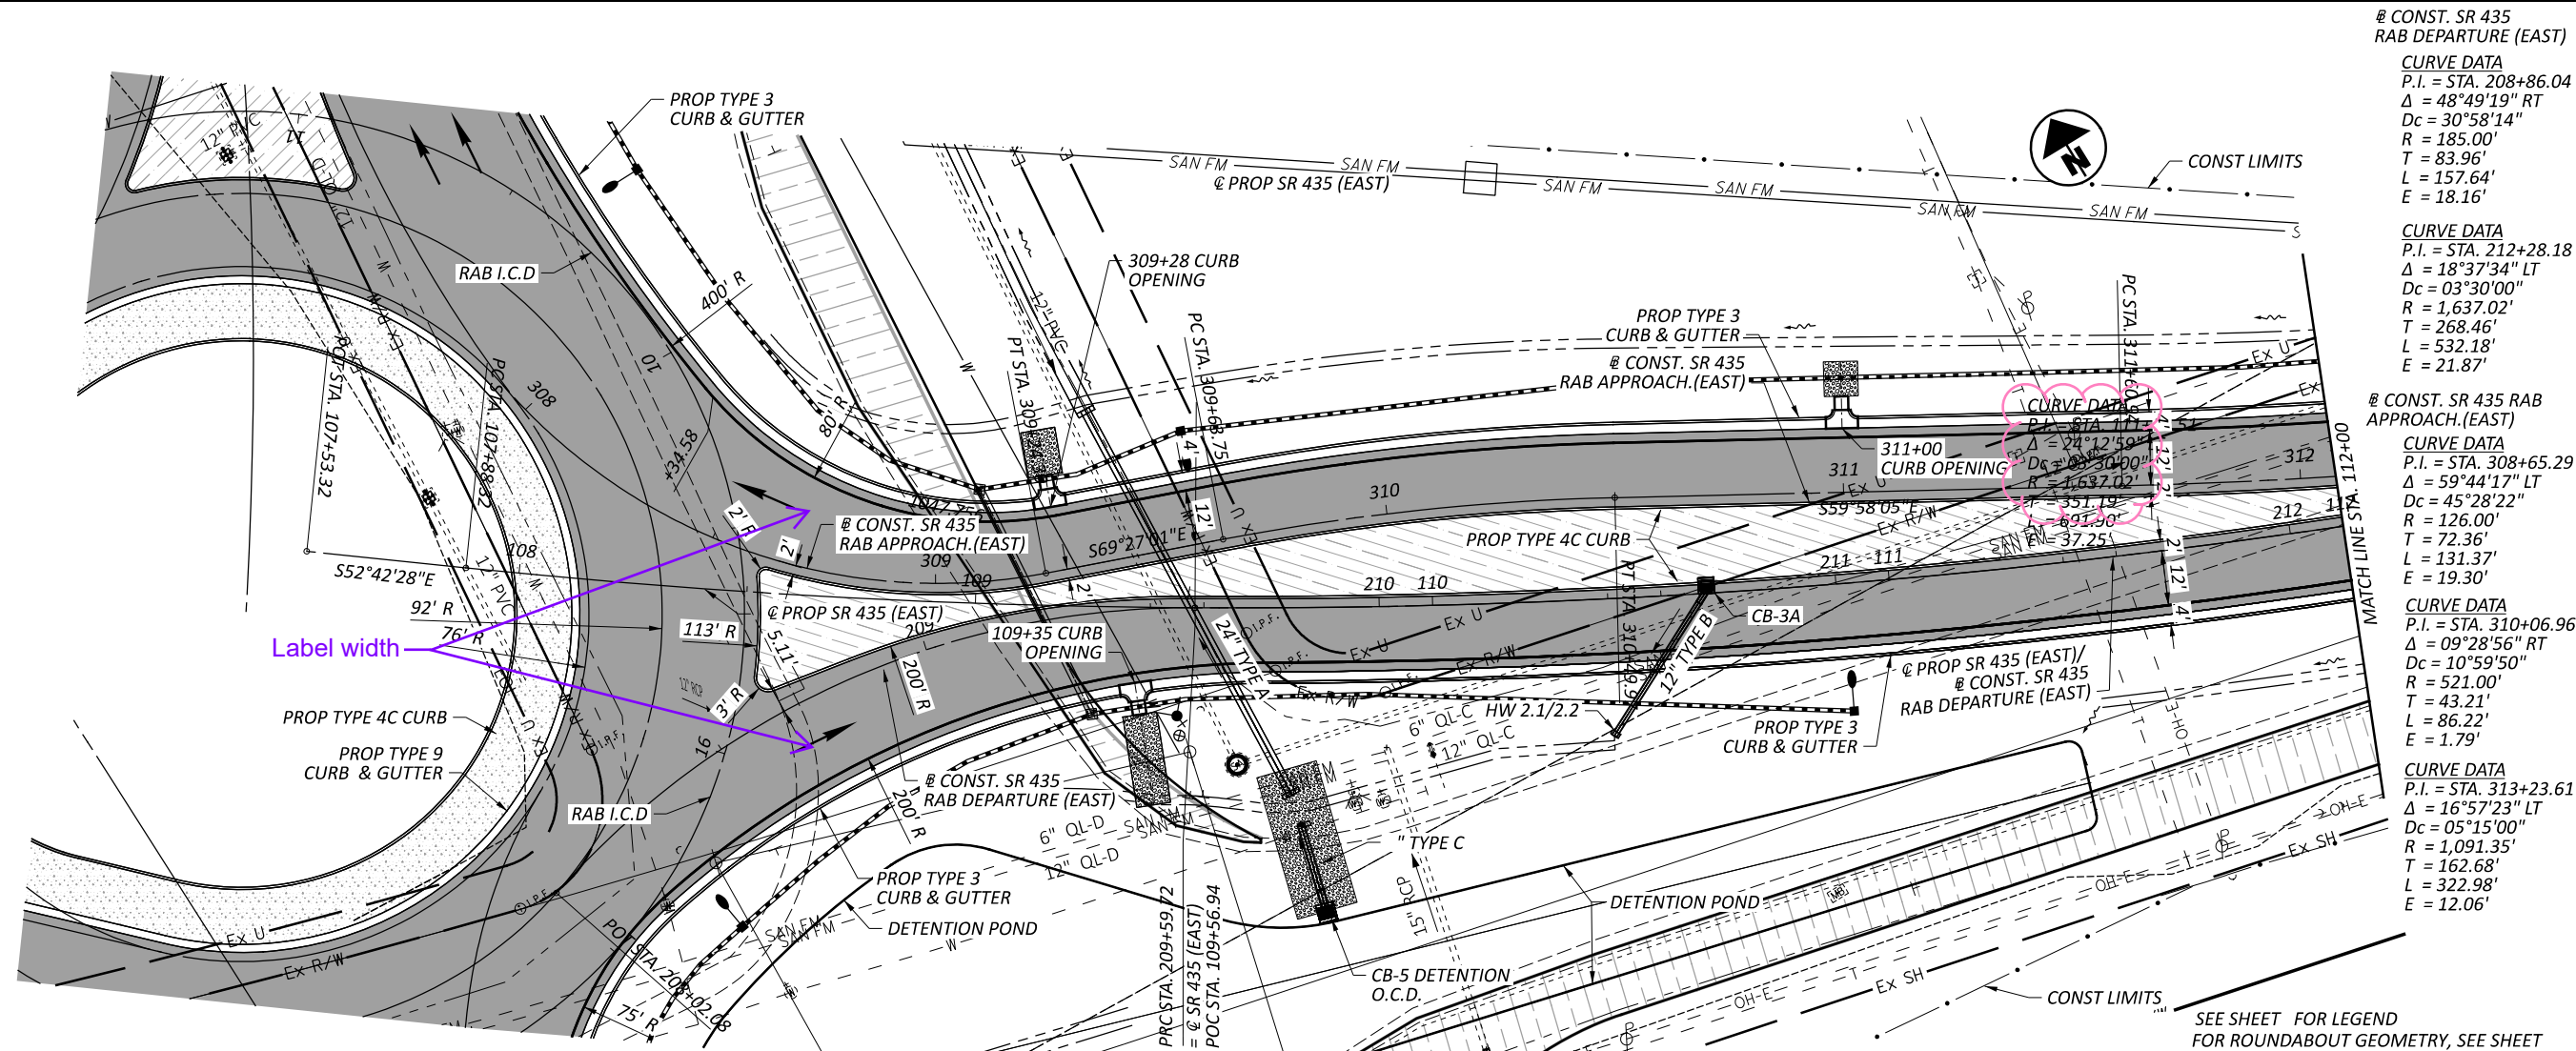


@ CONST. SR 435 RAB DEPARTURE (EAST)
 CURVE DATA
 P.I. = STA. 208+86.04
 $\Delta = 48^\circ 49' 19''$ RT
 $Dc = 30^\circ 58' 14''$
 $R = 185.00'$
 $T = 83.96'$
 $L = 157.64'$
 $E = 18.16'$

@ CONST. SR 435 RAB APPROACH (EAST)
 CURVE DATA
 P.I. = STA. 212+28.18
 $\Delta = 18^\circ 37' 34''$ LT
 $Dc = 03^\circ 30' 00''$
 $R = 1,637.02'$
 $T = 268.46'$
 $L = 532.18'$
 $E = 21.87'$

@ CONST. SR 435 RAB APPROACH (EAST)
 CURVE DATA
 P.I. = STA. 308+65.29
 $\Delta = 59^\circ 44' 17''$ LT
 $Dc = 45^\circ 28' 22''$
 $R = 126.00'$
 $T = 72.36'$
 $L = 131.37'$
 $E = 19.30'$

@ CONST. SR 435 (EAST) RAB DEPARTURE (EAST)
 CURVE DATA
 P.I. = STA. 310+06.96
 $\Delta = 09^\circ 28' 56''$ RT
 $Dc = 10^\circ 59' 50''$
 $R = 521.00'$
 $T = 43.21'$
 $L = 86.22'$
 $E = 1.79'$

@ CONST. SR 435 (EAST) RAB DEPARTURE (EAST)
 CURVE DATA
 P.I. = STA. 313+23.61
 $\Delta = 16^\circ 57' 23''$ LT
 $Dc = 05^\circ 15' 00''$
 $R = 1,091.35'$
 $T = 162.68'$
 $L = 322.98'$
 $E = 12.06'$

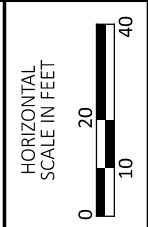

PLAN AND PROFILE
S.R. 435 (RAB EAST) STA 107+53.32 TO STA 112+00

DESIGN AGENCY
Palmer ENGINEERING
 8350 E. KEMPER RD.
 SUITE B
 CINCINNATI, OH 45249
 513-469-1600


DESIGNER
 DPF

REVIEWER
 DCJ MM-DD-YY


PROJECT ID
 117955

SHEET TOTAL
 P. 108 | 228

@ CONST. SR 435
 RAB APPROACH.(EAST)
 CURVE DATA
 P.I. = STA. 313+23.61
 $\Delta = 16^{\circ}57'23''$ LT
 $D_c = 05^{\circ}15'00''$
 $R = 1,091.35'$
 $T = 162.68'$
 $L = 322.98'$
 $E = 12.06'$

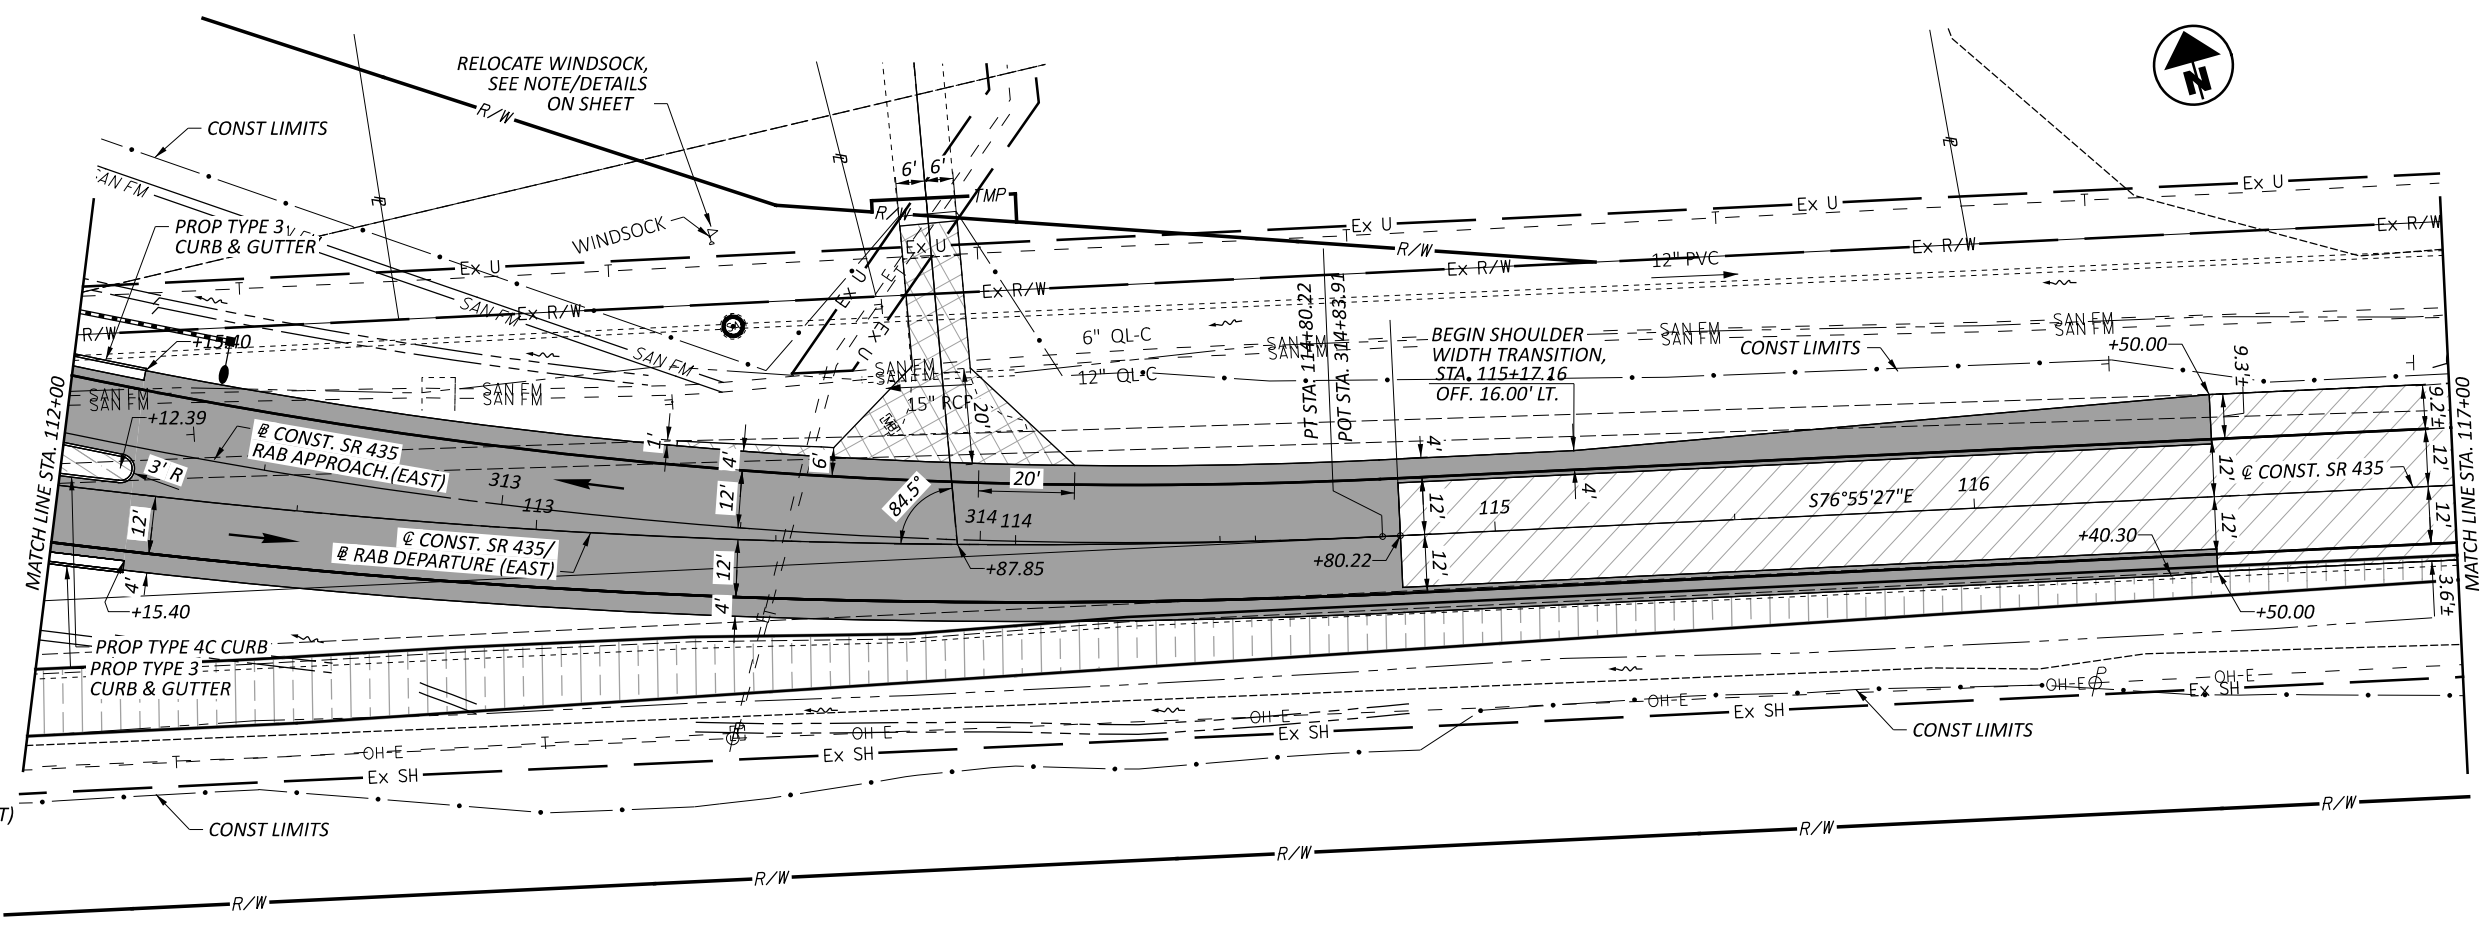


@ CONST. SR 435/
 RAB DEPARTURE (EAST)
 CURVE DATA
 P.I. = STA. 111+39.51
 $\Delta = 24^{\circ}12'59''$ LT
 $D_c = 03^{\circ}30'00''$
 $R = 1,637.02'$
 $T = 351.19'$
 $L = 691.90'$
 $E = 37.25'$

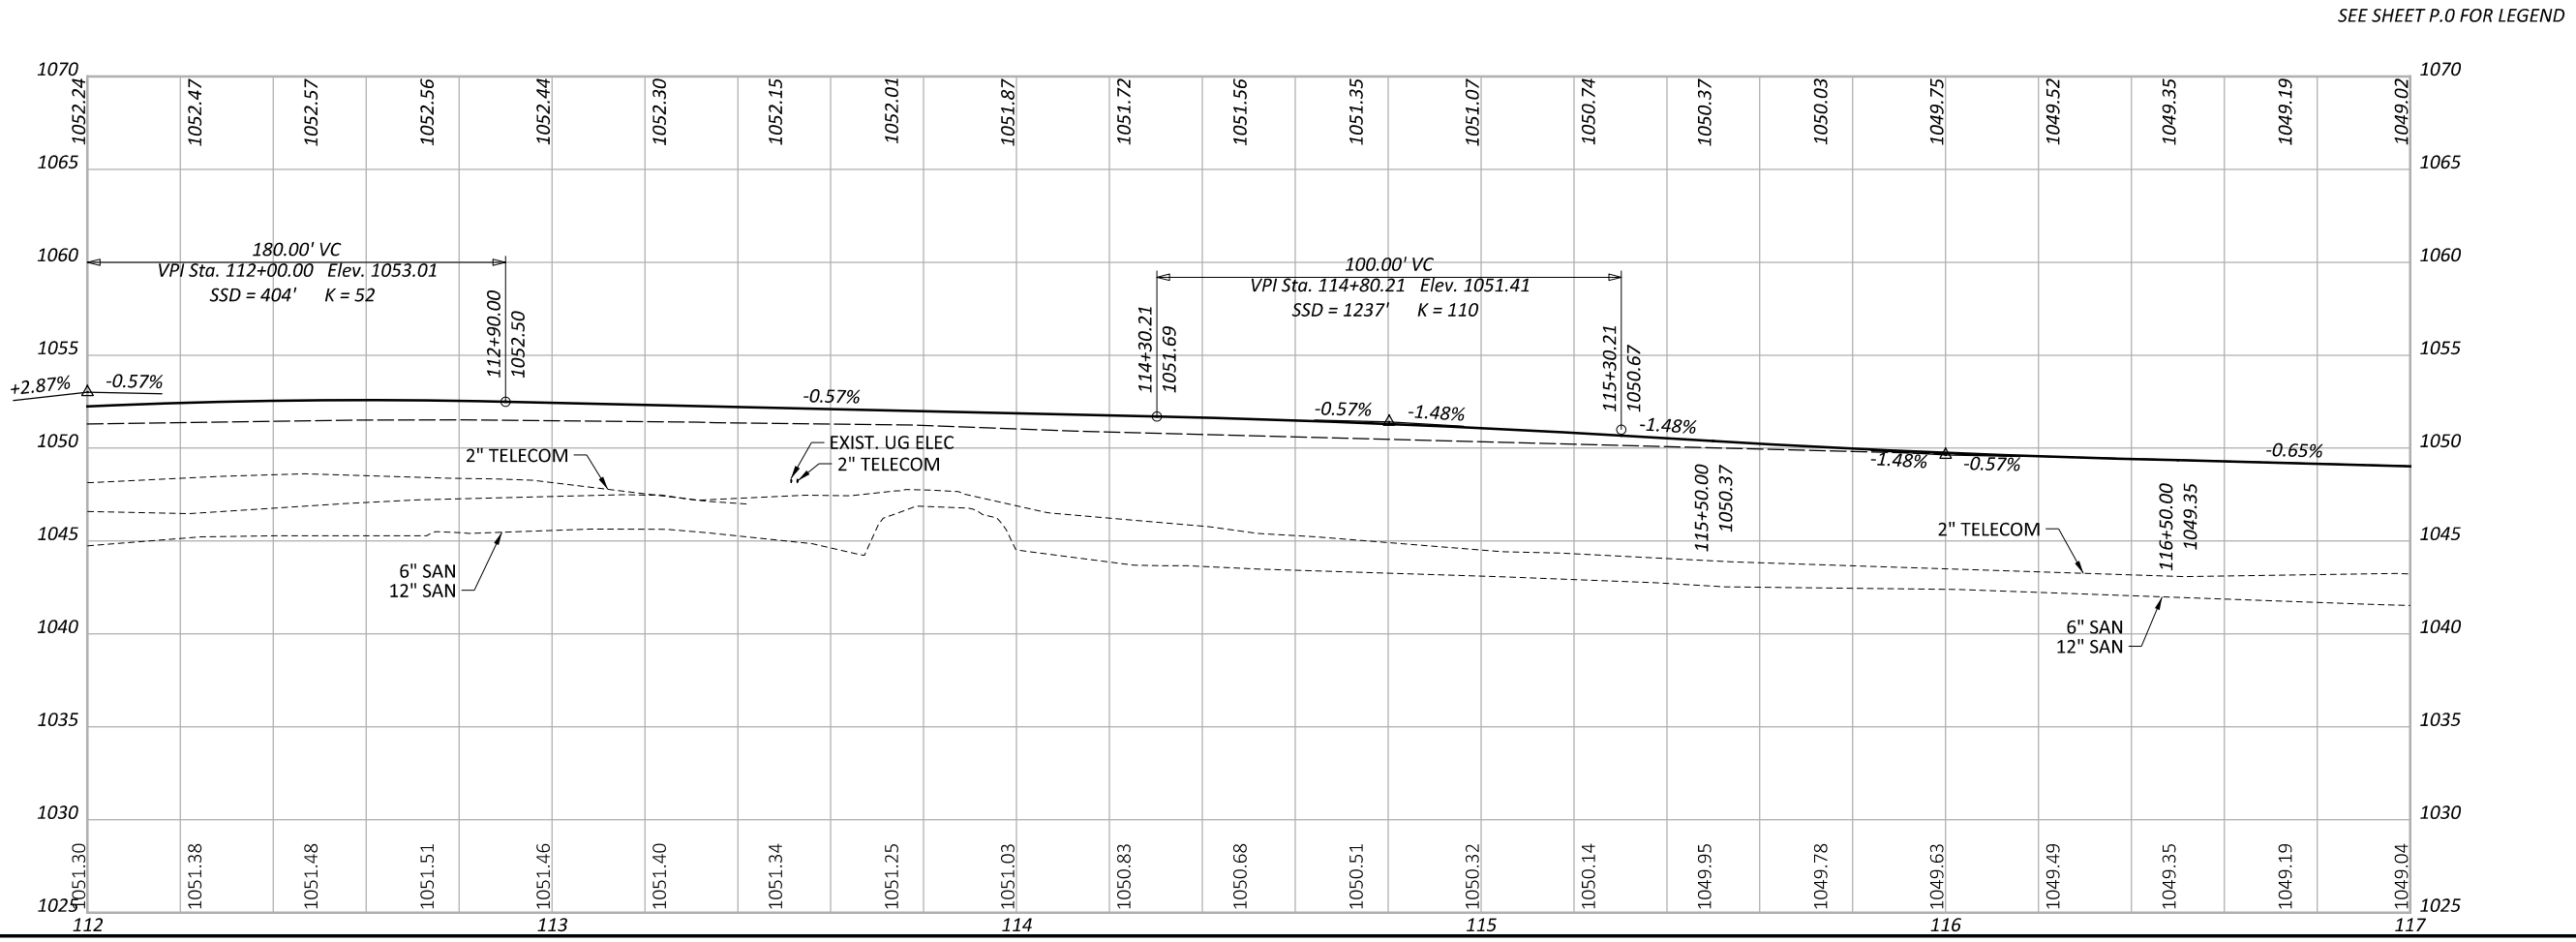

SEE SHEET P.0 FOR LEGEND




FAY-435-1.52

MODEL: CLIP_SR435_RAB_APPR_EAST - Plan 4 (Sheet) PAPER SIZE: 17x11 (in.) DATE: 3/25/2024 TIME: 3:39:03 PM USER: dan-f
 pw:\pewinp\04.pewin\private\palmernet.com\Palmer_Engineering\Documents\Ohio\000TV06\FAY\17955\000-Engineering\Roadway\Sheets\BU-5\17955_GP003.dgn

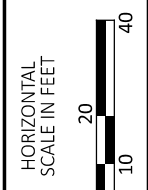

PLAN AND PROFILE
 S.R. 435 (RAB EAST) STA 112+00 TO STA 117+00



DESIGN AGENCY	
Palmer ENGINEERING	
8350 E. KEMPER RD. SUITE B CINCINNATI, OH 45249 513-469-1600	
DESIGNER	
DPF	
REVIEWER	
DCJ MM-DD-YY	
PROJECT ID	
117955	
SHEET	TOTAL
P. 109	228

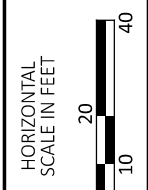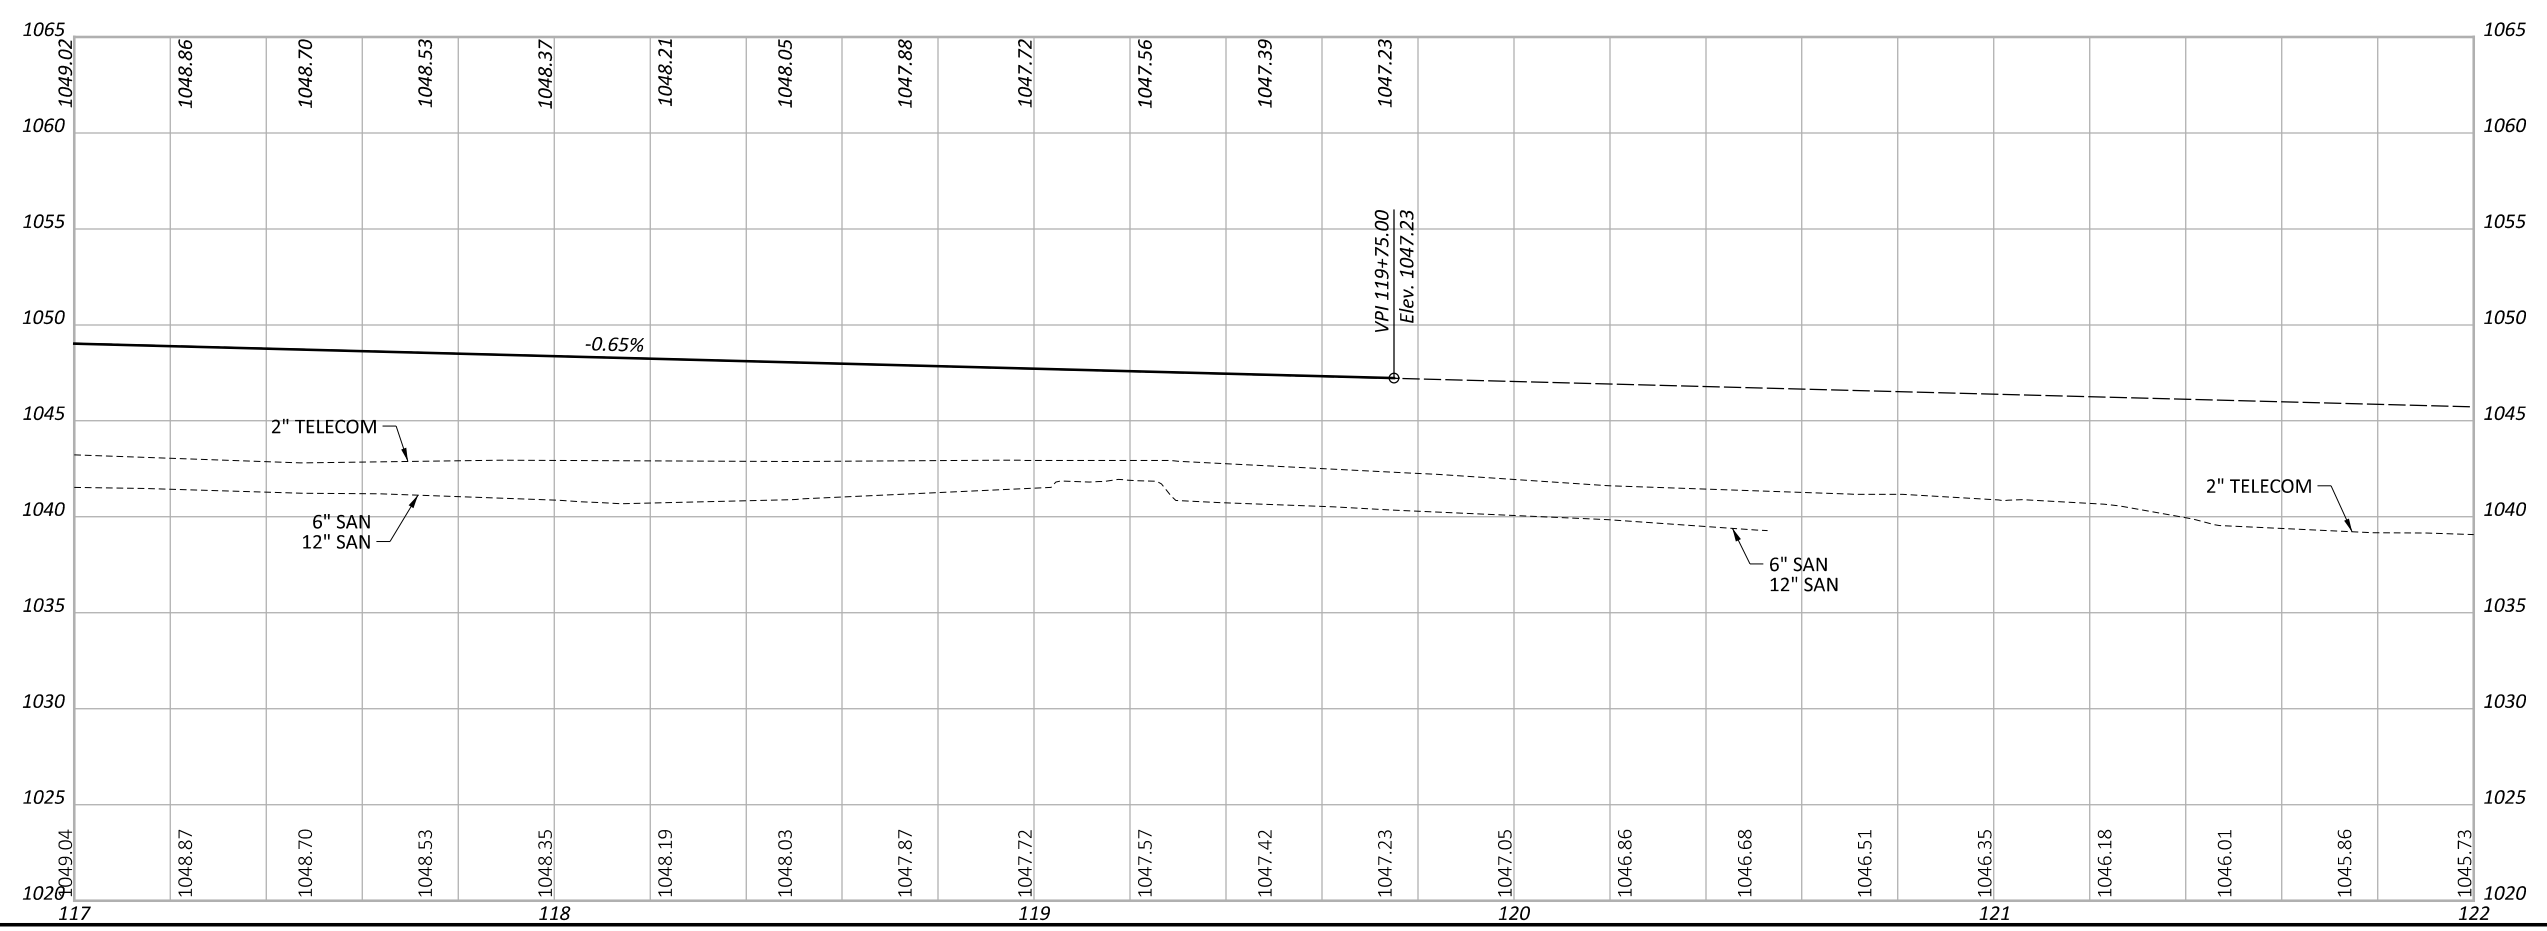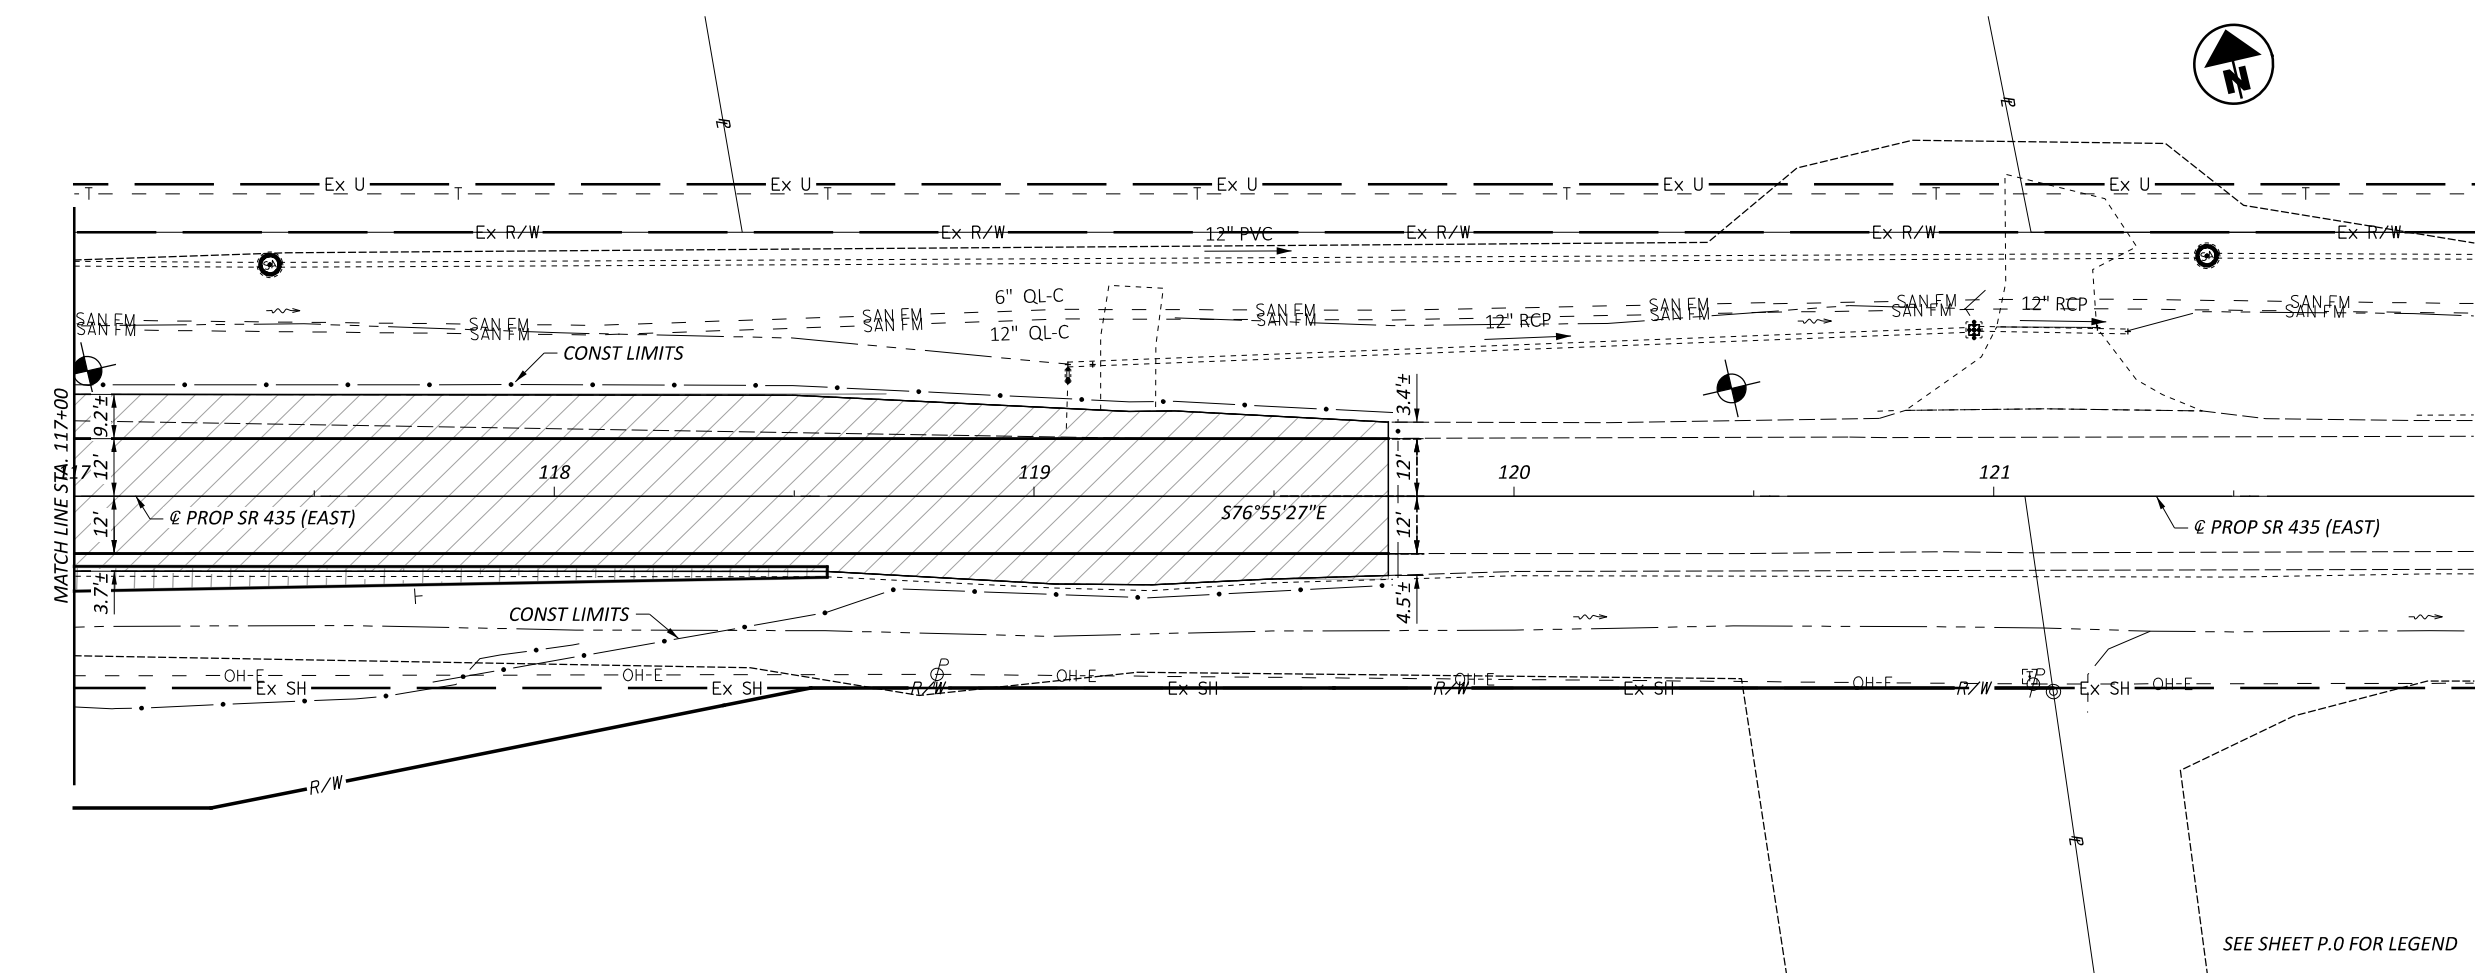

PLAN AND PROFILE
 S.R. 435 (RAB EAST) STA 117+00 TO STA 122+00

DESIGN AGENCY
Palmer
 ENGINEERING
 8350 E. KEMPER RD.
 SUITE B
 CINCINNATI, OH 45249
 513-469-1600

DESIGNER	DPF
REVIEWER	DCJ MM-DD-YY
PROJECT ID	117955
SHEET	TOTAL
P. 110	228

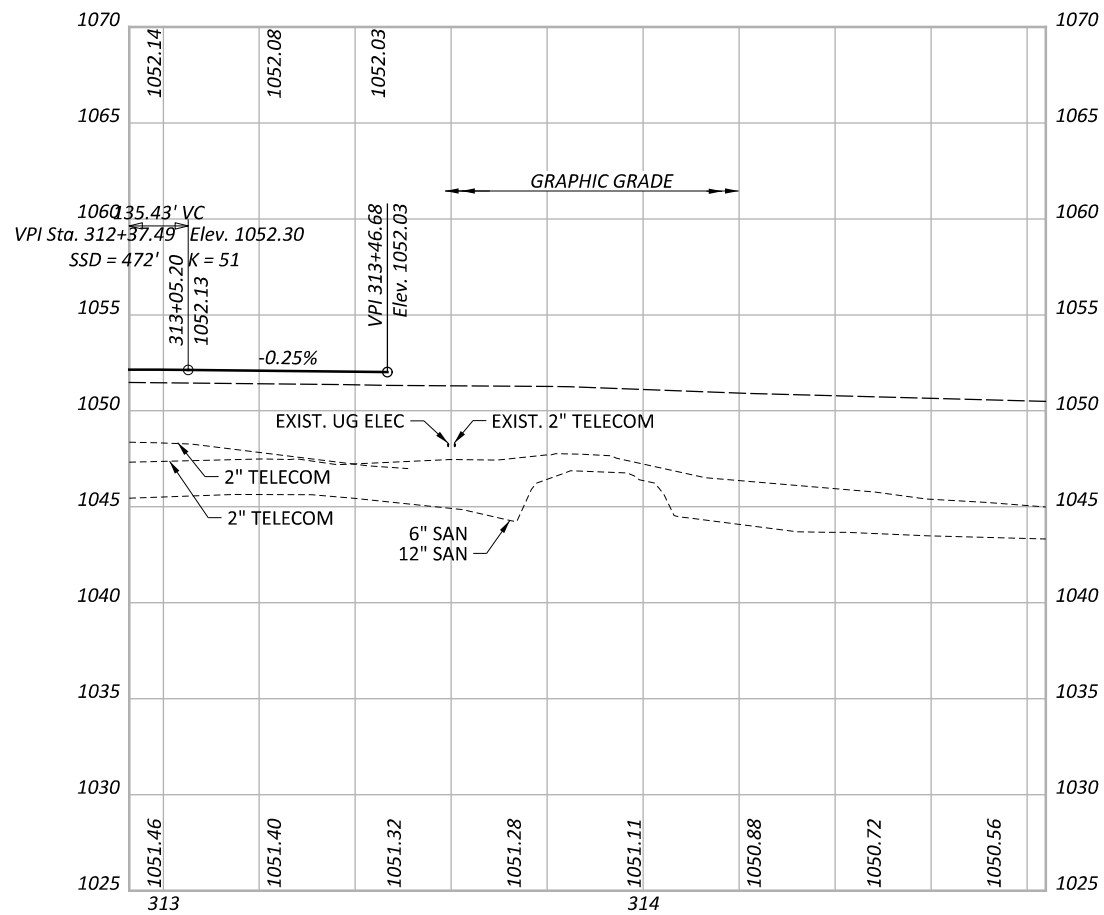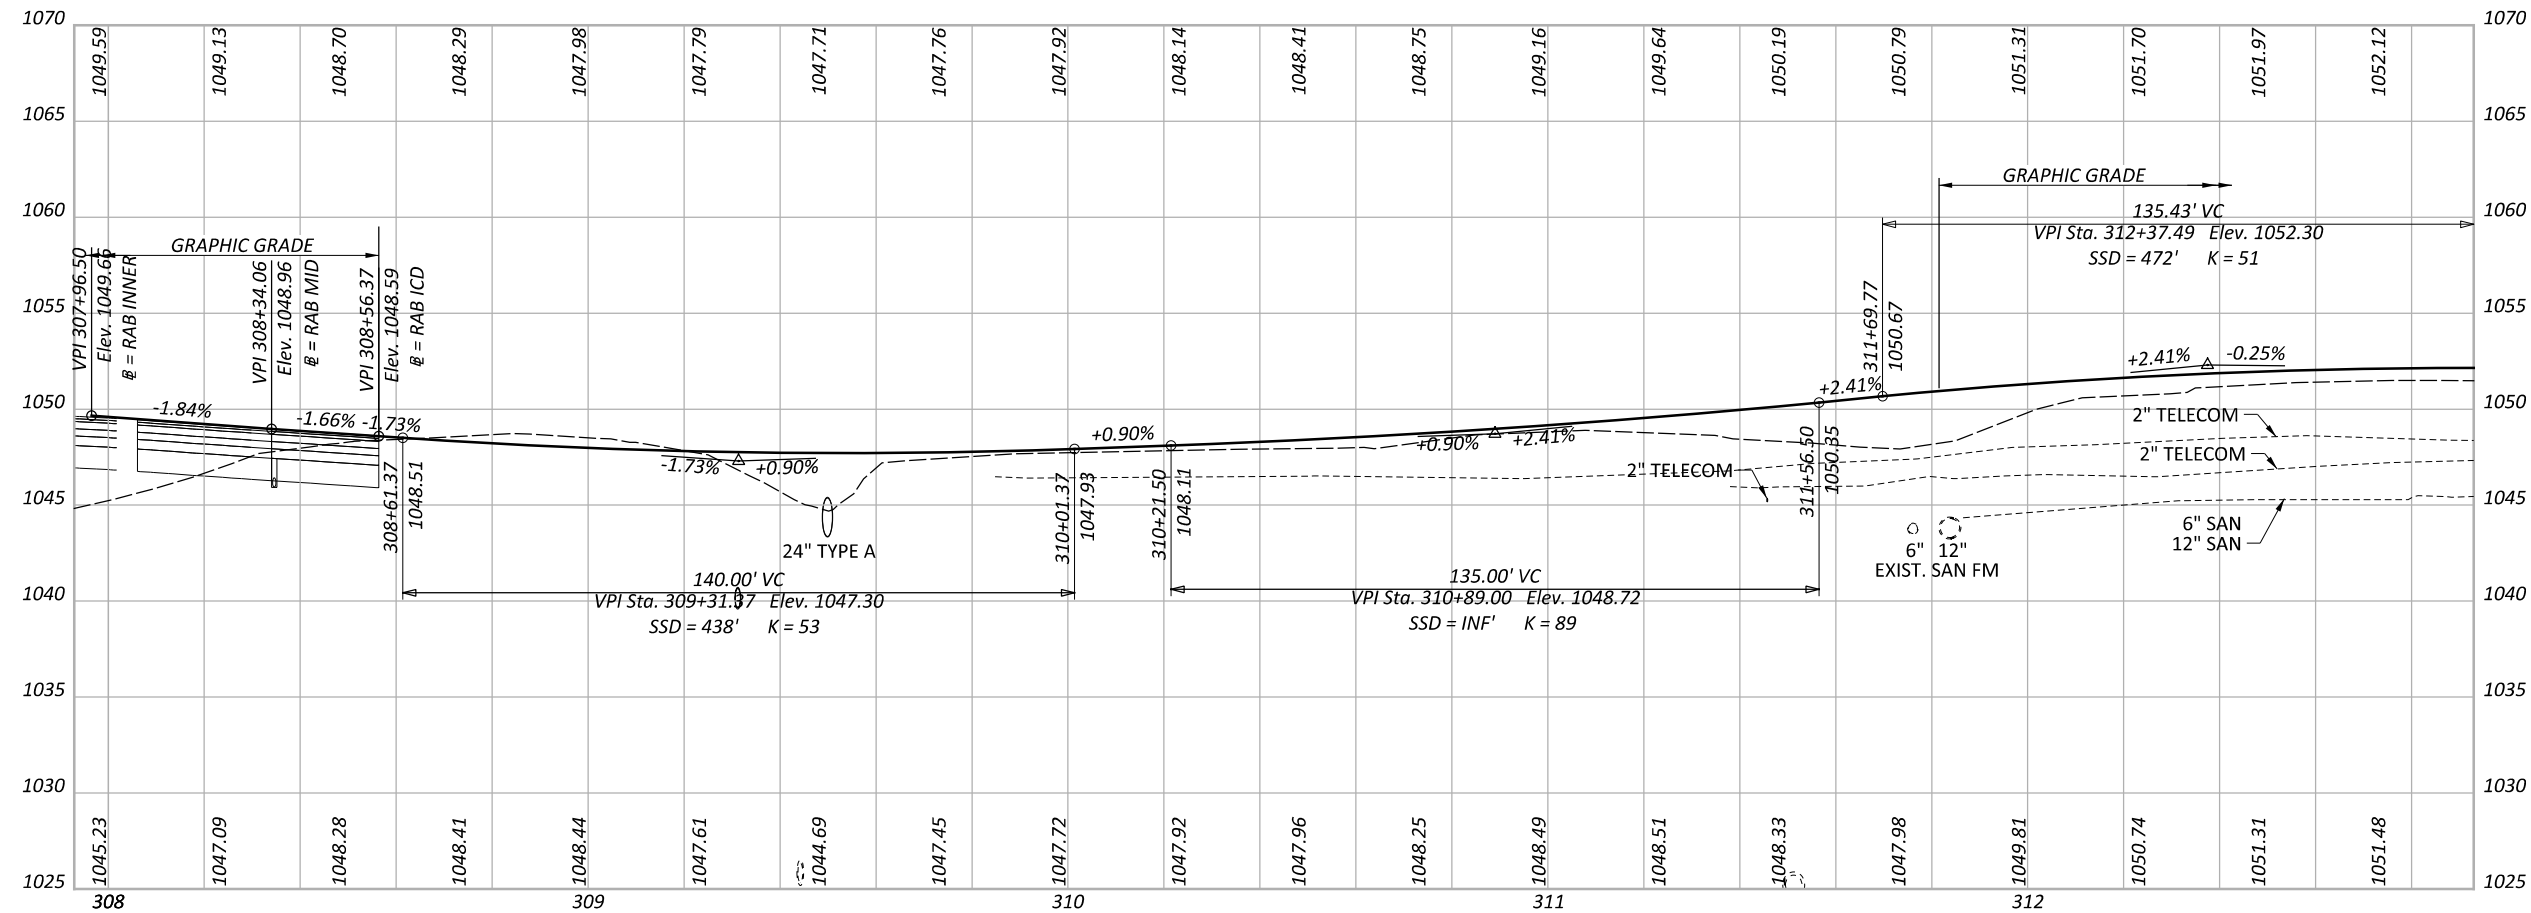

PROFILES
 SR 435 - ROUNDABOUT APPROACH (EAST)

DESIGN AGENCY




DESIGNER
 DPF

REVIEWER
 DCJ MM-DD-YY

PROJECT ID
 117955

SHEET TOTAL
 P. 112 228

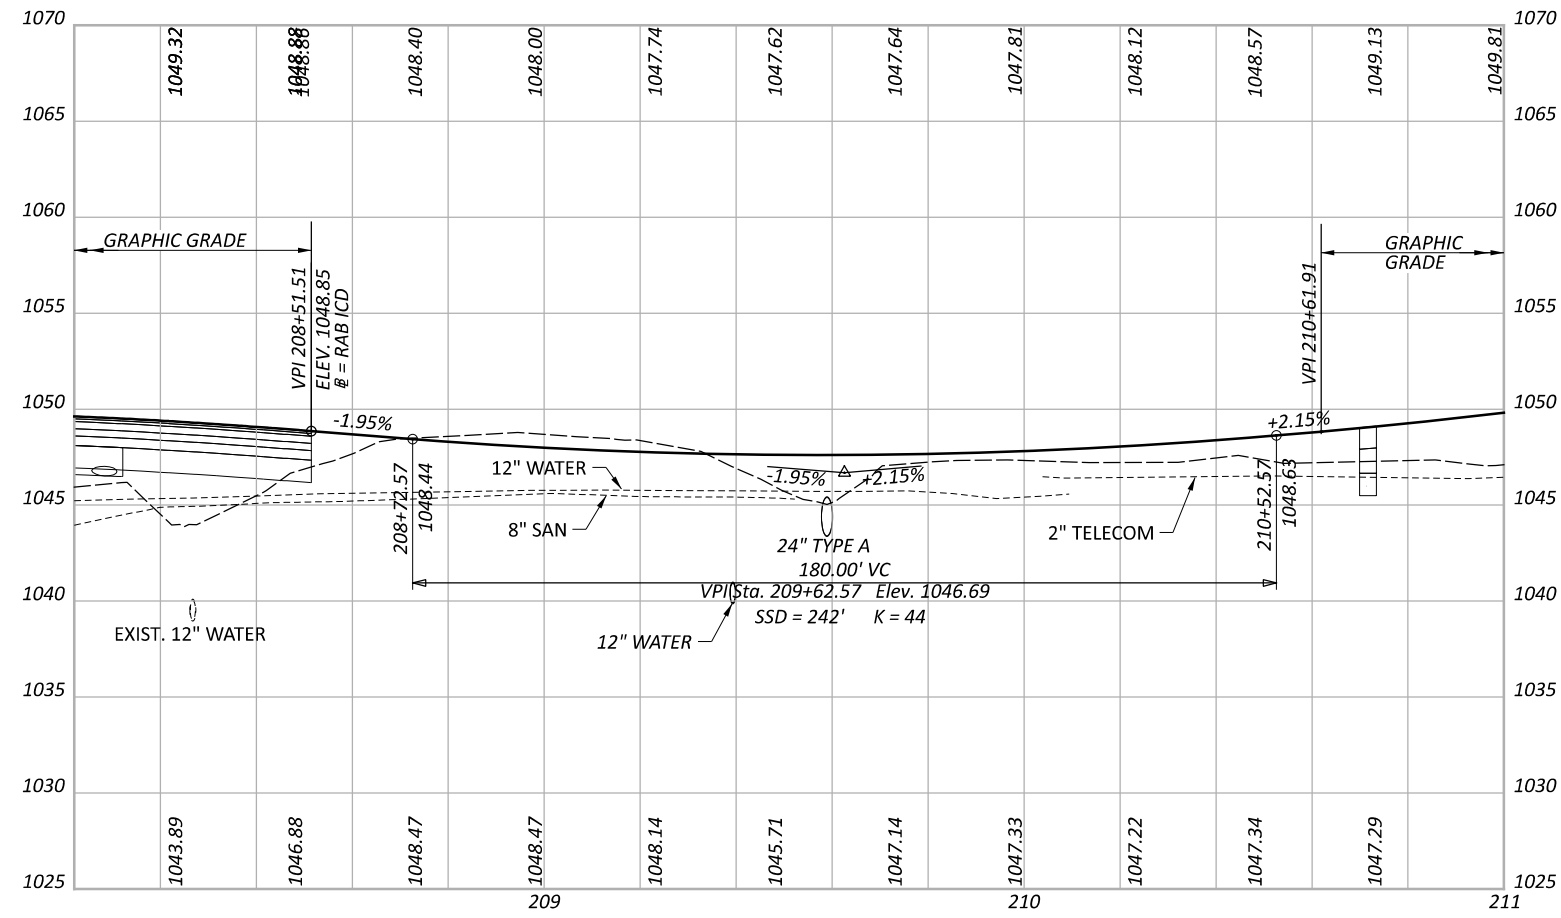

PROFILES
 SR 435 - ROUNDABOUT DEPARTURE (EAST)

DESIGN AGENCY





DESIGNER
 DPF

REVIEWER
 DCJ MM-DD-YY

PROJECT ID
 117955

SHEET TOTAL
 P. 111 228

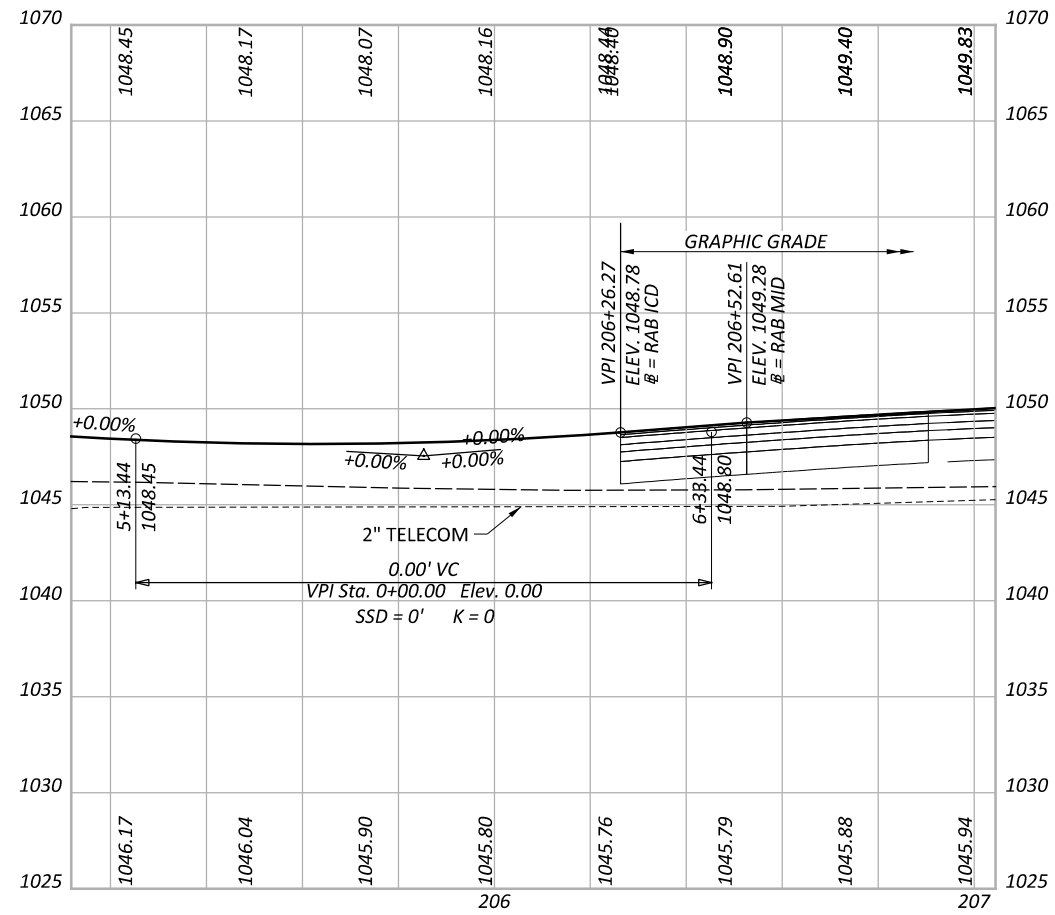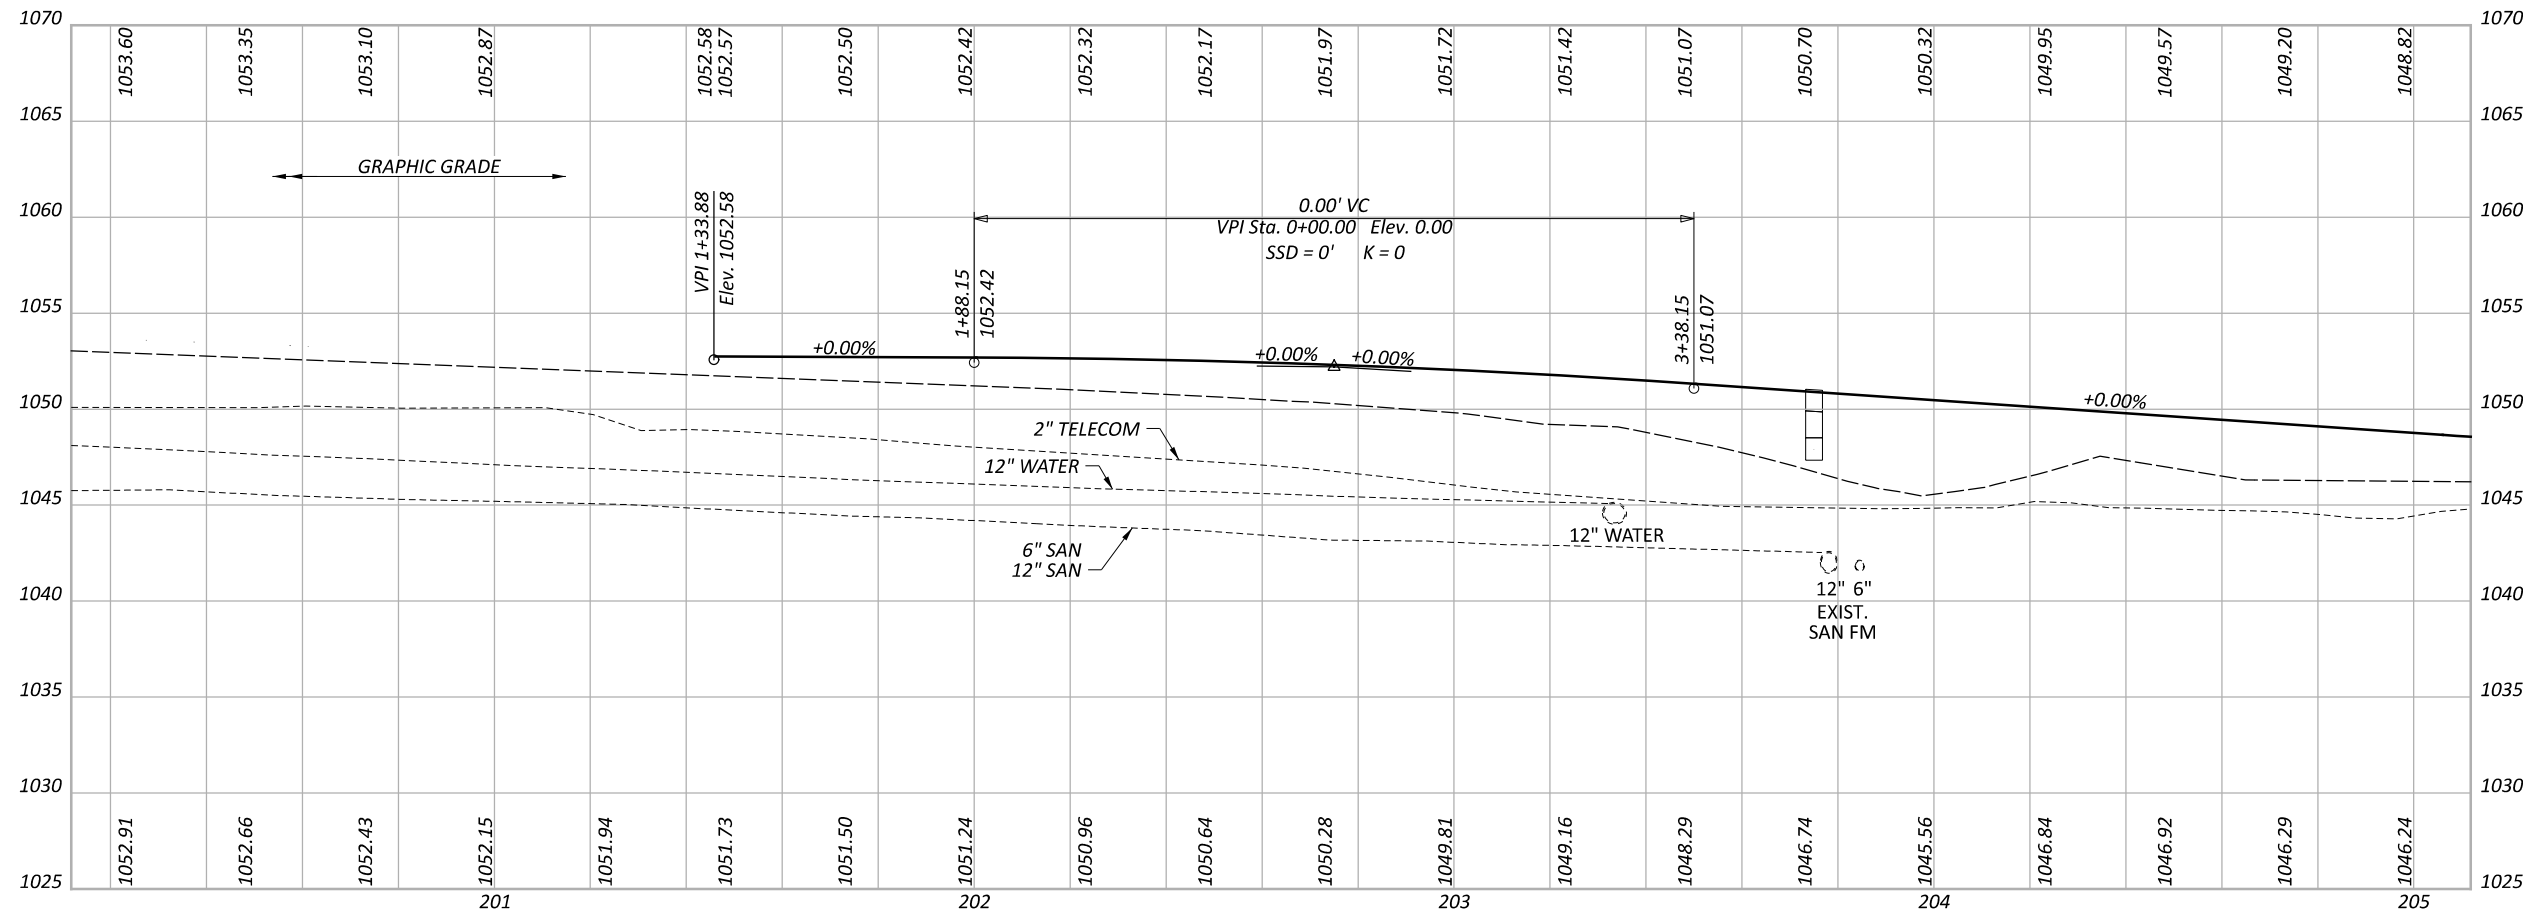

Grades and curve data showing as zeros on this sheet.

PROFILES
 SR 435 - ROUNDABOUT APPROACH (WEST)

DESIGN AGENCY

Palmer
 ENGINEERING
 8350 E. KEMPER RD.
 SUITE B
 CINCINNATI, OH 45249
 513-469-1600

DESIGNER

DPF

REVIEWER



DCJ MM-DD-YY

PROJECT ID

117955


SHEET TOTAL



P. 113 228

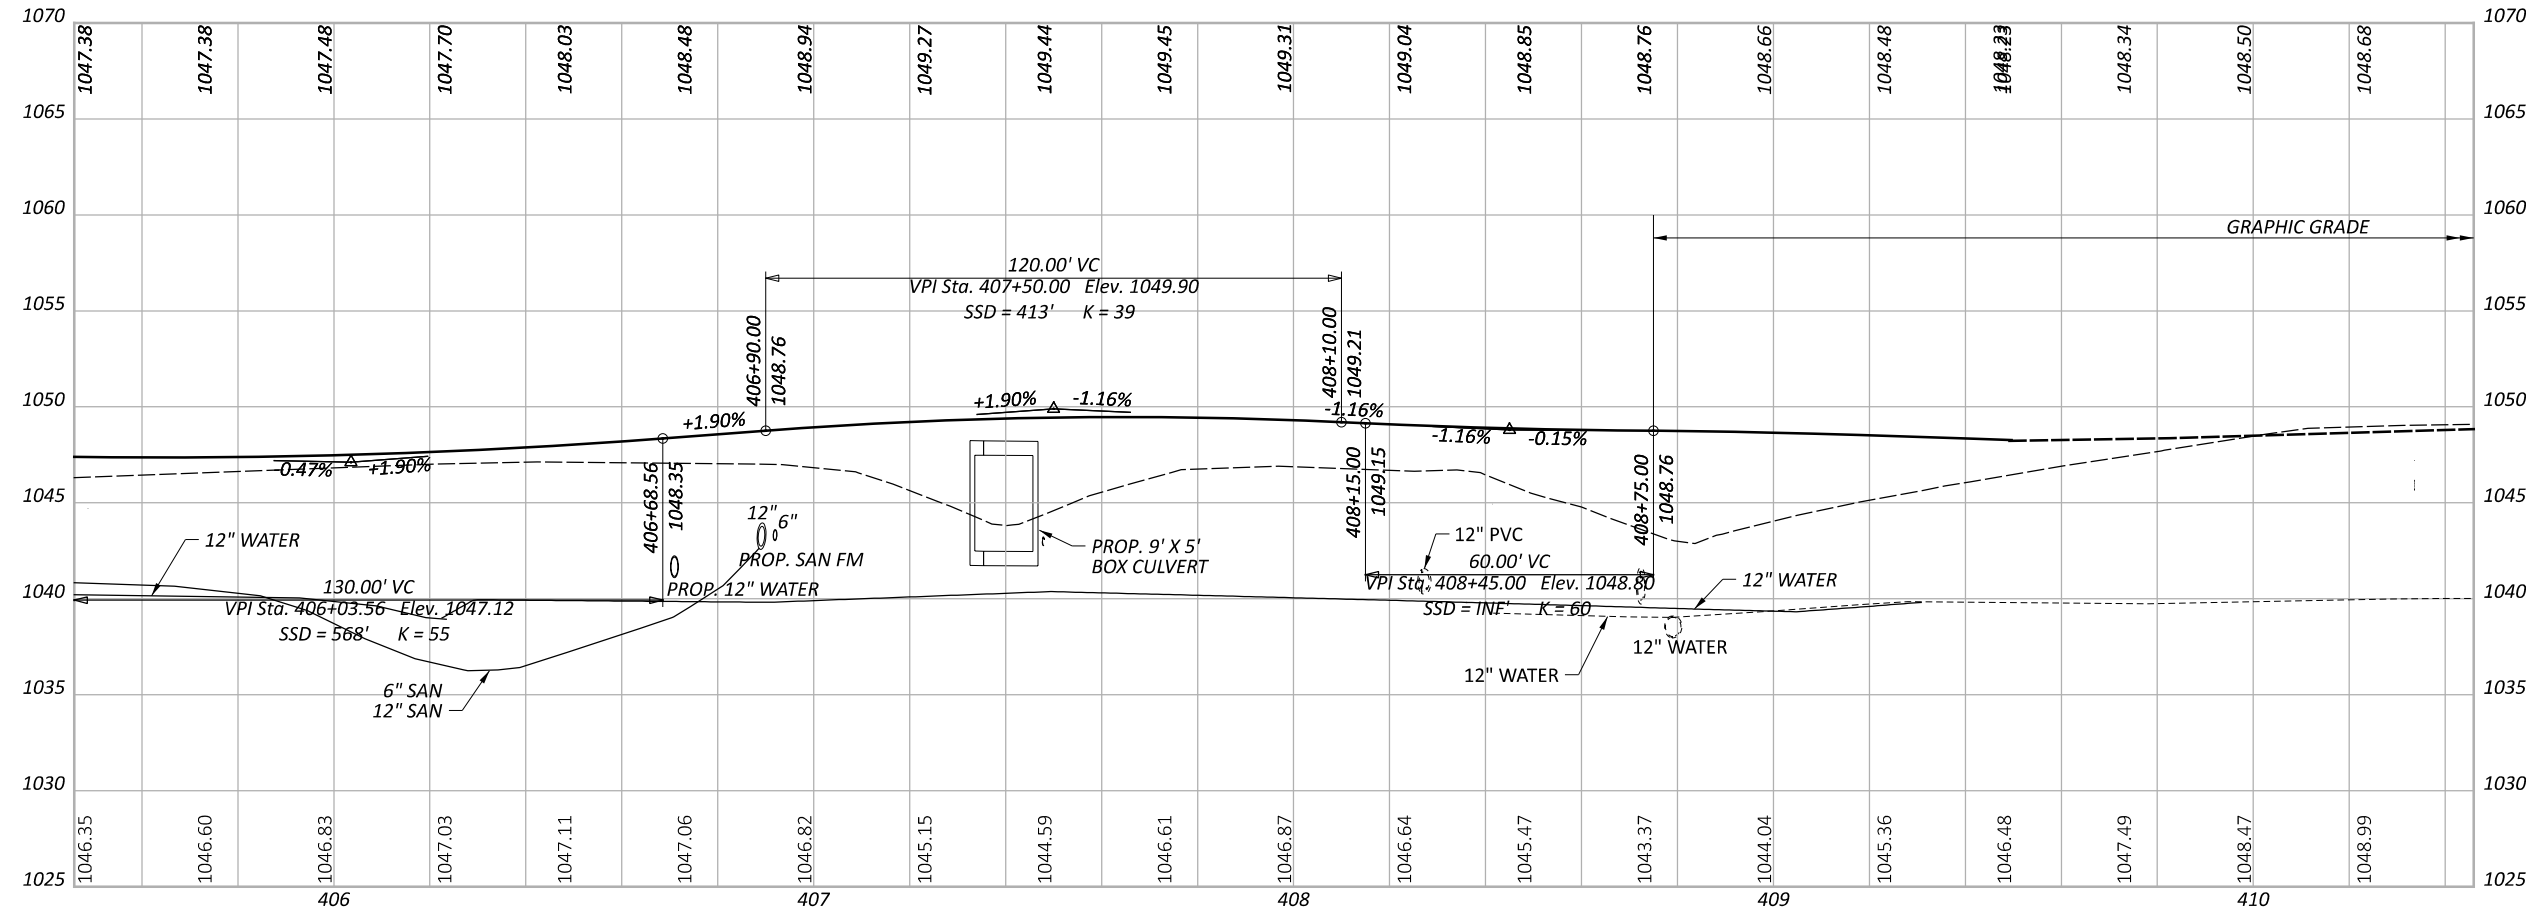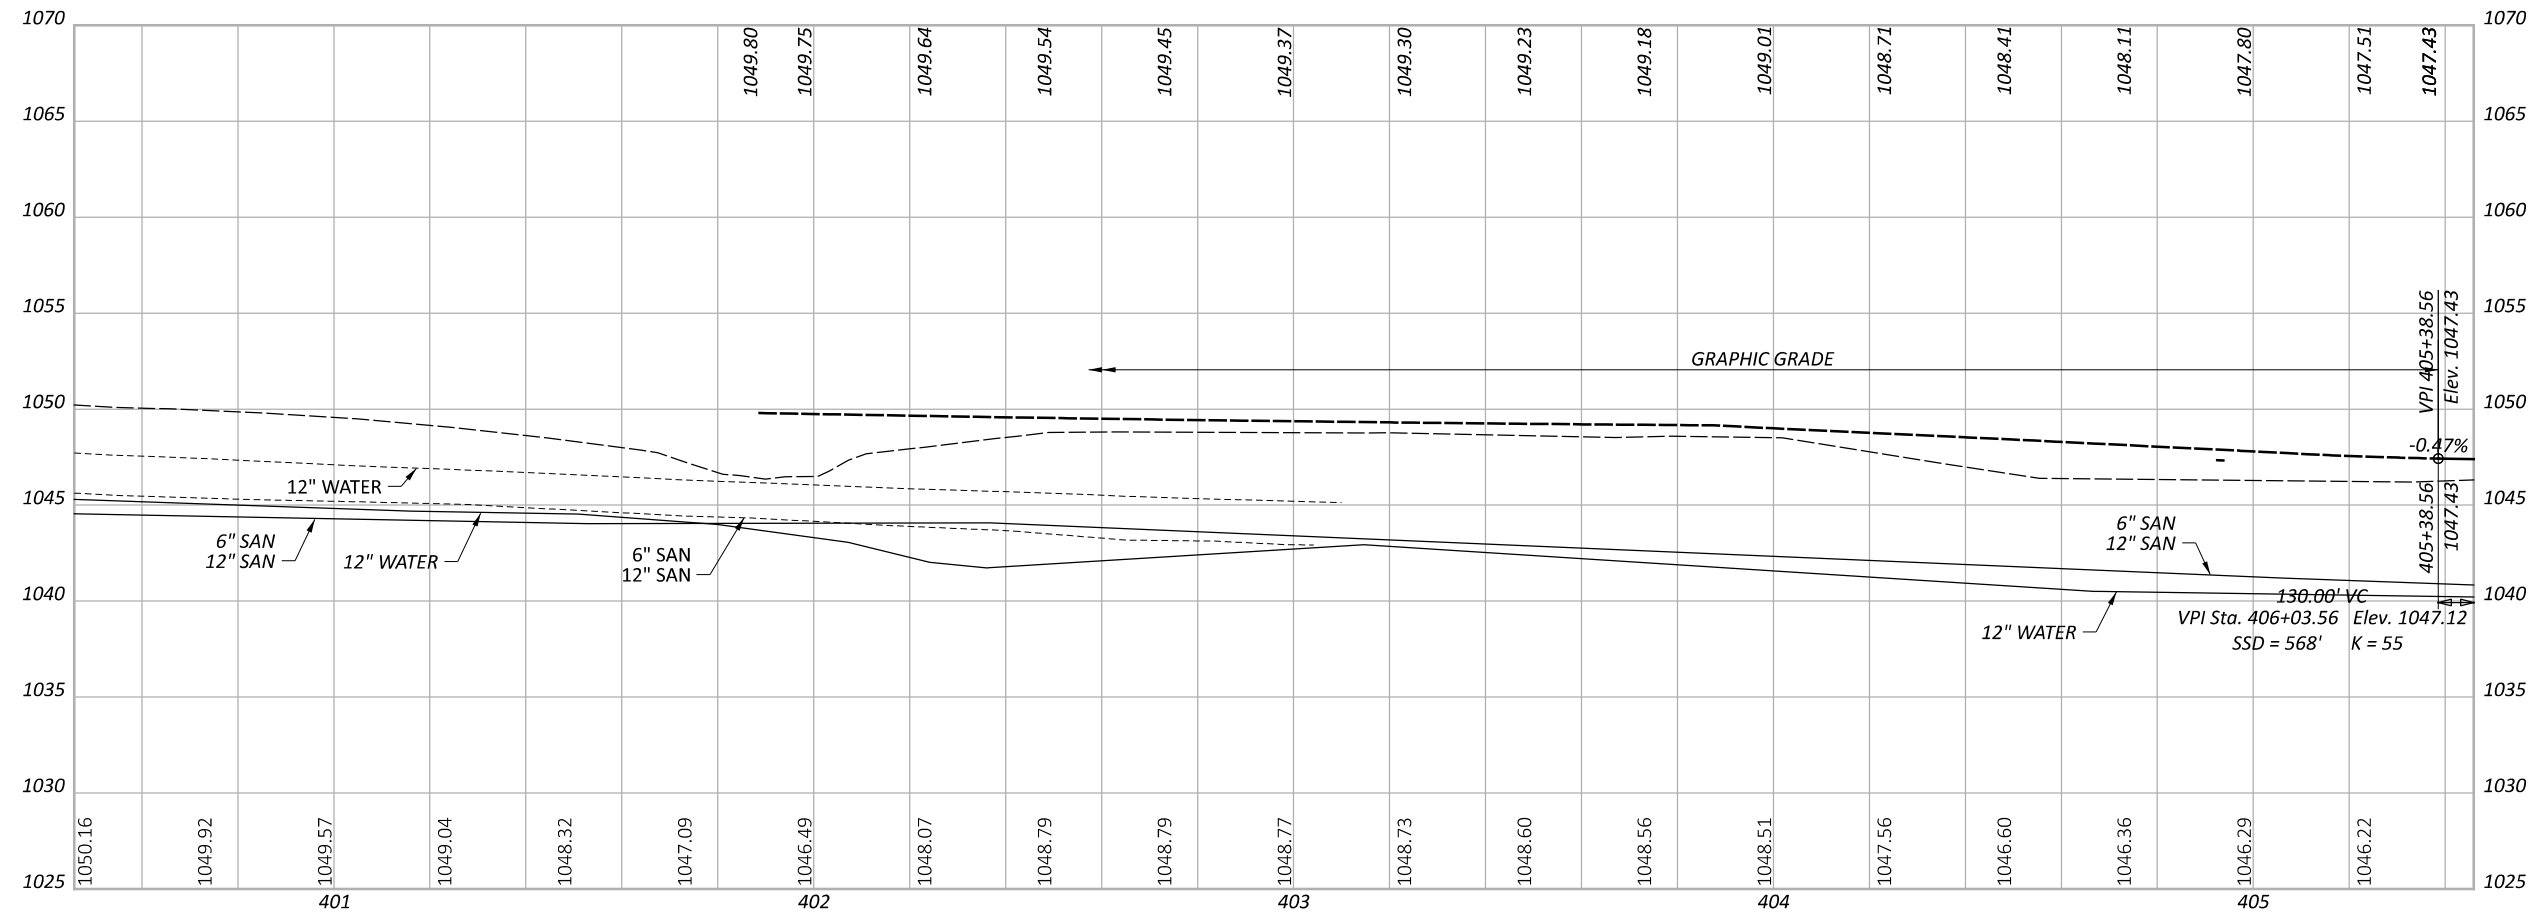



PROFILES
 SR 435 - ROUNDABOUT BYPASS LANE (WEST)

DESIGN AGENCY	
8350 E. KEMPER RD. SUITE B CINCINNATI, OH 45249 513-469-1600	
DESIGNER	
DPF	
REVIEWER	
DCJ MM-DD-YY	
PROJECT ID	
117955	
SHEET	TOTAL
P. 114	228

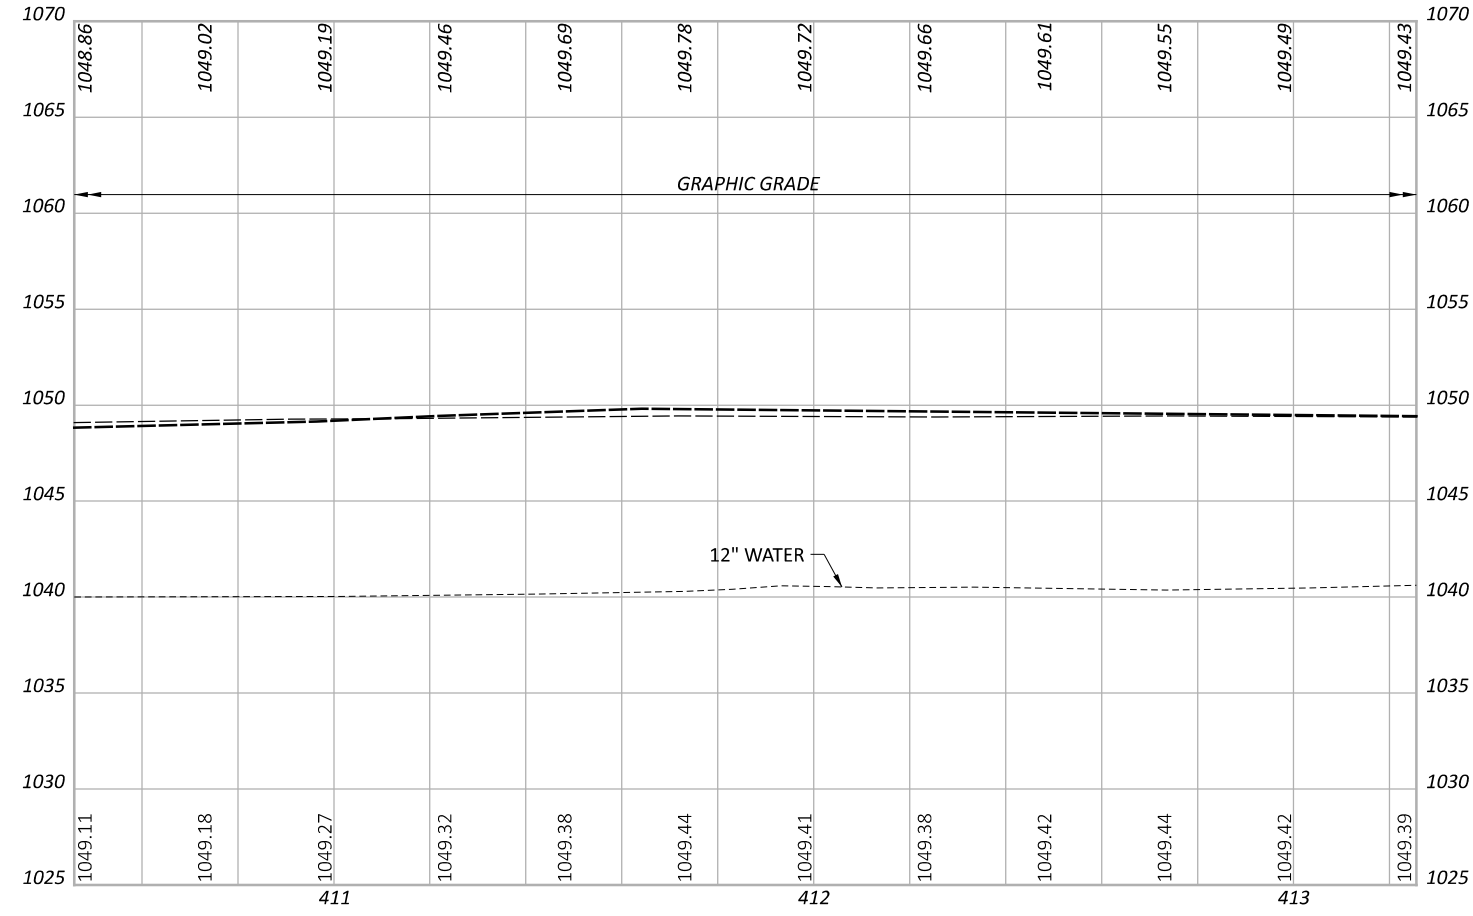

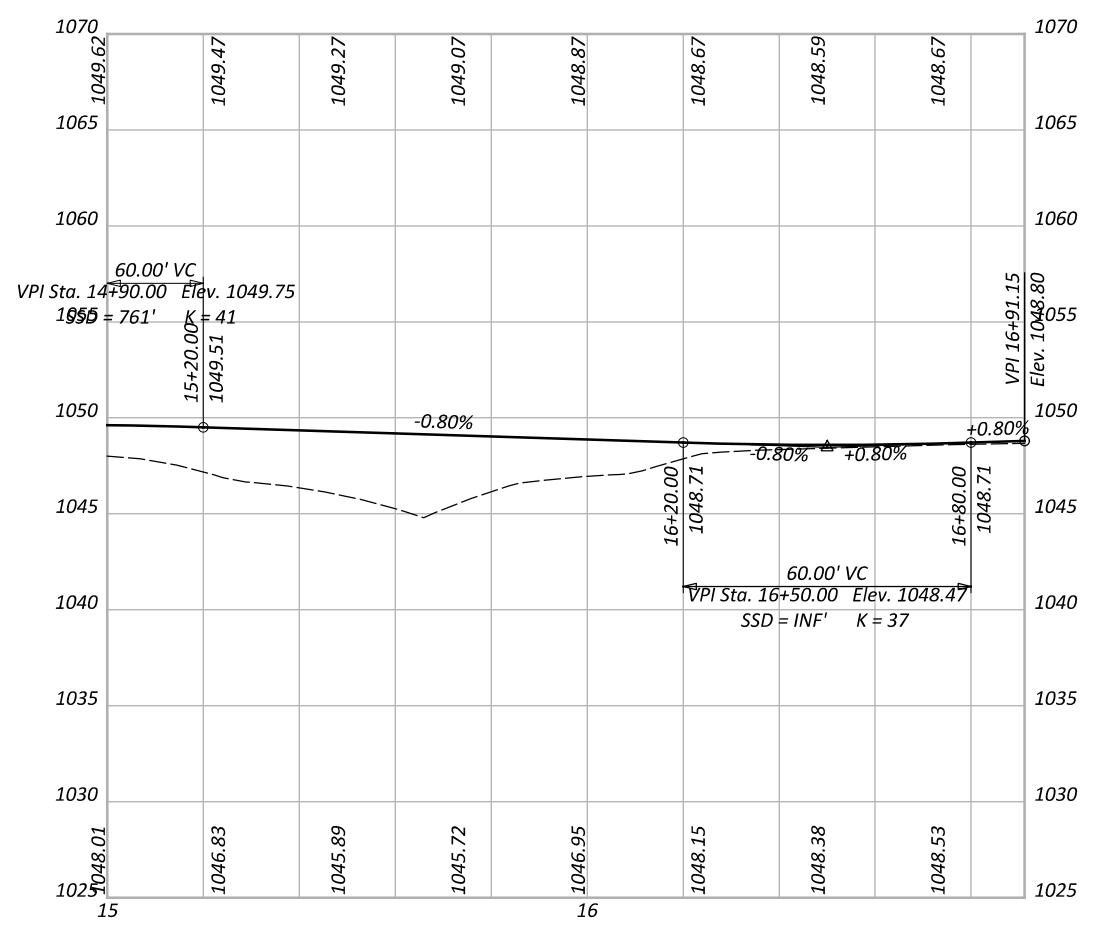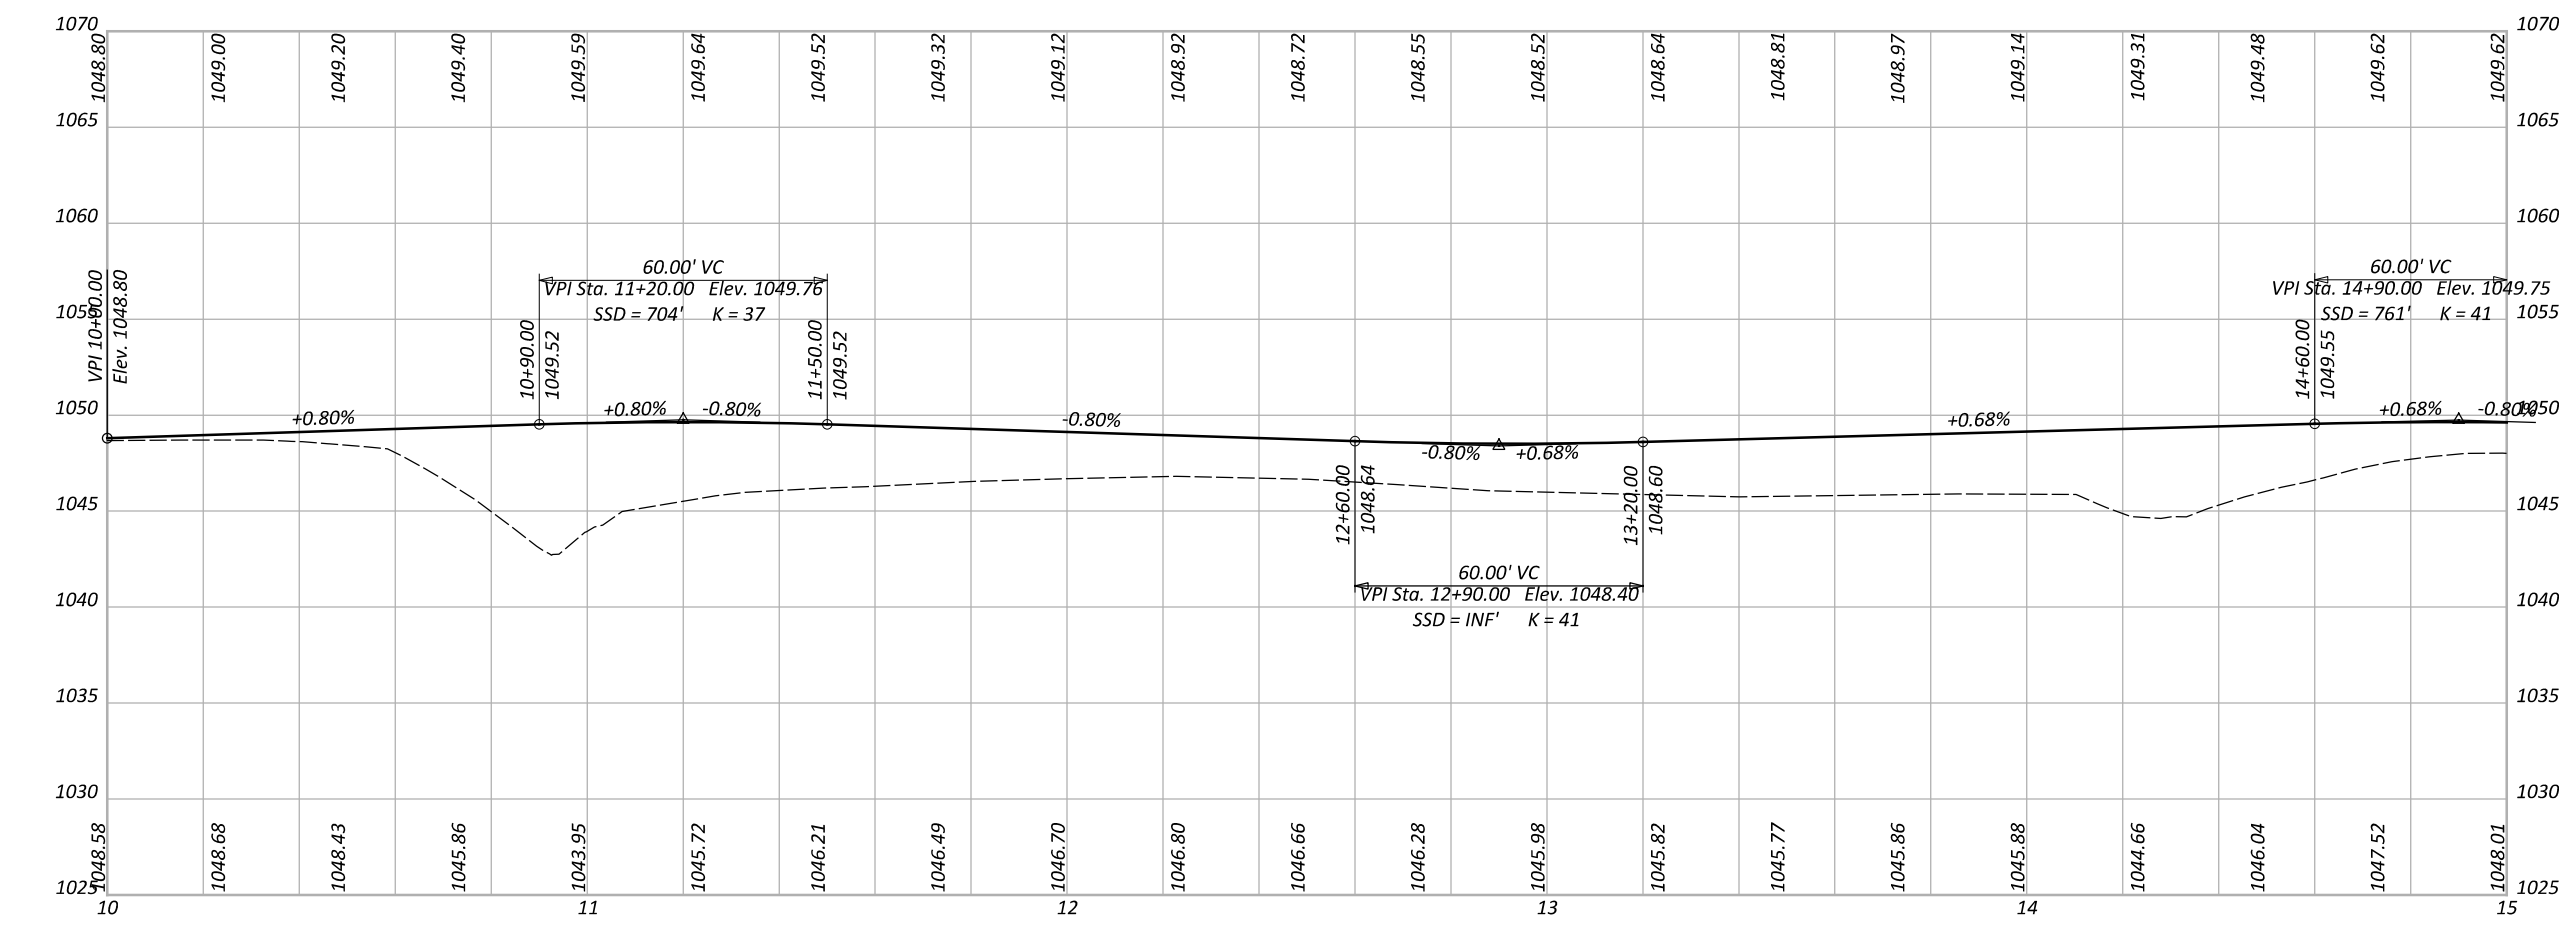


PROFILES
 SR 435 - ROUNDABOUT I.C.D.

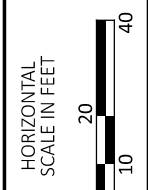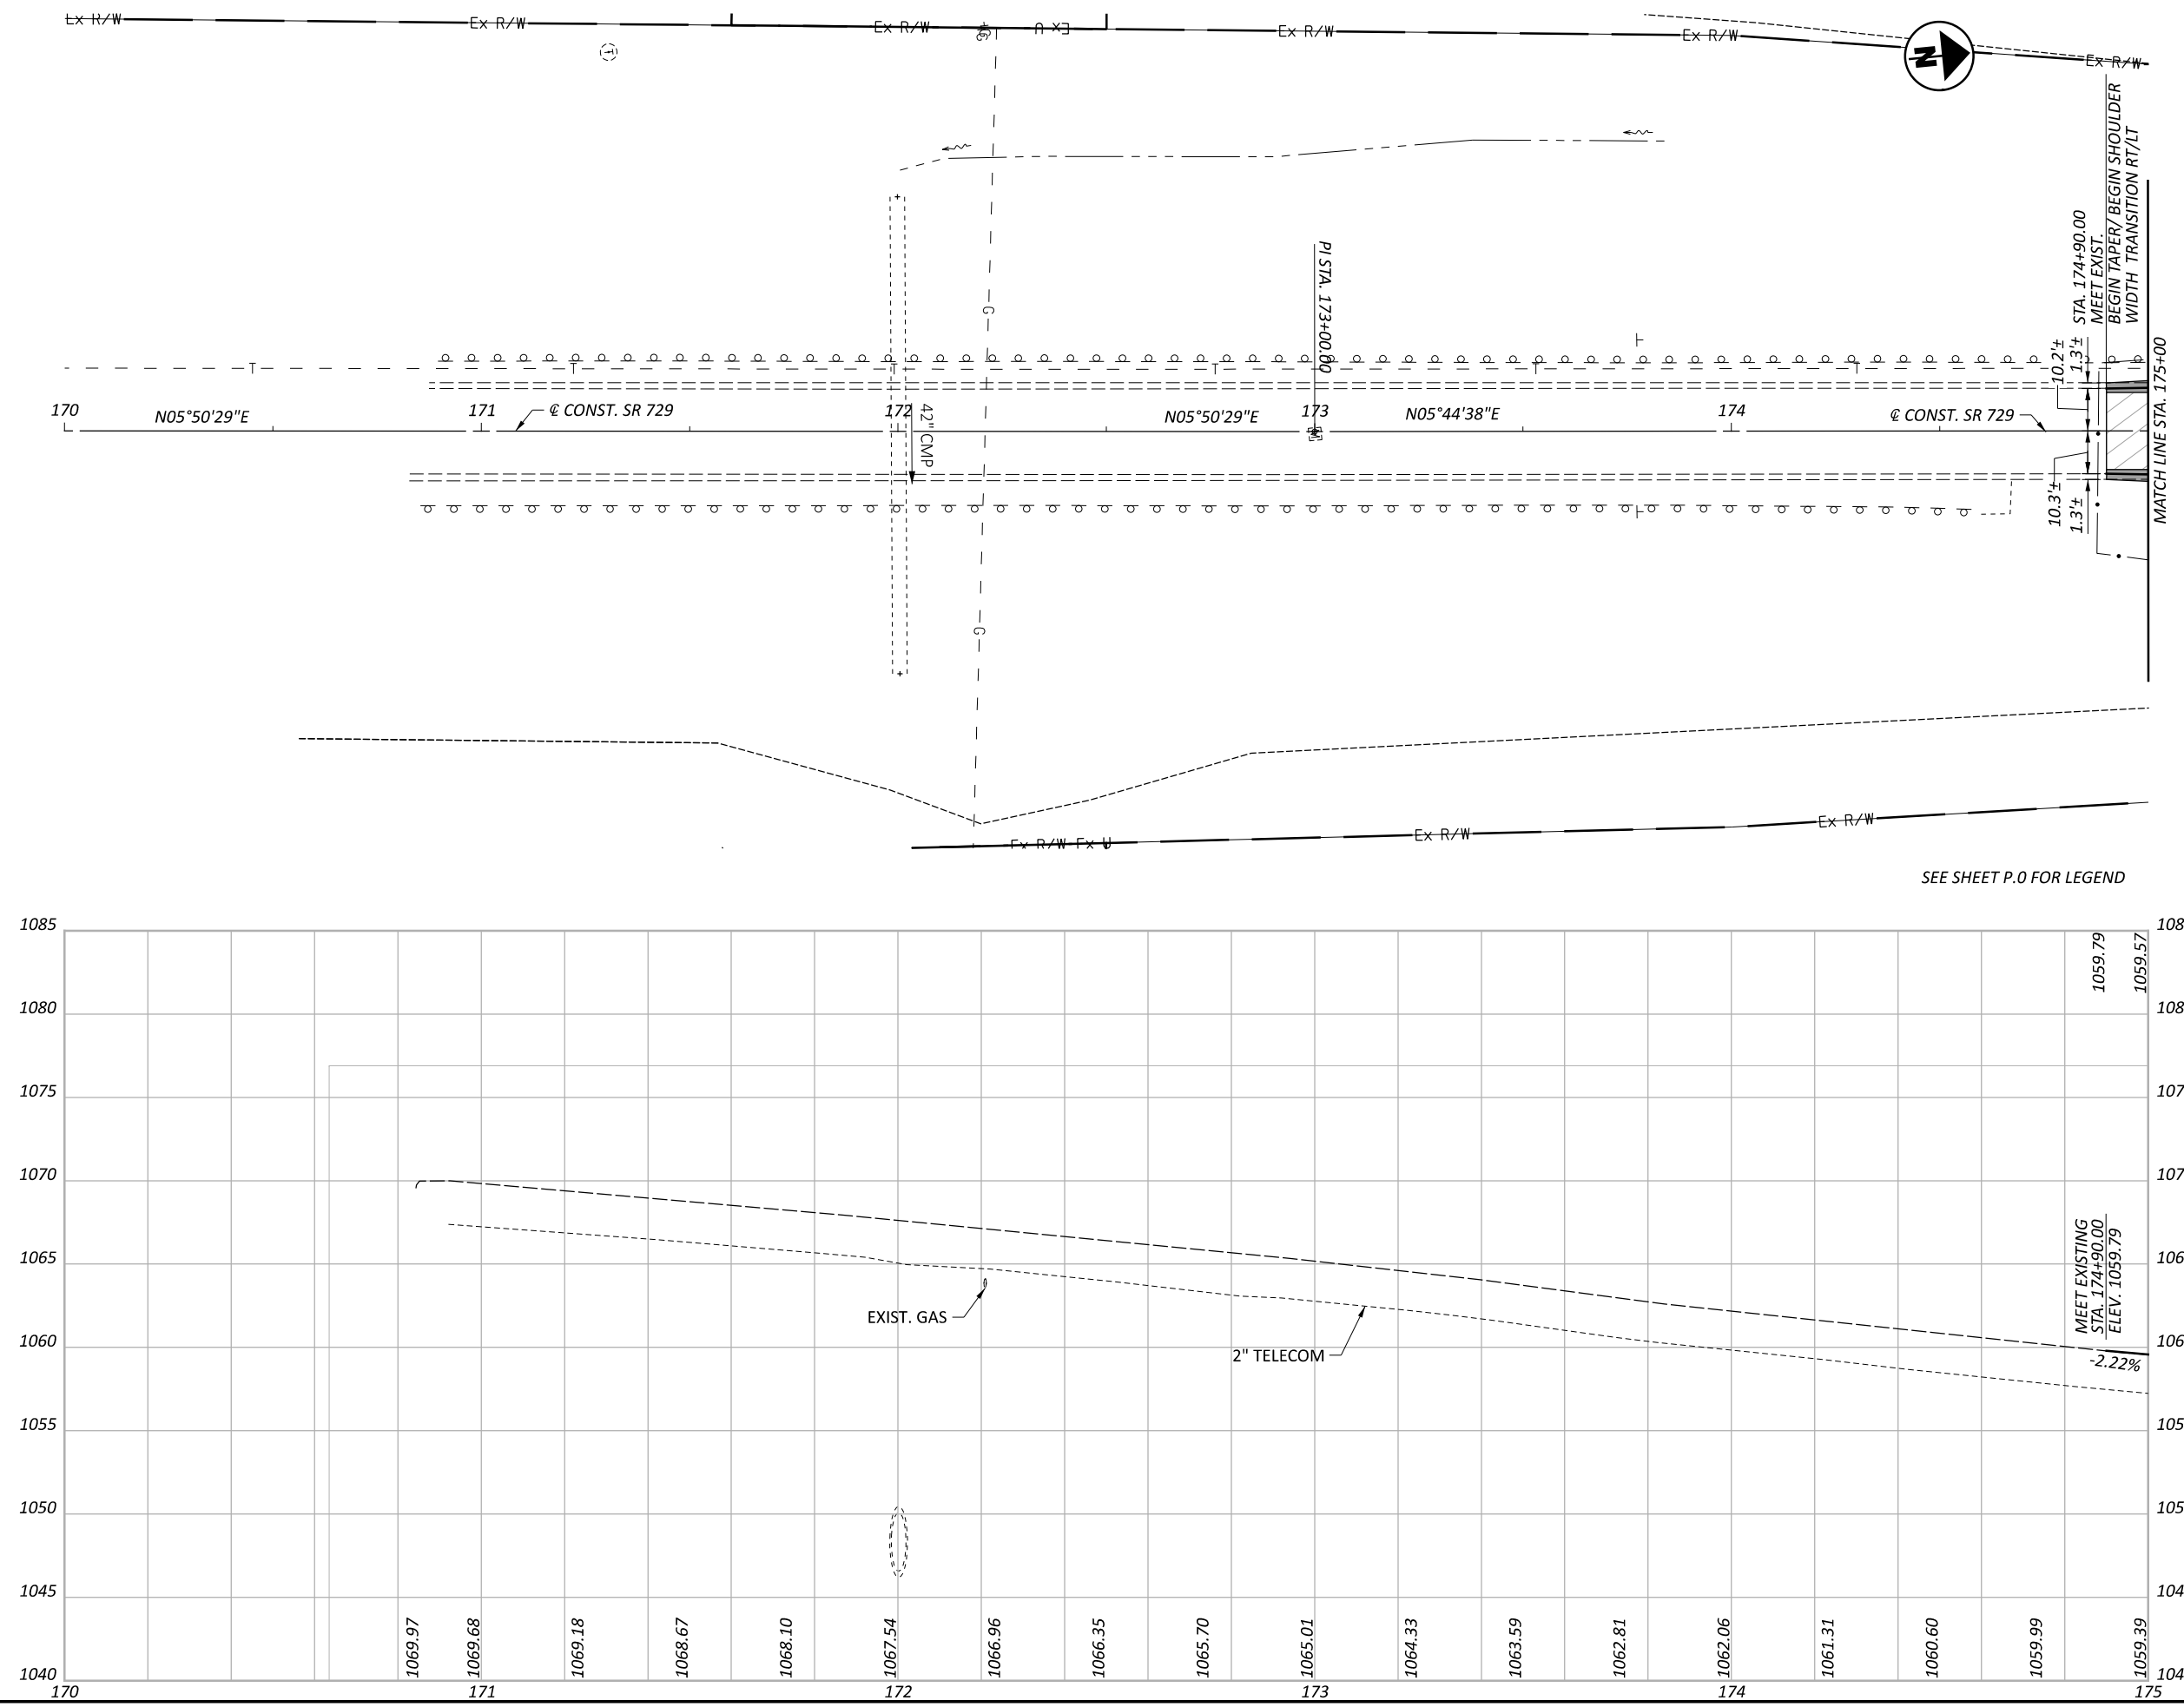

PLAN AND PROFILE
 S.R. 729 (RAB SOUTH) STA TO STA

DESIGN AGENCY	
 PALMER ENGINEERING 8350 E. KEMPER RD. SUITE B CINCINNATI, OH 45249 513-469-1600	
DESIGNER	
DPF	
REVIEWER	
DCJ MM-DD-YY	
PROJECT ID	
117955	
SHEET	TOTAL
P. 117	228

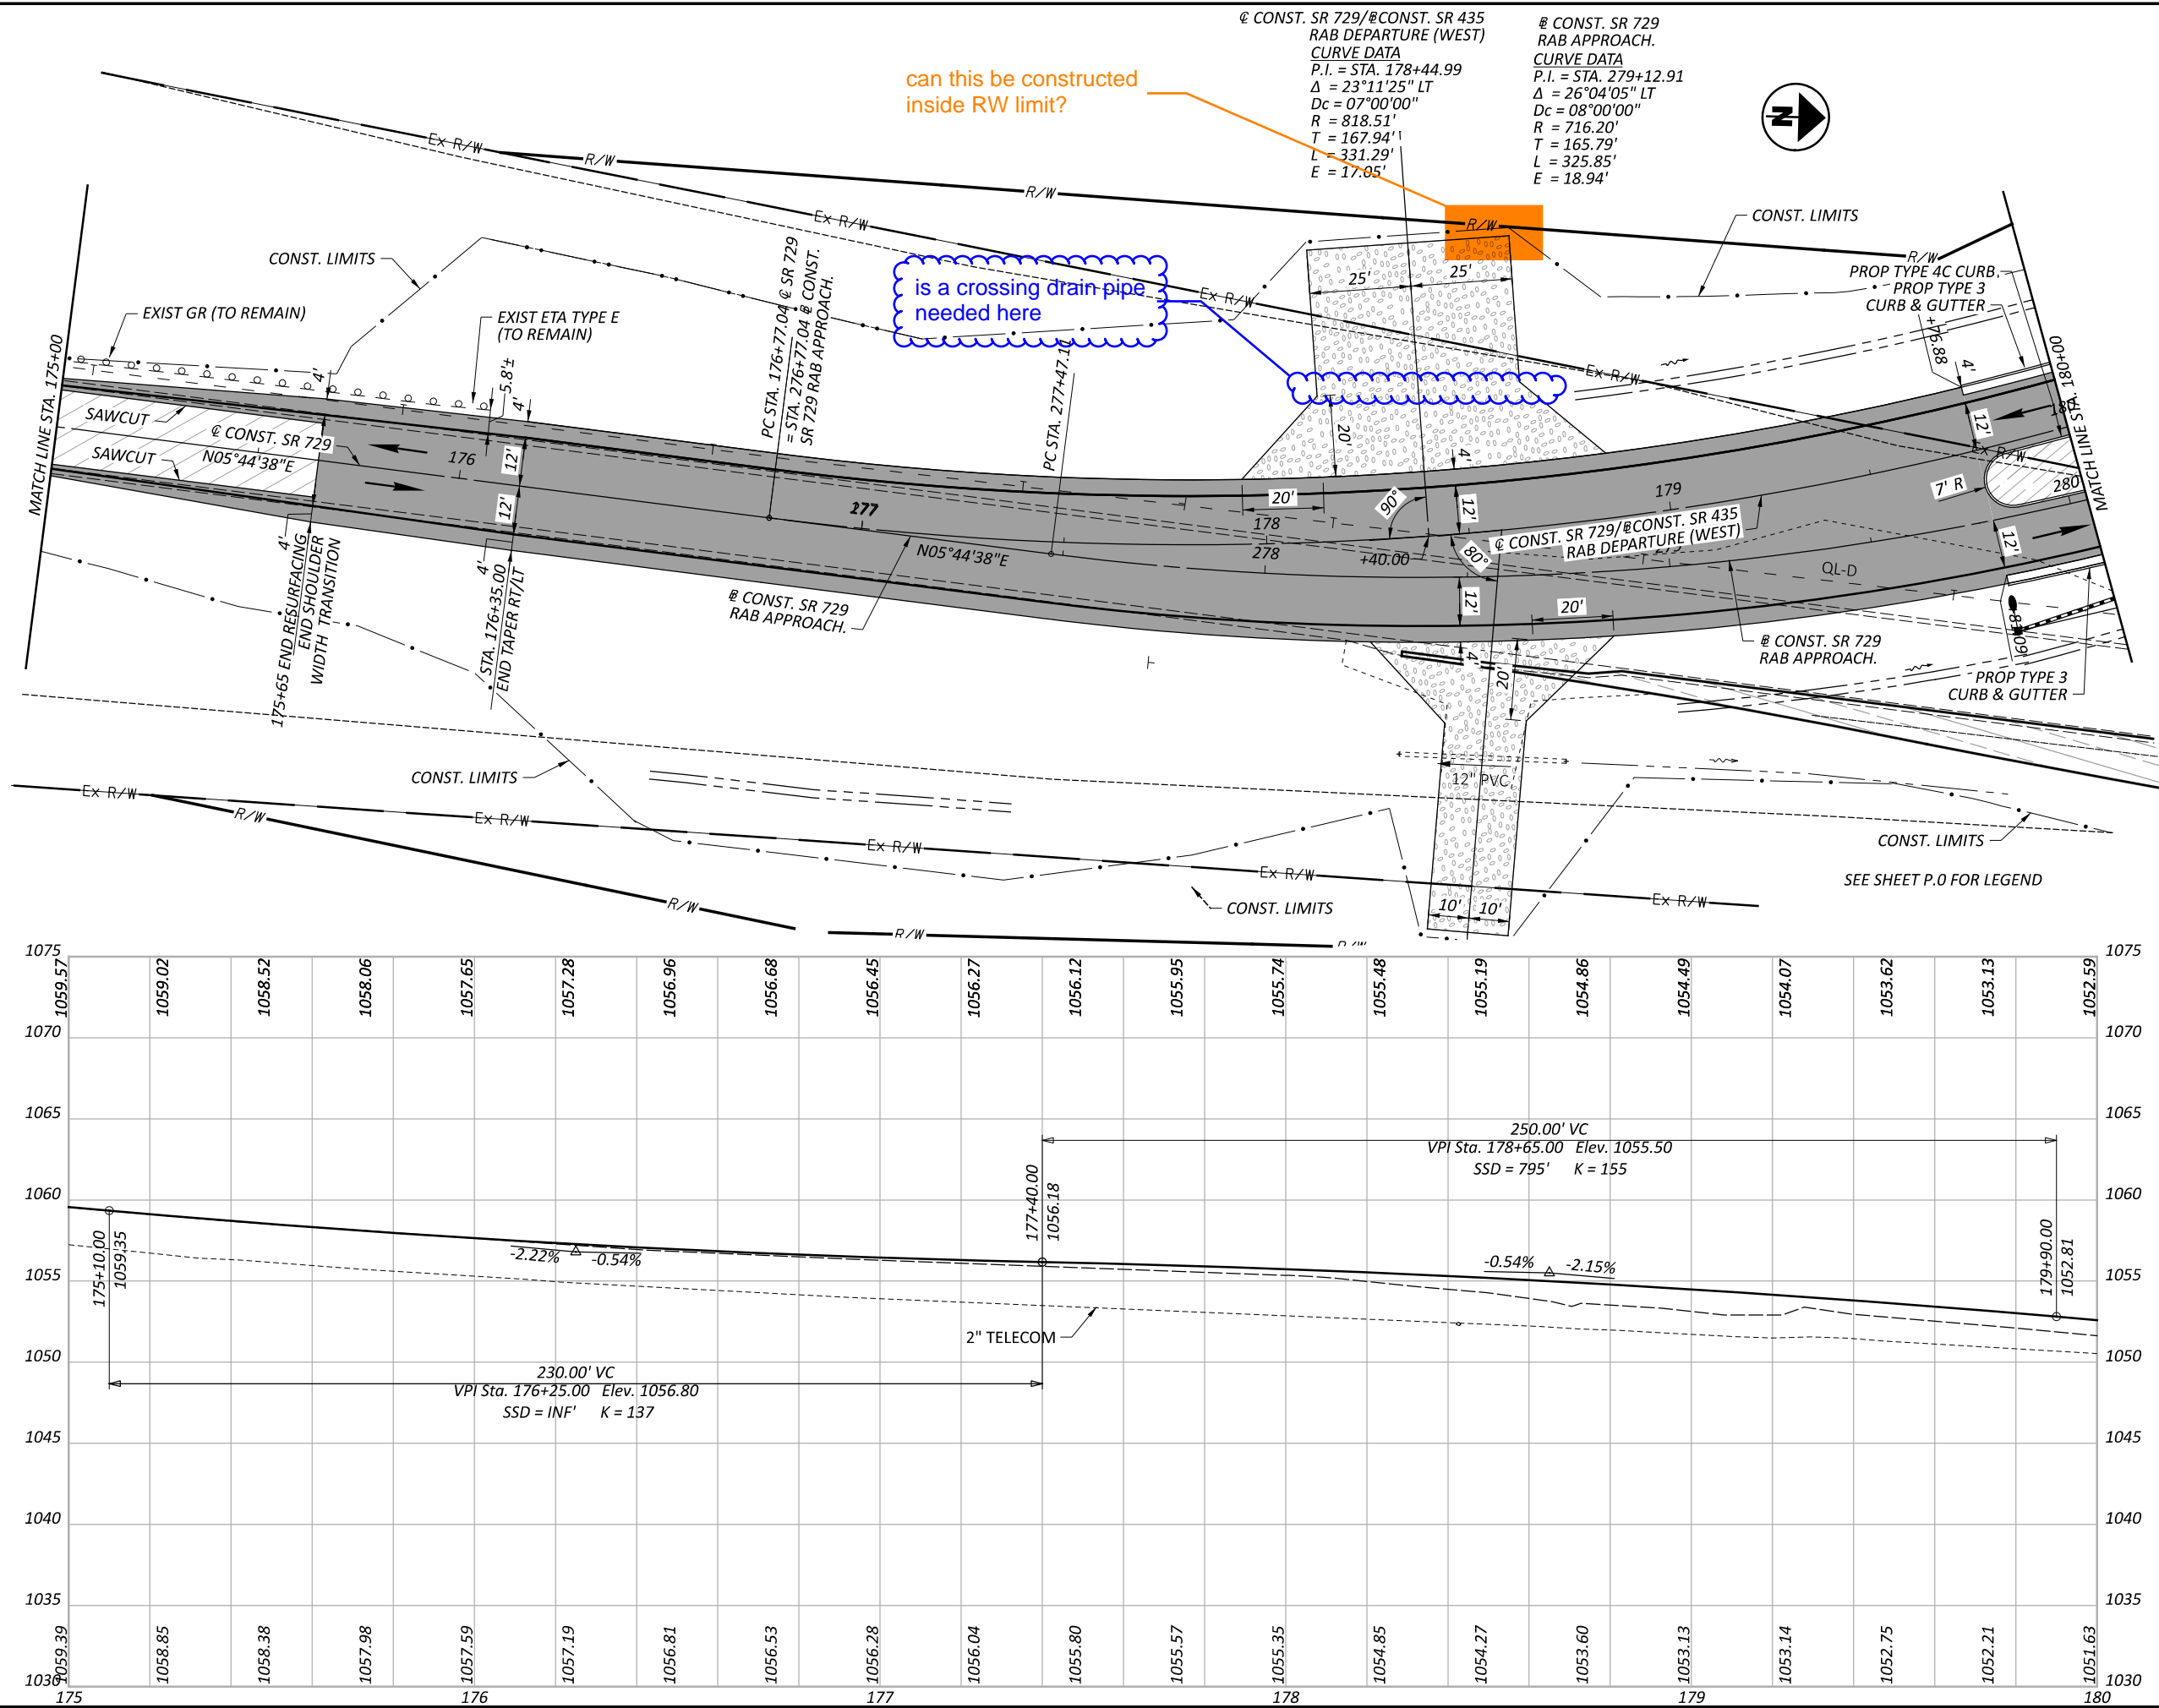


can this be constructed inside RW limit?

is a crossing drain pipe needed here

@ CONST. SR 729/@CONST. SR 435
 RAB DEPARTURE (WEST)
 CURVE DATA
 P.I. = STA. 178+44.99
 $\Delta = 23^{\circ}11'25''$ LT
 $D_c = 07^{\circ}00'00''$
 $R = 818.51'$
 $T = 167.94'$
 $L = 331.29'$
 $E = 17.95'$

@ CONST. SR 729
 RAB APPROACH.
 CURVE DATA
 P.I. = STA. 279+12.91
 $\Delta = 26^{\circ}04'05''$ LT
 $D_c = 08^{\circ}00'00''$
 $R = 716.20'$
 $T = 165.79'$
 $L = 325.85'$
 $E = 18.94'$

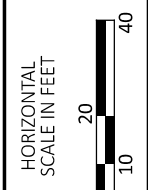

PLAN AND PROFILE
 S.R. 729 (RAB SOUTH) STA TO STA




DESIGN AGENCY	
8350 E. KEMPER RD. SUITE B CINCINNATI, OH 45249 513-469-1600	
DESIGNER	DPF
REVIEWER	DCJ MM-DD-YY
PROJECT ID	117955
SHEET	TOTAL
P. 118	228

@ CONST. SR 729
 CURVE DATA
 P.I. = STA. 182+09.43
 $\Delta = 16^{\circ}19'30''$ RT
 $D_c = 10^{\circ}59'50''$
 $R = 521.00'$
 $T = 74.73'$
 $L = 148.45'$
 $E = 5.33'$

@ CONST. SR 729
 RAB DEPARTURE
 CURVE DATA
 P.I. = STA. 382+86.92
 $\Delta = 31^{\circ}53'12''$ LT
 $D_c = 30^{\circ}58'14''$
 $R = 185.00'$
 $T = 52.85'$
 $L = 102.96'$
 $E = 7.40'$

@ CONST. SR 729
 RAB APPROACH.
 CURVE DATA
 P.I. = STA. 279+12.91
 $\Delta = 26^{\circ}04'05''$ LT
 $D_c = 08^{\circ}00'00''$
 $R = 716.20'$
 $T = 165.79'$
 $L = 325.85'$
 $E = 18.94'$


@ CONST. SR 729
 RAB APPROACH.
 CURVE DATA
 P.I. = STA. 282+97.09
 $\Delta = 82^{\circ}16'27''$ RT
 $D_c = 47^{\circ}21'07''$
 $R = 121.00'$
 $T = 105.69'$
 $L = 173.75'$
 $E = 39.66'$

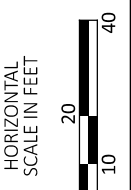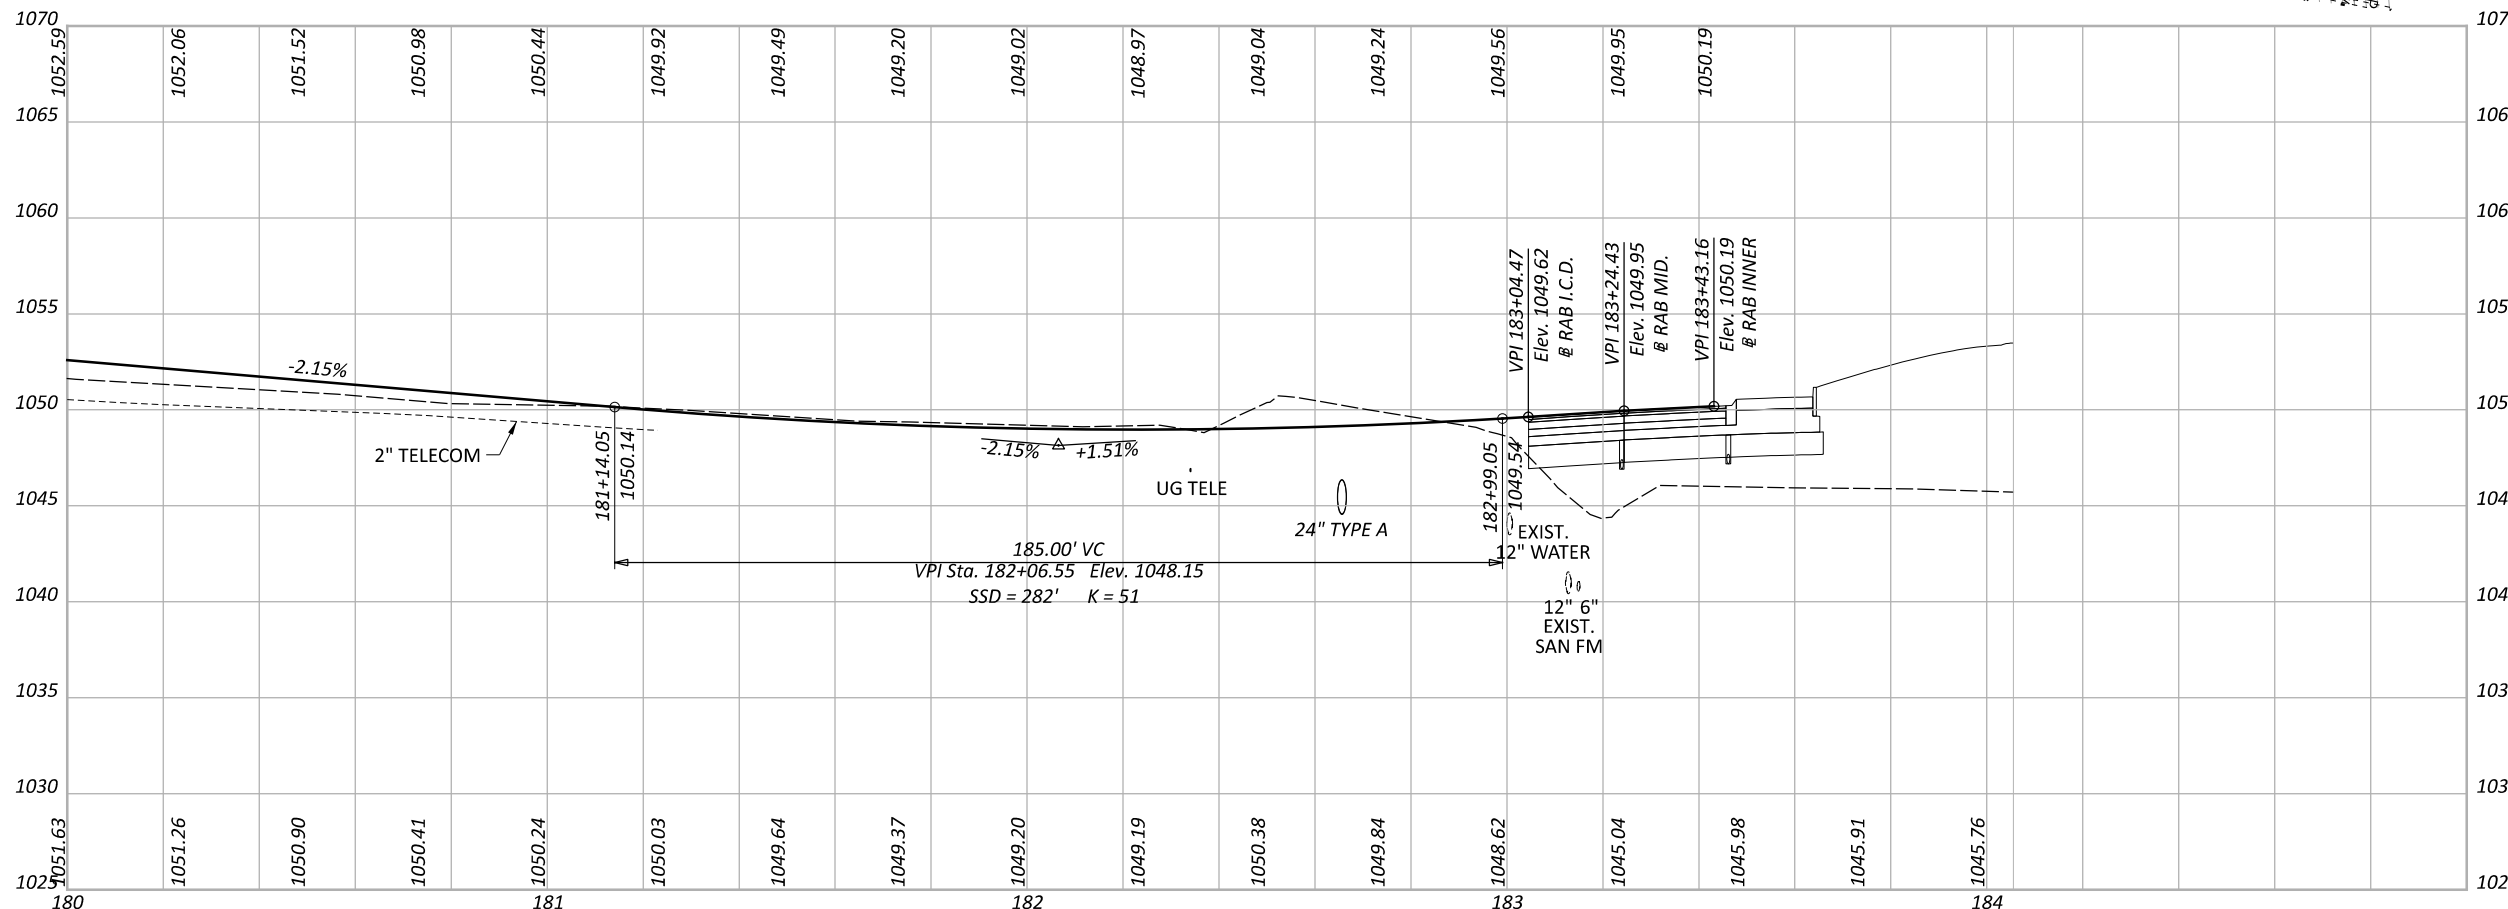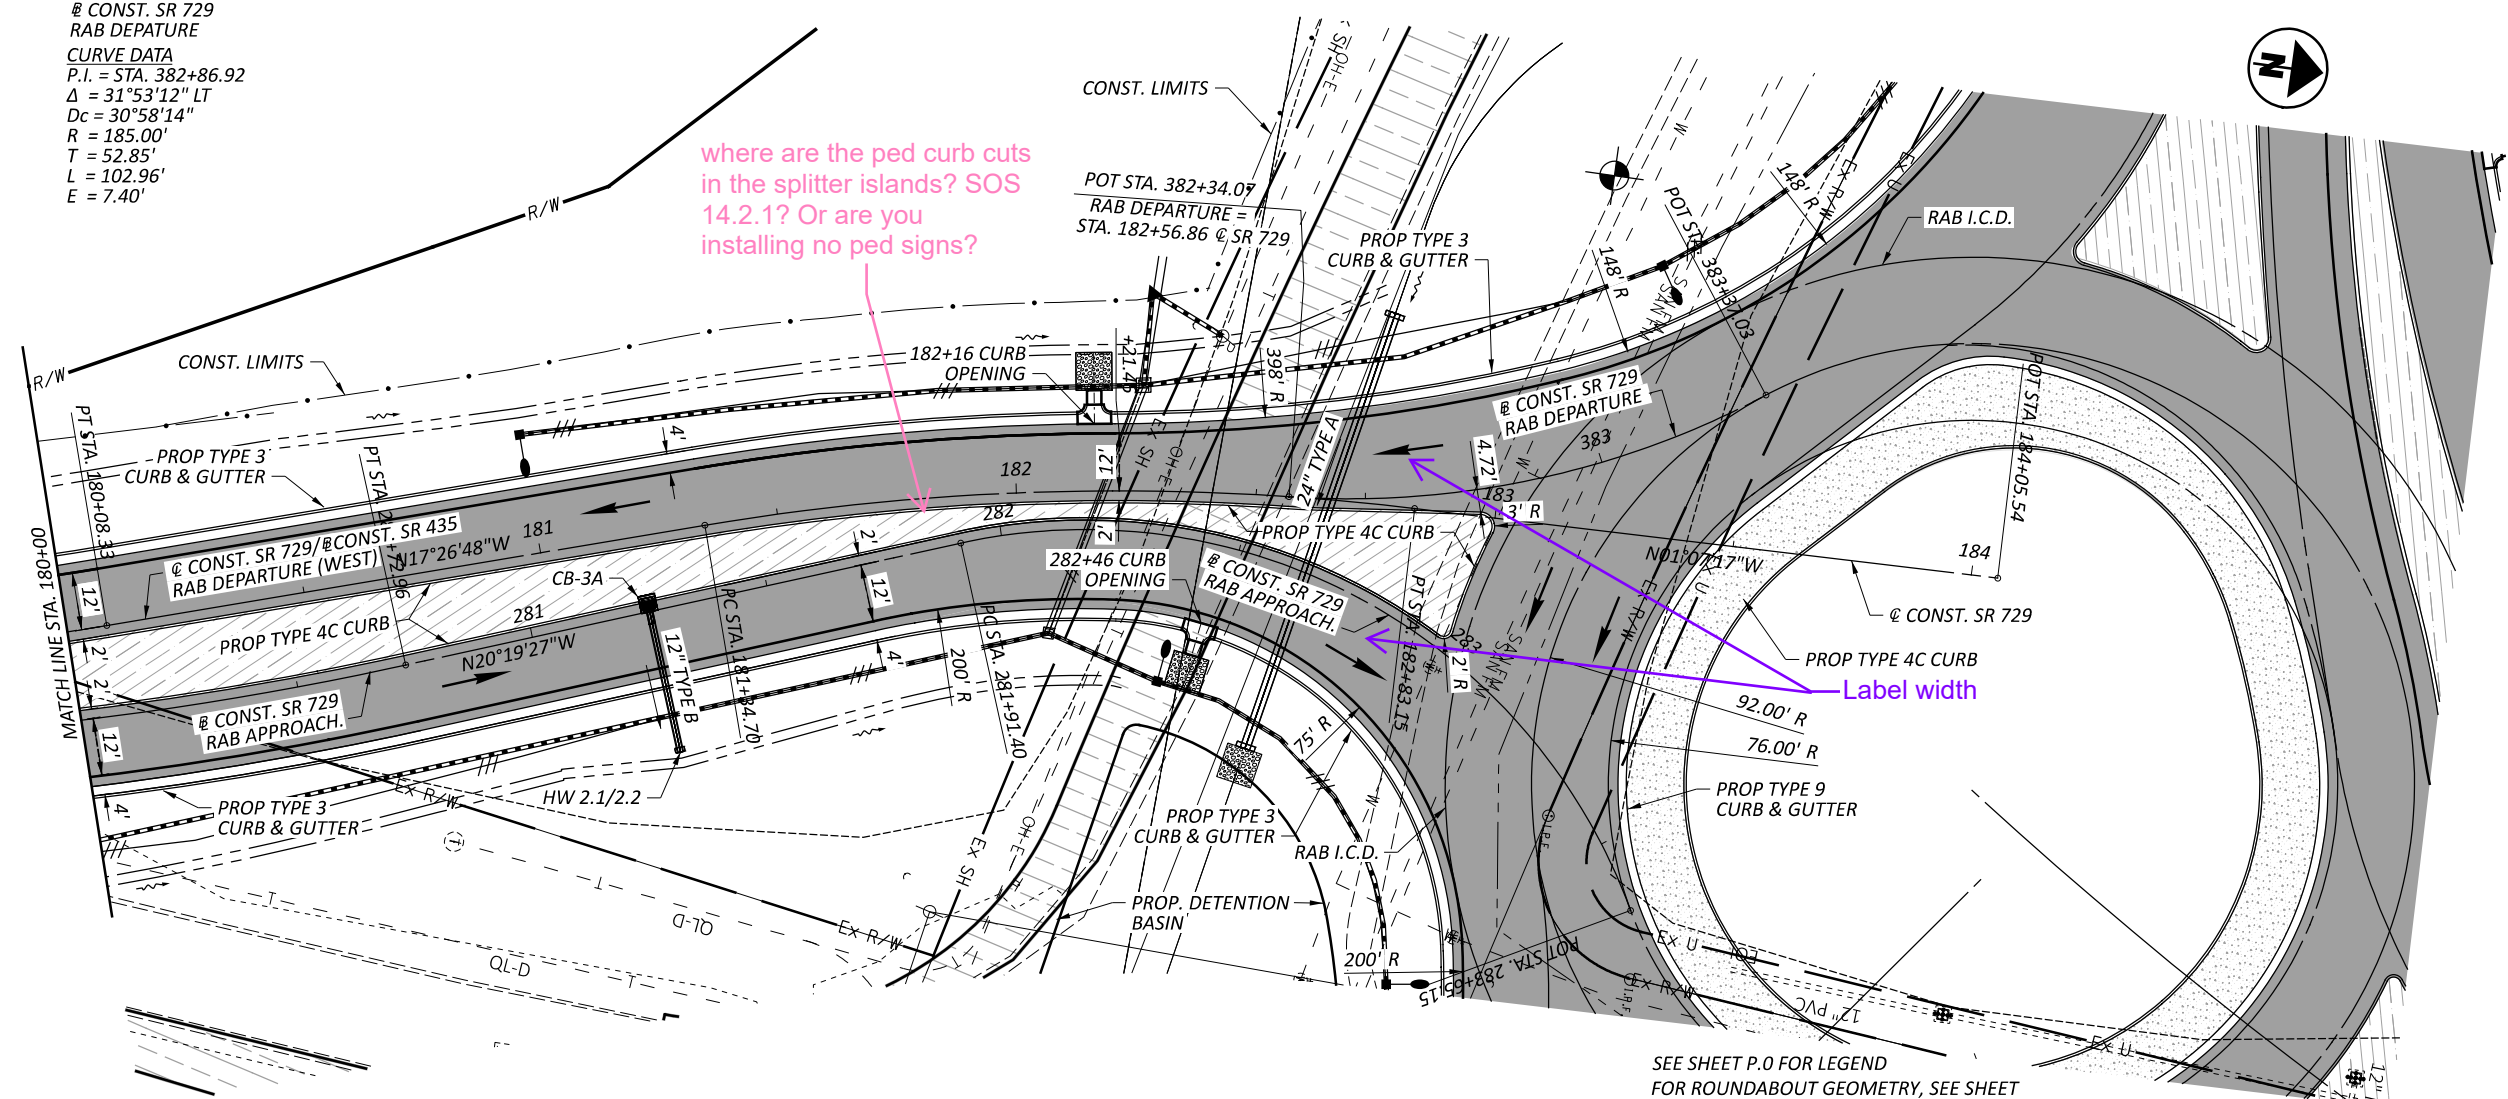

PLAN AND PROFILE
 S.R. 729 (RAB SOUTH) STA TO STA

DESIGN AGENCY
Palmer
 ENGINEERING
 8350 E. KEMPER RD.
 SUITE B
 CINCINNATI, OH 45249
 513-469-1600

DESIGNER	DPF
REVIEWER	DCJ MM-DD-YY
PROJECT ID	117955
SHEET TOTAL	P. 119 228

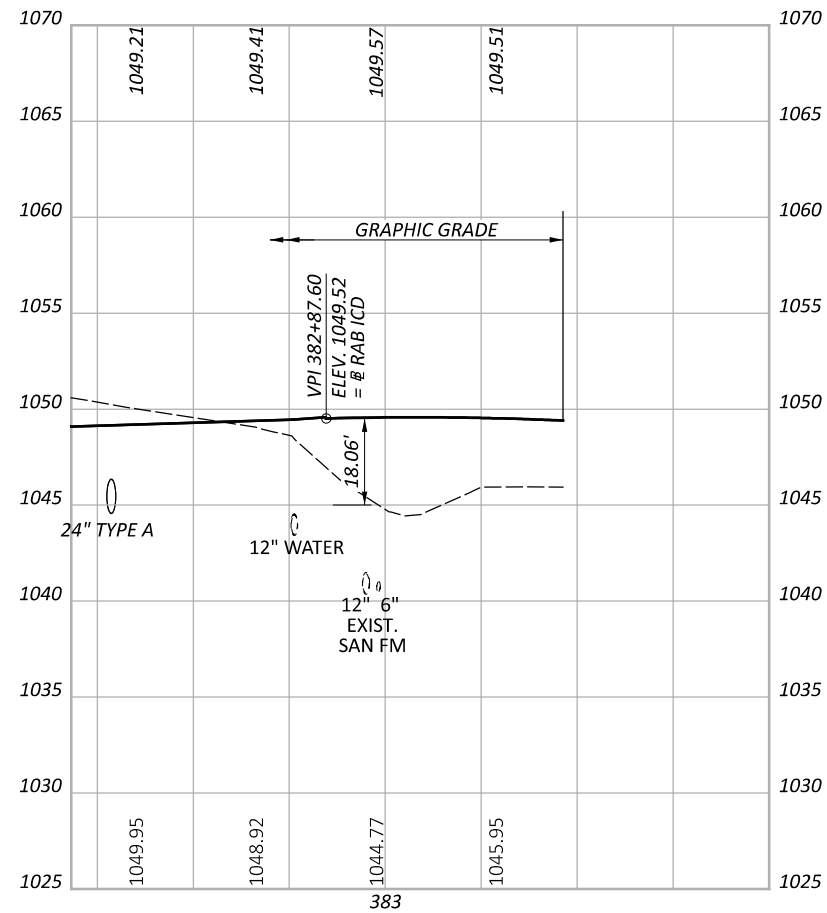

PROFILES
 SR 729 - ROUNDABOUT DEPARTURE

DESIGN AGENCY





DESIGNER
 DPF

REVIEWER
 DCJ MM-DD-YY

PROJECT ID
 117955

SHEET TOTAL
 P. 121 228

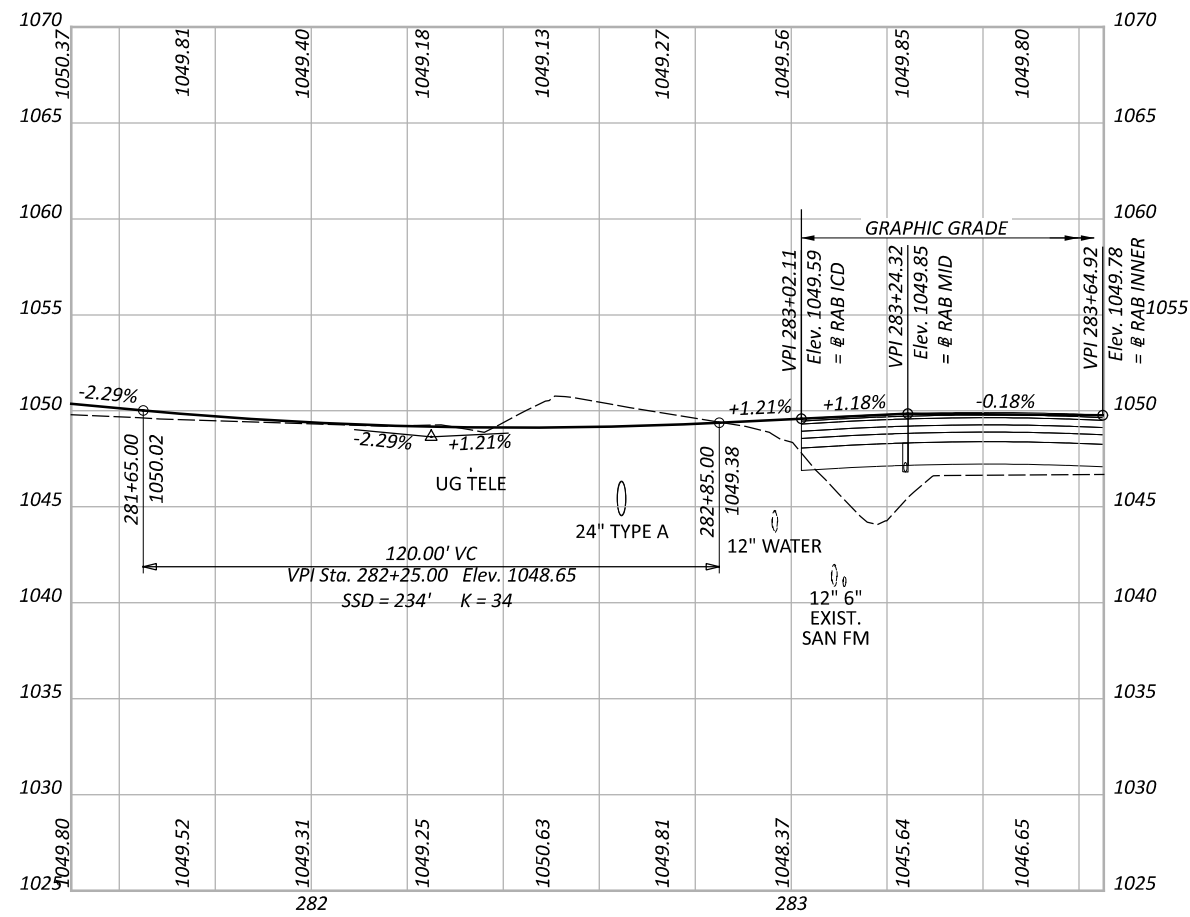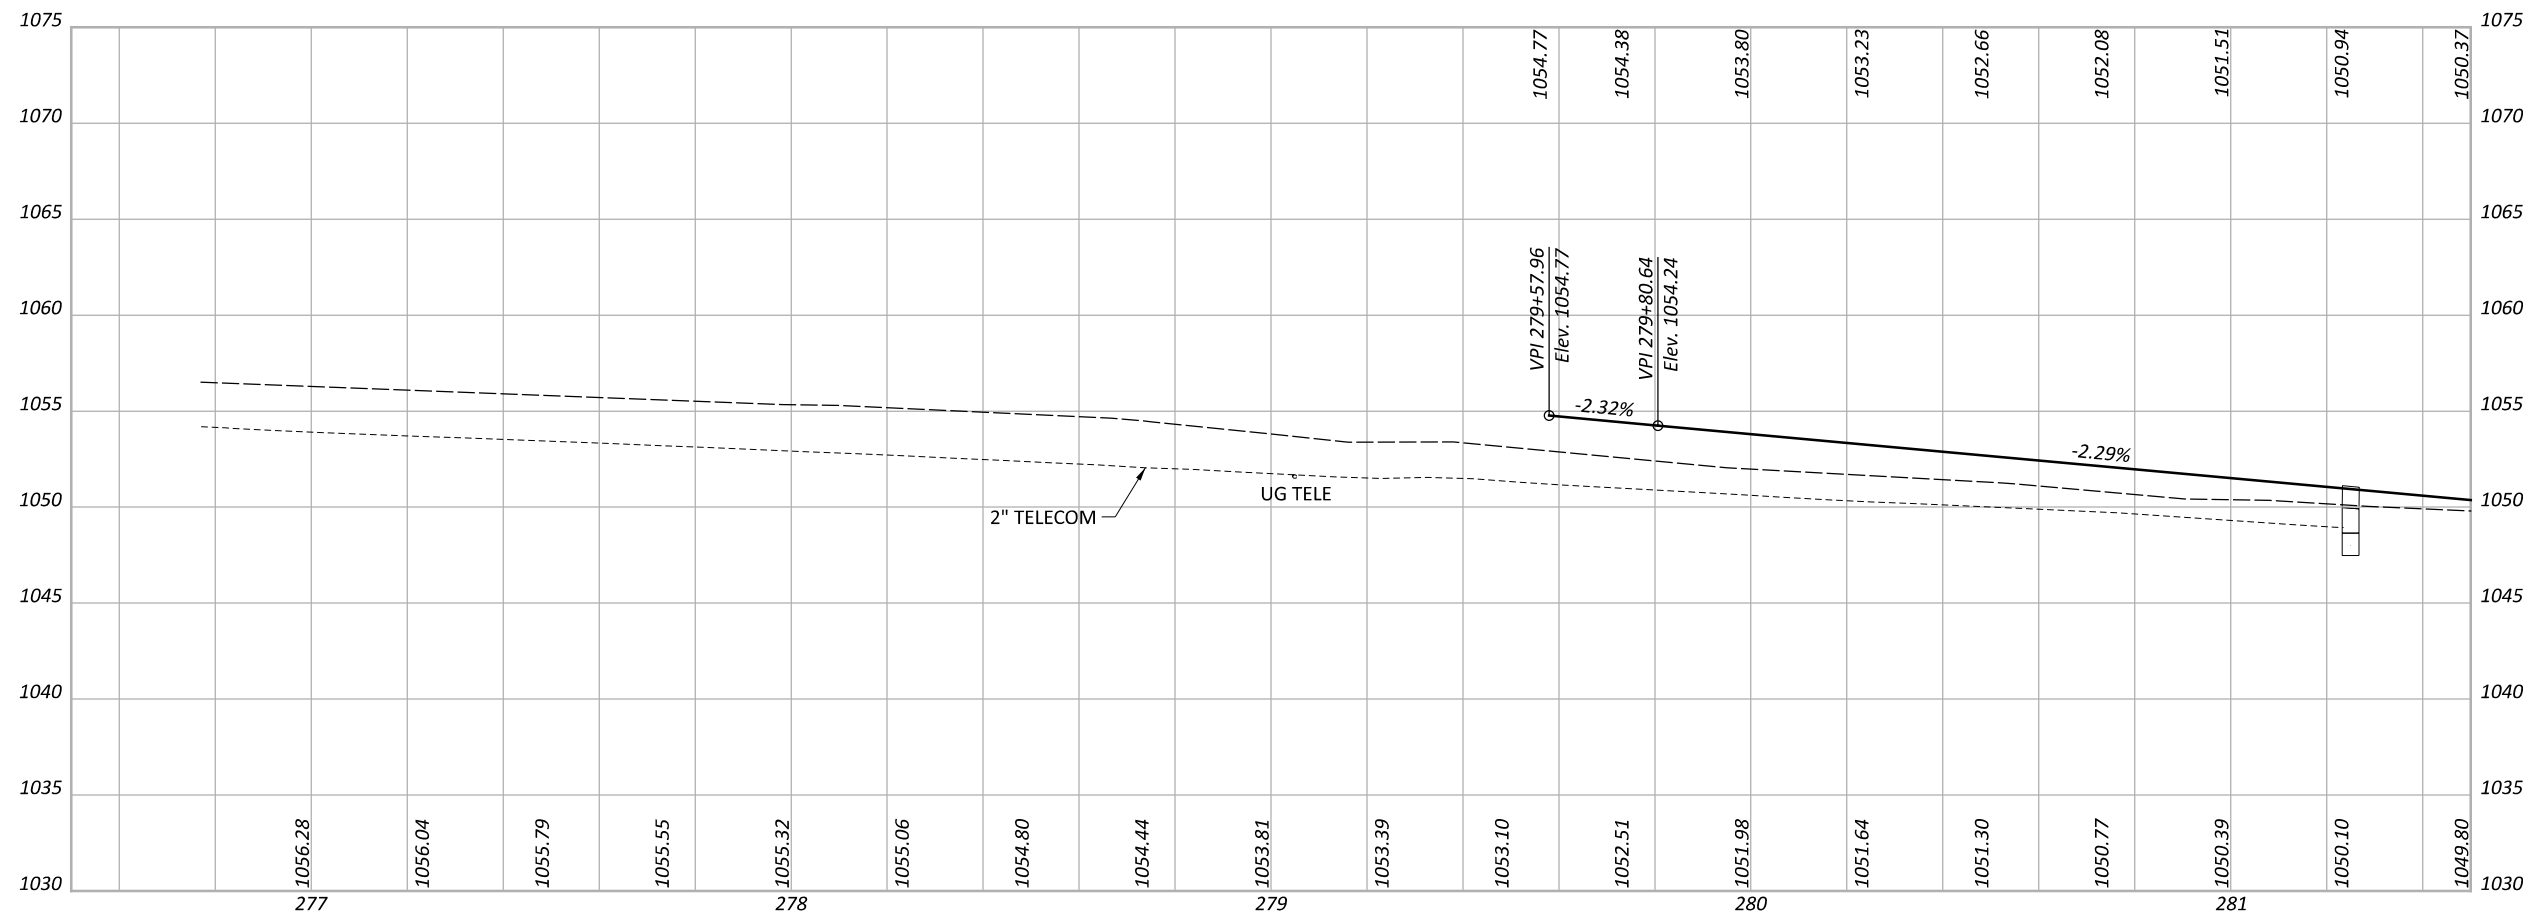

PROFILES
 SR 729 - ROUNDABOUT APPROACH

DESIGN AGENCY

Palmer
 ENGINEERING
 8350 E. KEMPER RD.
 SUITE B
 CINCINNATI, OH 45249
 513-469-1600

DESIGNER
DPF

REVIEWER
DCJ MM-DD-YY

PROJECT ID
117955

SHEET TOTAL
 P. 120 228

@ CONST. BLUEGRASS BLVD.
 RAB APPROACH.
 CURVE DATA
 P.I. = STA. 384+63.30
 $\Delta = 46^{\circ}15'12''$ LT
 $D_c = 38^{\circ}11'50''$
 $R = 150.00'$
 $T = 64.06'$
 $L = 121.09'$
 $E = 13.11'$

@ CONST. BLUEGRASS BLVD.
 RAB APPROACH.
 CURVE DATA
 P.I. = STA. 386+91.11
 $\Delta = 24^{\circ}16'41''$ LT
 $D_c = 07^{\circ}12'58''$
 $R = 794.00'$
 $T = 170.78'$
 $L = 336.44'$
 $E = 18.16'$


@ CONST. BLUEGRASS BLVD.
 CURVE DATA
 P.I. = STA. 186+20.39
 $\Delta = 31^{\circ}17'50''$ LT
 $D_c = 06^{\circ}00'00''$
 $R = 954.93'$
 $T = 267.49'$
 $L = 521.62'$
 $E = 36.76'$

@ CONST. BLUEGRASS BLVD.
 RAB DEPARTURE
 CURVE DATA
 P.I. = STA. 284+65.93
 $\Delta = 28^{\circ}43'48''$ RT
 $D_c = 17^{\circ}37'46''$
 $R = 325.00'$
 $T = 83.23'$
 $L = 162.97'$
 $E = 10.49'$

@ CONST. SR 435
 W.B. BYPASS LANE
 CURVE DATA
 P.I. = STA. 407+94.97
 $\Delta = 45^{\circ}40'07''$ LT
 $D_c = 17^{\circ}30'01''$
 $R = 327.40'$
 $T = 137.86'$
 $L = 260.96'$
 $E = 27.84'$



@ CONST. SR 435
 W.B. BYPASS LANE
 CURVE DATA
 P.I. = STA. 410+34.87
 $\Delta = 13^{\circ}56'49''$ LT
 $D_c = 06^{\circ}00'00''$
 $R = 954.93'$
 $T = 116.80'$
 $L = 232.45'$
 $E = 7.12'$

@ CONST. BLUEGRASS BLVD.
 RAB DEPARTURE
 CURVE DATA
 P.I. = STA. 287+12.32
 $\Delta = 19^{\circ}40'41''$ LT
 $D_c = 05^{\circ}57'45''$
 $R = 960.93'$
 $T = 166.66'$
 $L = 330.03'$
 $E = 14.34'$

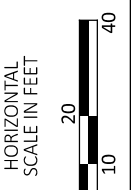

PLAN AND PROFILE
 BLUEGRASS BLVD. (RAB NORTH) STA 183+52.09 TO STA 188+00

SEE SHEET P.0 FOR LEGEND
 FOR ROUNDABOUT GEOMETRY, SEE SHEET

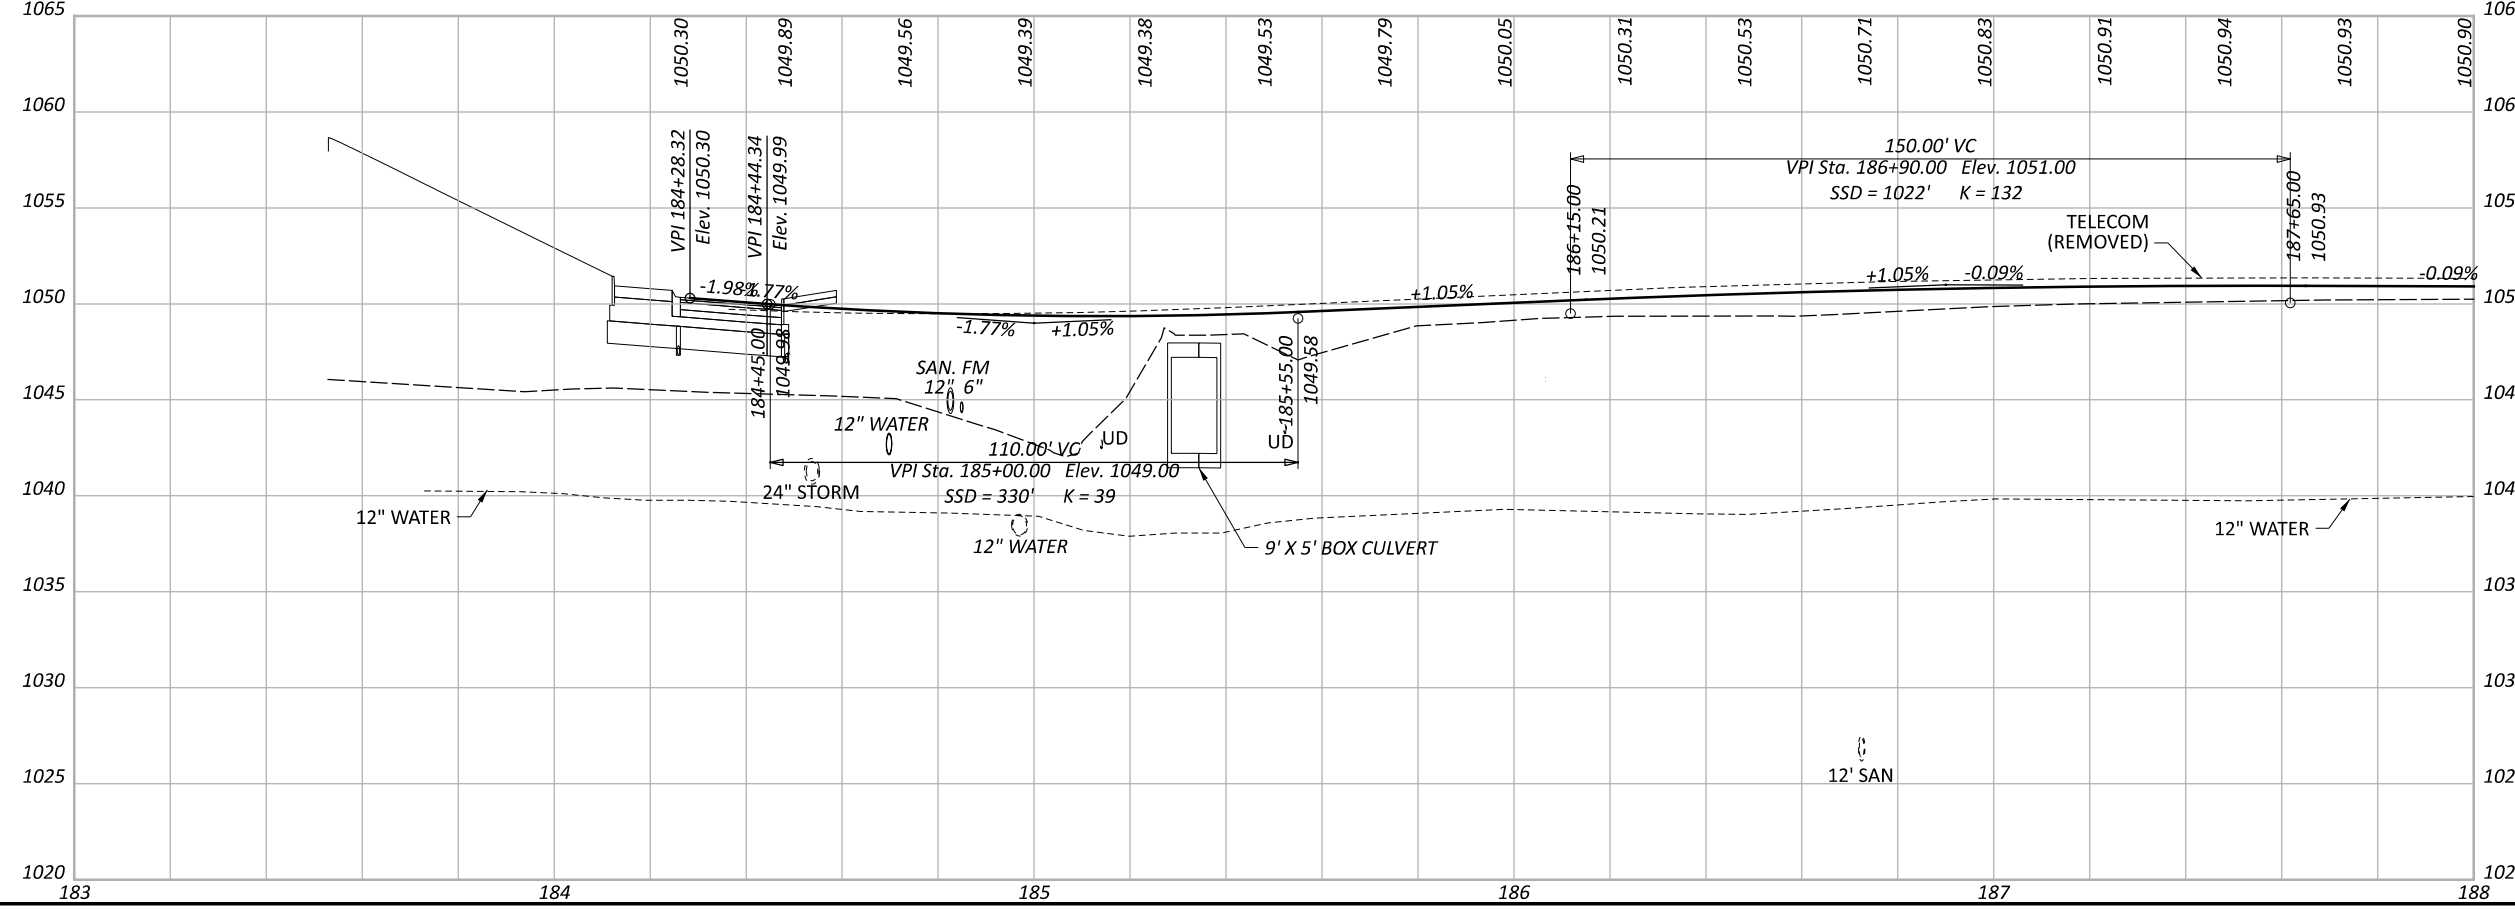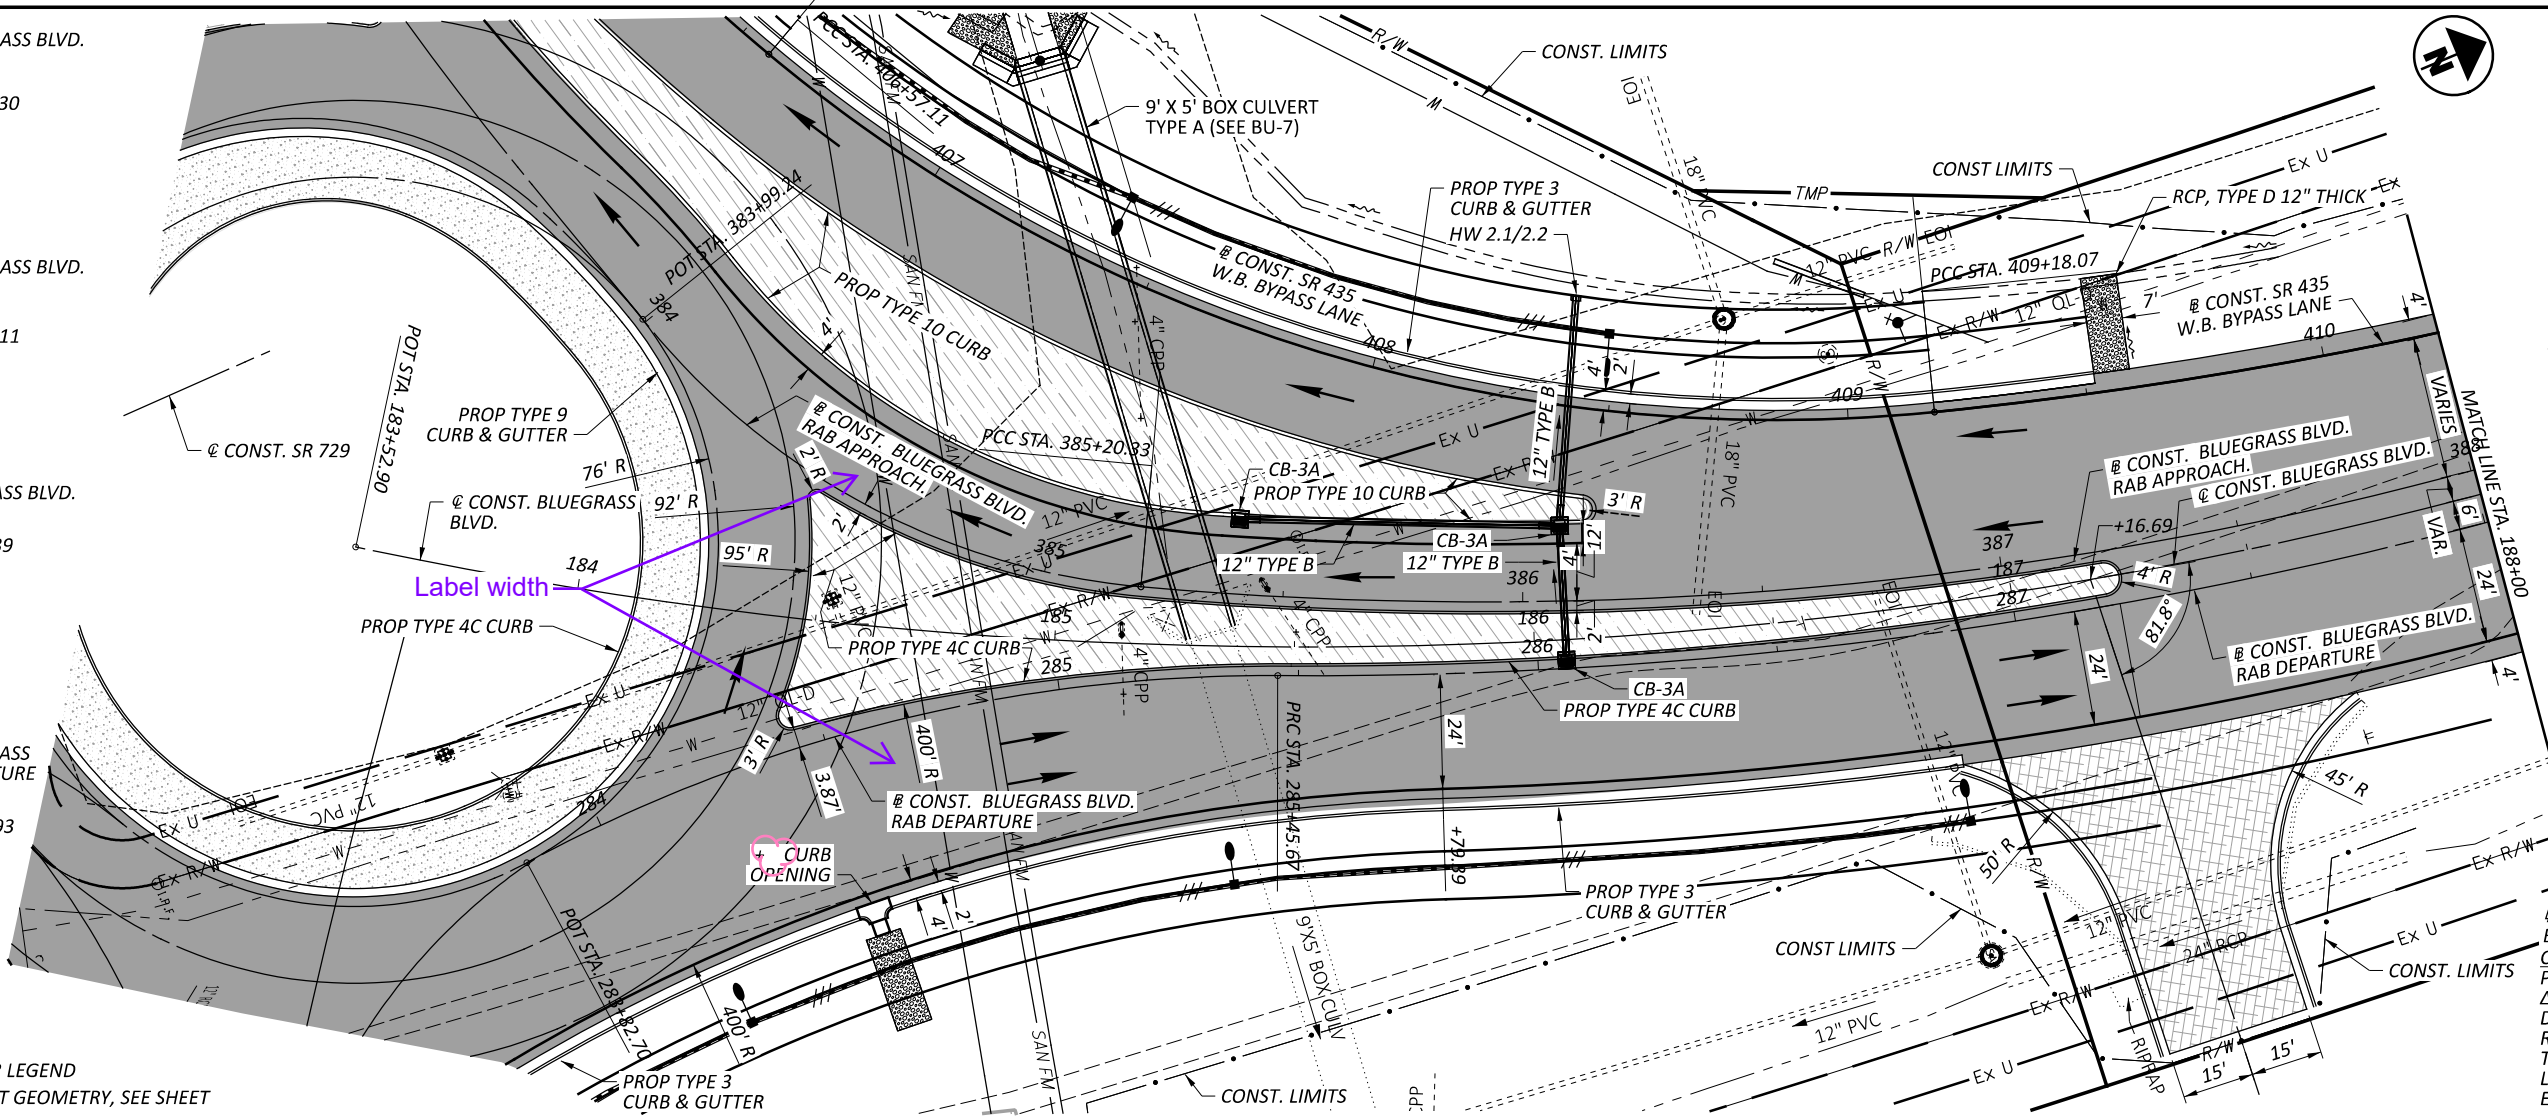

DESIGN AGENCY	
Palmer ENGINEERING	
8350 E. KEMPER RD. SUITE B CINCINNATI, OH 45249 513-469-1600	
DESIGNER	
DPF	
REVIEWER	
DCJ MM-DD-YY	
PROJECT ID	
117955	
SHEET	TOTAL
P. 122	228

@ CONST. BLUEGRASS BLVD.
 CURVE DATA
 P.I. = STA. 186+20.39
 $\Delta = 31^{\circ}17'50''$ LT
 Dc = $06^{\circ}00'00''$
 R = 954.93'
 T = 267.49'
 L = 521.62'
 E = 36.76'

CURVE DATA
 P.I. = STA. 190+14.58
 $\Delta = 02^{\circ}06'02''$ LT
 Dc = $00^{\circ}45'00''$
 R = 7,639.27'
 T = 140.06'
 L = 280.08'
 E = 1.28'




@ CONST. BLUEGRASS BLVD.
 RAB DEPARTURE
 CURVE DATA
 P.I. = STA. 287+12.32
 $\Delta = 19^{\circ}40'41''$ LT
 Dc = $05^{\circ}57'45''$
 R = 960.93'
 T = 166.66'
 L = 330.03'
 E = 14.34'

@ CONST. SR 435 W.B. BYPASS LANE
 CURVE DATA
 P.I. = STA. 410+34.87
 $\Delta = 13^{\circ}56'49''$ LT
 Dc = $06^{\circ}00'00''$
 R = 954.93'
 T = 116.80'
 L = 232.45'
 E = 7.12'

@ CONST. SR 435 W.B. BYPASS LANE
 CURVE DATA
 P.I. = STA. 412+38.06
 $\Delta = 01^{\circ}19'06''$ LT
 Dc = $00^{\circ}45'11''$
 R = 7,609.27'
 T = 87.54'
 L = 175.07'
 E = 0.50'

@ CONST. BLUEGRASS BLVD. RAB APPROACH.
 CURVE DATA
 P.I. = STA. 386+91.11
 $\Delta = 24^{\circ}16'41''$ LT
 Dc = $07^{\circ}12'58''$
 R = 794.00'
 T = 170.78'
 L = 336.44'
 E = 18.16'

@ CONST. BLUEGRASS BLVD. RAB APPROACH.
 CURVE DATA
 P.I. = STA. 390+05.75
 $\Delta = 02^{\circ}14'10''$ LT
 Dc = $00^{\circ}45'02''$
 R = 7,633.27'
 T = 148.98'
 L = 297.92'
 E = 1.45'

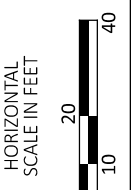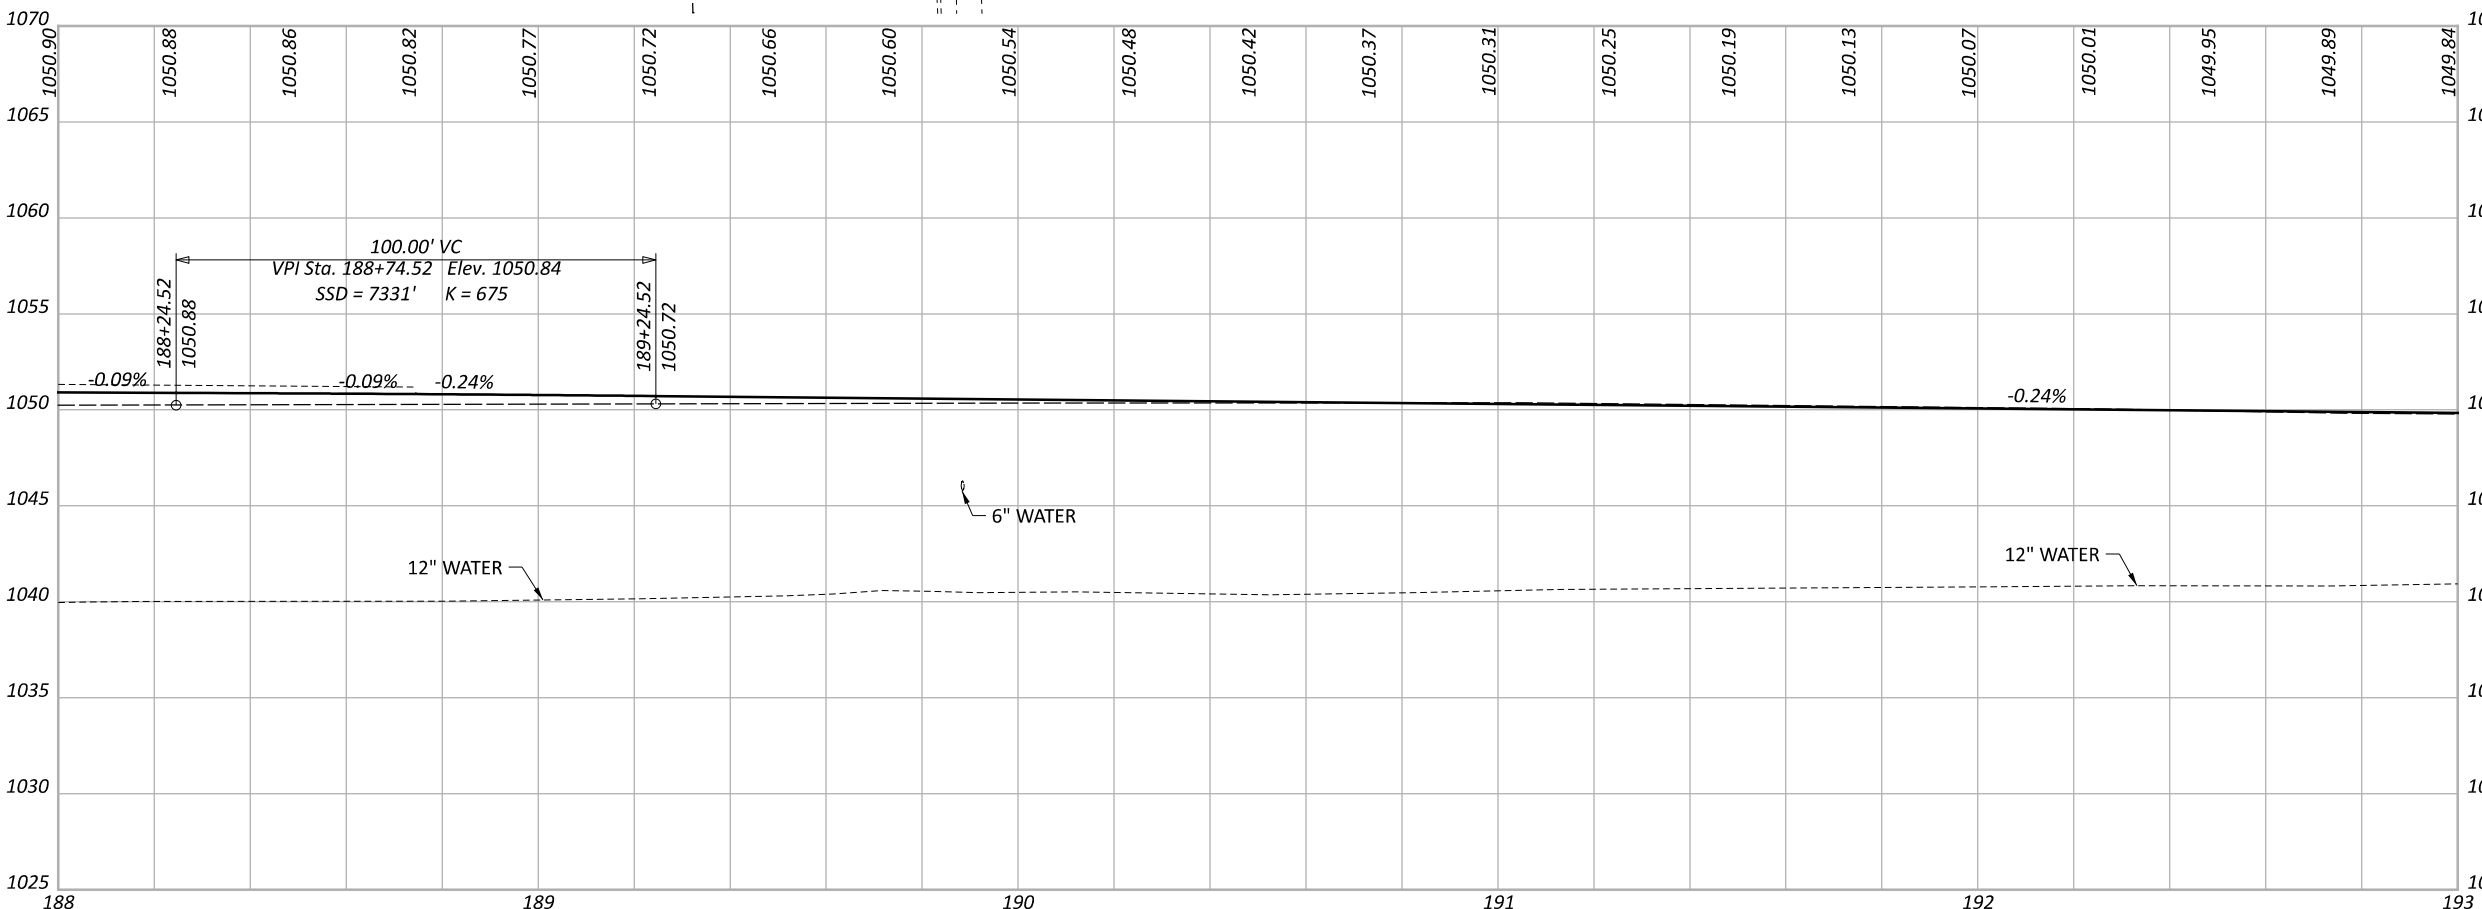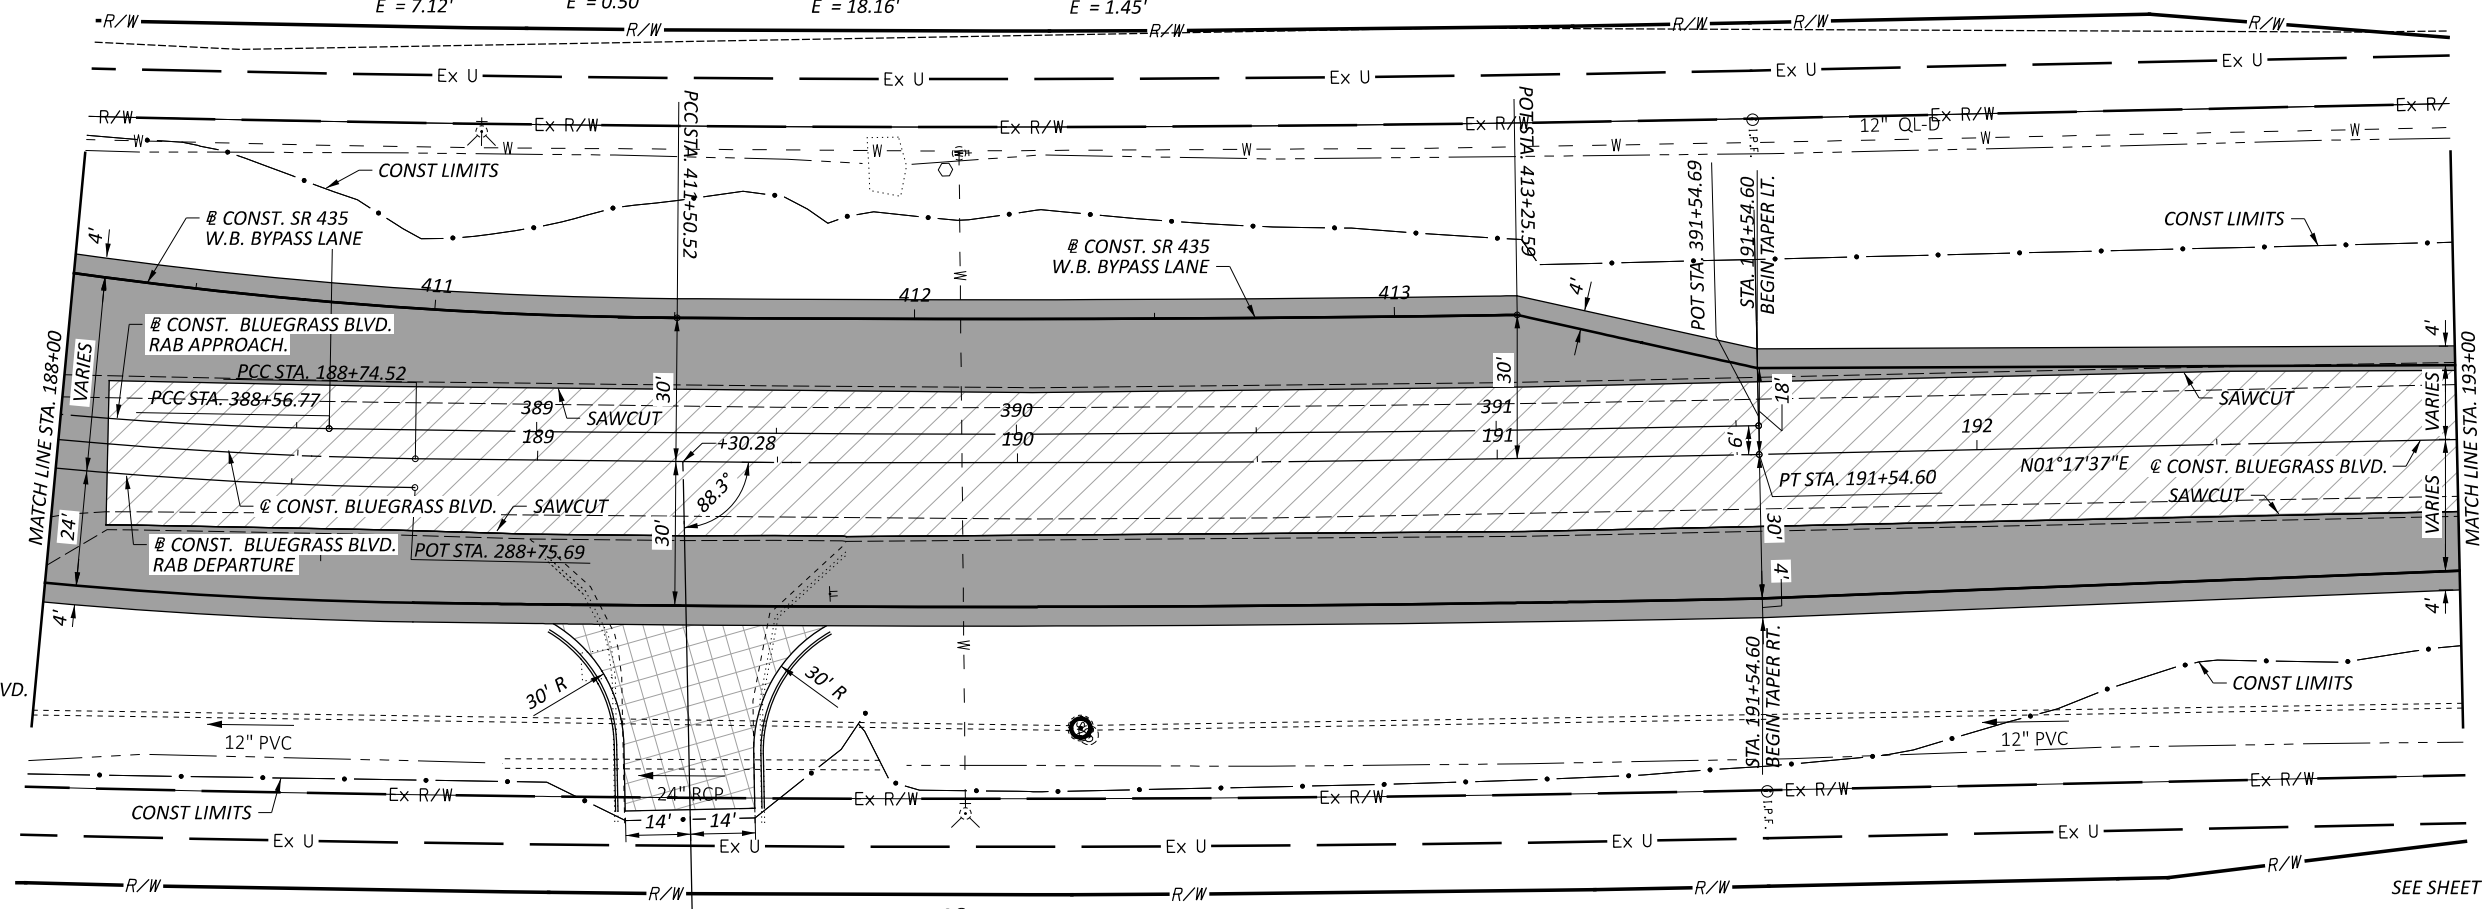

PLAN AND PROFILE
 BLUEGRASS BLVD. (RAB NORTH) STA 188+00 TO STA 193+00

SEE SHEET P.0 FOR LEGEND

DESIGN AGENCY



Palmer
 ENGINEERING
 8350 E. KEMPER RD.
 SUITE B
 CINCINNATI, OH 45249
 513-469-1600

DESIGNER
 DPF


REVIEWER
 DCJ MM-DD-YY

PROJECT ID
 117955

SHEET TOTAL
 P. 123 228

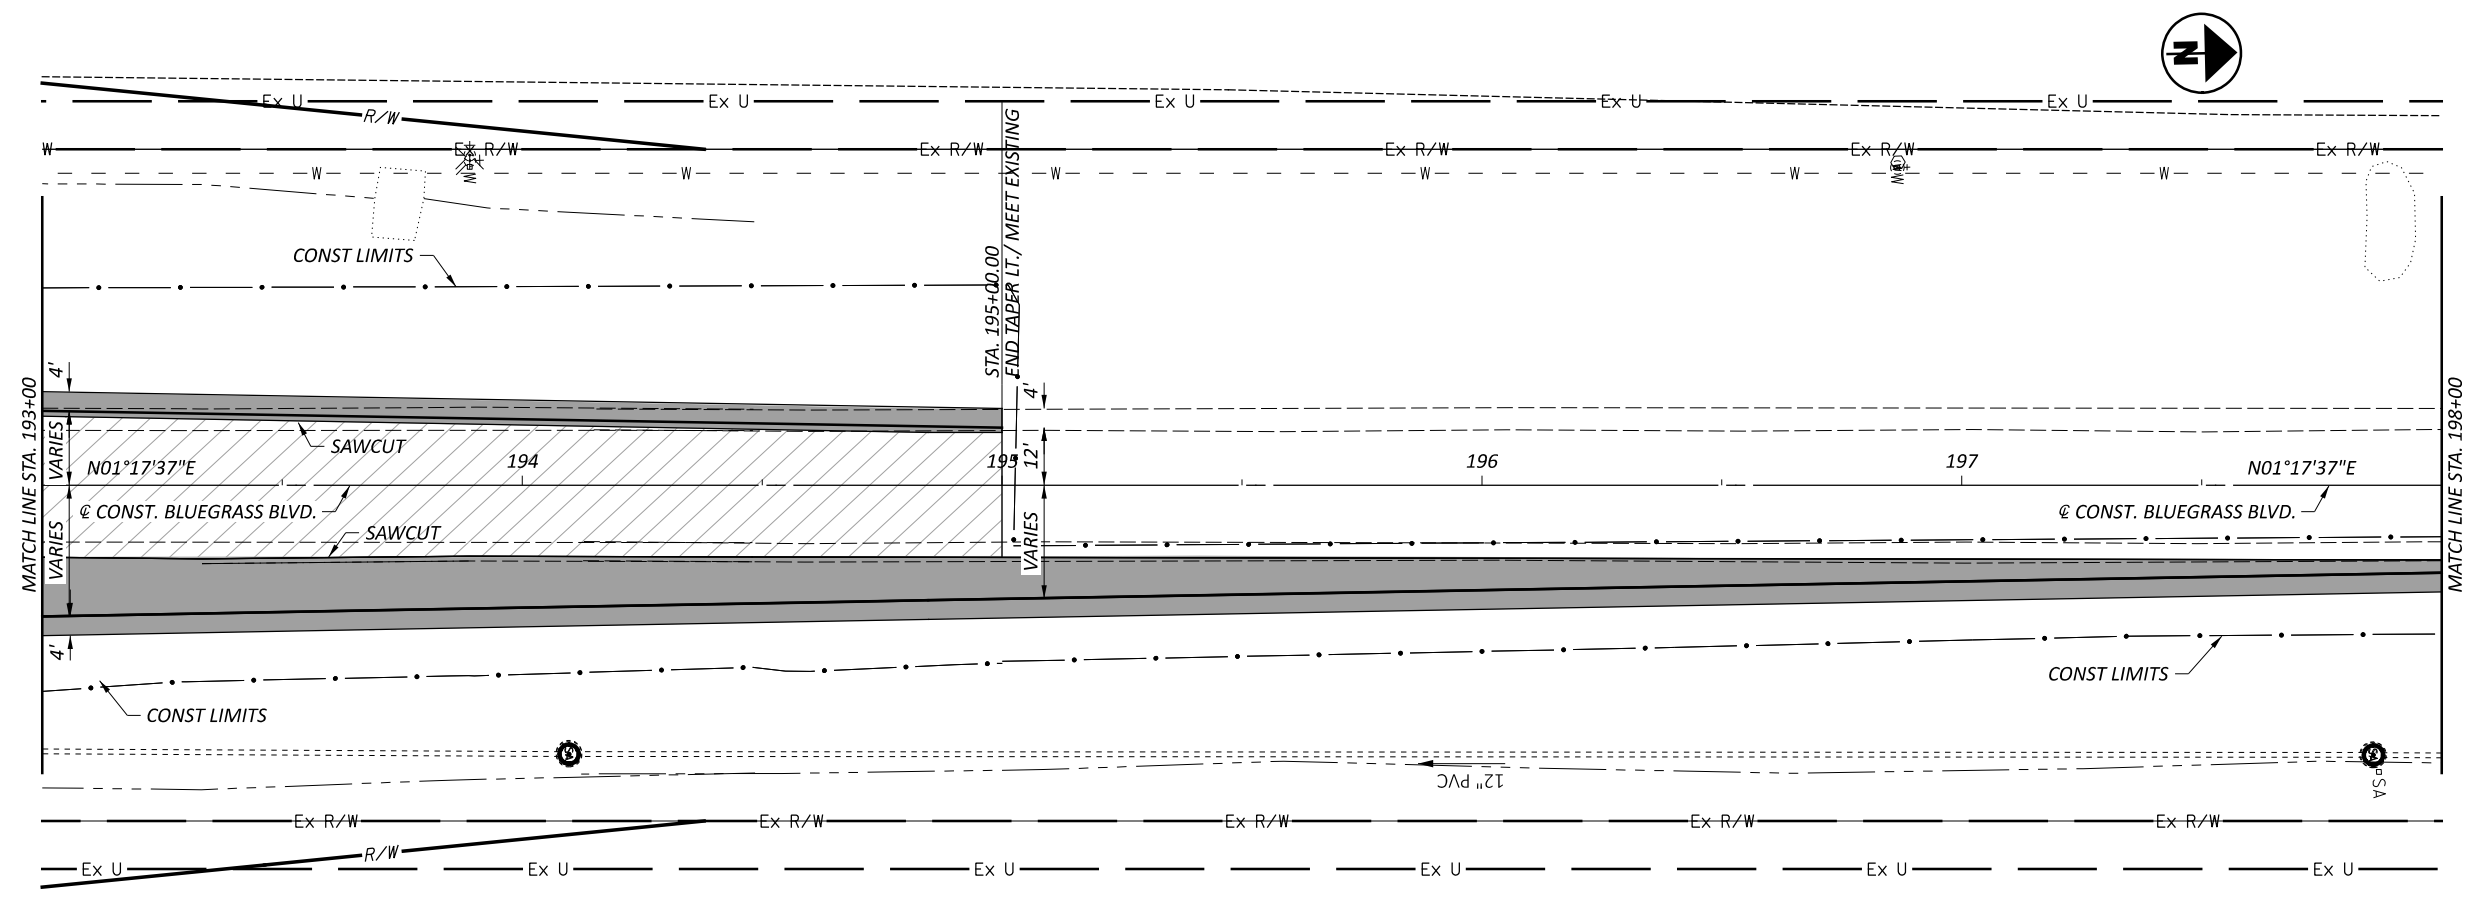
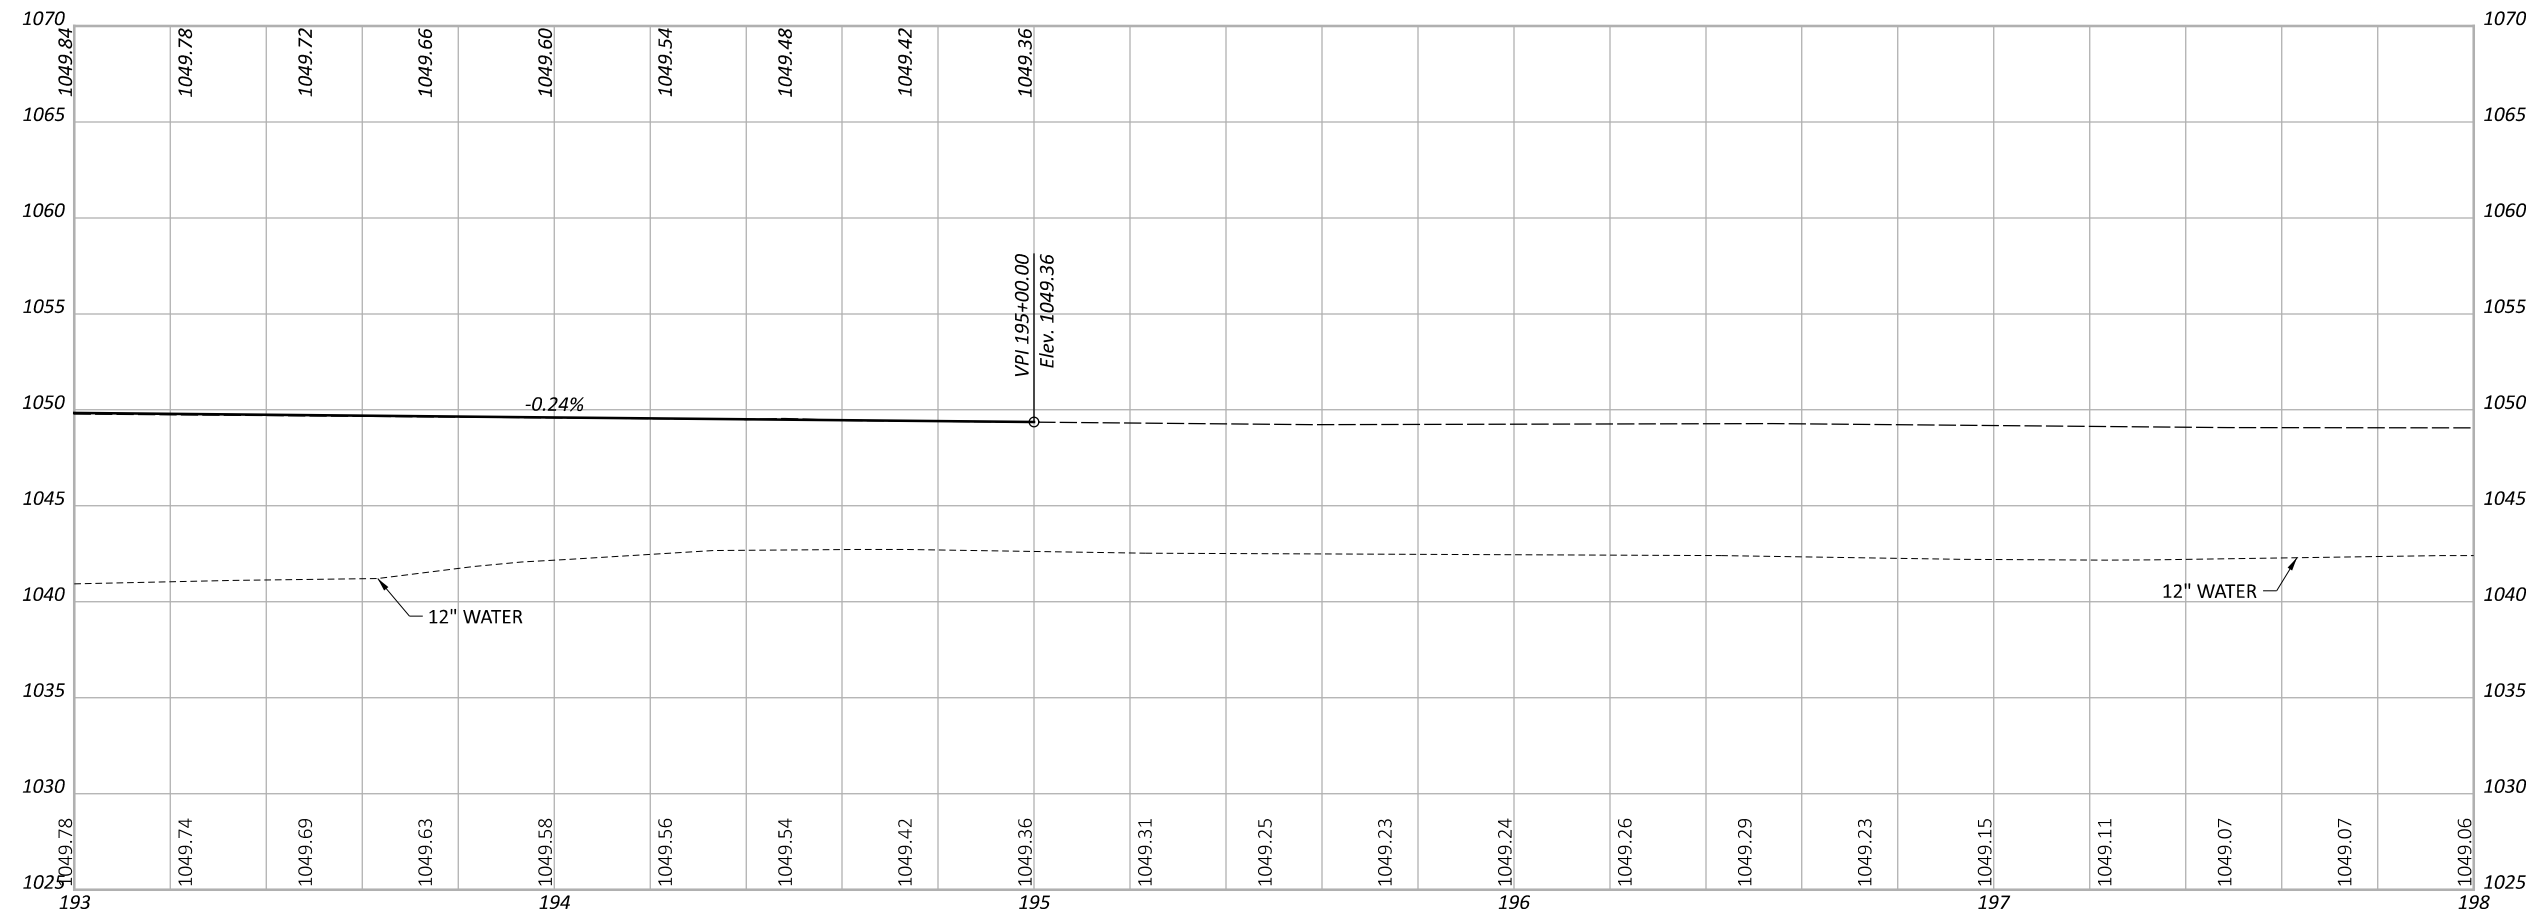


SEE SHEET P.0 FOR LEGEND

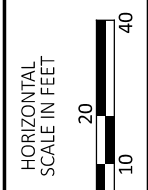


PLAN AND PROFILE
 BLUEGRASS BLVD. (RAB NORTH) STA 193+00 TO STA 198+00

DESIGN AGENCY	
 8350 E. KEMPER RD. SUITE B CINCINNATI, OH 45249 513-469-1600	
DESIGNER	
DPF	
REVIEWER	
DCJ MM-DD-YY	
PROJECT ID	
117955	
SHEET	TOTAL
P. 124	228

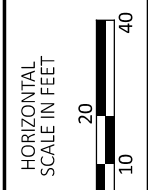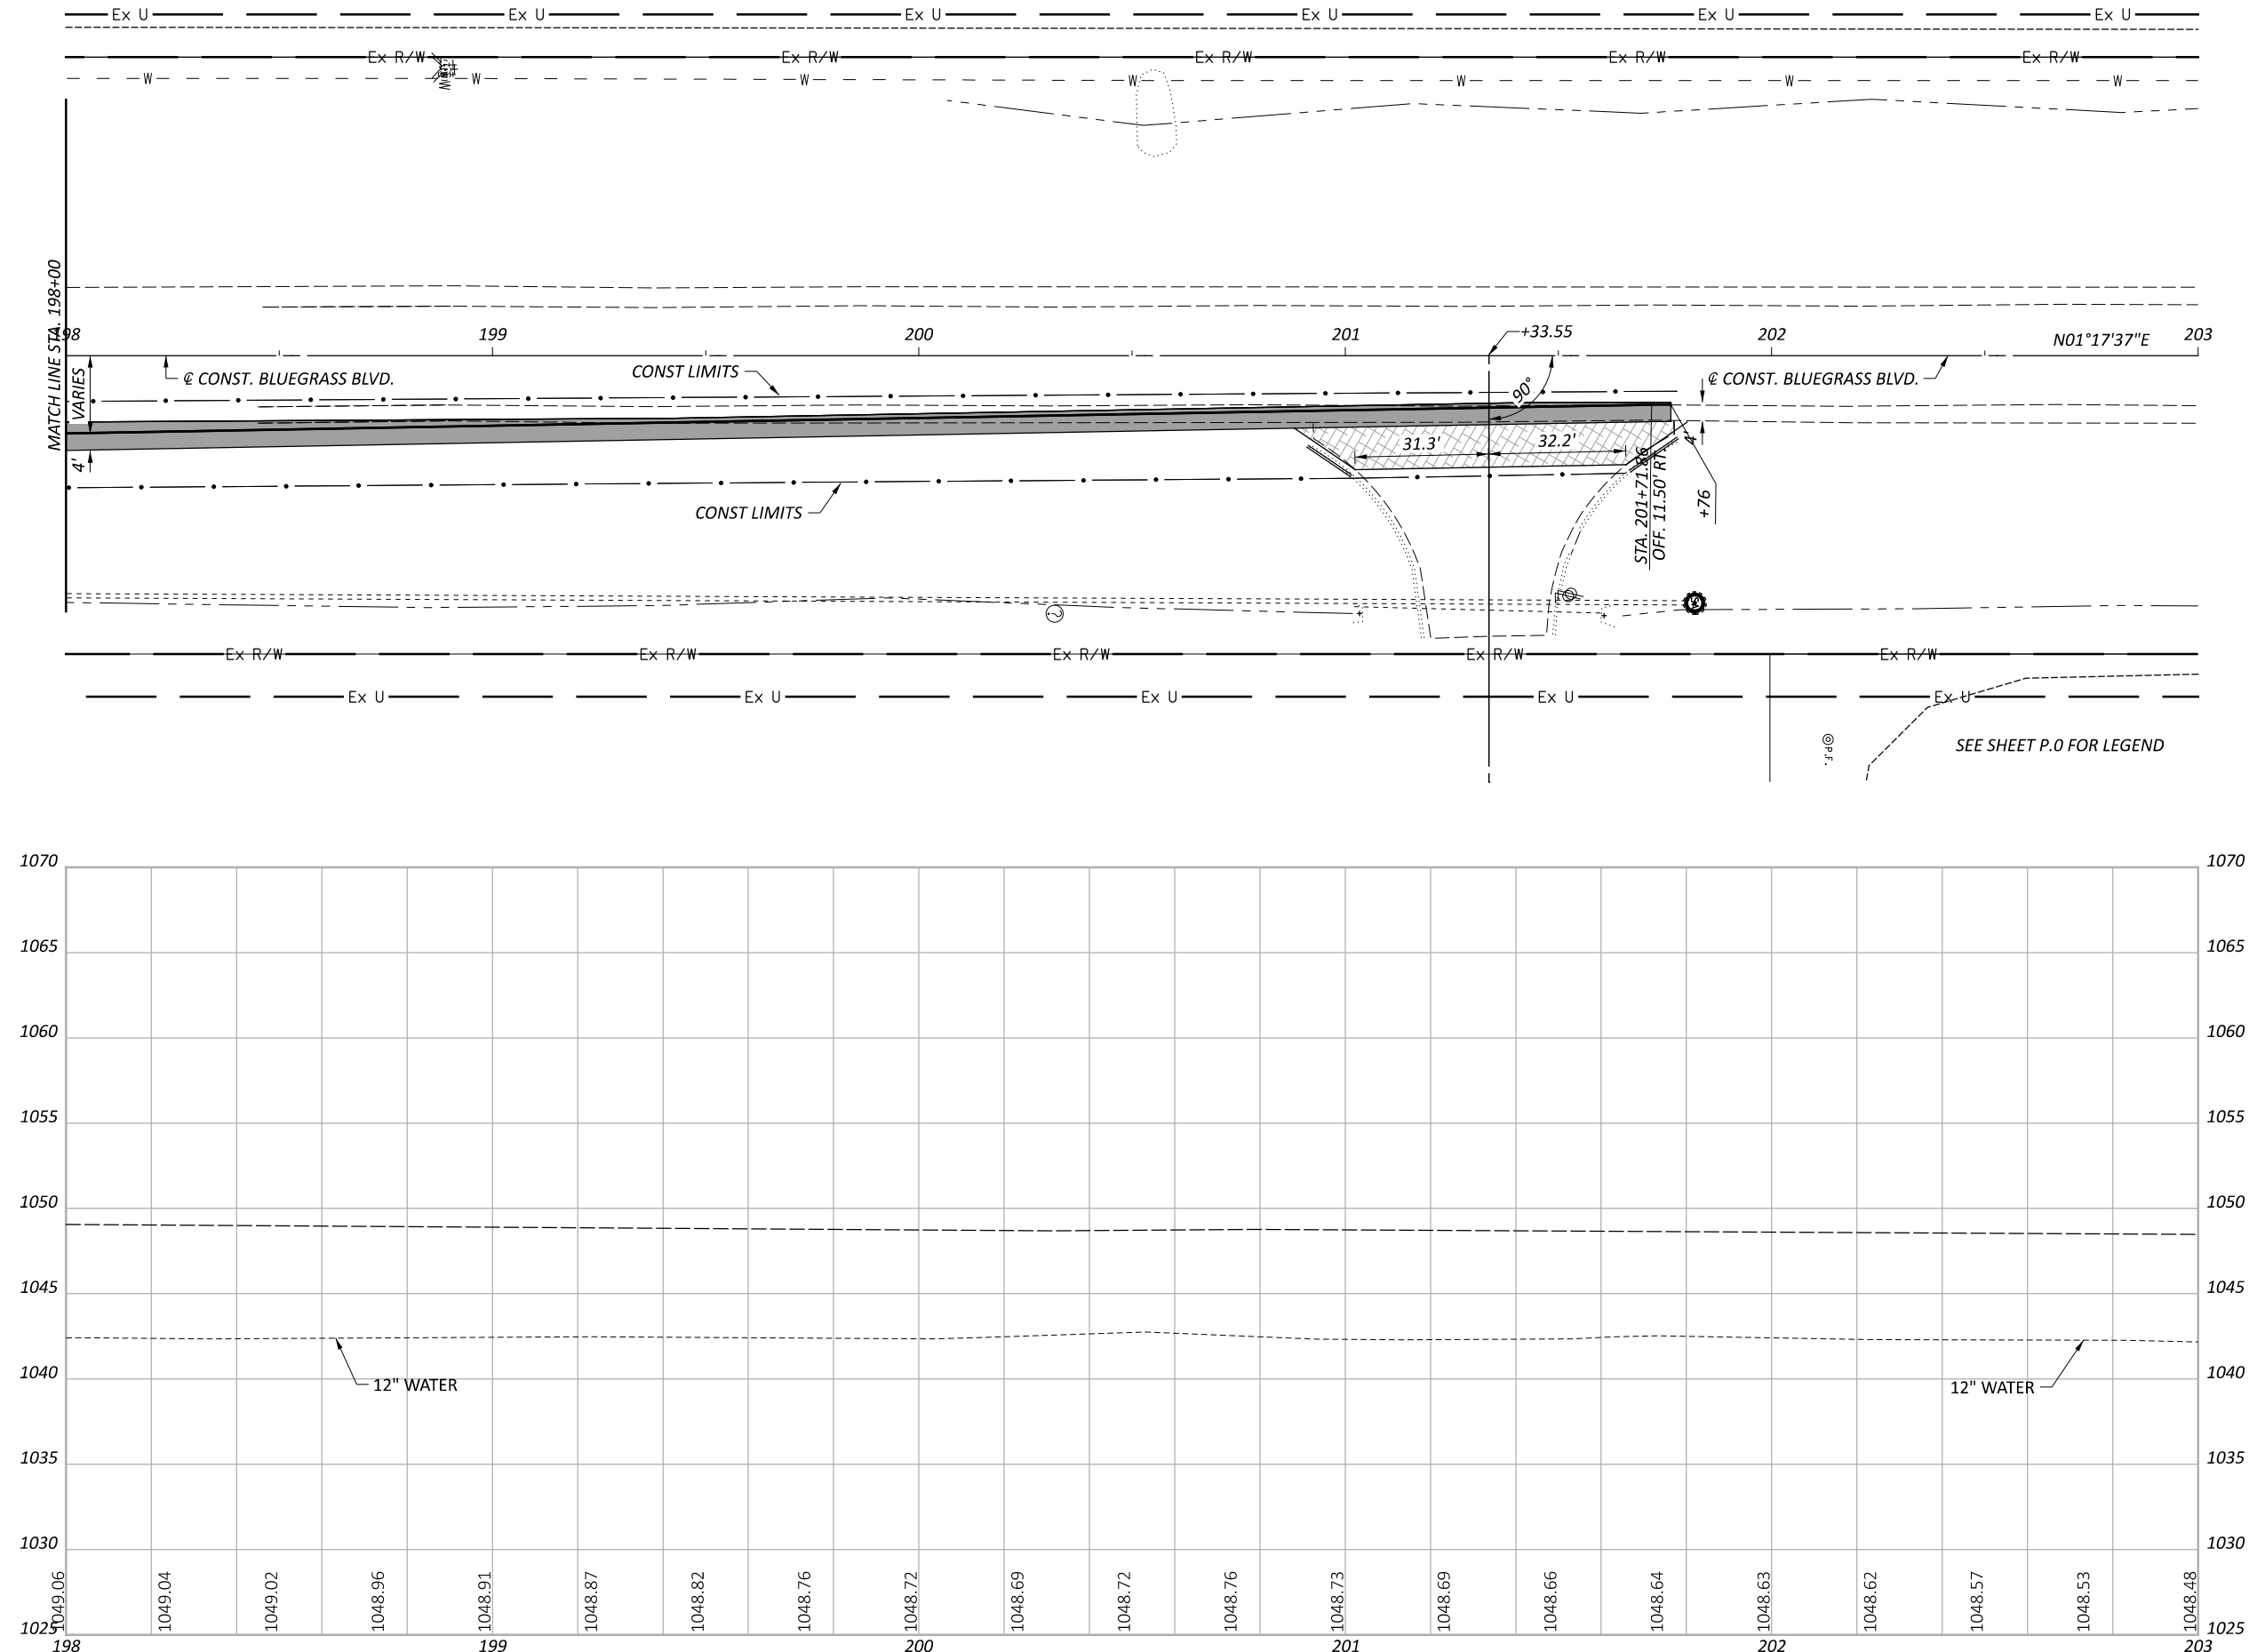

PLAN AND PROFILE
 BLUEGRASS BLVD. (RAB NORTH) STA 198+00 TO STA 203+00

DESIGN AGENCY	
 PALMER ENGINEERING 8350 E. KEMPER RD. SUITE B CINCINNATI, OH 45249 513-469-1600	
DESIGNER	
DPF	
REVIEWER	
DCJ MM-DD-YY	
PROJECT ID	
117955	
SHEET	TOTAL
P. 125	228

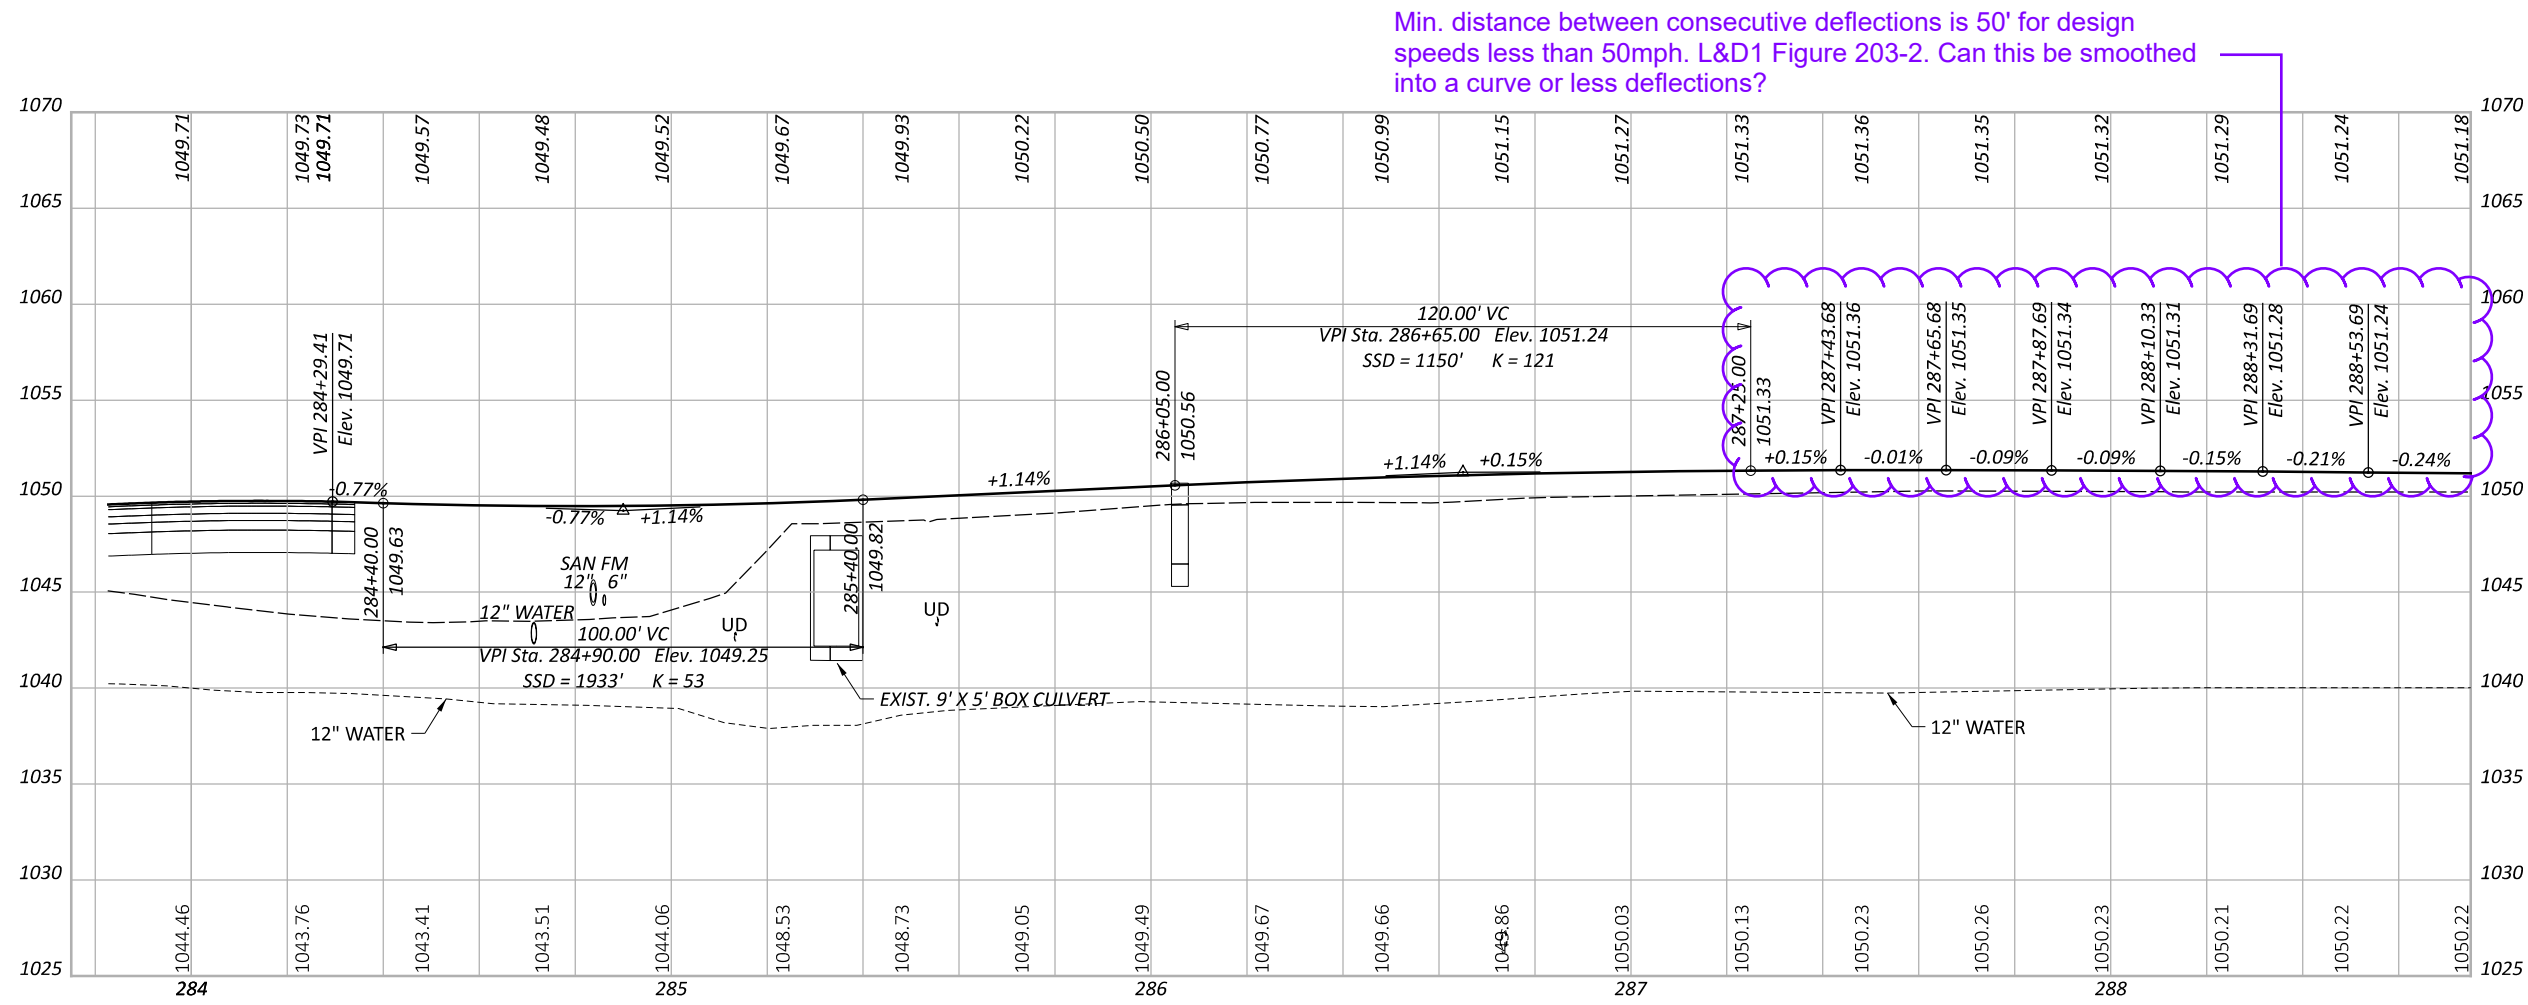

PROFILES
 BLUEGRASS BLVD - ROUNDABOUT DEPARTURE

DESIGN AGENCY




DESIGNER
 DPF

REVIEWER
 DCJ MM-DD-YY

PROJECT ID
 117955

SHEET TOTAL
 P. 127 228

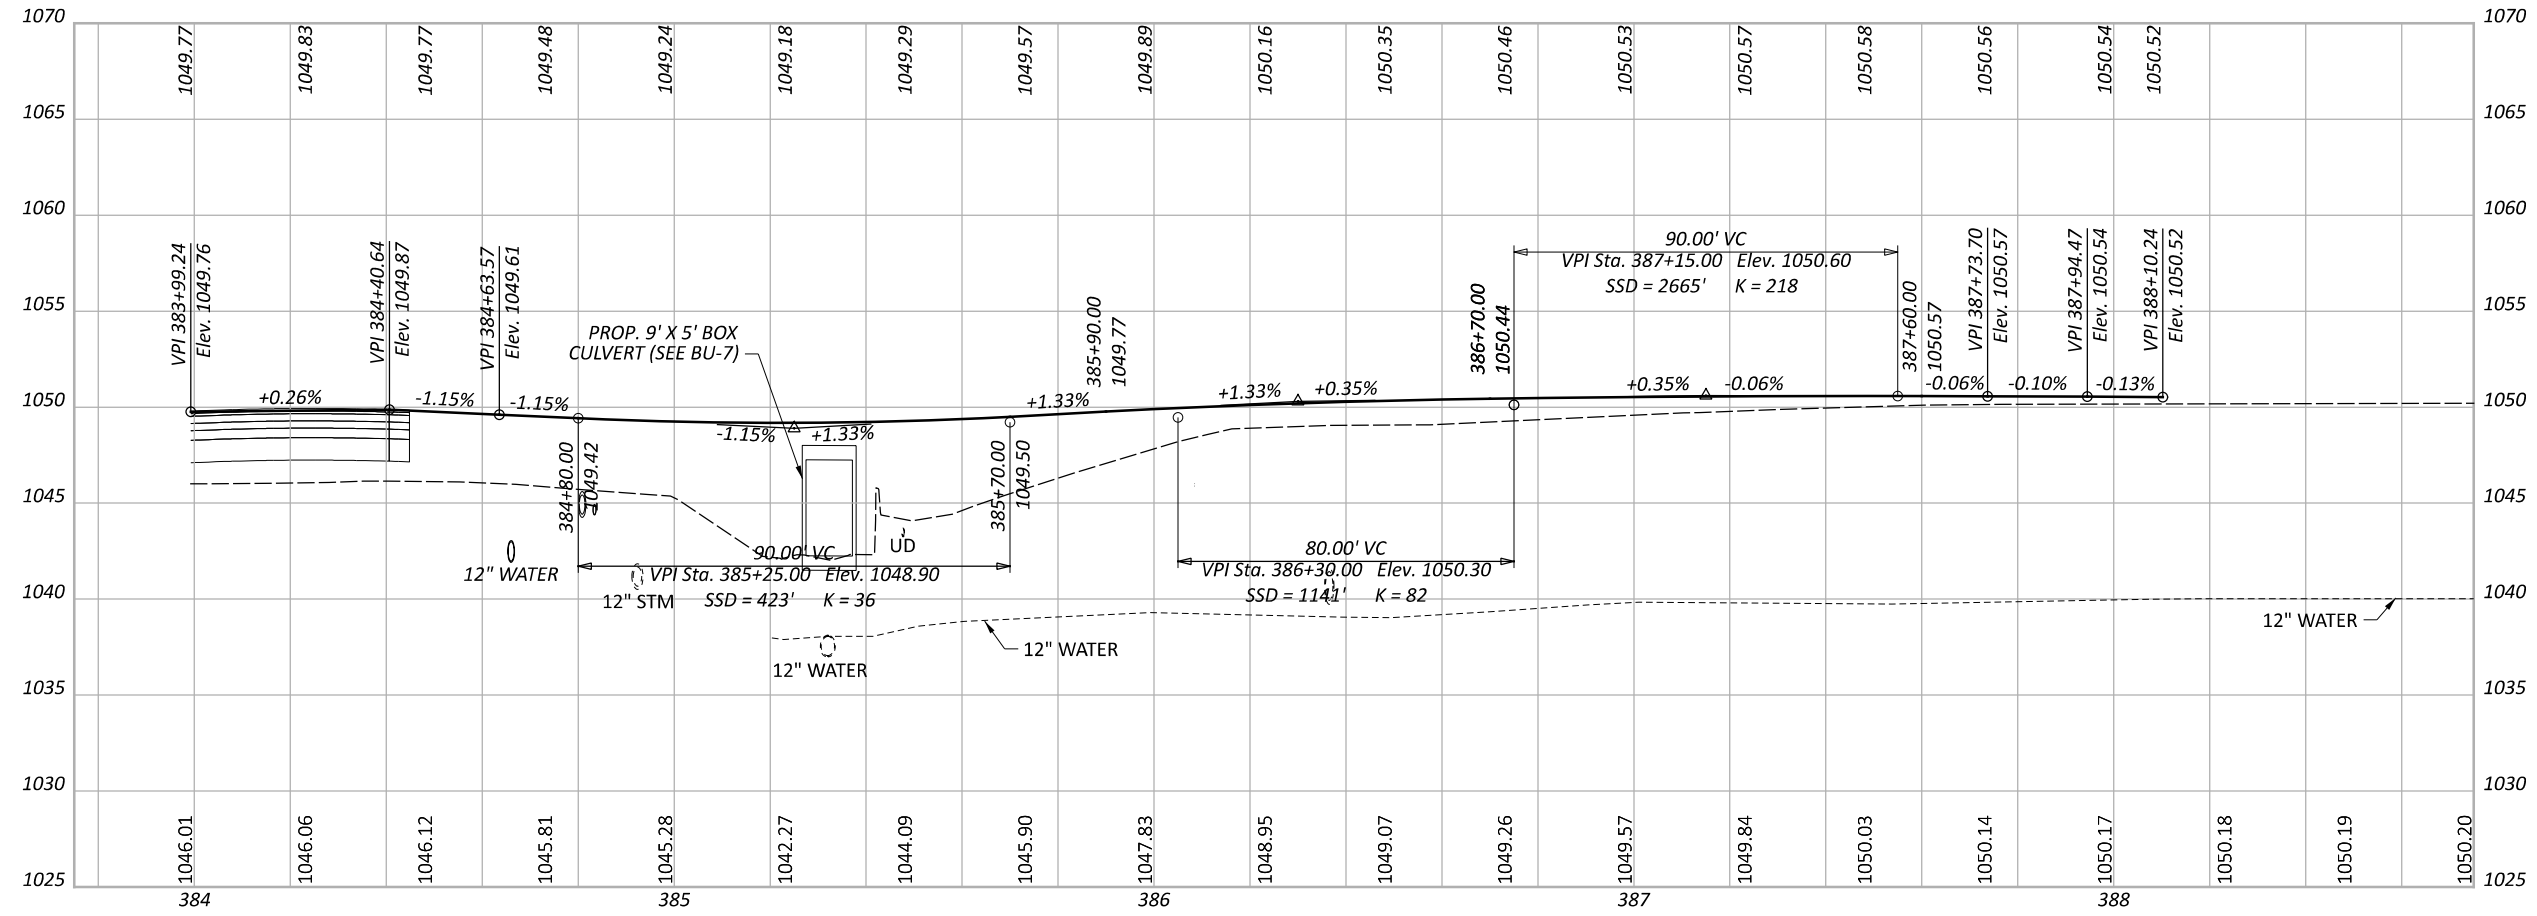

PROFILES
 BLUEGRASS BLVD - ROUNDABOUT APPROACH

DESIGN AGENCY






DESIGNER
 DPF

REVIEWER
 DCJ MM-DD-YY



PROJECT ID
 117955

SHEET TOTAL
 P. 126 | 228

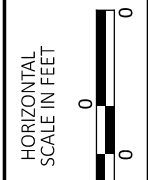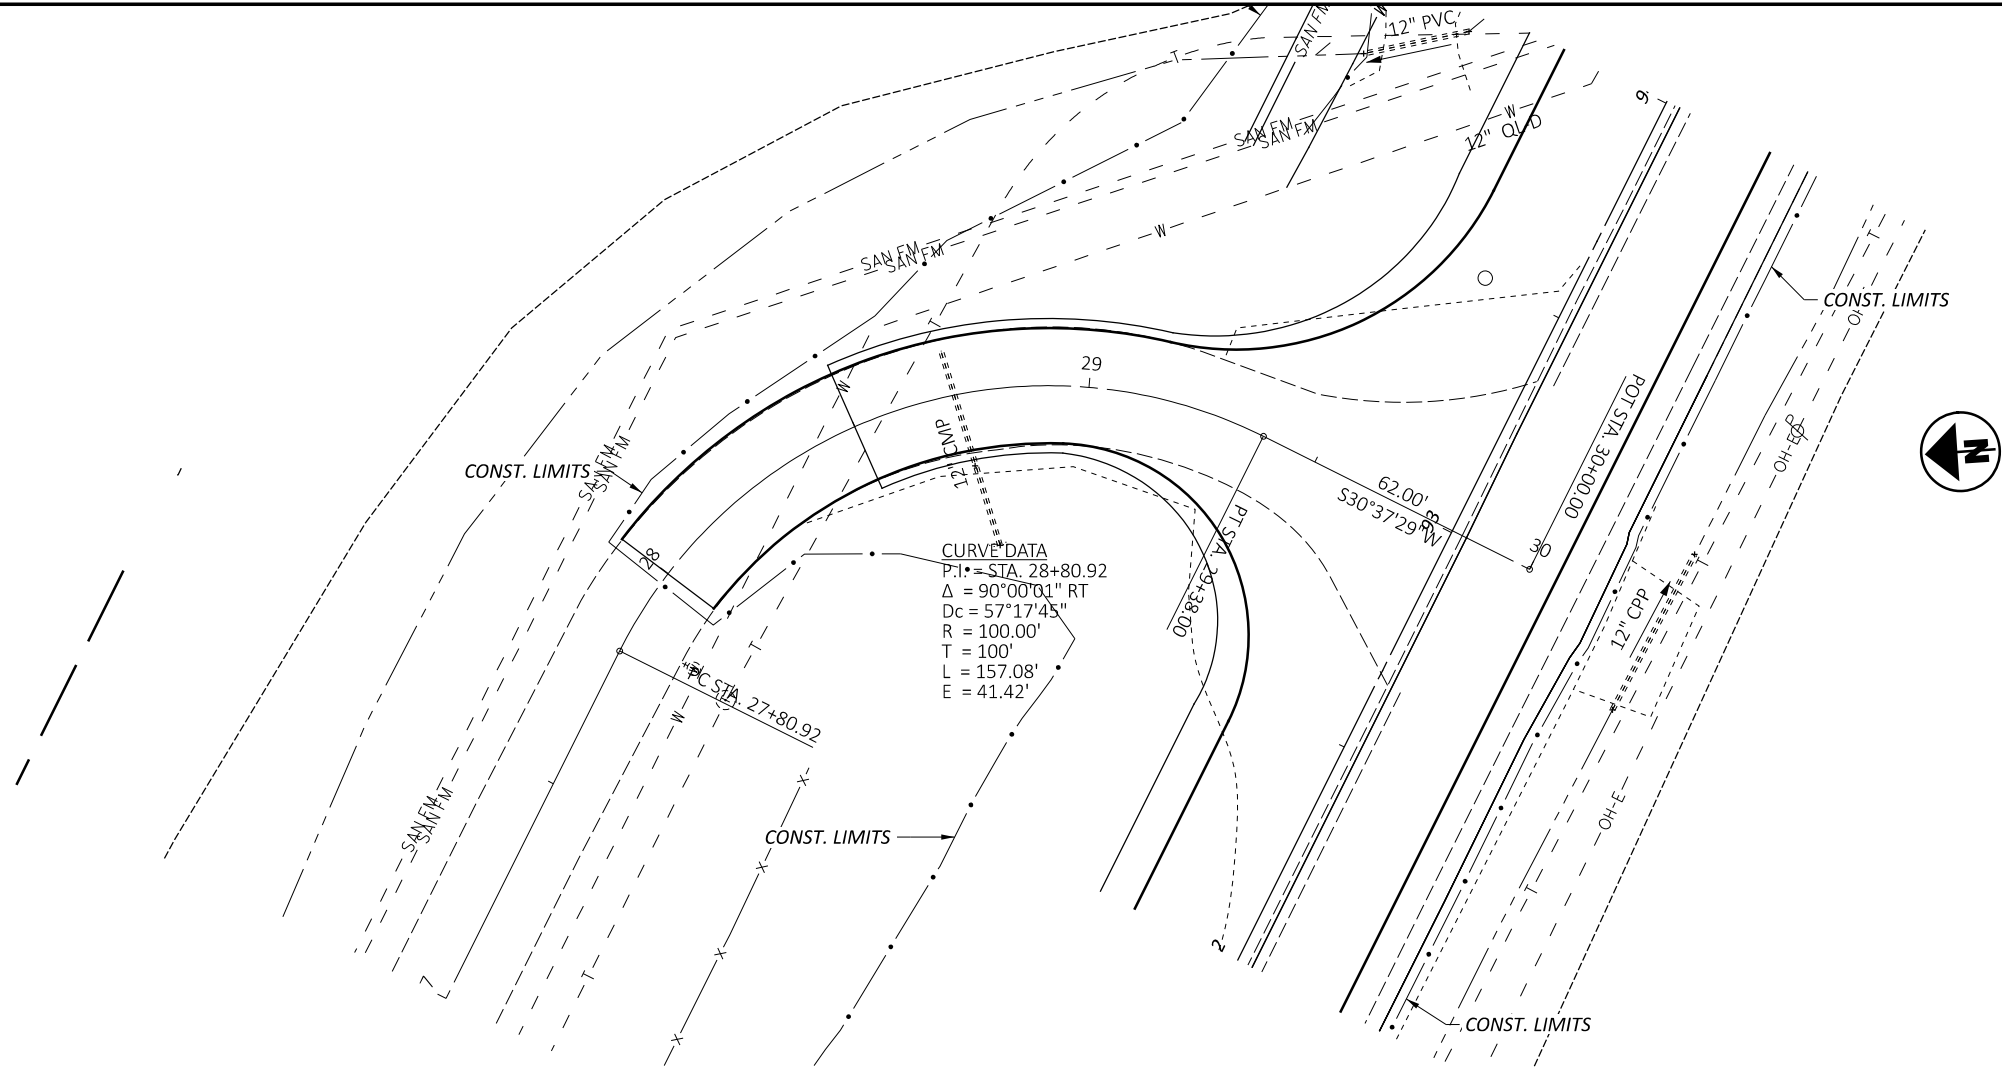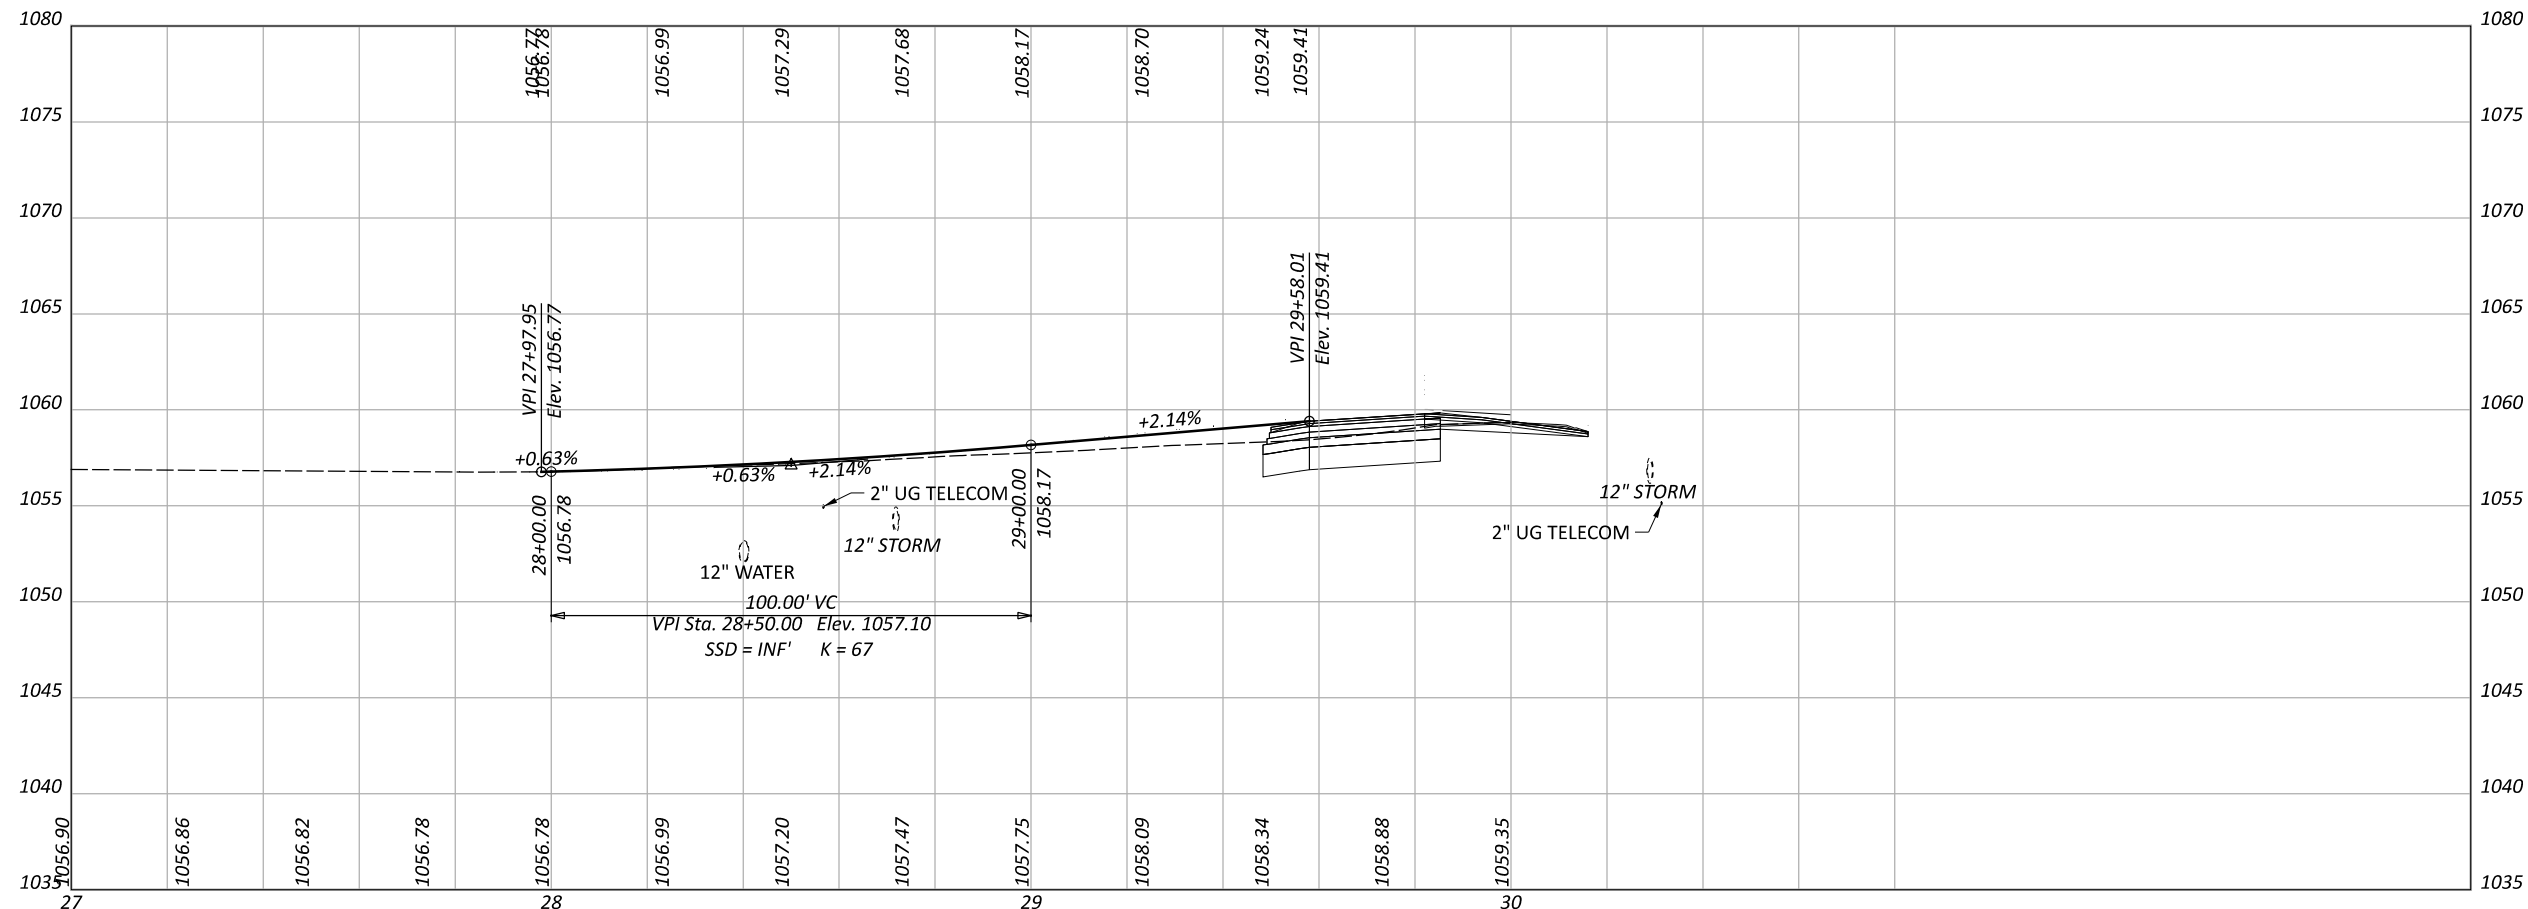



PLAN AND PROFILE
 DAVIDSON - SOLLERS ROAD

DESIGN AGENCY	
 PALMER ENGINEERING 8350 E. KEMPER RD. SUITE B CINCINNATI, OH 45249 513-469-1600	
DESIGNER	
DPF	
REVIEWER	
DCJ MM-DD-YY	
PROJECT ID	
117955	
SHEET	TOTAL
P. 128	228

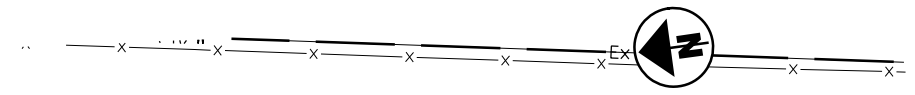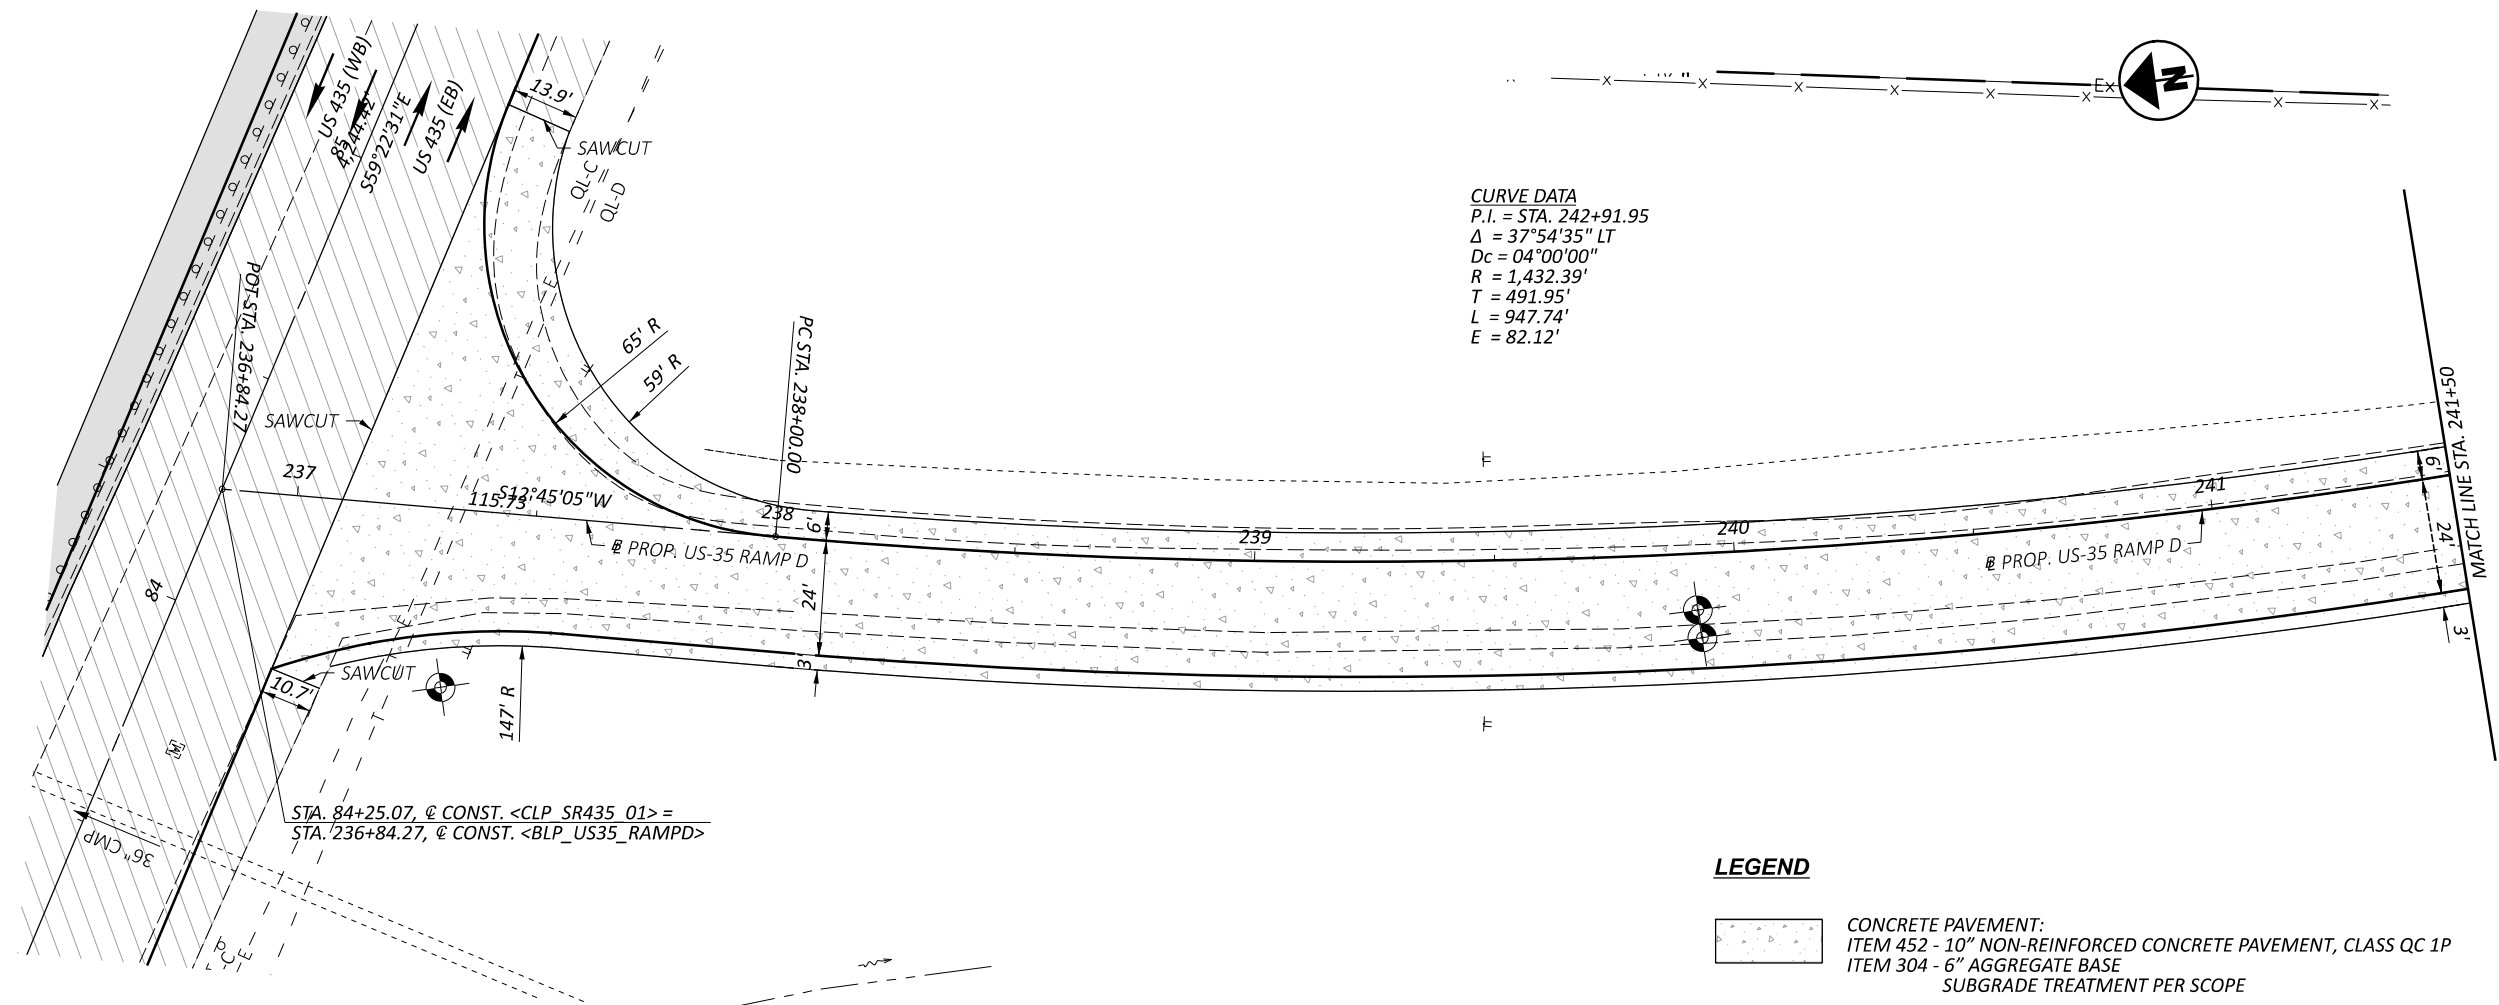

LEGEND

- CONCRETE PAVEMENT:
 ITEM 452 - 10" NON-REINFORCED CONCRETE PAVEMENT, CLASS QC 1P
- ITEM 304 - 6" AGGREGATE BASE
- SUBGRADE TREATMENT PER SCOPE

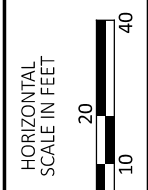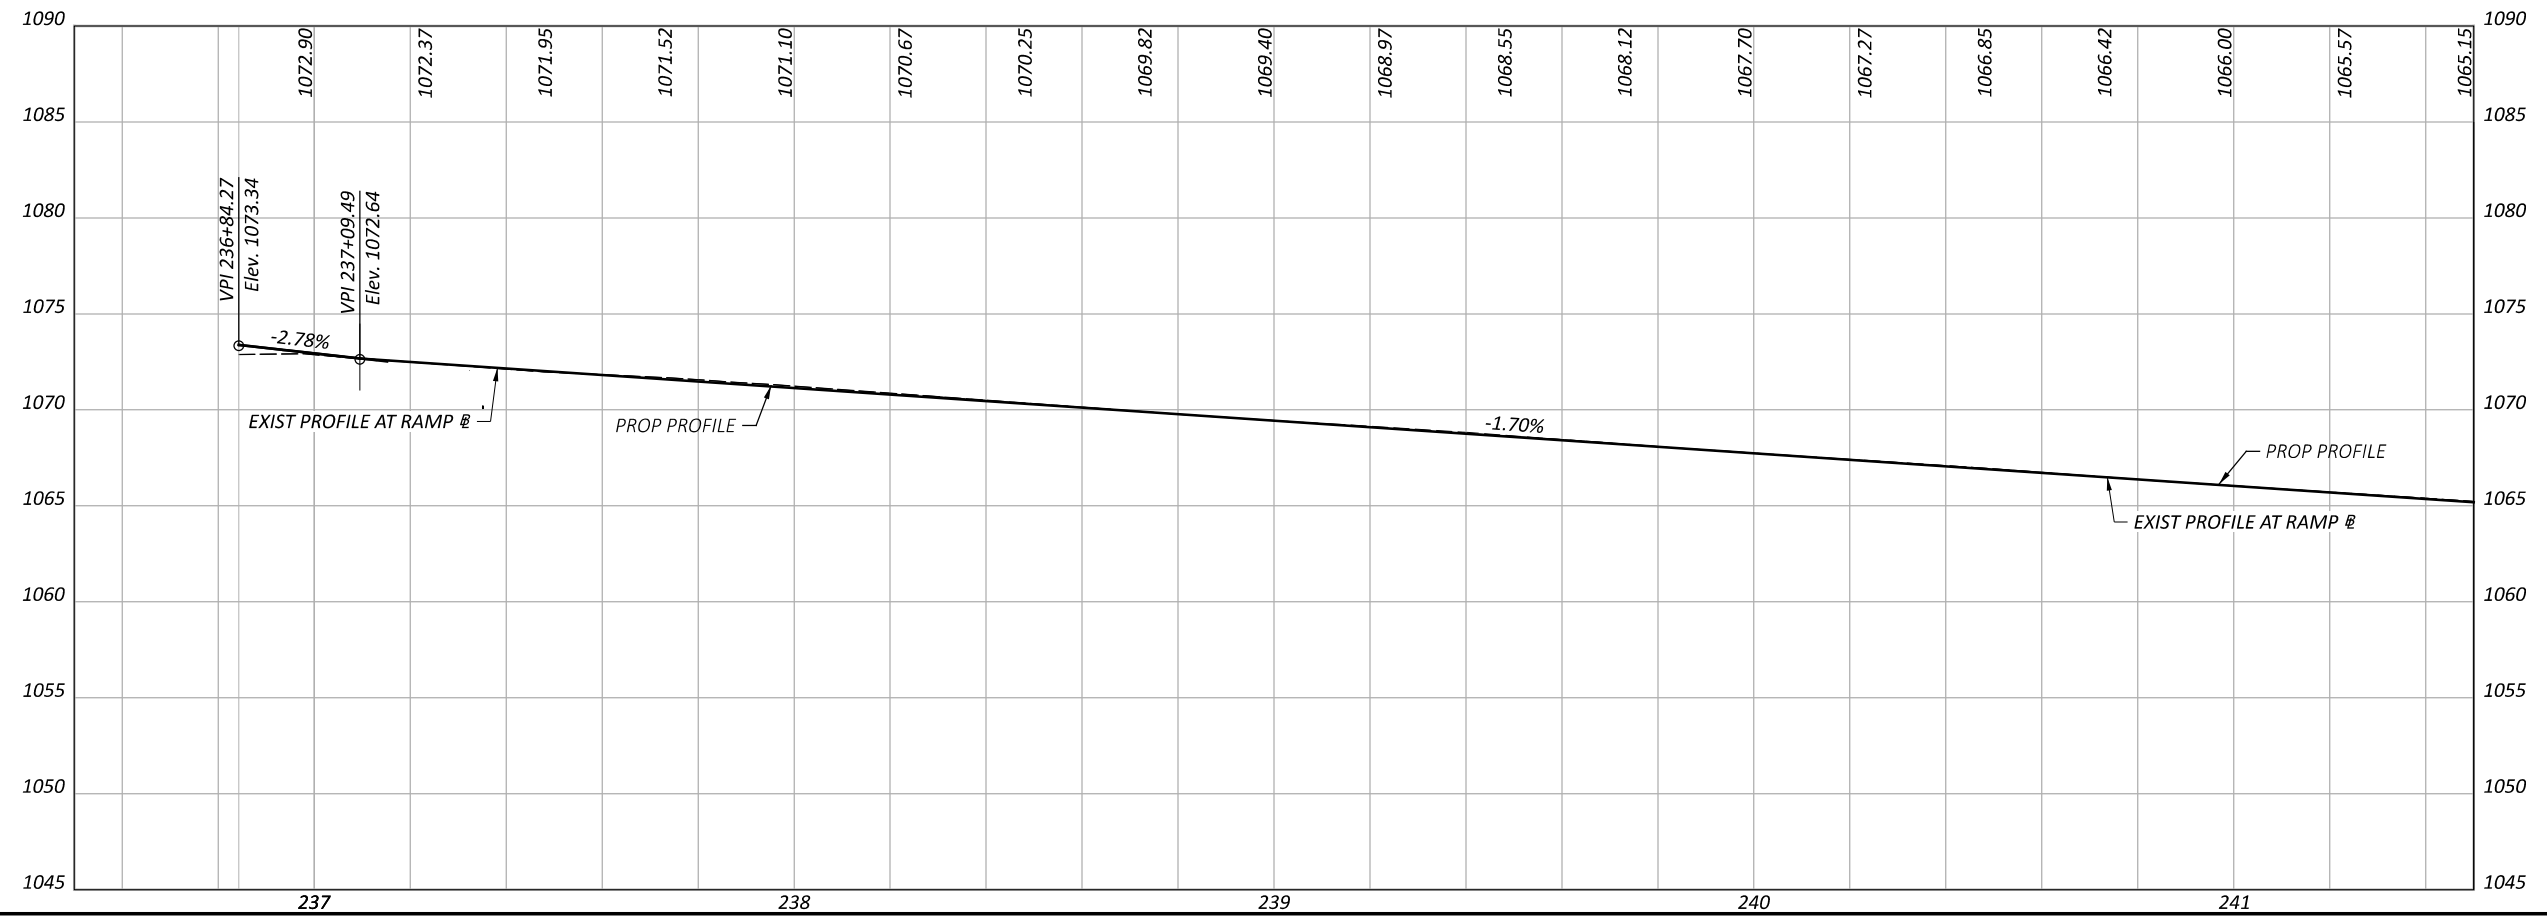


PLAN AND PROFILE
US35 RAMP D STA 236+84.27 TO STA 241+50

DESIGN AGENCY	
Palmer ENGINEERING	
8350 E. KEMPER RD. SUITE B CINCINNATI, OH 45249 513-469-1600	
DESIGNER	
DPF	
REVIEWER	
DCJ MM-DD-YY	
PROJECT ID	
117955	
SHEET	TOTAL
P. 129	228

LEGEND

-  CONCRETE PAVEMENT:
- ITEM 452 - 10" NON-REINFORCED CONCRETE PAVEMENT, CLASS QC 1P
- ITEM 304 - 6" AGGREGATE BASE
- SUBGRADE TREATMENT PER SCOPE

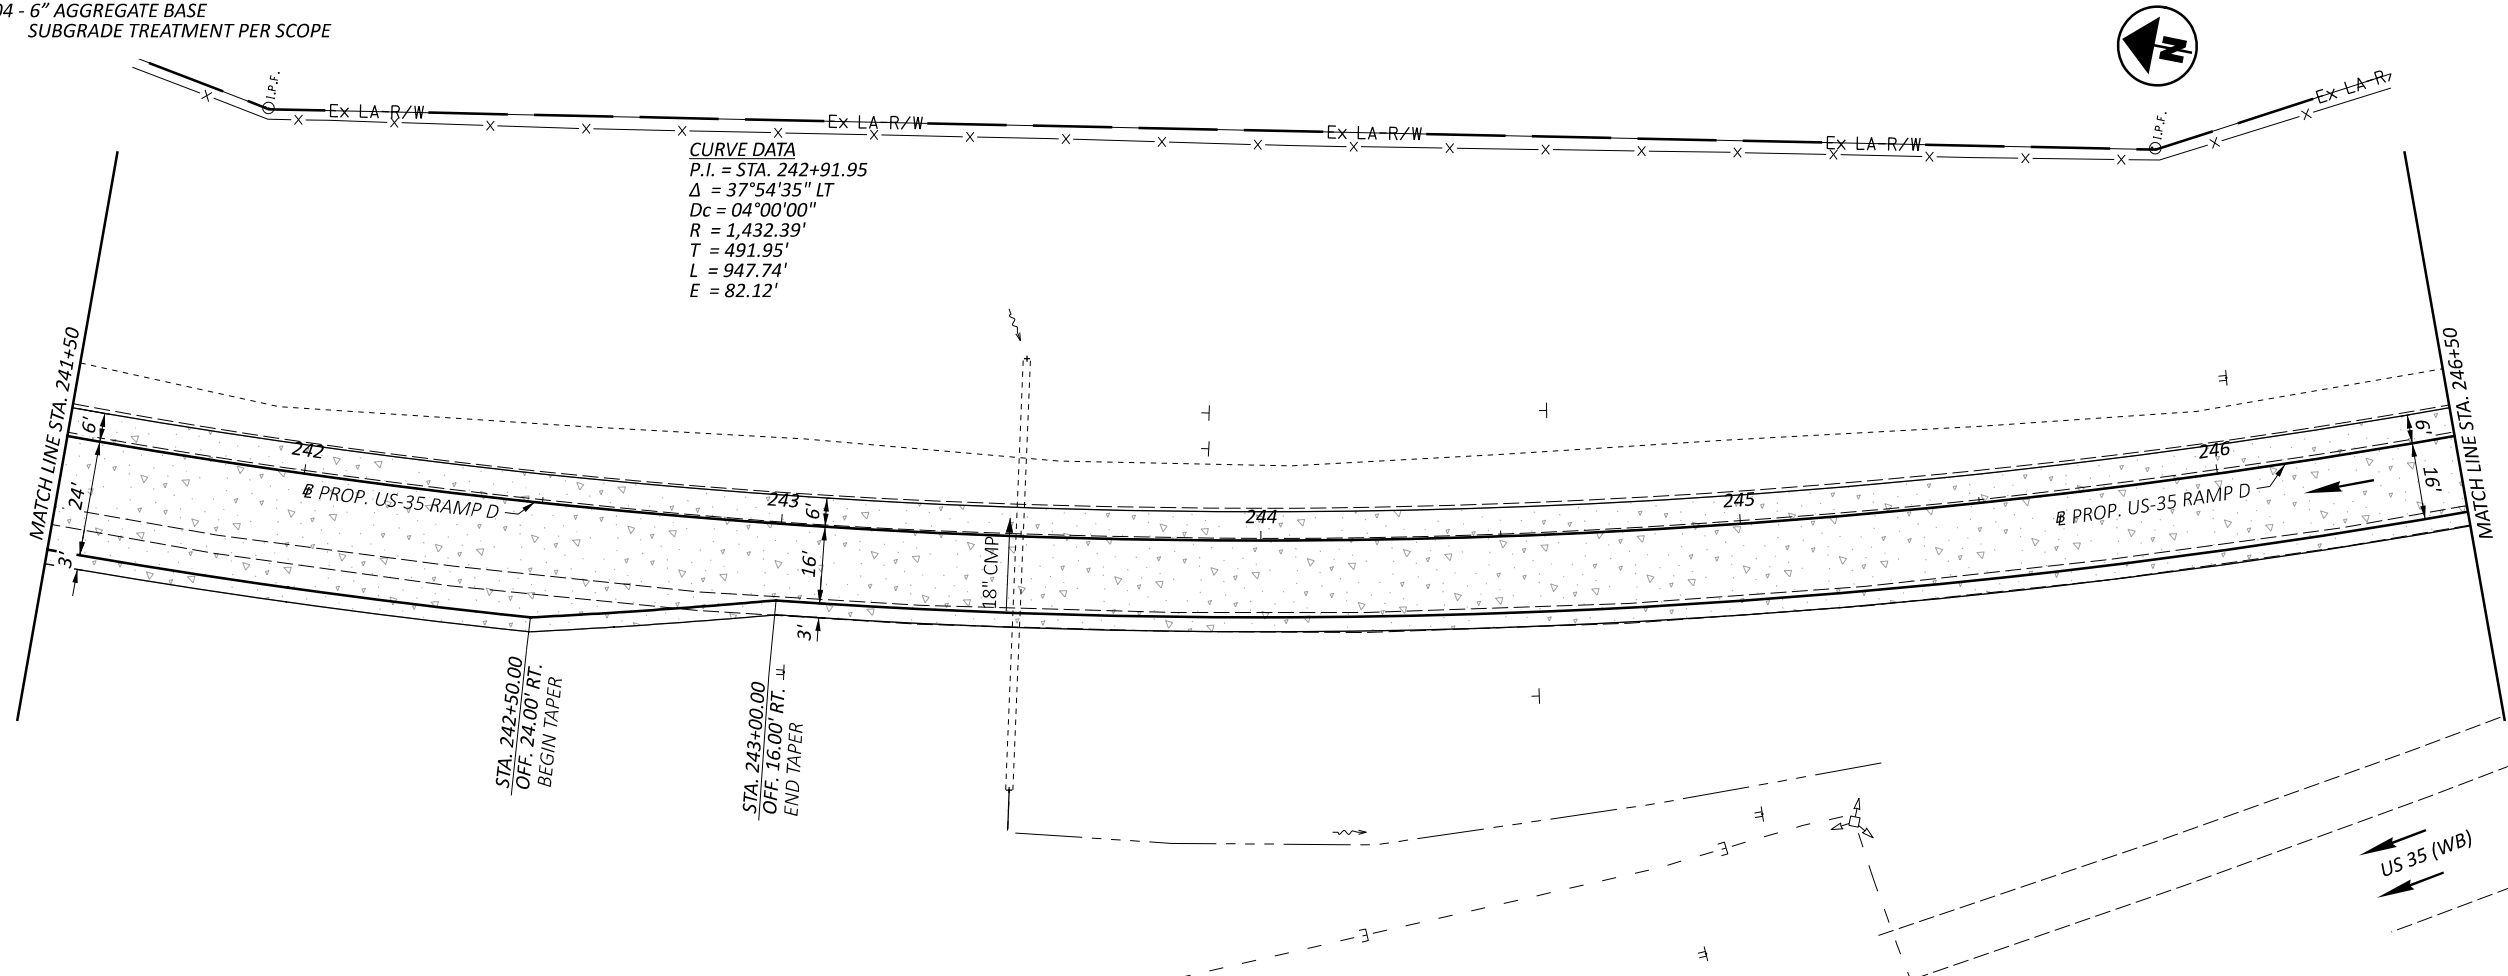


CURVE DATA
 P.I. = STA. 242+91.95
 $\Delta = 37^{\circ}54'35''$ LT
 $Dc = 04^{\circ}00'00''$
 $R = 1,432.39'$
 $T = 491.95'$
 $L = 947.74'$
 $E = 82.12'$


STA. 242+50.00
 OFF. 24.00' RT.
 BEGIN TAPER

STA. 243+00.00
 OFF. 16.00' RT.
 END TAPER

US 35 (WB)

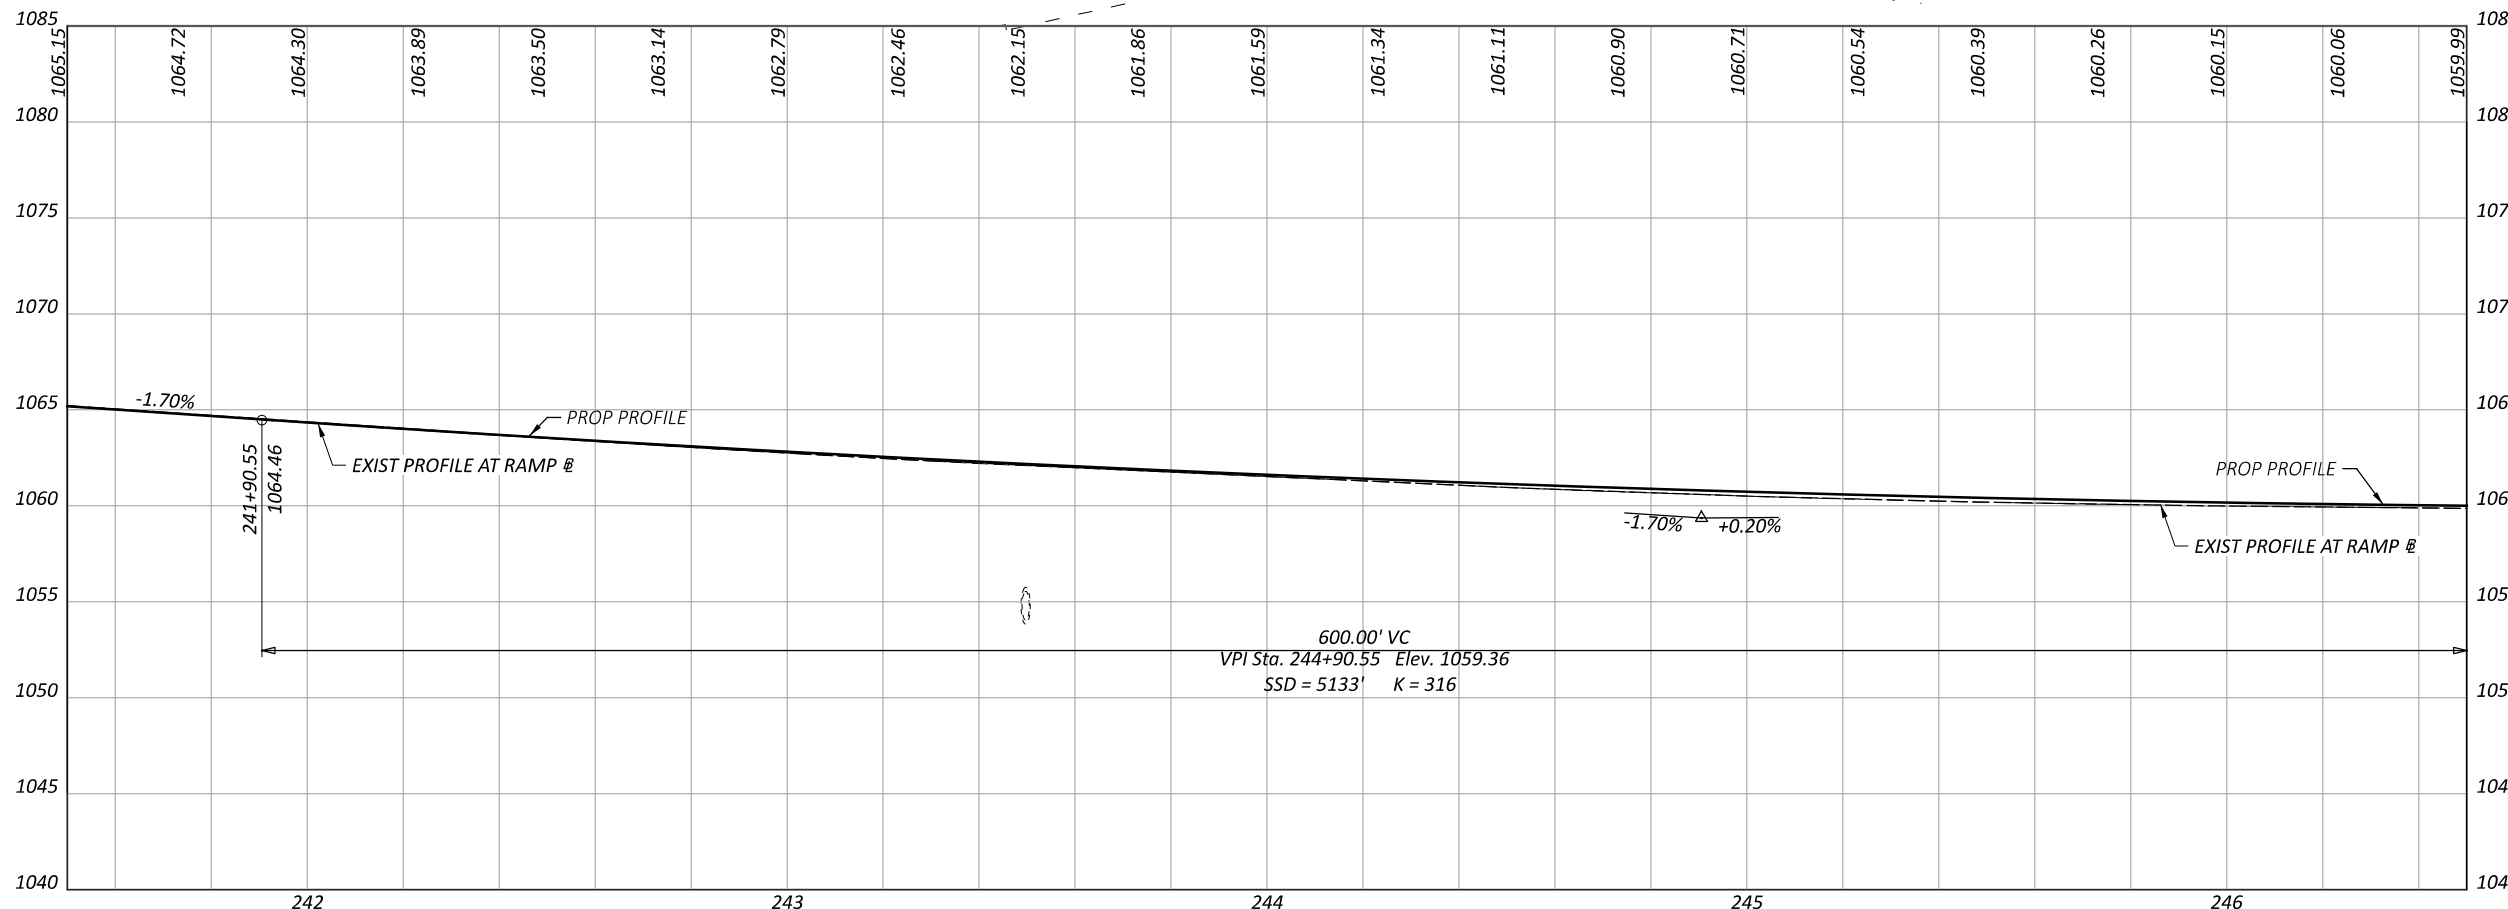

600.00' VC
 VPI Sta. 244+90.55 Elev. 1059.36
 SSD = 5133' K = 316

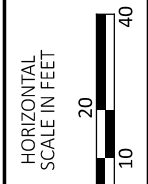

PLAN AND PROFILE
US35 RAMP D STA 241+50 TO STA 246+50

DESIGN AGENCY
Palmer
 ENGINEERING
 8350 E. KEMPER RD.
 SUITE B
 CINCINNATI, OH 45249
 513-469-1600




DESIGNER	DPF
REVIEWER	DCJ MM-DD-YY
PROJECT ID	117955
SHEET	TOTAL
P. 130	228

FAY-435-1.52

MODEL: BLP_US35_RAMPD - US35 Ramp D Plan 2 [Sheet] PAPER SIZE: 17x11 (in.) DATE: 3/25/2024 TIME: 3:40:41 PM USER: dan-f
 pw:\pewinp04.pewin.private\palmer.net.com\Palmer_Engineering\Documents\Ohio\000TV06\FAY\117955\100-Engineering\Roadway\Sheets\BU-5\117955_GP105.dgn

LEGEND

-  CONCRETE PAVEMENT:
- ITEM 452 - 10" NON-REINFORCED CONCRETE PAVEMENT, CLASS QC 1P
- ITEM 304 - 6" AGGREGATE BASE
- SUBGRADE TREATMENT PER SCOPE

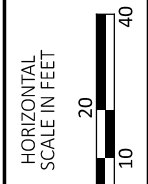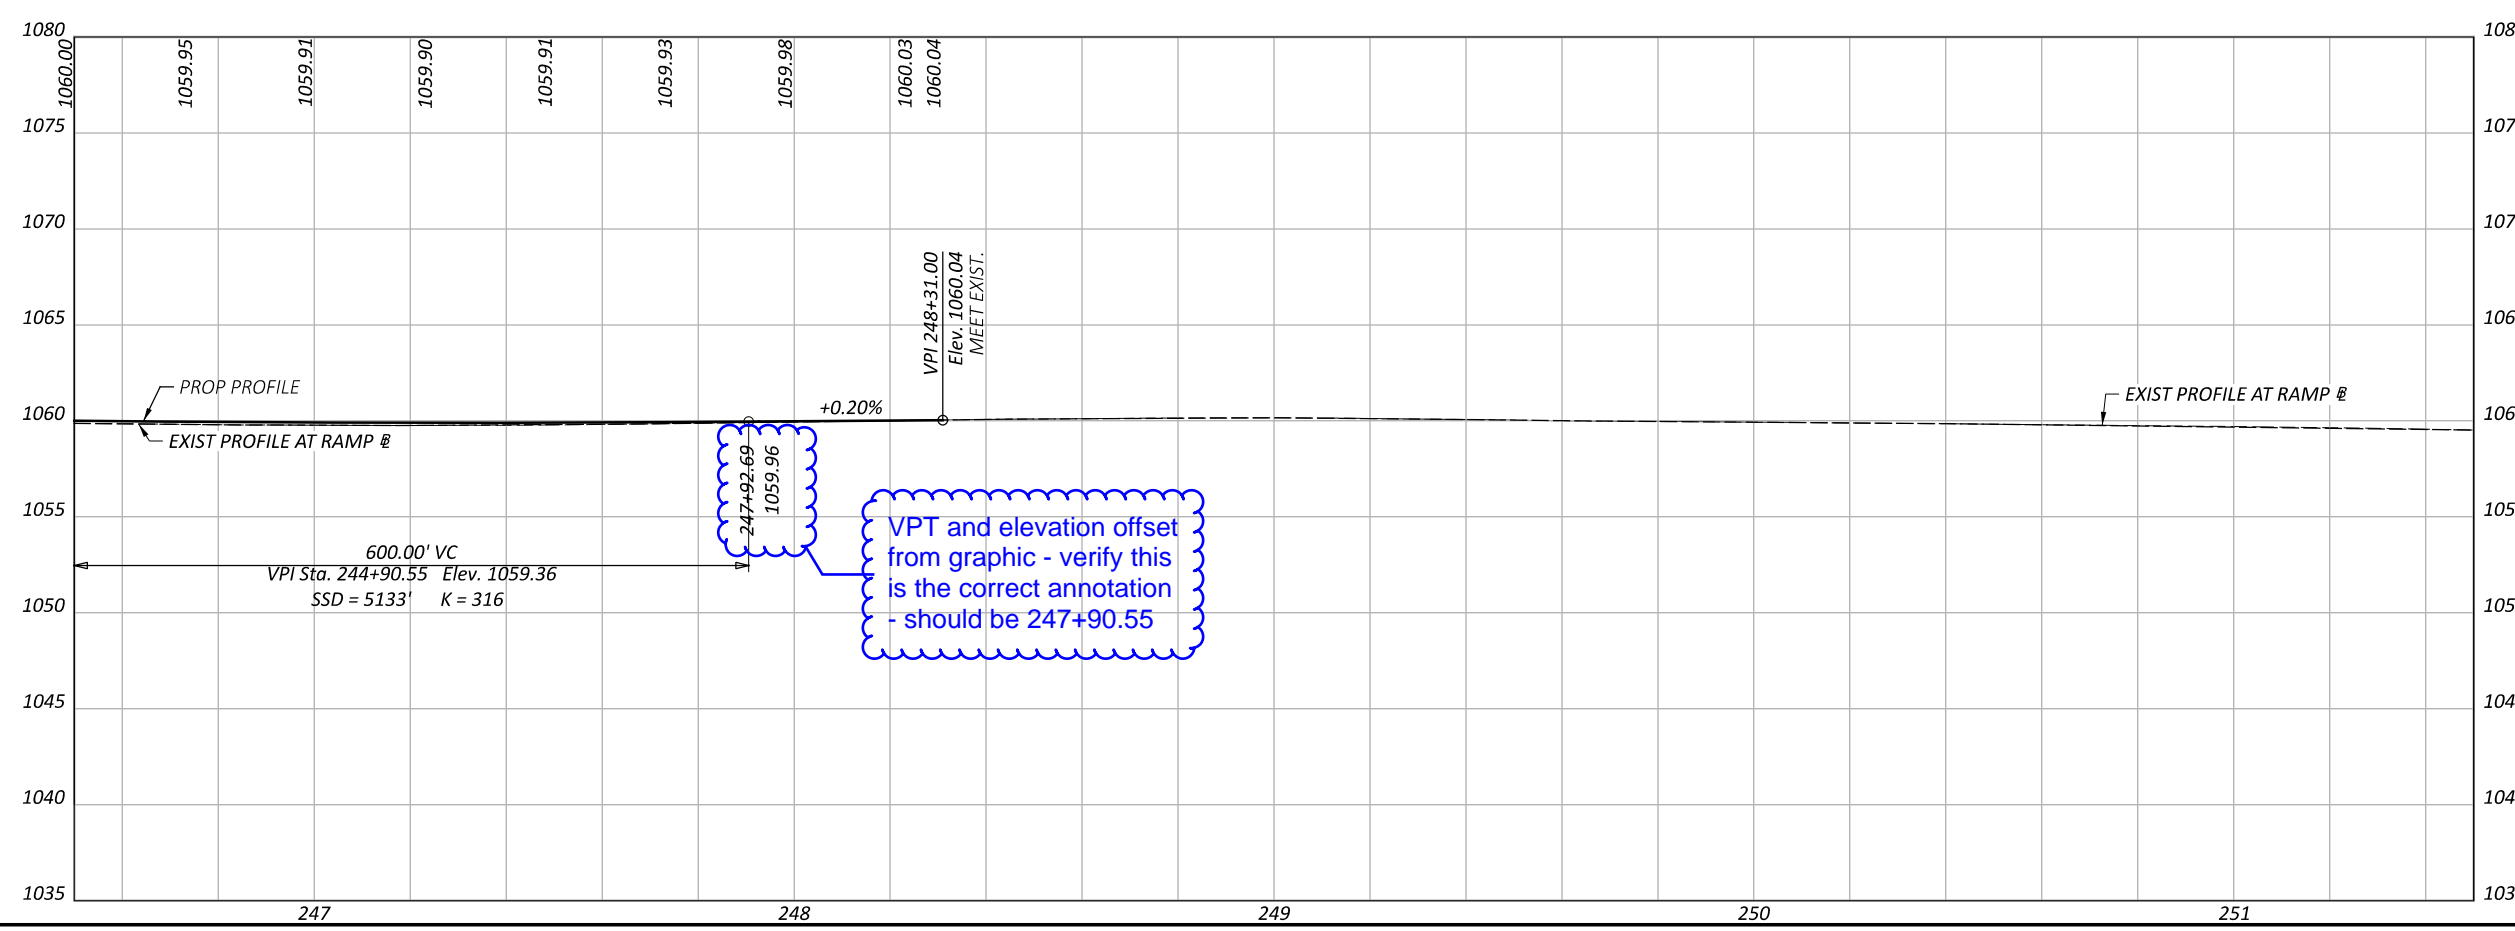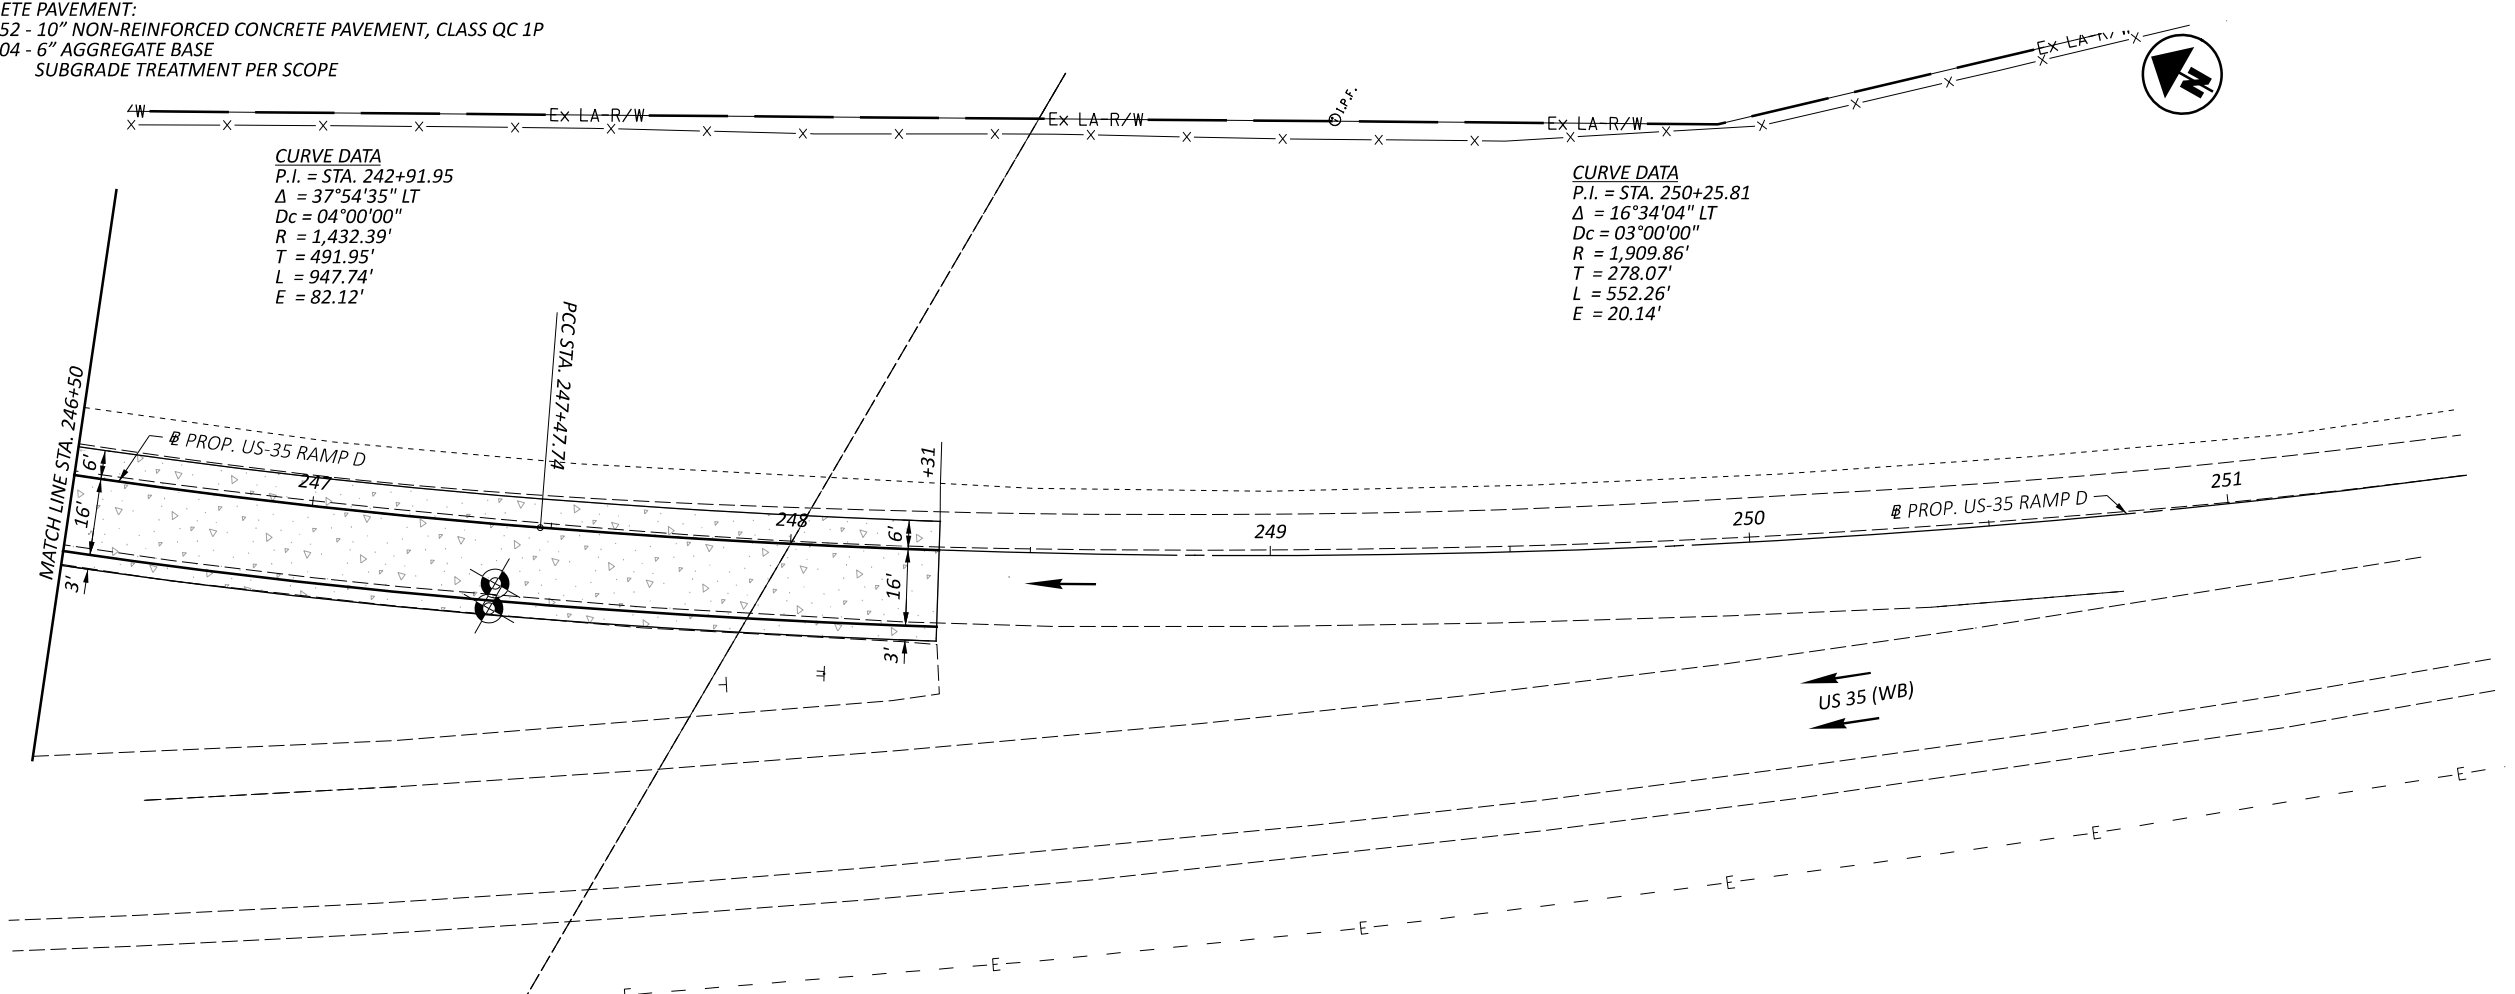

PLAN AND PROFILE
US35 RAMP D STA 246+50 TO STA 251+50

DESIGN AGENCY
Palmer
ENGINEERING
8350 E. KEMPER RD.
SUITE B
CINCINNATI, OH 45249
513-469-1600

DESIGNER
DPF


REVIEWER
DCJ MM-DD-YY

PROJECT ID
117955


SHEET TOTAL
P. 131 228

FAY-435-1.52


MODEL: BLP_US35_RAMPD - US35 Ramp D Plan 3 (Sheet) PAPER SIZE: 17x11 (in.) DATE: 3/25/2024 TIME: 3:40:42 PM USER: dan-f
pw:\pewinp04.pewin.private.palmer.net.com:Palmer_Engineering\Documents\Ohio\000T\06\FAY\117955\100-Engineering\Roadway\Sheets\BU-5\117955_GP105.dgn

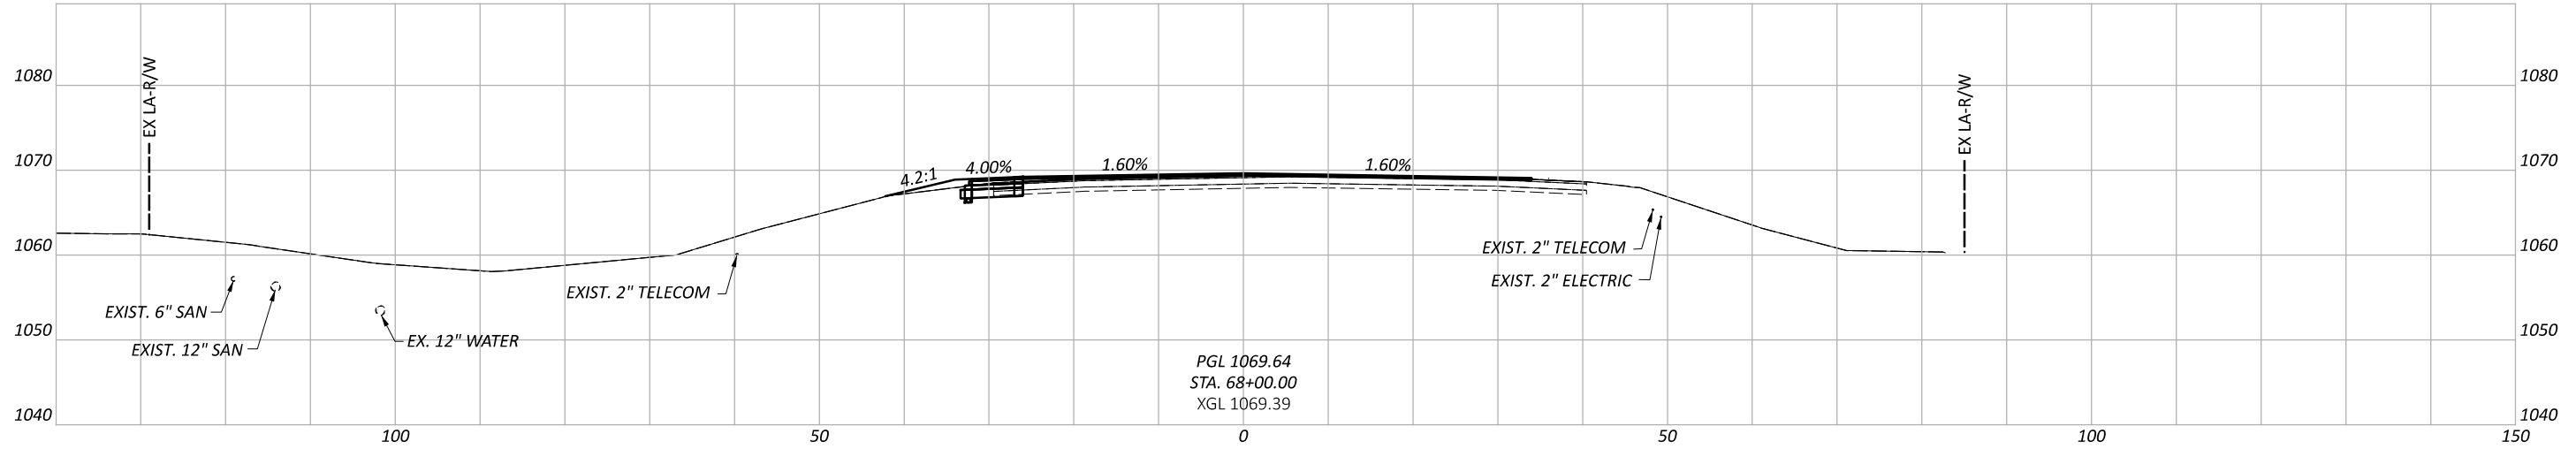

PGL 1069.64
 STA. 68+00.00
 XGL 1069.39

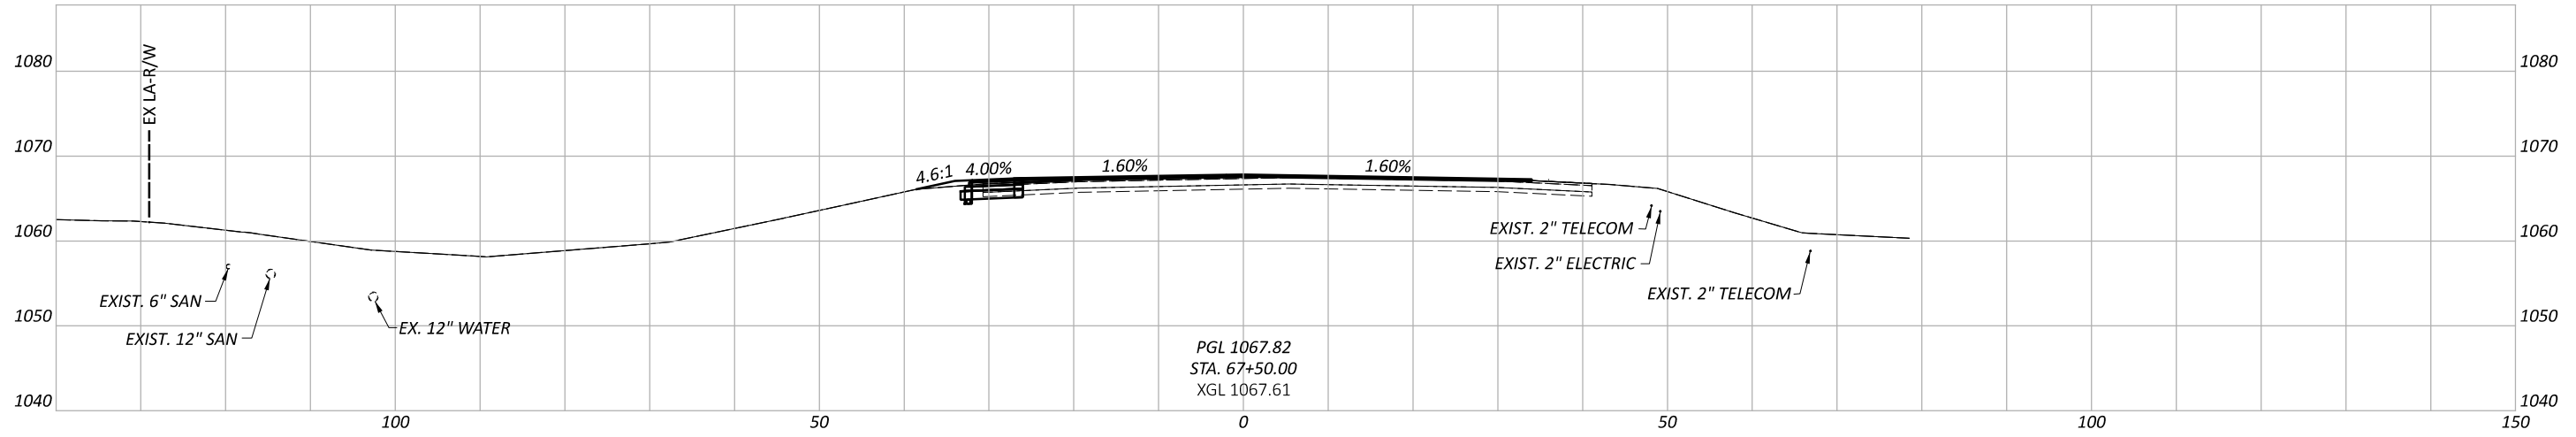

PGL 1067.82
 STA. 67+50.00
 XGL 1067.61

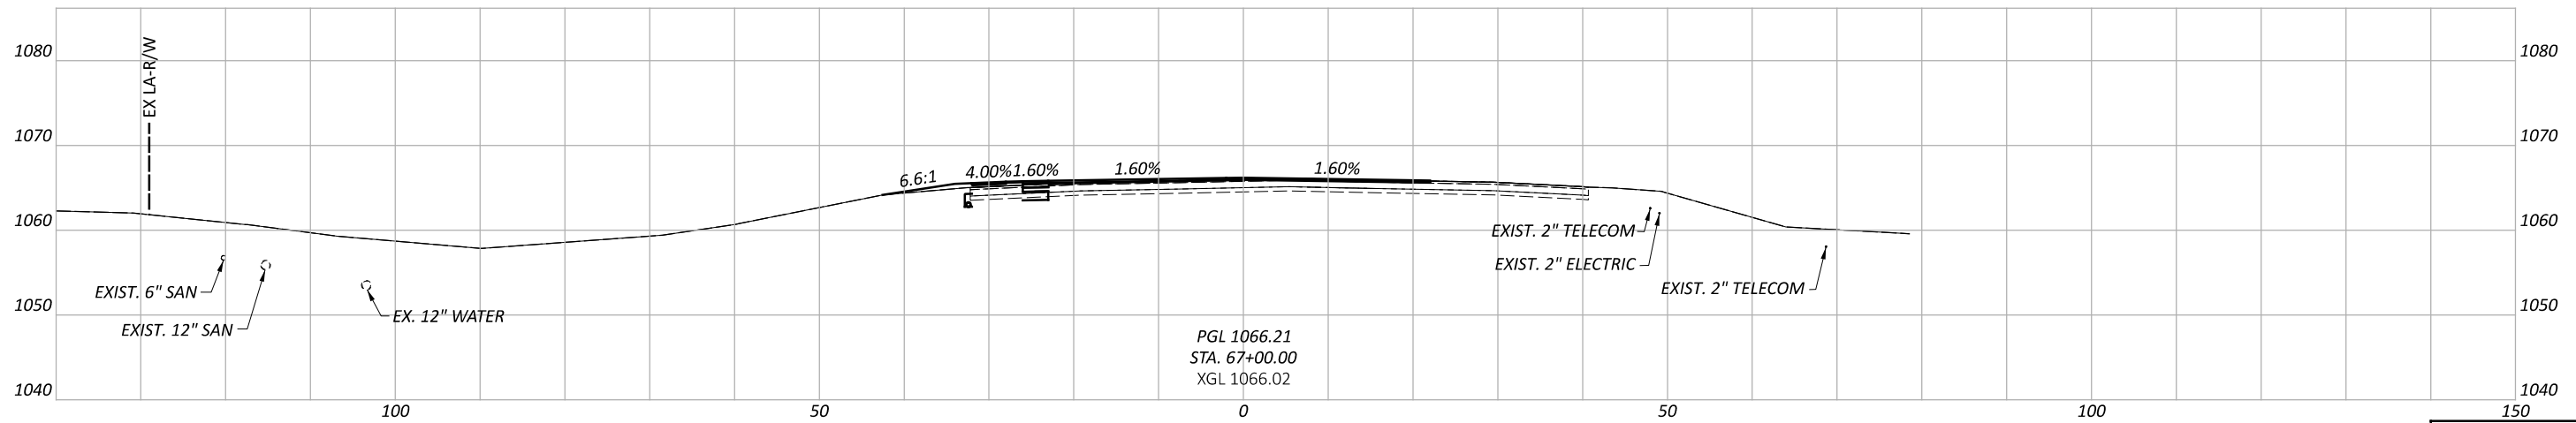

PGL 1066.21
 STA. 67+00.00
 XGL 1066.02

CROSS SECTIONS - SR 435
 STA. 67+00.00 - STA. 68+00.00

DESIGN AGENCY



DESIGNER

DPF

REVIEWER

DCJ MM-DD-YY

PROJECT ID



117955

Sheet Totals

Seeding	Cut	Fill

SHEET TOTAL

P. 132 228

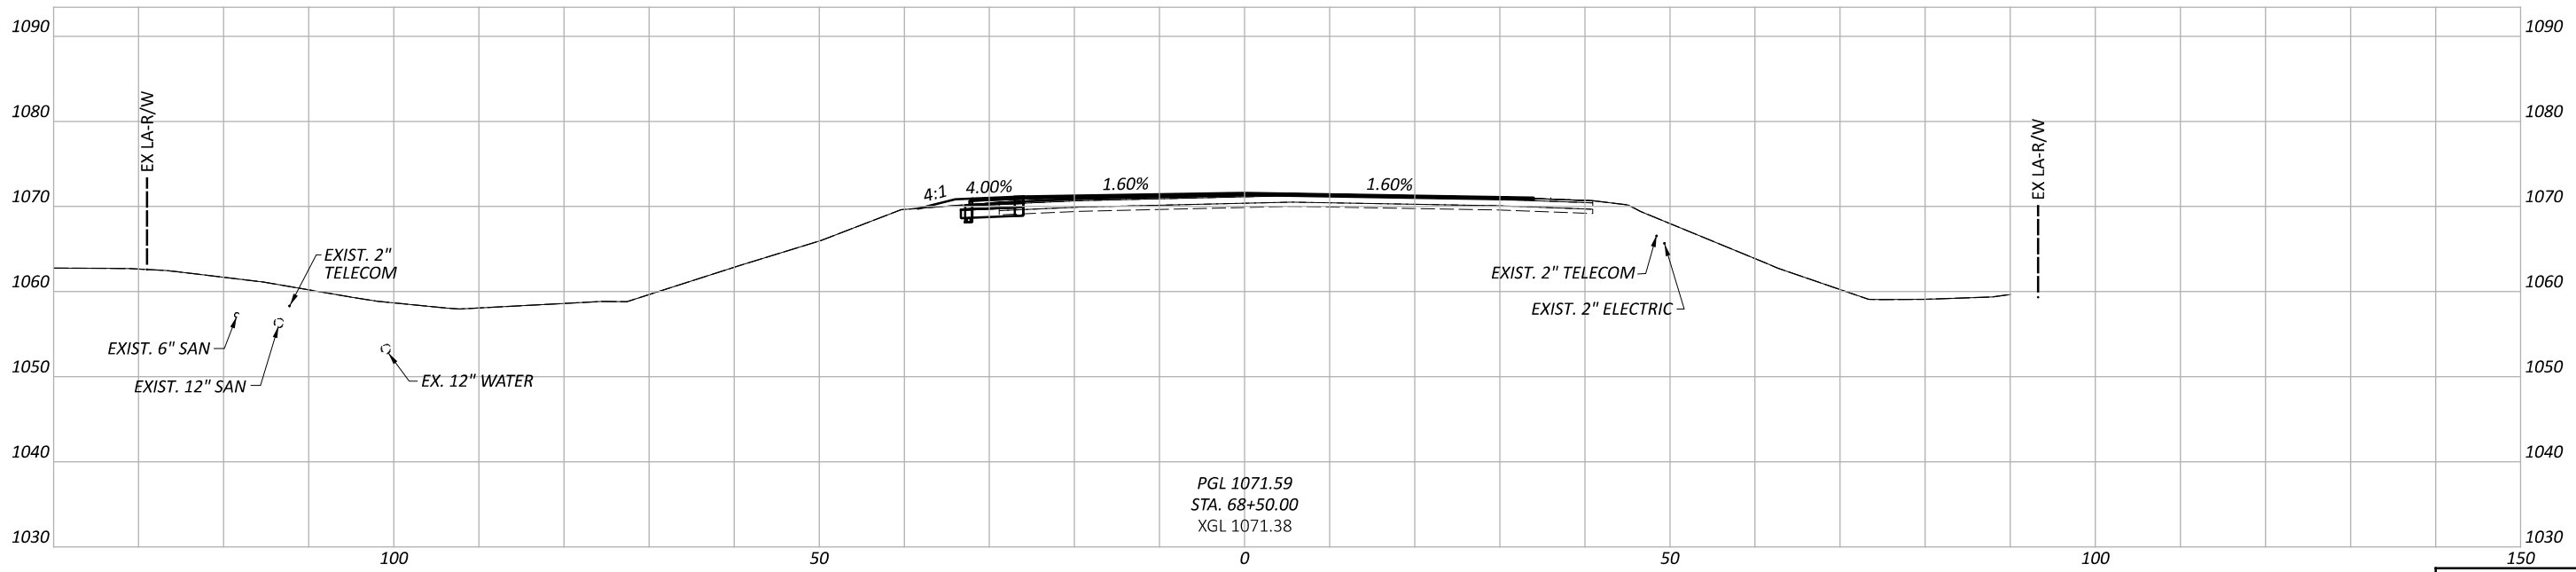
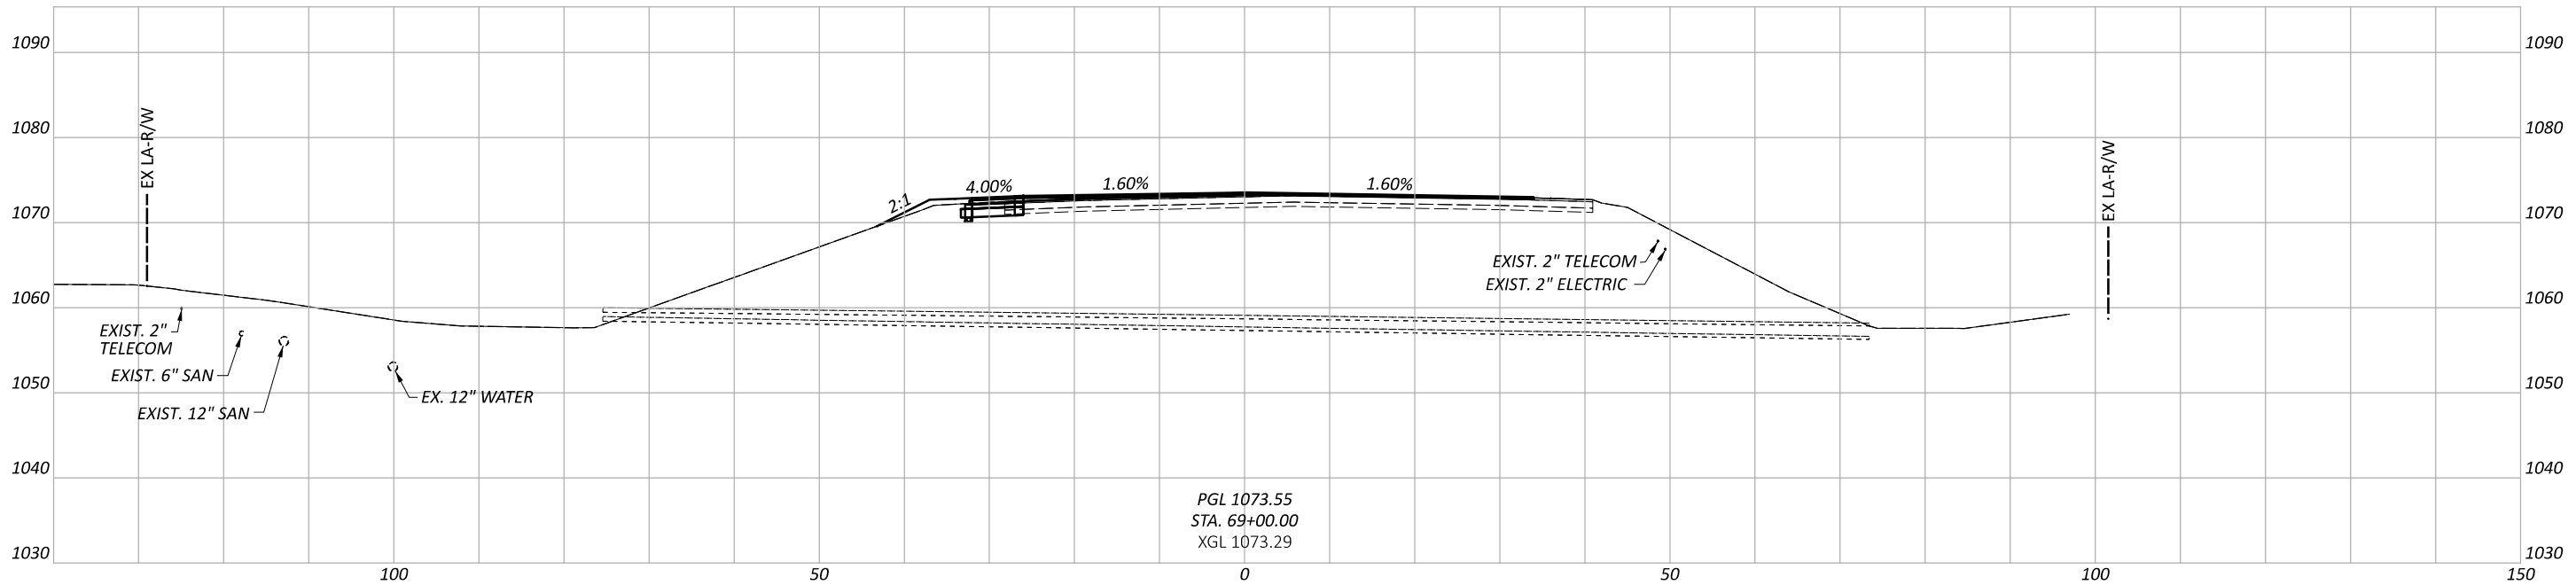


CROSS SECTIONS - SR 435
 STA. 68+50.00 TO STA. 69+00.00

DESIGN AGENCY
Palmer
 ENGINEERING
 8350 E. KEMPER RD.
 SUITE B
 CINCINNATI, OH 45249
 513-469-1600

DESIGNER
DPF
 REVIEWER
DCJ MM-DD-YY
 PROJECT ID
117955


Sheet Totals			TOTAL	
Seeding	Cut	Fill	SHEET	TOTAL
			P. 133	228

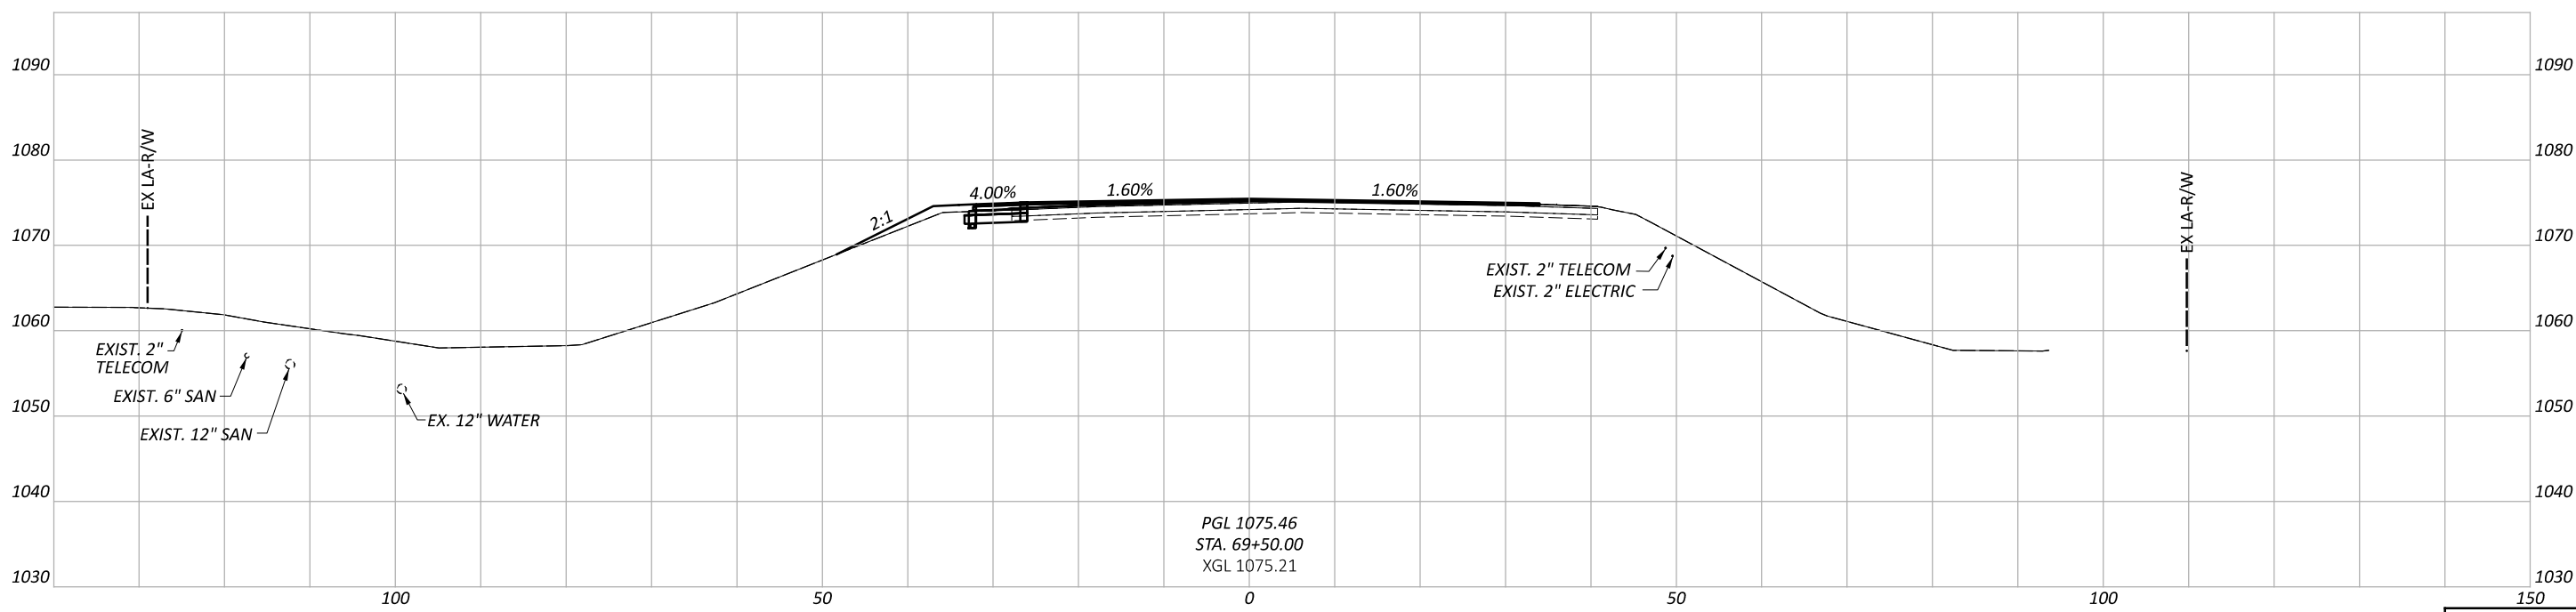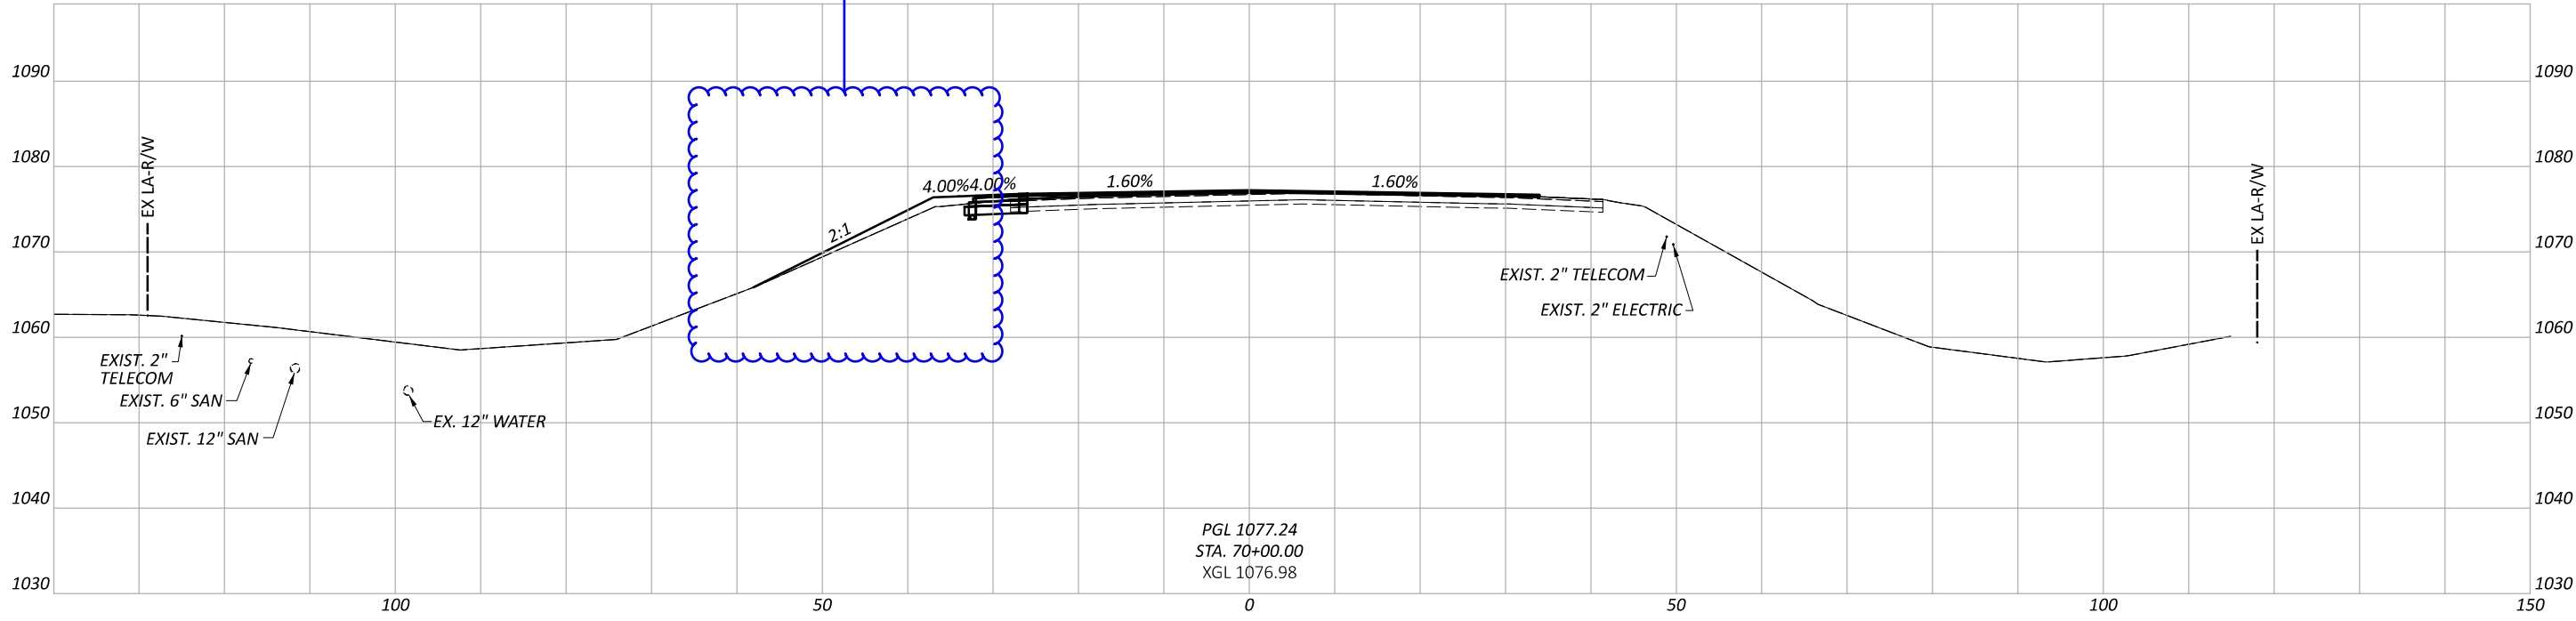


CROSS SECTIONS - SR 435
 STA. 69+50.00 TO STA. 70+00.00

DESIGN AGENCY	
 8350 E. KEMPER RD. SUITE B CINCINNATI, OH 45249 513-469-1600	
DESIGNER	
DPF	
REVIEWER	
DCJ MM-DD-YY	
PROJECT ID	
117955	
SHEET TOTAL	
P. 134	TOTAL 228

Sheet Totals		
Seeding	Cut	Fill

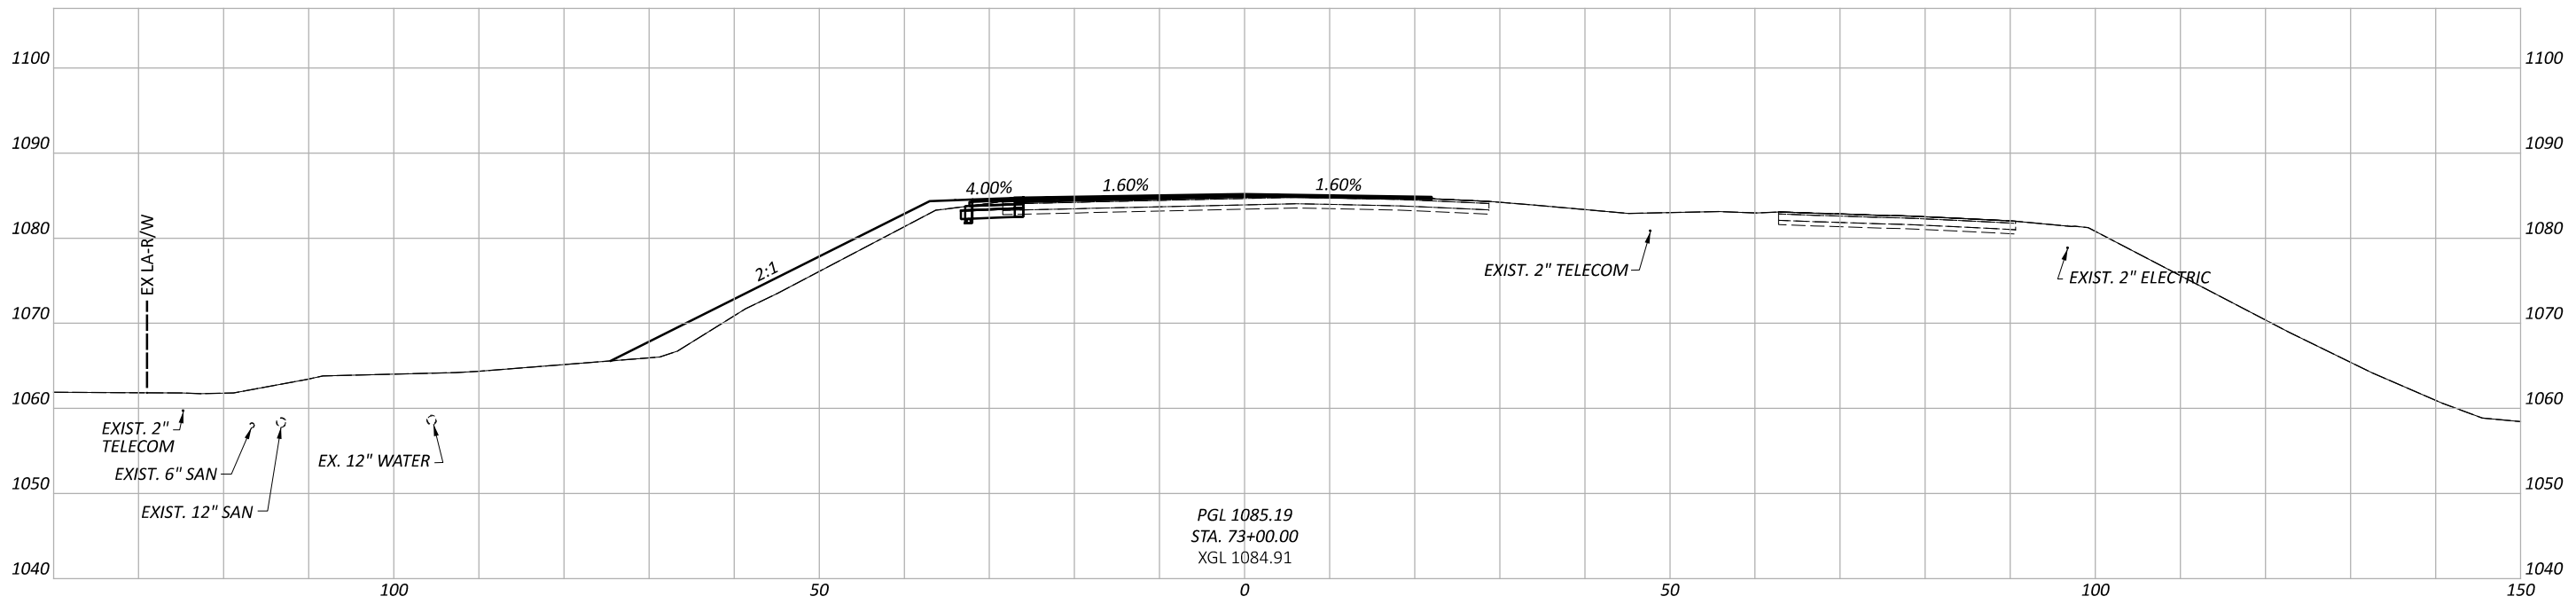

PGL 1085.19
 STA. 73+00.00
 XGL 1084.91

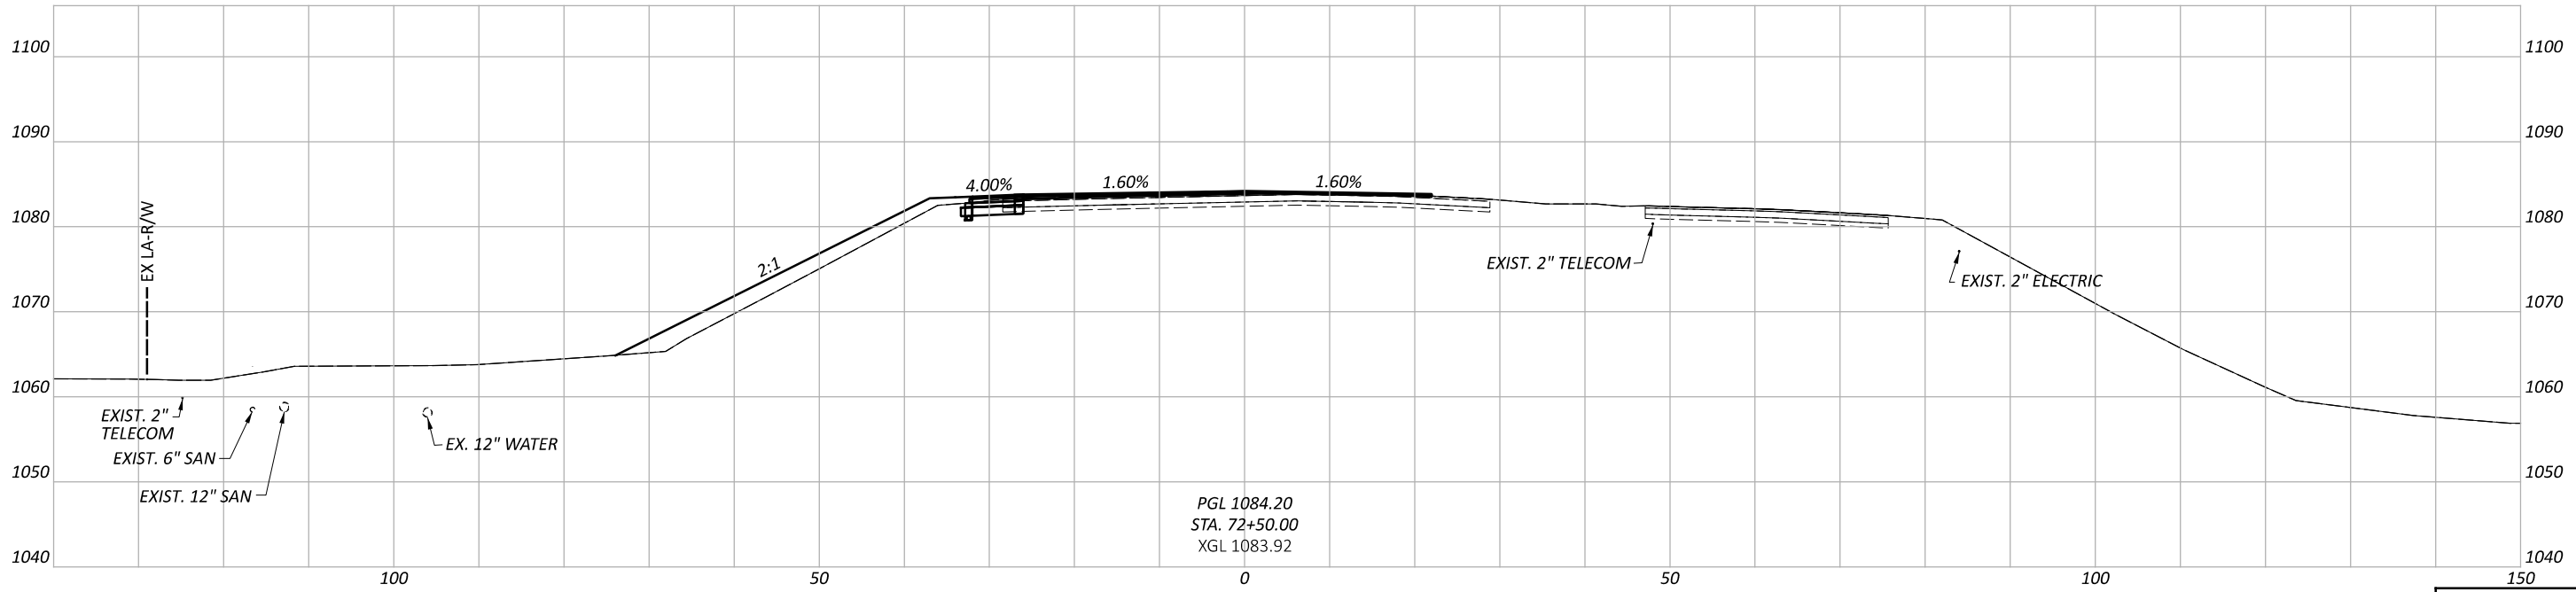

PGL 1084.20
 STA. 72+50.00
 XGL 1083.92




CROSS SECTIONS - SR 435
 STA. 72+50.00 TO STA. 73+00.00

DESIGN AGENCY
Palmer
 ENGINEERING
 8350 E. KEMPER RD.
 SUITE B
 CINCINNATI, OH 45249
 513-469-1600

DESIGNER
 DPF
 REVIEWER
 DCJ MM-DD-YY
 PROJECT ID

117955
 SHEET TOTAL
 P. 137 TOTAL 228

Sheet Totals		
Seeding	Cut	Fill

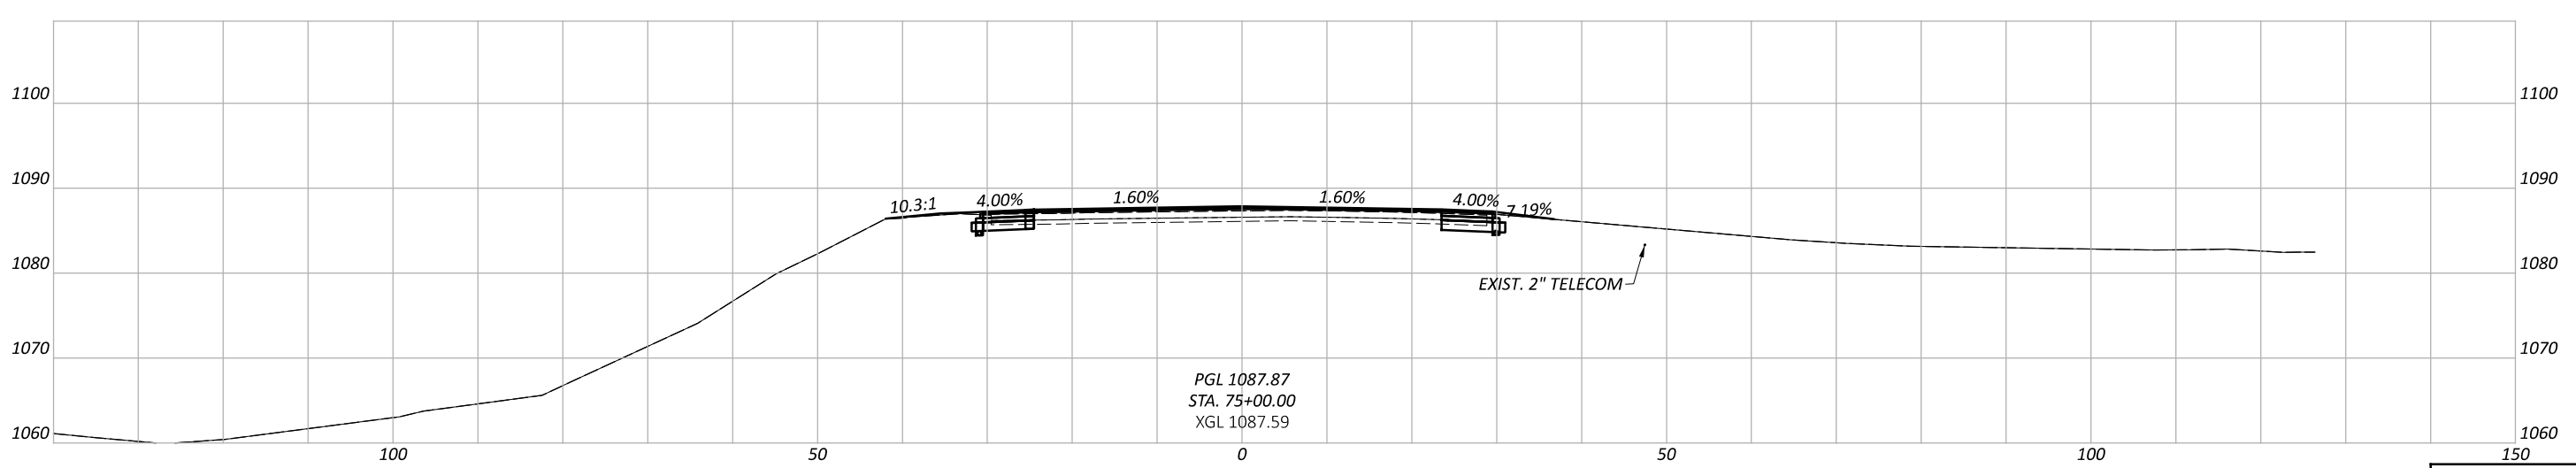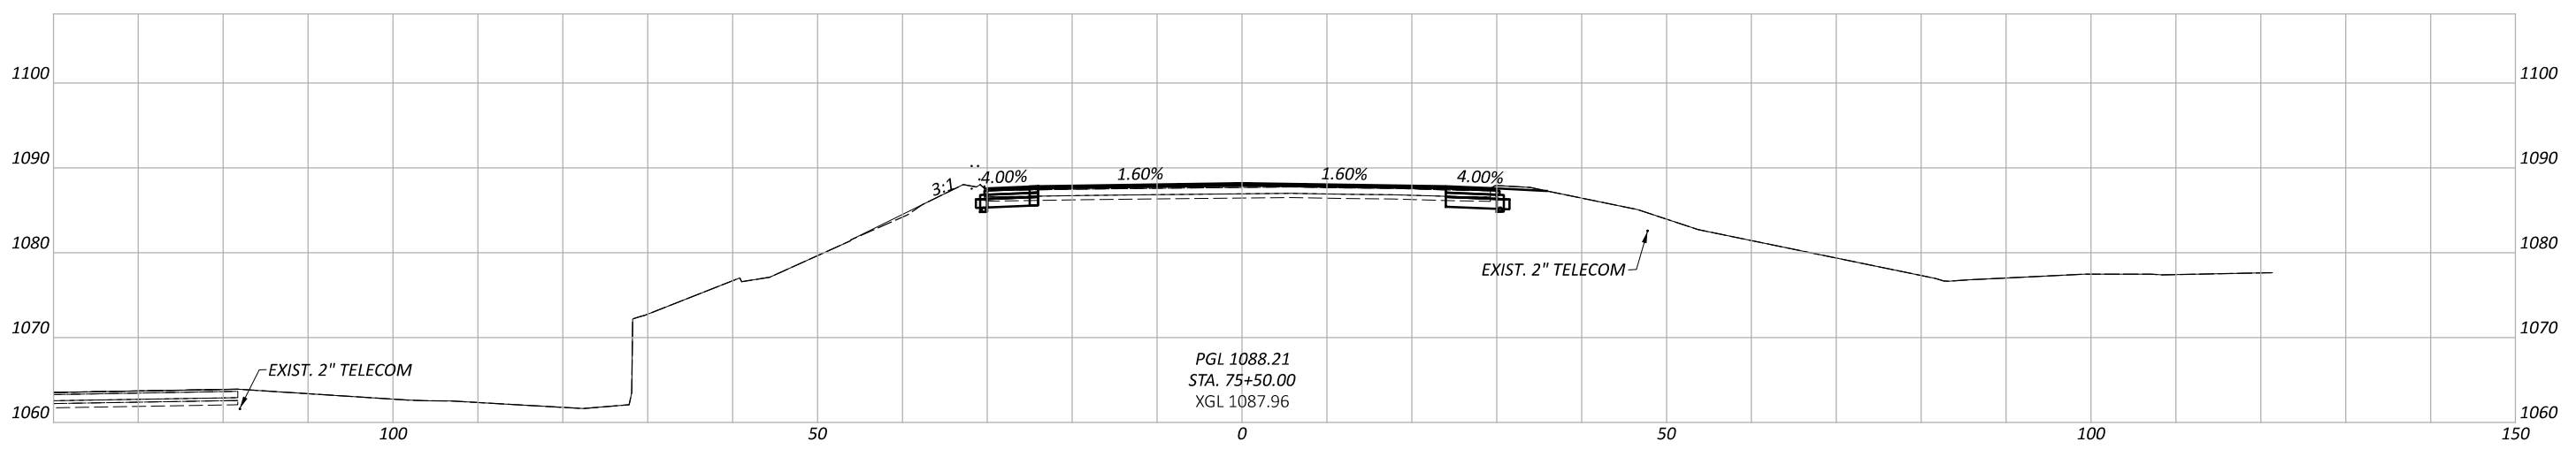
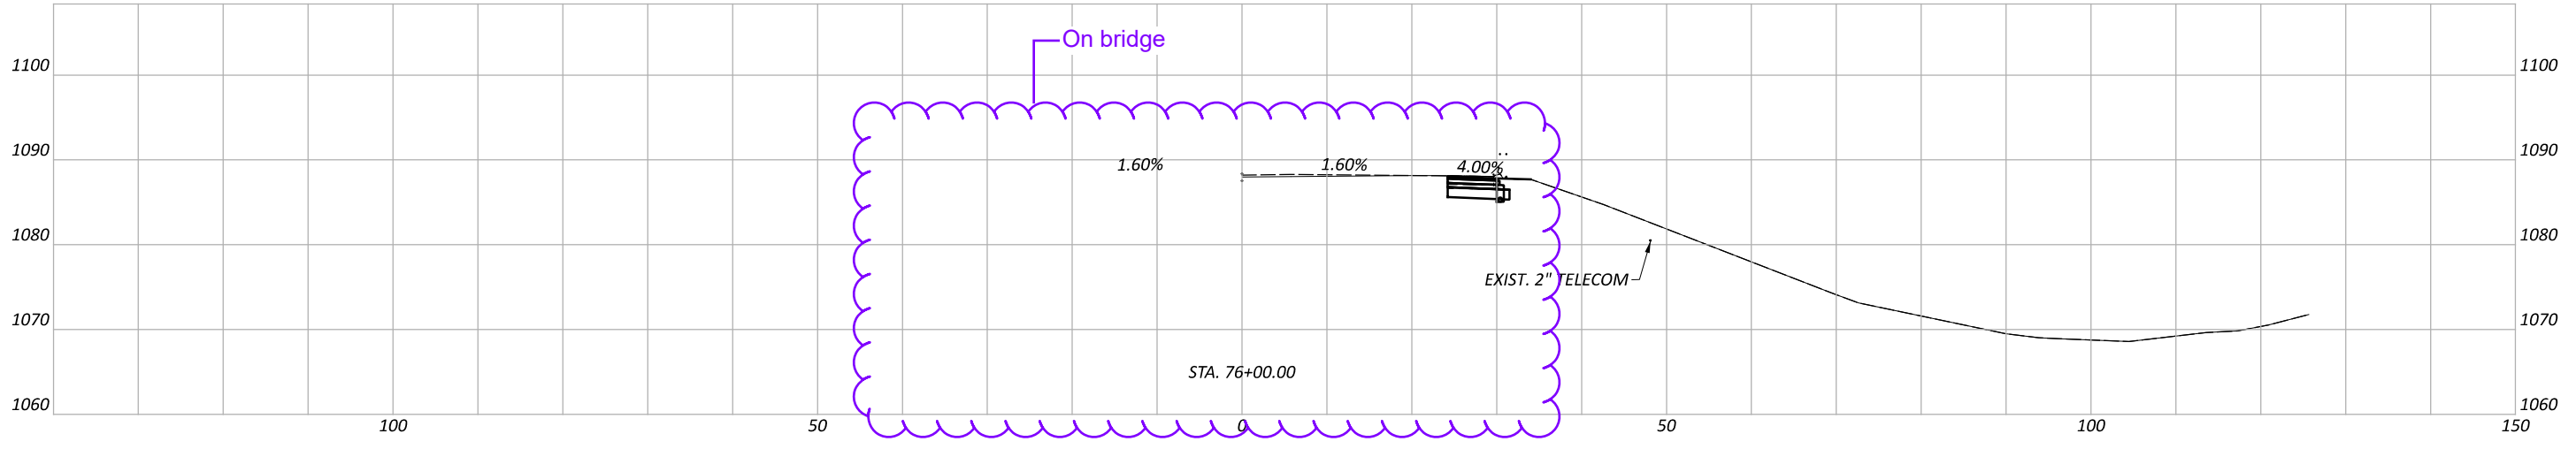


CROSS SECTIONS - SR 435
 STA. 75+00.00 TO STA. 75+52.70


DESIGN AGENCY
Palmer
 ENGINEERING
 8350 E. KEMPER RD.
 SUITE B
 CINCINNATI, OH 45249
 513-469-1600

DESIGNER
 DPF
 REVIEWER
 DCJ MM-DD-YY
 PROJECT ID

Sheet Totals			117955	
Seeding	Cut	Fill	SHEET	TOTAL
			P. 139	228

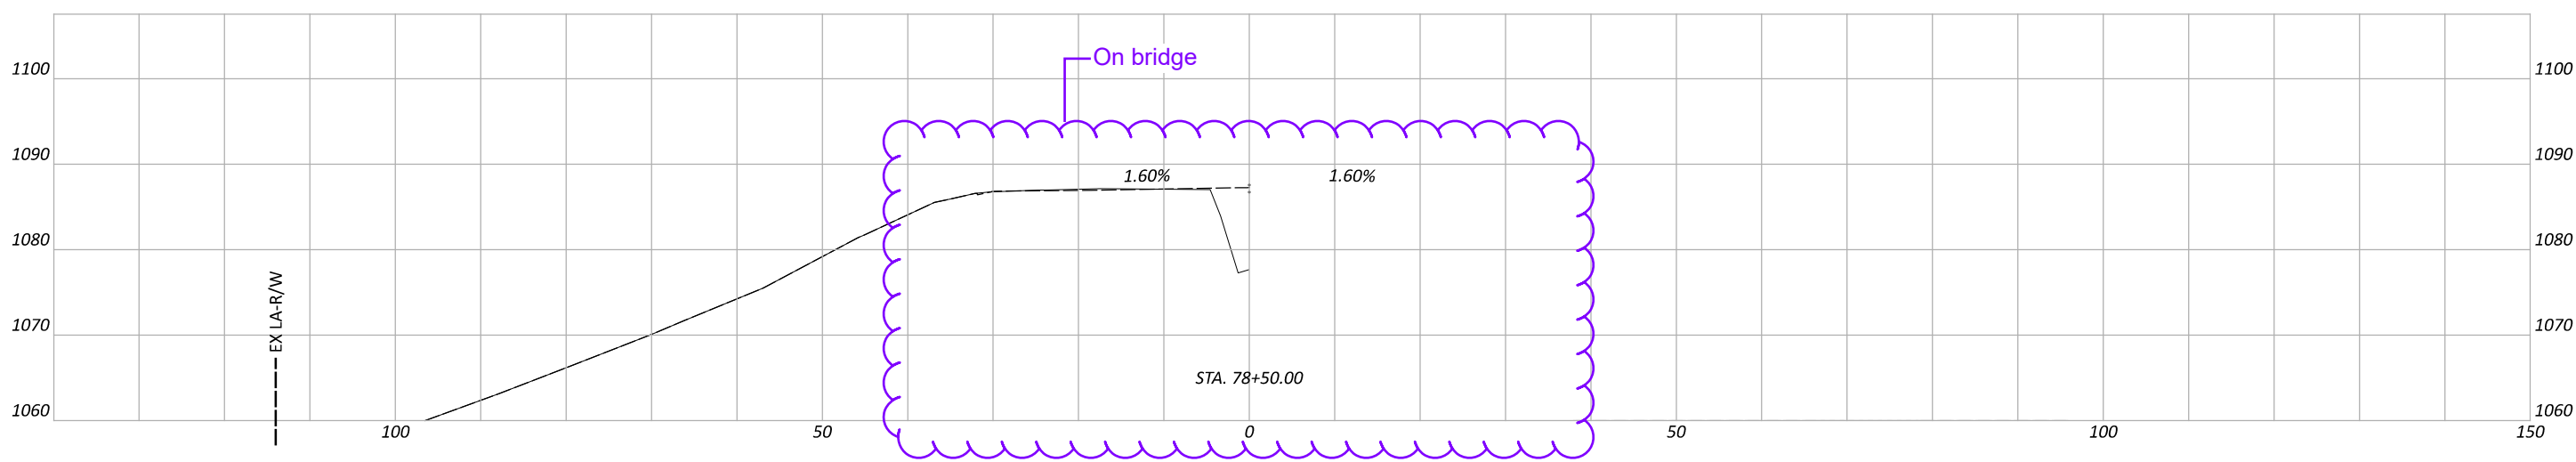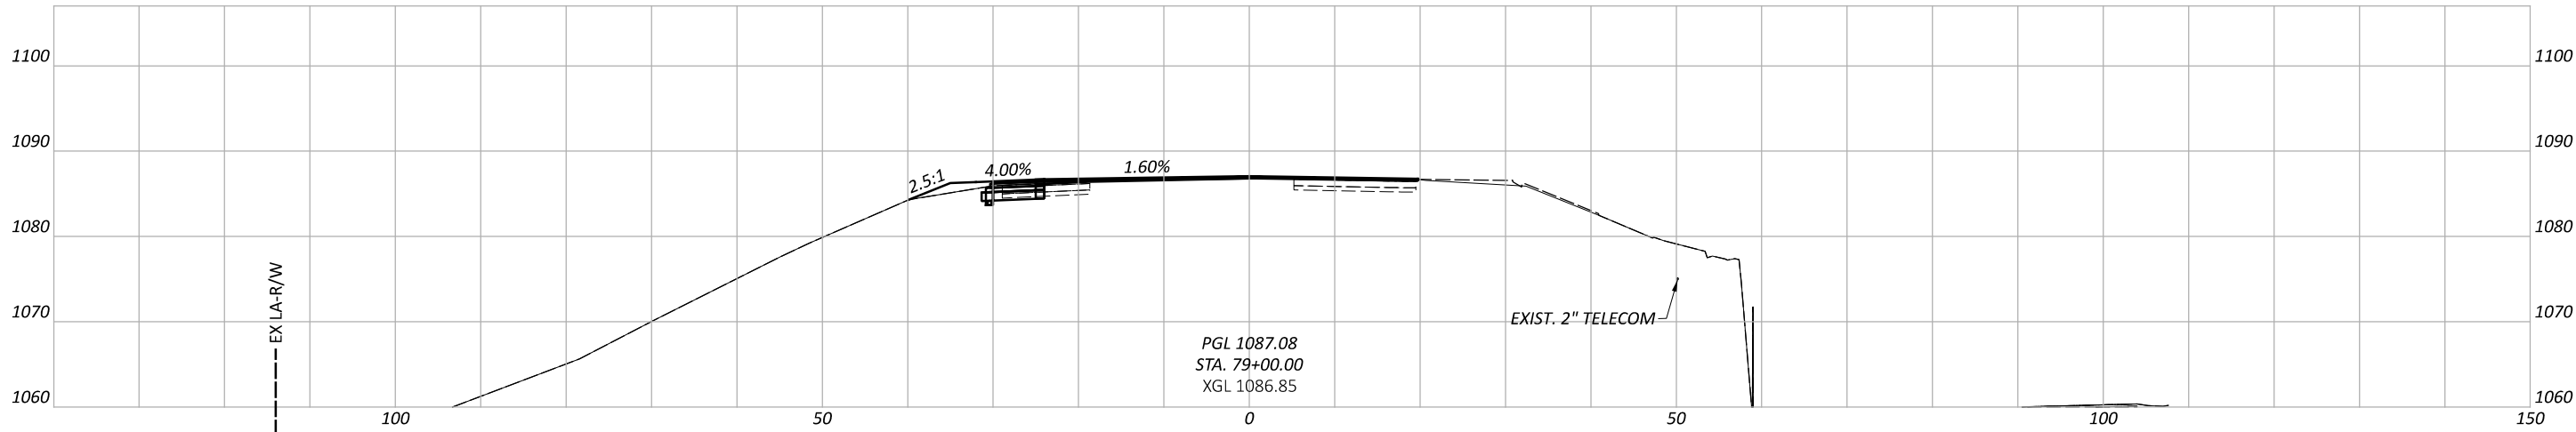

CROSS SECTIONS - SR 435
 STA. 78+50.00 TO STA. 79+00.00




DESIGN AGENCY

 ENGINEERING
 8350 E. KEMPER RD.
 SUITE B
 CINCINNATI, OH 45249
 513-469-1600

DESIGNER
 DPF

REVIEWER
 DCJ MM-DD-YY

PROJECT ID
 117955

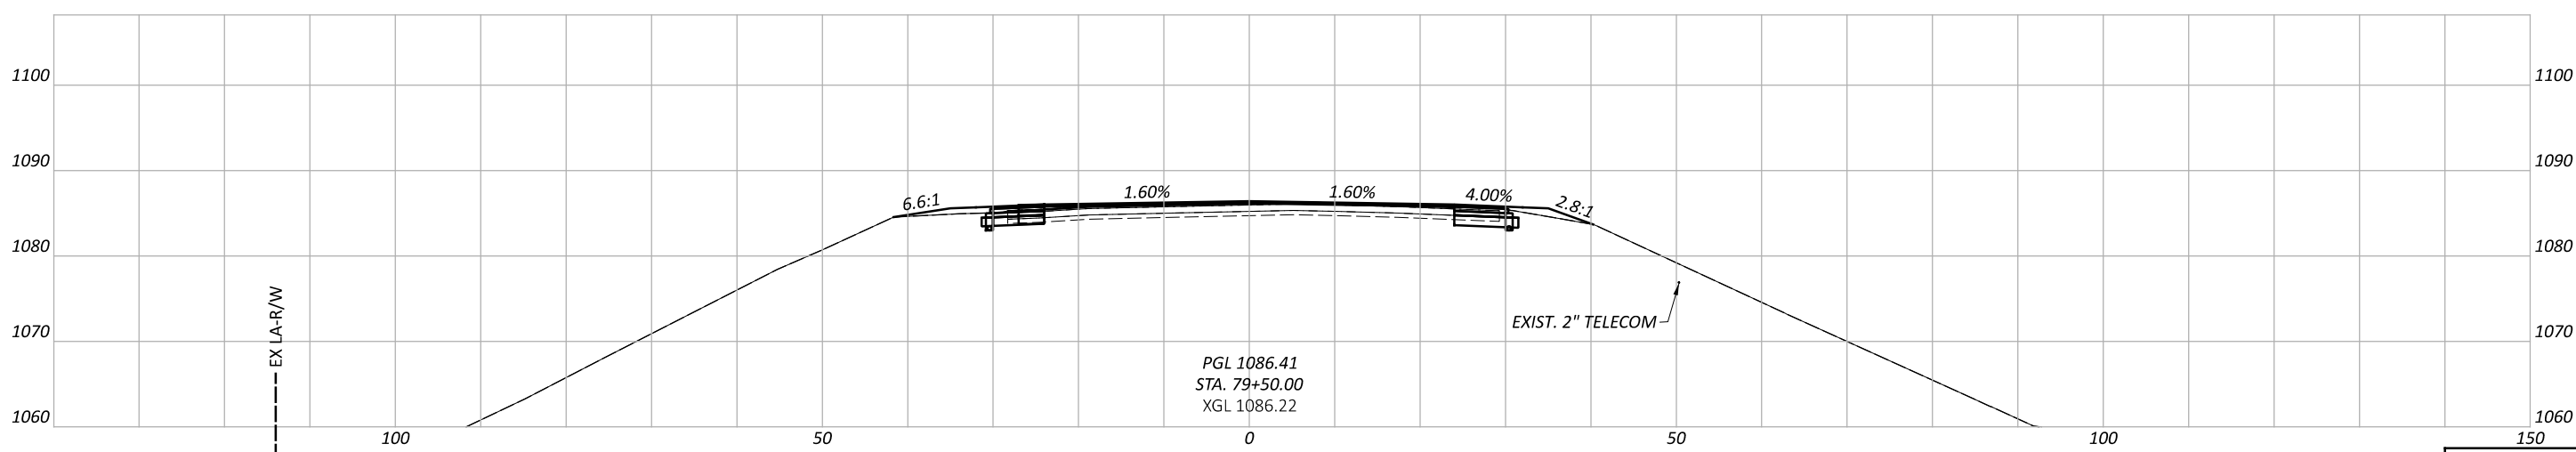
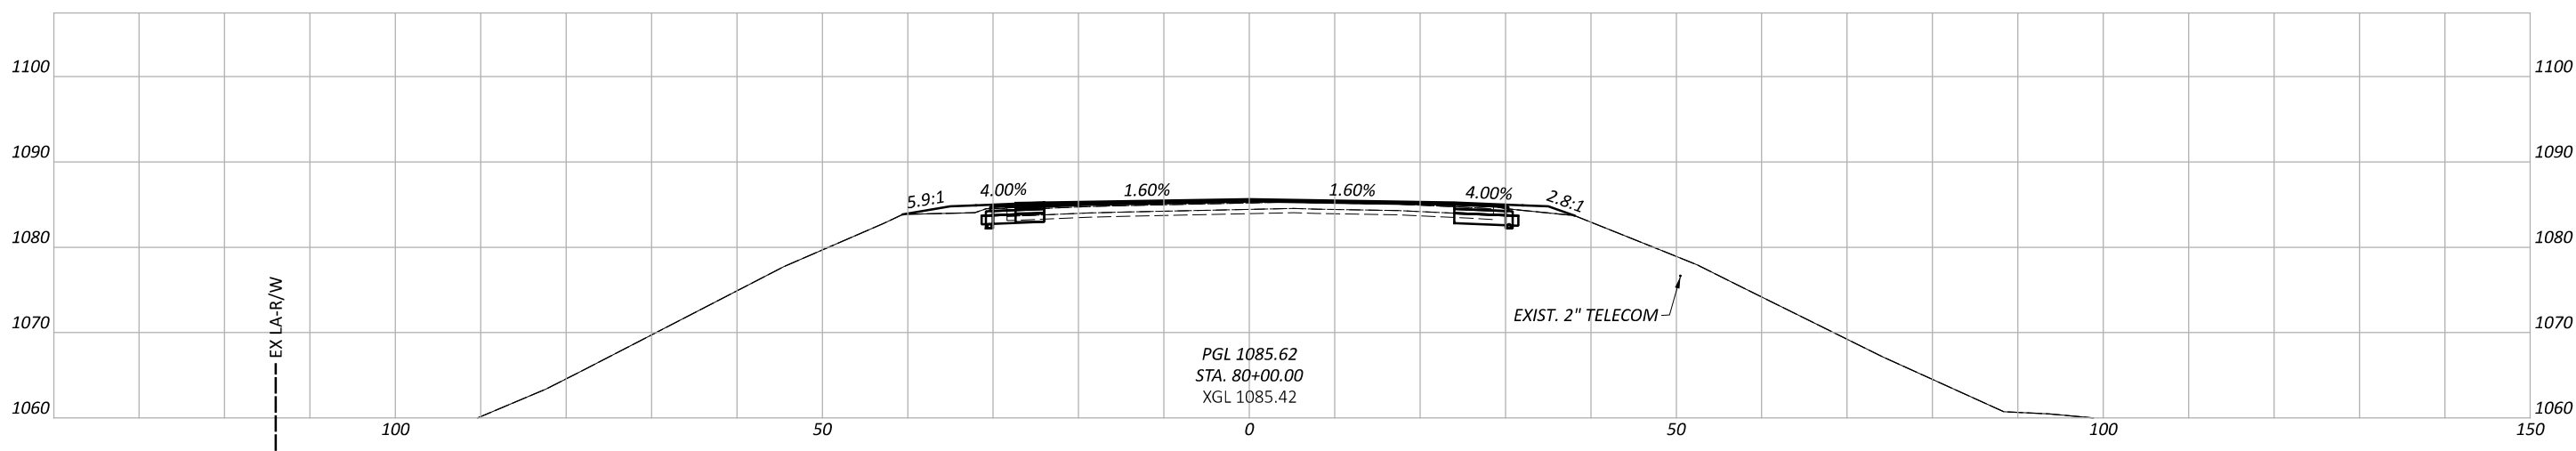
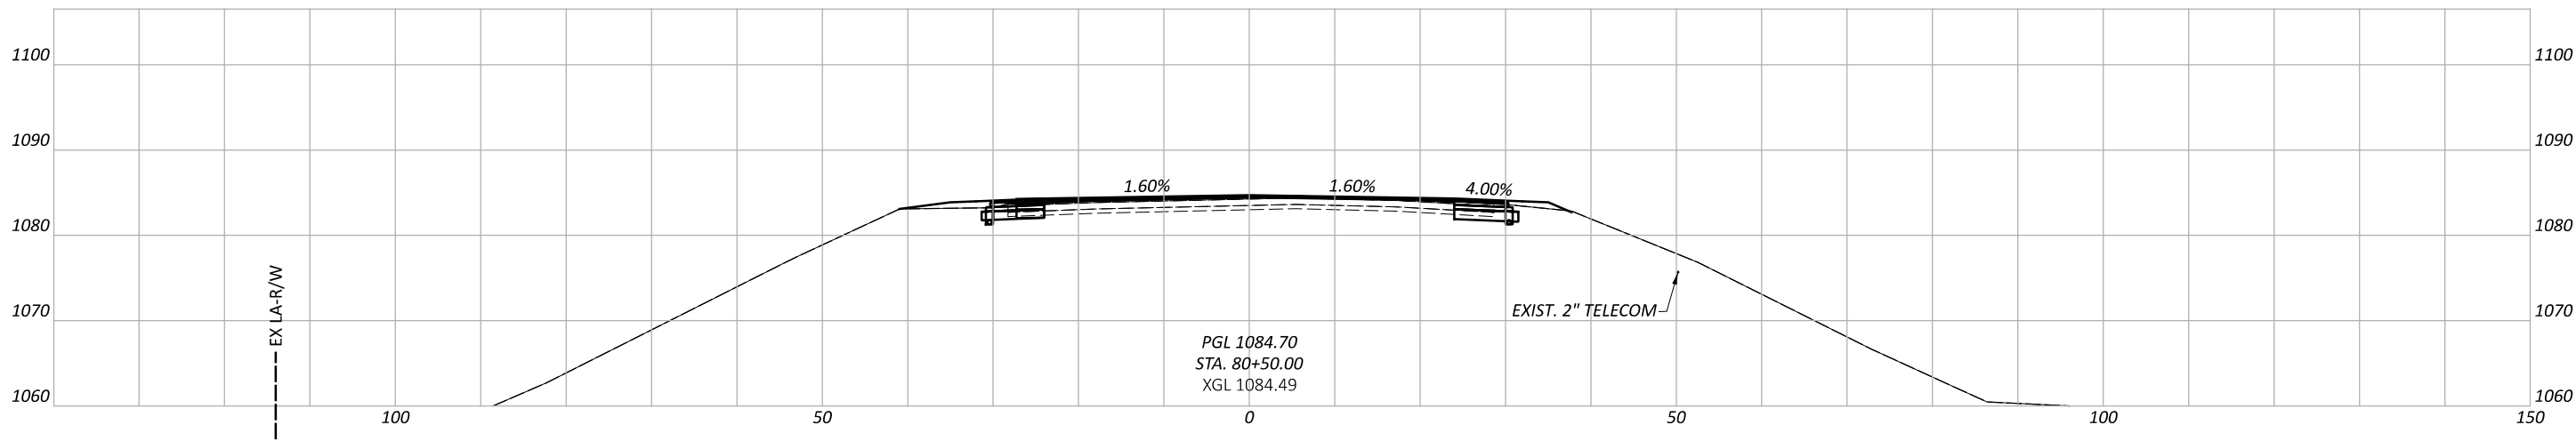
Sheet Totals			TOTAL	
Seeding	Cut	Fill	SHEET	TOTAL
			P. 140	228



CROSS SECTIONS - SR 435
 STA. 79+50.00 TO STA. 80+50.00

DESIGN AGENCY	Palmer ENGINEERING
DESIGNER	DPF
REVIEWER	DCJ MM-DD-YY
PROJECT ID	117955
SHEET TOTAL	P. 141 / 228

Sheet Totals		
Seeding	Cut	Fill

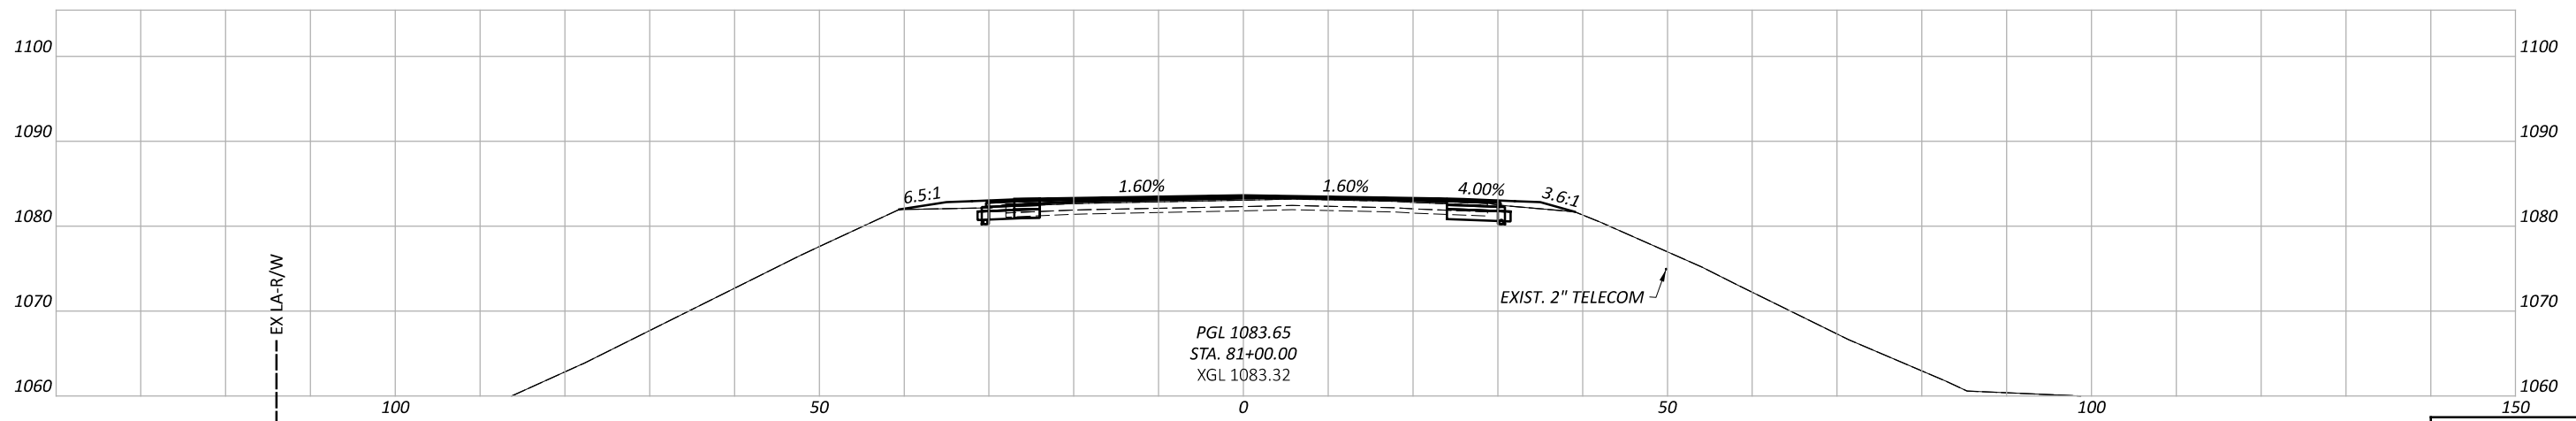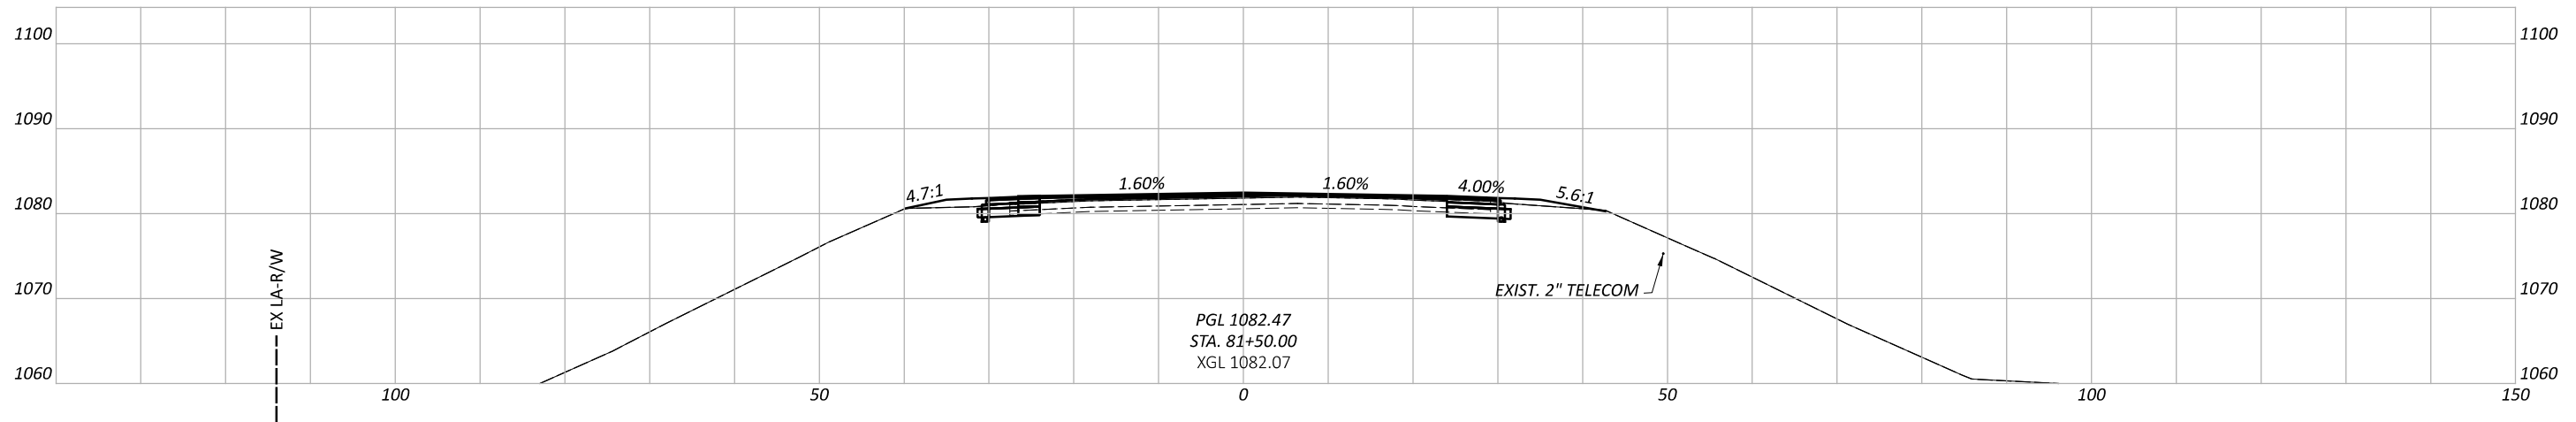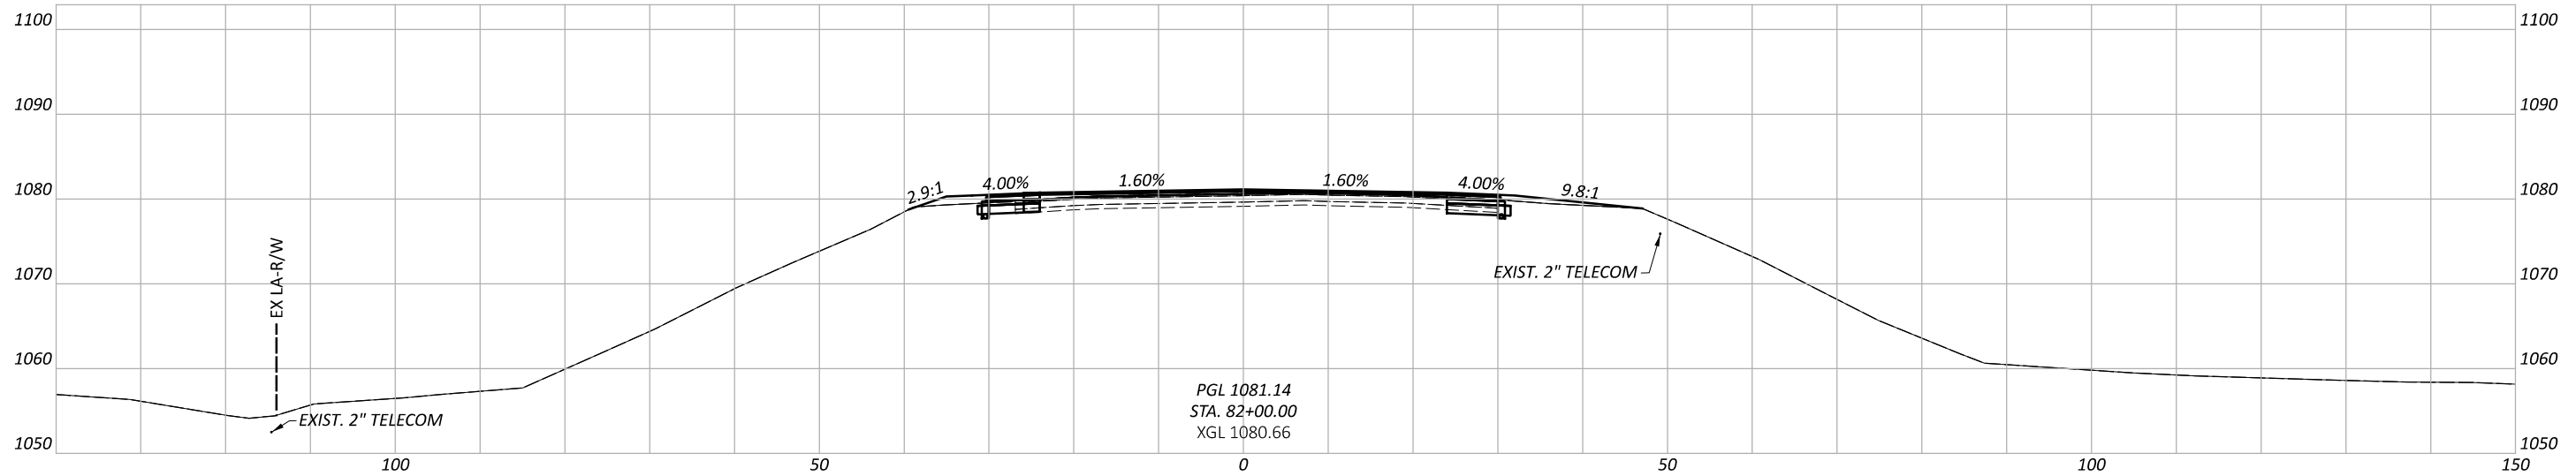

CROSS SECTIONS - SR 435
 STA. 81+00.00 TO STA. 82+00.00

DESIGN AGENCY




DESIGNER
 DPF

REVIEWER
 DCJ MM-DD-YY


PROJECT ID
 117955

Sheet Totals		
Seeding	Cut	Fill


SHEET	TOTAL
P. 142	228

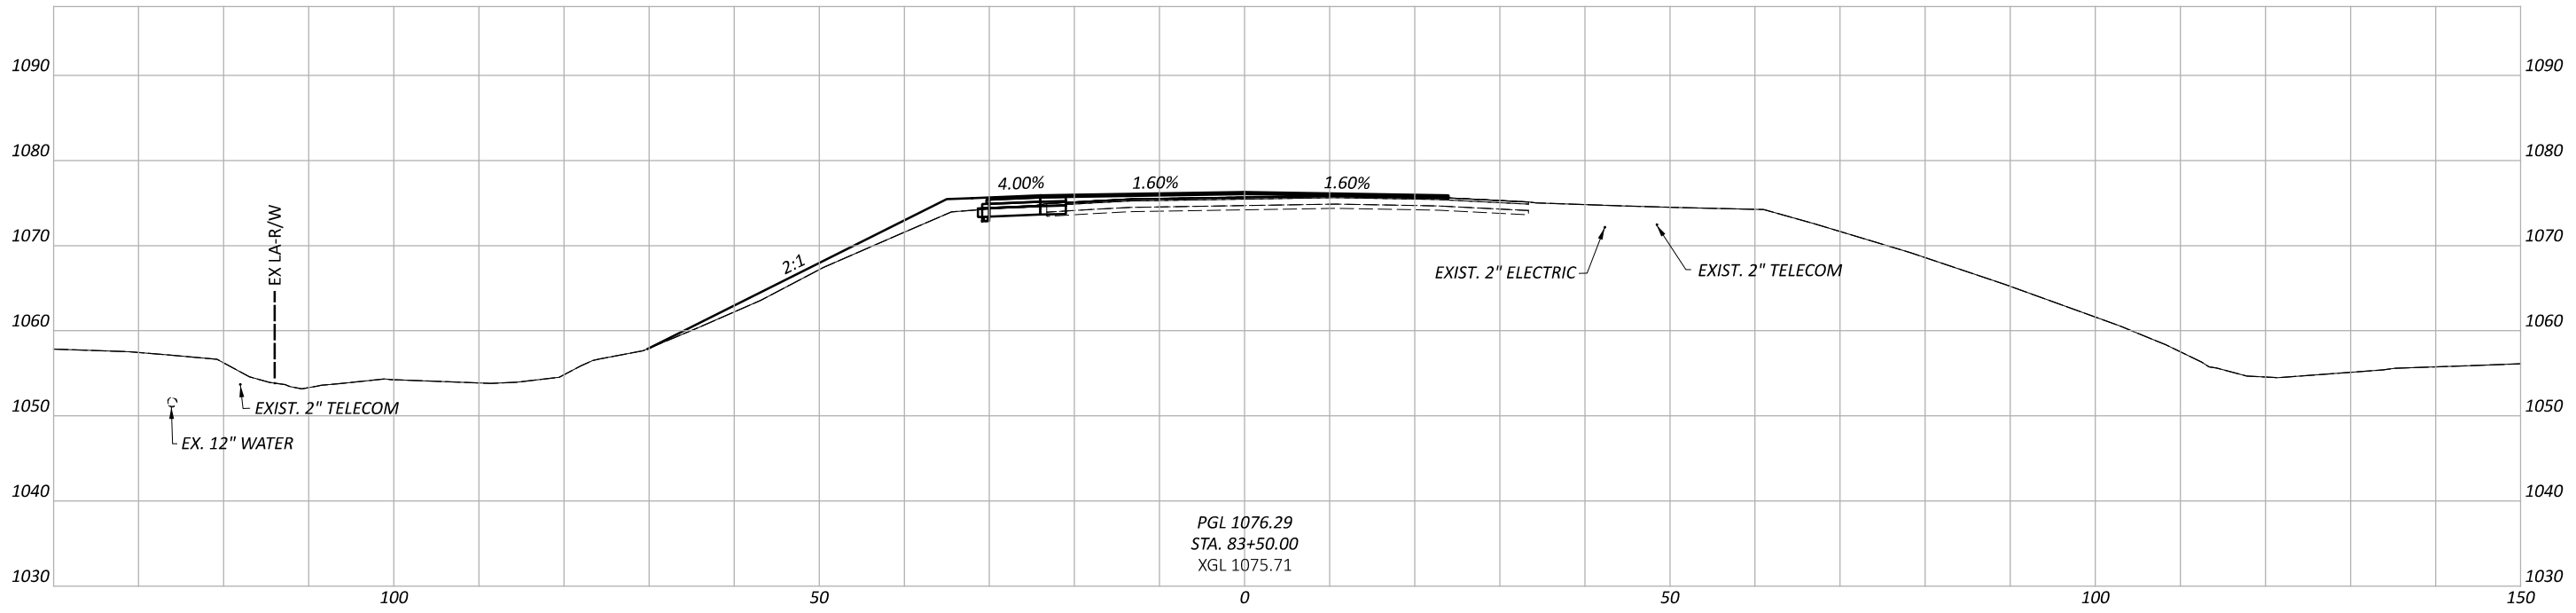

PGL 1076.29
 STA. 83+50.00
 XGL 1075.71

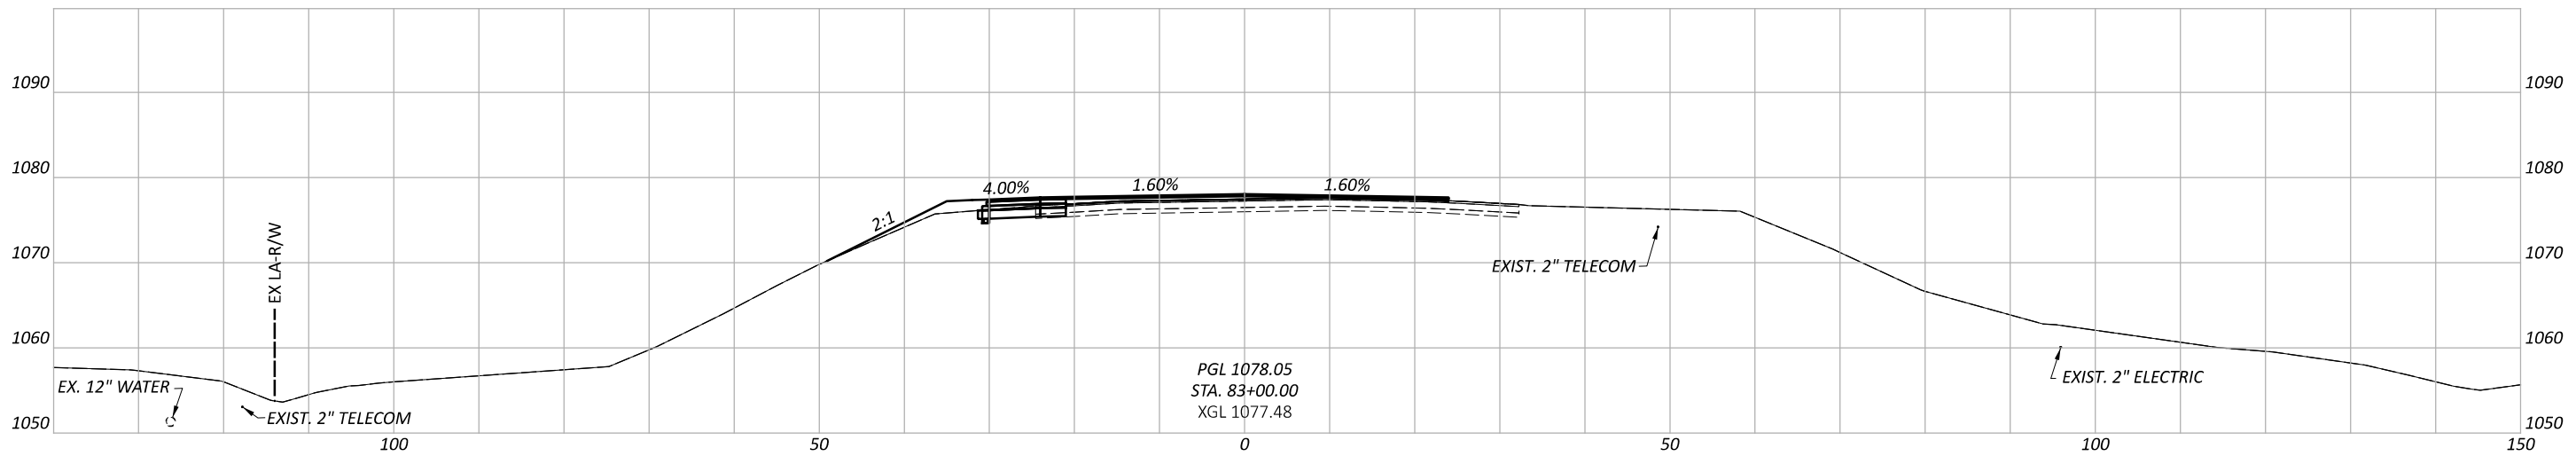

PGL 1078.05
 STA. 83+00.00
 XGL 1077.48

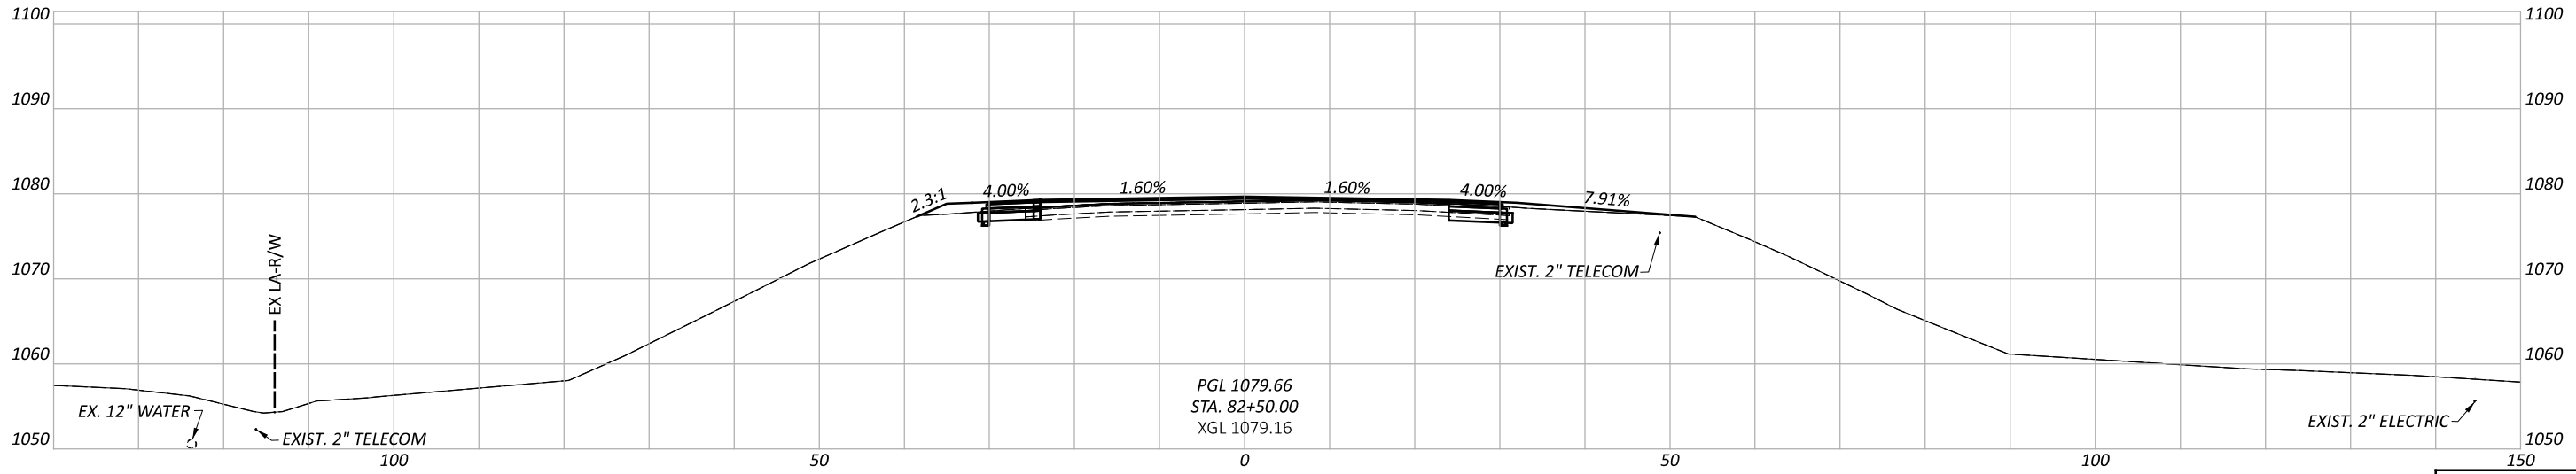

PGL 1079.66
 STA. 82+50.00
 XGL 1079.16

CROSS SECTIONS - SR 435
 STA. 82+50.00 TO STA. 83+50.00

DESIGN AGENCY

Palmer
 ENGINEERING
 8350 E. KEMPER RD.
 SUITE B
 CINCINNATI, OH 45249
 513-469-1600

DESIGNER

DPF

REVIEWER


DCJ MM-DD-YY

PROJECT ID

117955


Sheet Totals		
Seeding	Cut	Fill

SHEET	TOTAL
P. 143	228

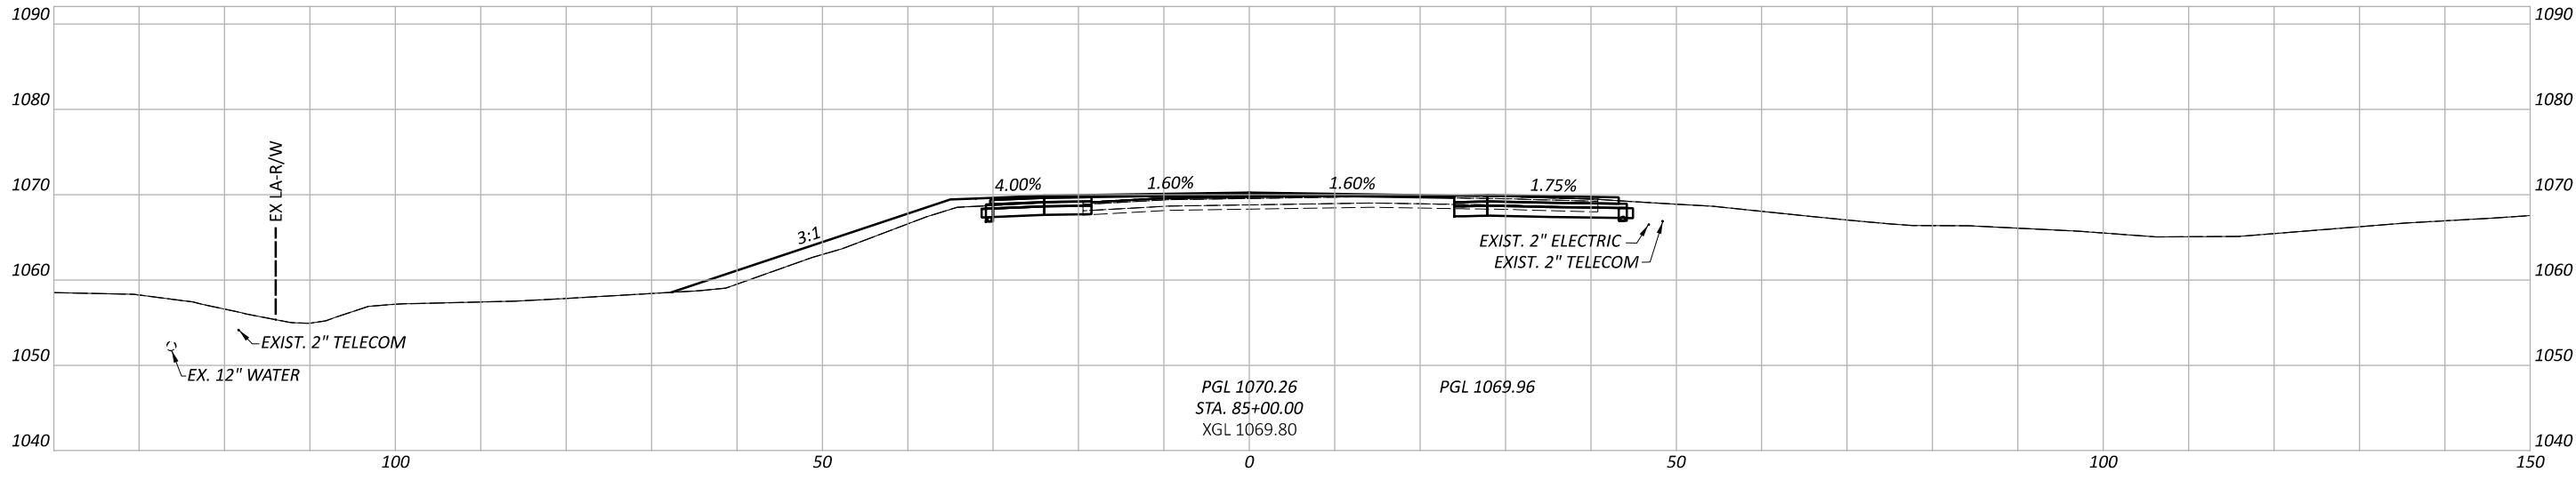


PGL 1070.26
 STA. 85+00.00
 XGL 1069.80

PGL 1069.96

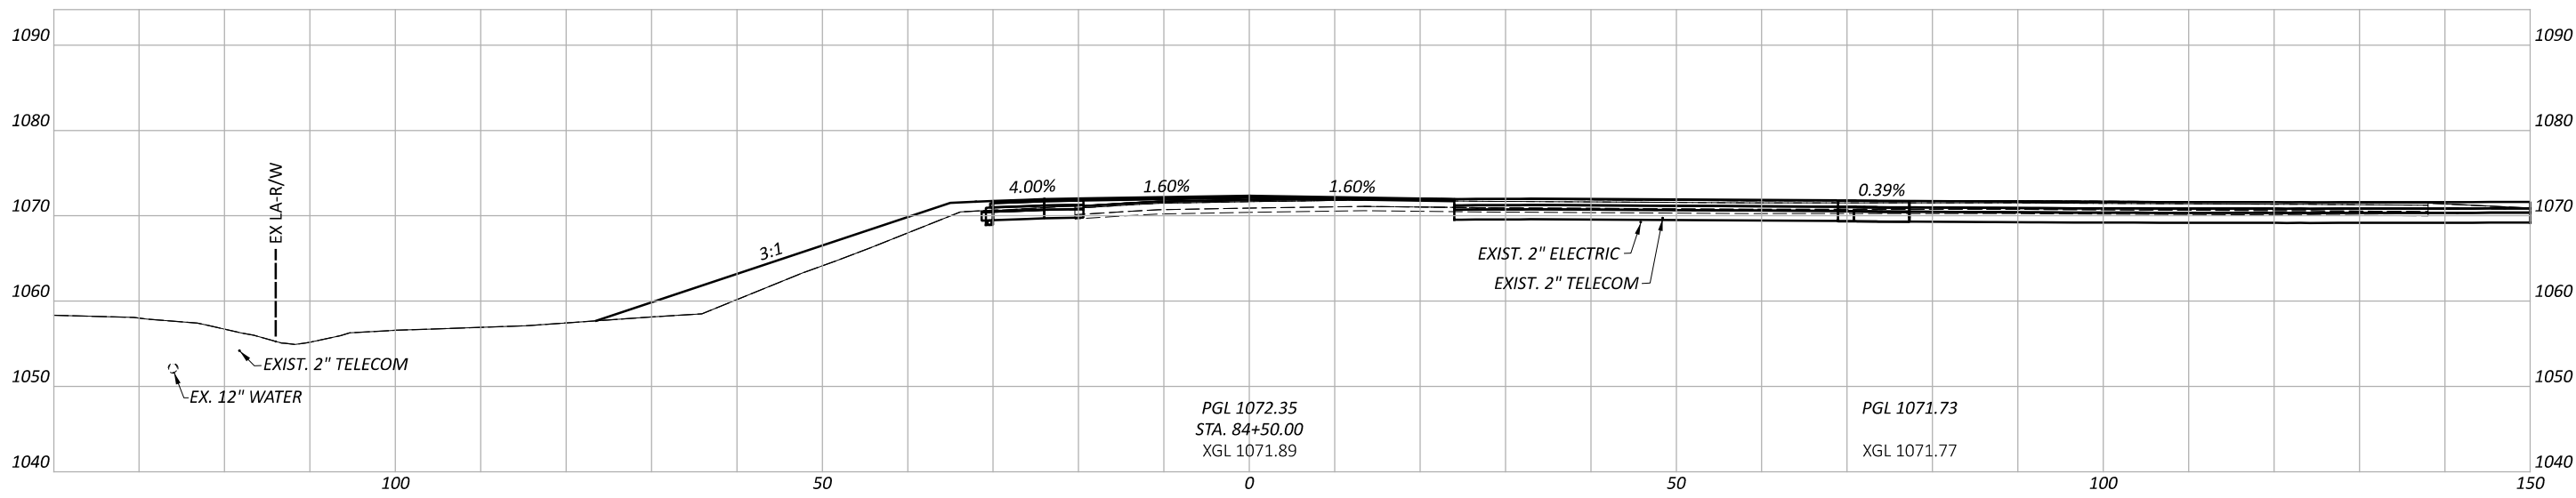

PGL 1072.35
 STA. 84+50.00
 XGL 1071.89

PGL 1071.73
 XGL 1071.77

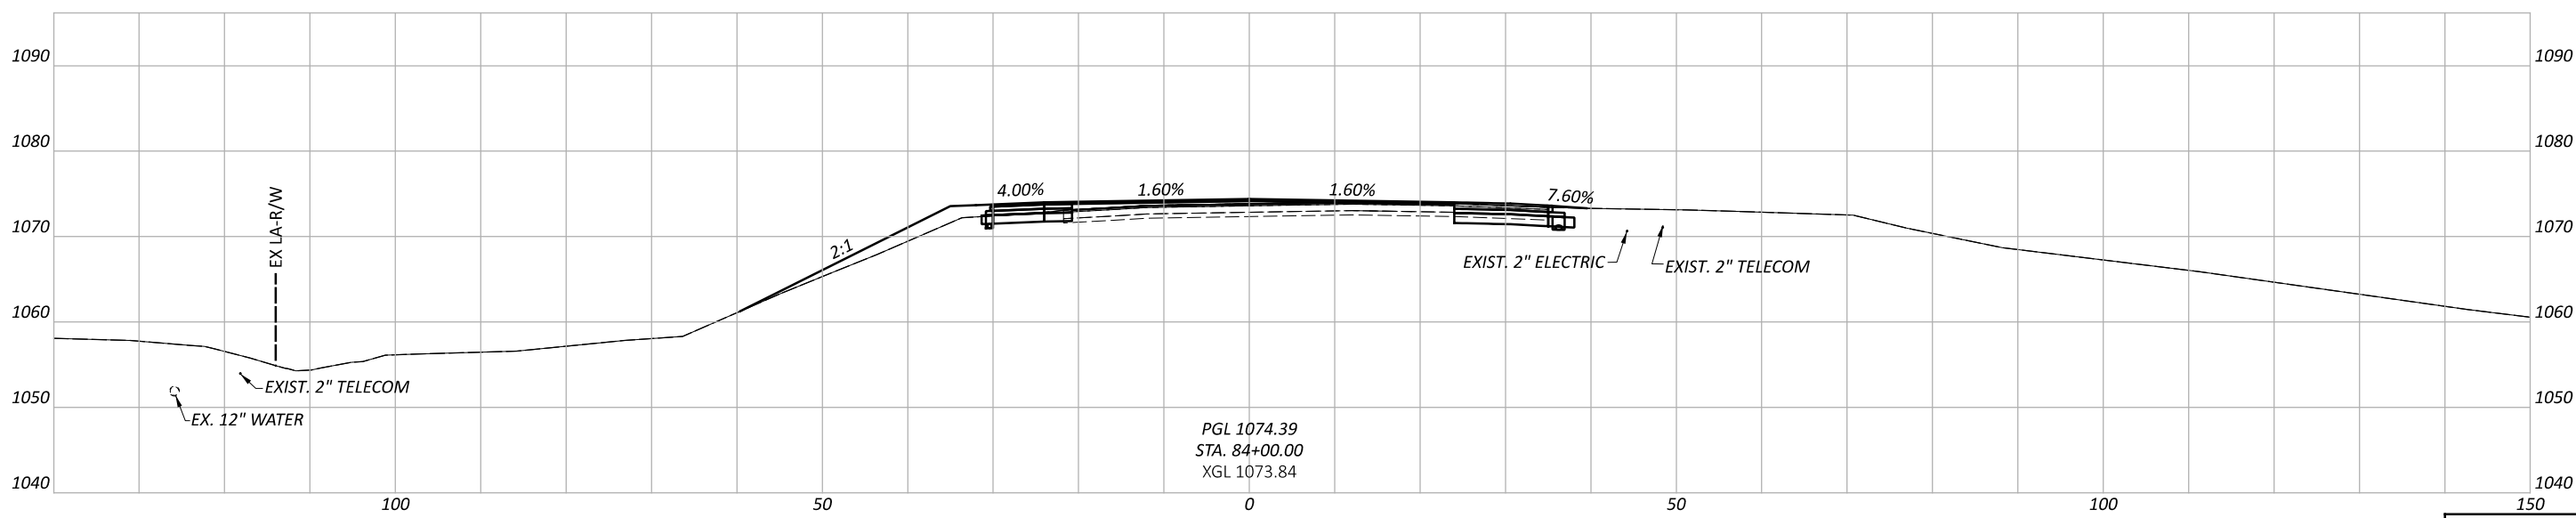




PGL 1074.39
 STA. 84+00.00
 XGL 1073.84

CROSS SECTIONS - SR 435
 STA. 84+00.00 TO STA. 85+00.00

DESIGN AGENCY
Palmer
 ENGINEERING
 8350 E. KEMPER RD.
 SUITE B
 CINCINNATI, OH 45249
 513-469-1600

DESIGNER
 DPF
 REVIEWER
 DCJ MM-DD-YY
 PROJECT ID

Sheet Totals			117955	
Seeding	Cut	Fill	SHEET	TOTAL
			P. 144	228

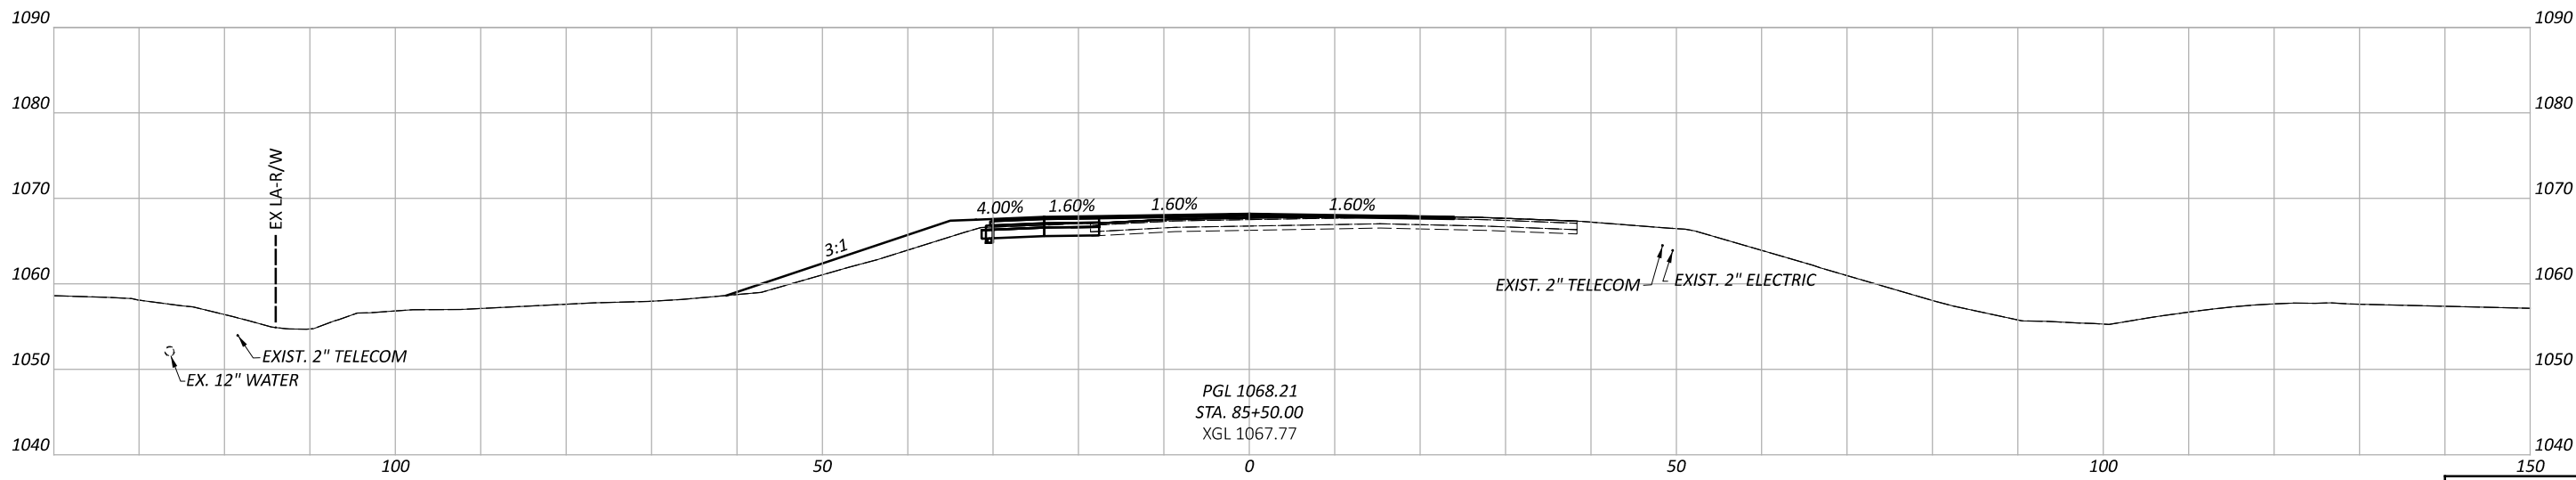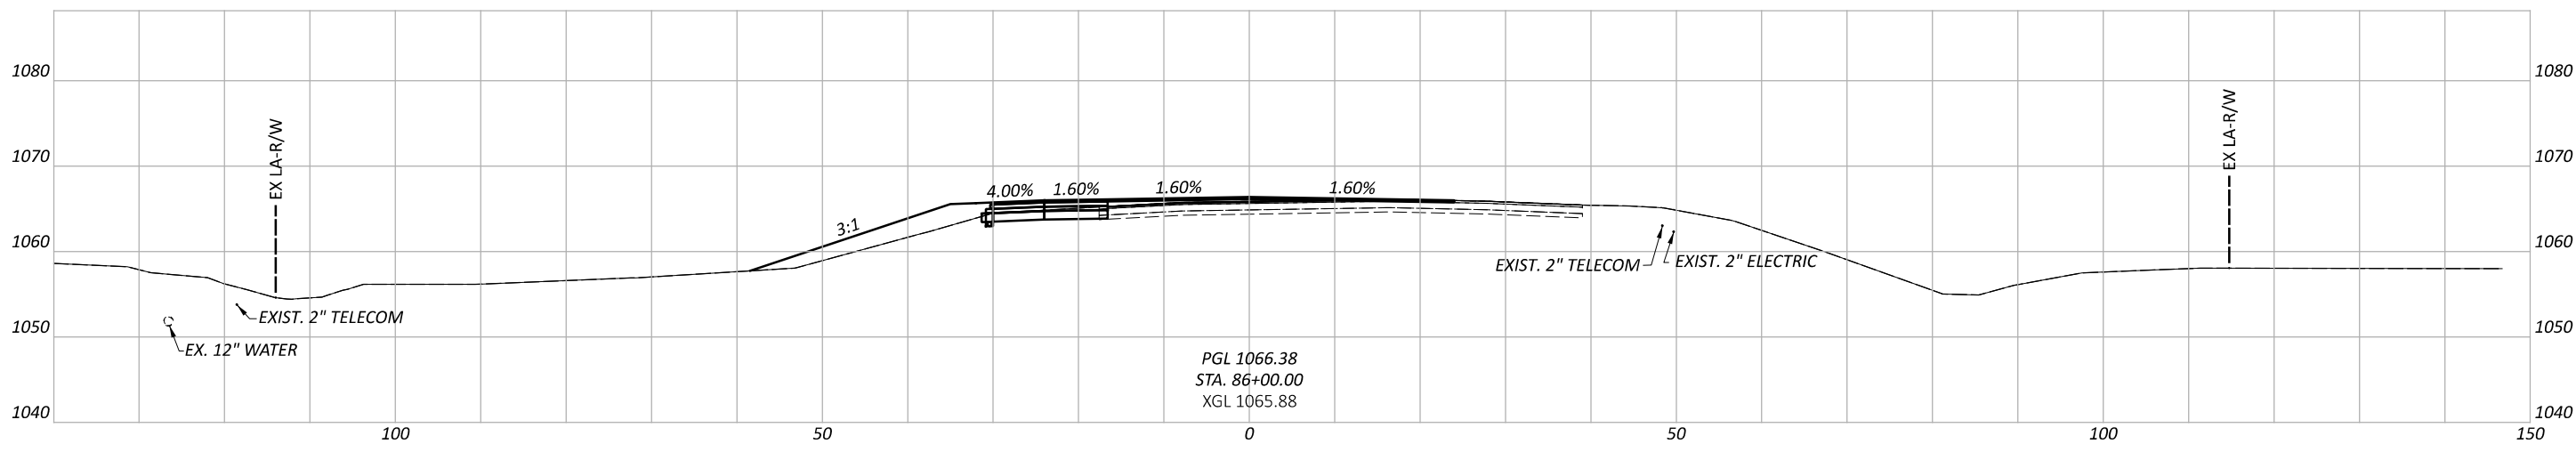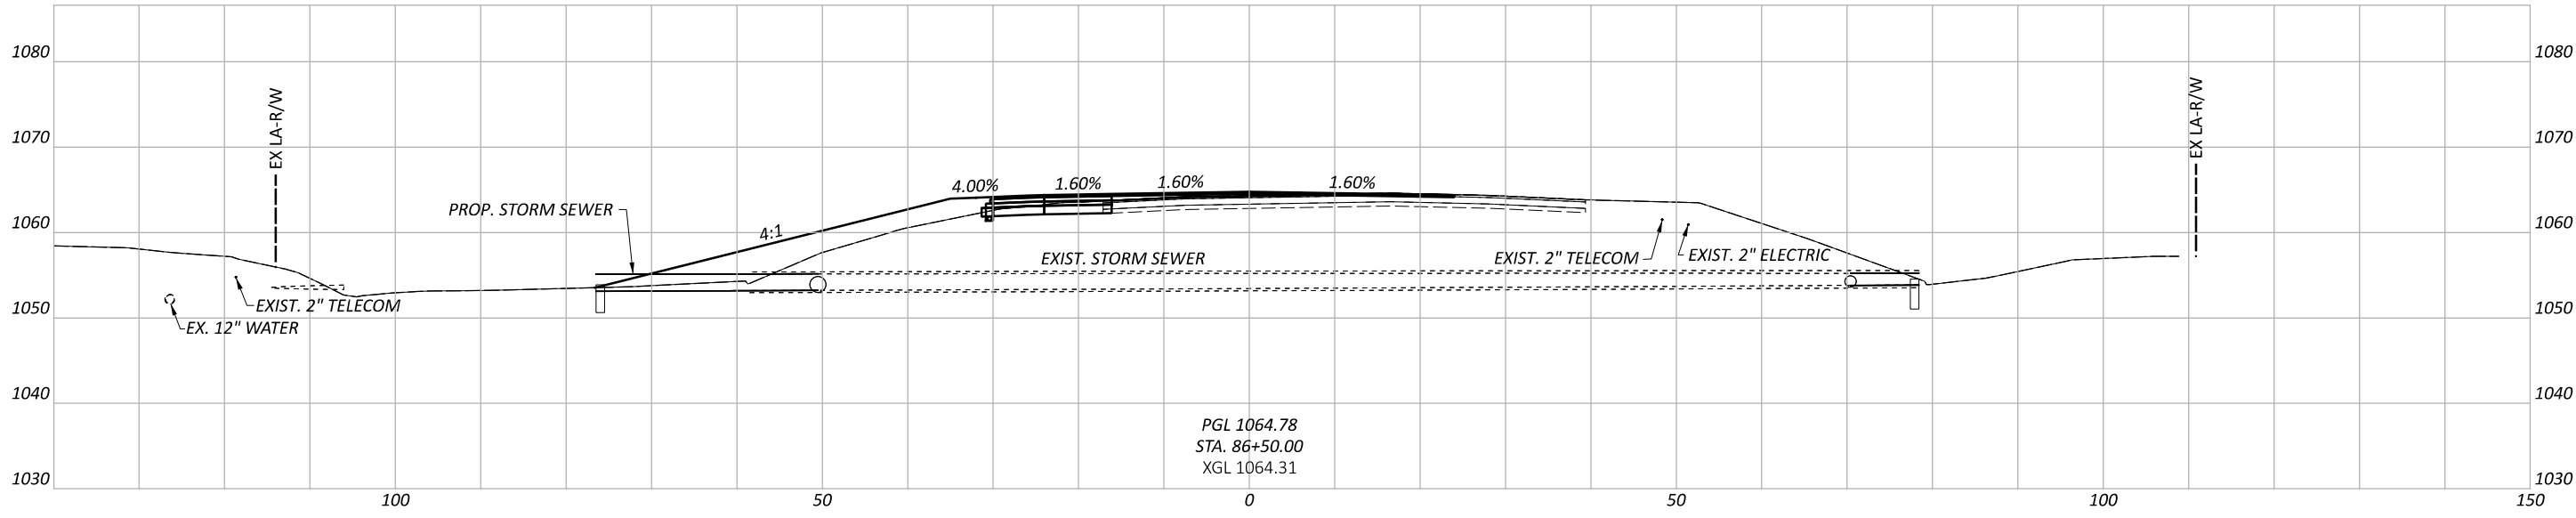

CROSS SECTIONS - SR 435
 STA. 85+50.00 TO STA. 86+50.00

DESIGN AGENCY




Palmer
 ENGINEERING
 8350 E. KEMPER RD.
 SUITE B
 CINCINNATI, OH 45249
 513-469-1600

DESIGNER
 DPF

REVIEWER
 DCJ MM-DD-YY

PROJECT ID
 117955

Sheet Totals			TOTAL
Seeding	Cut	Fill	P. 145 228

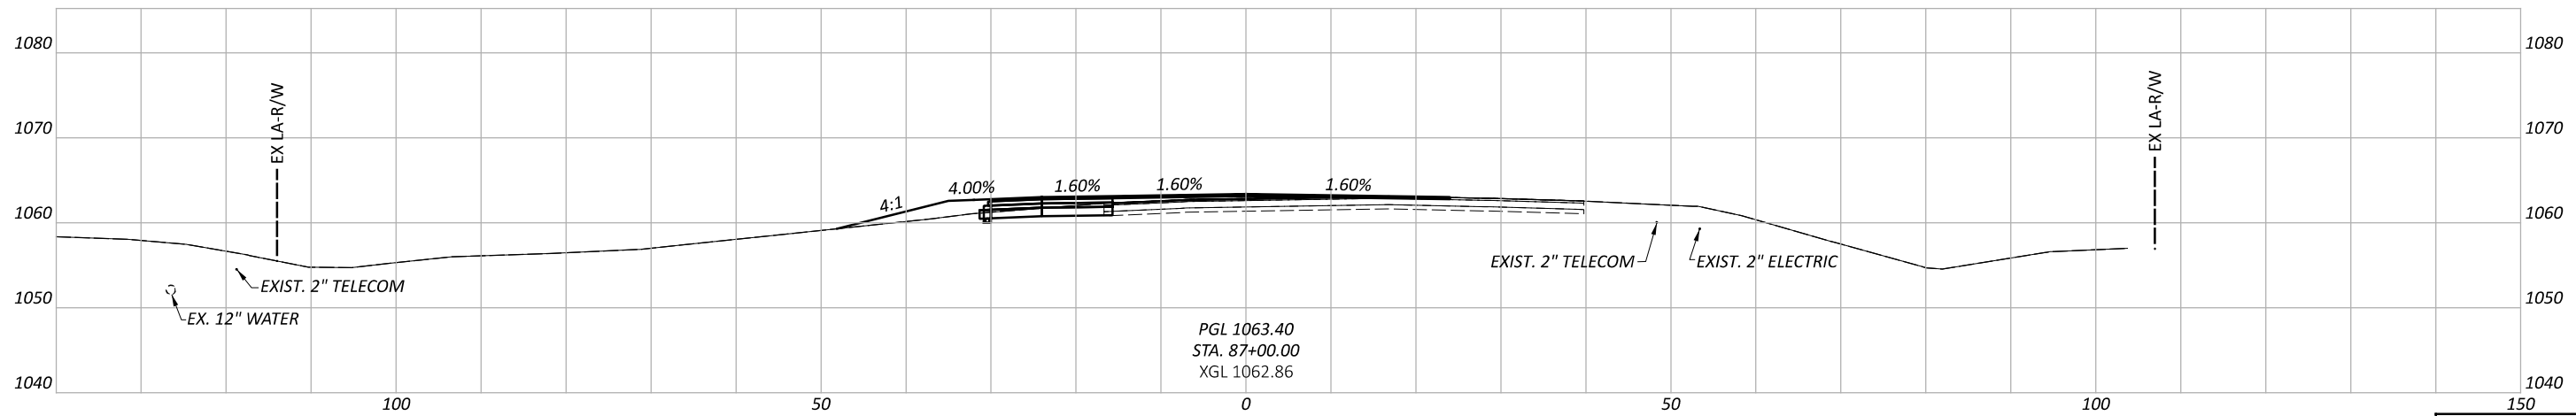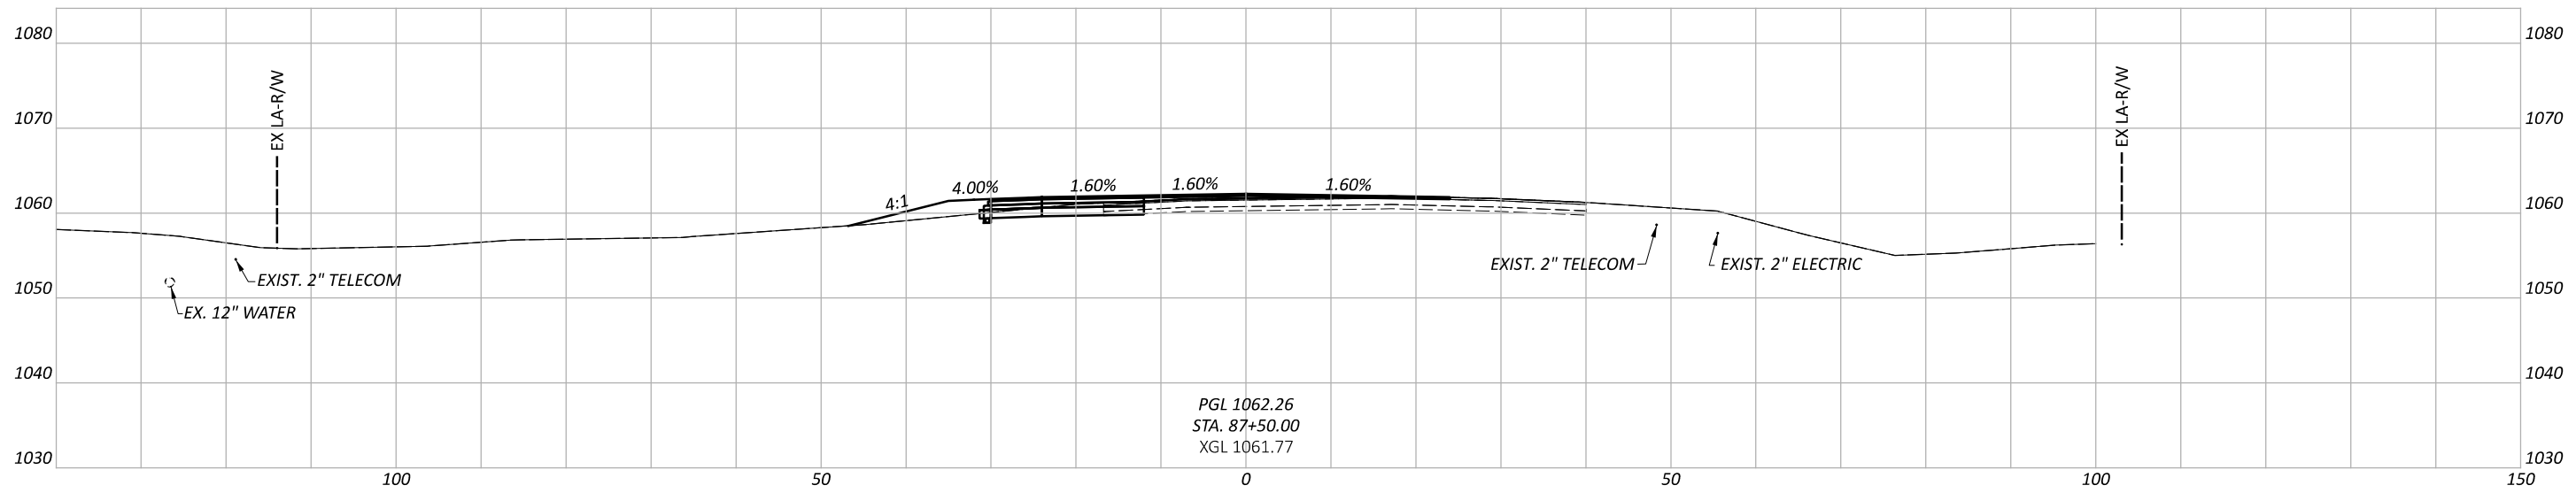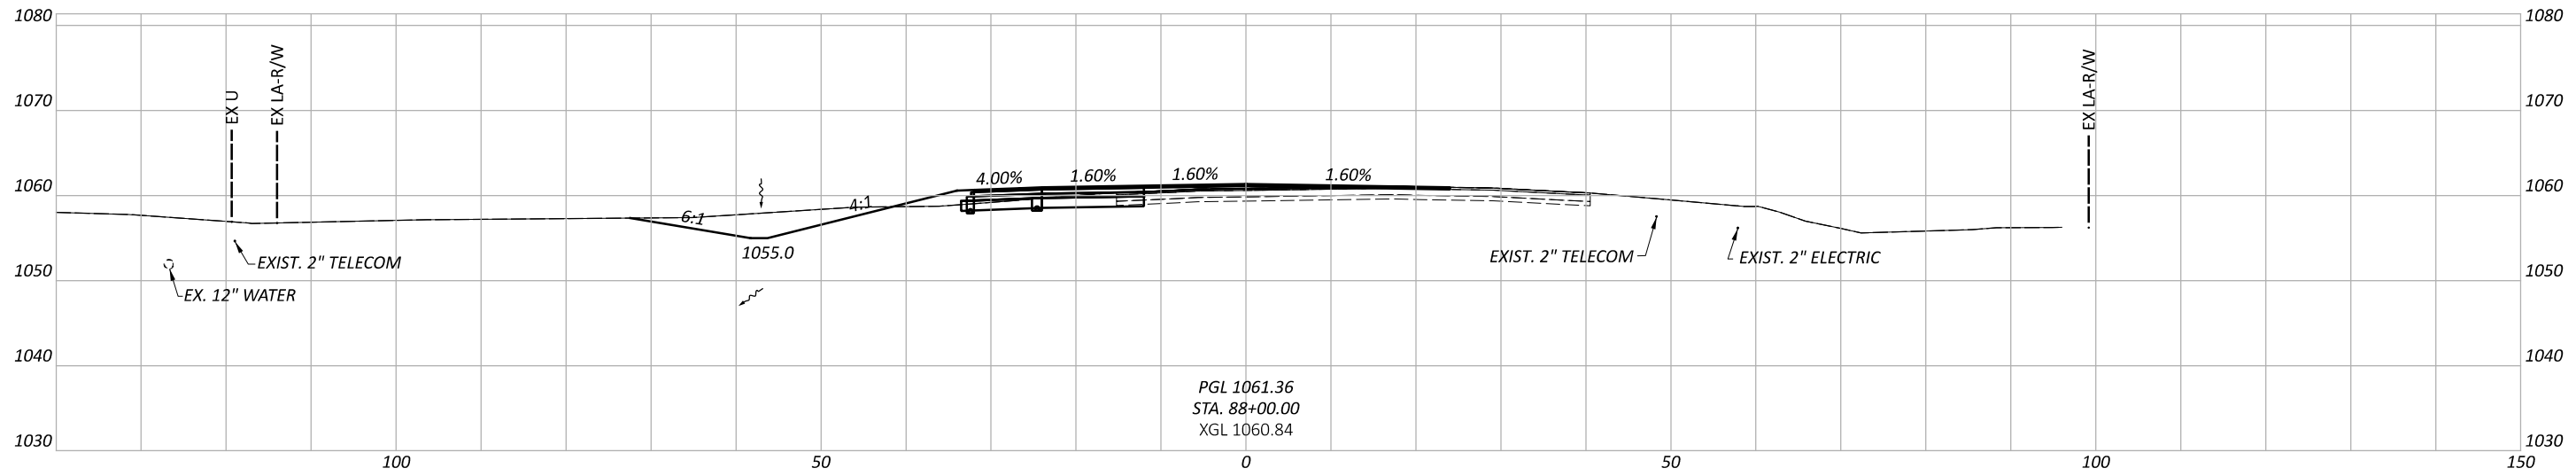

CROSS SECTIONS - SR 435
 STA. 87+00.00 TO STA. 88+00.00

DESIGN AGENCY



DESIGNER

DPF

REVIEWER

DCJ MM-DD-YY

PROJECT ID


117955

Sheet Totals

Seeding	Cut	Fill

SHEET TOTAL

P. 146 228

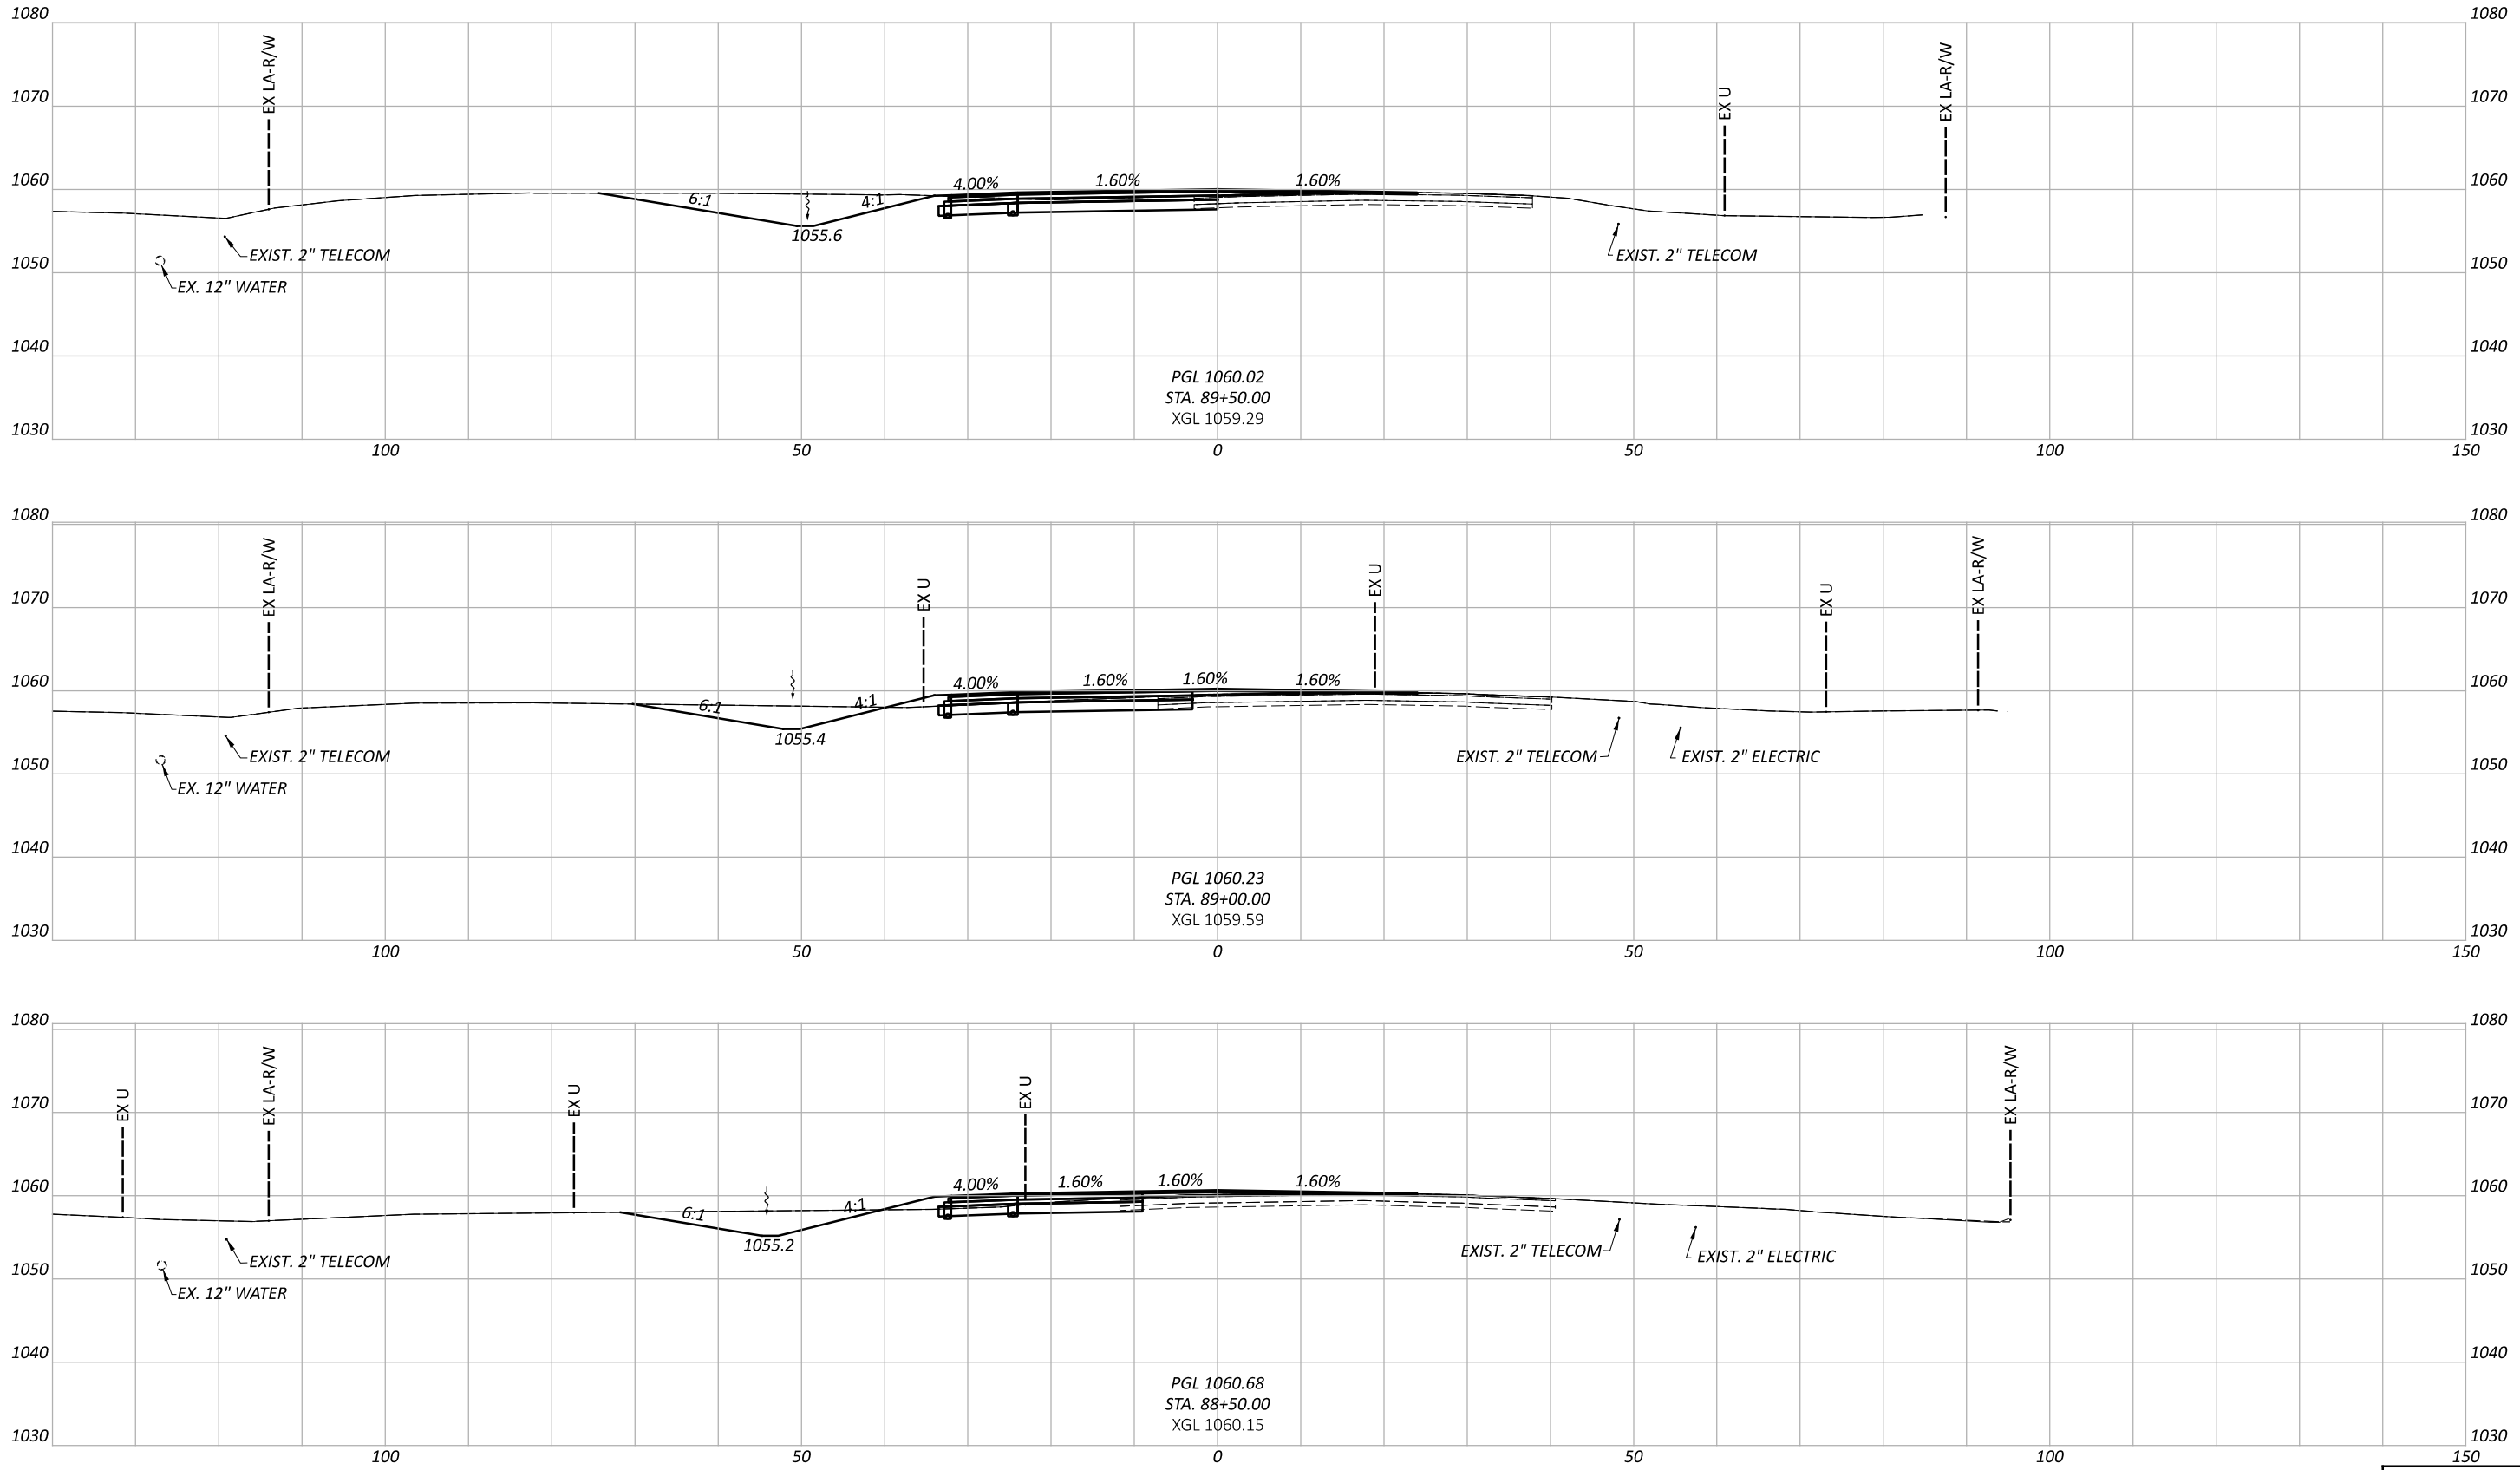


CROSS SECTIONS - SR 435
 STA. 88+50.00 TO STA. 89+00.00

DESIGN AGENCY
Palmer
 ENGINEERING
 8350 E. KEMPER RD.
 SUITE B
 CINCINNATI, OH 45249
 513-469-1600

DESIGNER
 DPF
 REVIEWER
 DCJ MM-DD-YY

PROJECT ID
 117955
 SHEET TOTAL
 P. 147 228

Sheet Totals		
Seeding	Cut	Fill

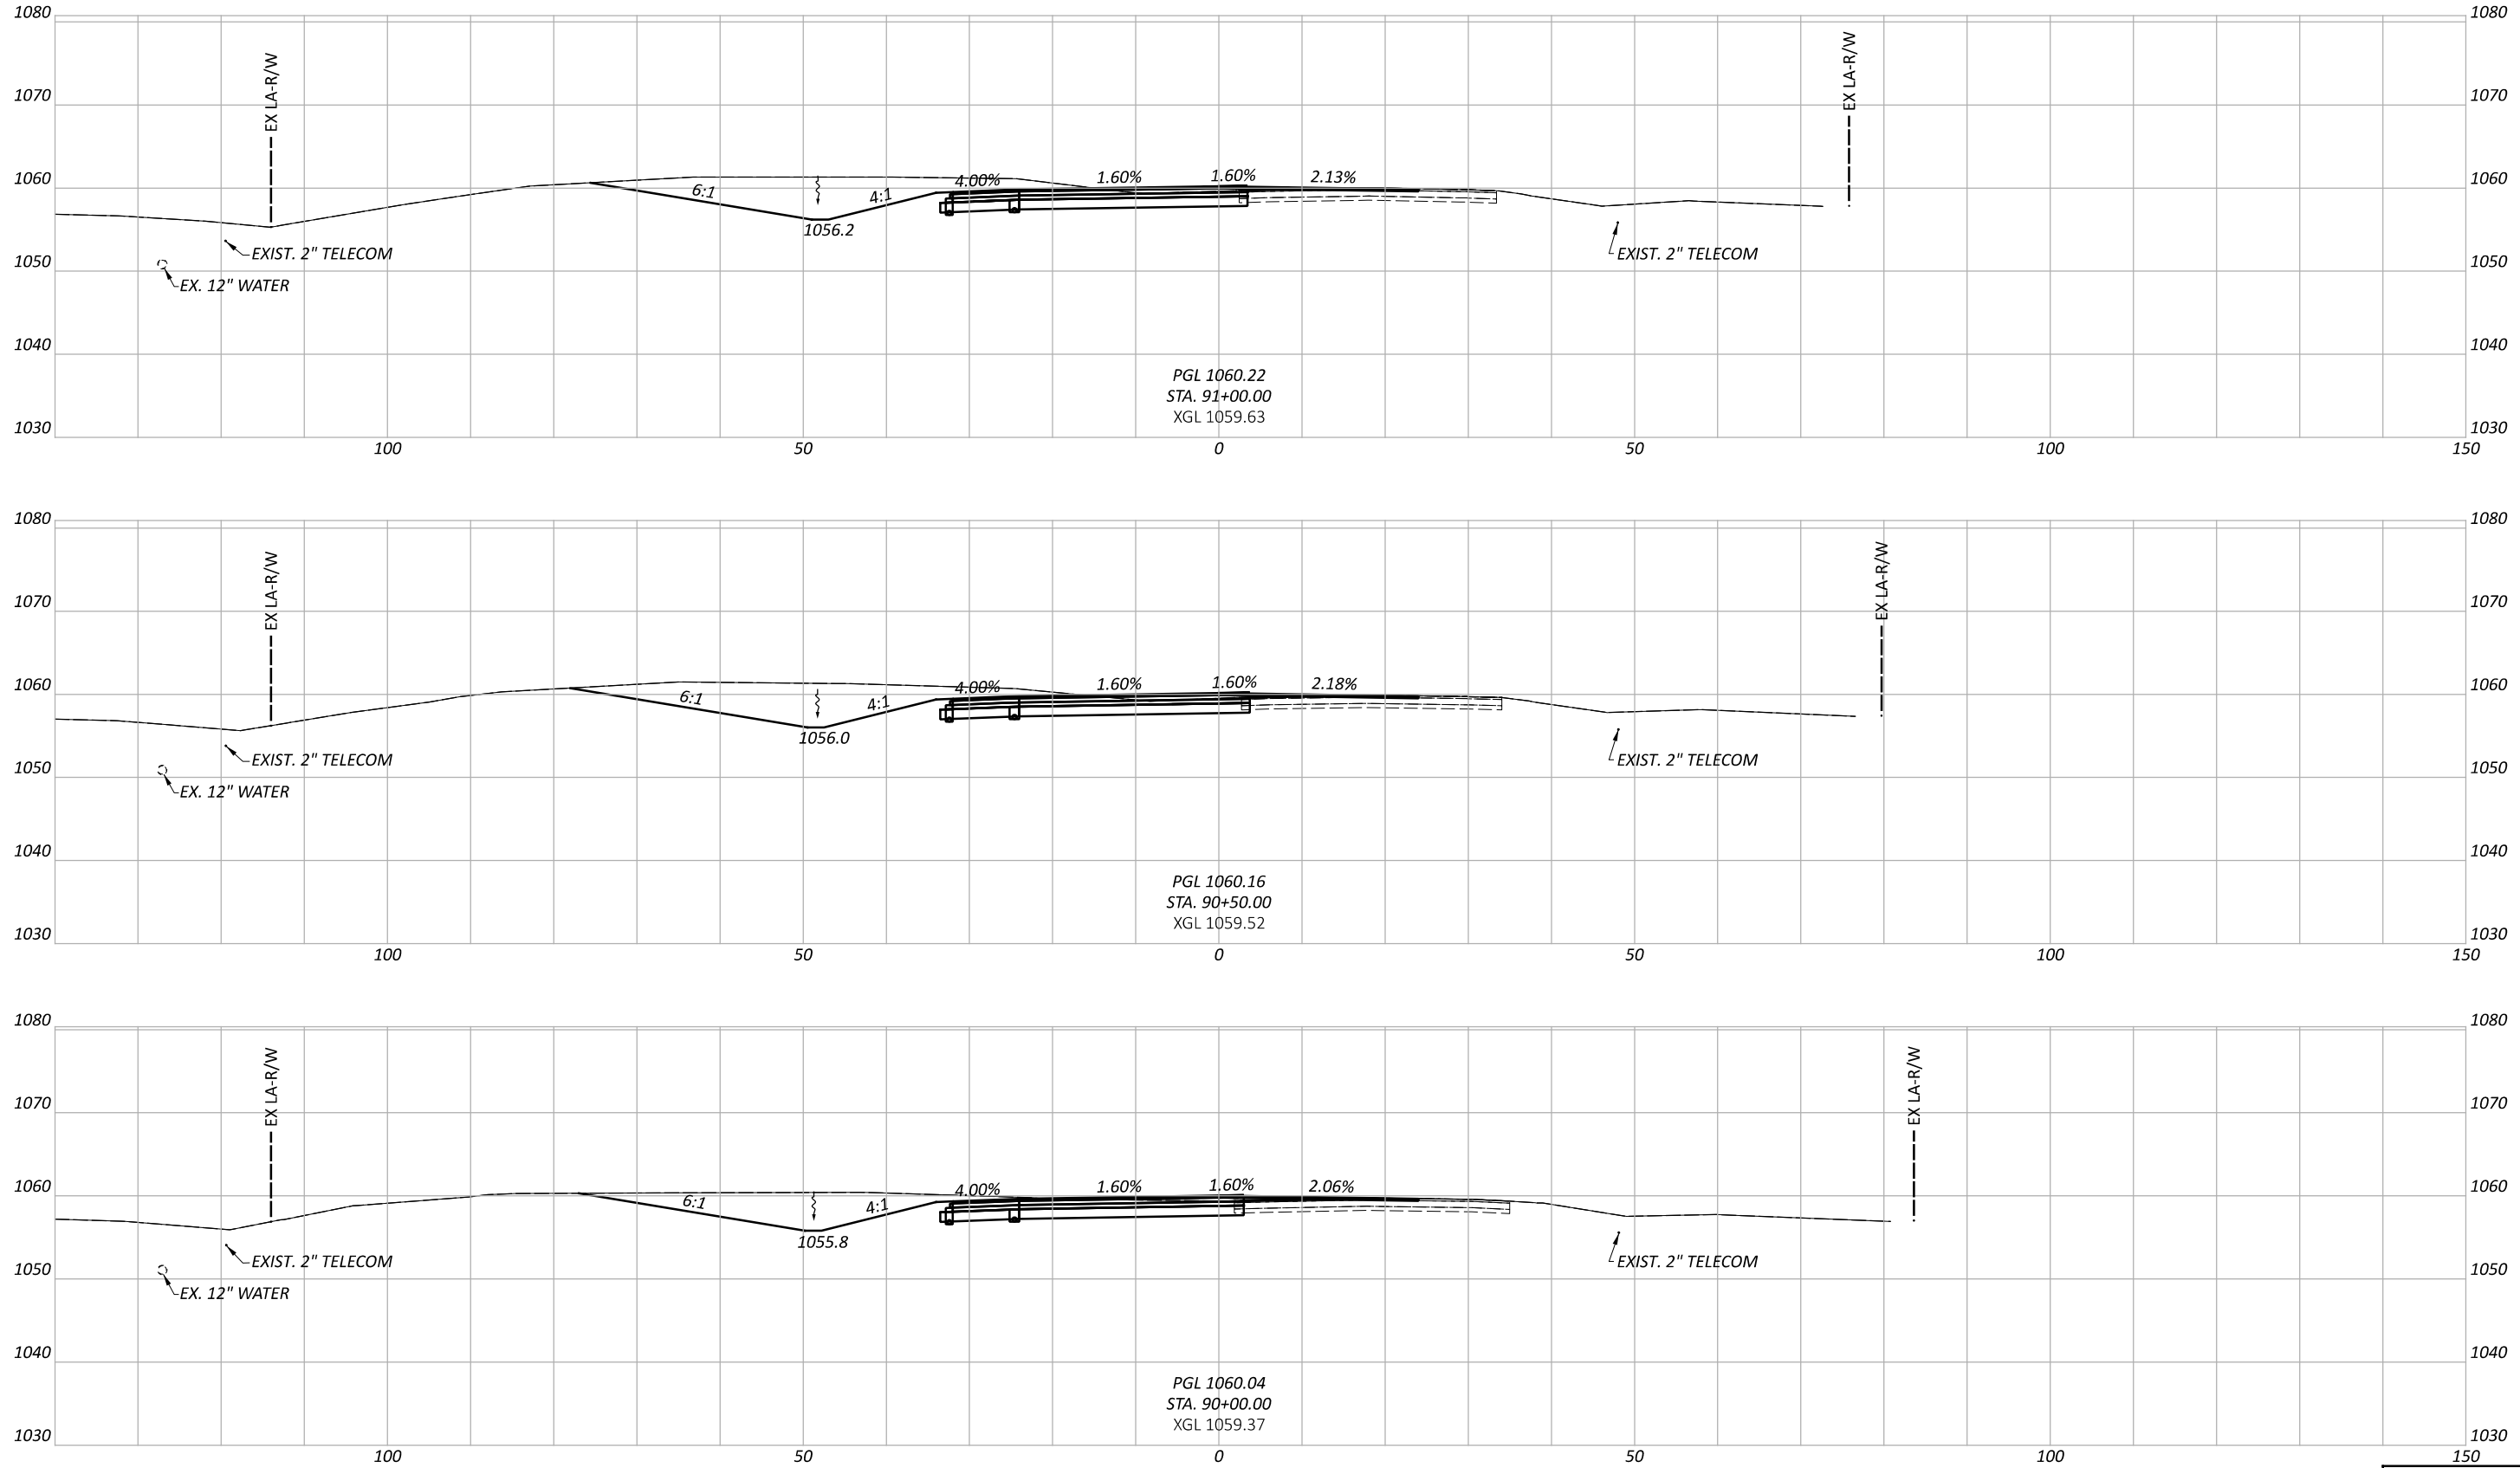


CROSS SECTIONS - SR 435
 STA. 90+00.00 TO STA. 91+00.00


DESIGN AGENCY
Palmer
 ENGINEERING
 8350 E. KEMPER RD.
 SUITE B
 CINCINNATI, OH 45249
 513-469-1600

DESIGNER
 DPF
 REVIEWER
 DCJ MM-DD-YY
 PROJECT ID


Sheet Totals			117955
Seeding	Cut	Fill	TOTAL
			P. 148 228

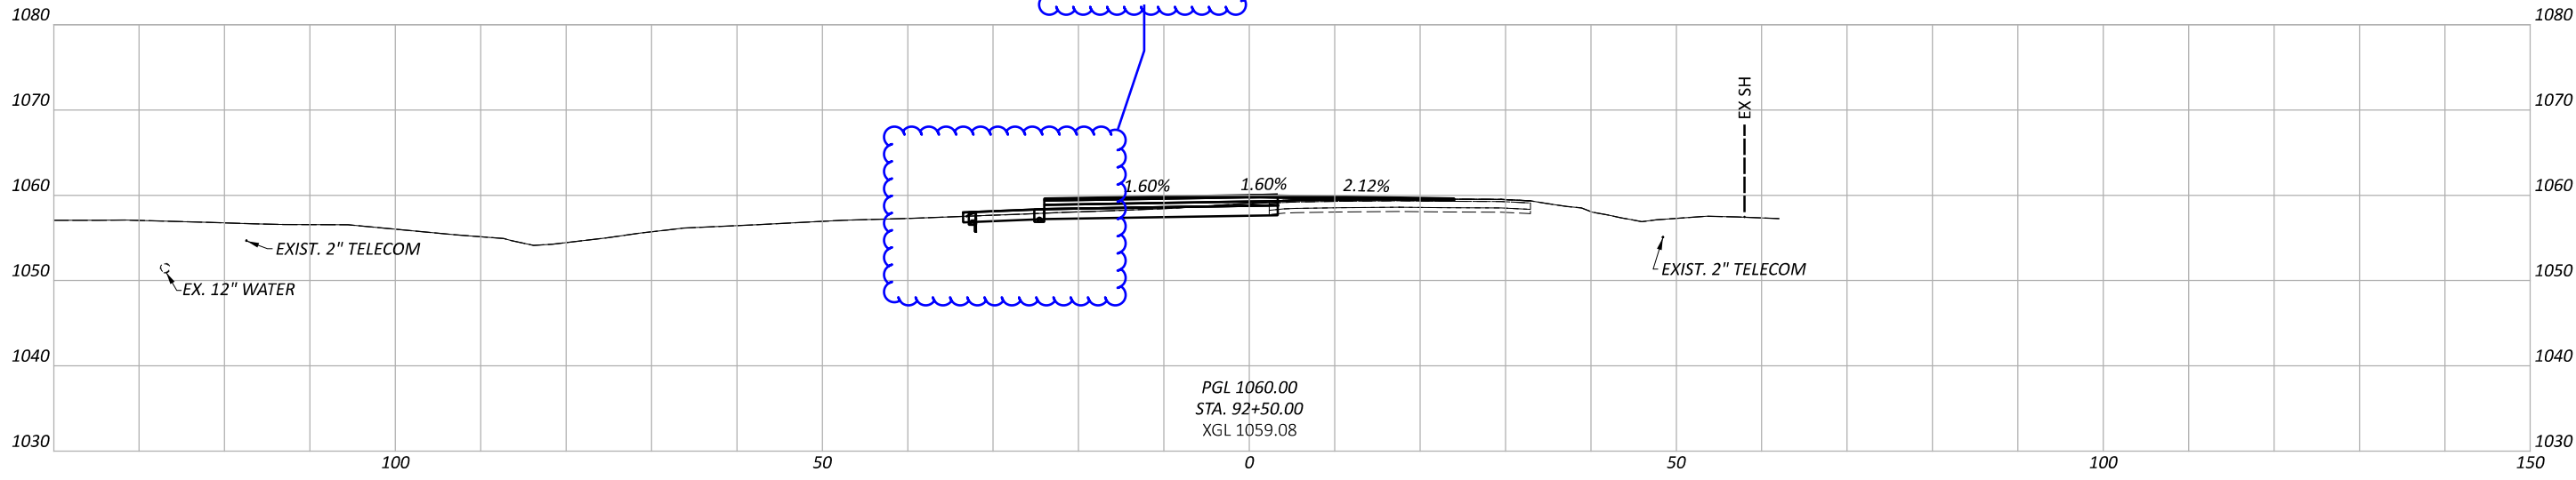

PGL 1060.00
 STA. 92+50.00
 XGL 1059.08

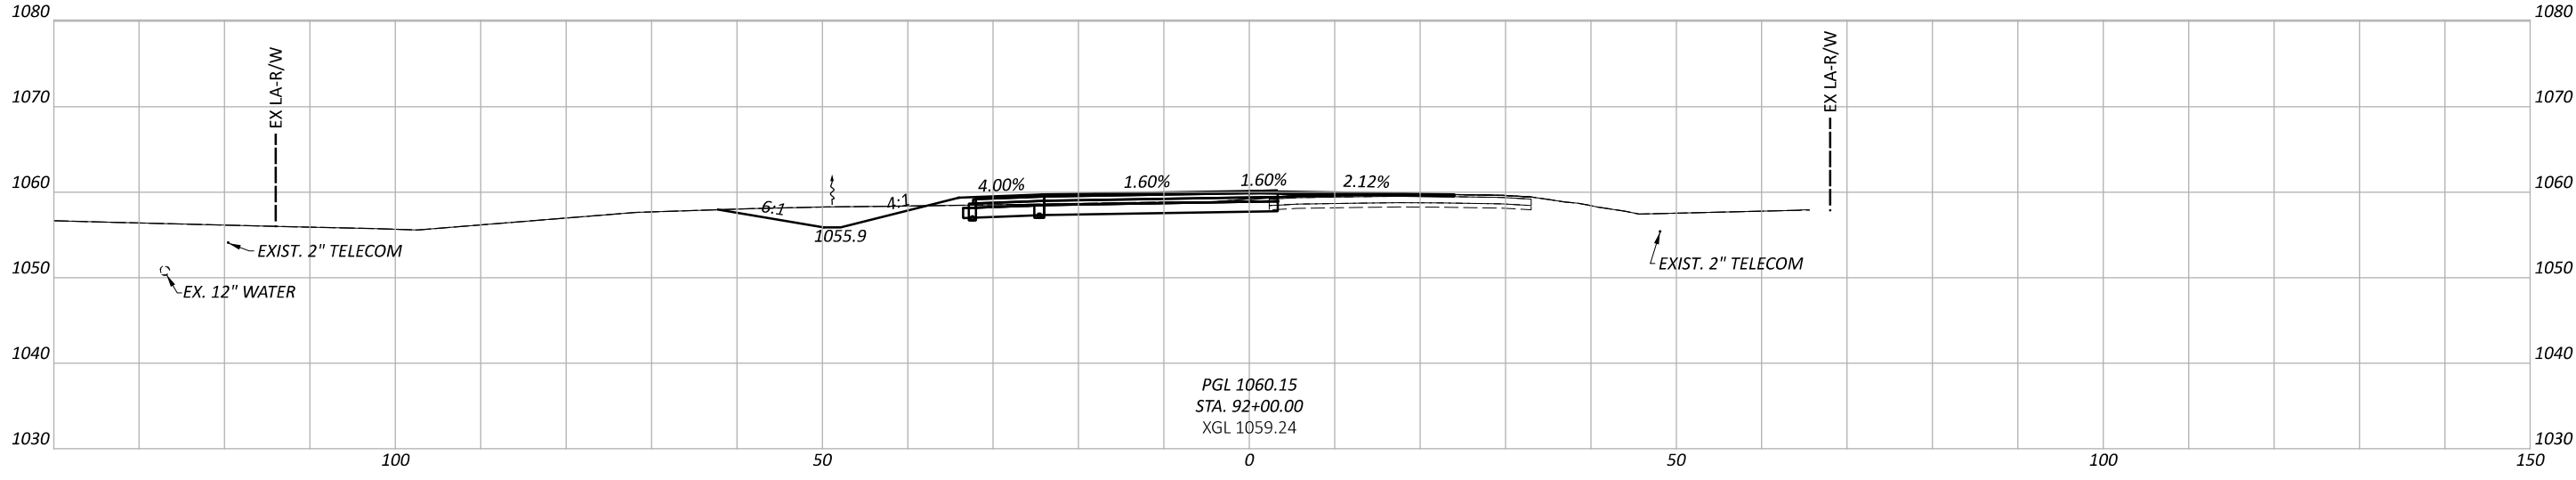

PGL 1060.15
 STA. 92+00.00
 XGL 1059.24

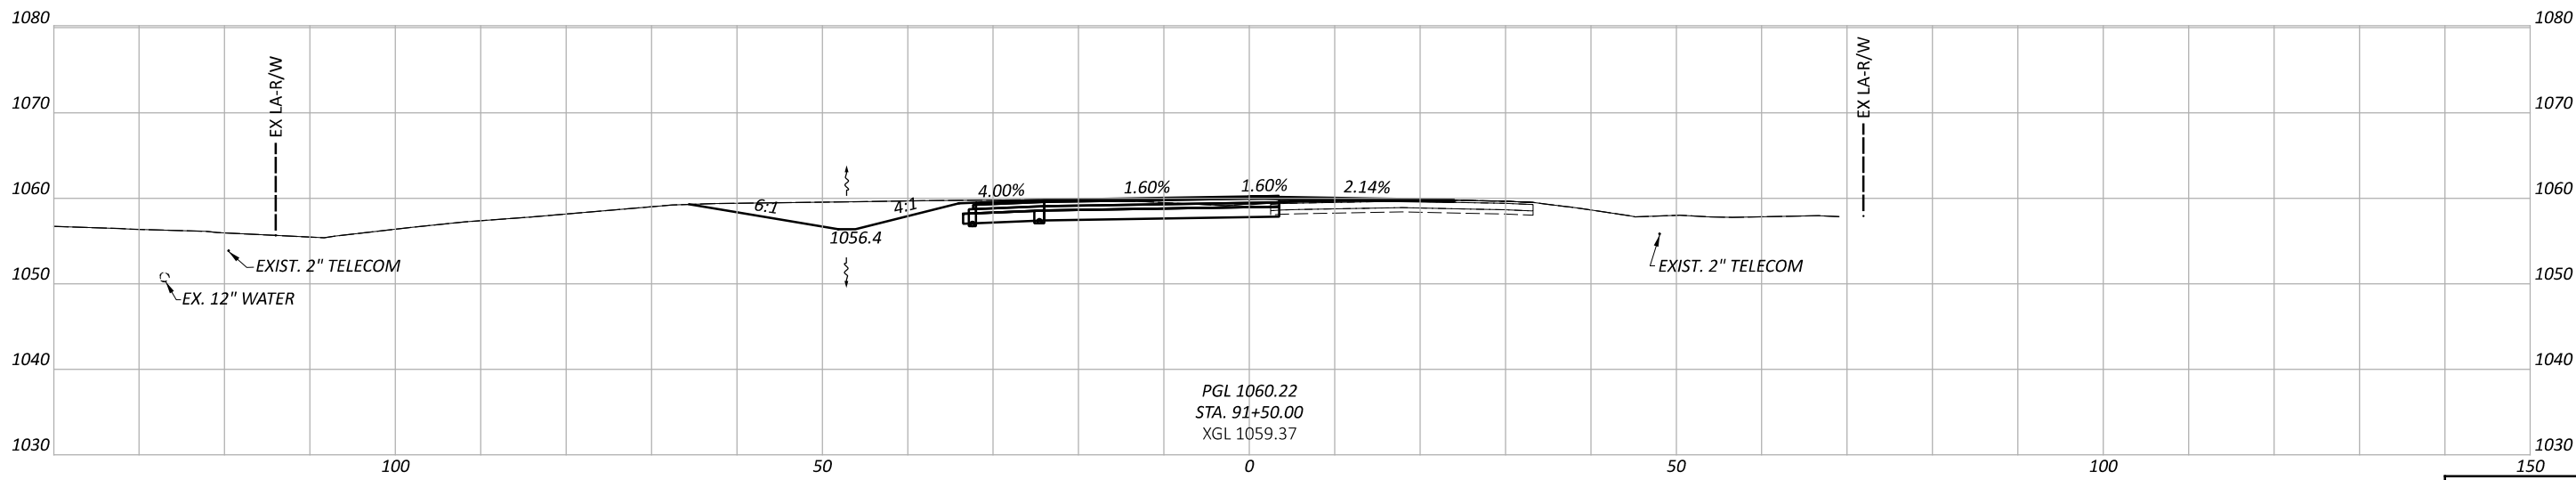




PGL 1060.22
 STA. 91+50.00
 XGL 1059.37

CROSS SECTIONS - SR 435
 STA. 91+50.00 TO STA. 92+50.00

DESIGN AGENCY
Palmer
 ENGINEERING
 8350 E. KEMPER RD.
 SUITE B
 CINCINNATI, OH 45249
 513-469-1600

DESIGNER
DPF
 REVIEWER
DCJ MM-DD-YY

Sheet Totals			117955
Seeding	Cut	Fill	TOTAL
			P. 149 228

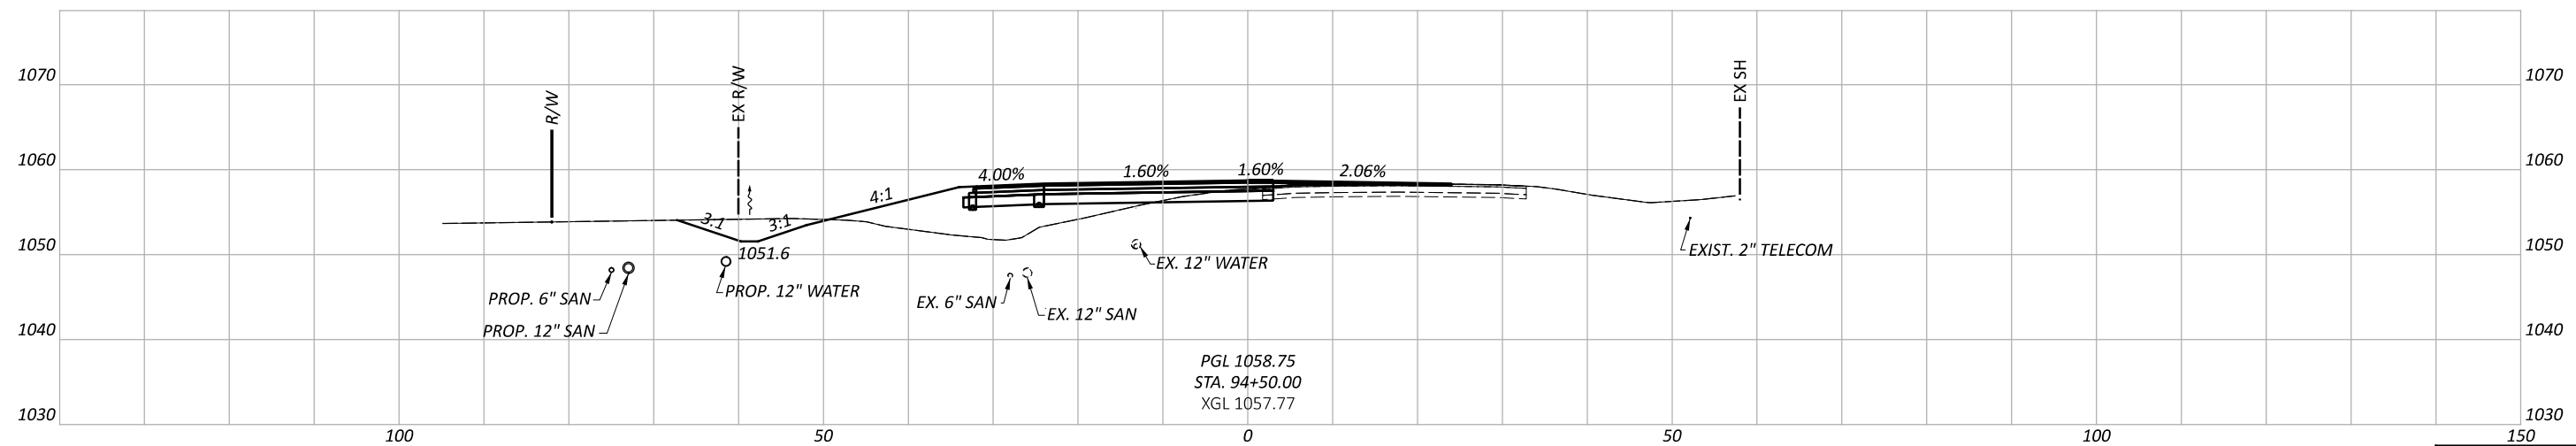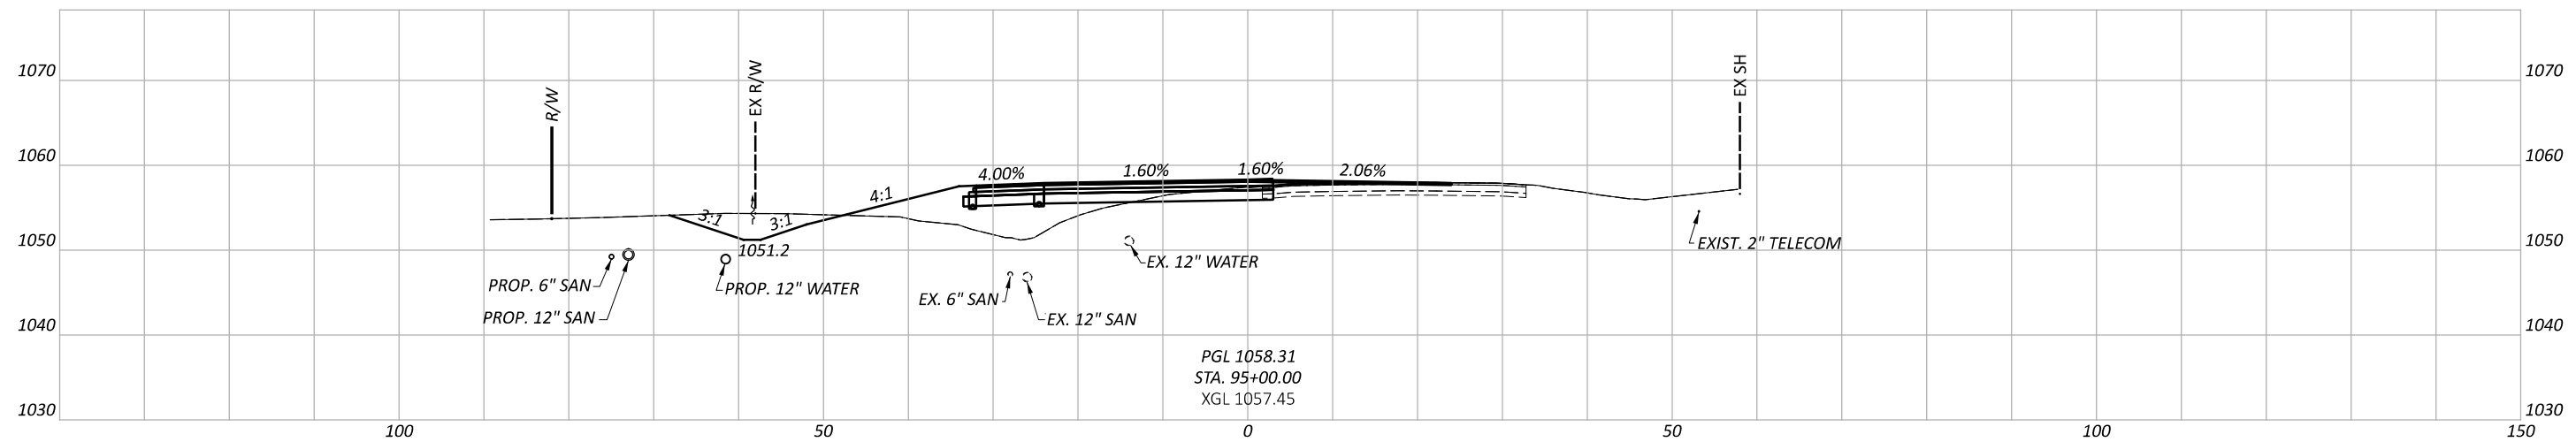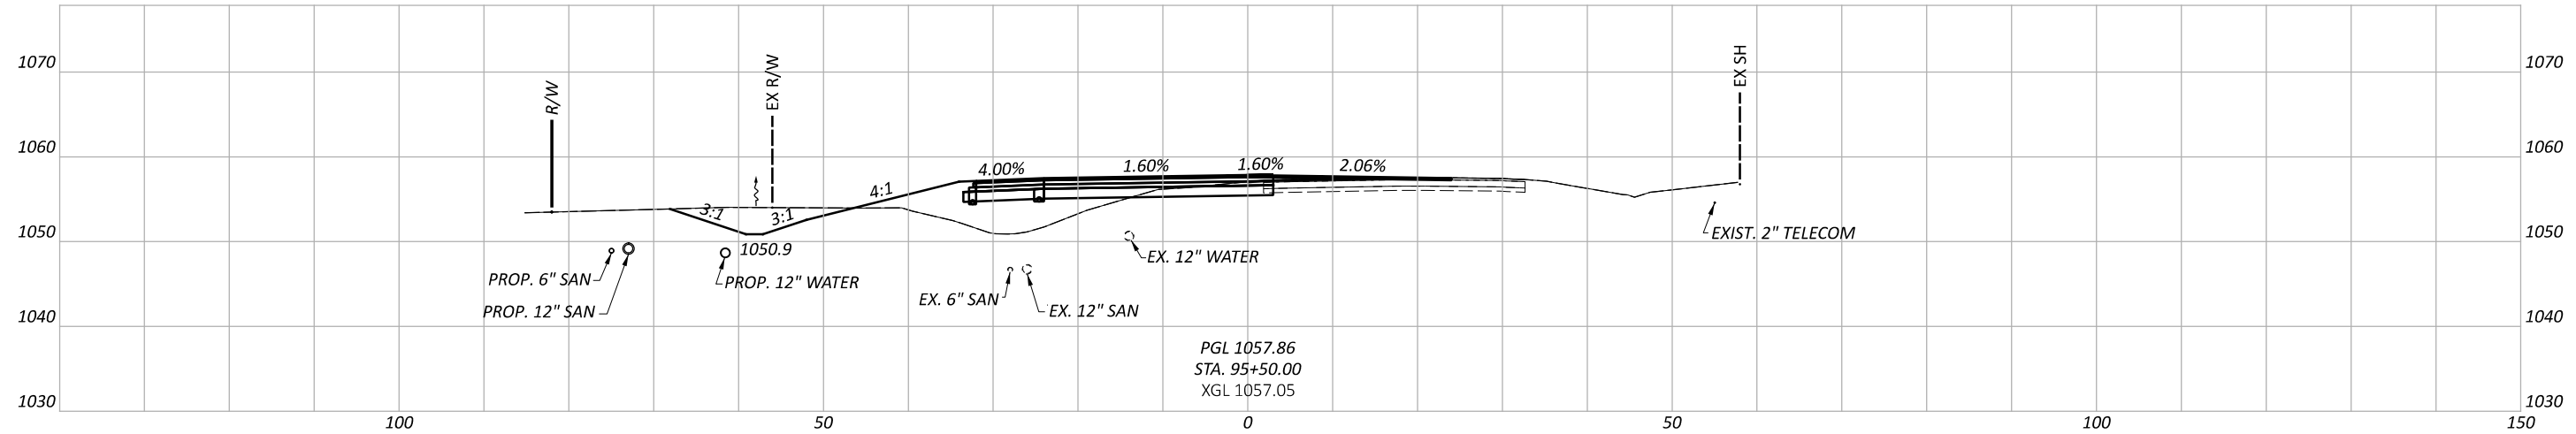

CROSS SECTIONS - SR 435
 STA. 94+50.00 TO STA. 95+50.00




DESIGN AGENCY

Palmer
 ENGINEERING
 8350 E. KEMPER RD.
 SUITE B
 CINCINNATI, OH 45249
 513-469-1600

DESIGNER
 DPF
 REVIEWER
 DCJ MM-DD-YY

PROJECT ID
 117955
 SHEET TOTAL
 P. 151 228

Sheet Totals		
Seeding	Cut	Fill

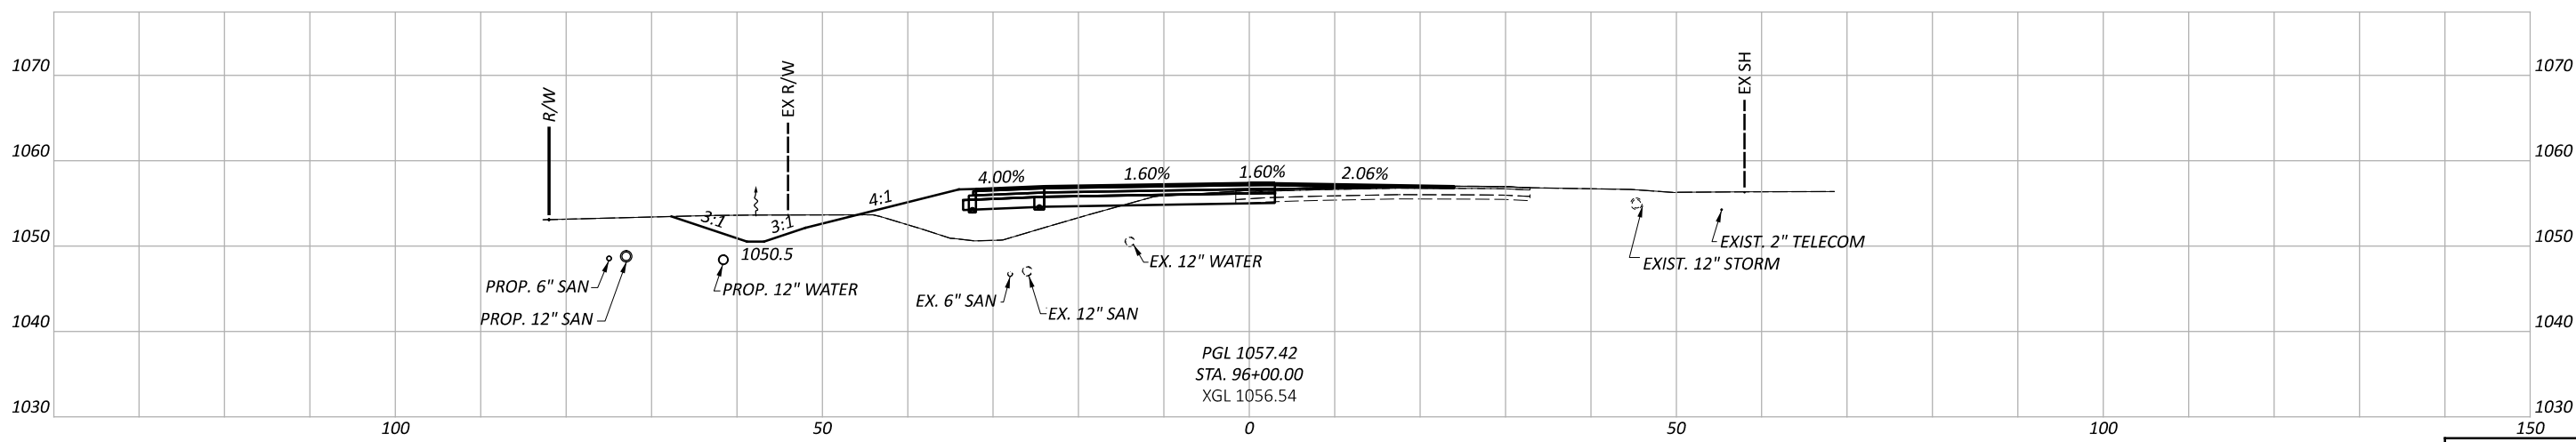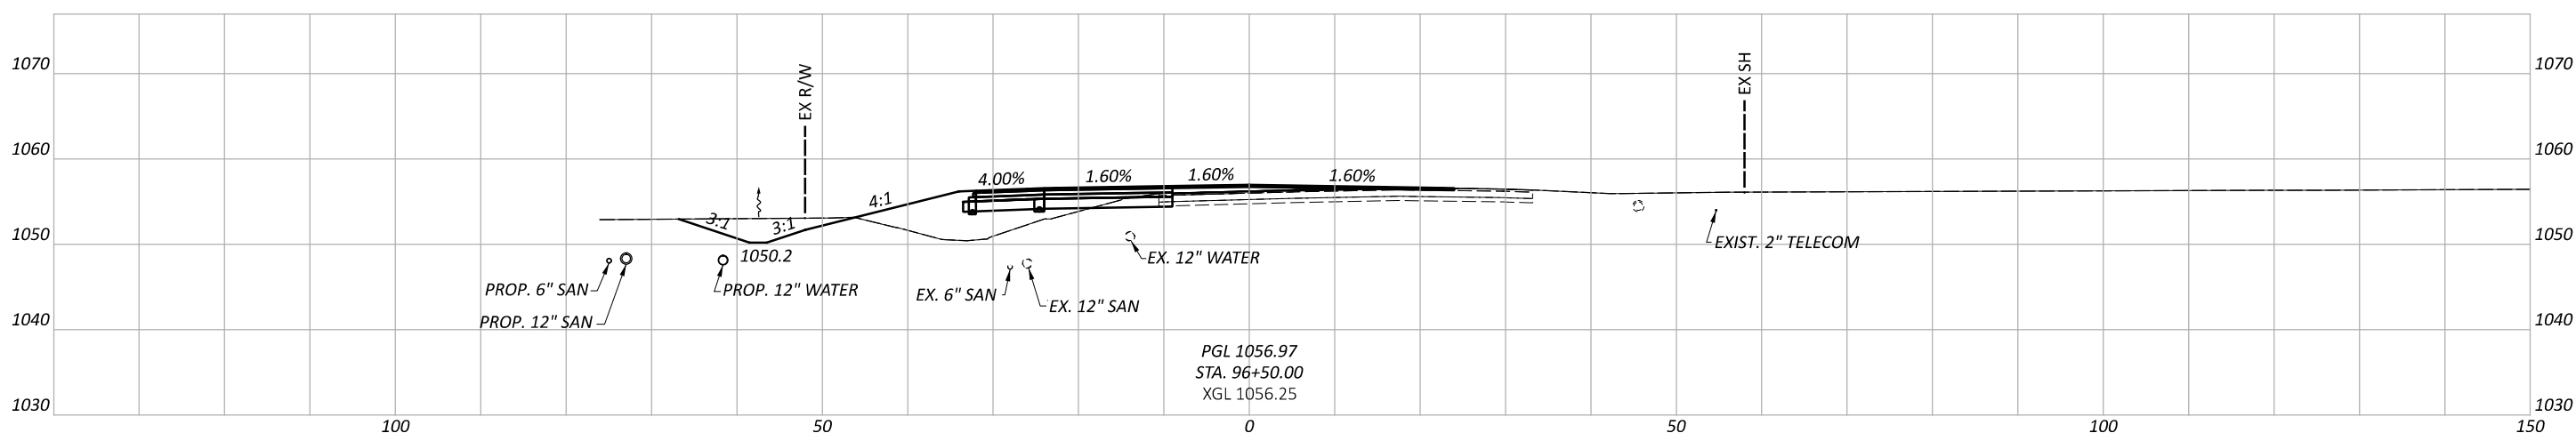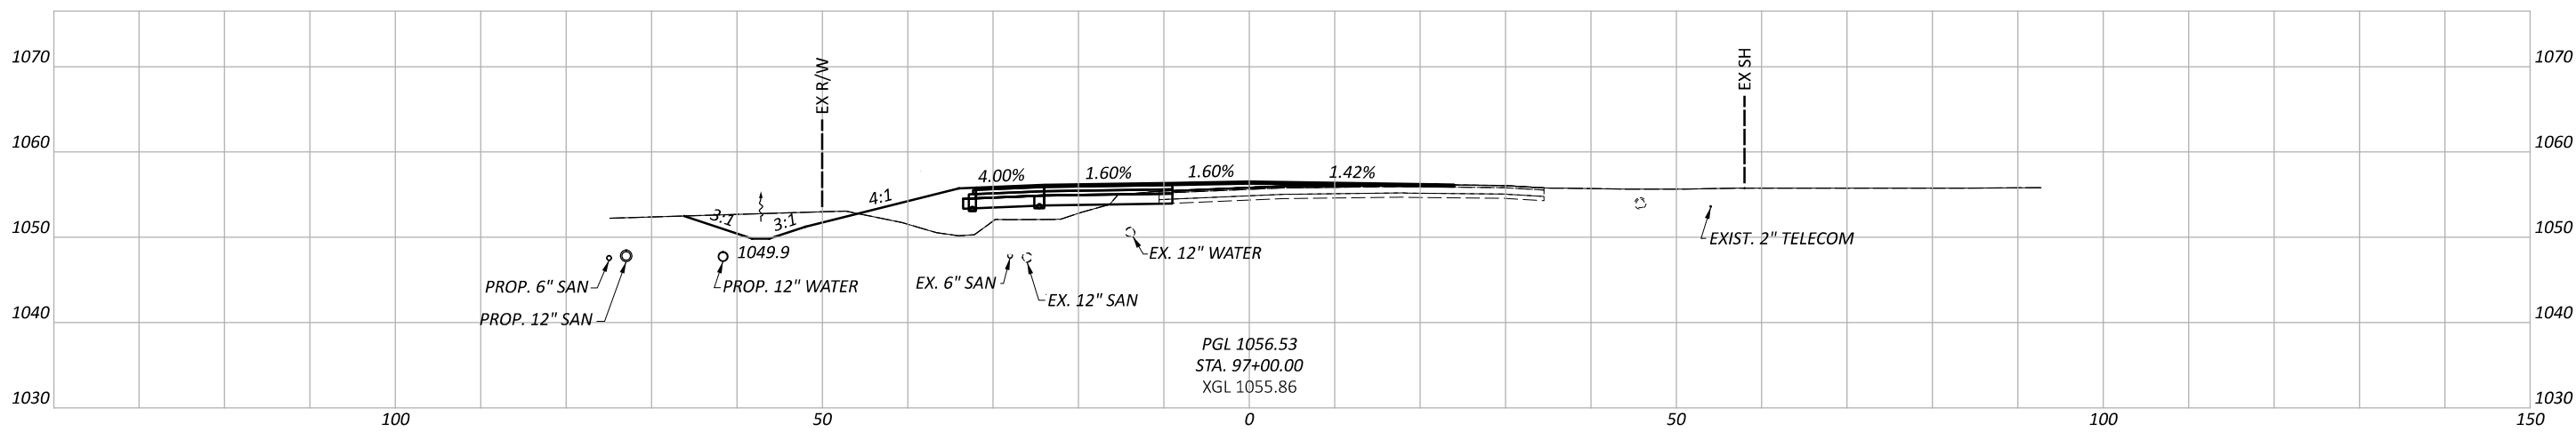

CROSS SECTIONS - SR 435
 STA. 96+00.00 TO STA. 97+00.00

DESIGN AGENCY




Palmer
ENGINEERING
8350 E. KEMPER RD.
SUITE B
CINCINNATI, OH 45249
513-469-1600

DESIGNER
DPF

REVIEWER
DCJ MM-DD-YY

PROJECT ID
117955

Sheet Totals			TOTAL	
Seeding	Cut	Fill	SHEET	TOTAL
			P. 152	228

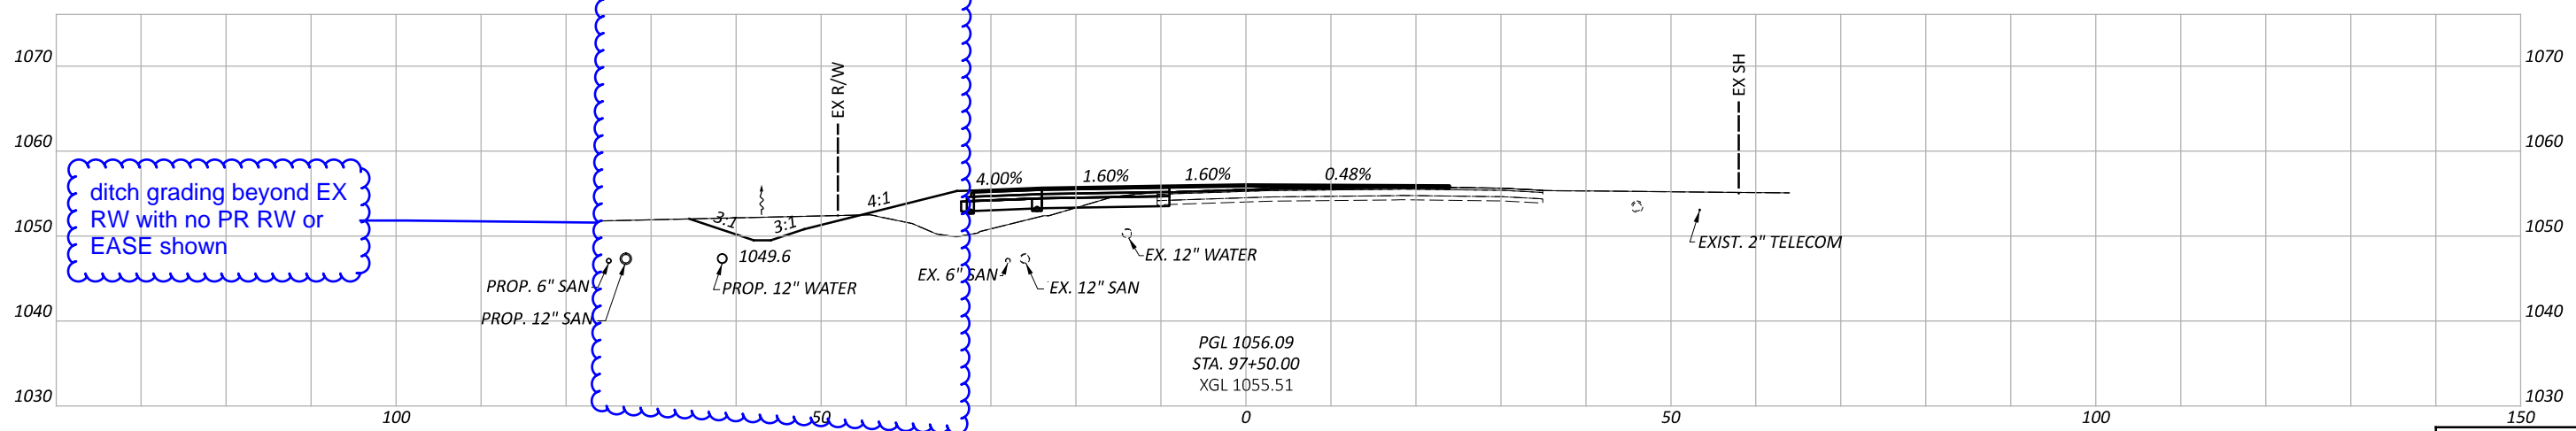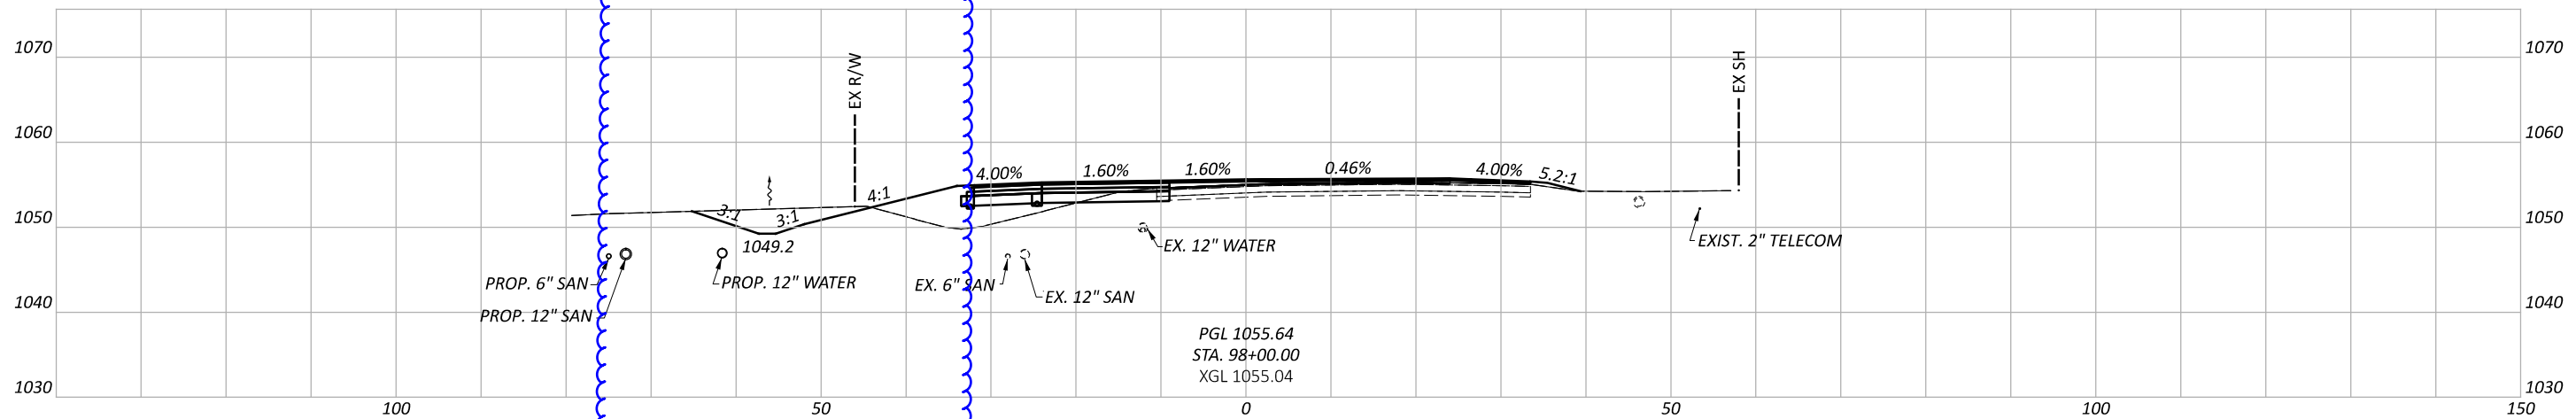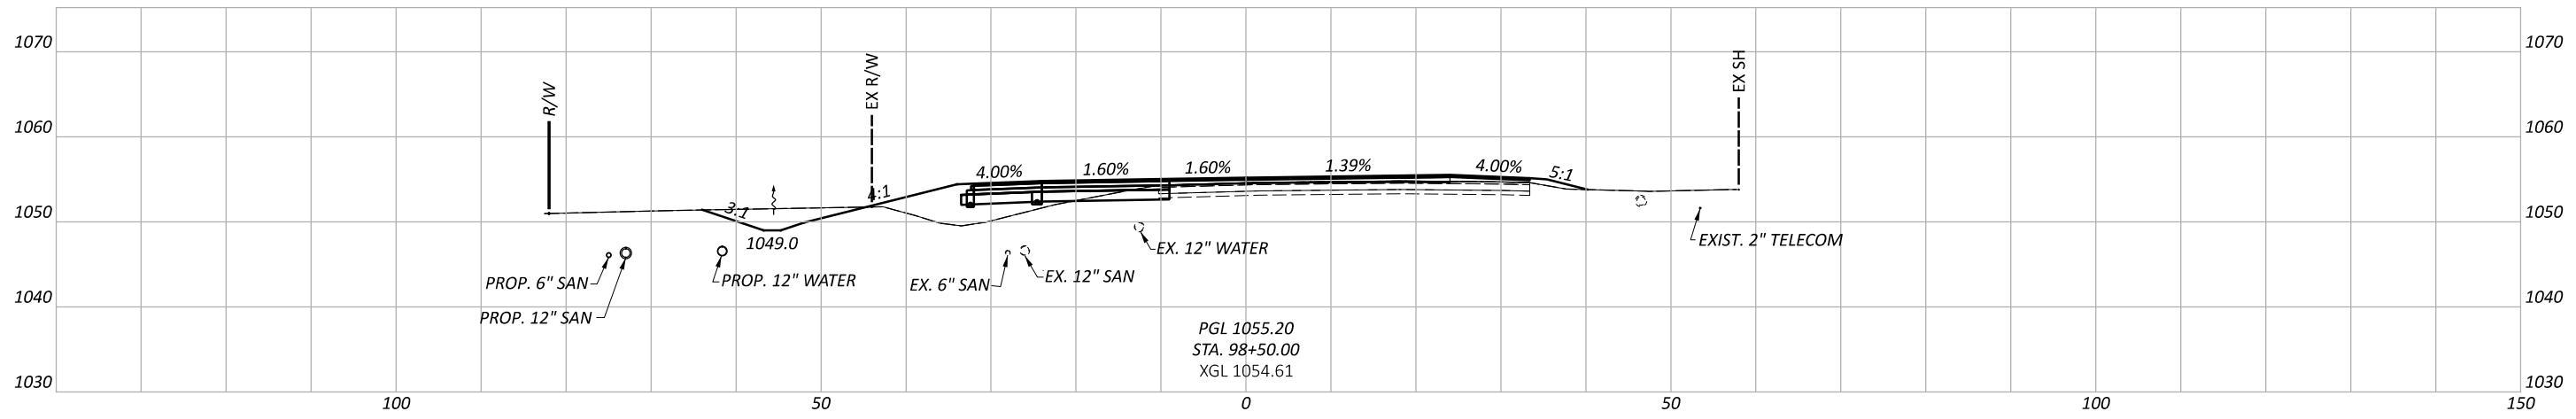

ditch grading beyond EX RW with no PR RW or EASE shown

CROSS SECTIONS - SR 435
 STA. 97+50.00 TO STA. 98+50.00


DESIGN AGENCY
Palmer
 ENGINEERING
 8350 E. KEMPER RD.
 SUITE B
 CINCINNATI, OH 45249
 513-469-1600

DESIGNER
 DPF

REVIEWER
 DCJ MM-DD-YY

PROJECT ID
 117955

Sheet Totals			TOTAL	
Seeding	Cut	Fill	P. 153	228

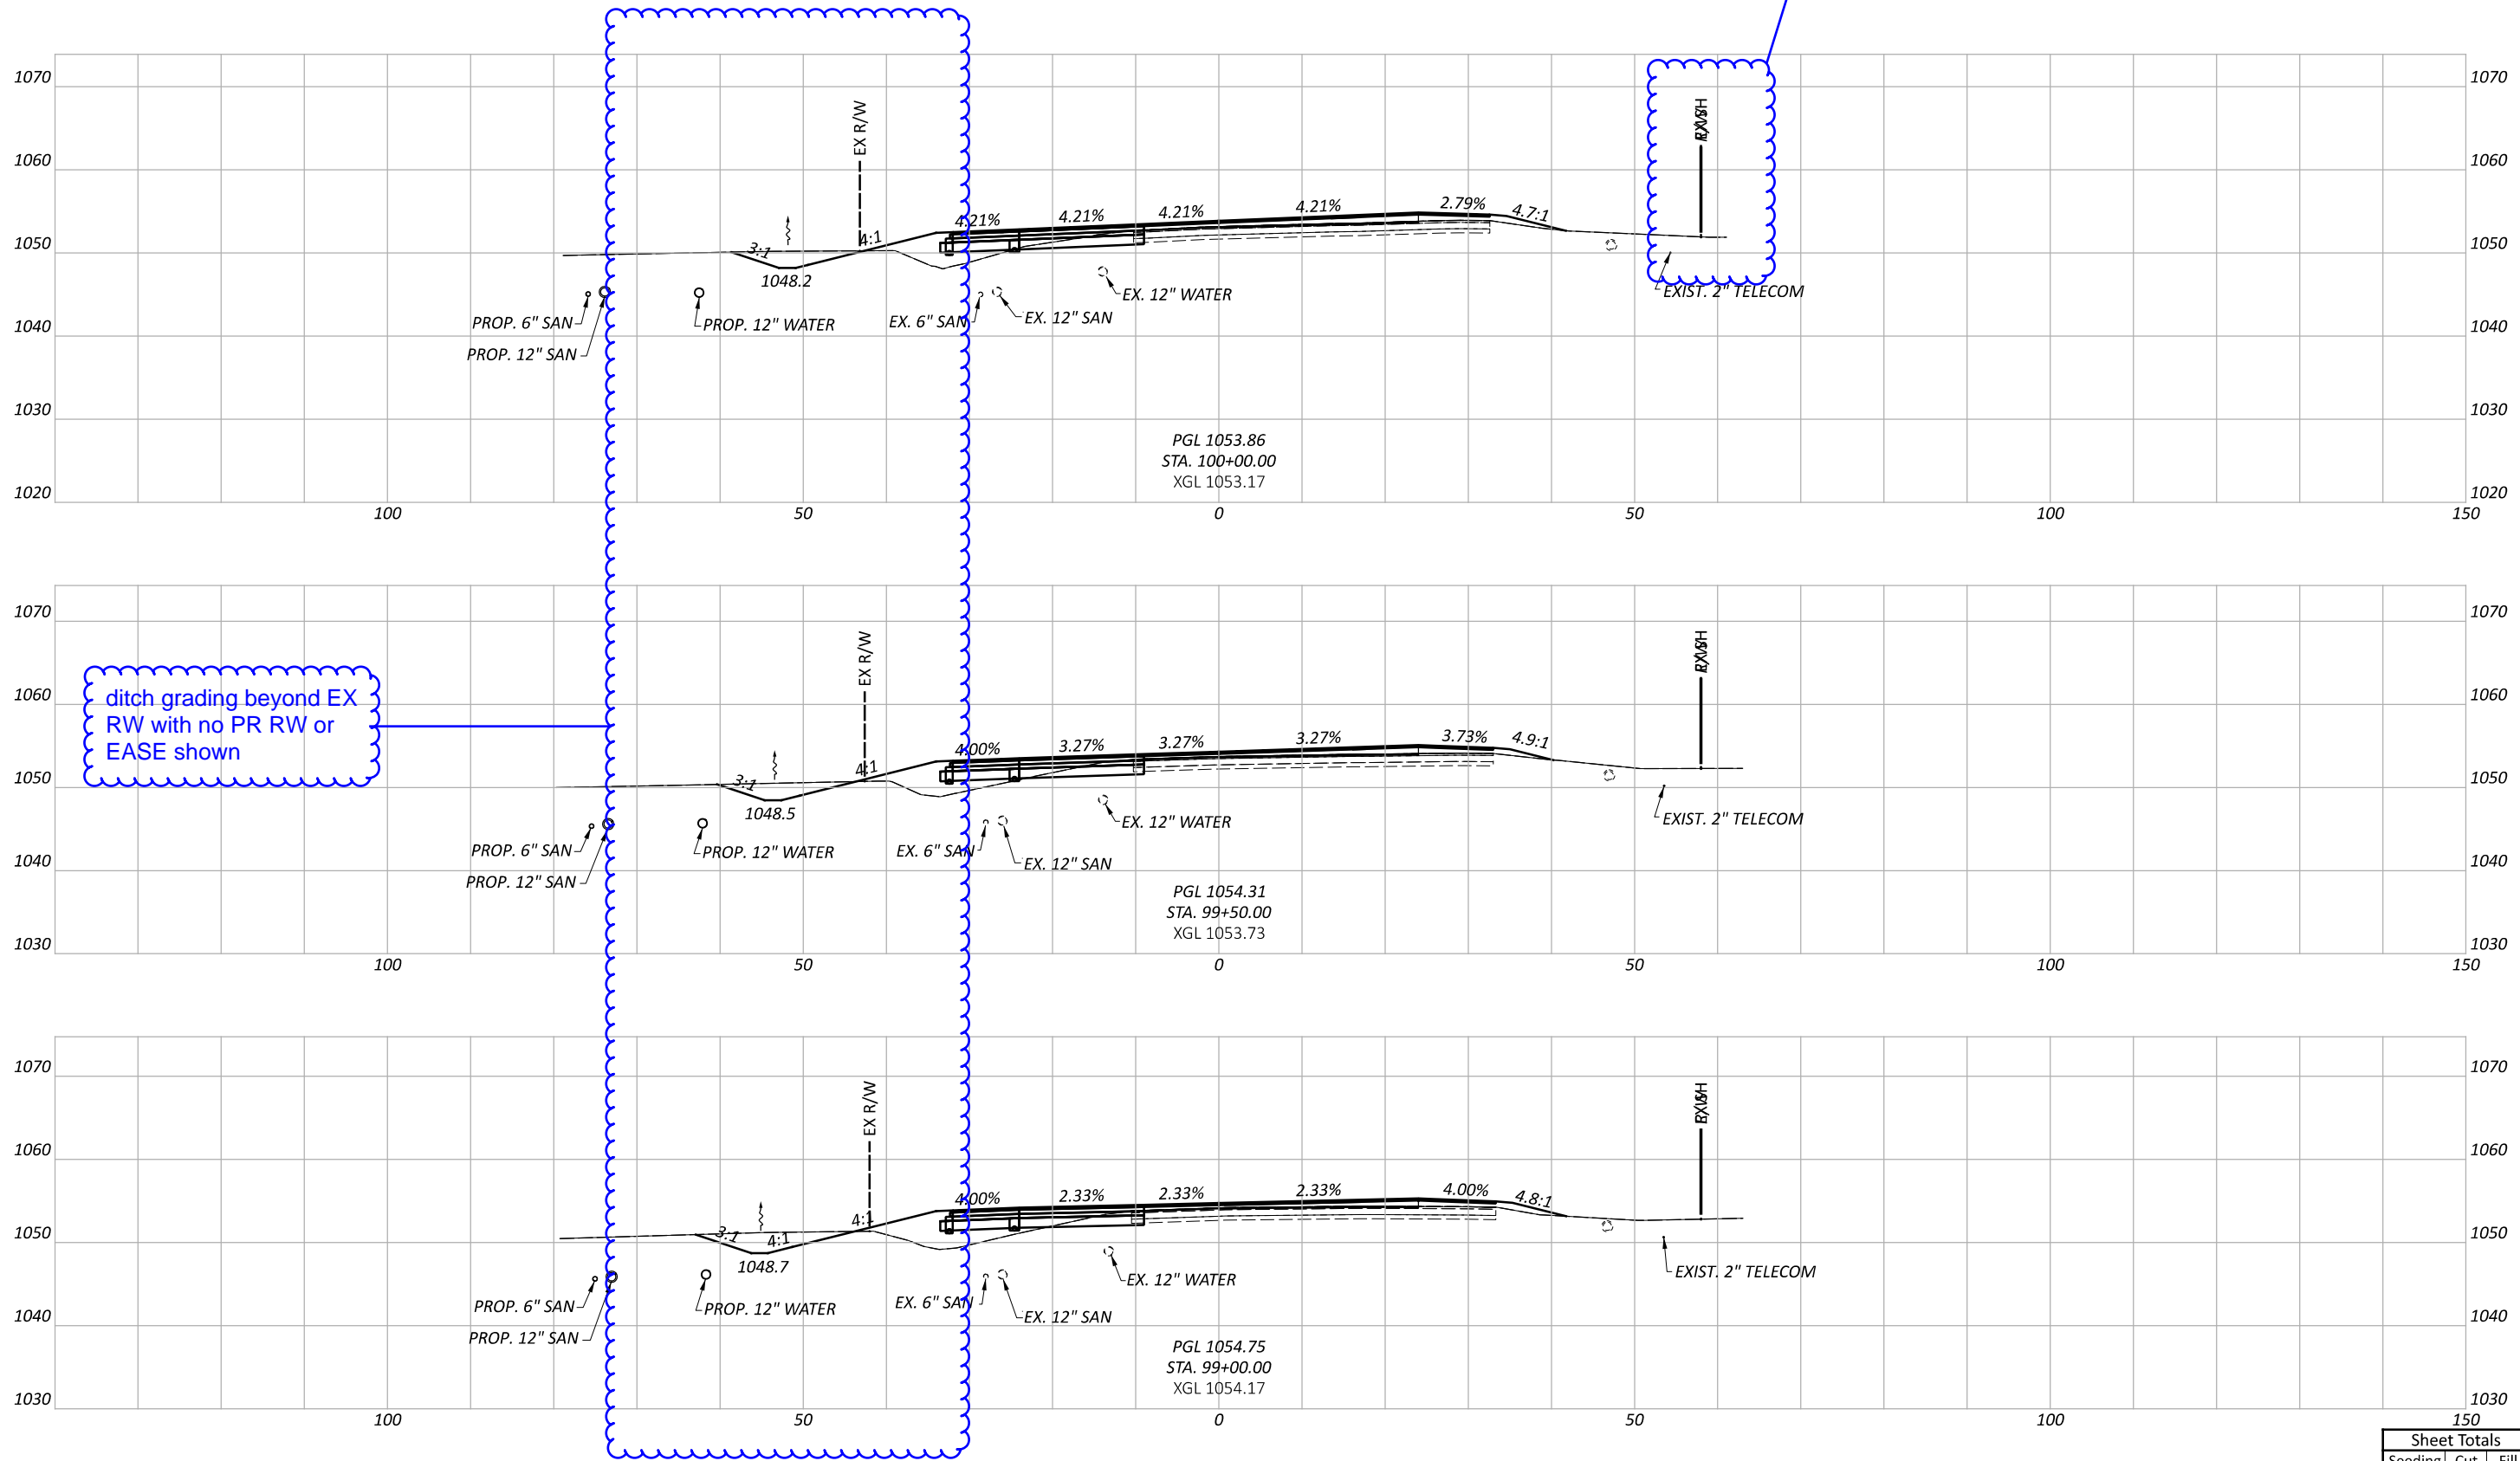

typical - clean up RW label overlap

ditch grading beyond EX RW with no PR RW or EASE shown

CROSS SECTIONS - SR 435
 STA. 99+00.00 TO STA. 100+00.00

DESIGN AGENCY

Palmer
 ENGINEERING
 8350 E. KEMPER RD.
 SUITE B
 CINCINNATI, OH 45249
 513-469-1600




DESIGNER
 DPF

REVIEWER
 DCJ MM-DD-YY

PROJECT ID
 117955

Sheet Totals			TOTAL
Seeding	Cut	Fill	P. 154 228

verify sheets p.155 to p.159 correctly show EX and PR RW

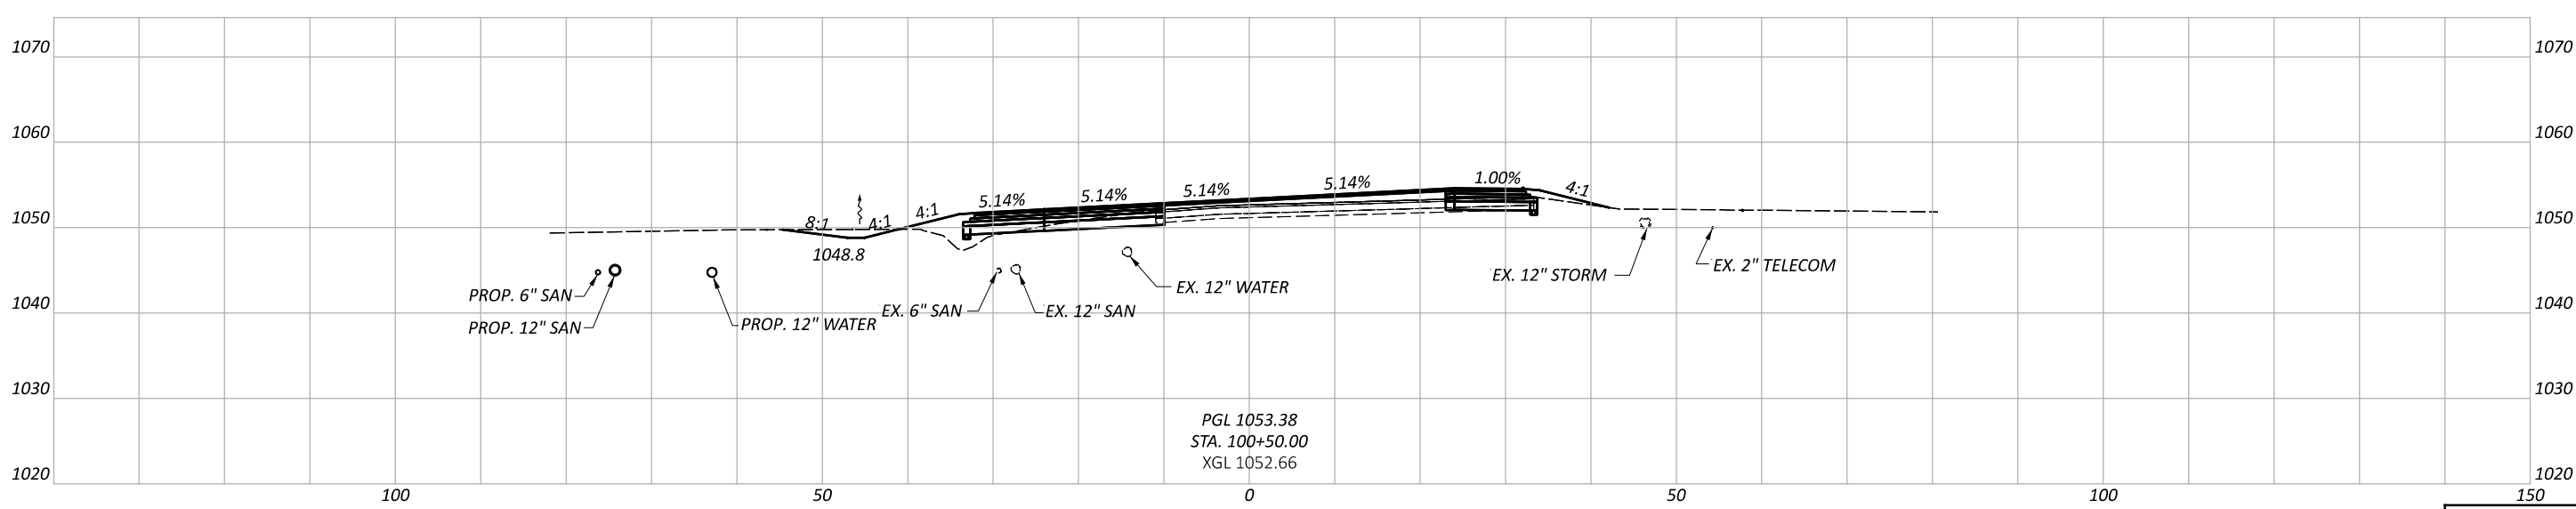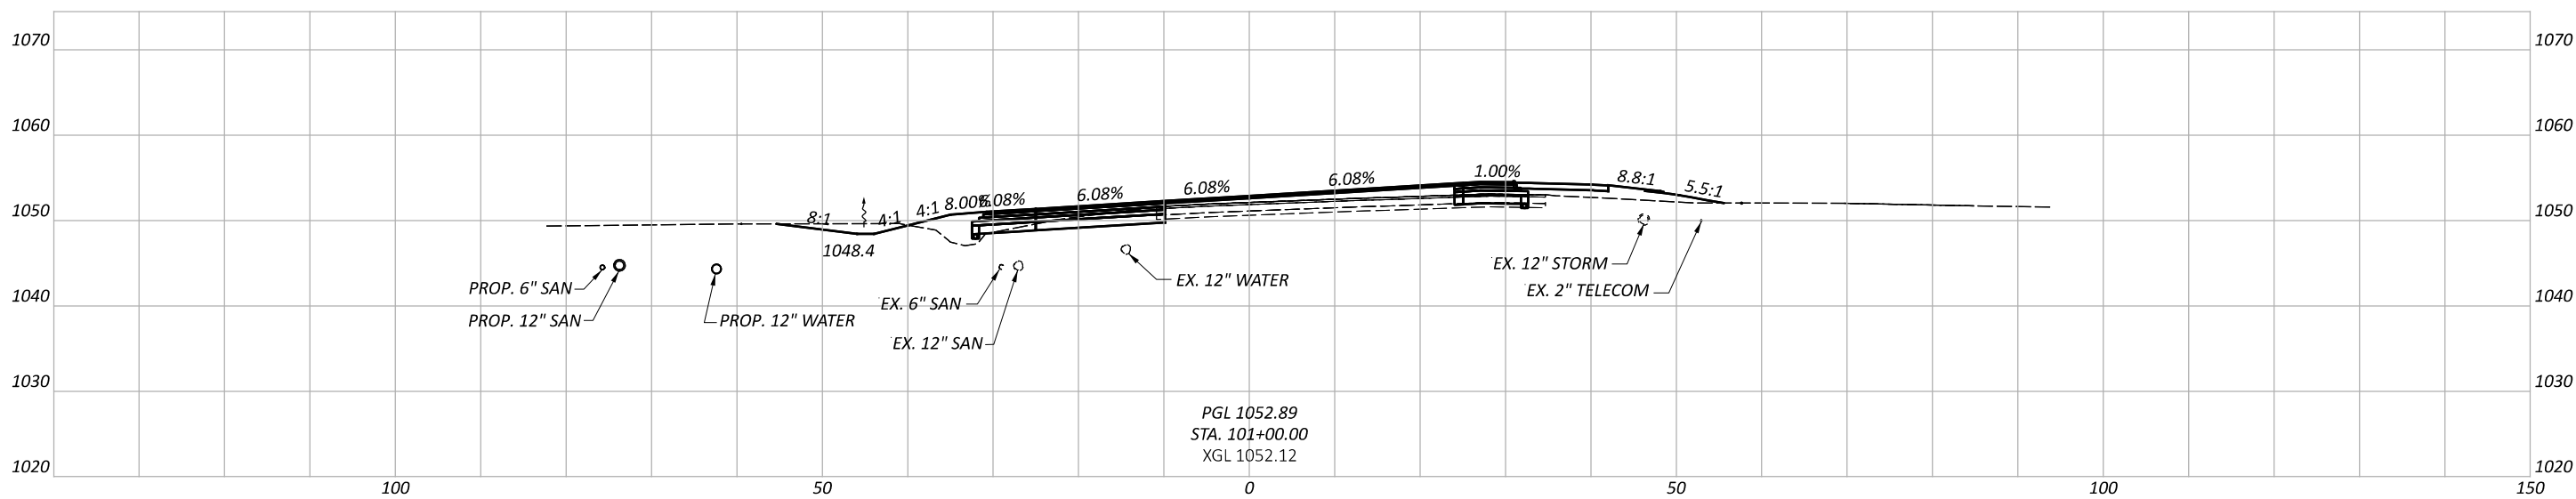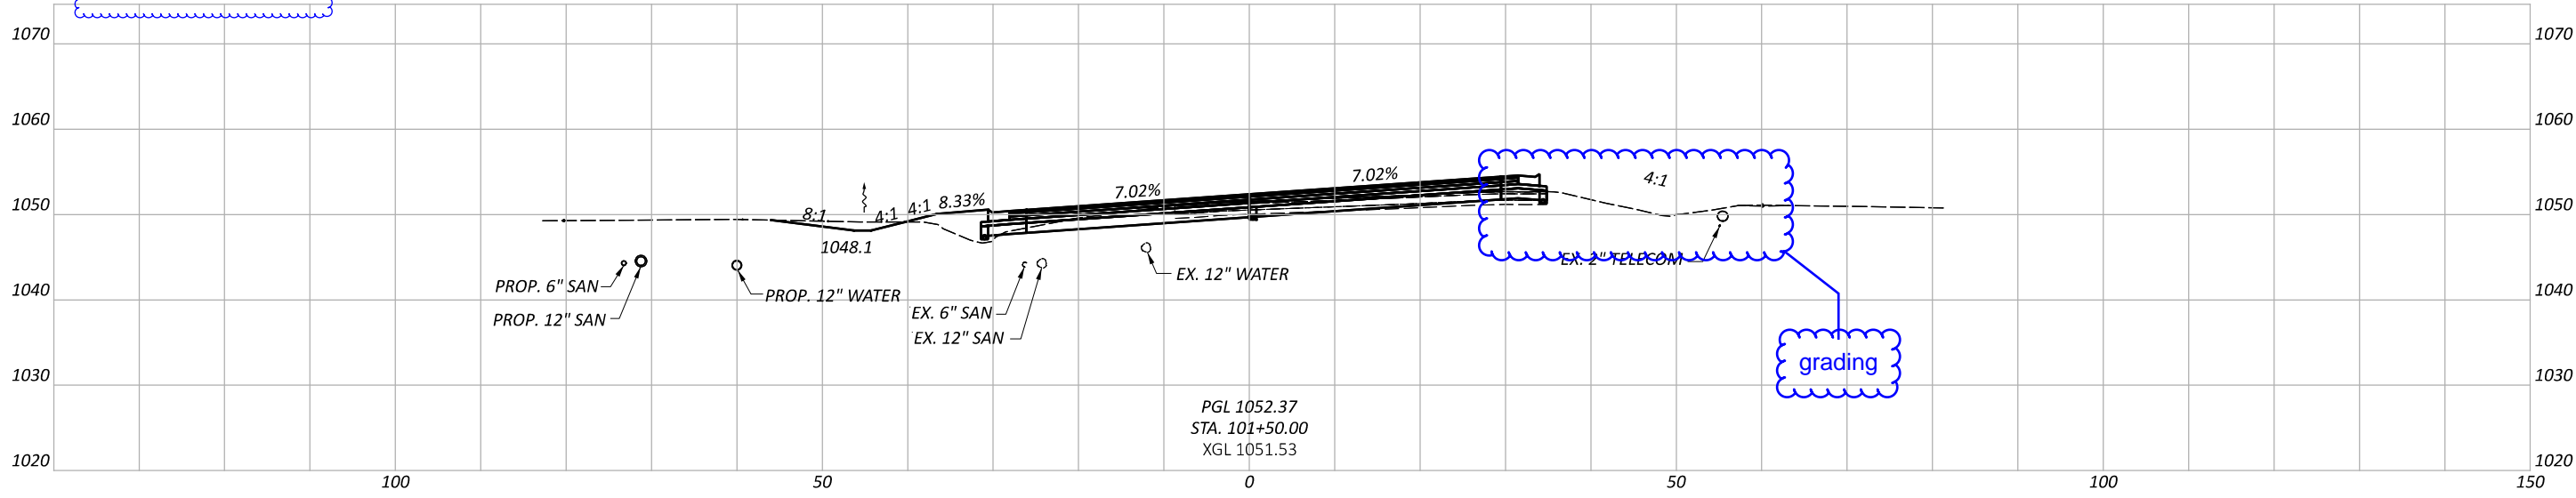

CROSS SECTIONS - SR 435 - WEST ROUNDABOUT APPROACH
STA. 100+50 TO STA. 101+50

FAY-435-1.52




MODEL: SR 435 WEST APPROACH - 100+50.00 [Sheet] PAPER SIZE: 17x11 (in.) DATE: 3/25/2024 TIME: 3:43:12 PM USER: dan-f
pw:\pewinp04.pewin,private.palmernet.com:Palmer_Engineering\Documents\Ohio\000TV06\FAY\117955\100-Engineering\Roadway\Sheets\BU-5\117955_XS003.dgn

DESIGN AGENCY
Palmer
ENGINEERING
8350 E. KEMPER RD.
SUITE B
CINCINNATI, OH 45249
513-469-1600

DESIGNER
DPF
REVIEWER
DCJ MM-DD-YY

PROJECT ID
117955
SHEET TOTAL
P. 155 228

Sheet Totals		
Seeding	Cut	Fill

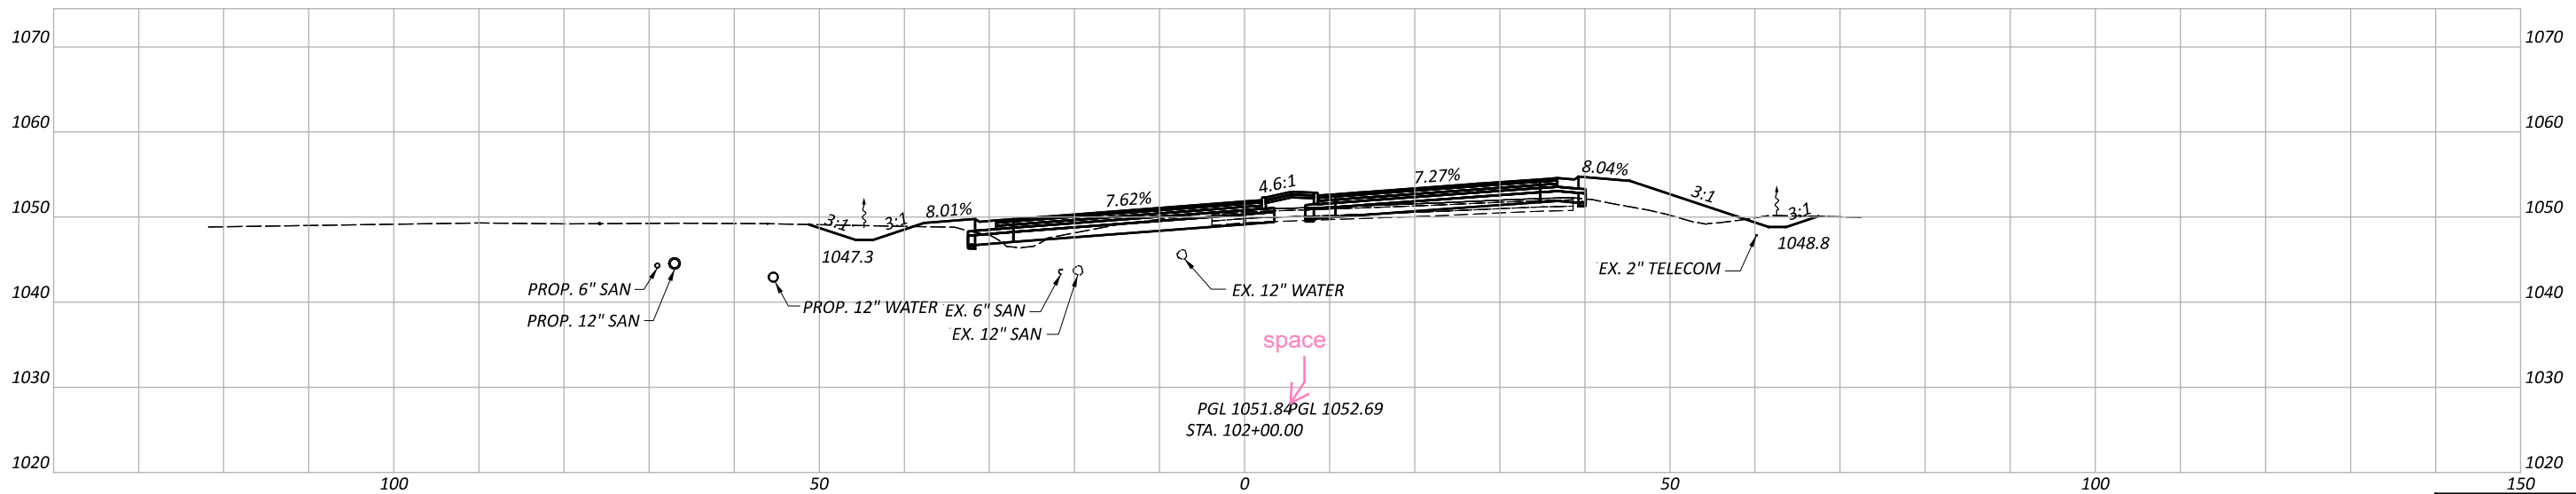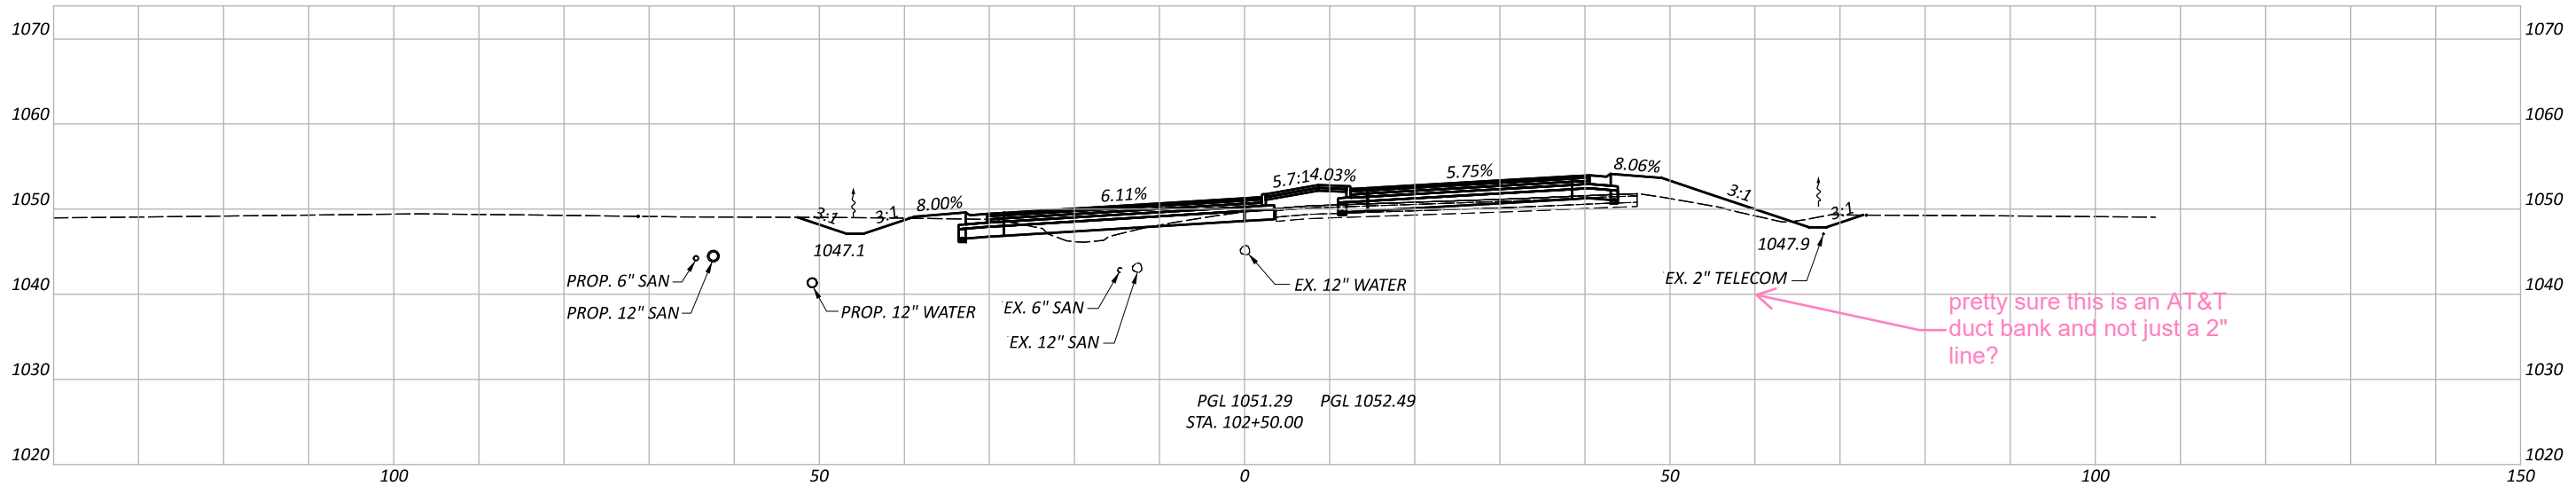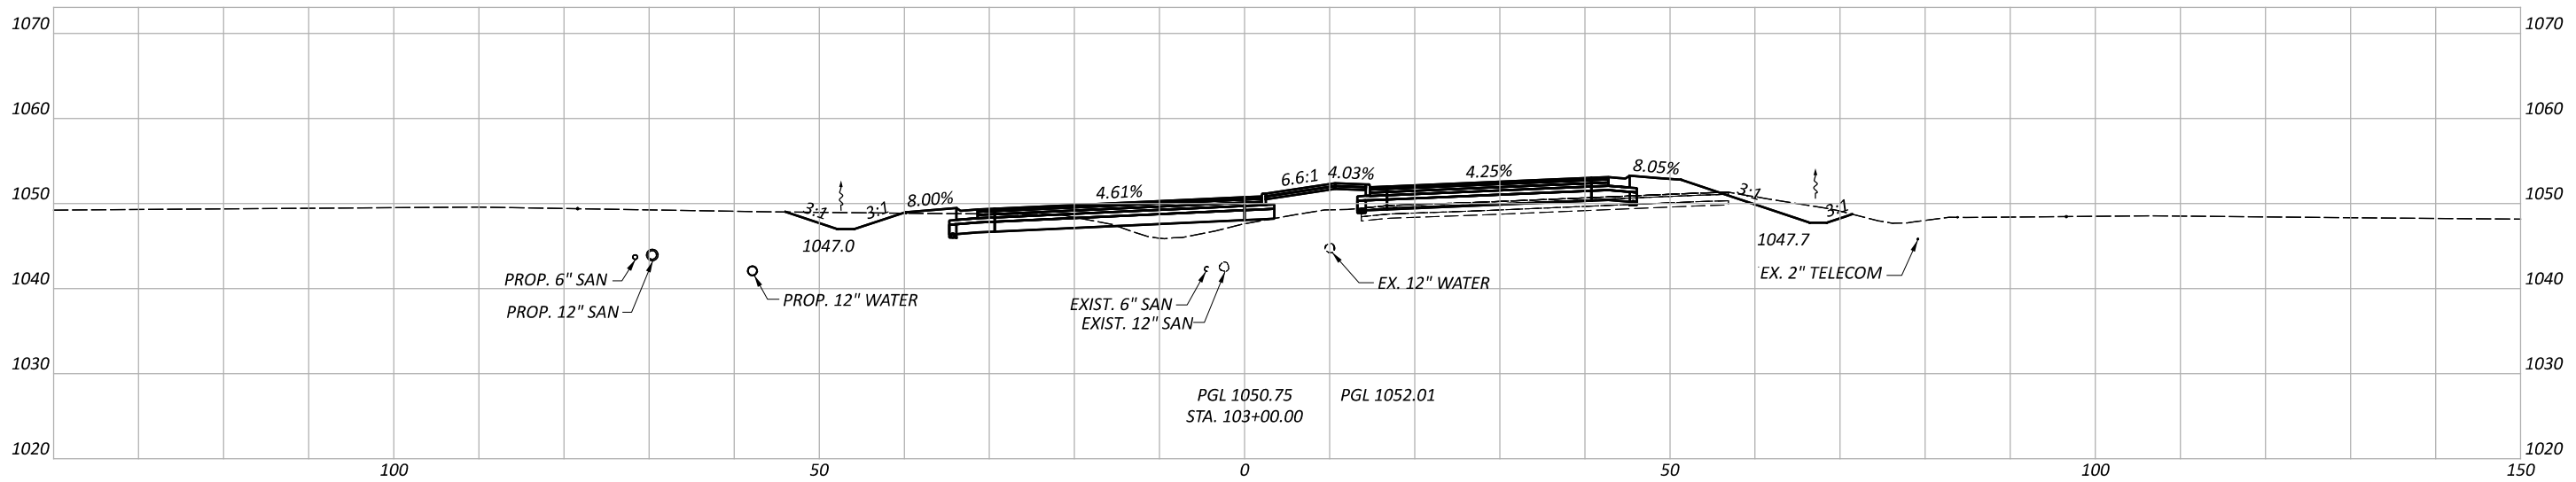

CROSS SECTIONS - SR 435 - WEST ROUNDABOUT APPROACH
 STA. 102+00 TO STA. 103+00

DESIGN AGENCY

Palmer
 ENGINEERING
 8350 E. KEMPER RD.
 SUITE B
 CINCINNATI, OH 45249
 513-469-1600

DESIGNER

DPF

REVIEWER

DCJ MM-DD-YY

PROJECT ID


117955

Sheet Totals

Seeding	Cut	Fill

SHEET TOTAL

P. 156 TOTAL 228

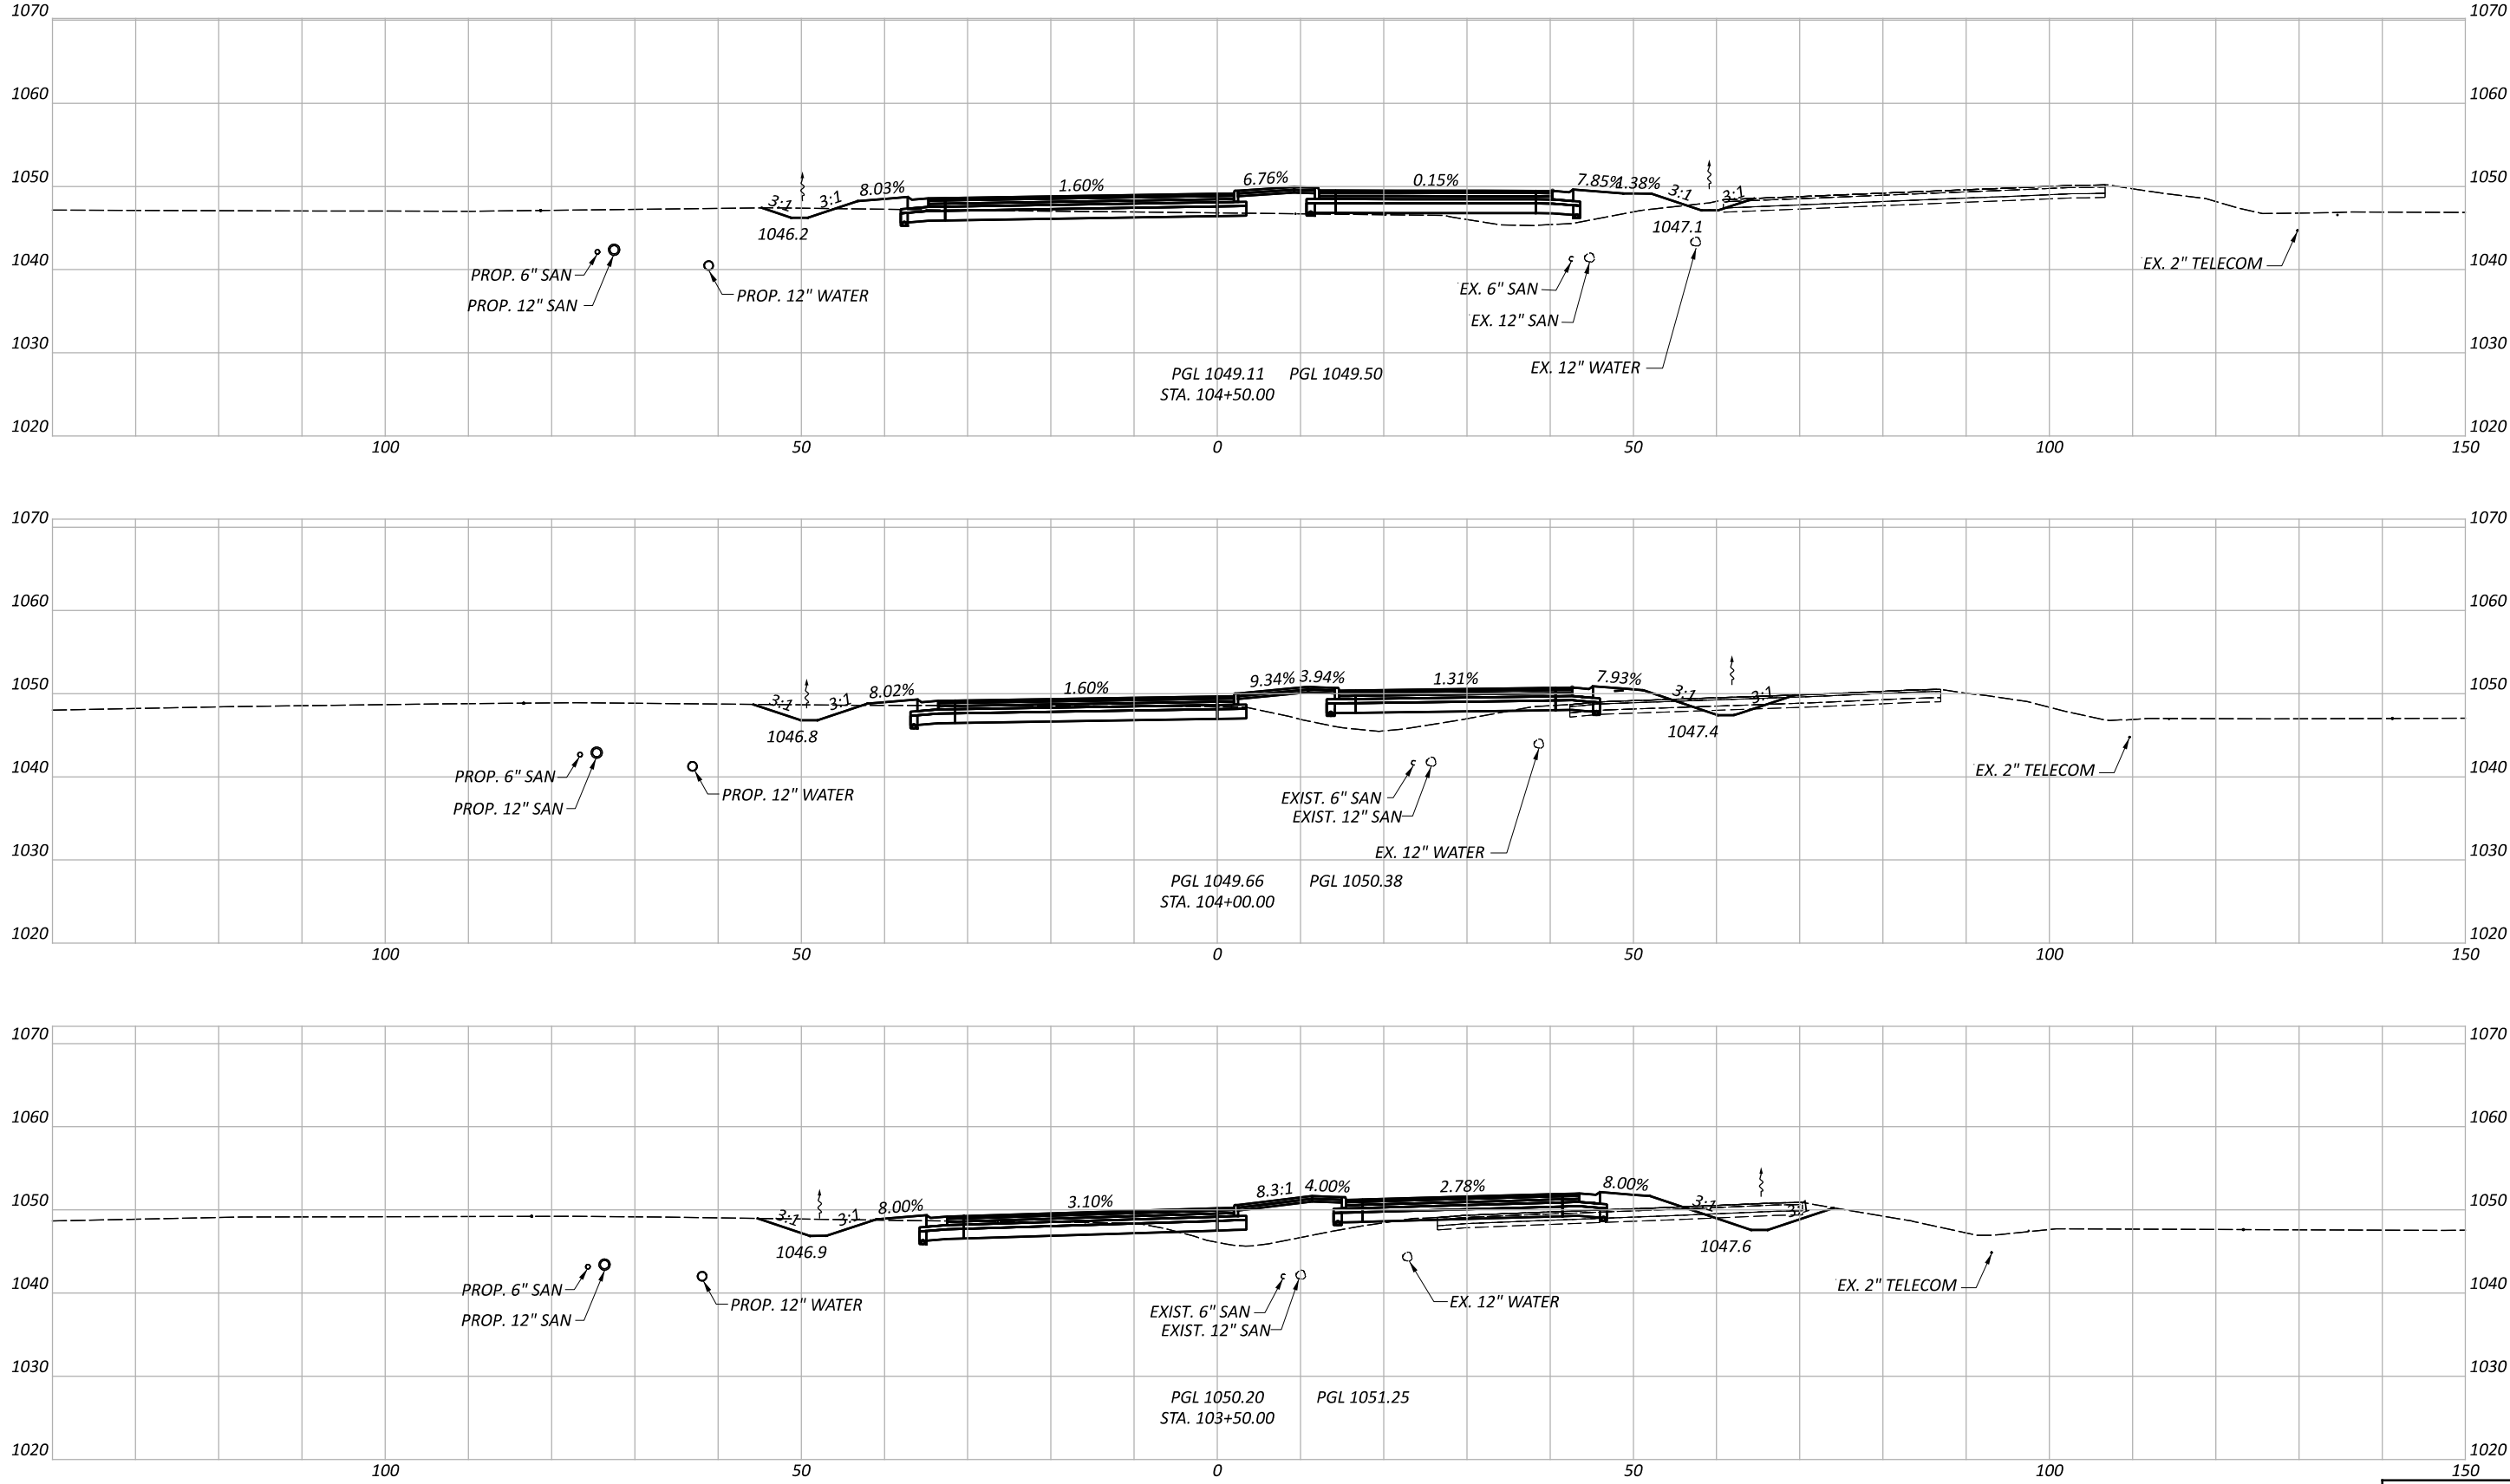

CROSS SECTIONS - SR 435 - WEST ROUNDABOUT APPROACH
 STA. 103+50 TO STA. 104+50


DESIGN AGENCY
Palmer
 ENGINEERING
 8350 E. KEMPER RD.
 SUITE B
 CINCINNATI, OH 45249
 513-469-1600

DESIGNER
 DPF

REVIEWER
 DCJ MM-DD-YY

PROJECT ID
 117955

Sheet Totals			TOTAL	
Seeding	Cut	Fill	SHEET	TOTAL
			P. 157	228

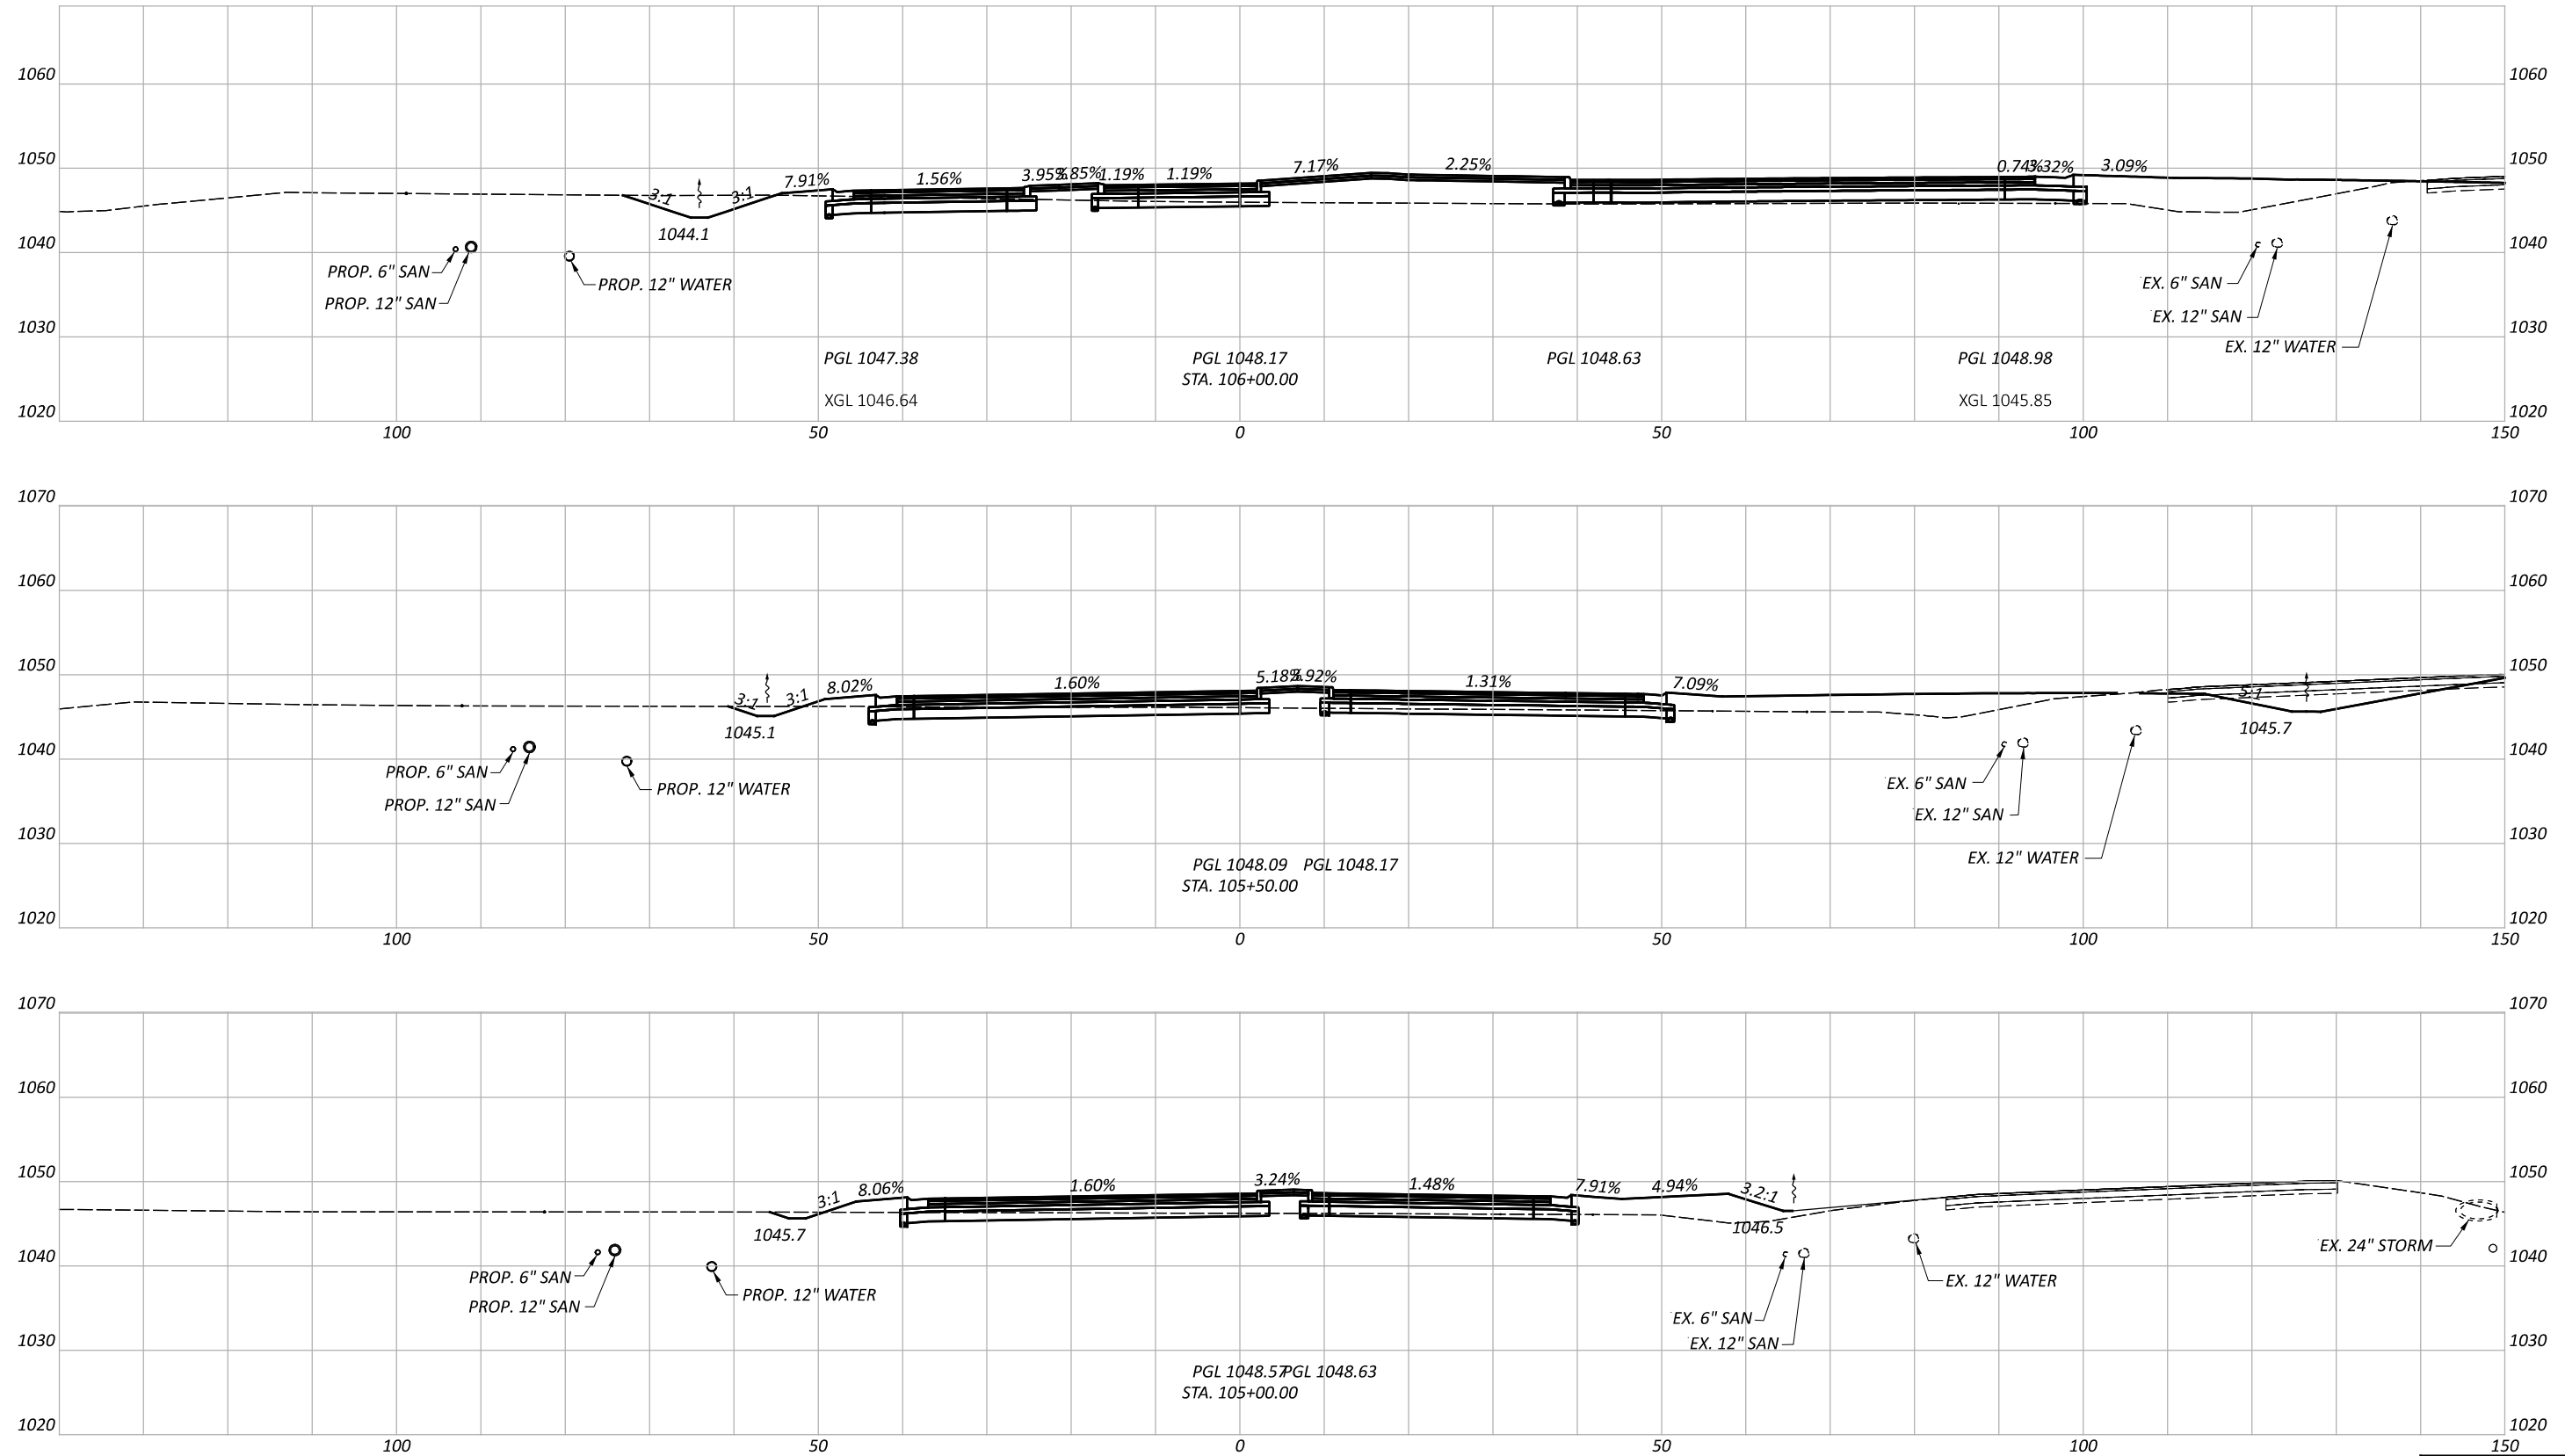

CROSS SECTIONS - SR 435 - WEST ROUNDABOUT APPROACH
 STA. 105+00 TO STA. 106+00

DESIGN AGENCY

Palmer
 ENGINEERING
 8350 E. KEMPER RD.
 SUITE B
 CINCINNATI, OH 45249
 513-469-1600

DESIGNER

DPF



REVIEWER

DCJ MM-DD-YY

PROJECT ID

117955

Sheet Totals		
Seeding	Cut	Fill
SHEET		TOTAL
P. 158		228

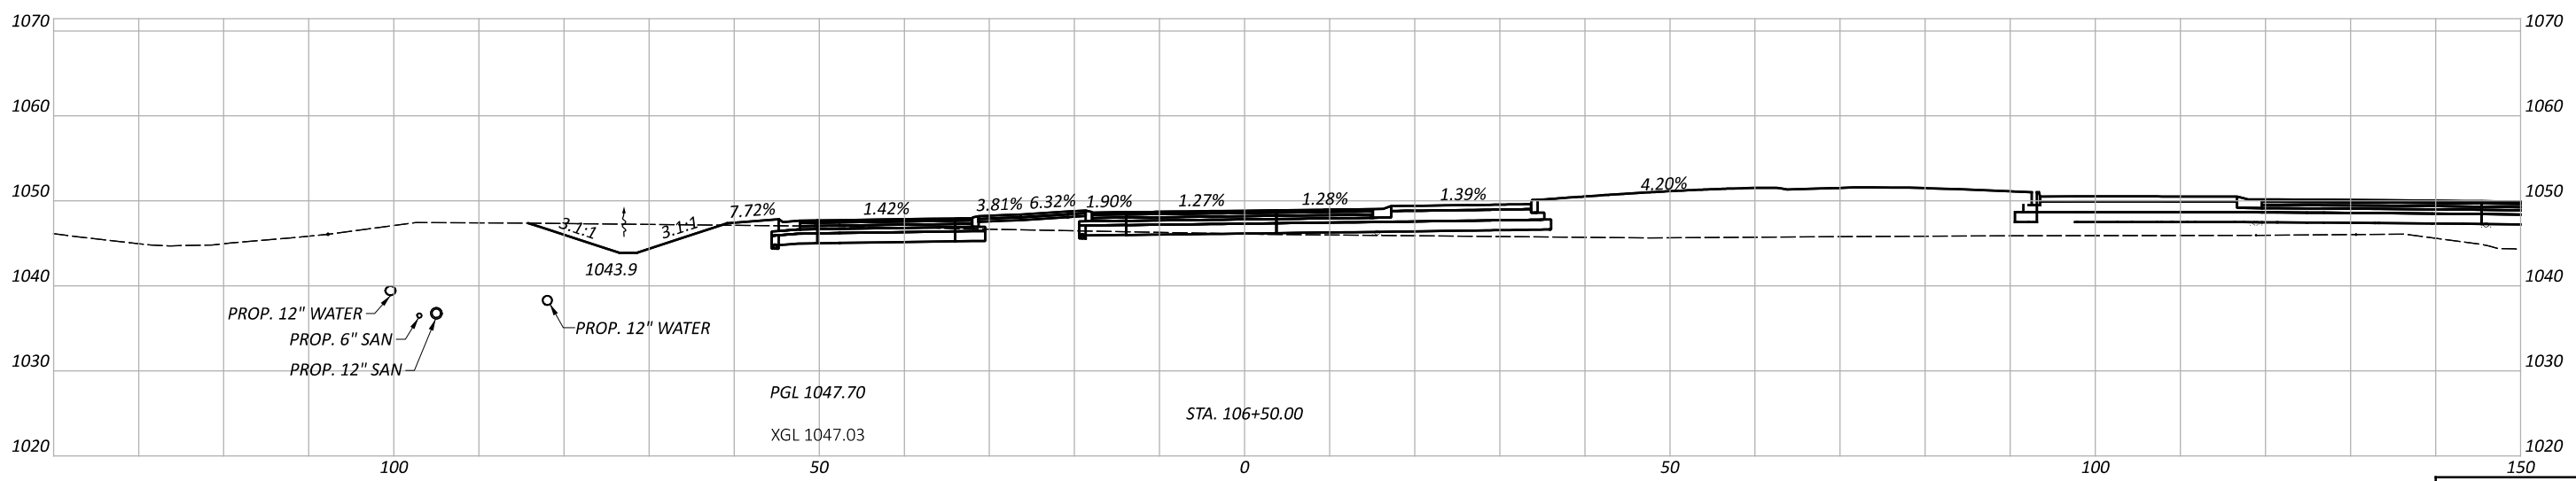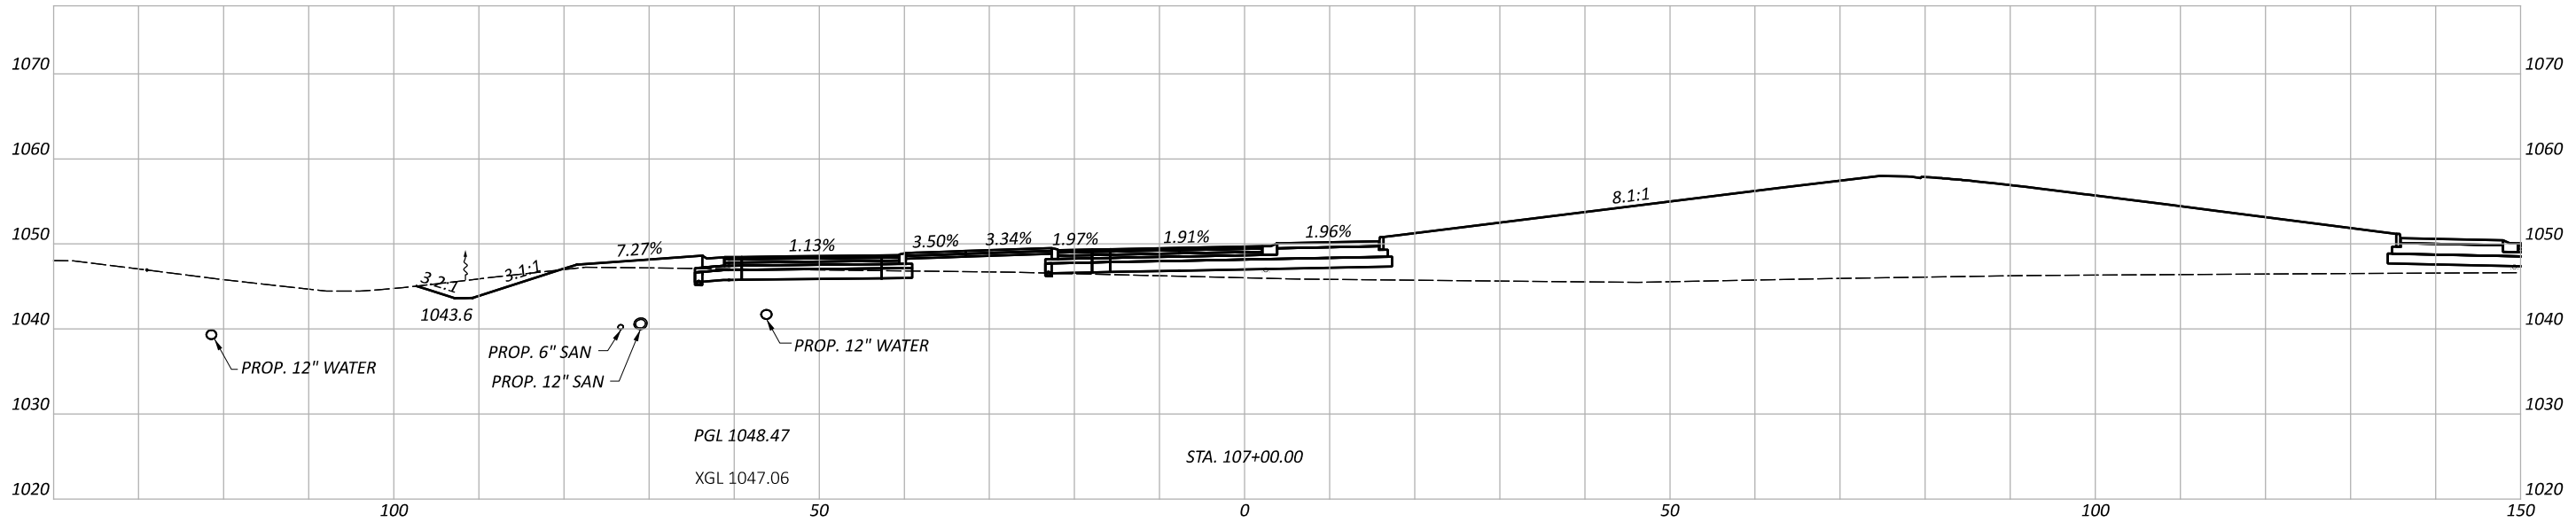


CROSS SECTIONS - SR 435 - WEST ROUNDABOUT APPROACH
 STA. 106+50 TO STA. 107+00

DESIGN AGENCY
Palmer
 ENGINEERING
 8350 E. KEMPER RD.
 SUITE B
 CINCINNATI, OH 45249
 513-469-1600

DESIGNER
 DPF
 REVIEWER
 DCJ MM-DD-YY
 PROJECT ID
 117955

Sheet Totals			TOTAL	
Seeding	Cut	Fill	P. 159	228

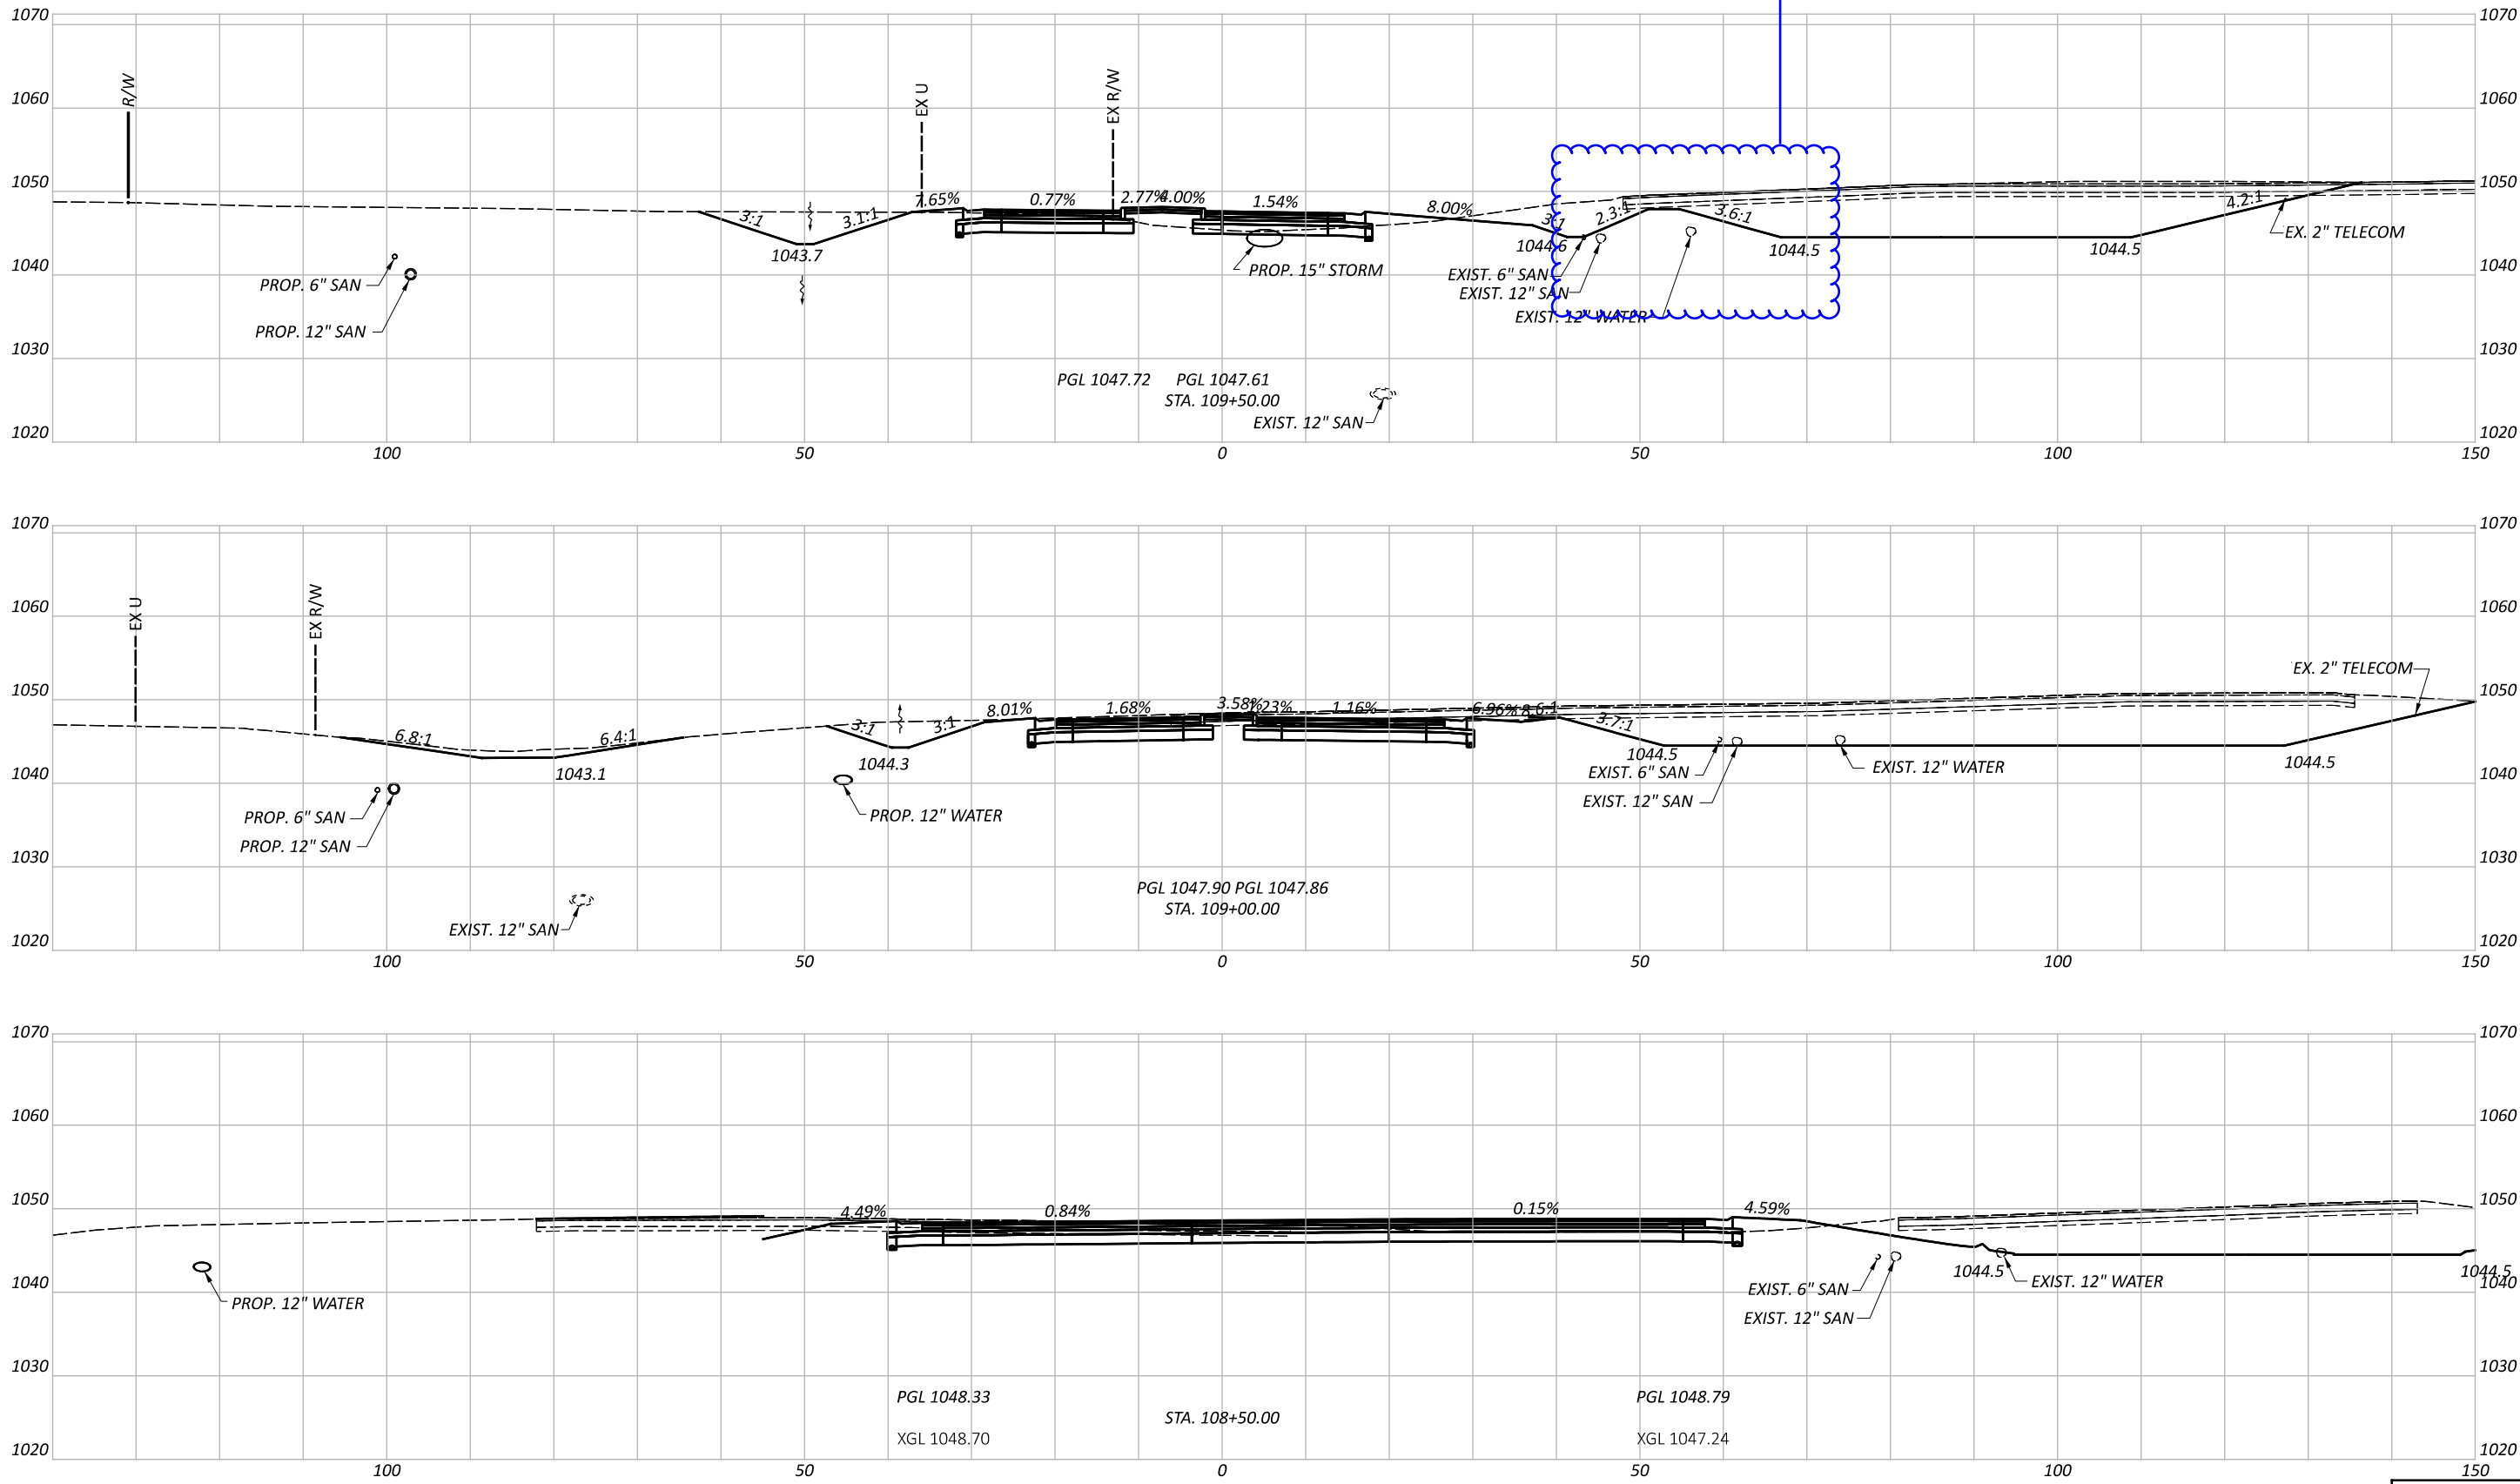

CROSS SECTIONS - SR 435 - EAST ROUNDABOUT APPROACH
 STA. 108+50 TO STA. 109+50


DESIGN AGENCY
Palmer
 ENGINEERING
 8350 E. KEMPER RD.
 SUITE B
 CINCINNATI, OH 45249
 513-469-1600

DESIGNER
 DPF

REVIEWER
 DCJ MM-DD-YY

PROJECT ID
 117955

Sheet Totals			SHEET TOTAL	
Seeding	Cut	Fill	P. 160	228

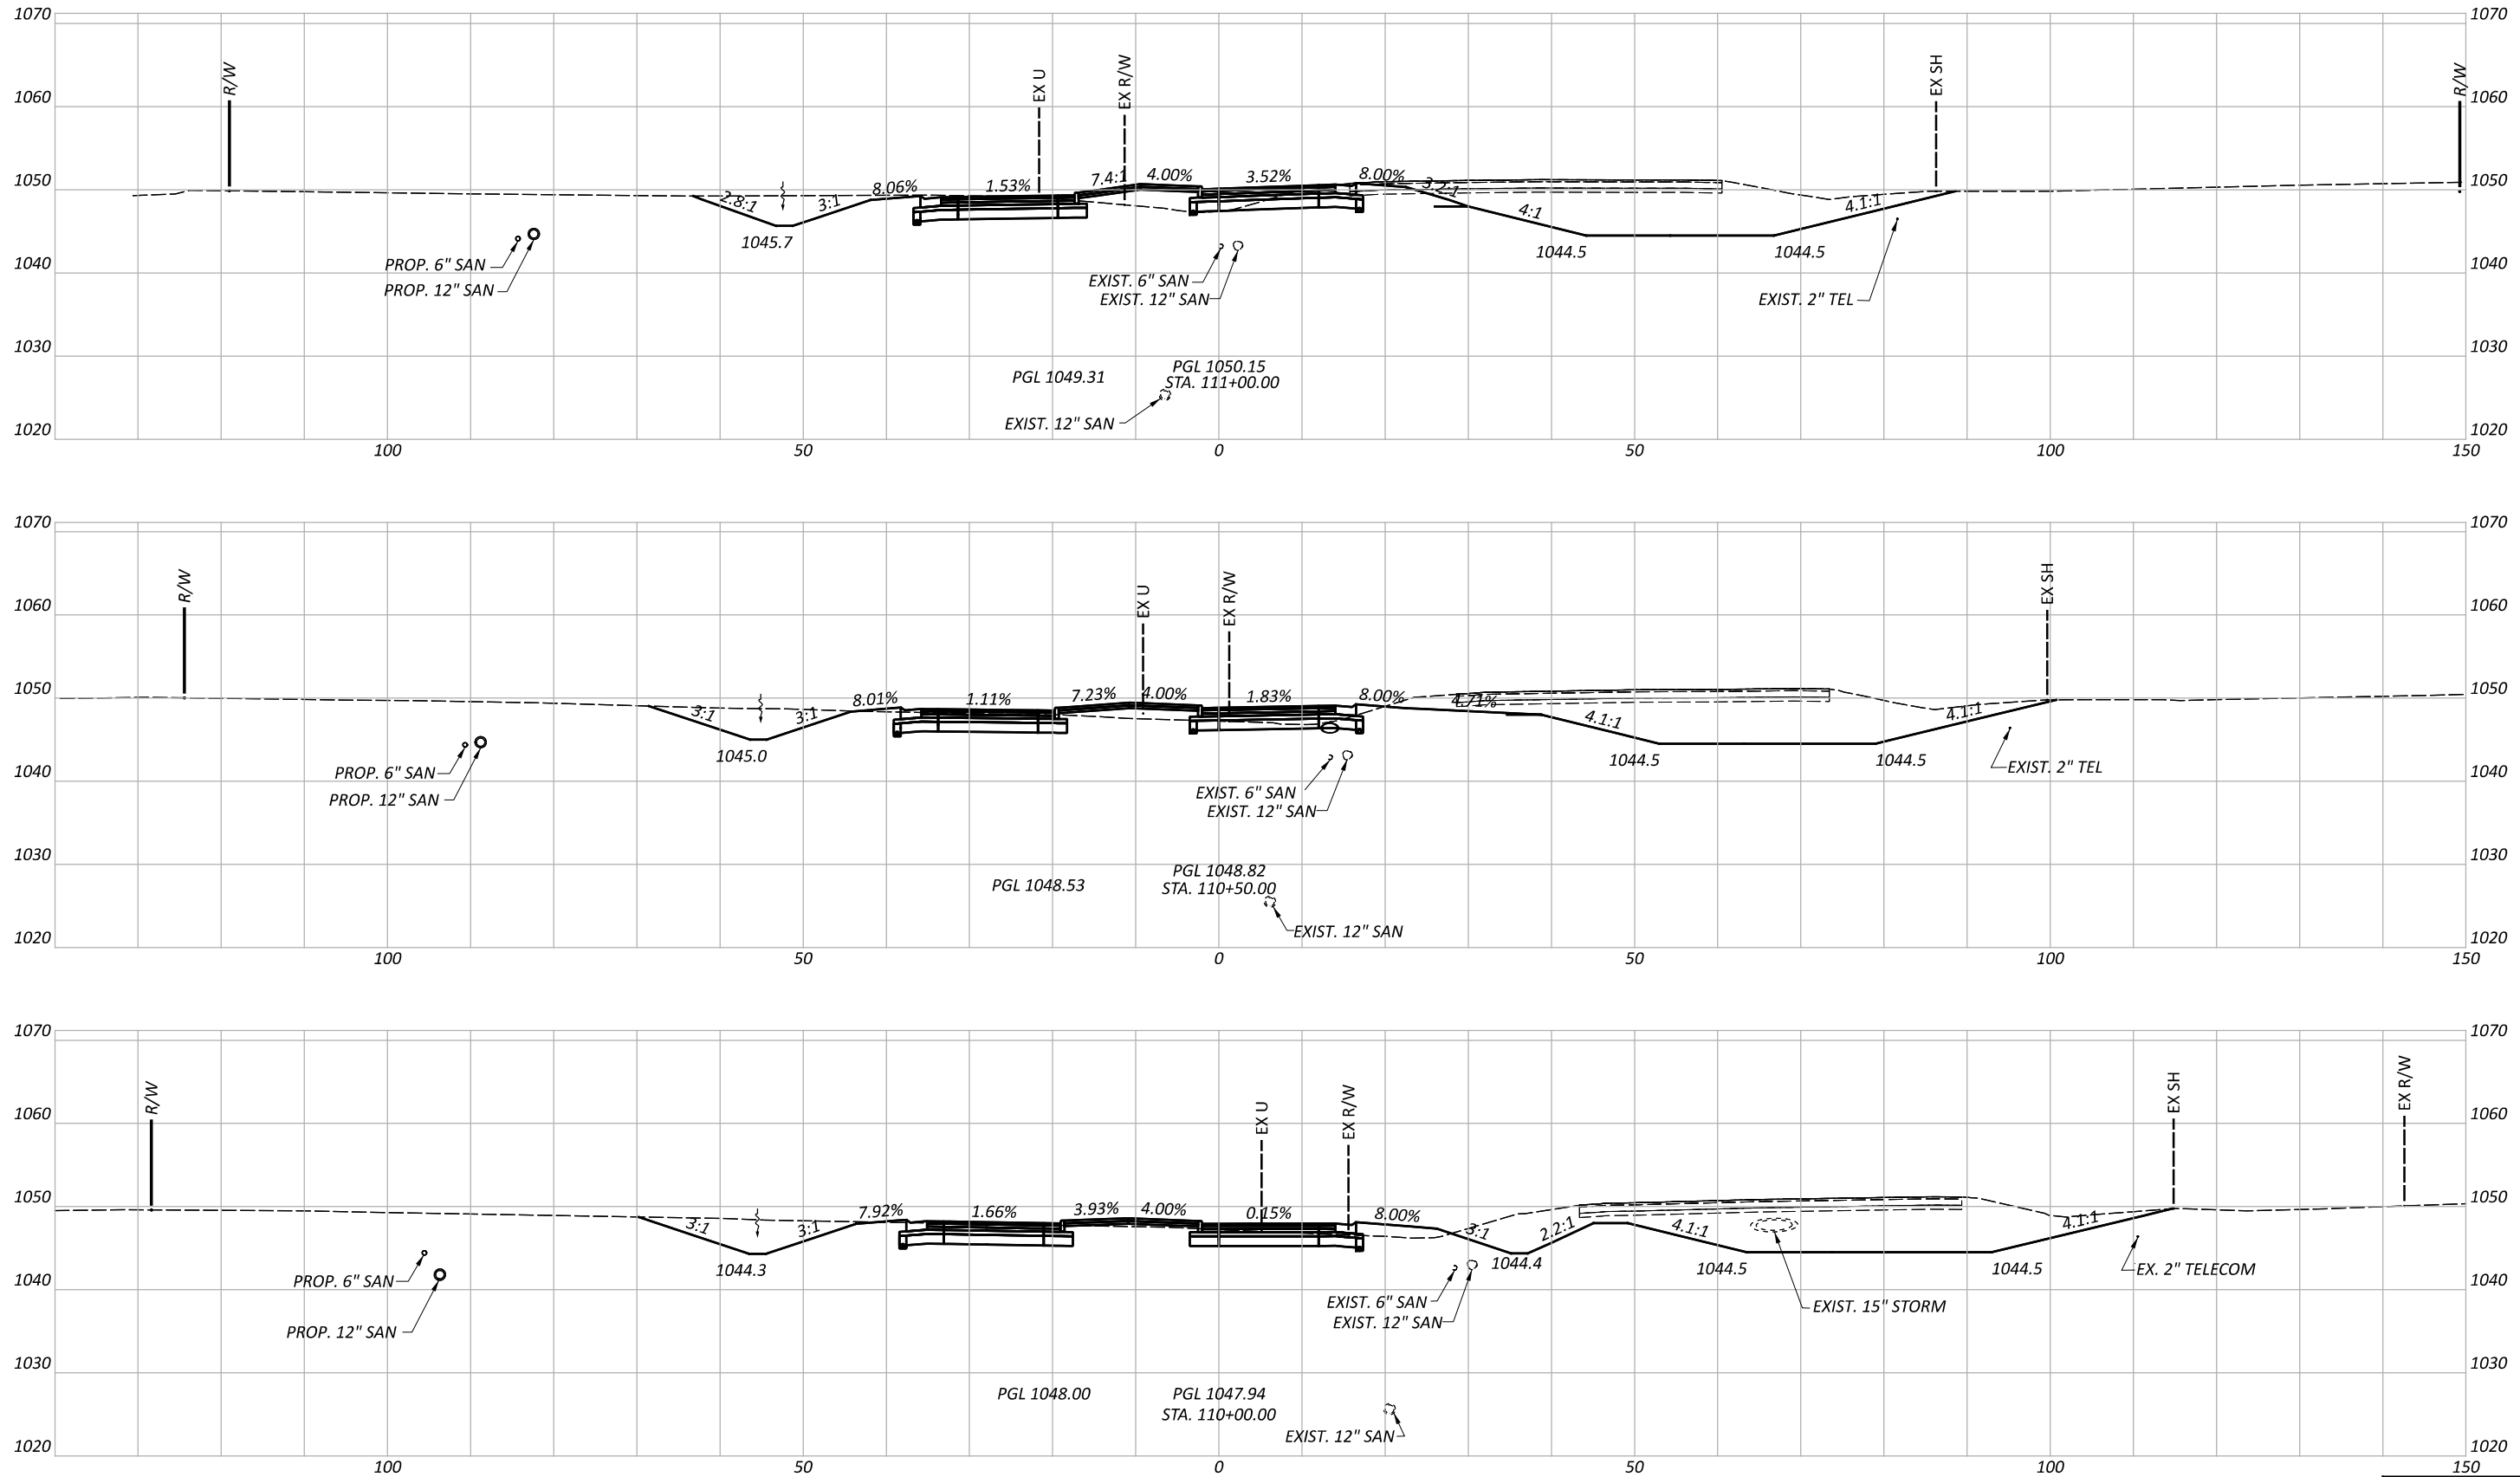




CROSS SECTIONS - SR 435 - EAST ROUNDABOUT APPROACH
 STA. 110+00 TO STA. 111+00

DESIGN AGENCY
Palmer
 ENGINEERING
 8350 E. KEMPER RD.
 SUITE B
 CINCINNATI, OH 45249
 513-469-1600

DESIGNER
 DPF
 REVIEWER
 DCJ MM-DD-YY

PROJECT ID
 117955
 SHEET TOTAL
 P. 161 228

Sheet Totals		
Seeding	Cut	Fill

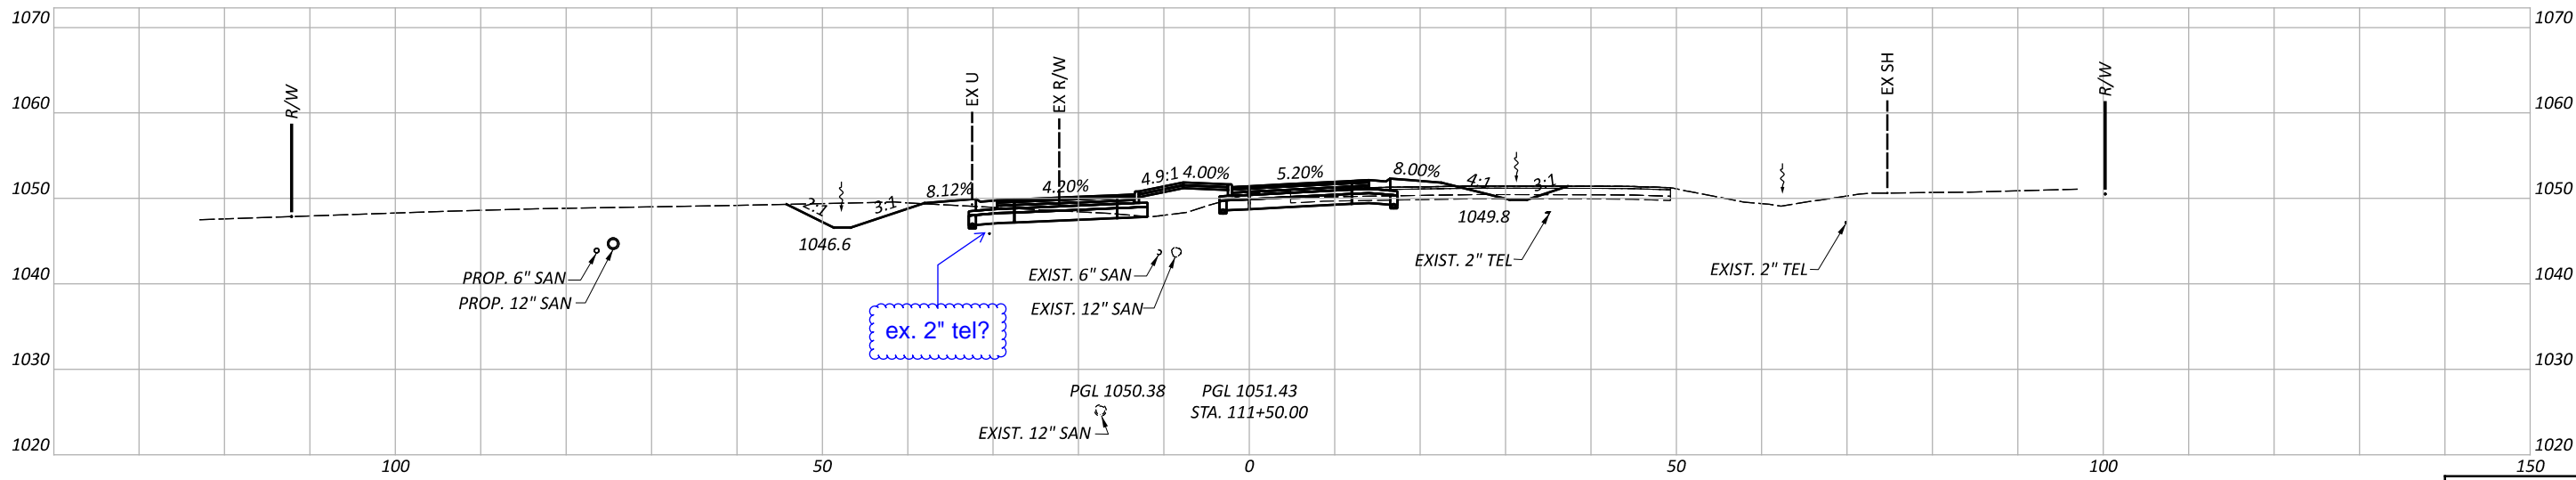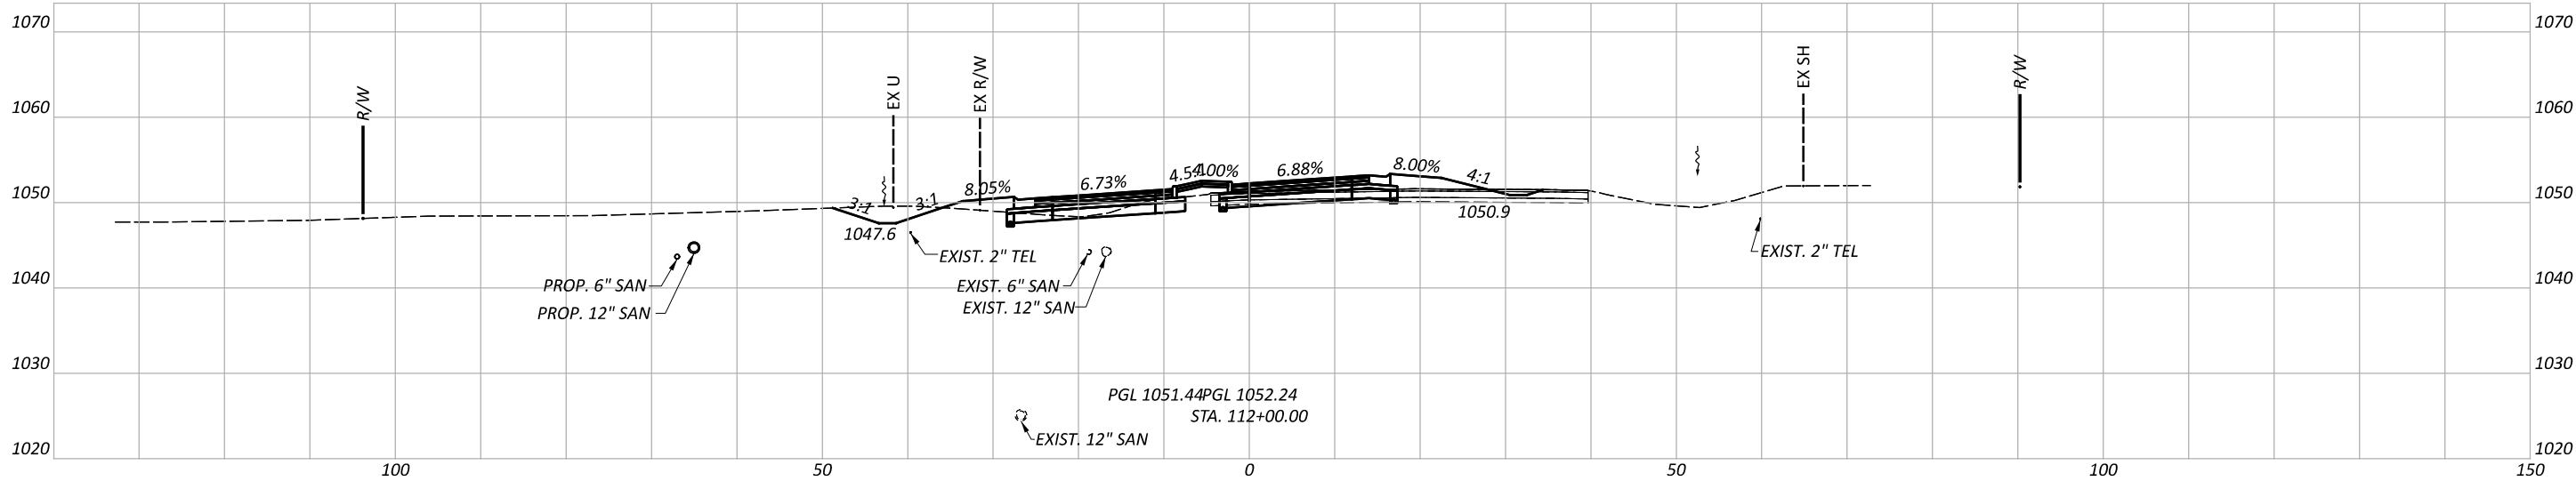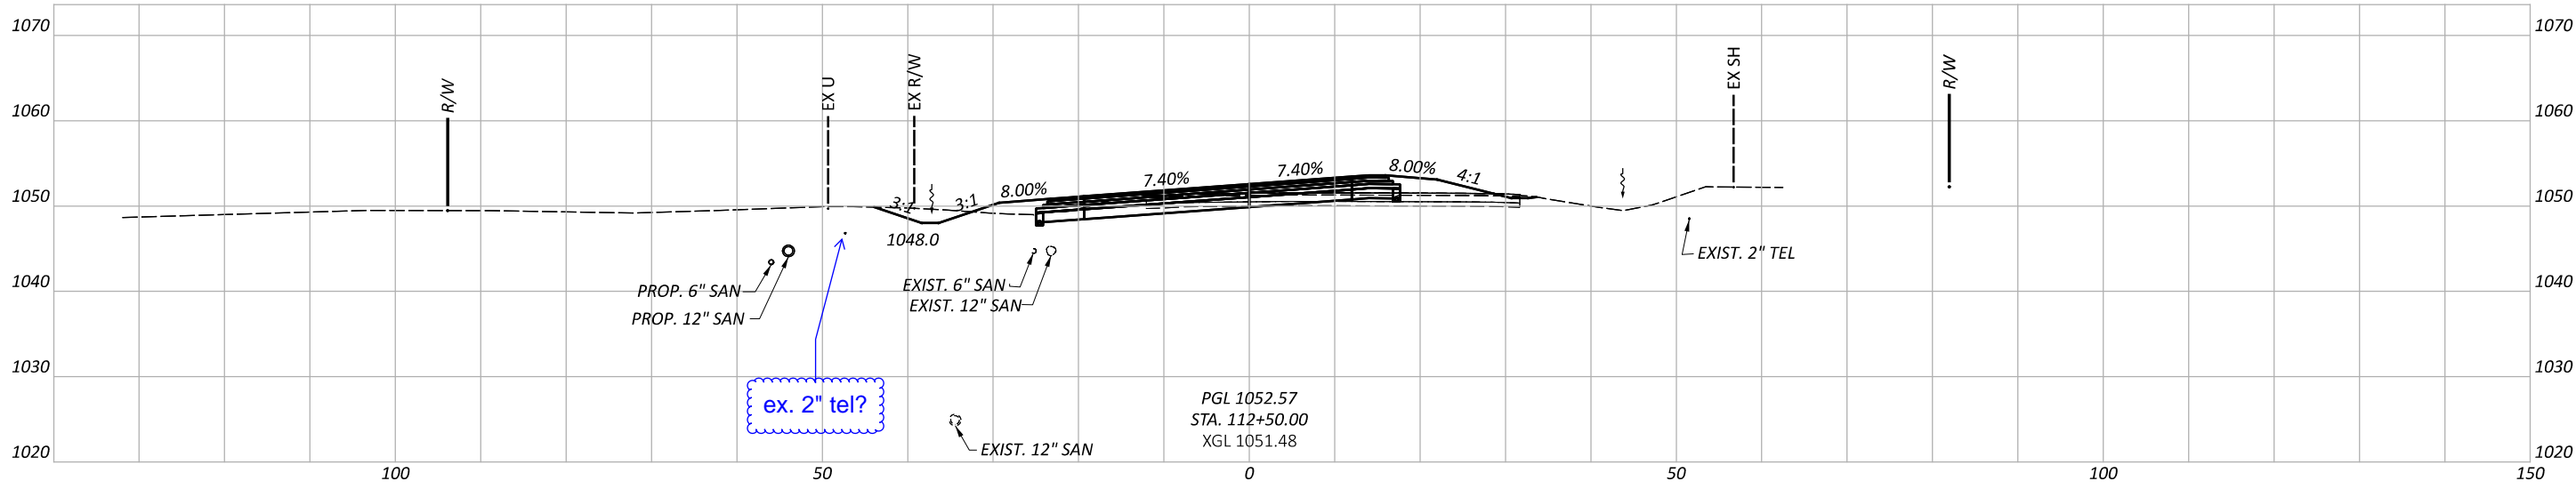




CROSS SECTIONS - SR 435 - EAST ROUNDABOUT APPROACH
 STA. 111+50 TO STA. 112+50

DESIGN AGENCY
Palmer
 ENGINEERING
 8350 E. KEMPER RD.
 SUITE B
 CINCINNATI, OH 45249
 513-469-1600

DESIGNER
 DPF
 REVIEWER
 DCJ MM-DD-YY

PROJECT ID
 117955
 SHEET TOTAL
 P. 162 228

Sheet Totals		
Seeding	Cut	Fill

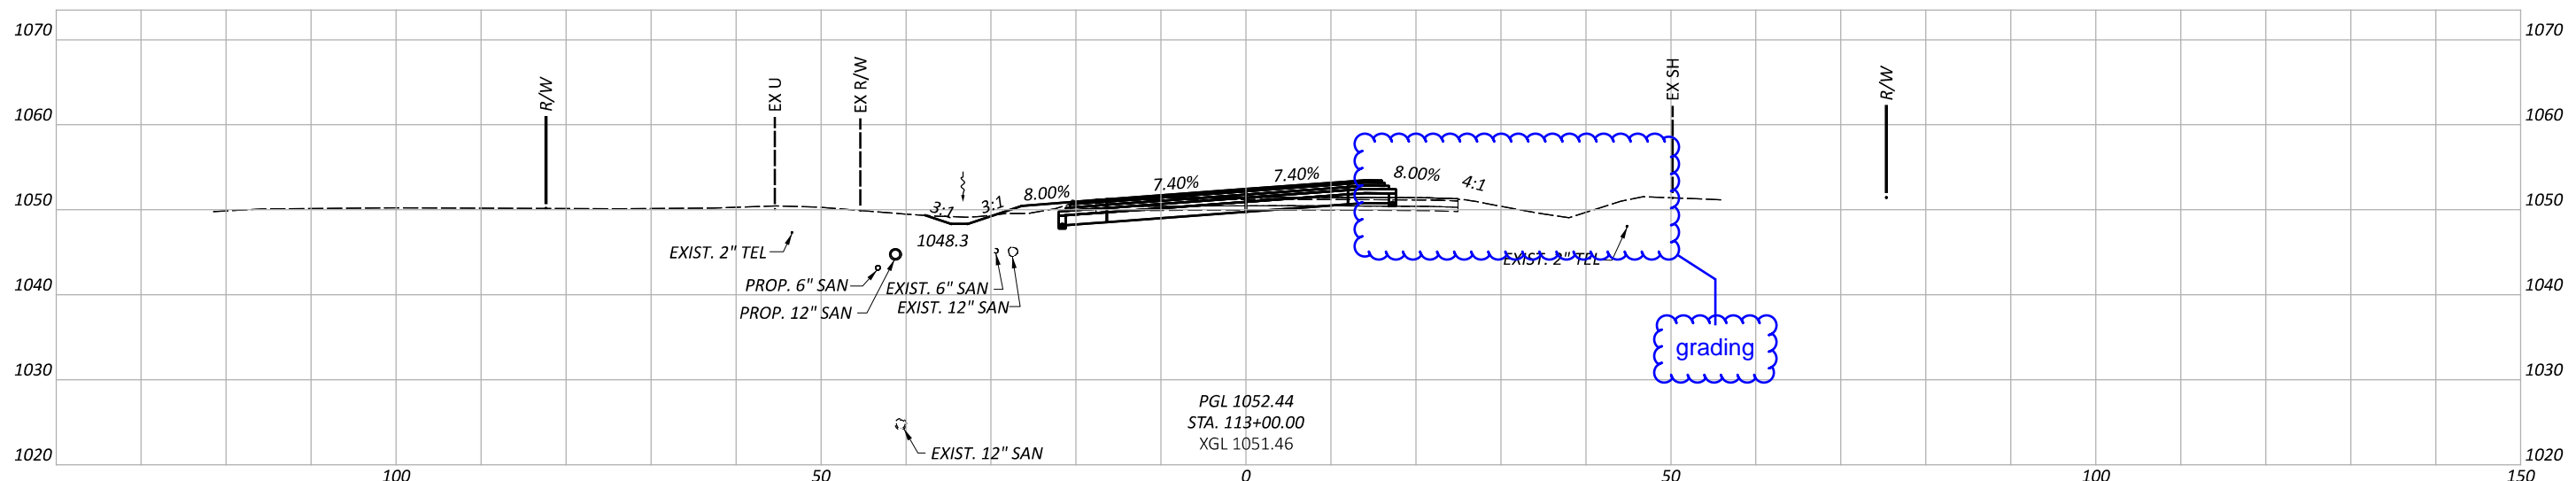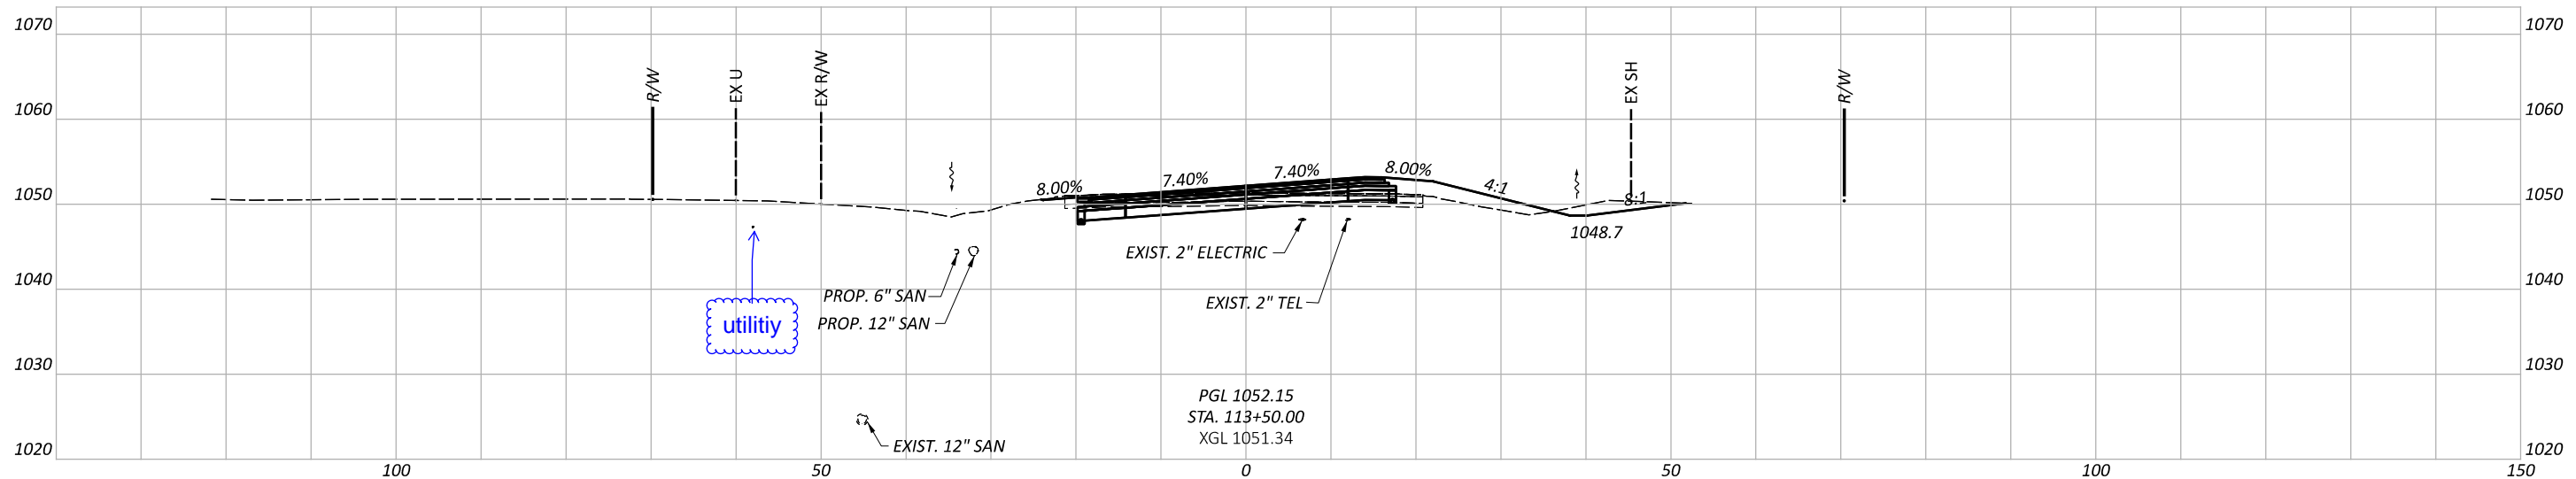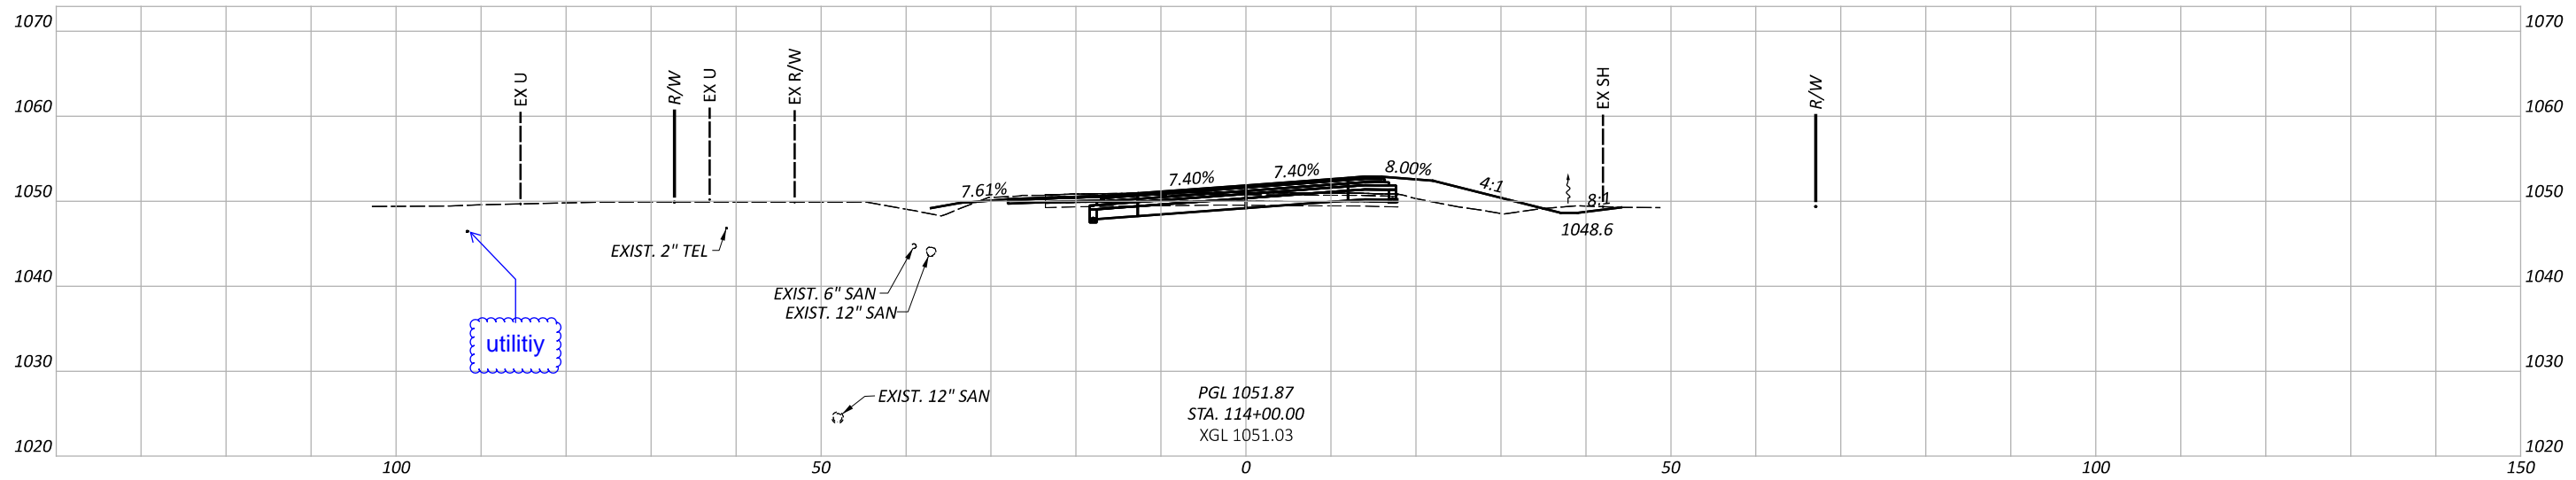

CROSS SECTIONS - SR 435 - EAST ROUNDABOUT APPROACH
 STA. 113+00 TO STA. 114+00

DESIGN AGENCY

Palmer
 ENGINEERING
 8350 E. KEMPER RD.
 SUITE B
 CINCINNATI, OH 45249
 513-469-1600

DESIGNER

DPF

REVIEWER




DCJ MM-DD-YY

PROJECT ID

117955




Sheet Totals		
Seeding	Cut	Fill

SHEET	TOTAL
P. 163	228

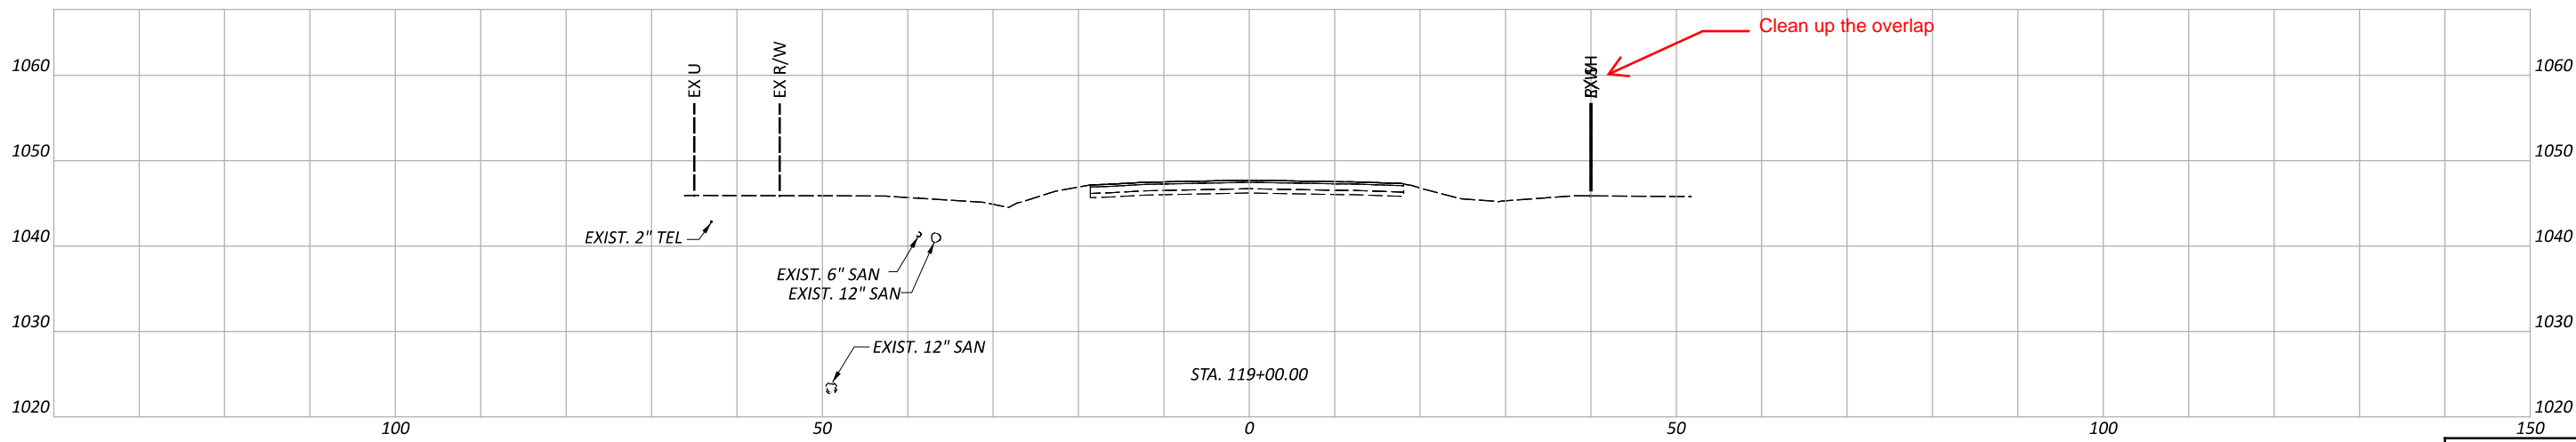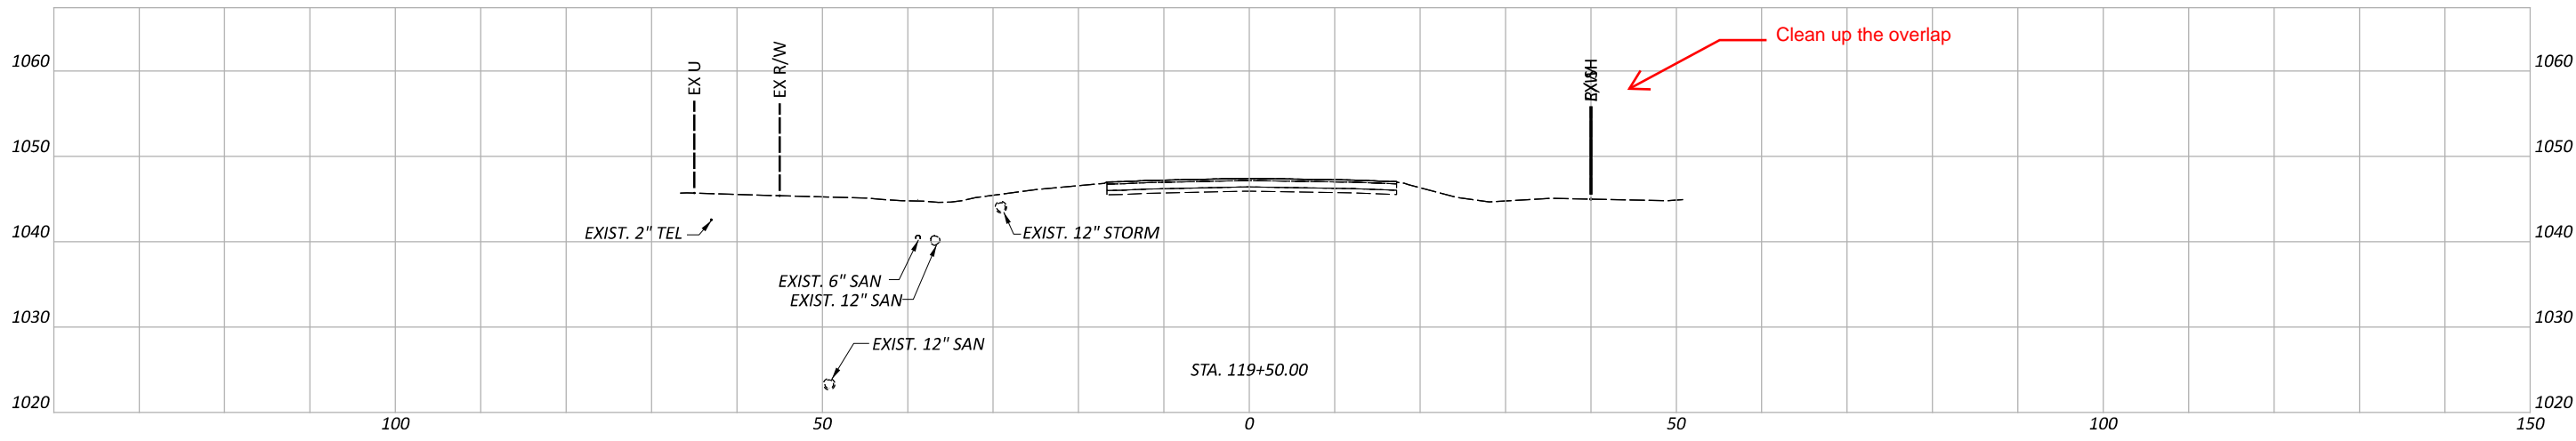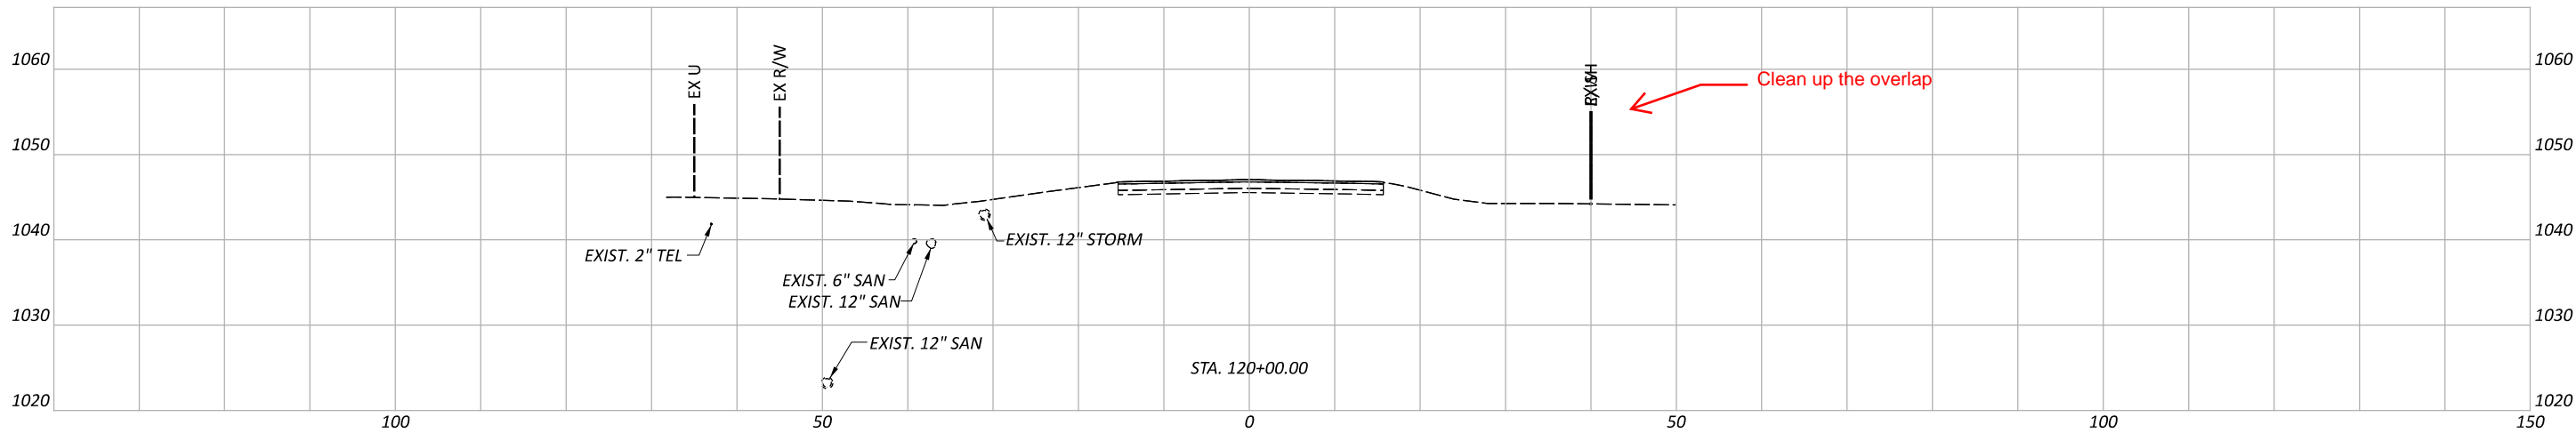

CROSS SECTIONS - SR 435 - EAST ROUNDABOUT APPROACH
 STA. 119+00 TO STA. 120+00

DESIGN AGENCY	
8350 E. KEMPER RD. SUITE B CINCINNATI, OH 45249 513-469-1600	
DESIGNER	
DPF	
REVIEWER	
DCJ MM-DD-YY	
PROJECT ID	
117955	
Sheet Totals	TOTAL
Seeding	P. 167
Cut	228
Fill	

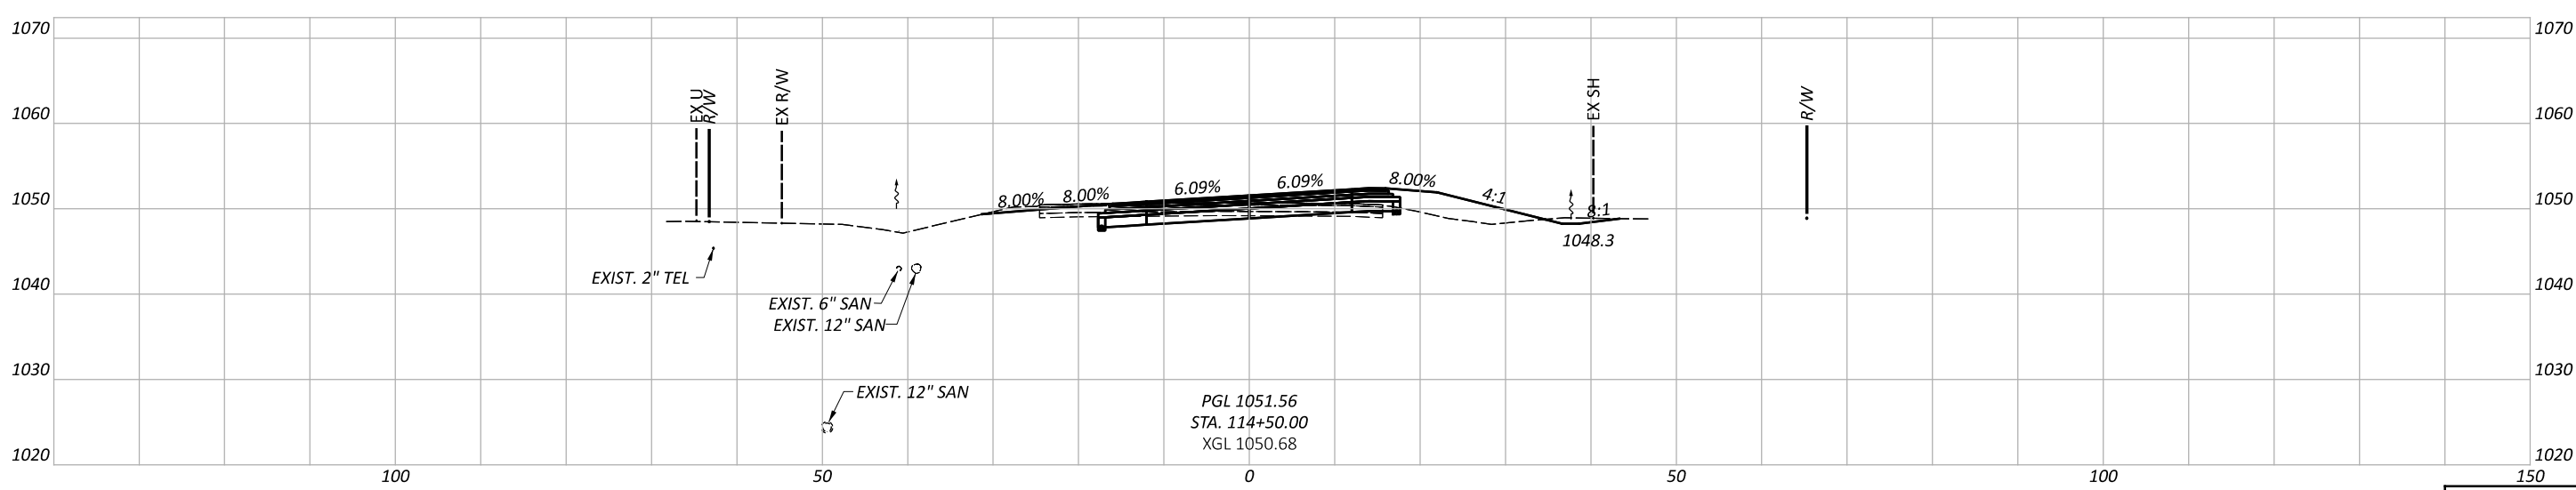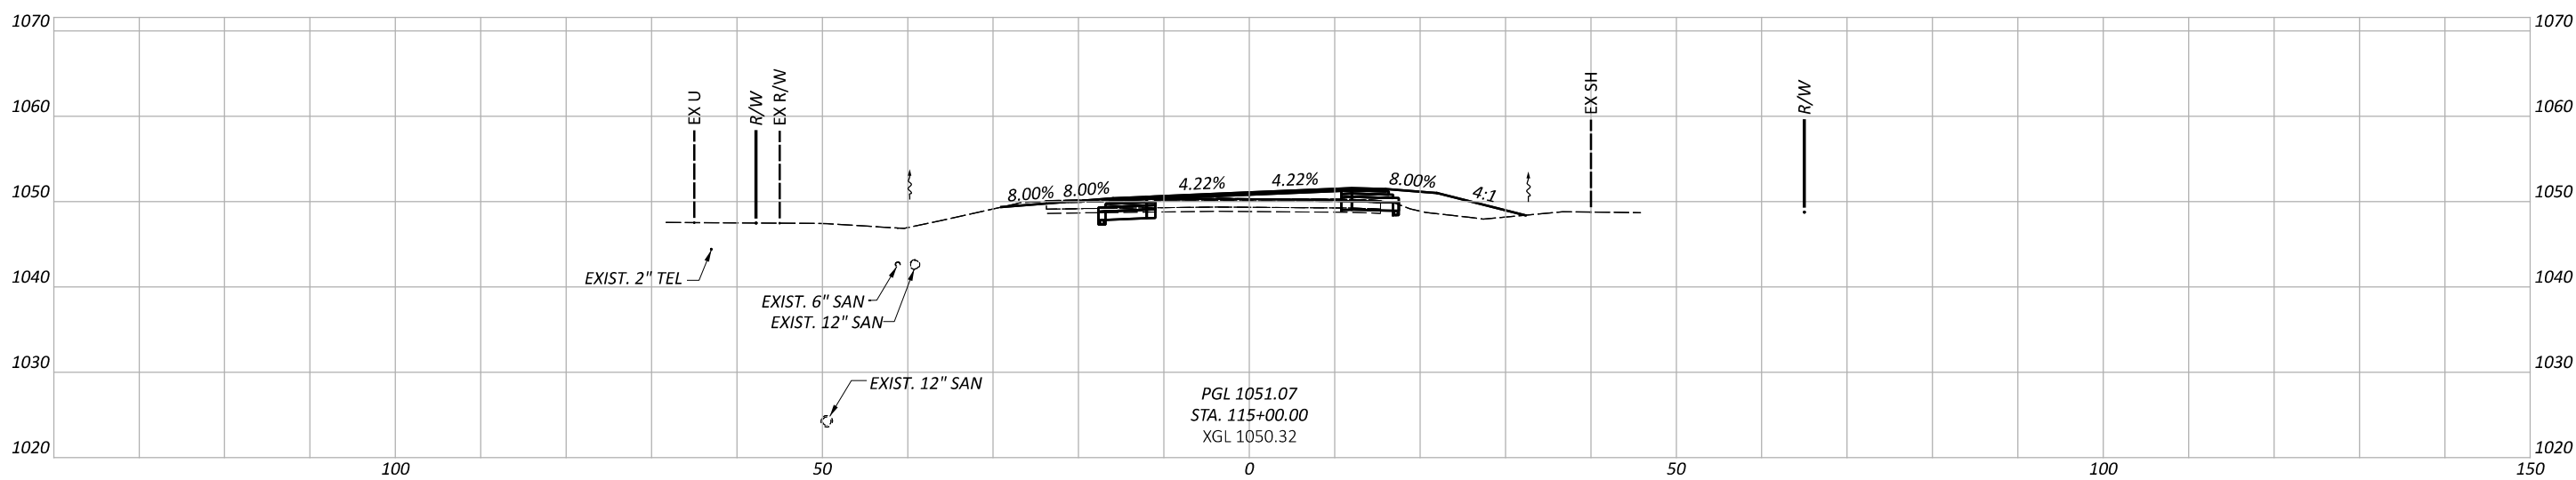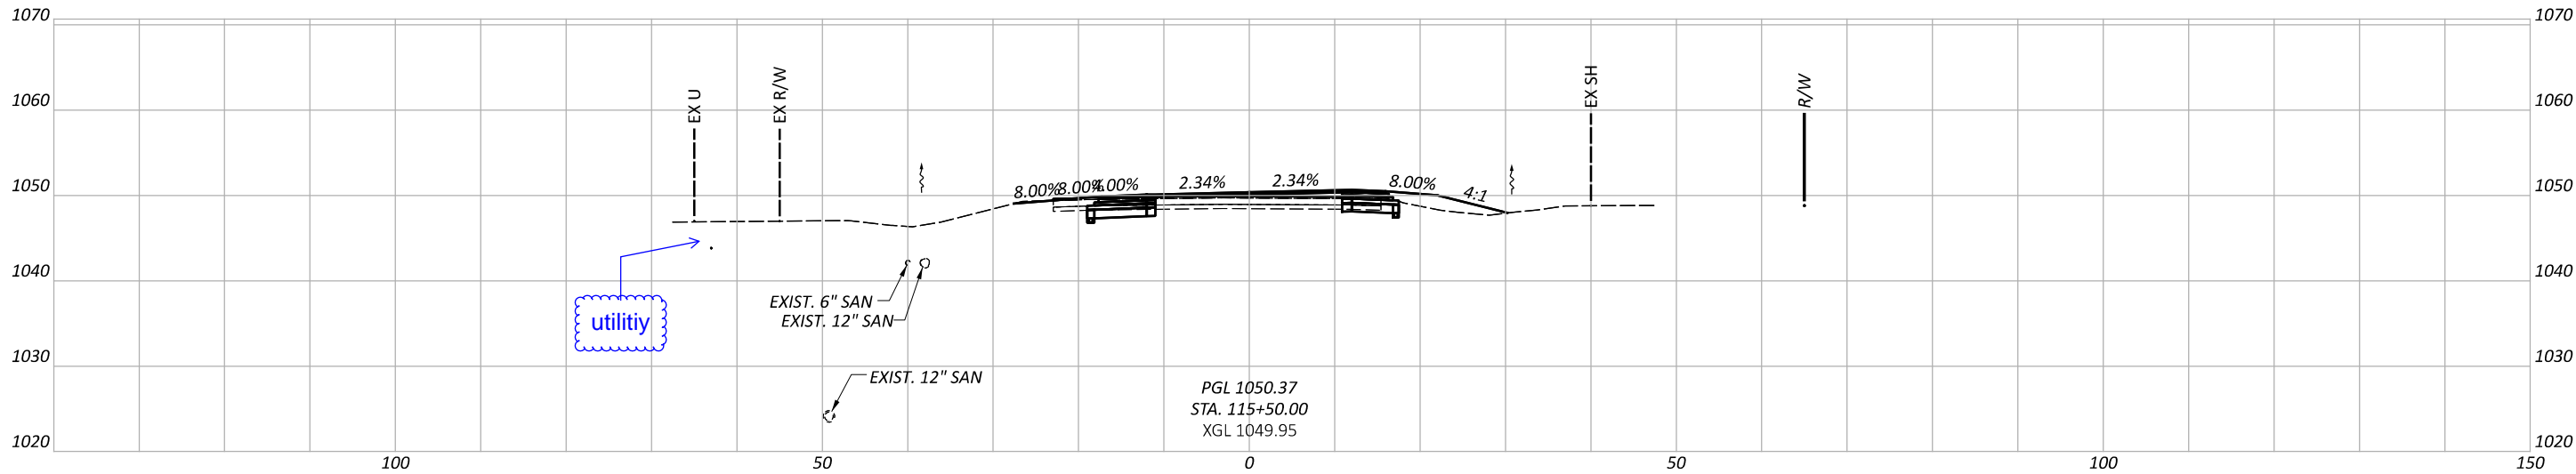




CROSS SECTIONS - SR 435 - EAST ROUNDABOUT APPROACH
 STA. 114+50 TO STA. 115+50

DESIGN AGENCY
Palmer
 ENGINEERING
 8350 E. KEMPER RD.
 SUITE B
 CINCINNATI, OH 45249
 513-469-1600

DESIGNER
 DPF
 REVIEWER
 DCJ MM-DD-YY

PROJECT ID
 117955
 SHEET TOTAL
 P. 164 228




Sheet Totals		
Seeding	Cut	Fill

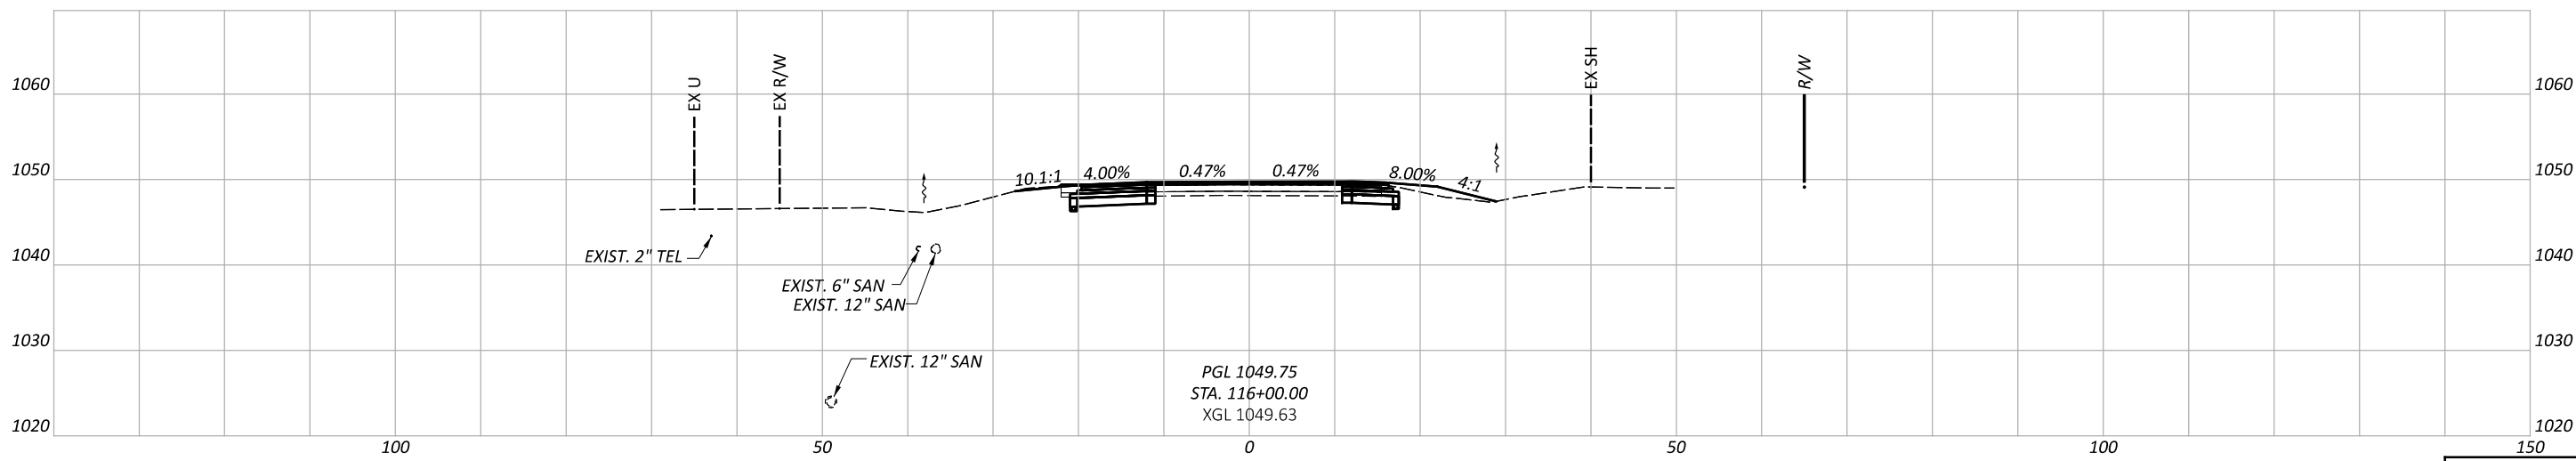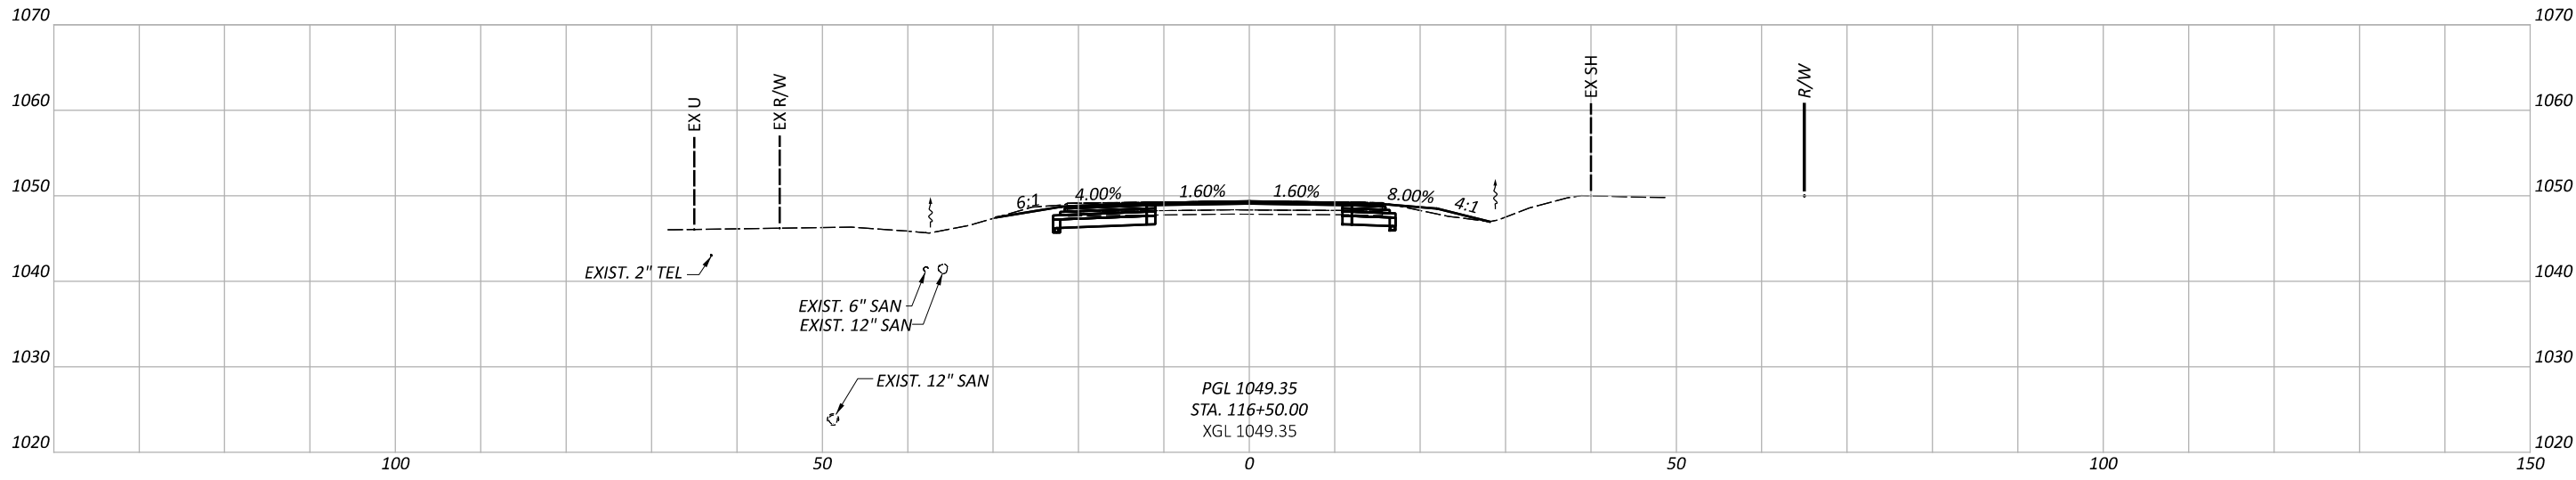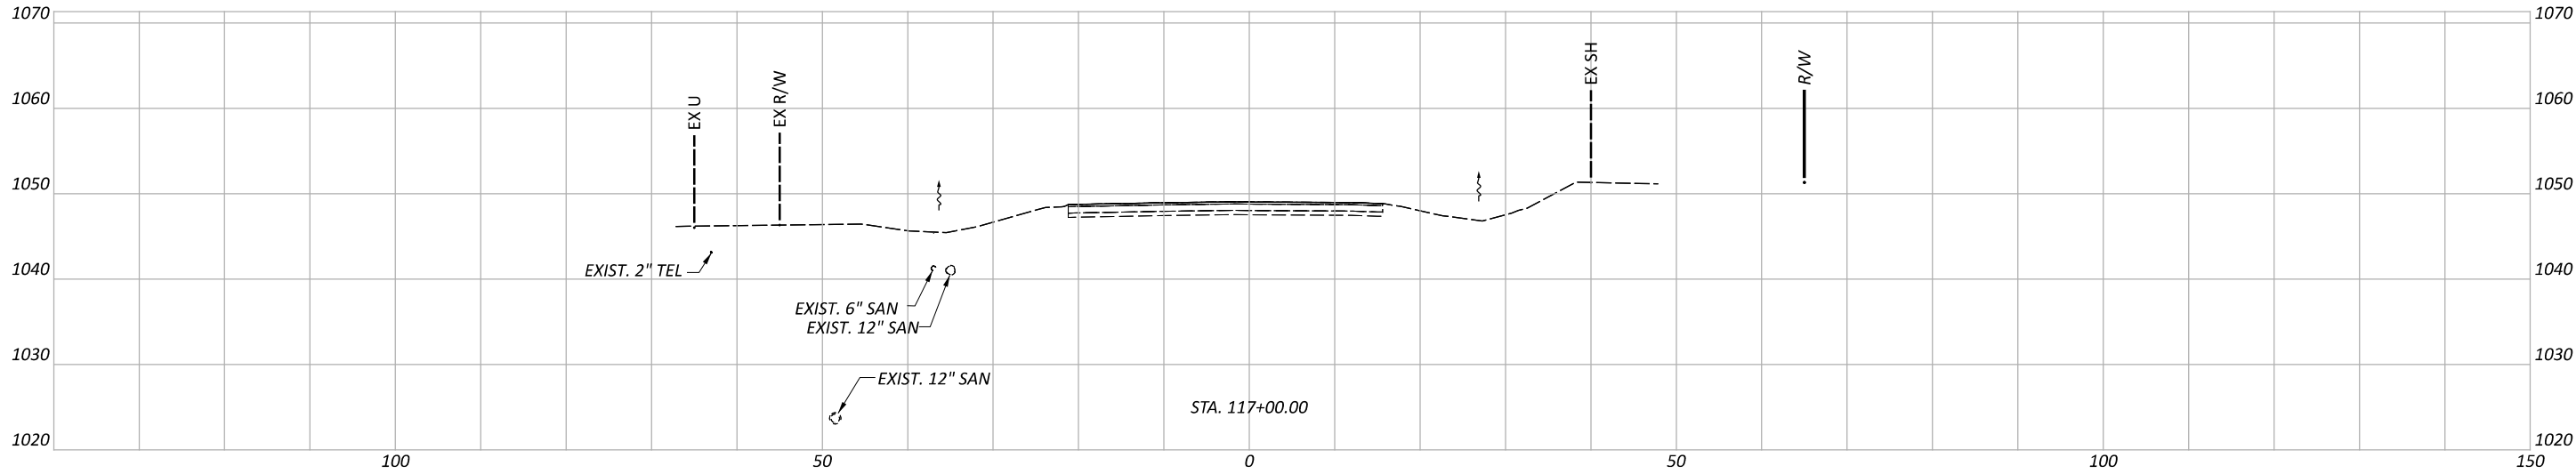

CROSS SECTIONS - SR 435 - EAST ROUNDABOUT APPROACH
 STA. 116+00 TO STA. 117+00

DESIGN AGENCY	
8350 E. KEMPER RD. SUITE B CINCINNATI, OH 45249 513-469-1600	
DESIGNER	
DPF	
REVIEWER	
DCJ MM-DD-YY	
PROJECT ID	
117955	
SHEET TOTAL	
P. 165	228

Sheet Totals		
Seeding	Cut	Fill

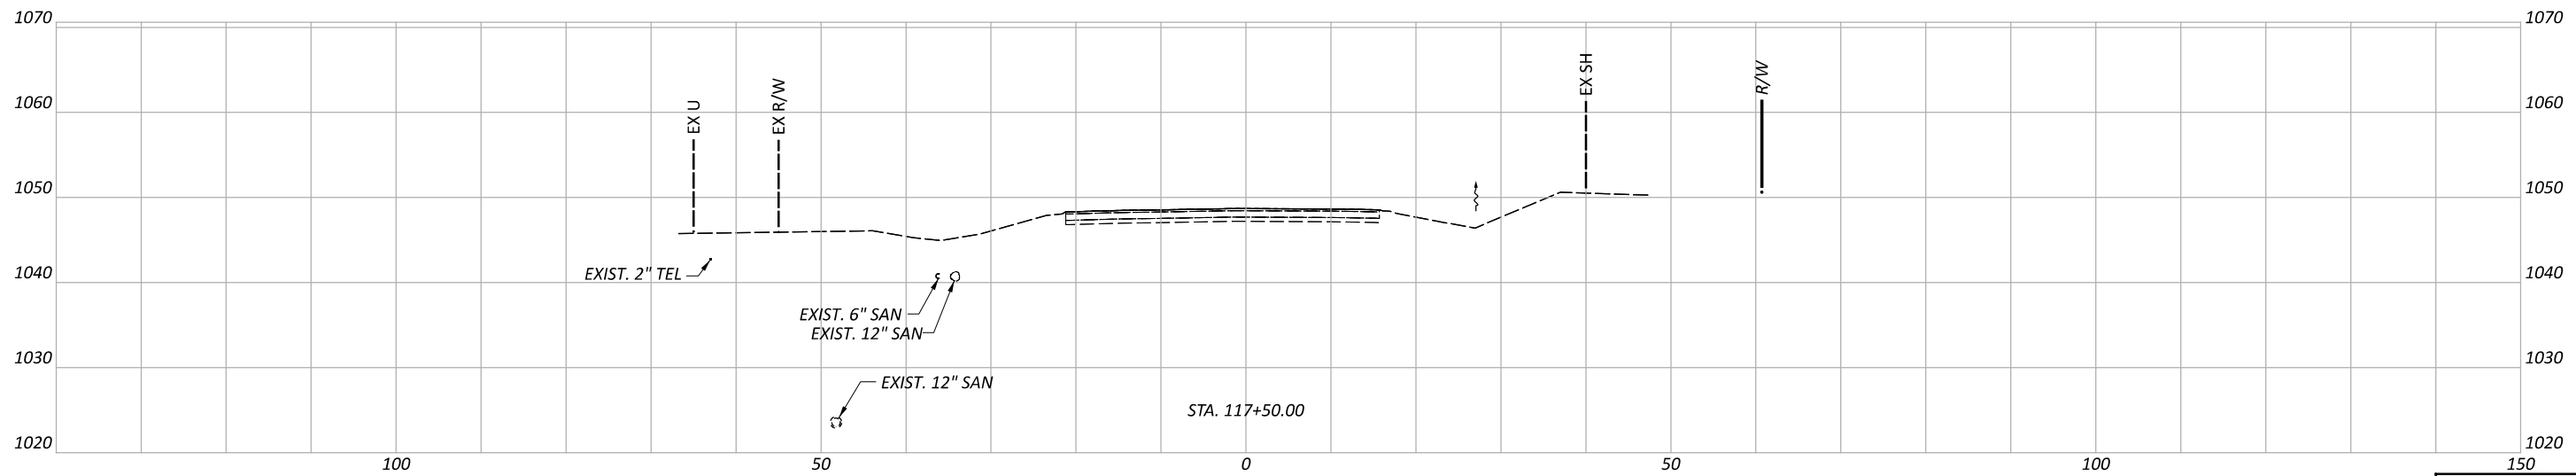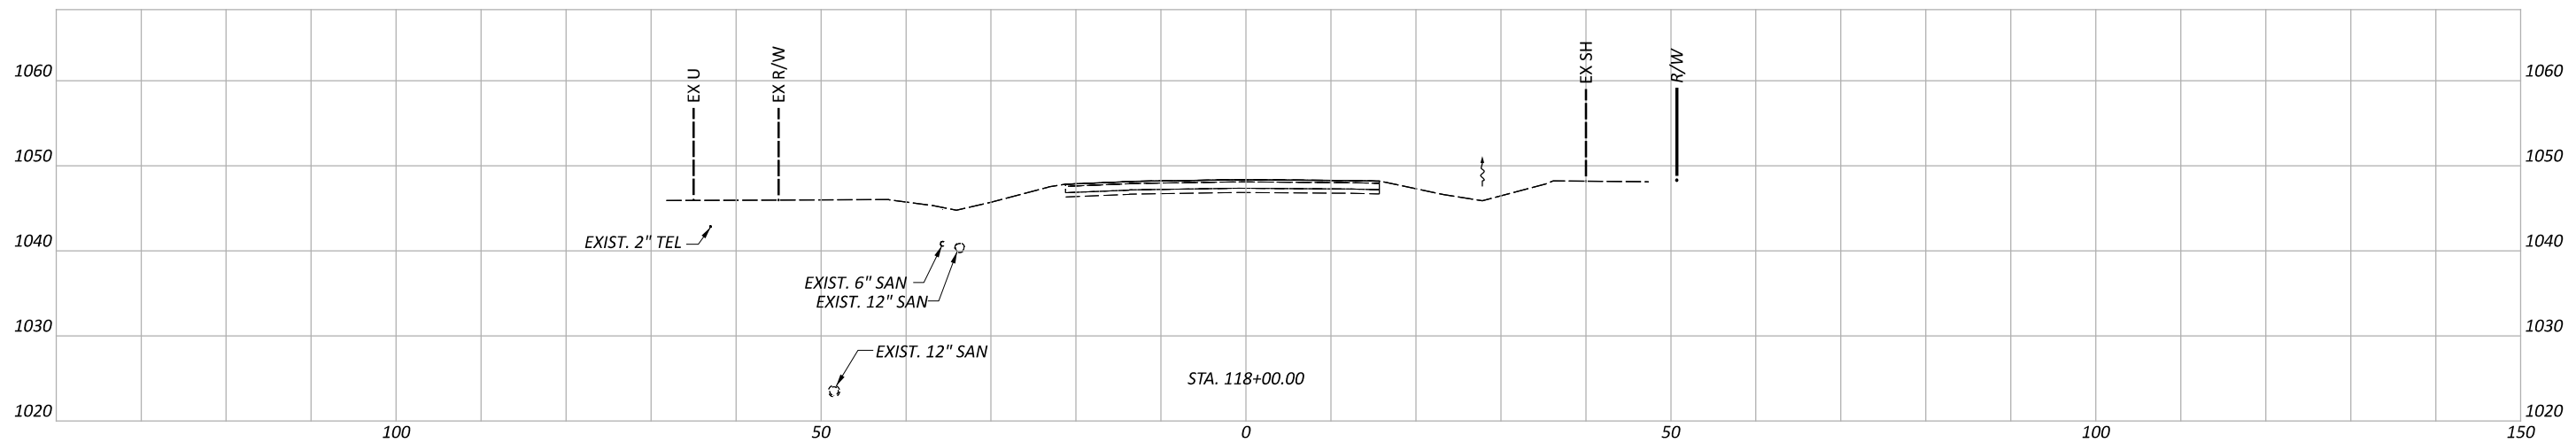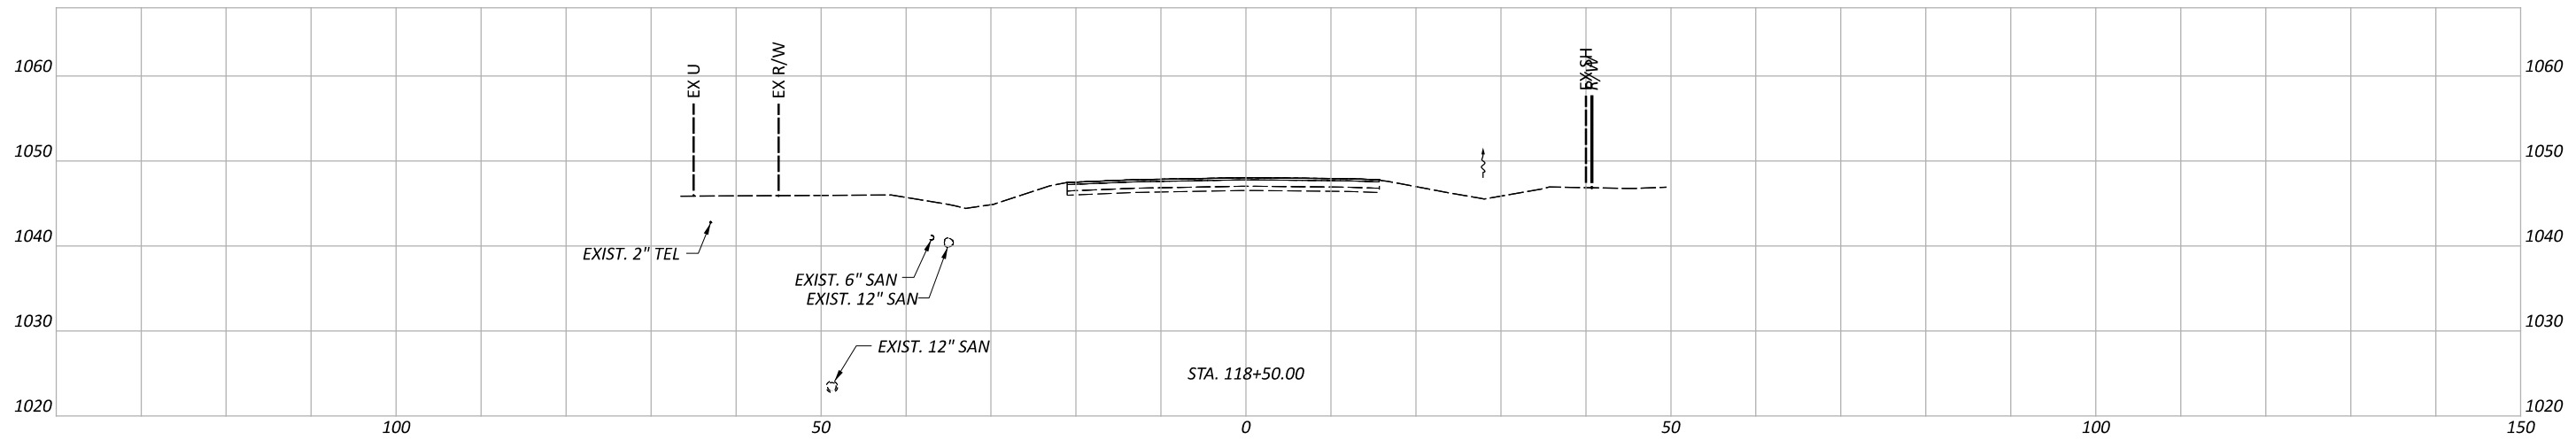

CROSS SECTIONS - SR 435 - EAST ROUNDABOUT APPROACH
 STA. 117+50 TO STA. 118+50

DESIGN AGENCY



DESIGNER

REVIEWER




DCJ MM-DD-YY

PROJECT ID

117955

Sheet Totals		
Seeding	Cut	Fill

SHEET	TOTAL
P. 166	228

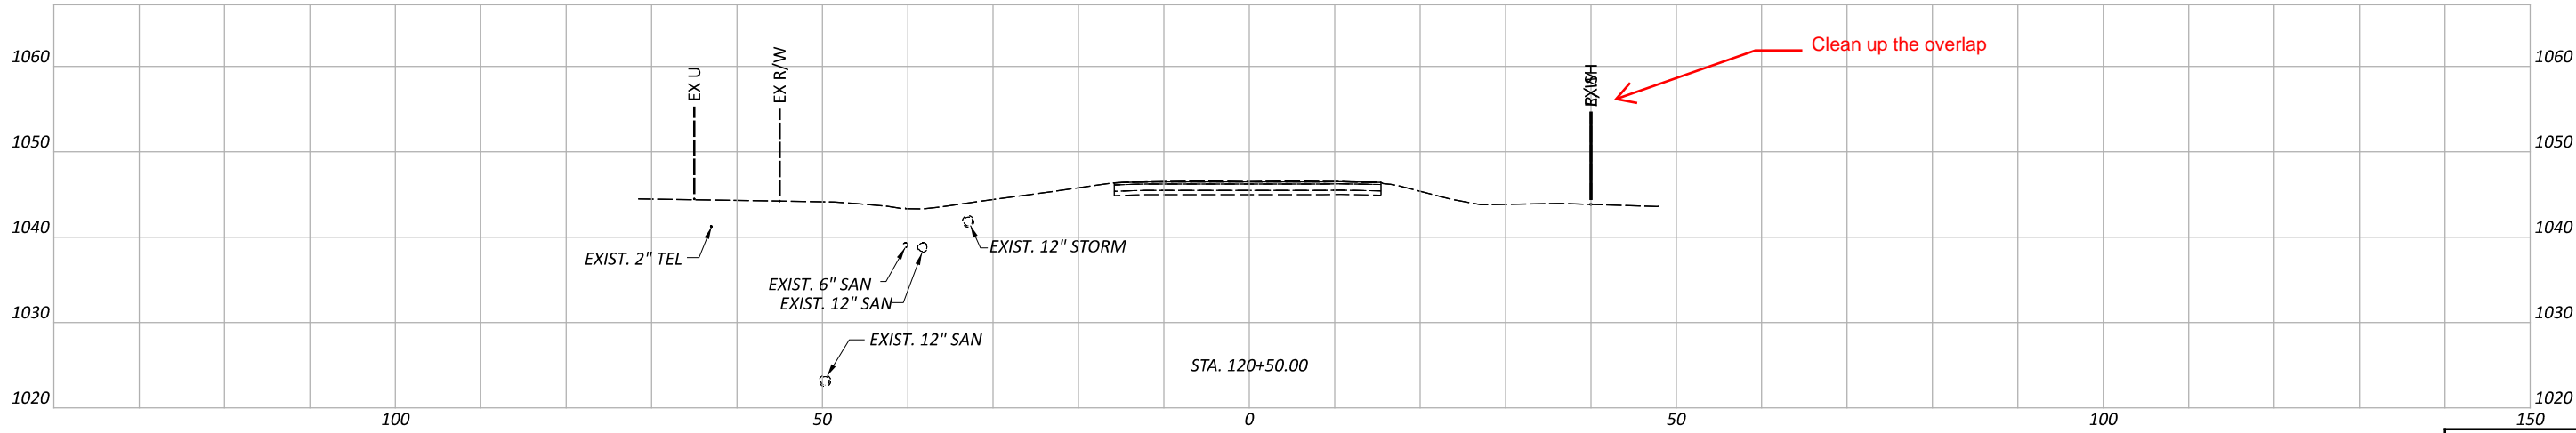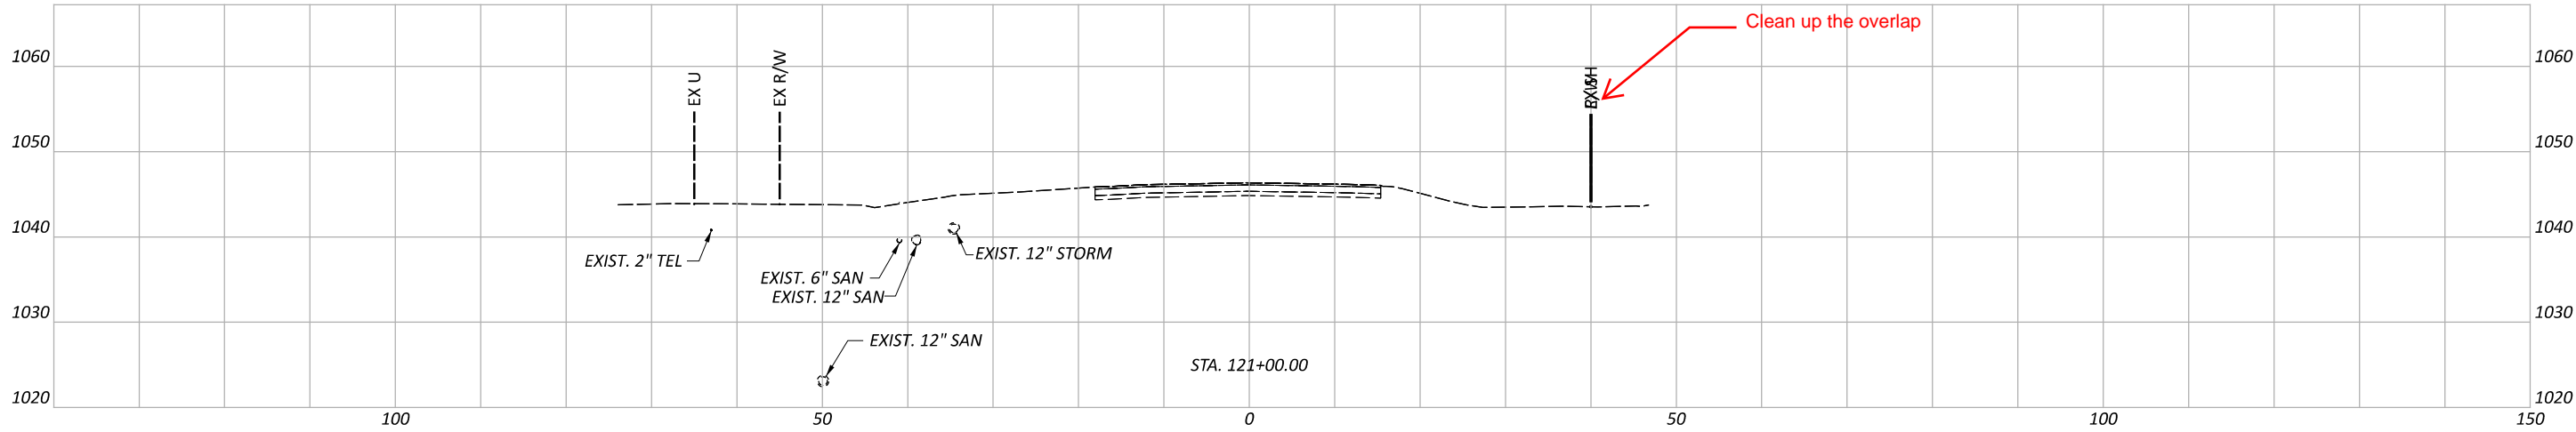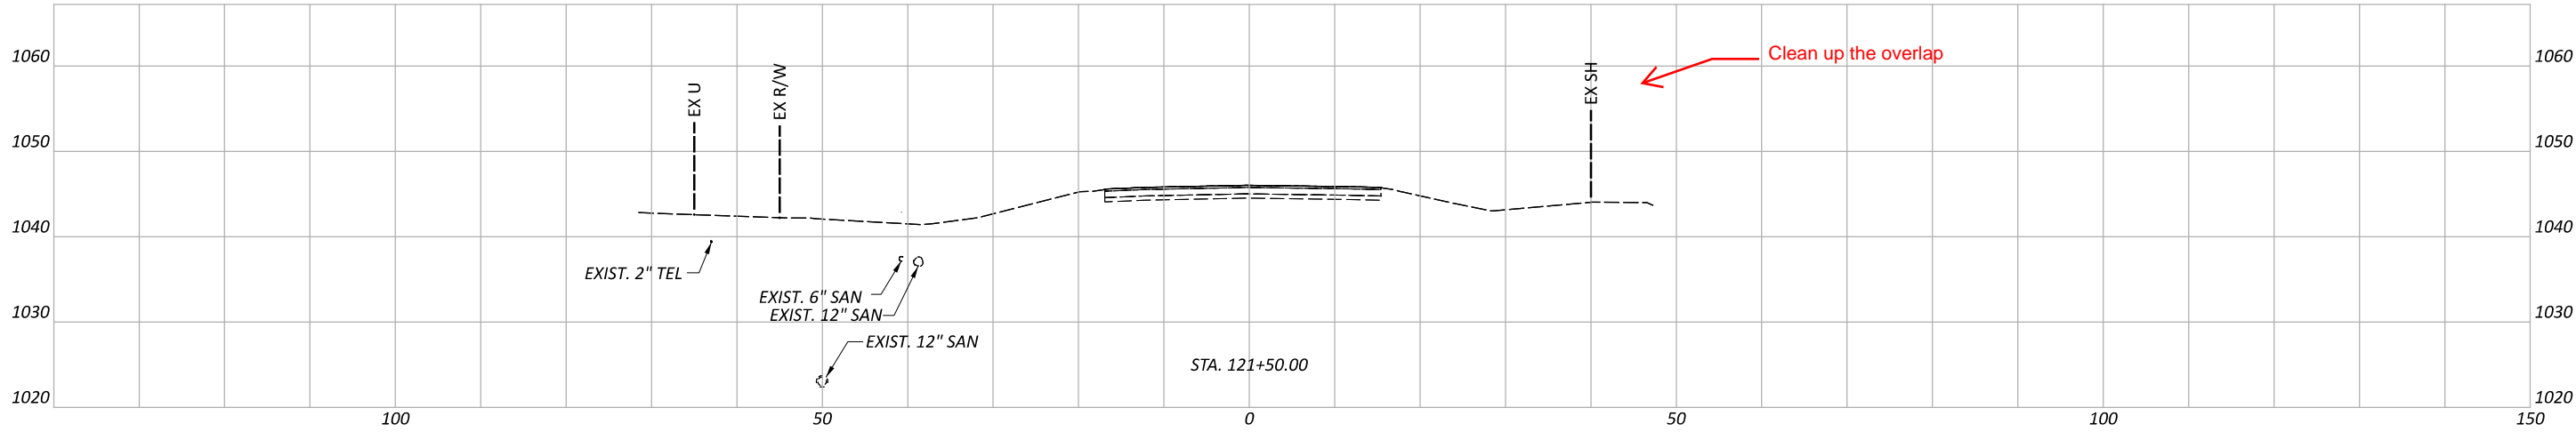



CROSS SECTIONS - SR 435 - EAST ROUNDABOUT APPROACH
 STA. 120+50 TO STA. 121+50

DESIGN AGENCY
Palmer
 ENGINEERING
 8350 E. KEMPER RD.
 SUITE B
 CINCINNATI, OH 45249
 513-469-1600

DESIGNER
 DPF
 REVIEWER
 DCJ MM-DD-YY

PROJECT ID
 117955
 SHEET TOTAL
 P. 168 228



Sheet Totals		
Seeding	Cut	Fill

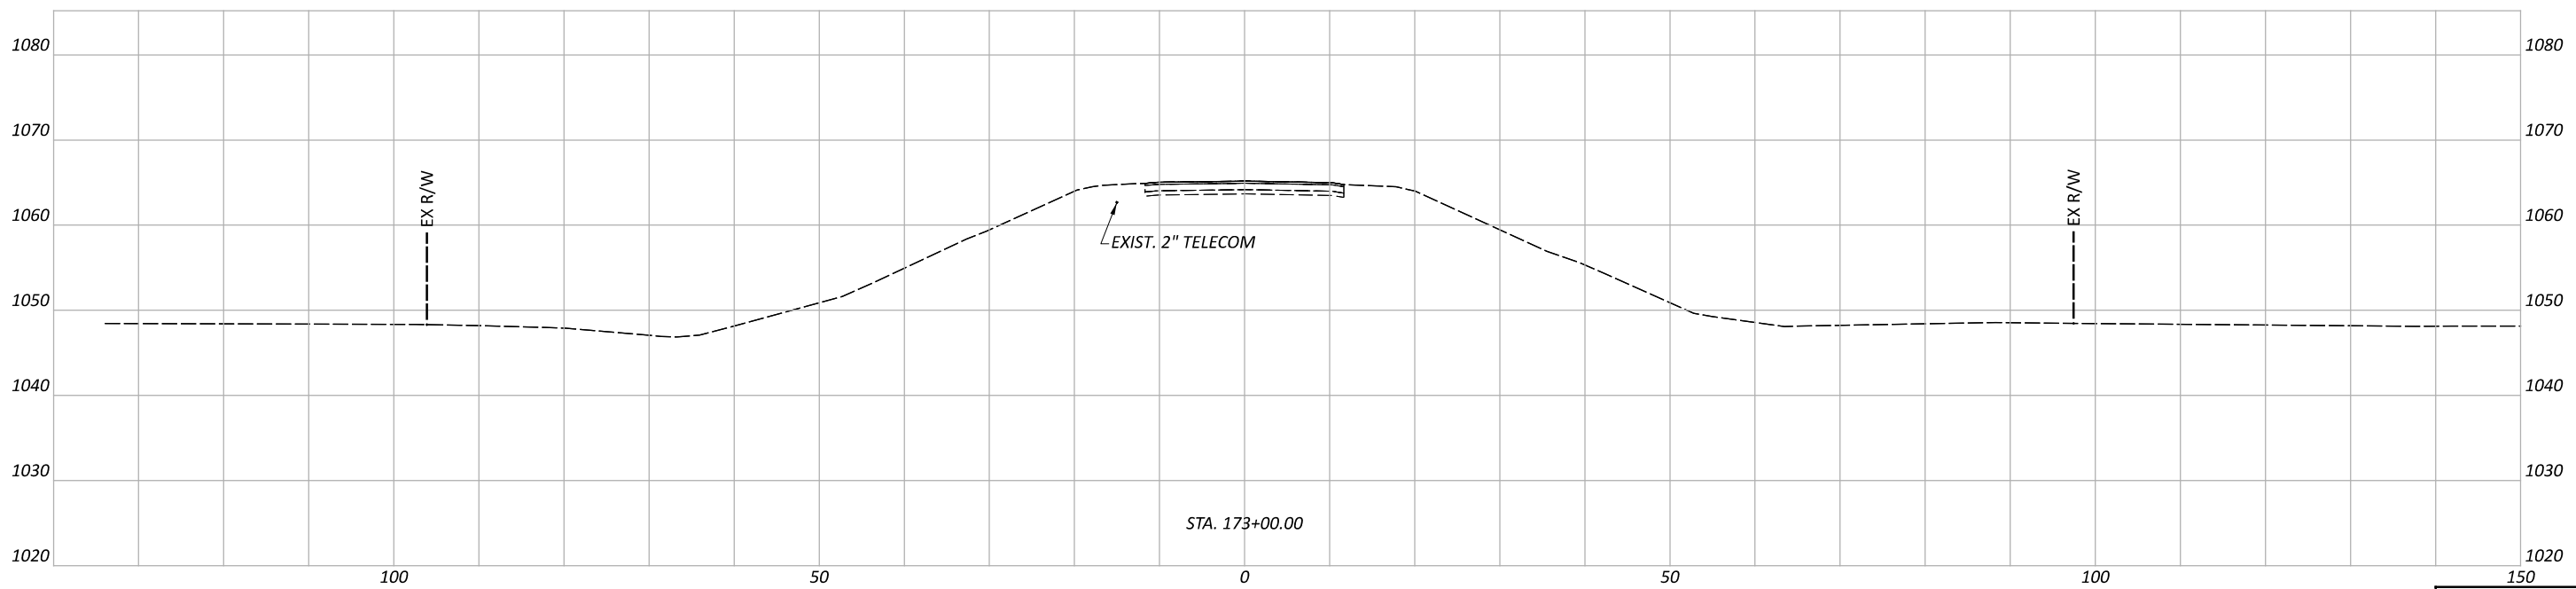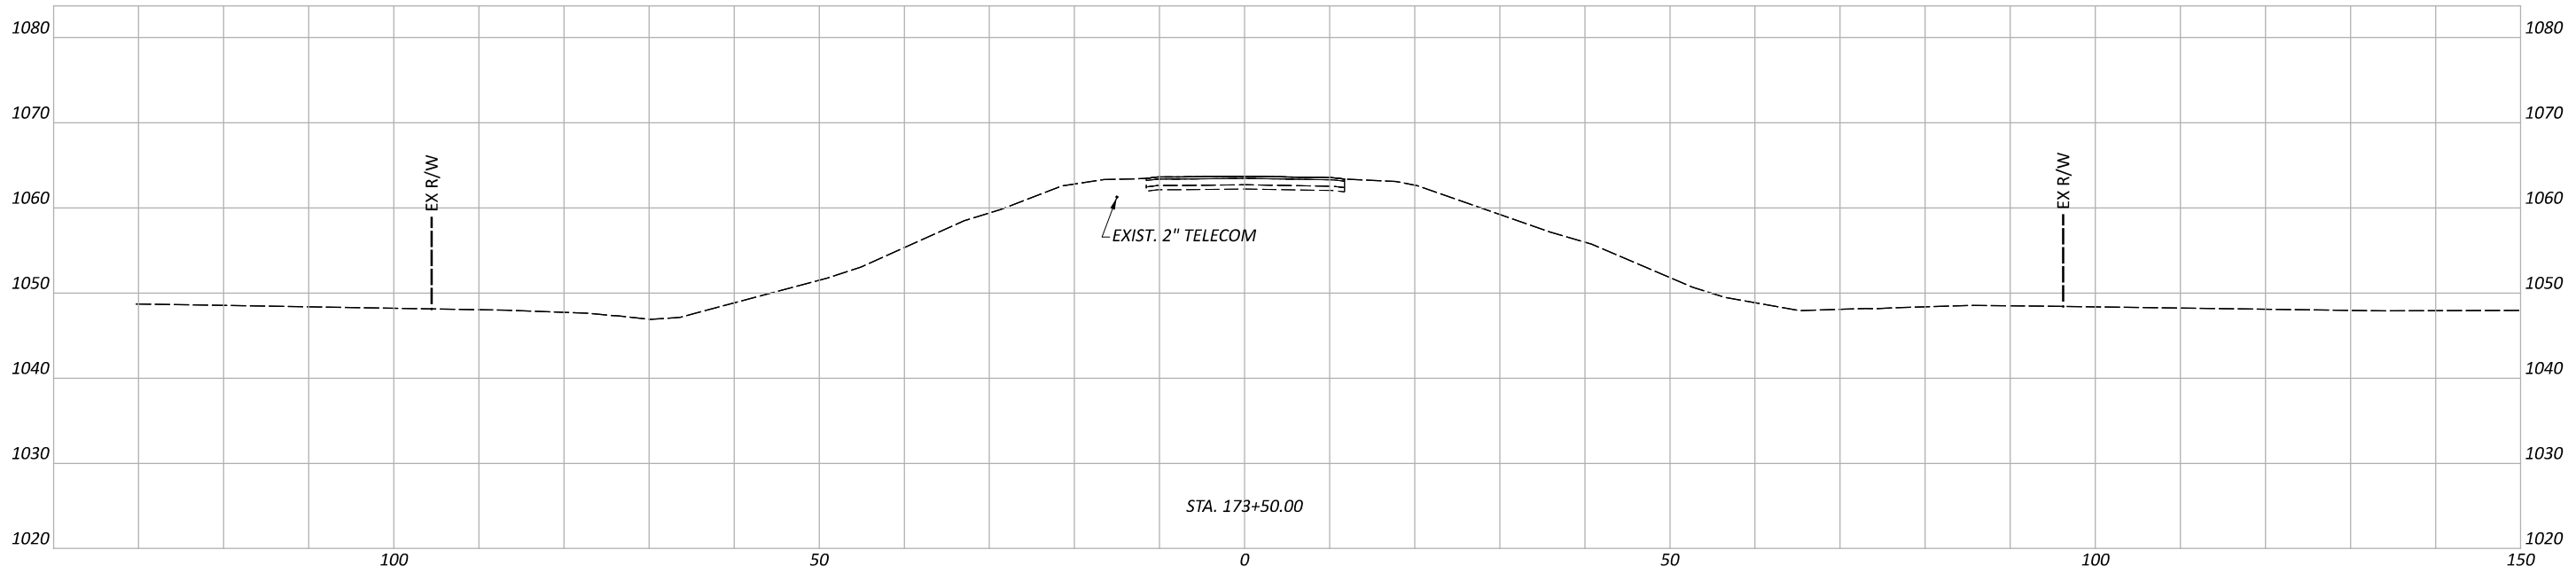

CROSS SECTIONS - SR 729 - SOUTH ROUNDABOUT APPROACH
 STA. 173+00 TO STA. 173+50

DESIGN AGENCY	Palmer ENGINEERING
DESIGNER	DPF
REVIEWER	DCJ MM-DD-YY
PROJECT ID	117955
SHEET TOTAL	P. 169 / 228


Sheet Totals		
Seeding	Cut	Fill

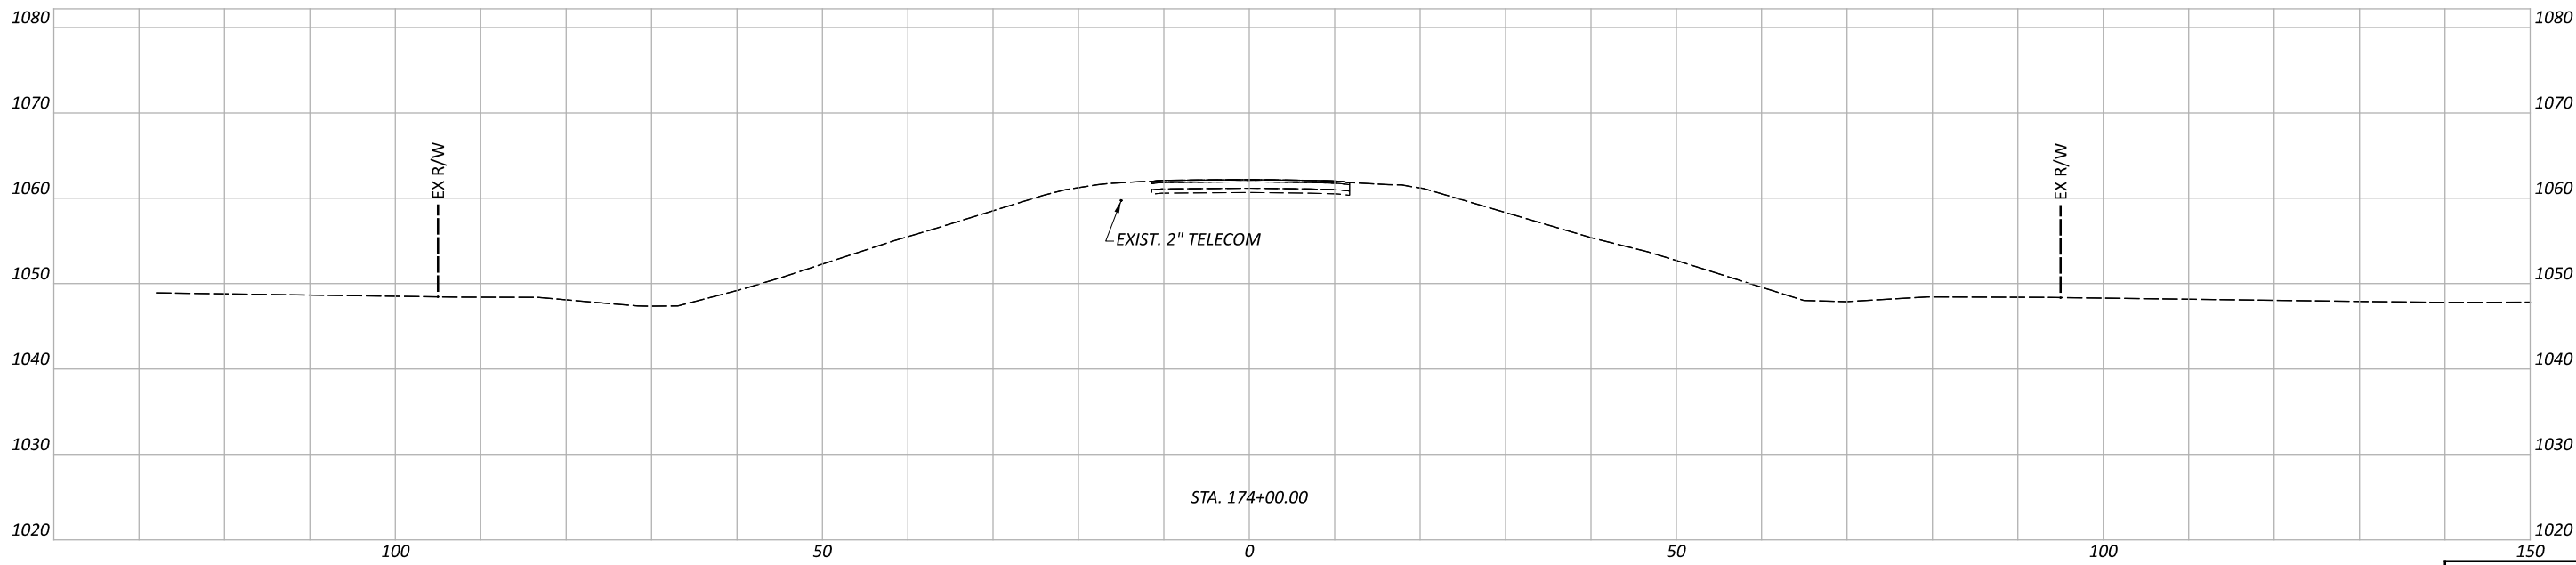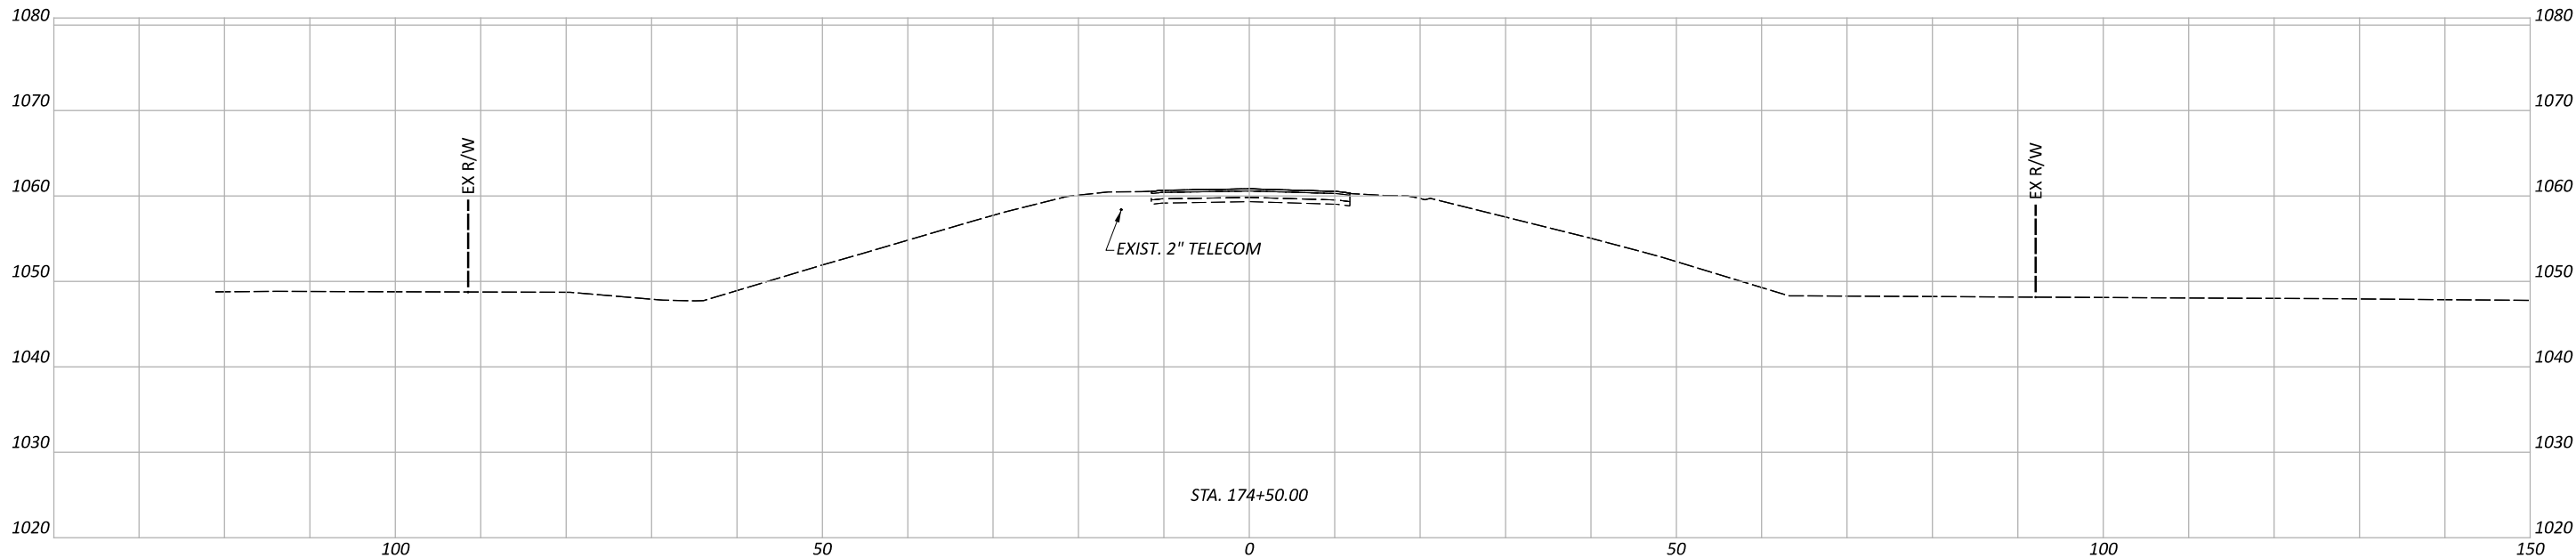

CROSS SECTIONS - SR 729 - SOUTH ROUNDABOUT APPROACH
 STA. 174+00 TO STA. 174+50


DESIGN AGENCY	Palmer ENGINEERING
DESIGNER	DPF
REVIEWER	DCJ MM-DD-YY
PROJECT ID	117955
SHEET	TOTAL
P. 170	228

Sheet Totals		
Seeding	Cut	Fill

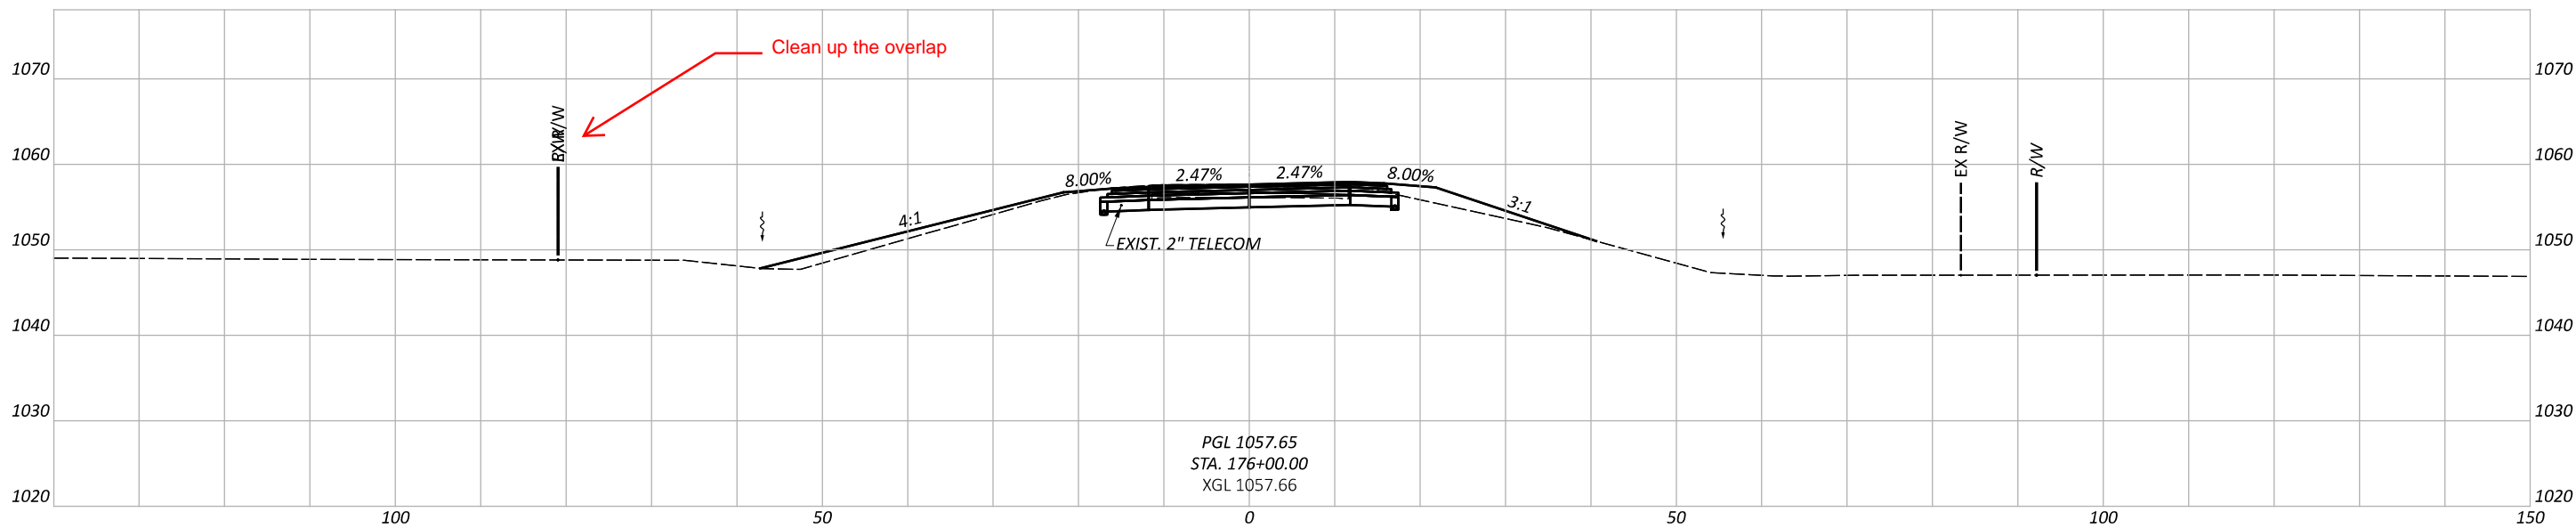


PGL 1057.65
 STA. 176+00.00
 XGL 1057.66

Clean up the overlap

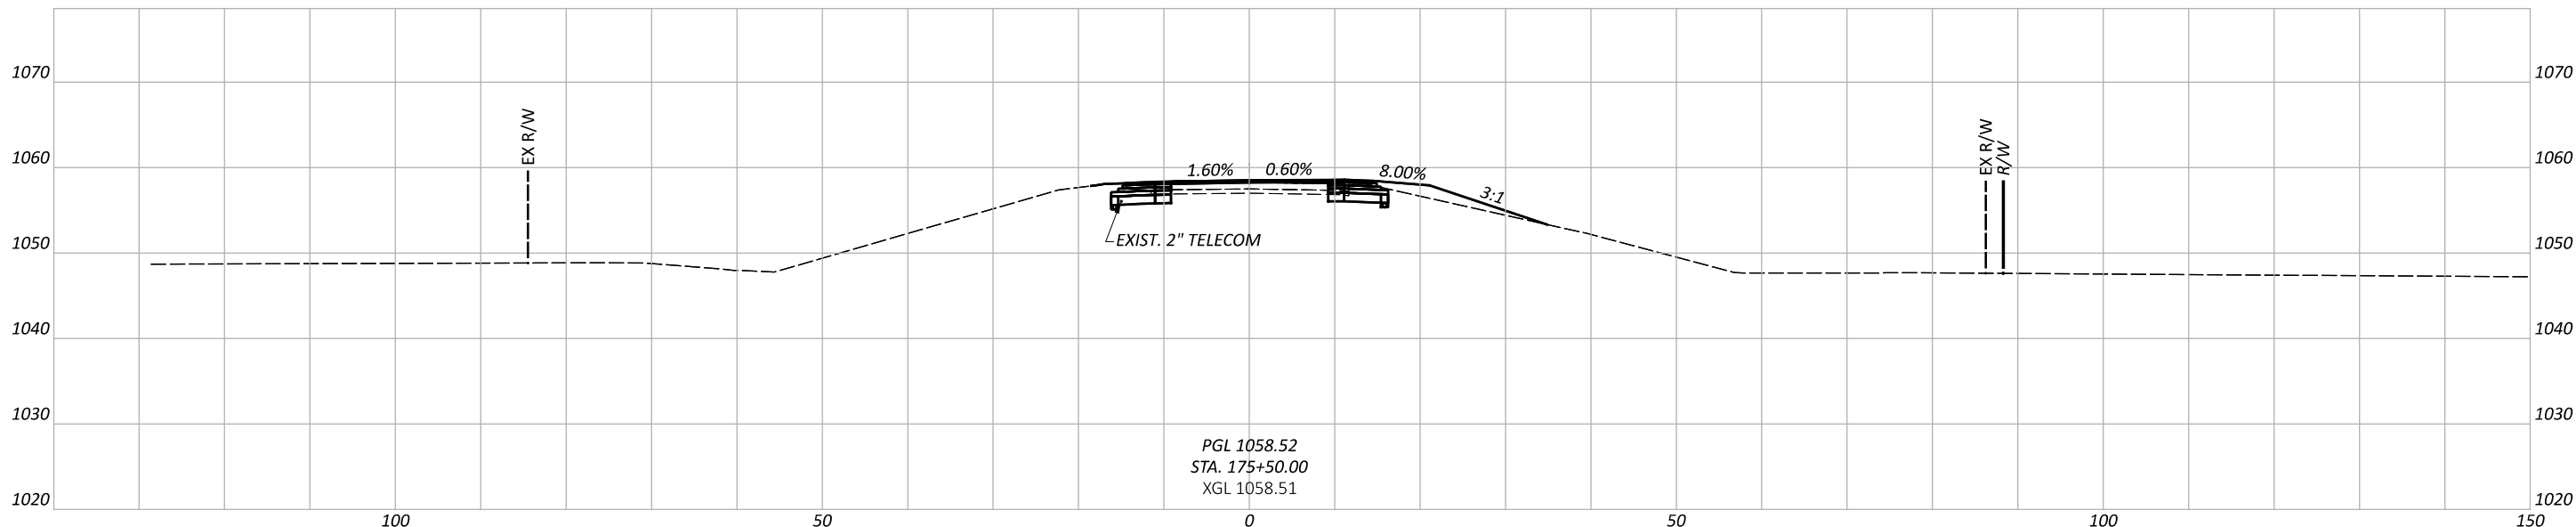


PGL 1058.52
 STA. 175+50.00
 XGL 1058.51

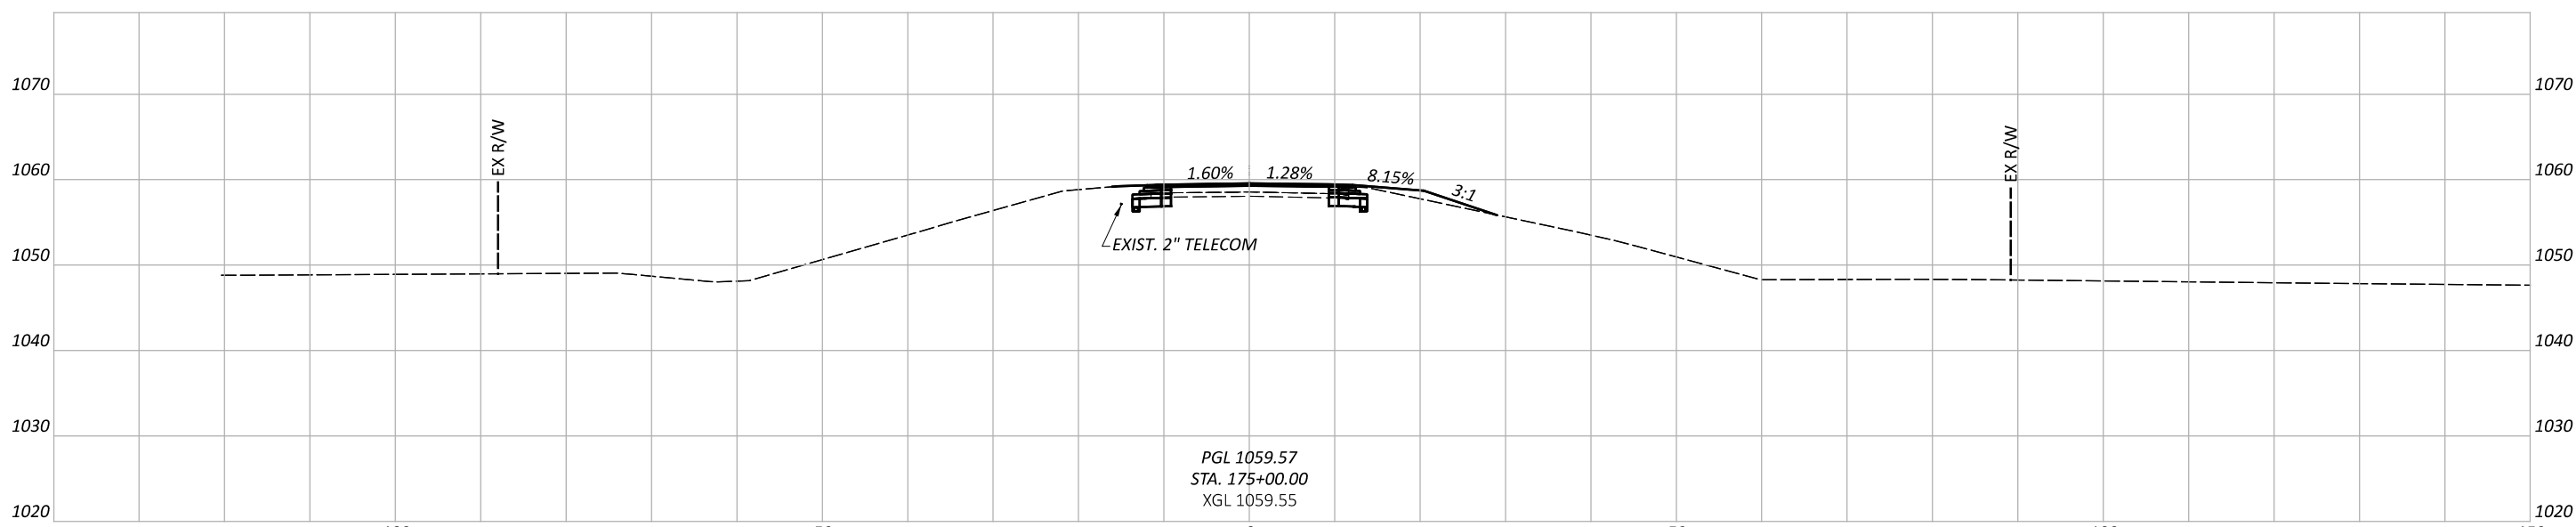

PGL 1059.57
 STA. 175+00.00
 XGL 1059.55

CROSS SECTIONS - SR 729 - SOUTH ROUNDABOUT APPROACH
 STA. 175+00 TO STA. 176+00




DESIGN AGENCY

 8350 E. KEMPER RD.
 SUITE B
 CINCINNATI, OH 45249
 513-469-1600

DESIGNER
 DPF

REVIEWER
 DCJ MM-DD-YY

PROJECT ID
 117955

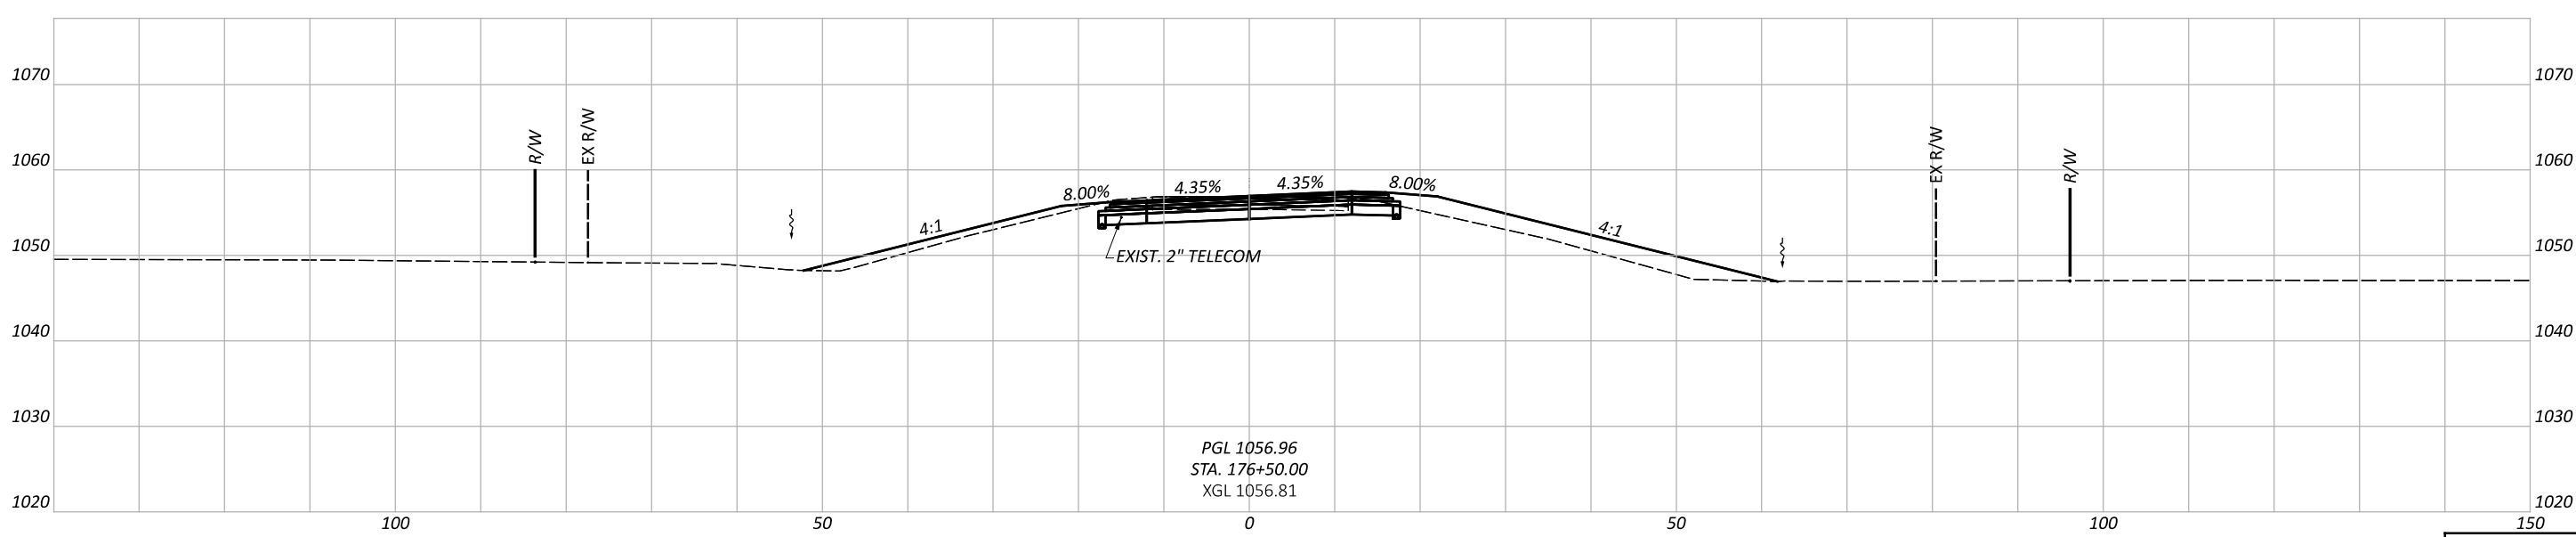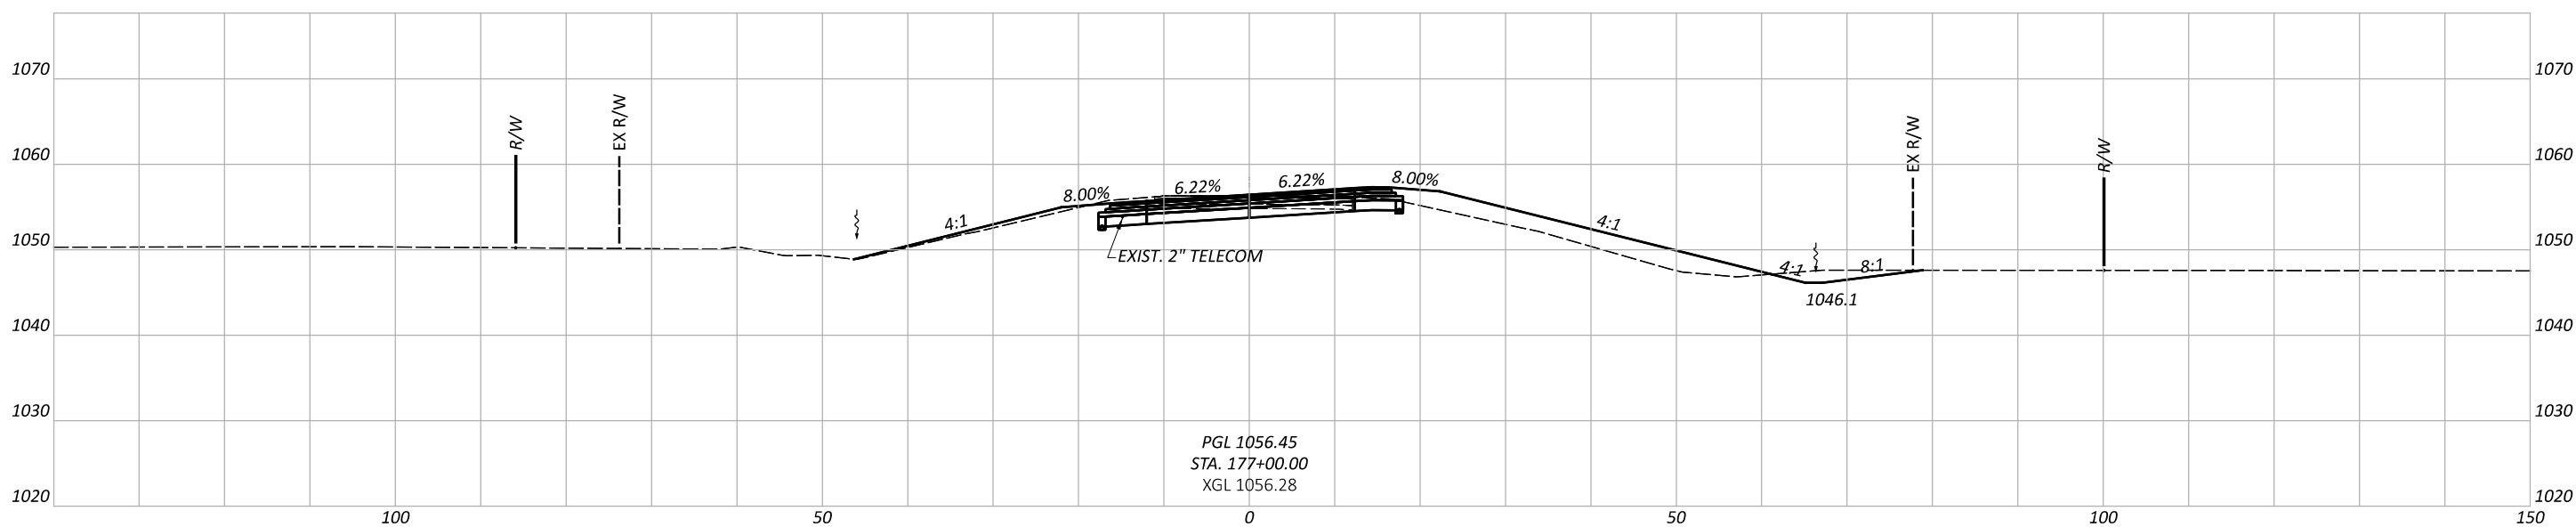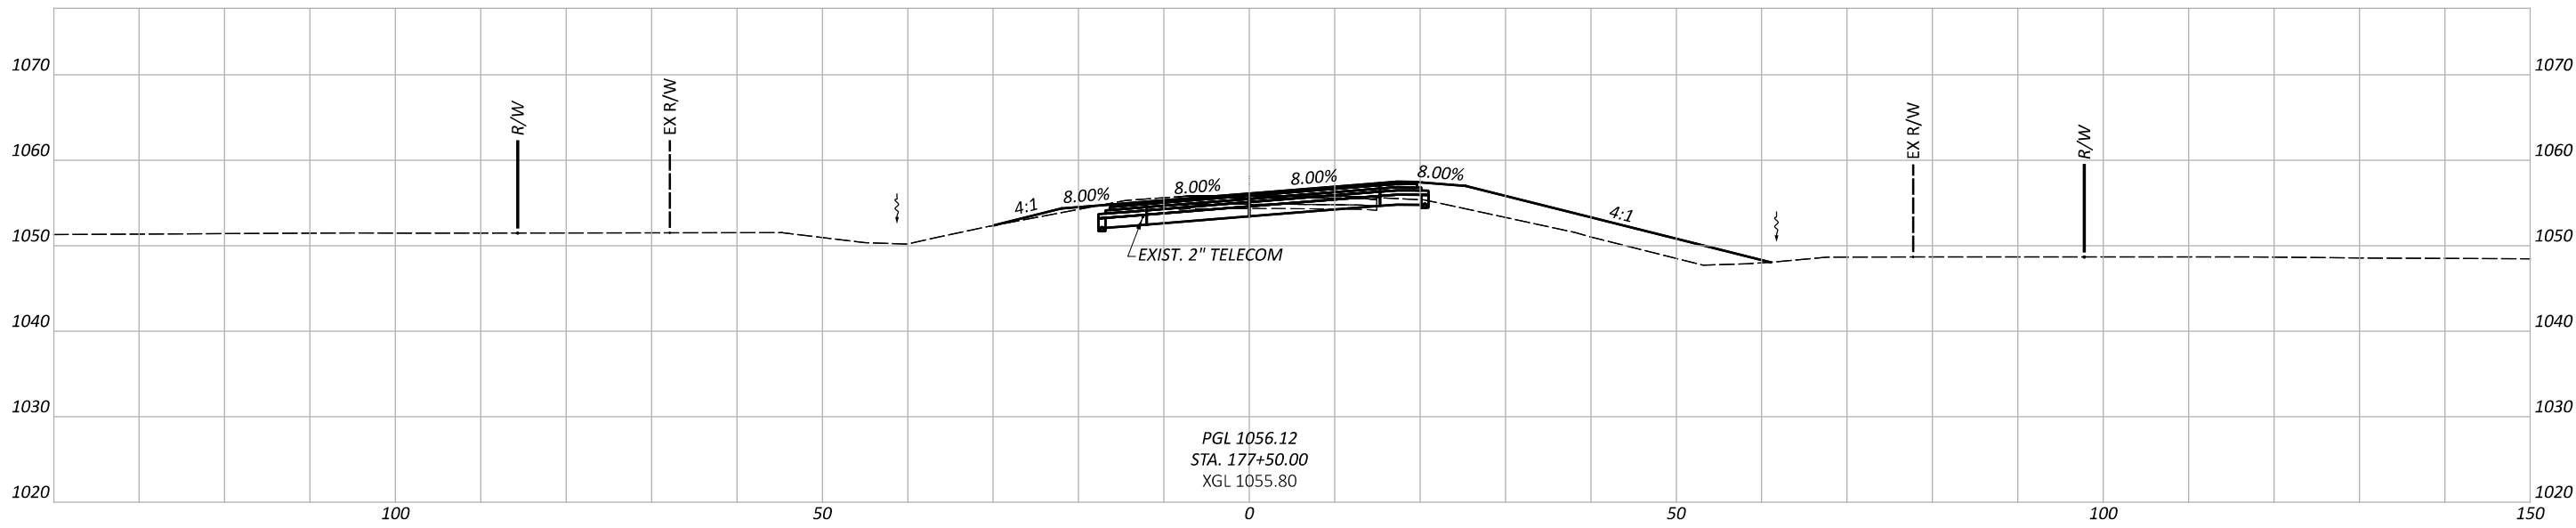Sheet Totals			TOTAL	
Seeding	Cut	Fill	SHEET	TOTAL
			P. 171	228



CROSS SECTIONS - SR 729 - SOUTH ROUNDABOUT APPROACH
 STA. 176+50 TO STA. 177+50




DESIGN AGENCY
Palmer
 ENGINEERING
 8350 E. KEMPER RD.
 SUITE B
 CINCINNATI, OH 45249
 513-469-1600

DESIGNER
 DPF


REVIEWER
 DCJ MM-DD-YY

PROJECT ID
 117955

Sheet Totals		
Seeding	Cut	Fill
SHEET		TOTAL
P. 172		228

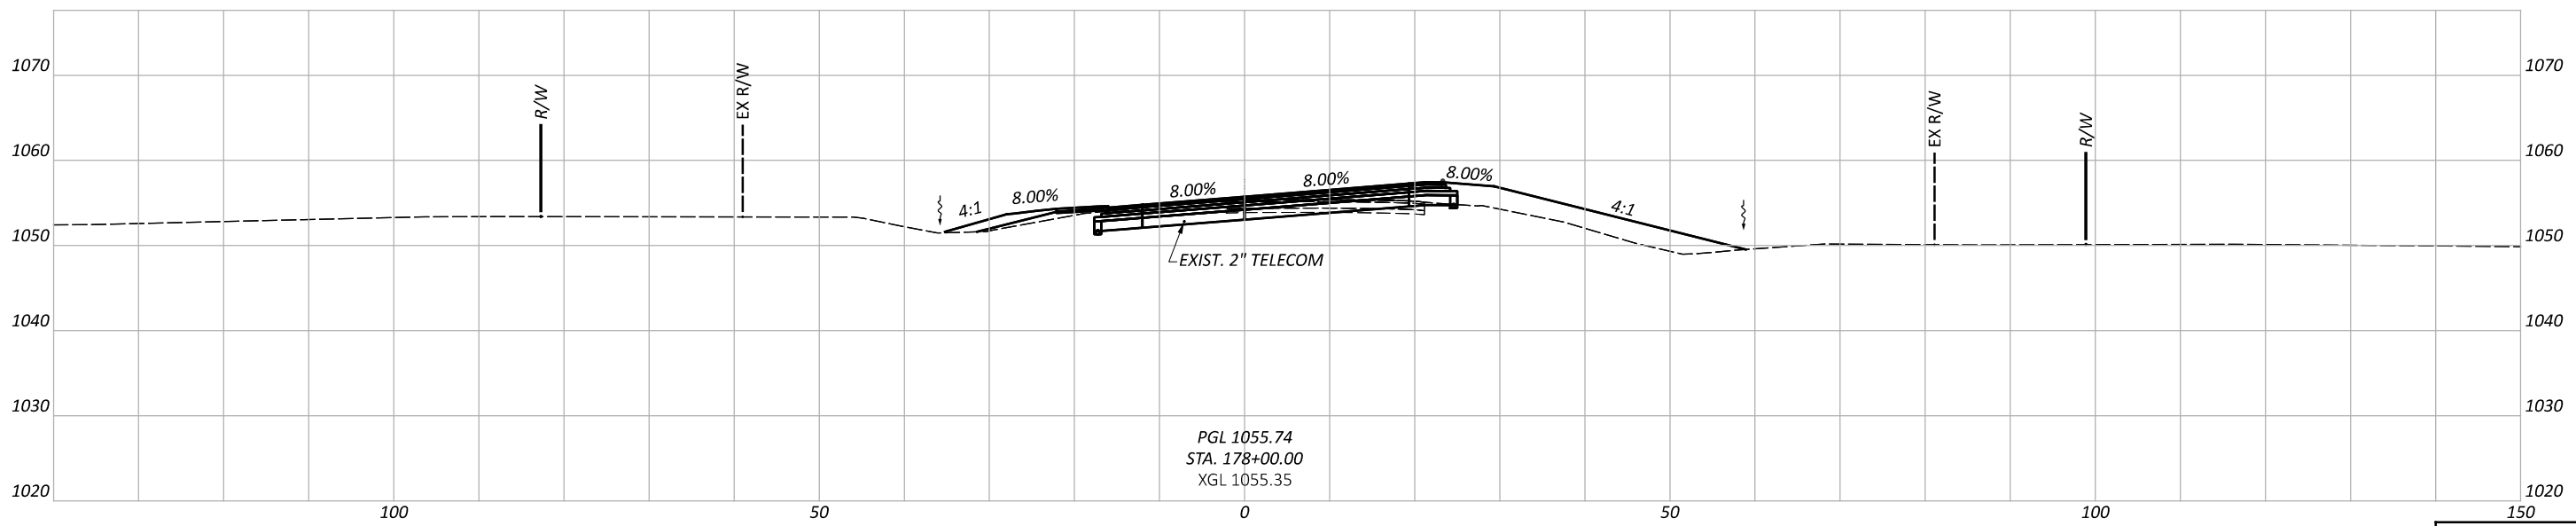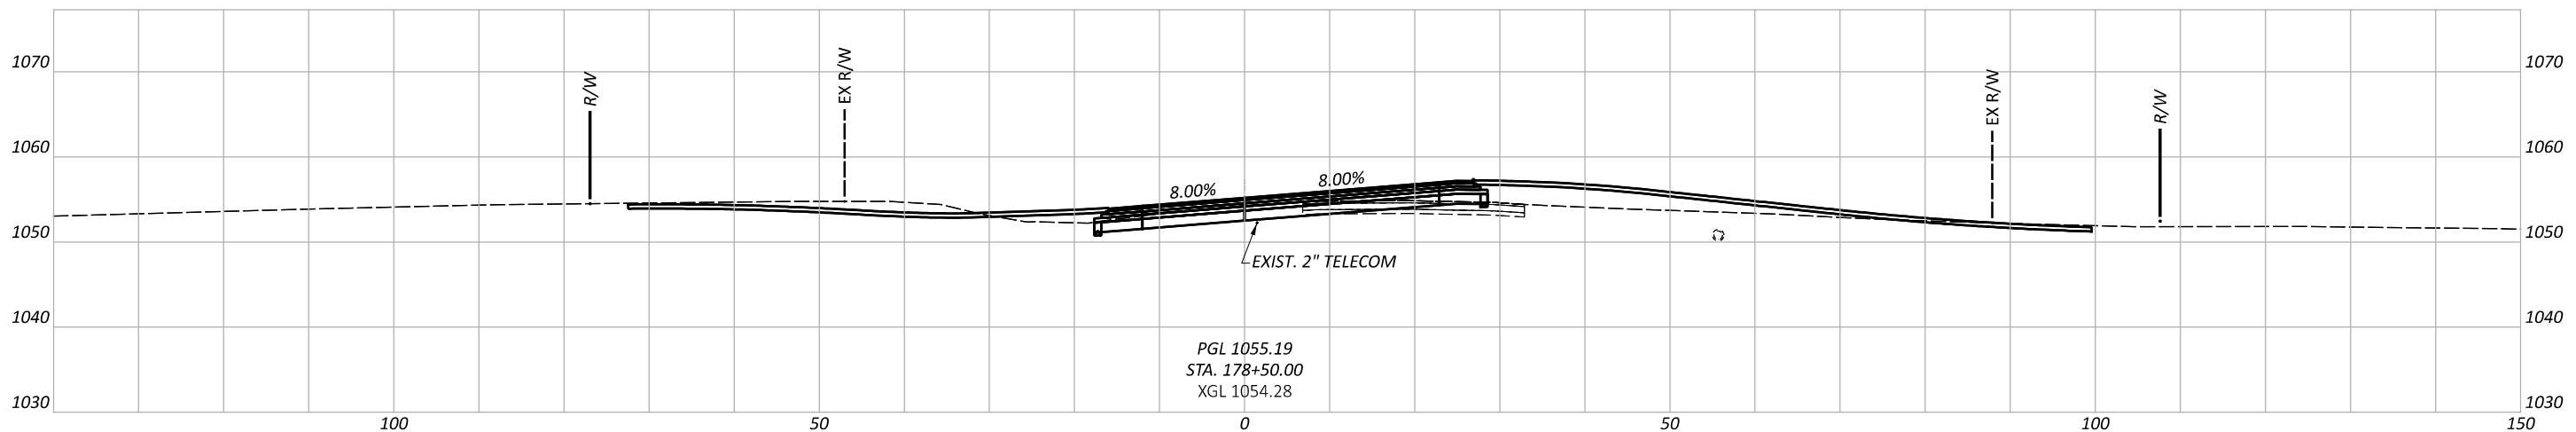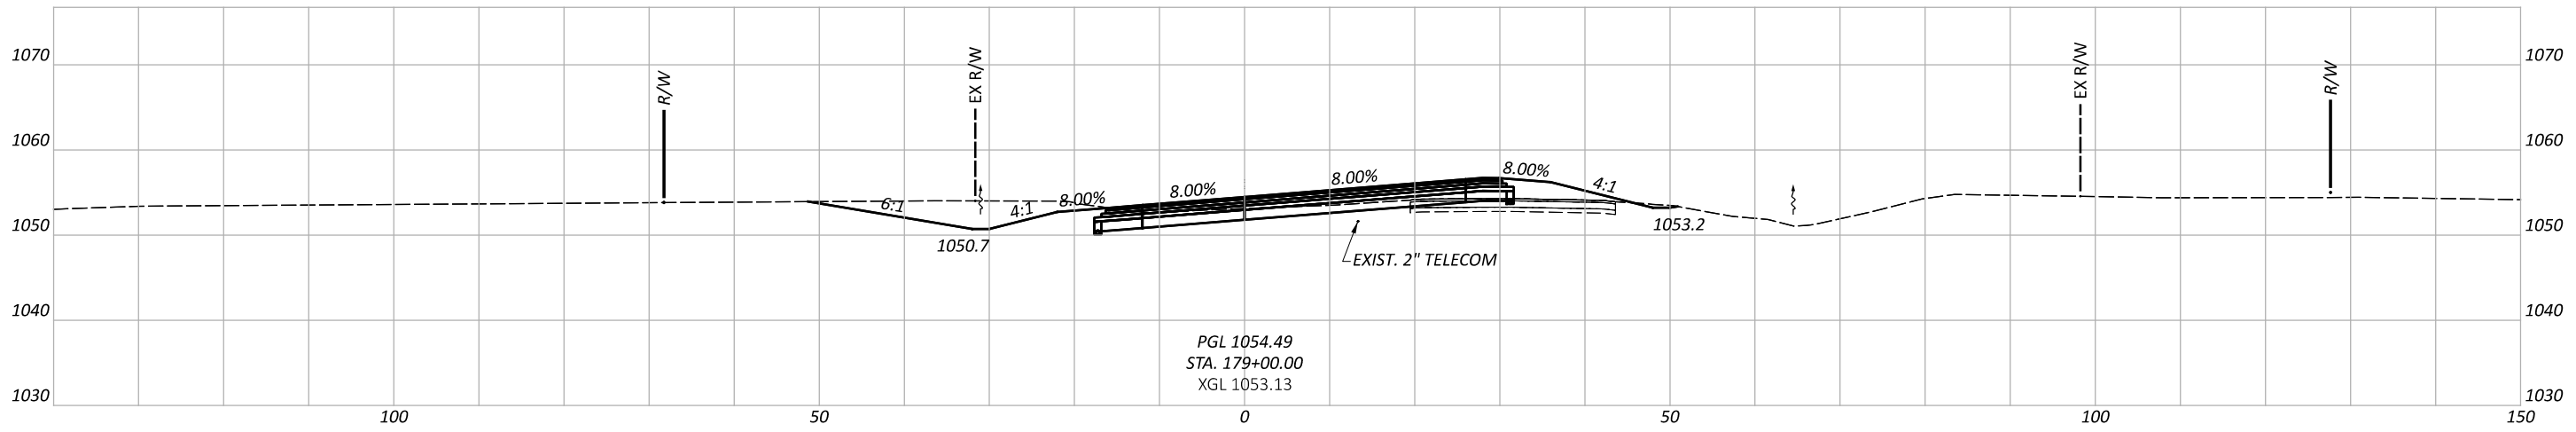

CROSS SECTIONS - SR 729 - SOUTH ROUNDABOUT APPROACH
 STA. 178+00 TO STA. 179+00


DESIGN AGENCY

 8350 E. KEMPER RD.
 SUITE B
 CINCINNATI, OH 45249
 513-469-1600

DESIGNER
 DPF

REVIEWER
 DCJ MM-DD-YY

PROJECT ID
 117955

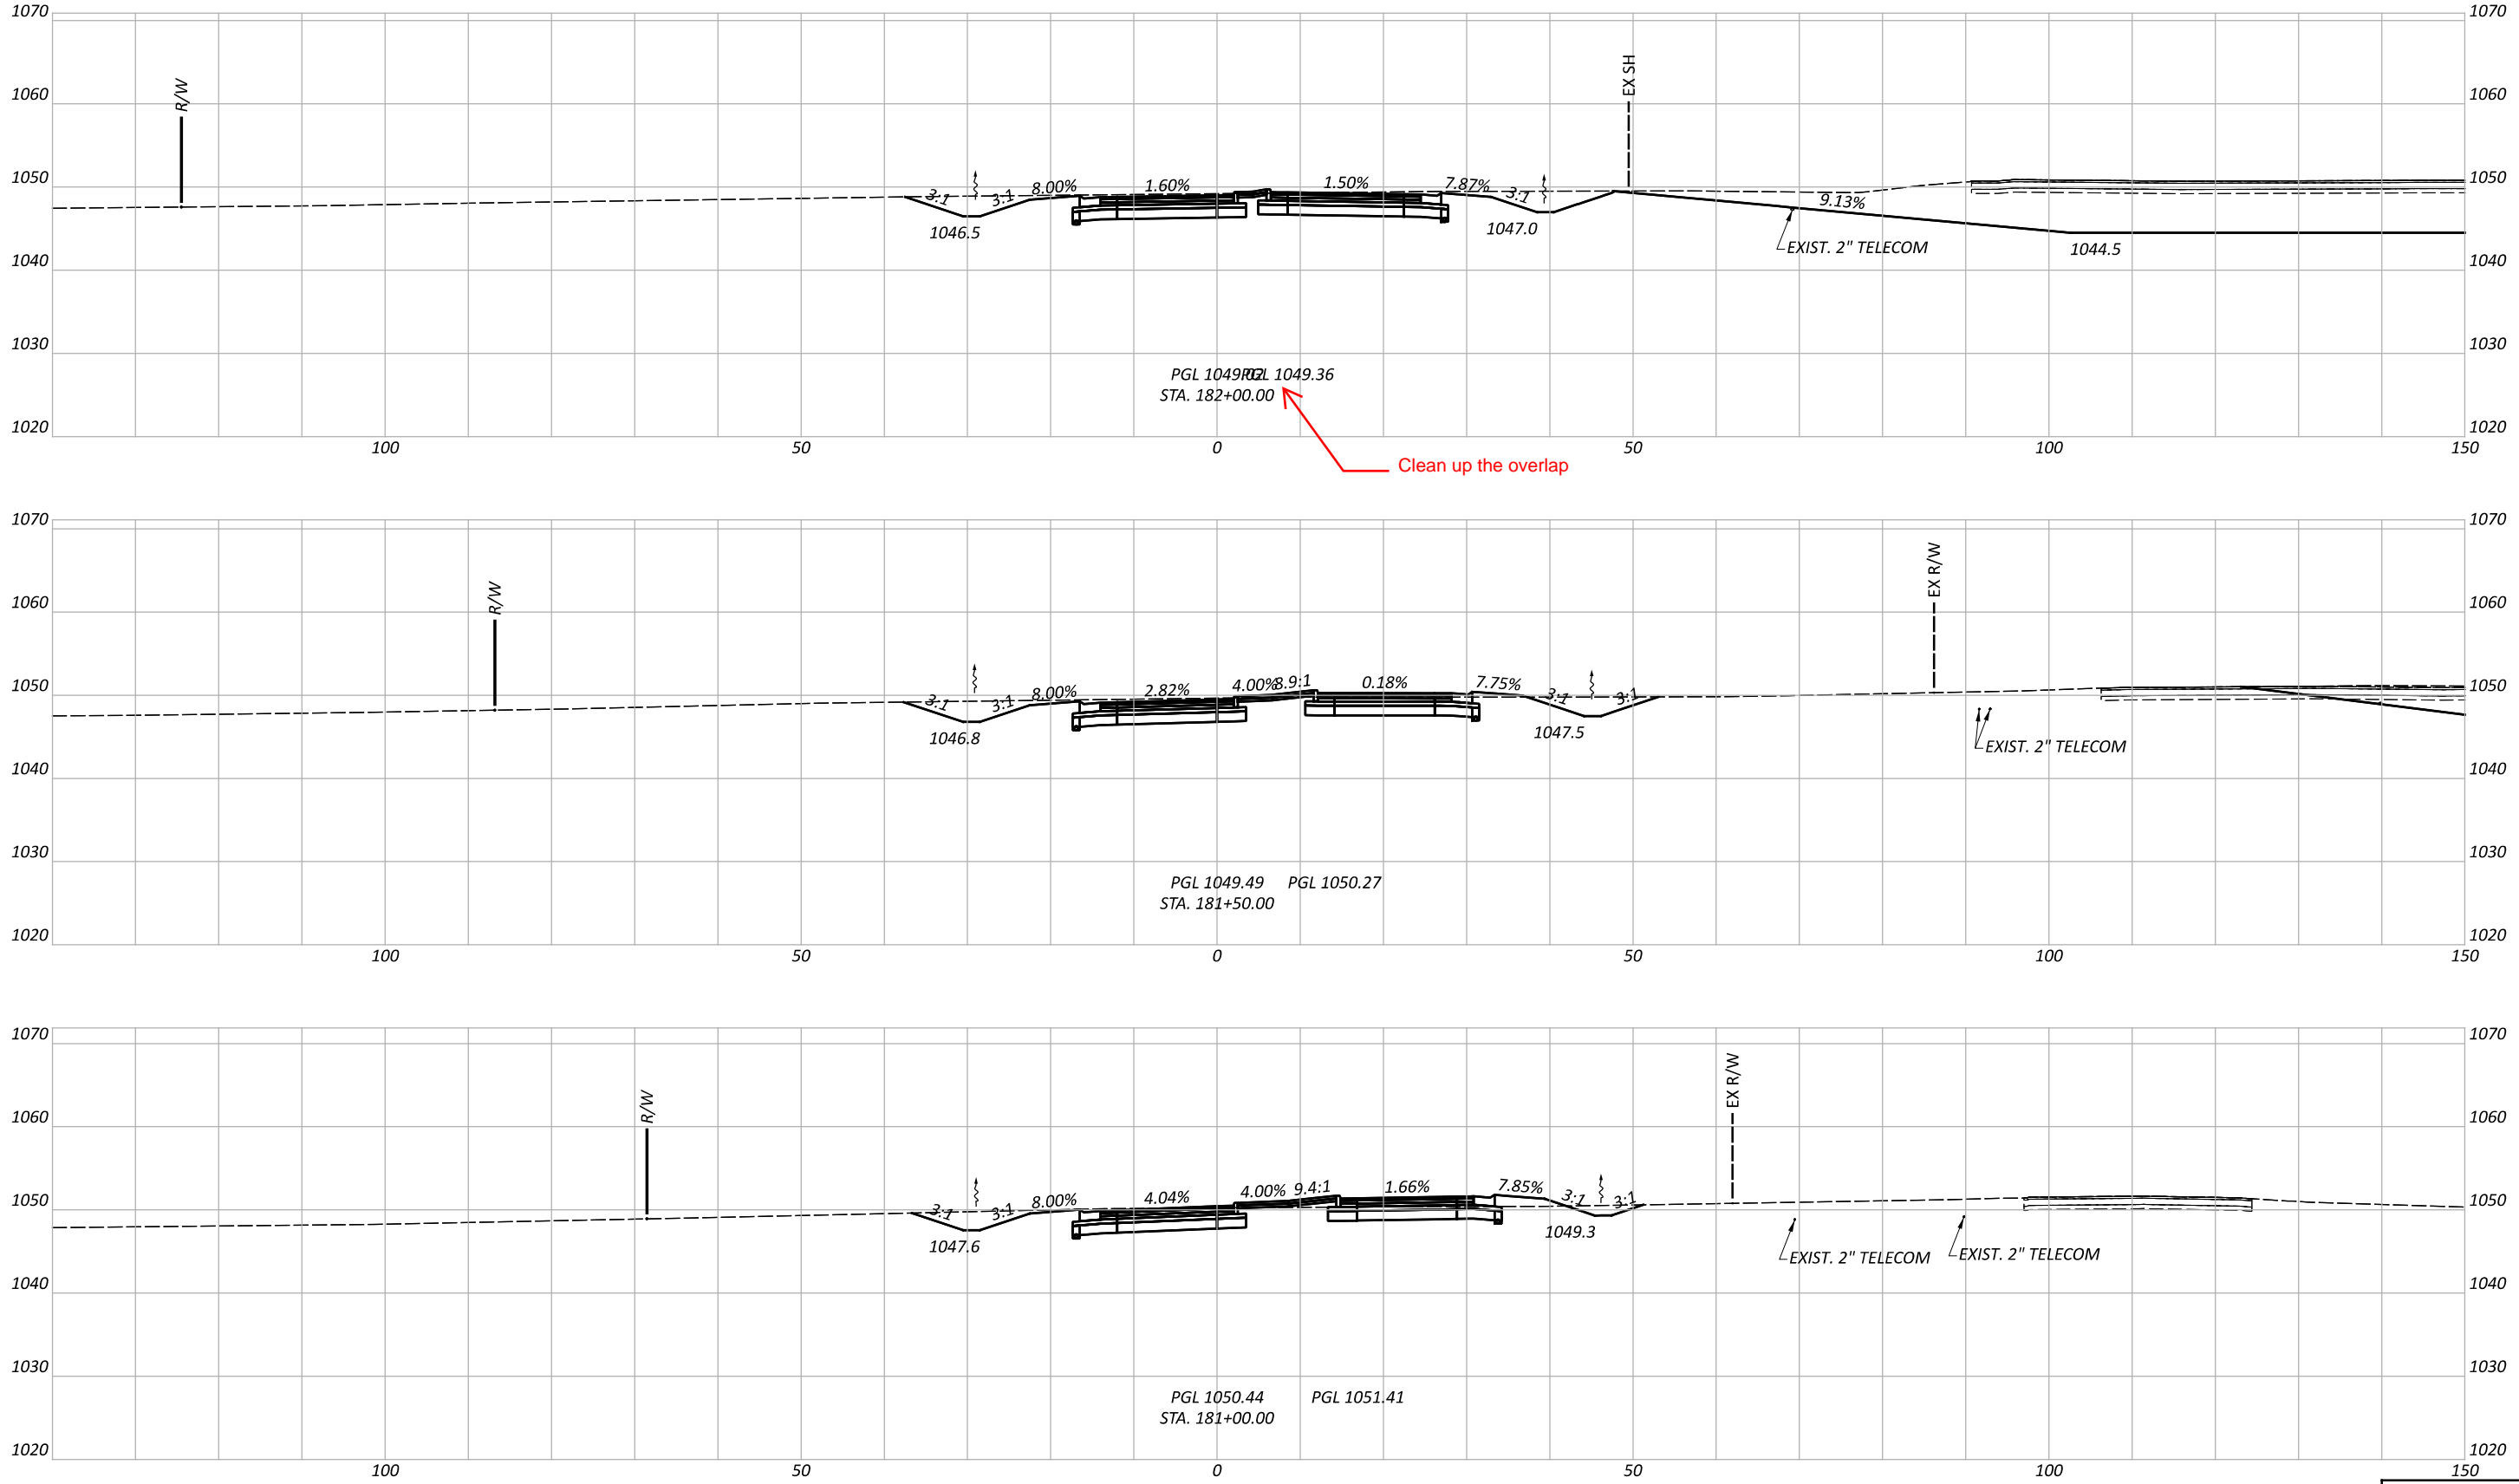Sheet Totals			TOTAL	
Seeding	Cut	Fill	P. 173	228



CROSS SECTIONS - SR 729 - SOUTH ROUNDABOUT APPROACH
 STA. 181+00 TO STA. 182+00

DESIGN AGENCY





DESIGNER
 DPF

REVIEWER
 DCJ MM-DD-YY

PROJECT ID
 117955

Sheet Totals			TOTAL	
Seeding	Cut	Fill	P. 175	228

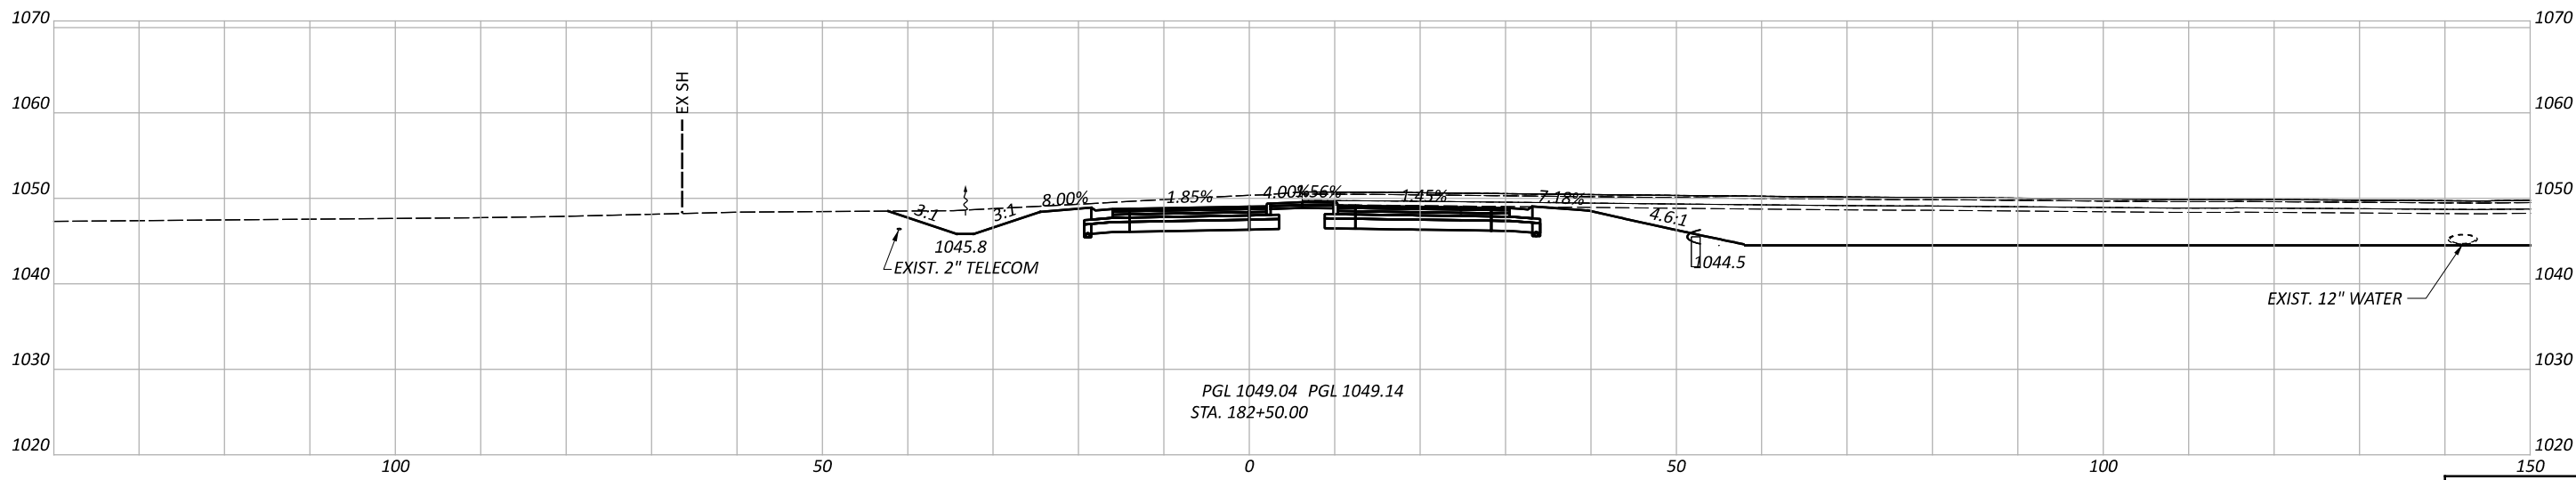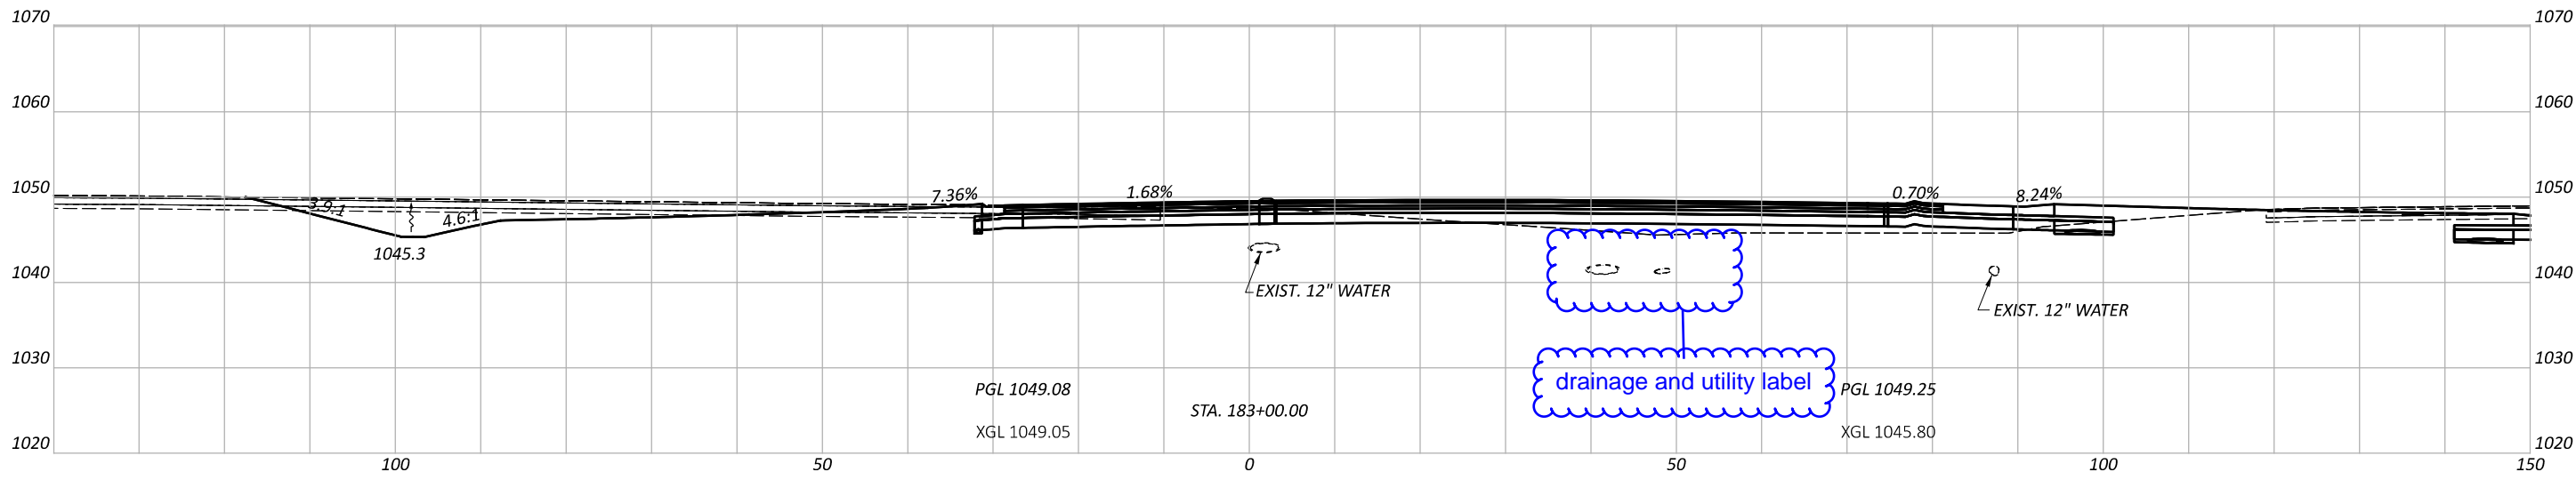

drainage and utility label

Sheet Totals			117955	
Seeding	Cut	Fill	SHEET	TOTAL
			P. 176	228


DESIGN AGENCY
Palmer
 ENGINEERING
 8350 E. KEMPER RD.
 SUITE B
 CINCINNATI, OH 45249
 513-469-1600

DESIGNER
DPF

REVIEWER
DCJ MM-DD-YY

PROJECT ID
117955

CROSS SECTIONS - SR 729 - SOUTH ROUNDABOUT APPROACH
 STA. 182+50 TO STA. 183+00

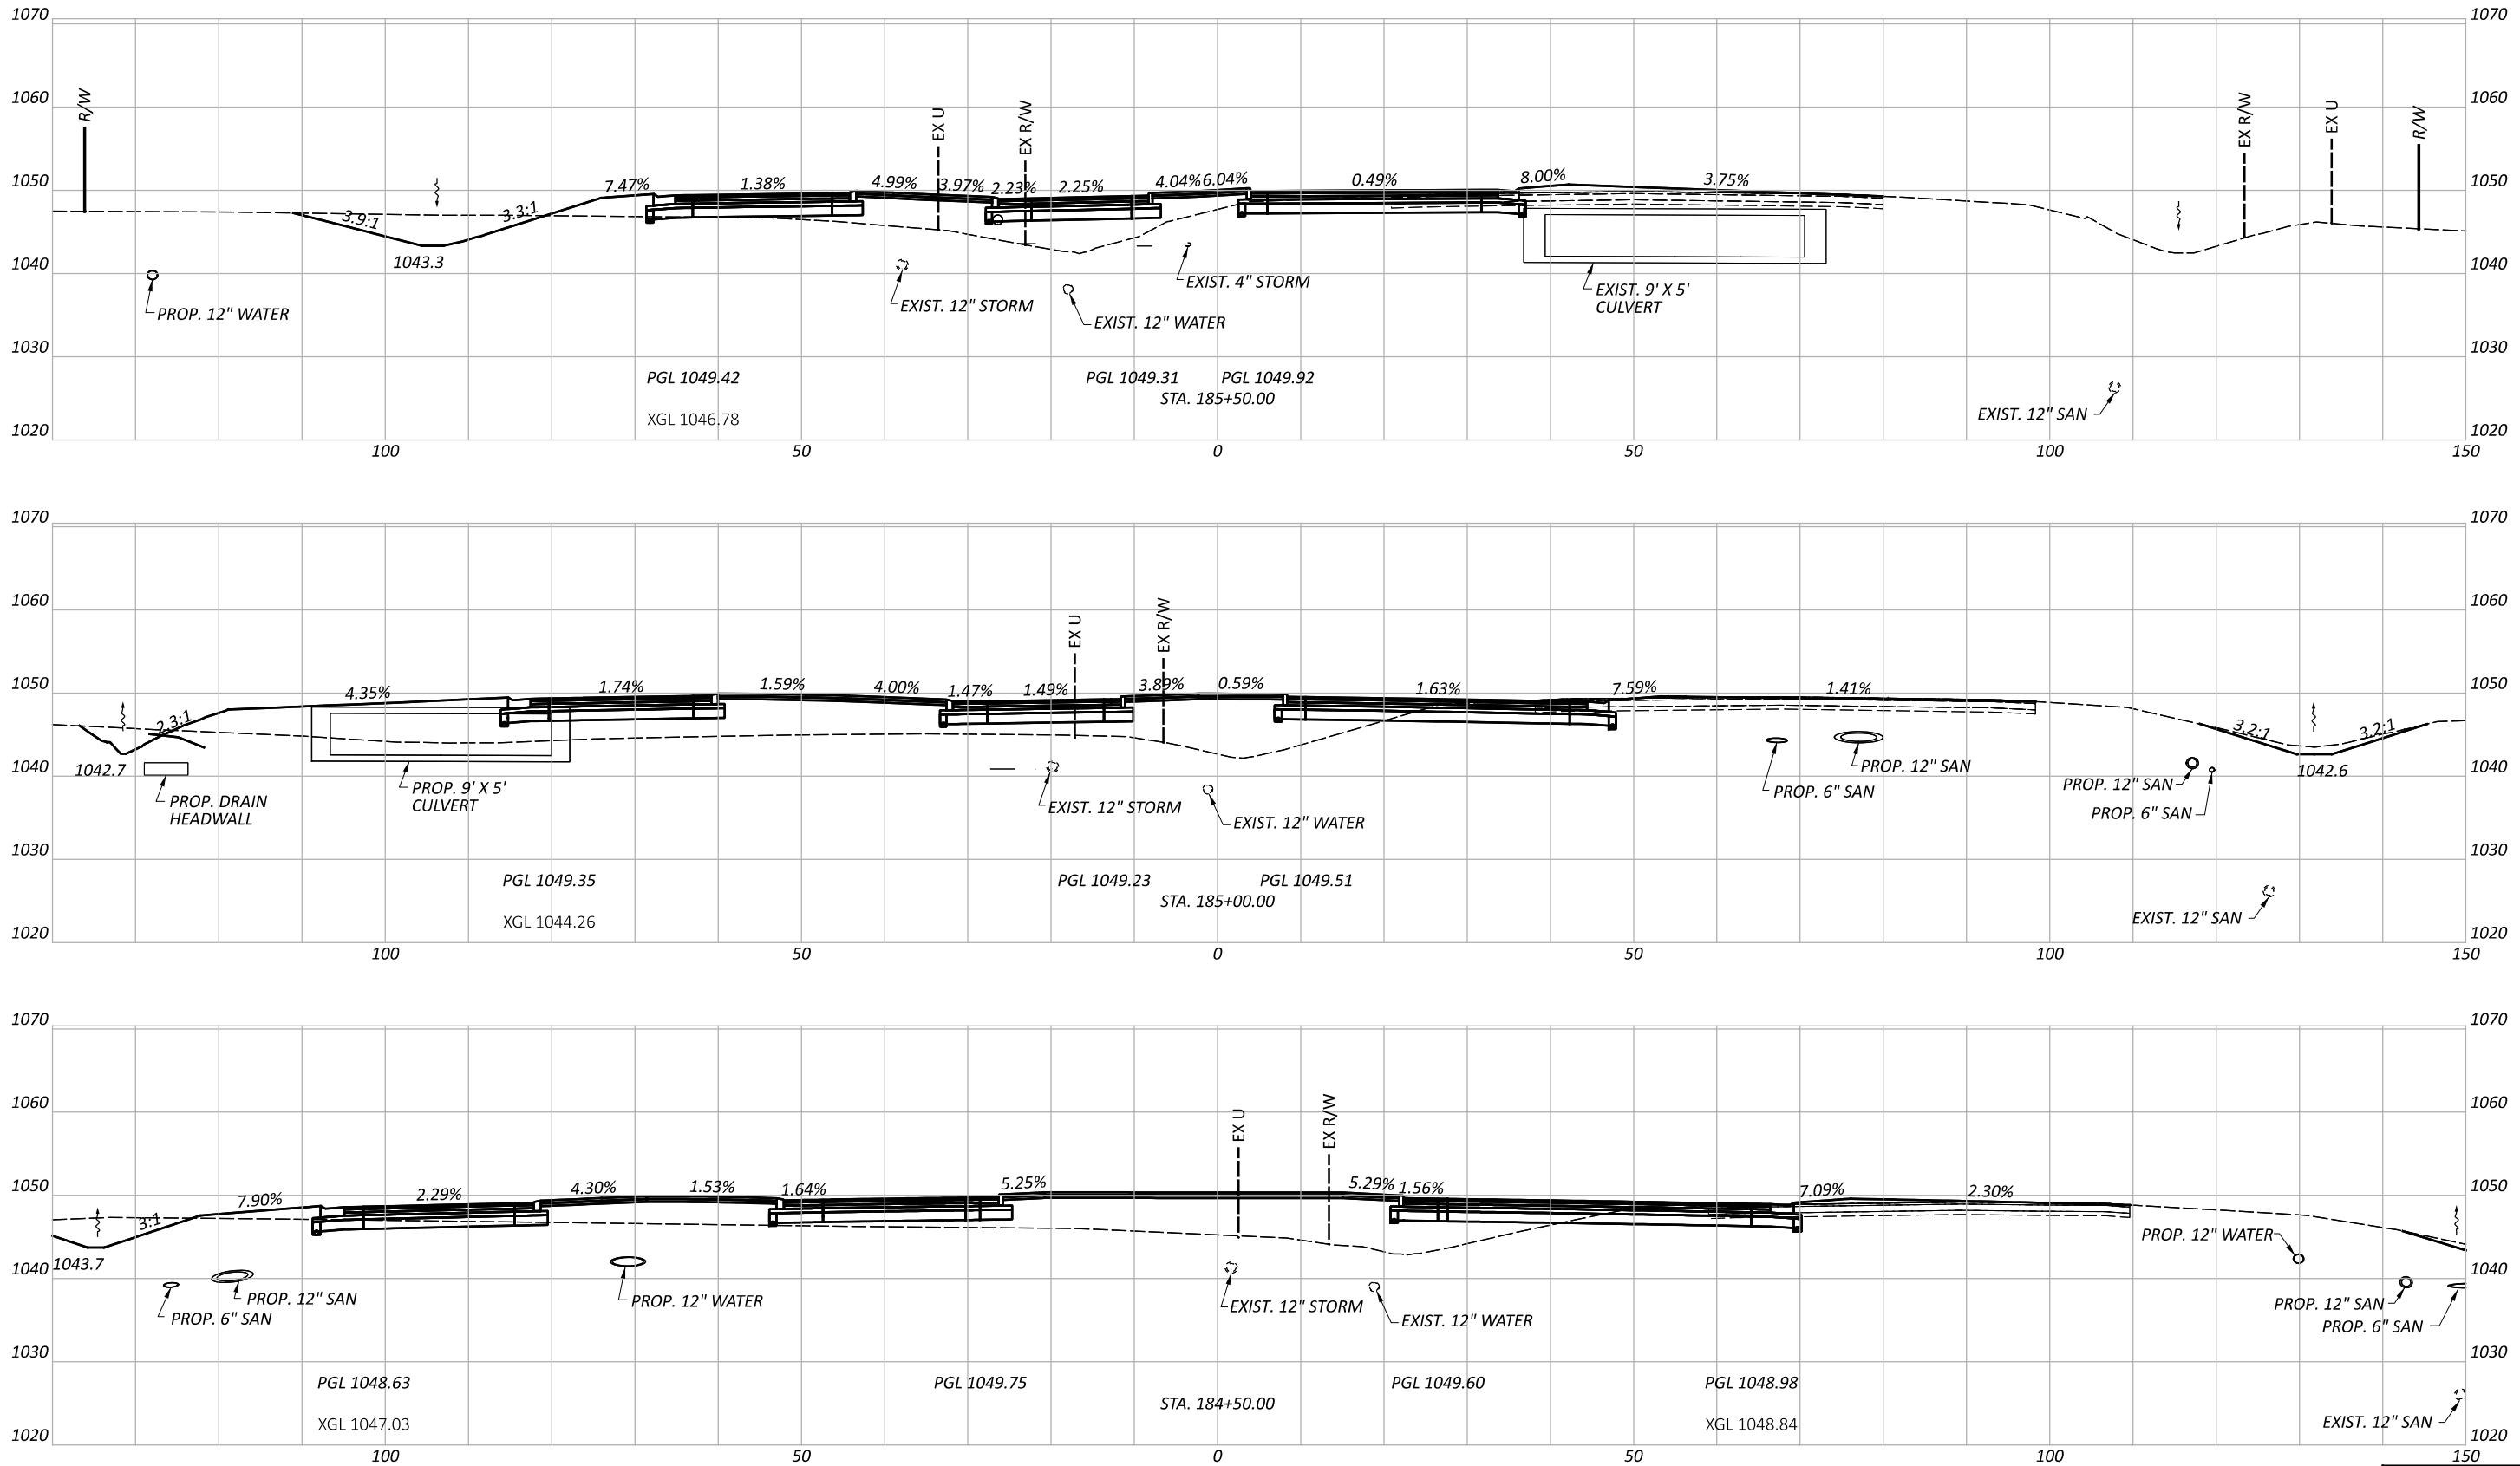

CROSS SECTIONS - BLUEGRASS - NORTH ROUNDABOUT APPROACH
 STA. 184+50 TO STA. 185+50

DESIGN AGENCY
Palmer
 ENGINEERING
 8350 E. KEMPER RD.
 SUITE B
 CINCINNATI, OH 45249
 513-469-1600




DESIGNER
 DPF

REVIEWER
 DCJ MM-DD-YY

PROJECT ID
 117955

Sheet Totals		
Seeding	Cut	Fill

SHEET TOTAL
 P. 177 228

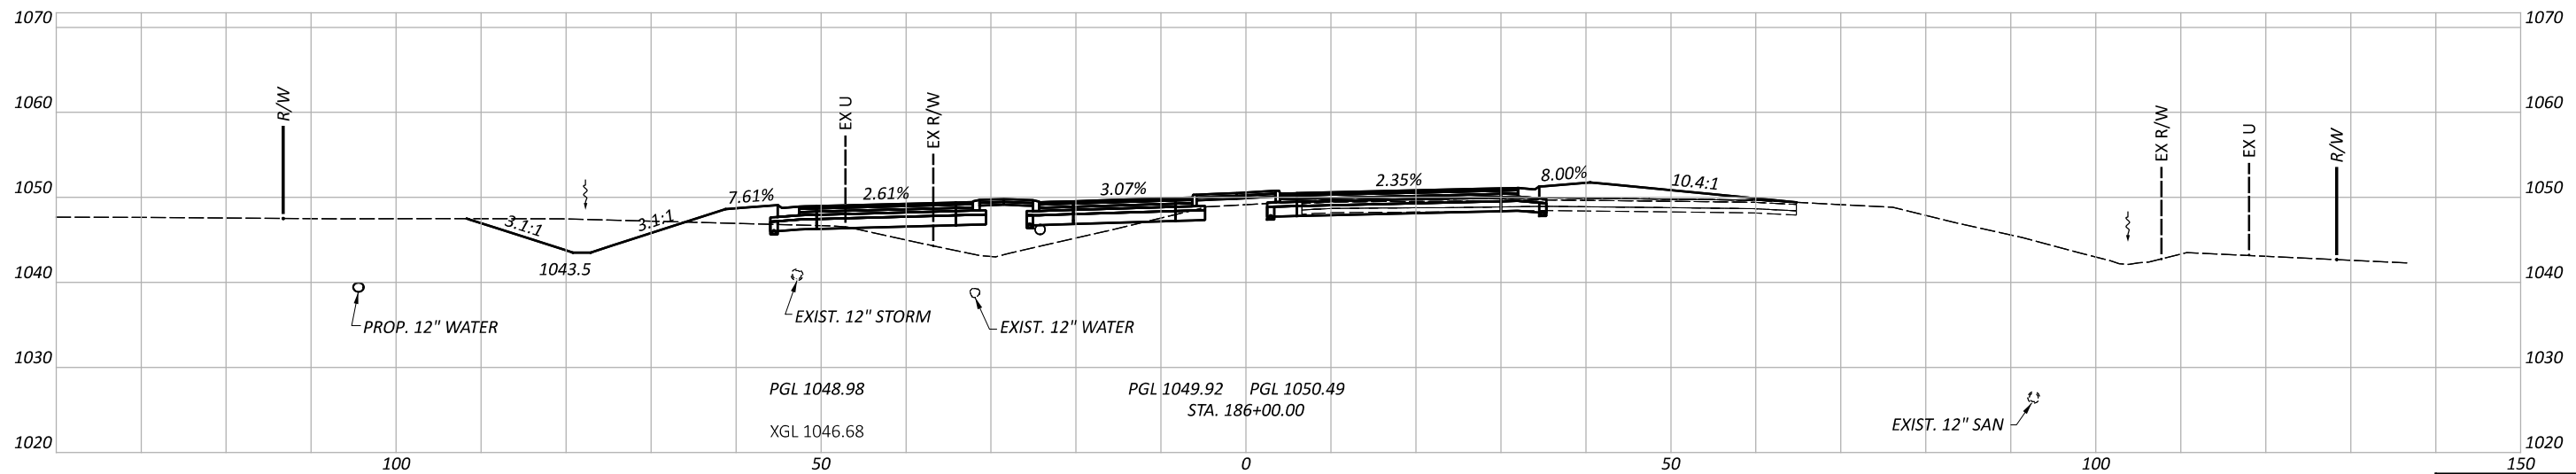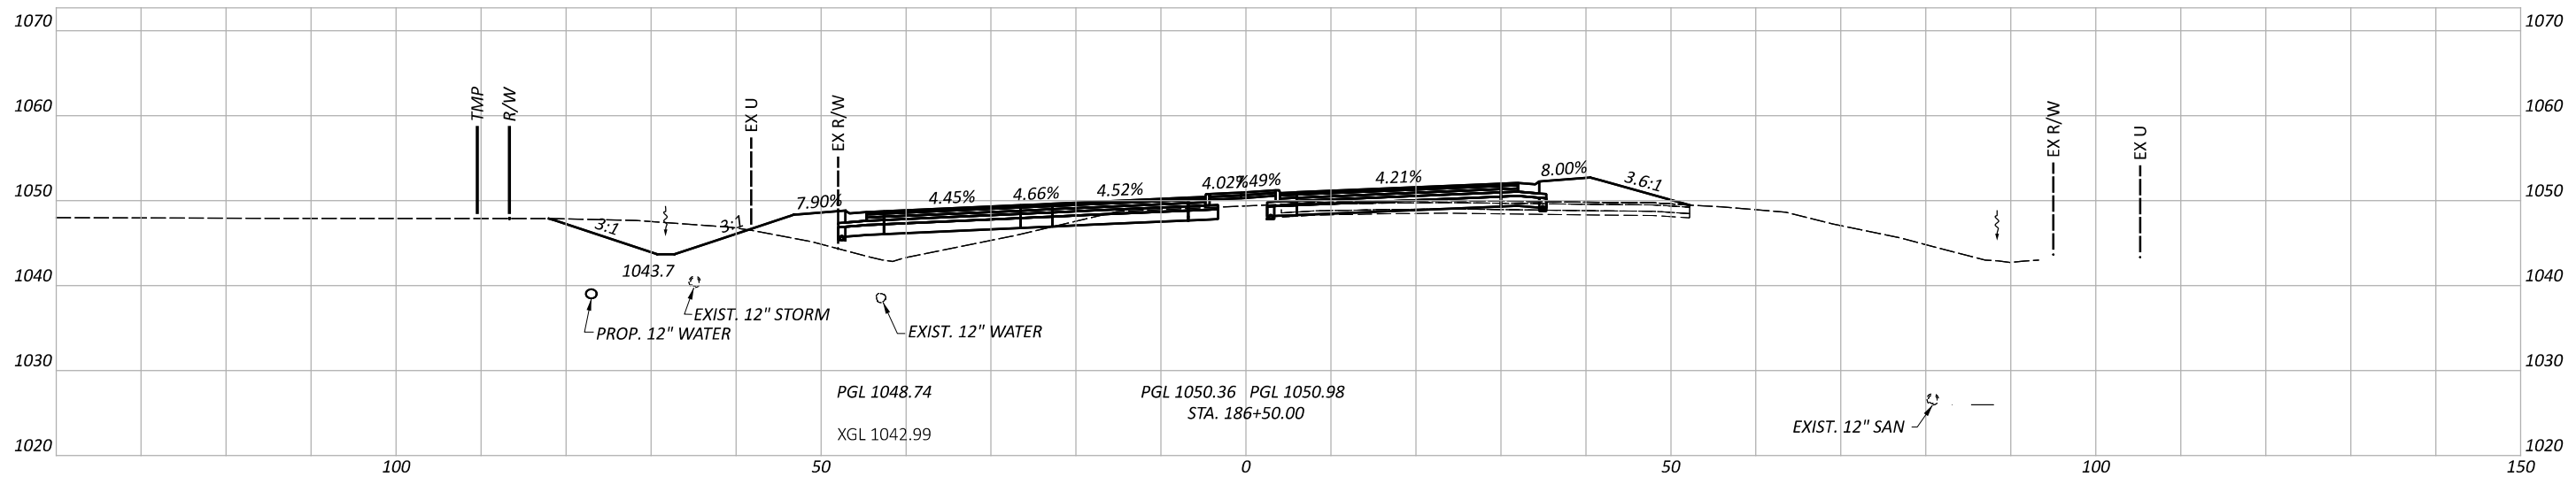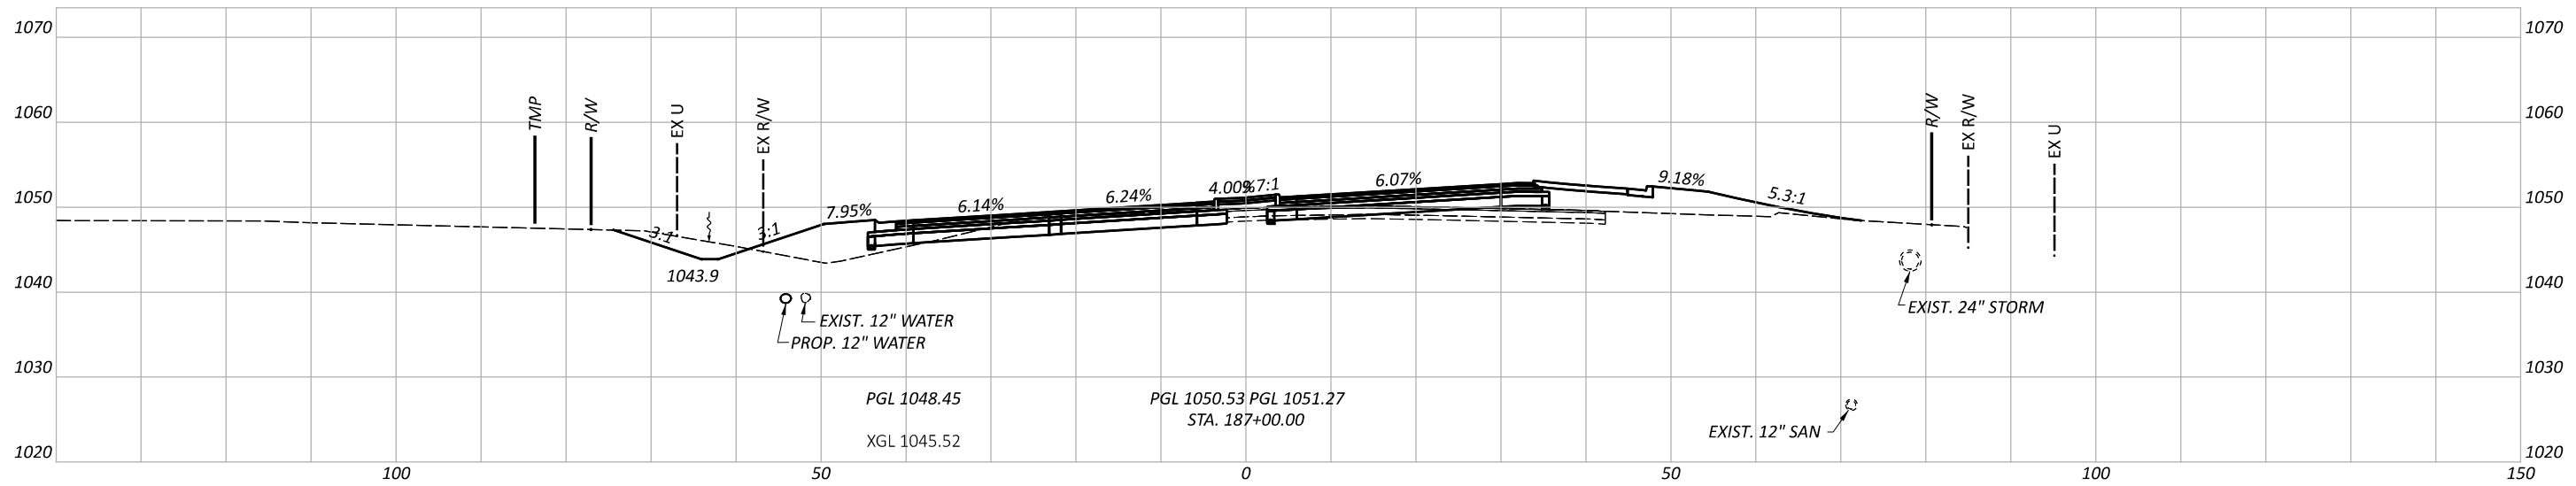

CROSS SECTIONS - BLUEGRASS - NORTH ROUNDABOUT APPROACH
 STA. 186+00 TO STA. 187+00




DESIGN AGENCY



DESIGNER
 DPF
 REVIEWER
 DCJ MM-DD-YY

PROJECT ID
 117955
 SHEET TOTAL
 P. 178 228

Sheet Totals		
Seeding	Cut	Fill

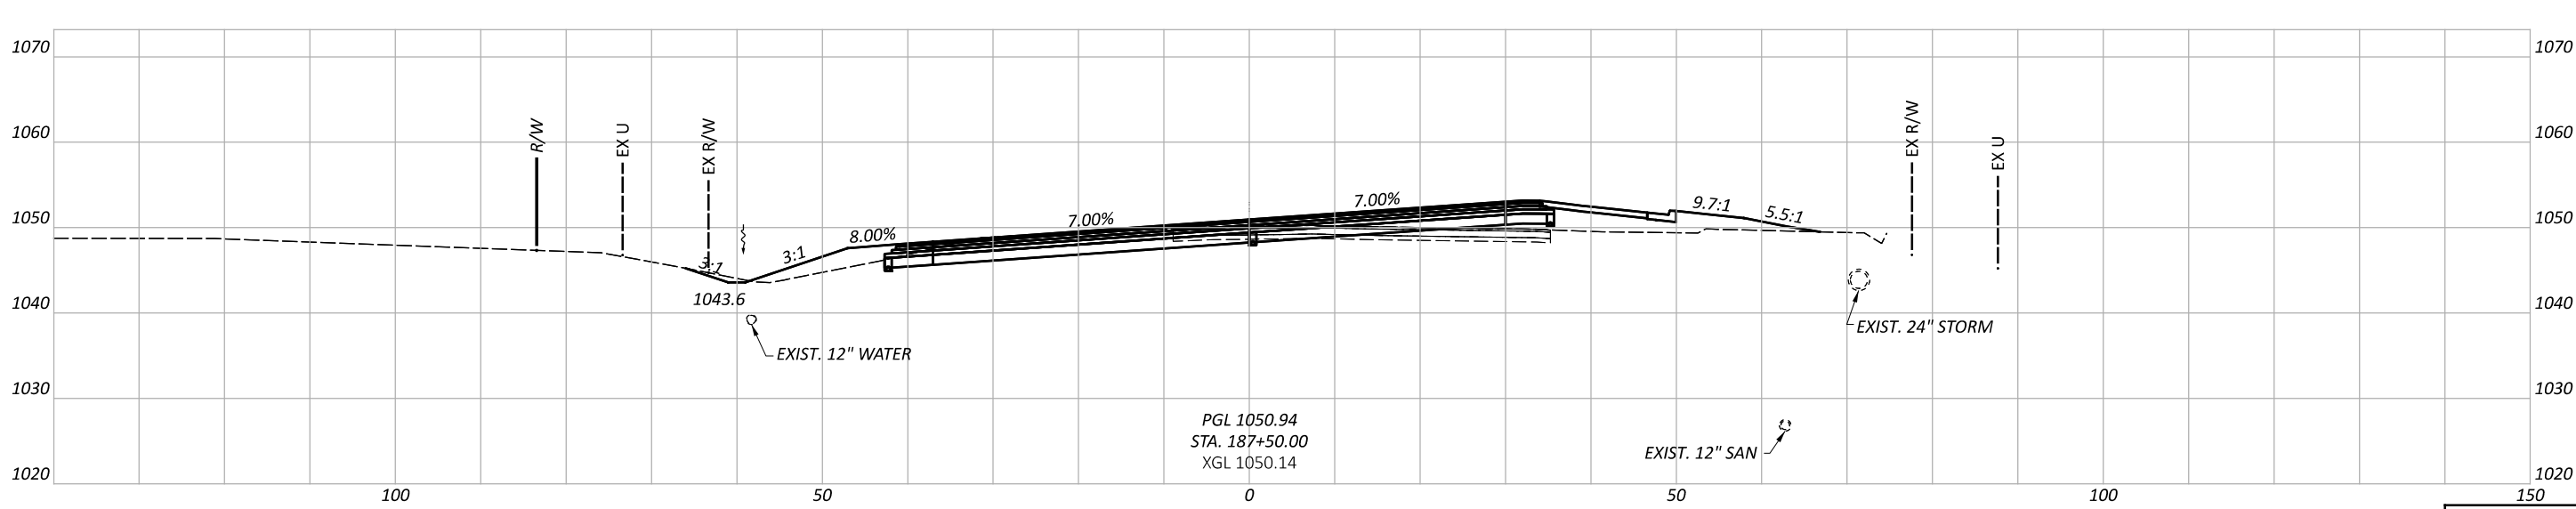
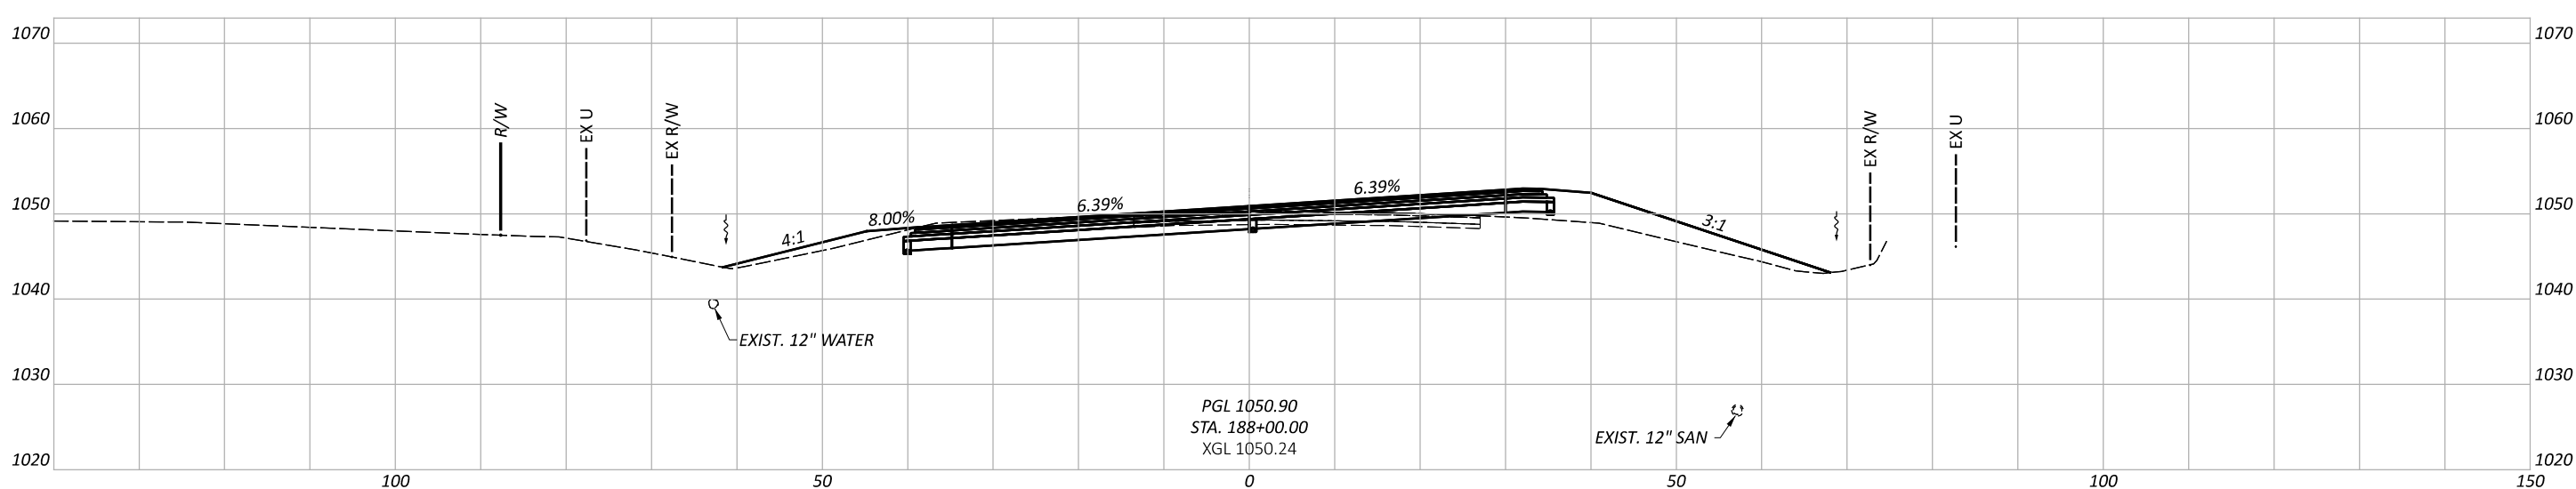
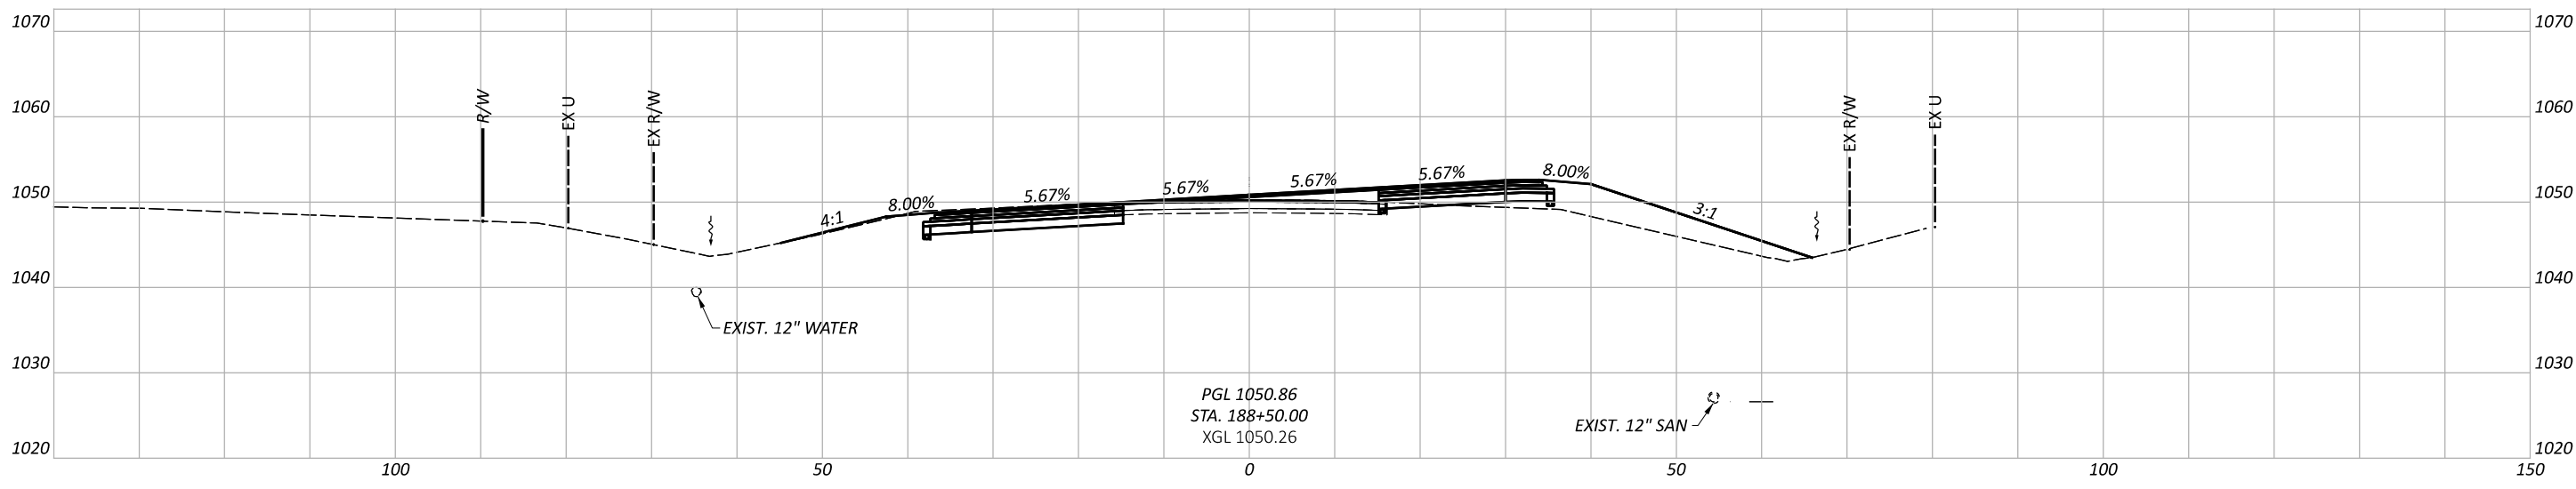


CROSS SECTIONS - BLUEGRASS - NORTH ROUNDABOUT APPROACH
 STA. 187+50 TO STA. 188+50

DESIGN AGENCY
Palmer
 ENGINEERING
 8350 E. KEMPER RD.
 SUITE B
 CINCINNATI, OH 45249
 513-469-1600

DESIGNER
 DPF
 REVIEWER
 DCJ MM-DD-YY
 PROJECT ID
 117955

Sheet Totals			TOTAL	
Seeding	Cut	Fill	SHEET	TOTAL
			P. 179	228

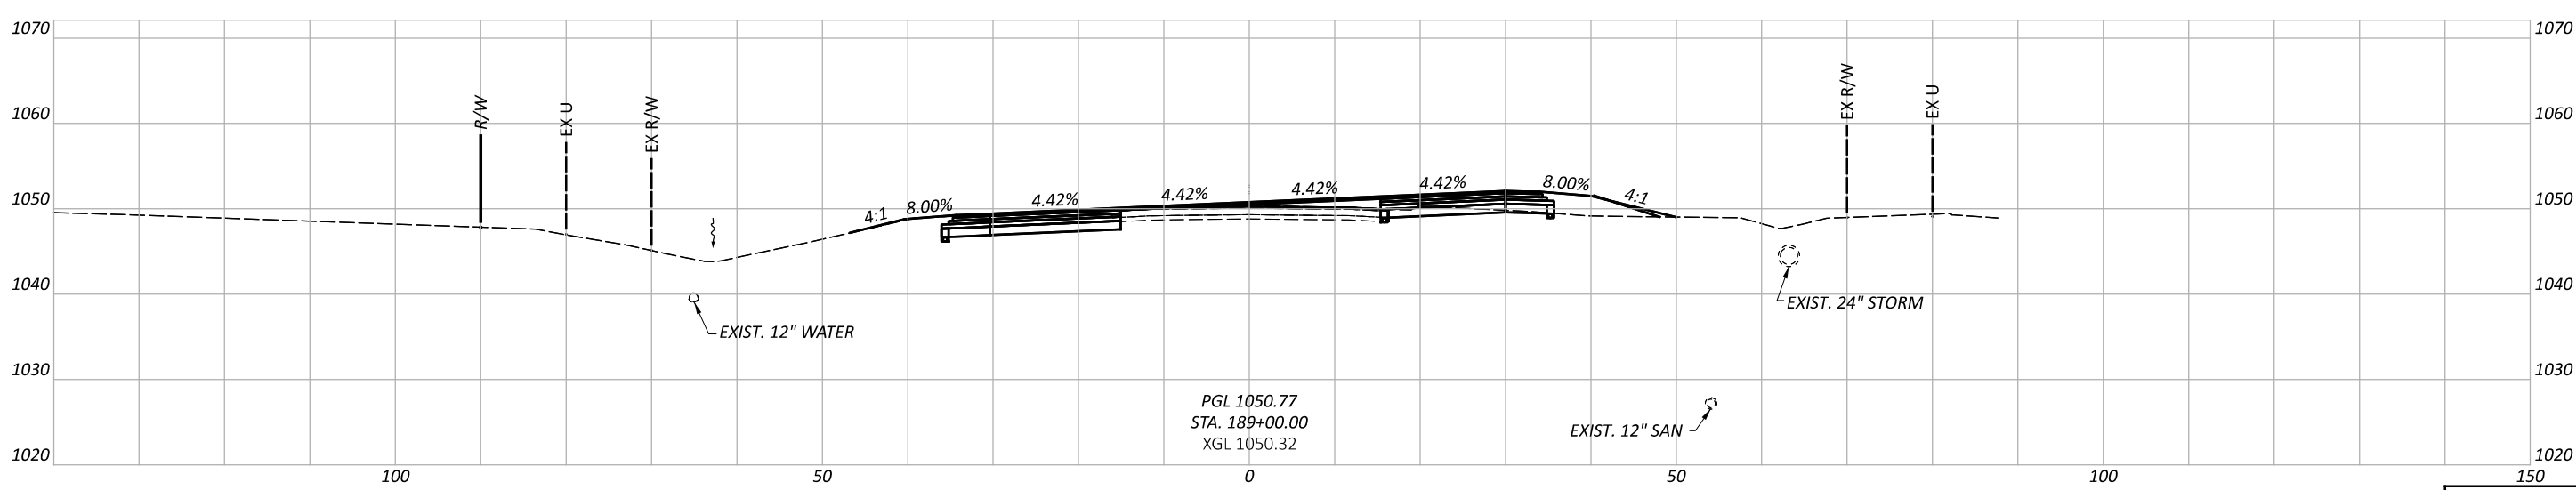
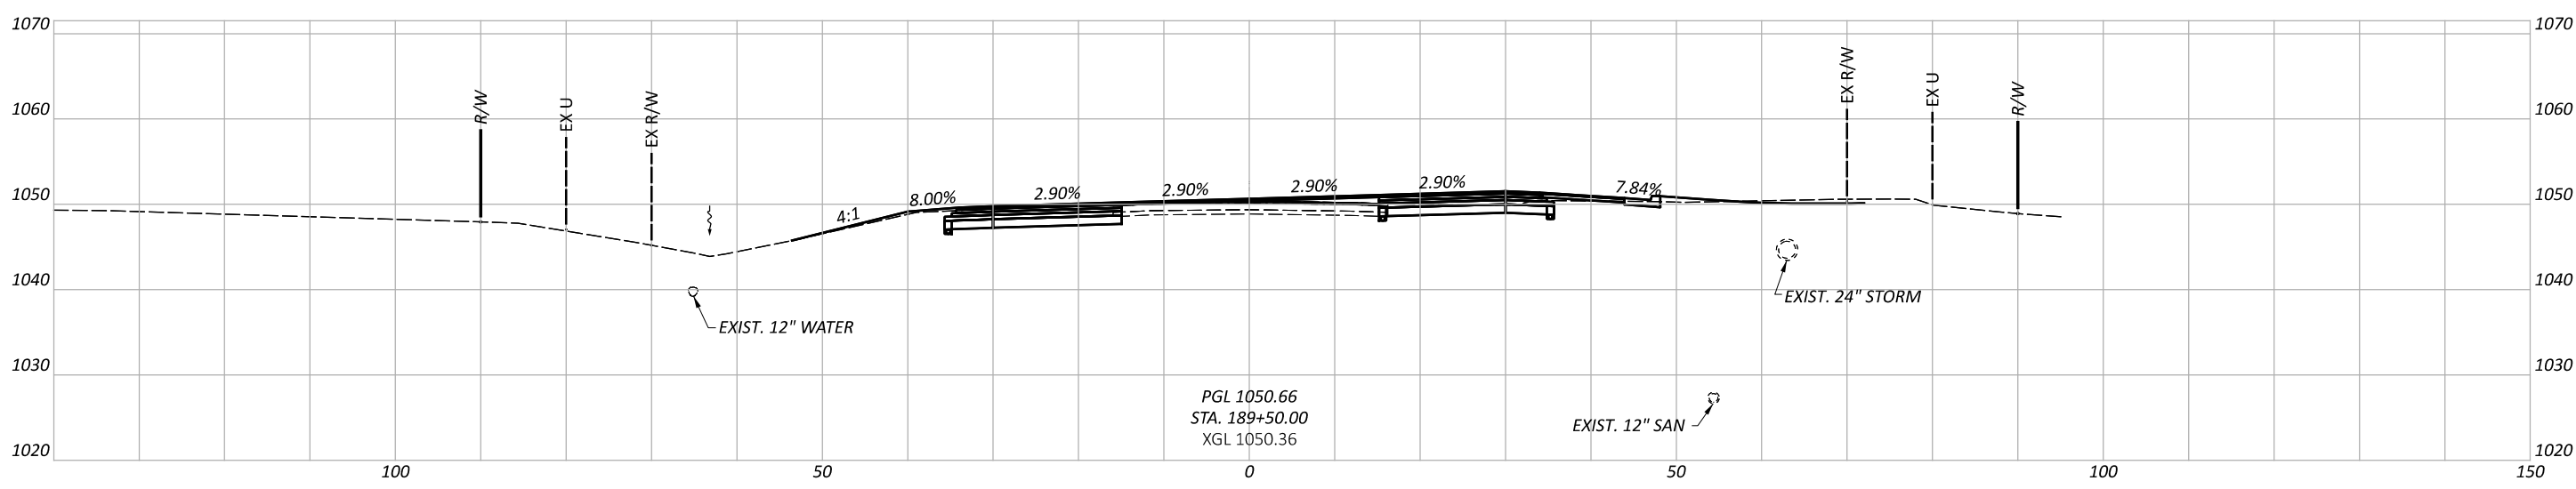
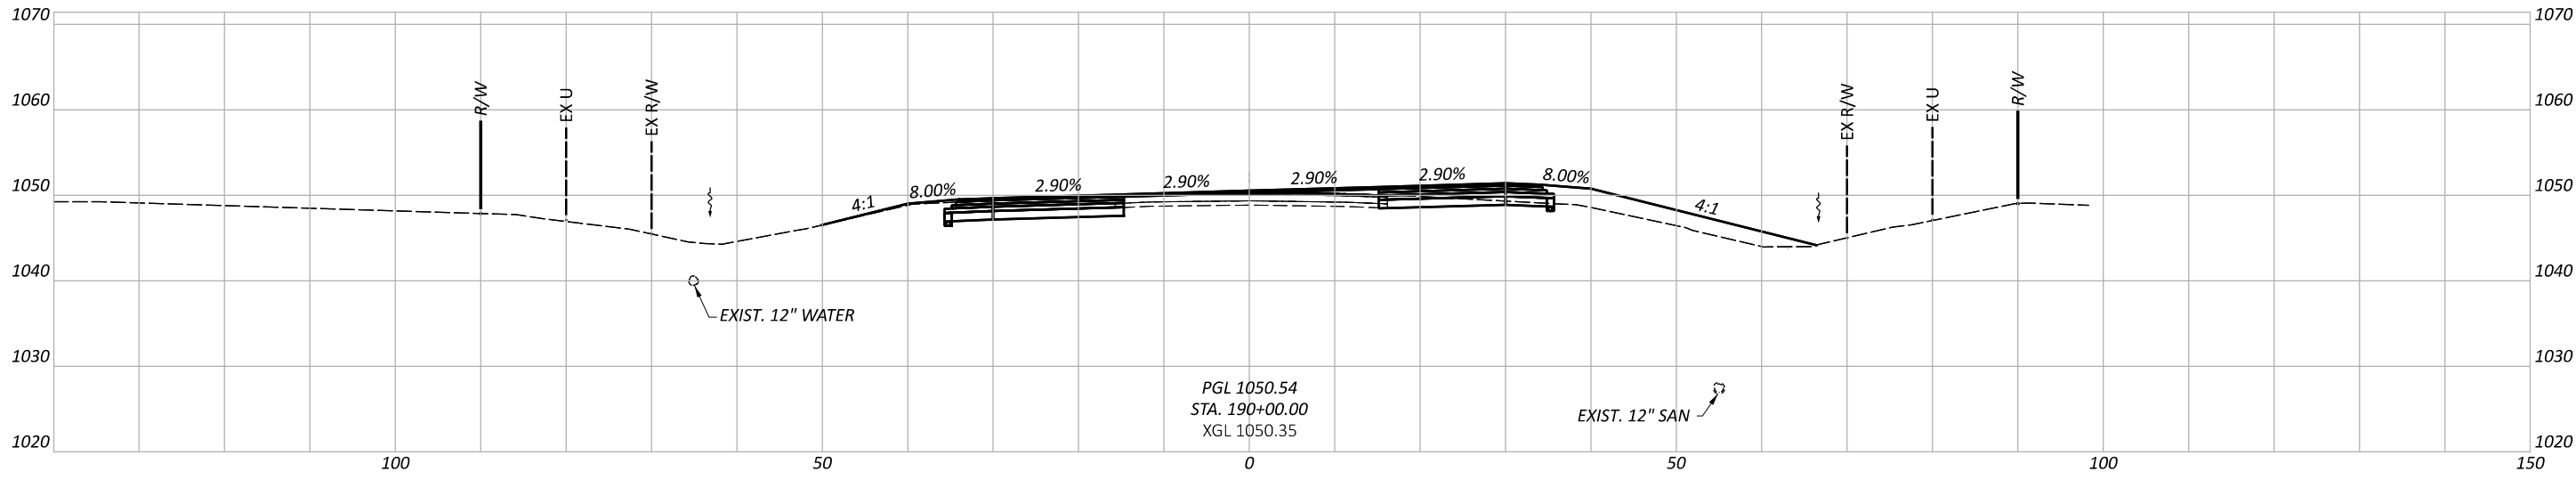


CROSS SECTIONS - BLUEGRASS - NORTH ROUNDABOUT APPROACH
 STA. 189+00 TO STA. 190+00

DESIGN AGENCY
Palmer
 ENGINEERING
 8350 E. KEMPER RD.
 SUITE B
 CINCINNATI, OH 45249
 513-469-1600

DESIGNER
 DPF
 REVIEWER
 DCJ MM-DD-YY
 PROJECT ID

Sheet Totals			117955
Seeding	Cut	Fill	TOTAL
			P. 180 228

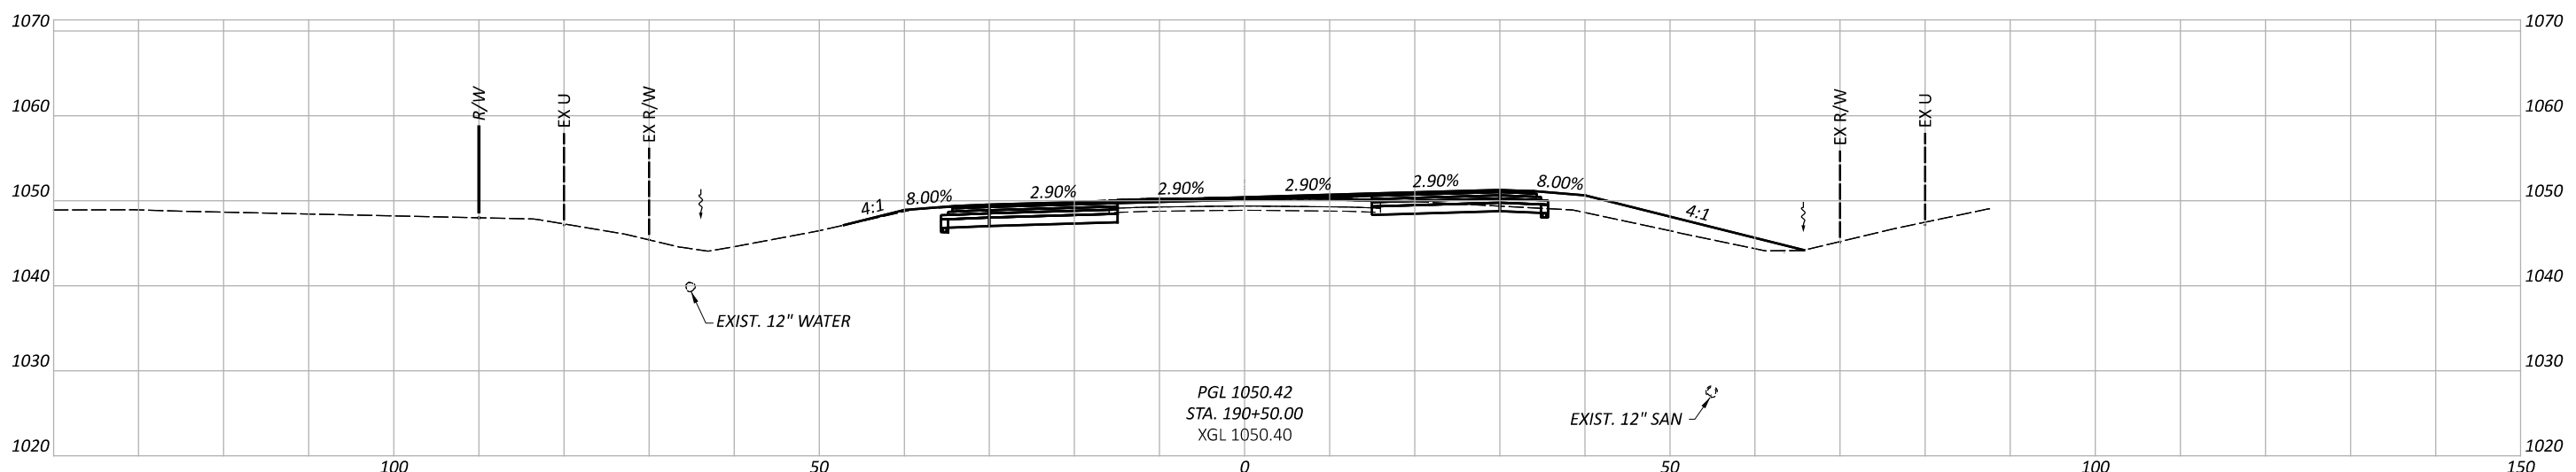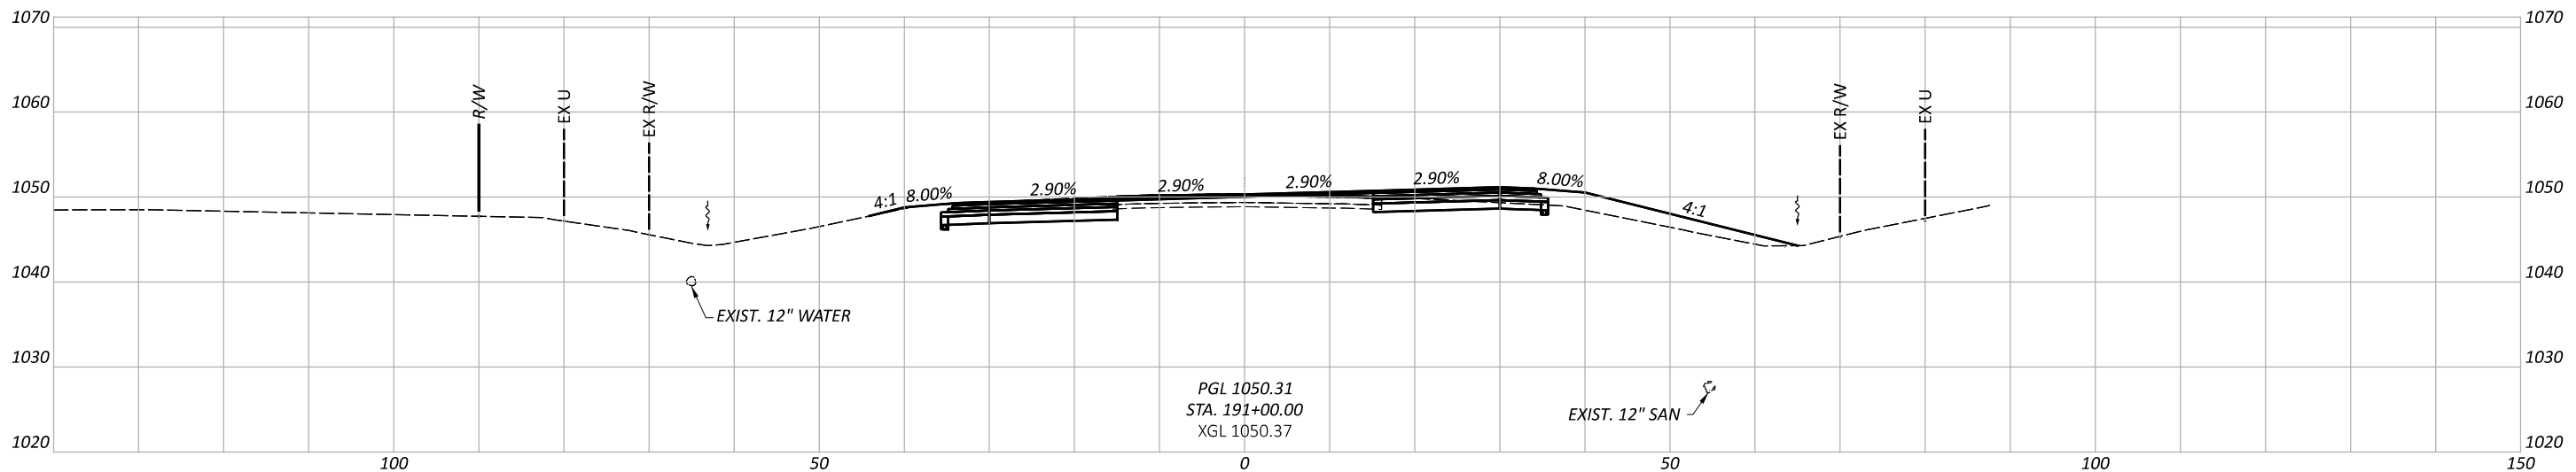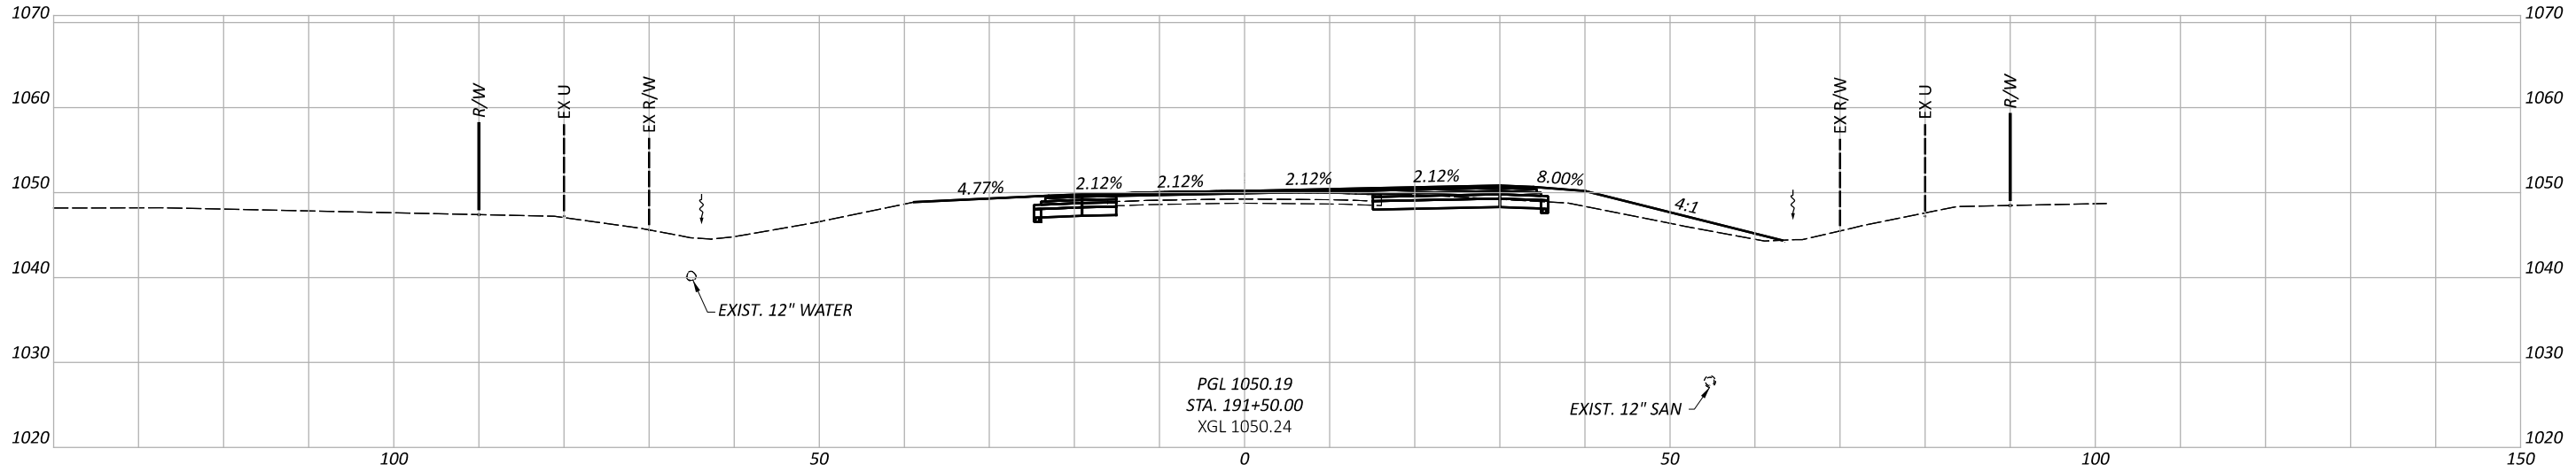

CROSS SECTIONS - BLUEGRASS - NORTH ROUNDABOUT APPROACH
 STA. 190+50 TO STA. 191+50

DESIGN AGENCY



DESIGNER

DPF




REVIEWER

DCJ MM-DD-YY

PROJECT ID

117955

Sheet Totals			TOTAL	
Seeding	Cut	Fill	SHEET	TOTAL
			P. 181	228

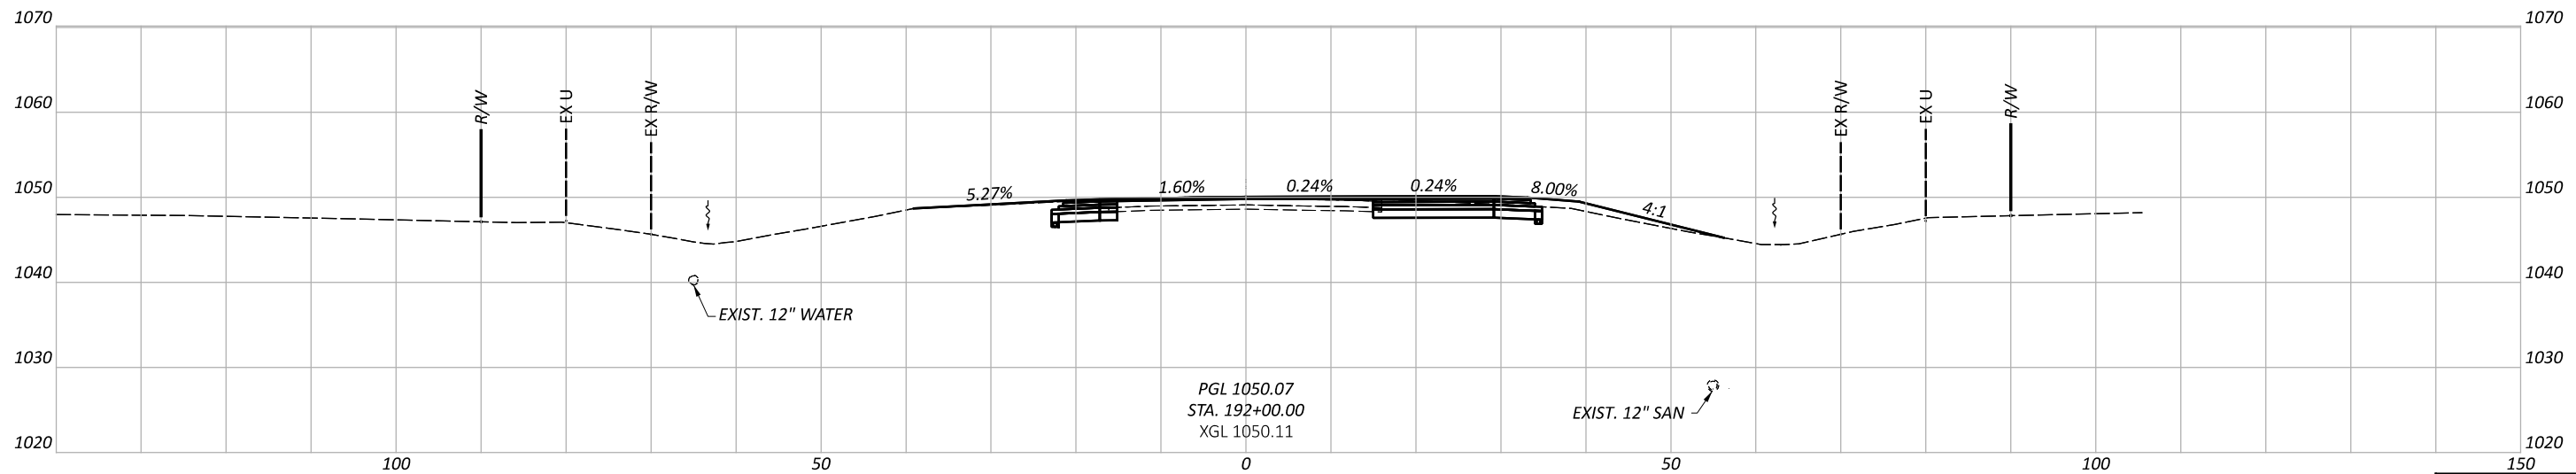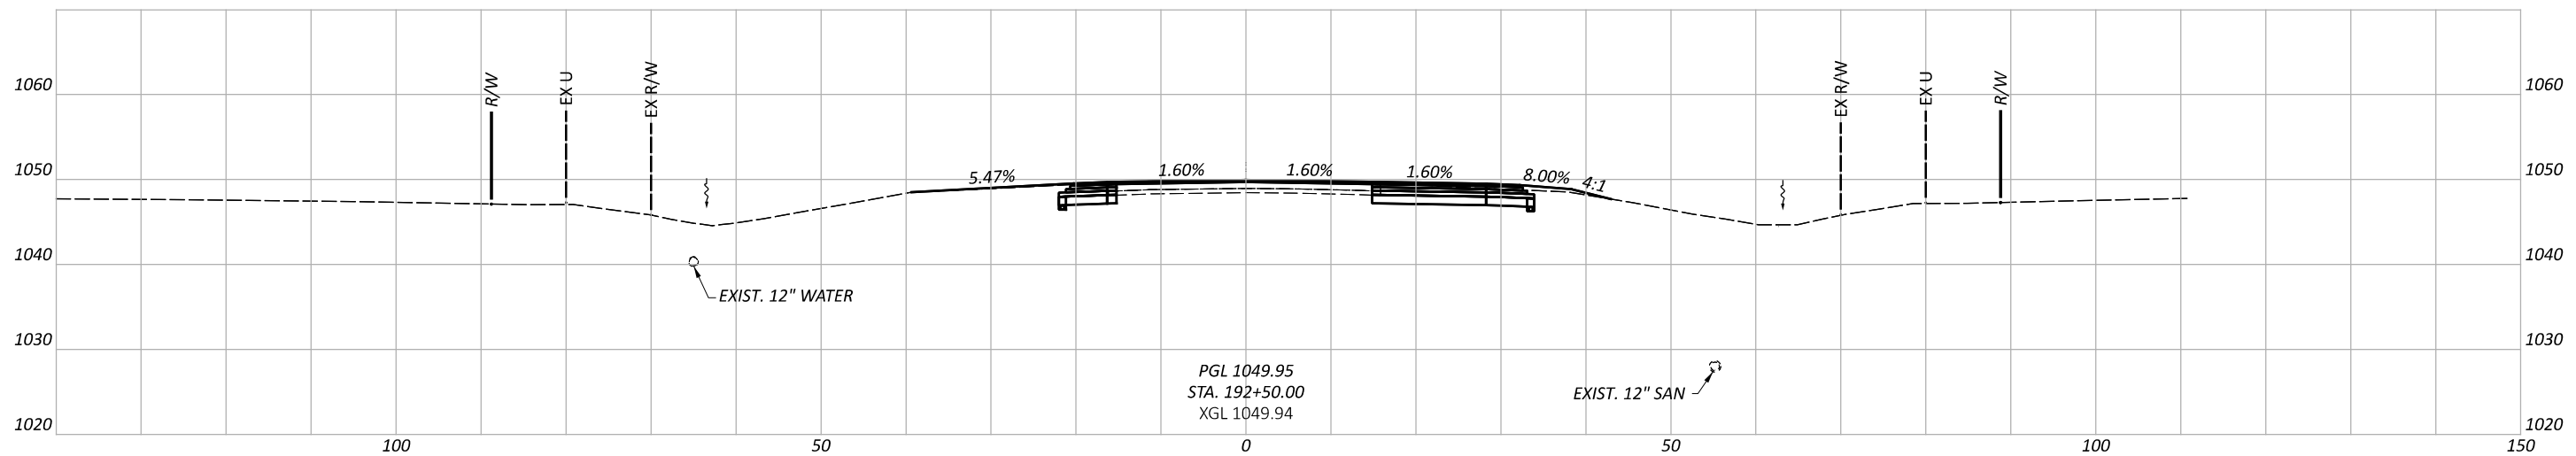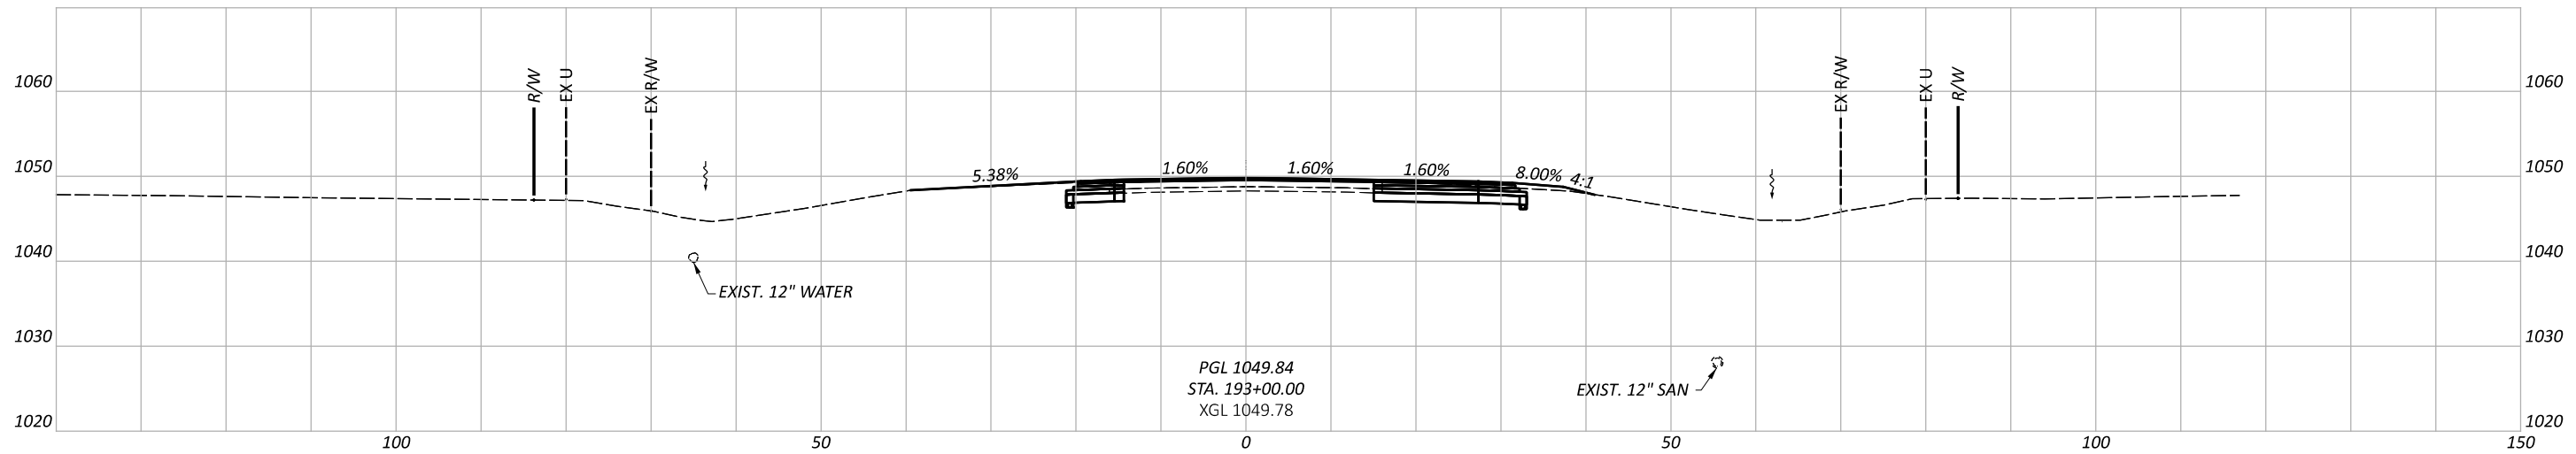

CROSS SECTIONS - BLUEGRASS - NORTH ROUNDABOUT APPROACH
 STA. 192+00 TO STA. 193+00

DESIGN AGENCY

Palmer
 ENGINEERING
 8350 E. KEMPER RD.
 SUITE B
 CINCINNATI, OH 45249
 513-469-1600

DESIGNER

DPF

REVIEWER




DCJ MM-DD-YY

PROJECT ID

117955

Sheet Totals		
Seeding	Cut	Fill




SHEET	TOTAL
P. 182	228

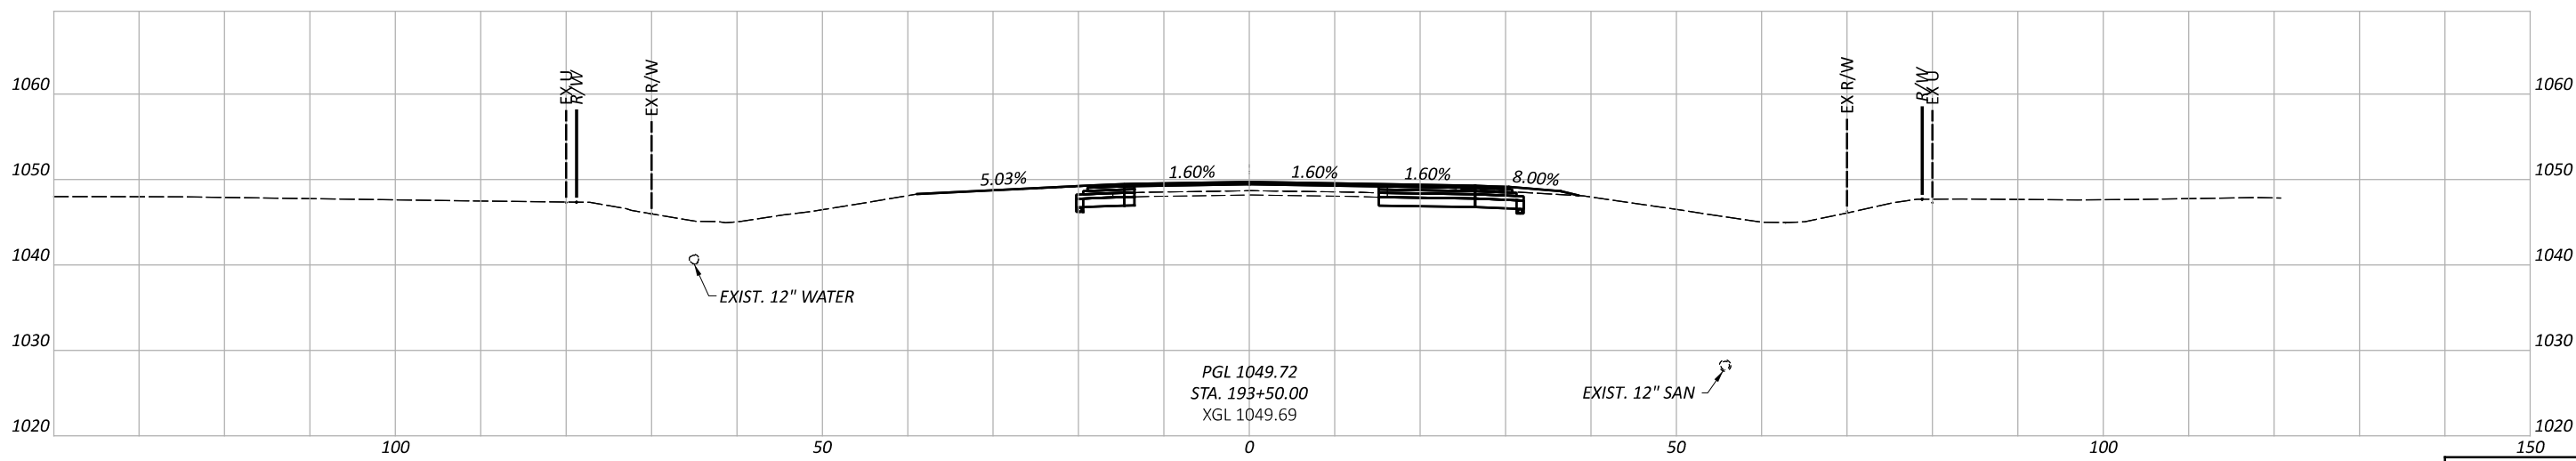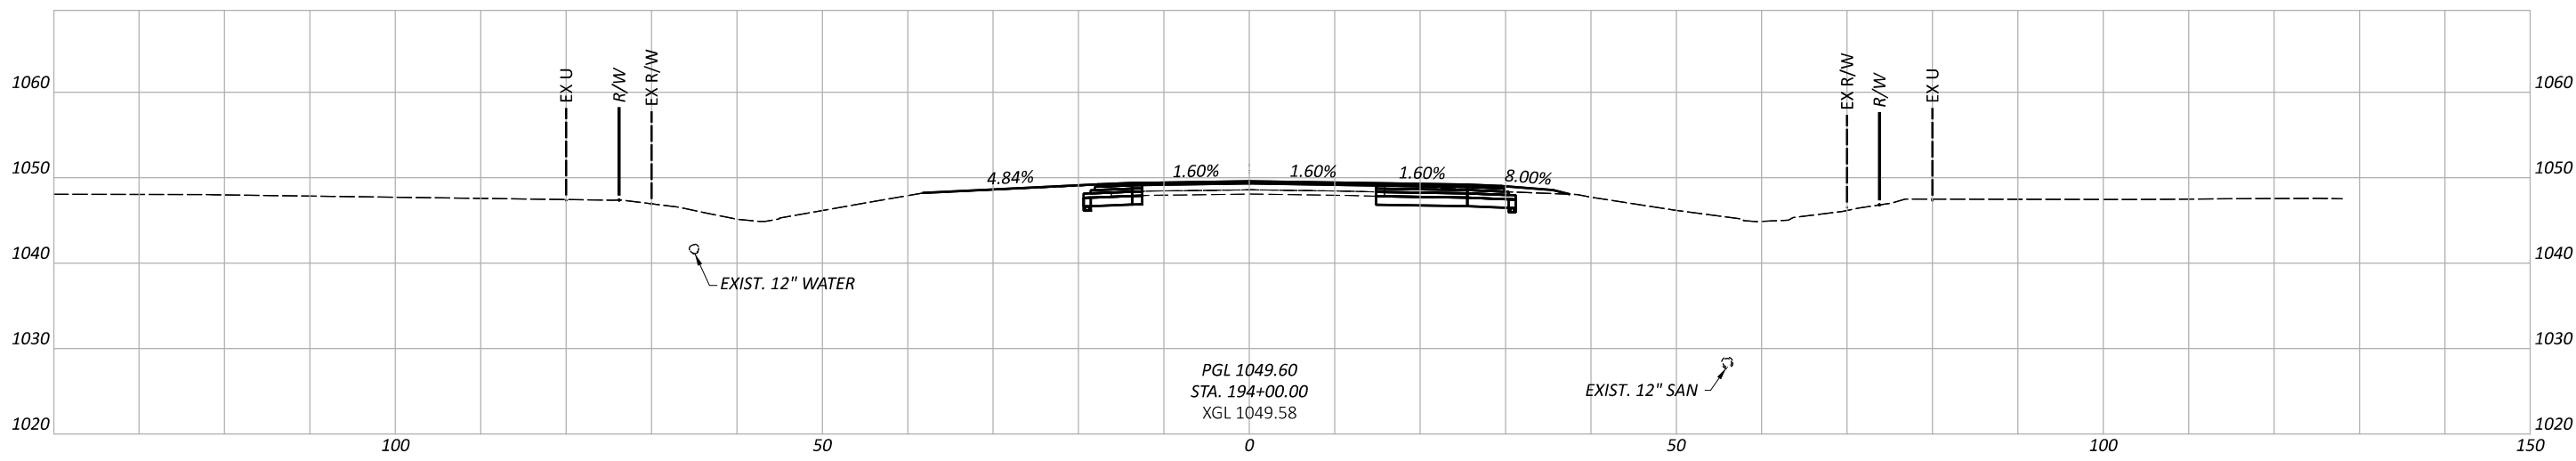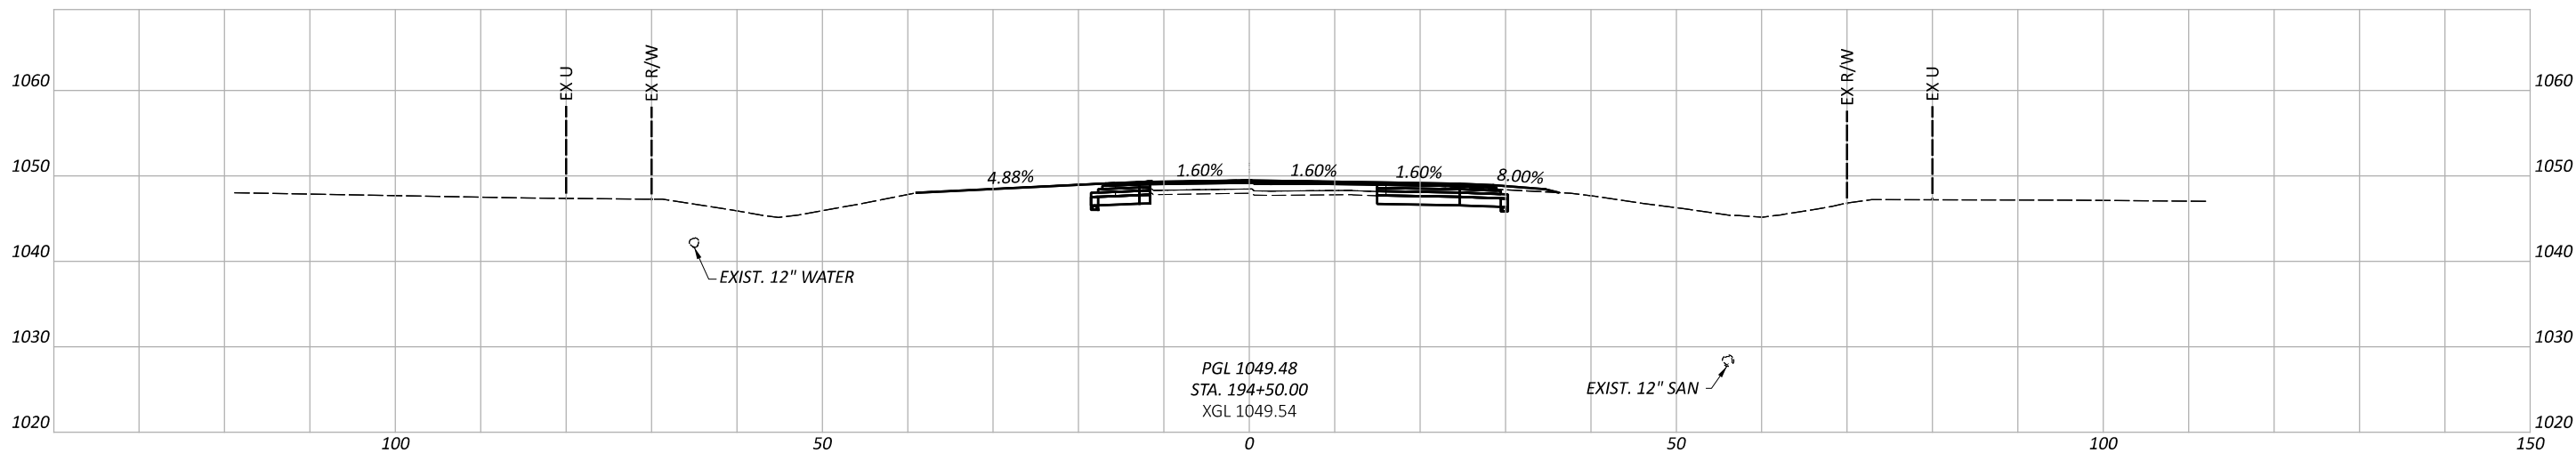

CROSS SECTIONS - BLUEGRASS - NORTH ROUNDABOUT APPROACH
 STA. 193+50 TO STA. 194+50

DESIGN AGENCY	
8350 E. KEMPER RD. SUITE B CINCINNATI, OH 45249 513-469-1600	
DESIGNER	
DPF	
REVIEWER	
DCJ MM-DD-YY	
PROJECT ID	
117955	
SHEET TOTAL	
P. 183	228

Sheet Totals		
Seeding	Cut	Fill

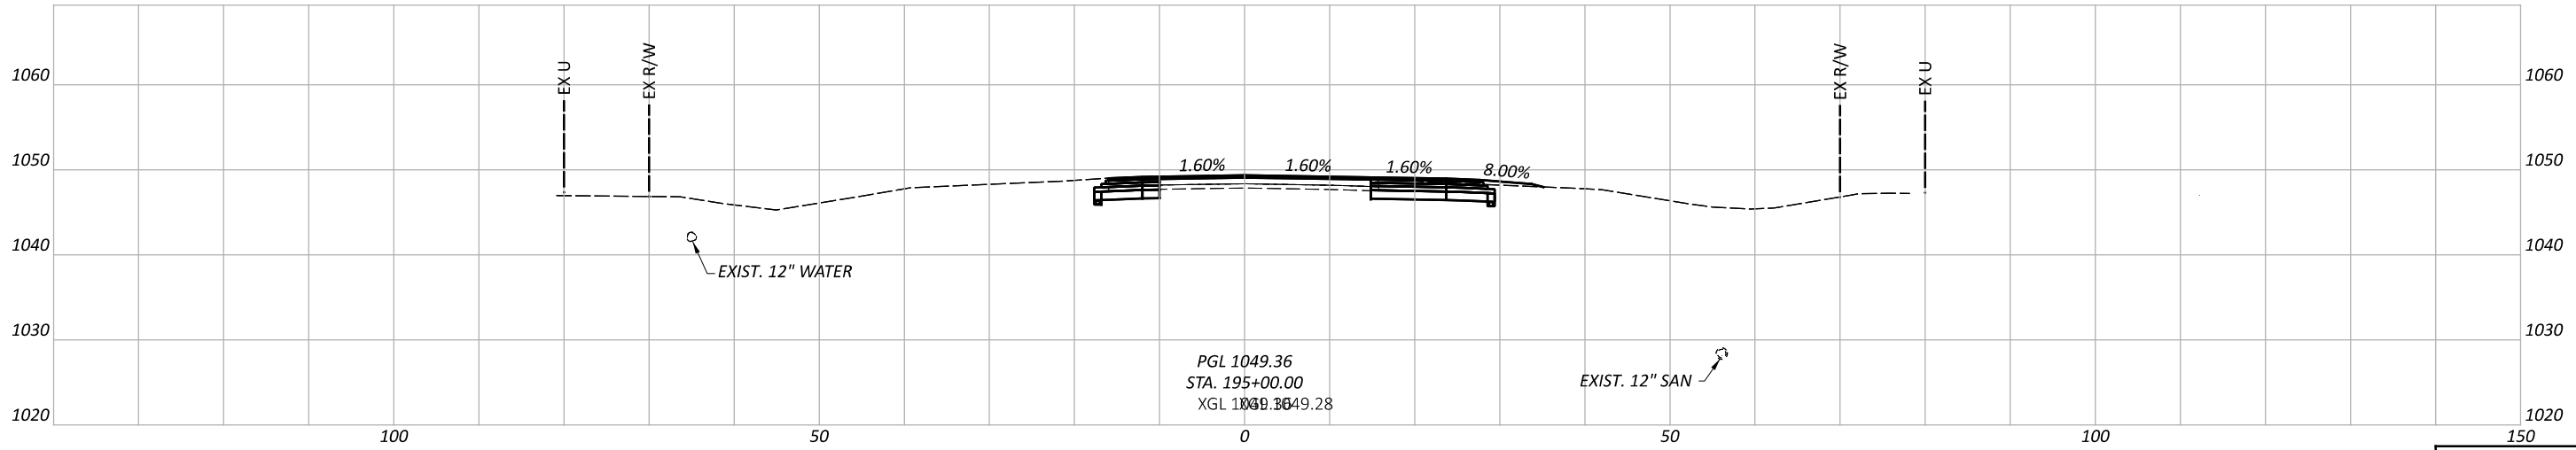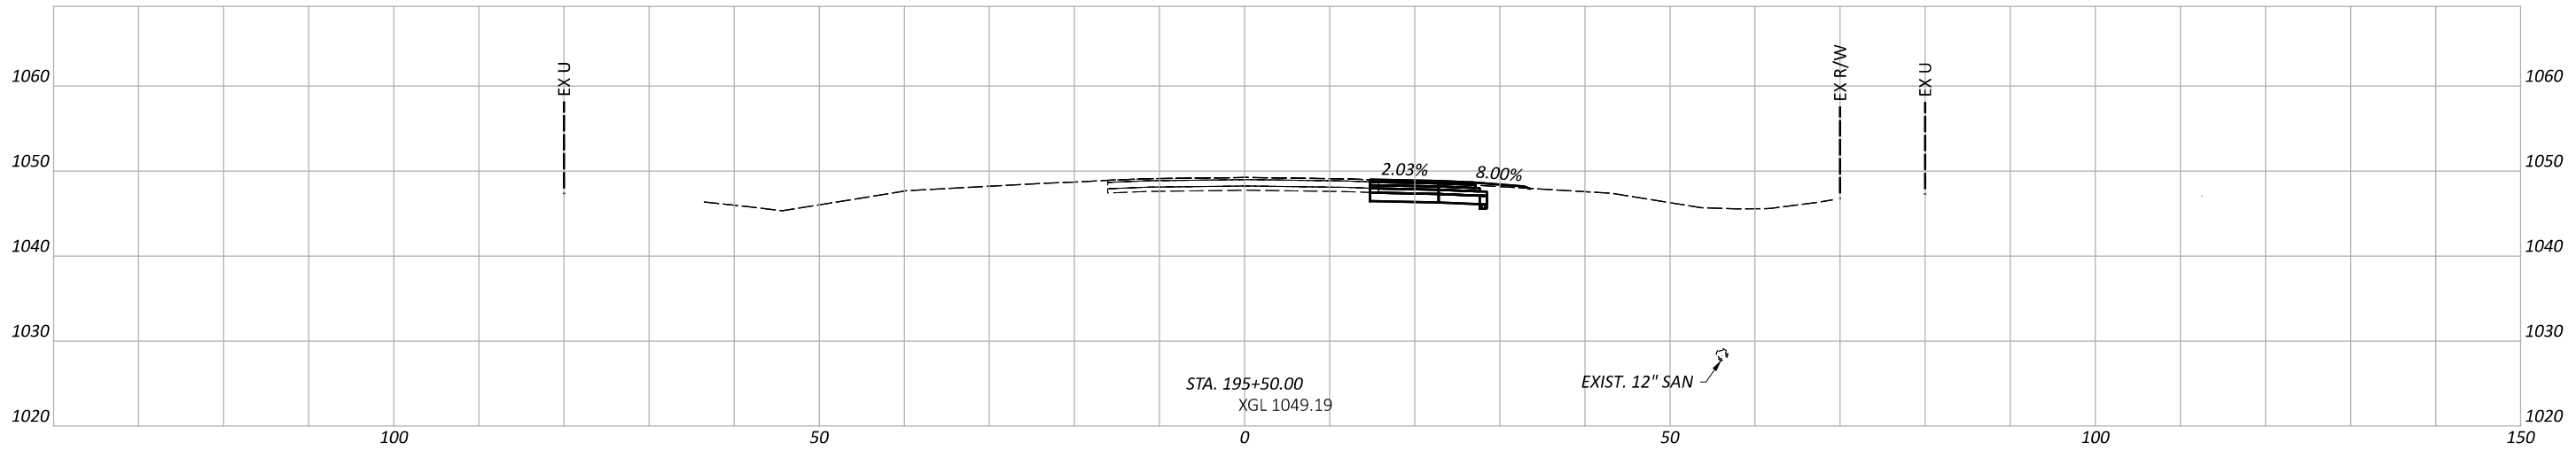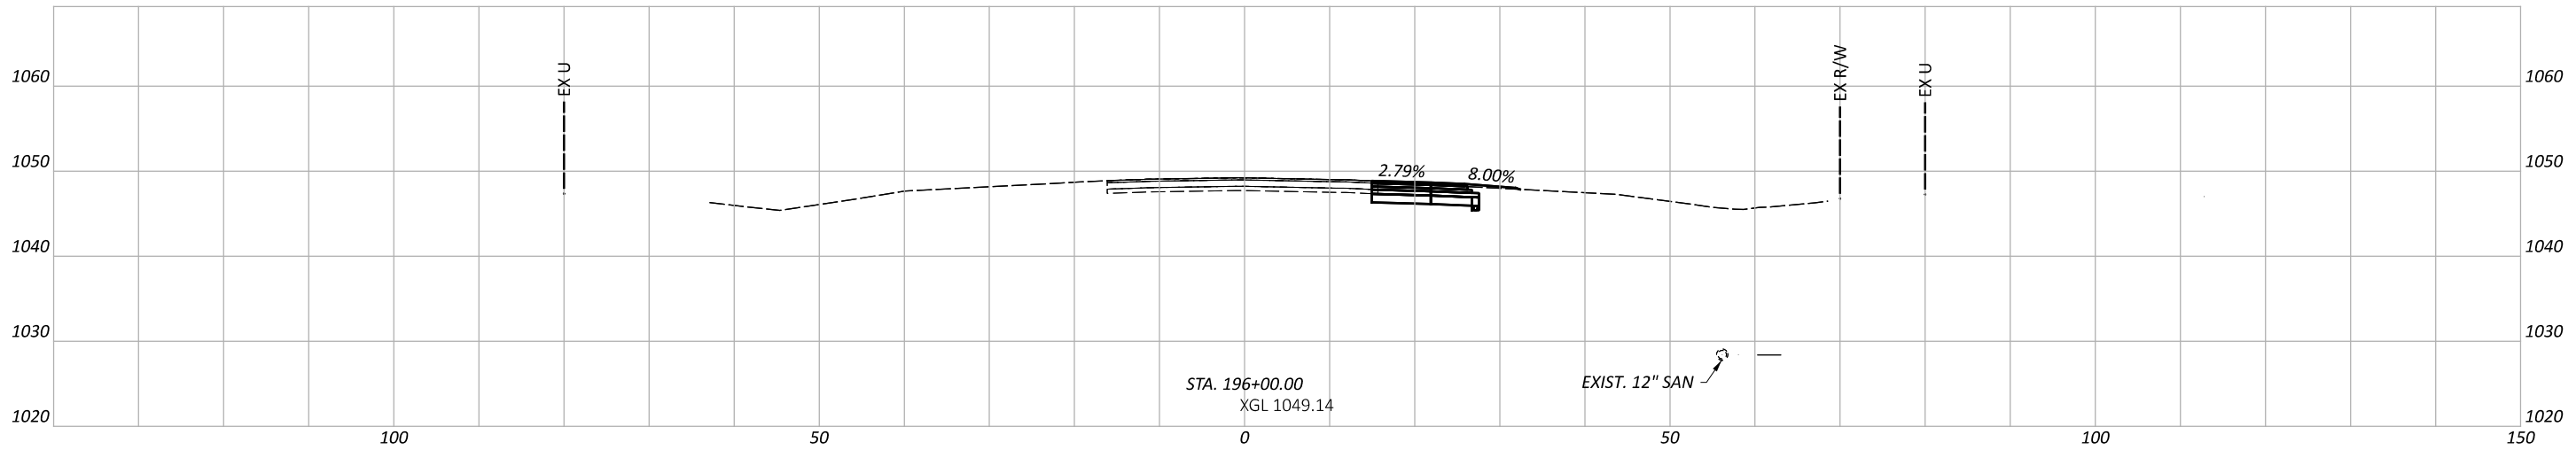

CROSS SECTIONS - BLUEGRASS - NORTH ROUNDABOUT APPROACH
 STA. 195+00 TO STA. 196+00




DESIGN AGENCY
Palmer
 ENGINEERING
 8350 E. KEMPER RD.
 SUITE B
 CINCINNATI, OH 45249
 513-469-1600

DESIGNER
 DPF

REVIEWER
 DCJ MM-DD-YY

PROJECT ID
 117955




Sheet Totals			TOTAL	
Seeding	Cut	Fill	SHEET	TOTAL
			P. 184	228

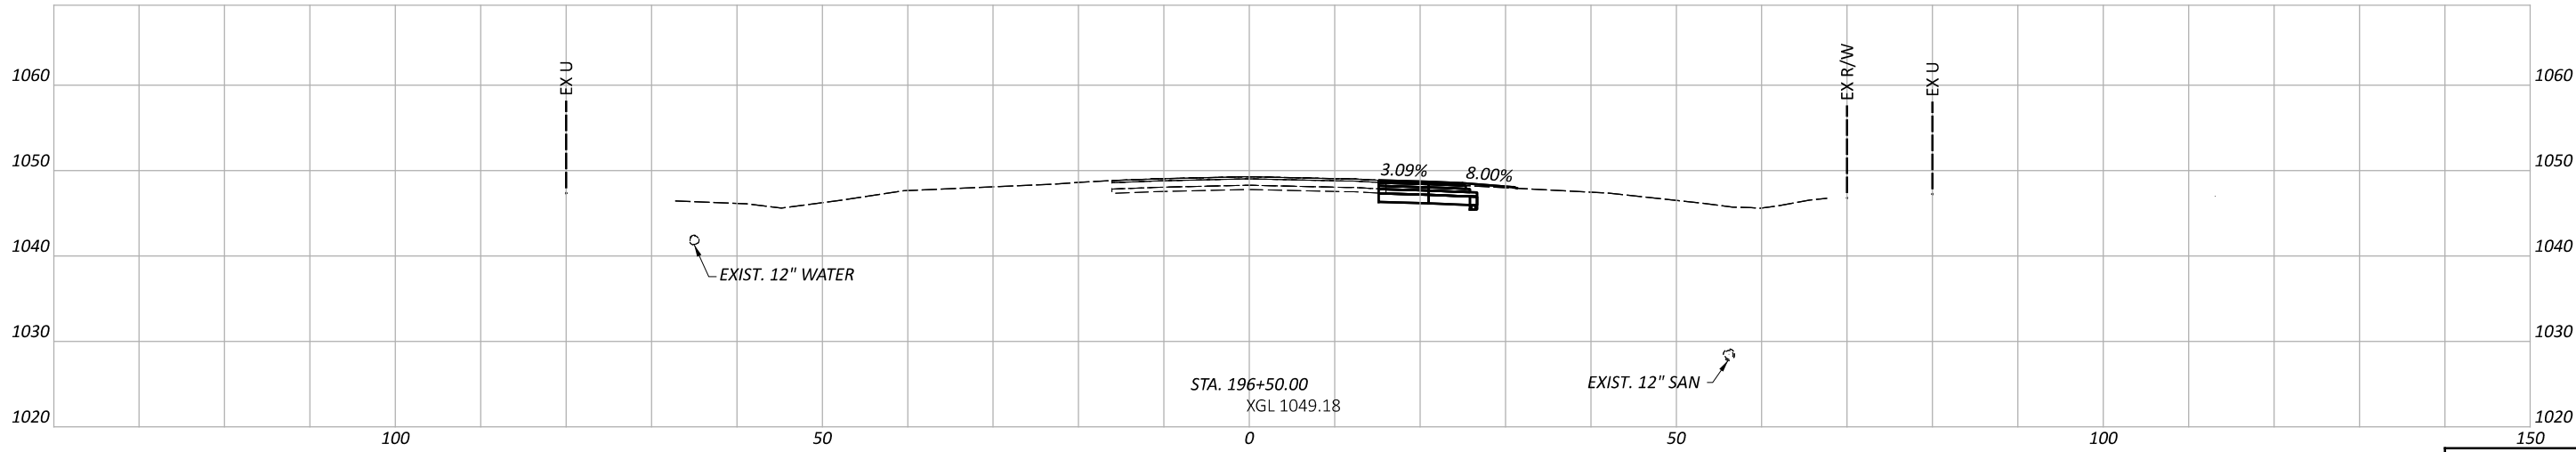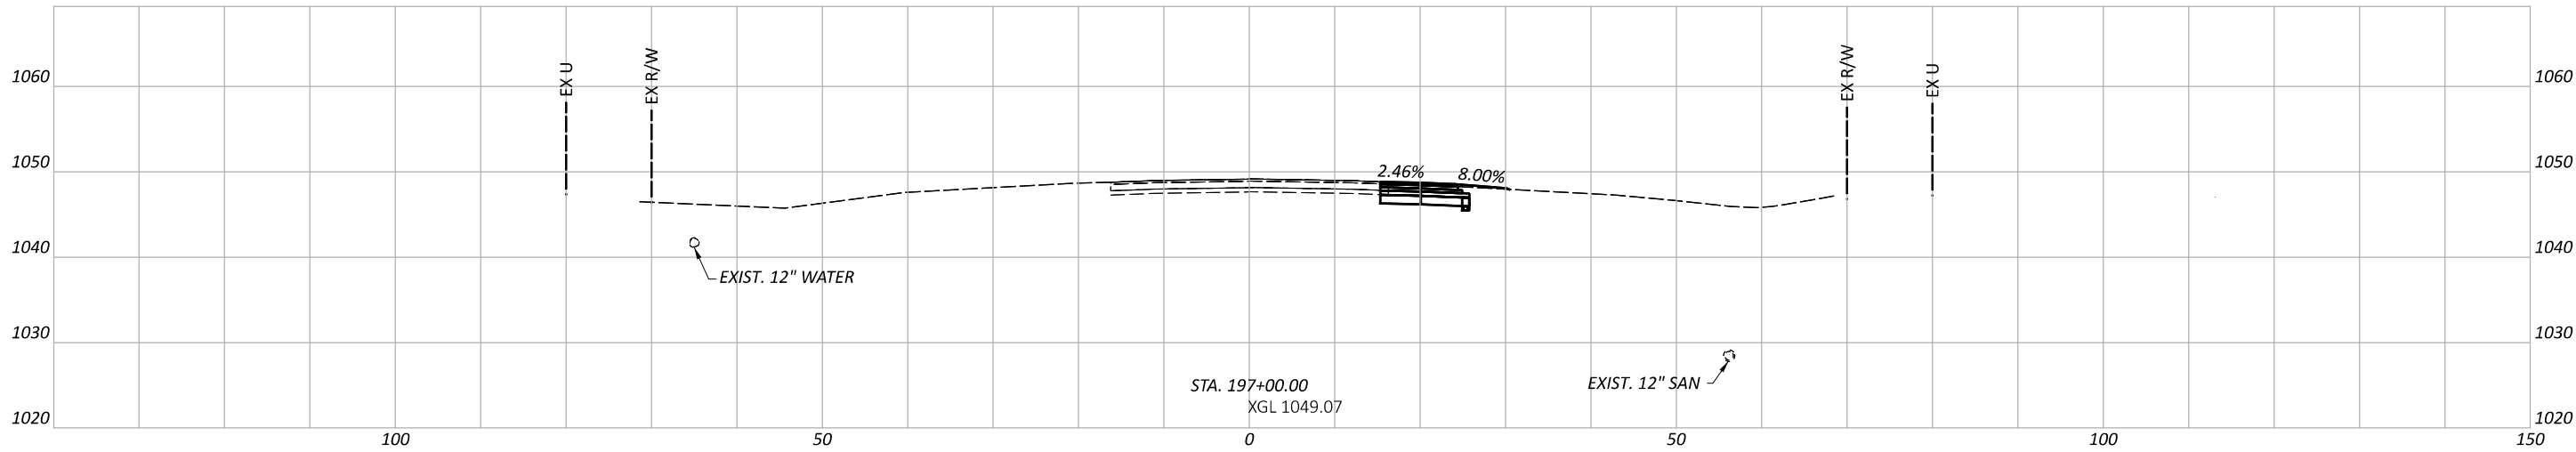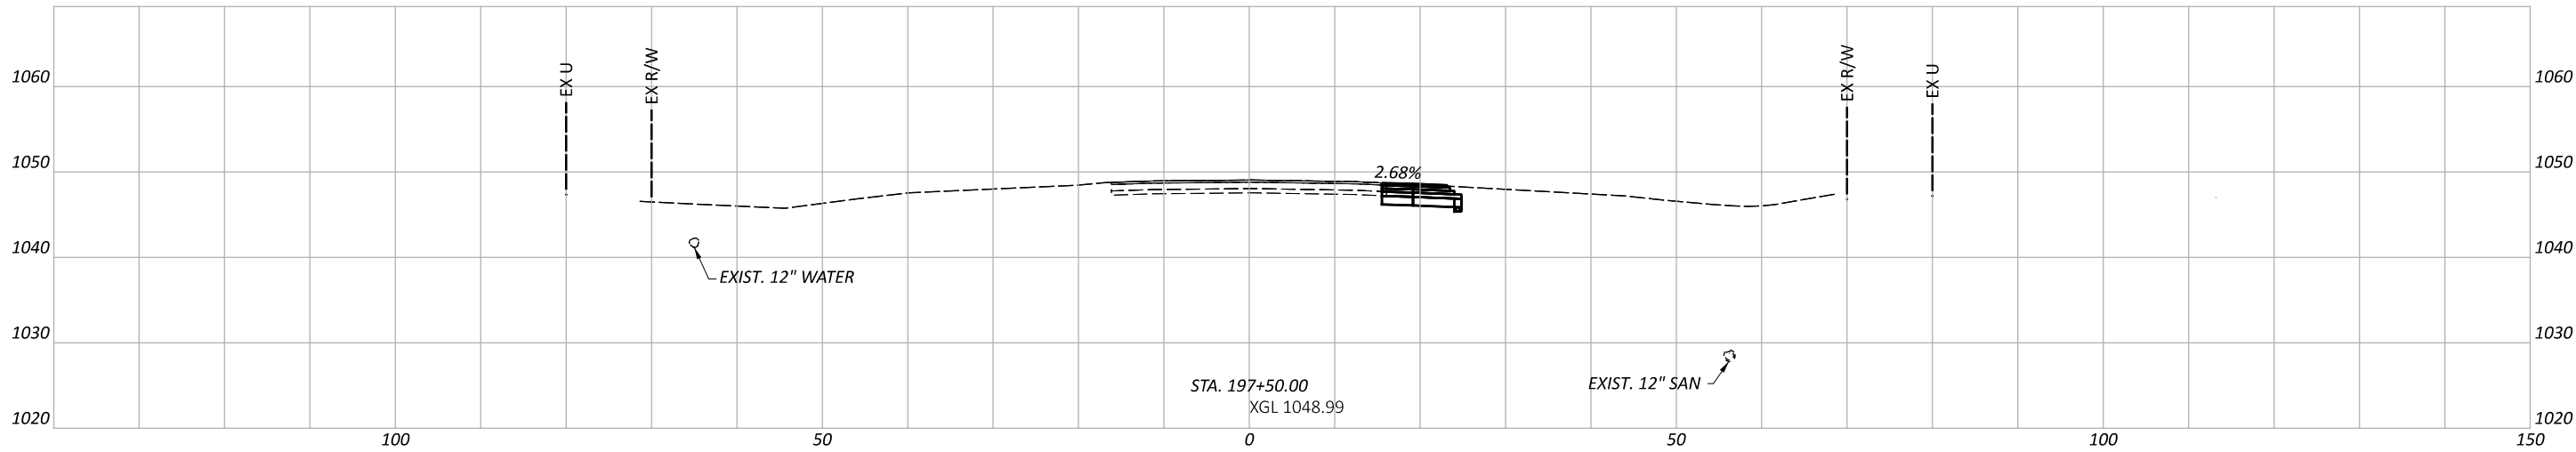


CROSS SECTIONS - BLUEGRASS - NORTH ROUNDABOUT APPROACH
 STA. 196+50 TO STA. 197+50

DESIGN AGENCY	Palmer ENGINEERING
DESIGNER	DPF
REVIEWER	DCJ MM-DD-YY
PROJECT ID	117955
SHEET TOTAL	TOTAL
P. 185	228

Sheet Totals		
Seeding	Cut	Fill

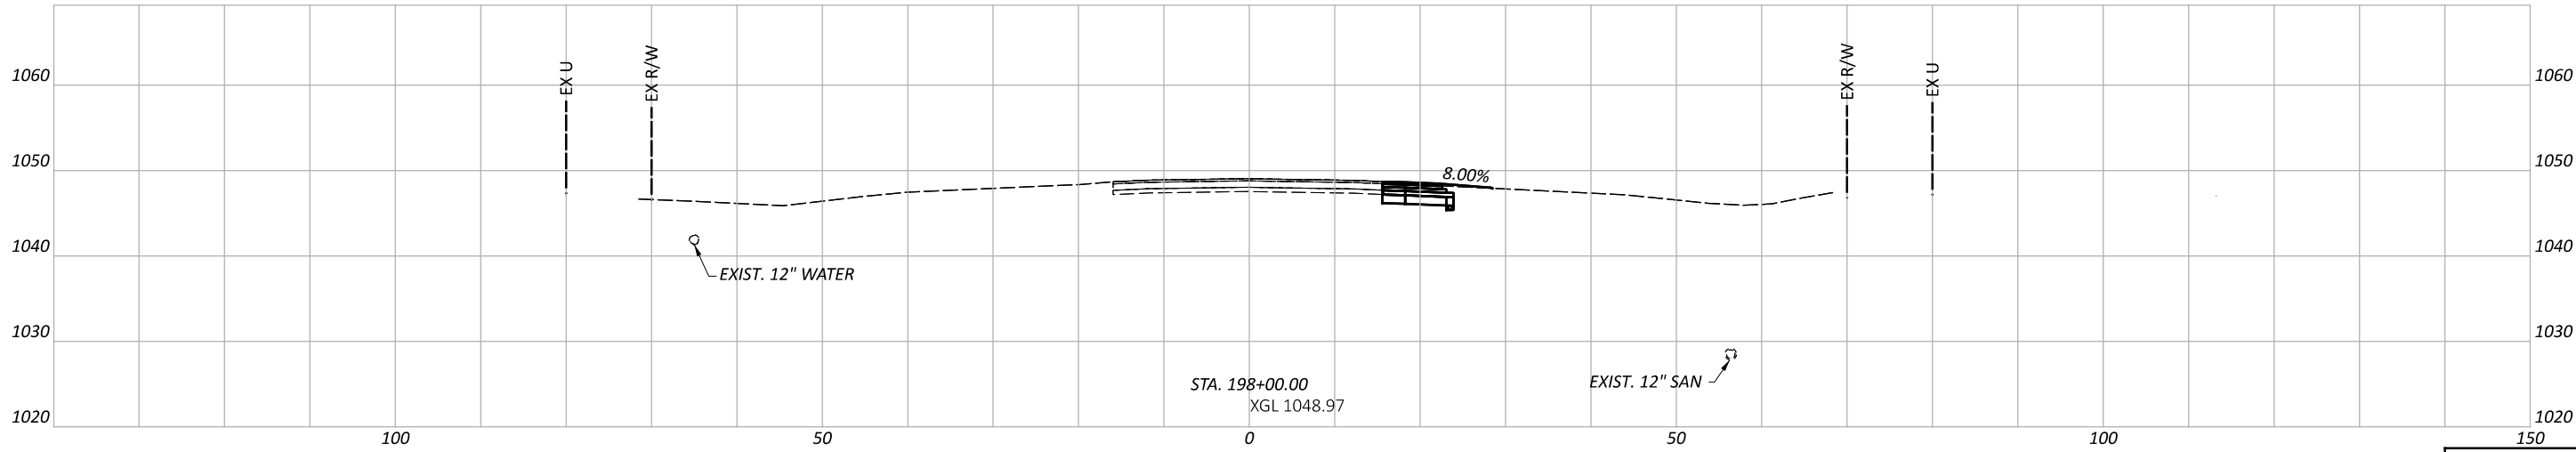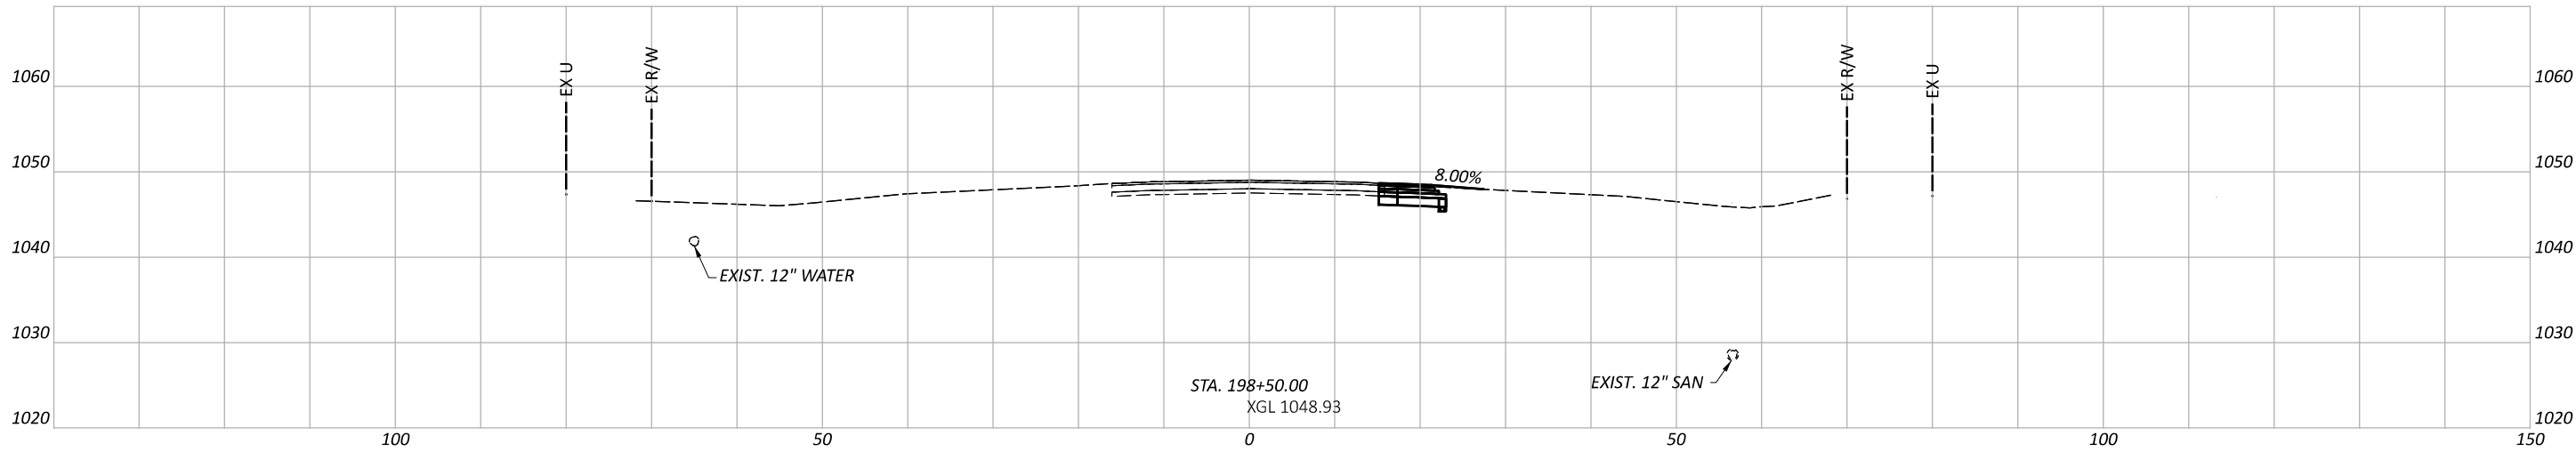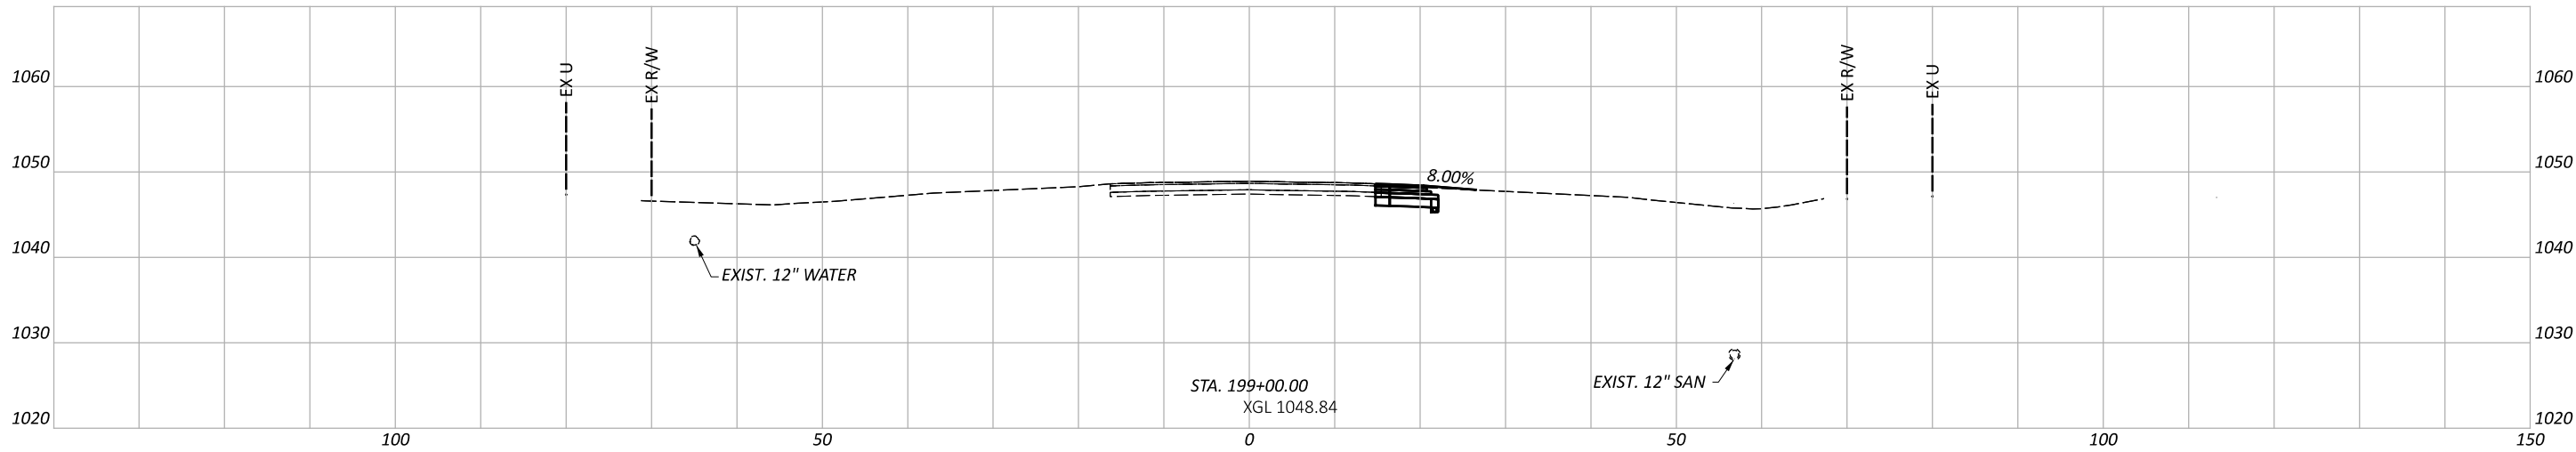

CROSS SECTIONS - BLUEGRASS - NORTH ROUNDABOUT APPROACH
 STA. 198+00 TO STA. 199+00




DESIGN AGENCY

 8350 E. KEMPER RD.
 SUITE B
 CINCINNATI, OH 45249
 513-469-1600

DESIGNER
 DPF

REVIEWER
 DCJ MM-DD-YY

PROJECT ID
 117955

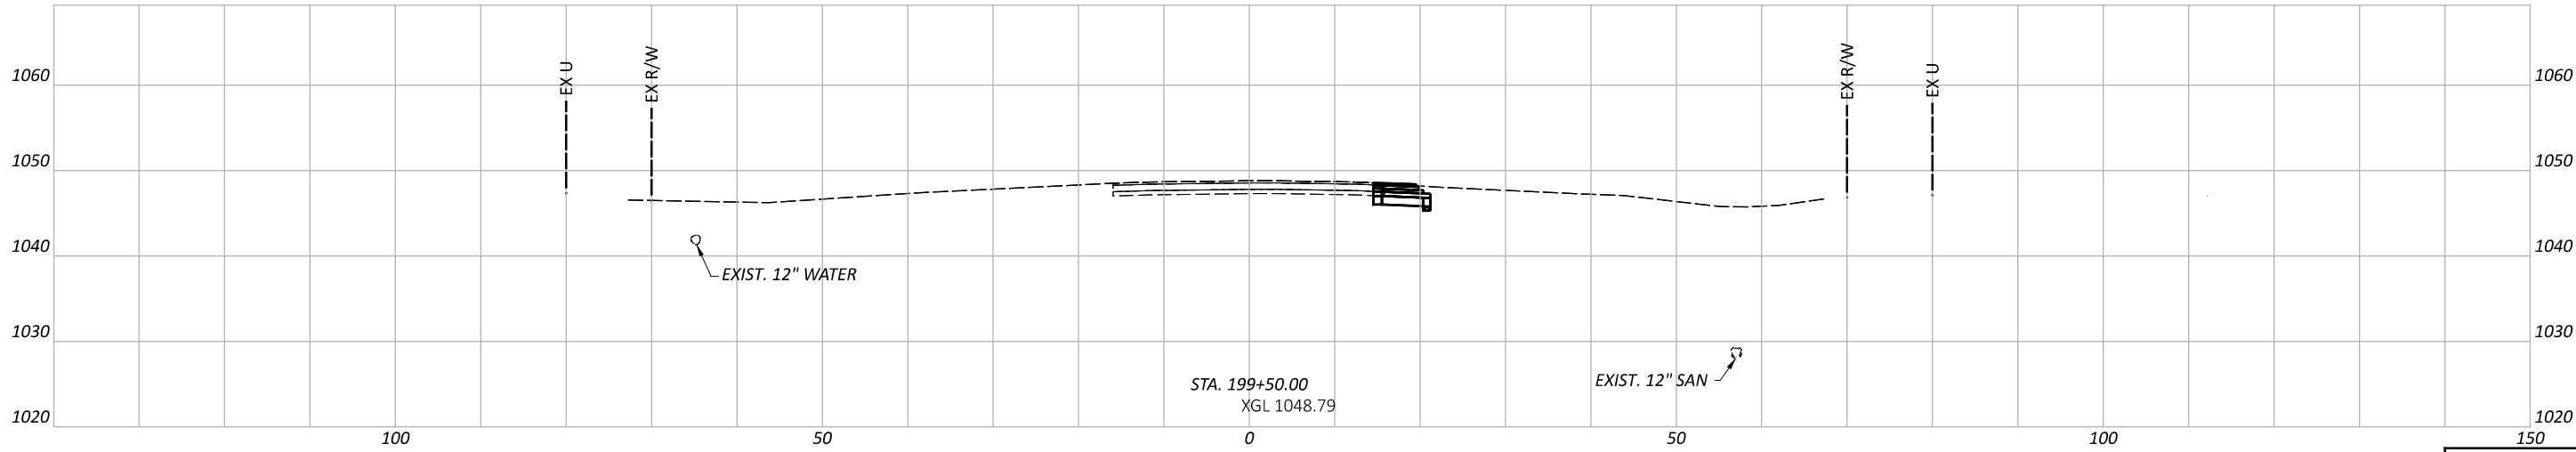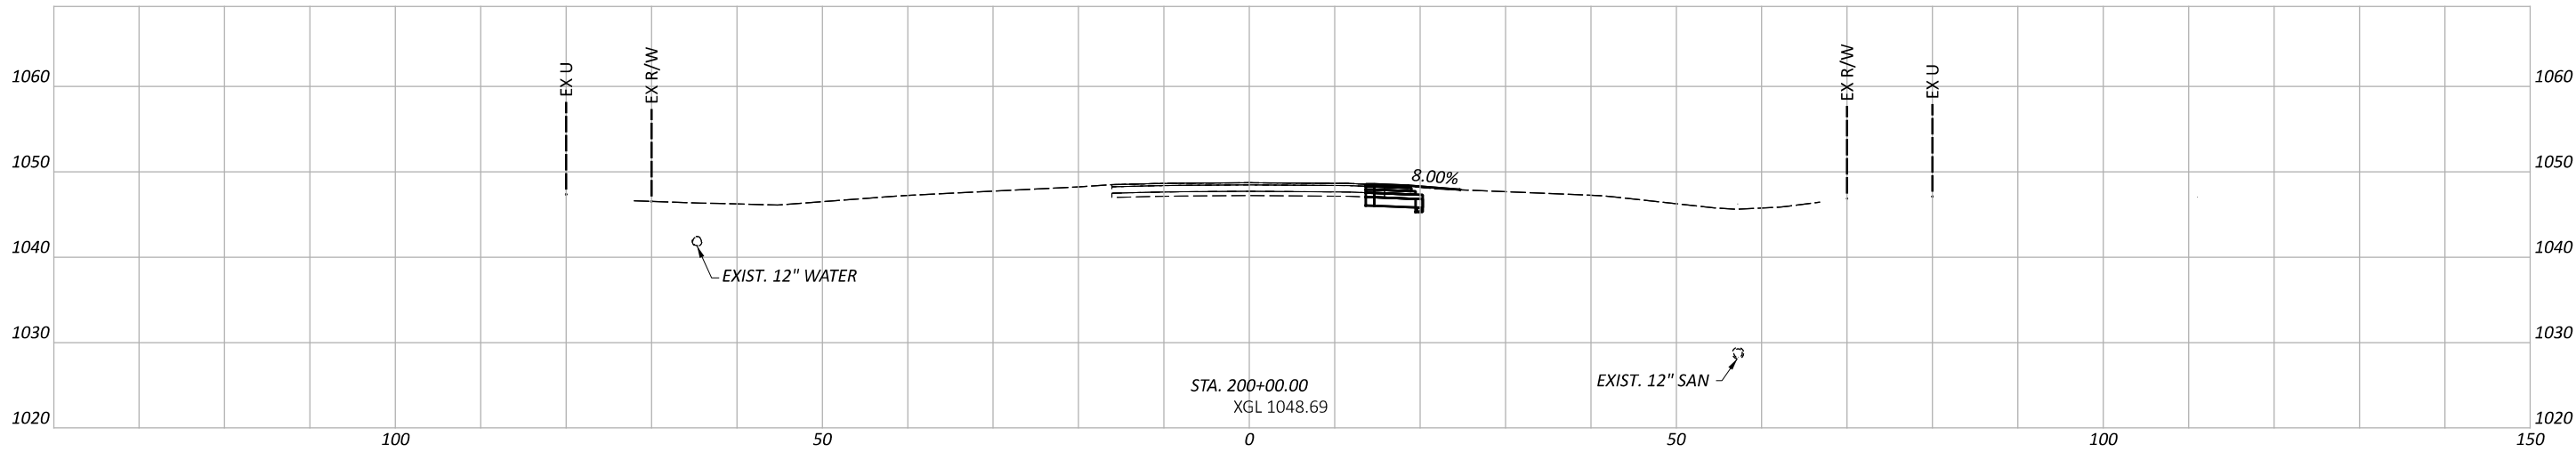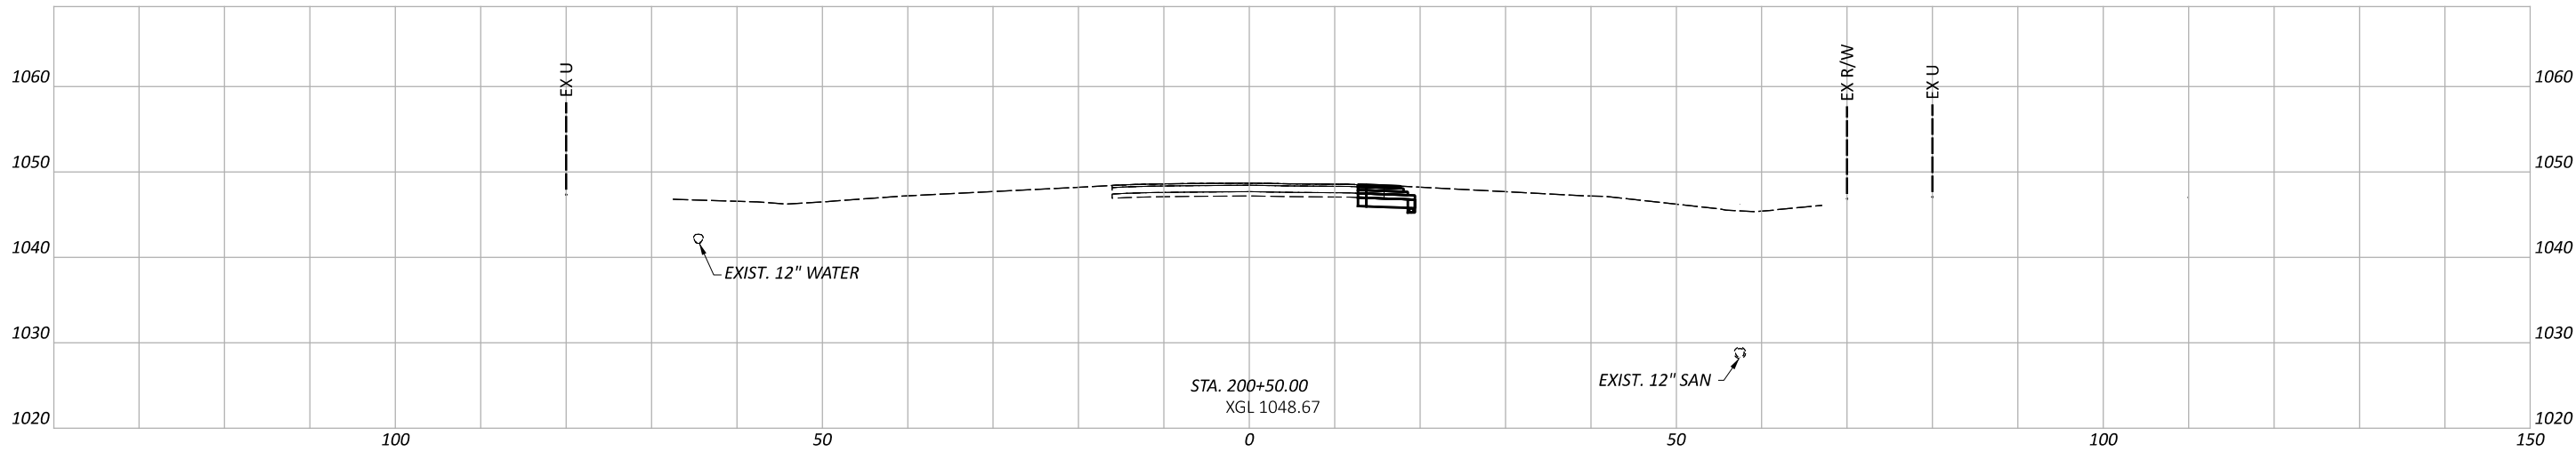Sheet Totals			TOTAL	
Seeding	Cut	Fill	P. 186	228



Sheet Totals			117955	
Seeding	Cut	Fill	SHEET	TOTAL
			P. 187	228




DESIGN AGENCY
Palmer
 ENGINEERING
 8350 E. KEMPER RD.
 SUITE B
 CINCINNATI, OH 45249
 513-469-1600

DESIGNER
 DPF

REVIEWER
 DCJ MM-DD-YY

PROJECT ID
 117955




CROSS SECTIONS - BLUEGRASS - NORTH ROUNDABOUT APPROACH
 STA. 199+50 TO STA. 200+50

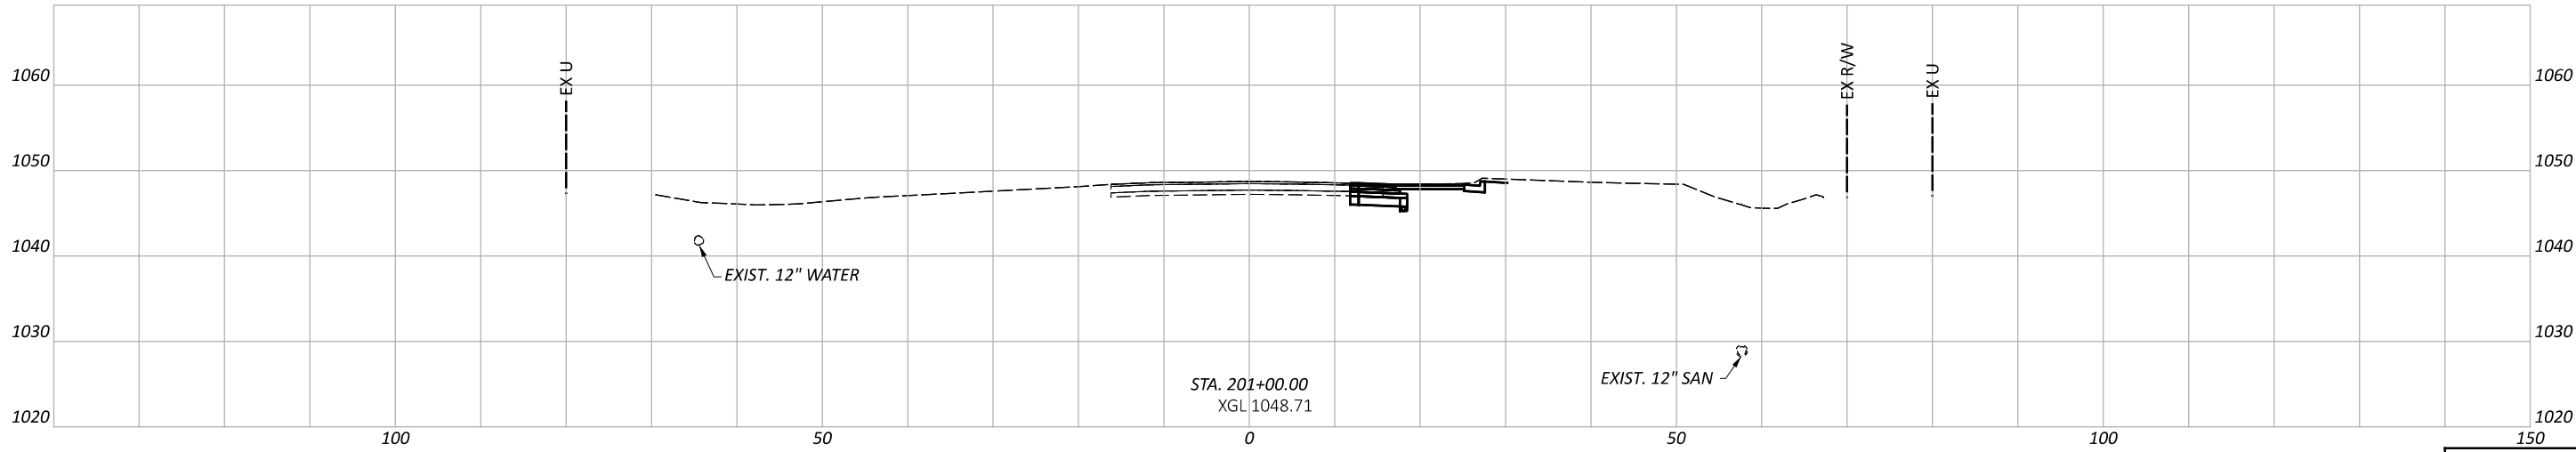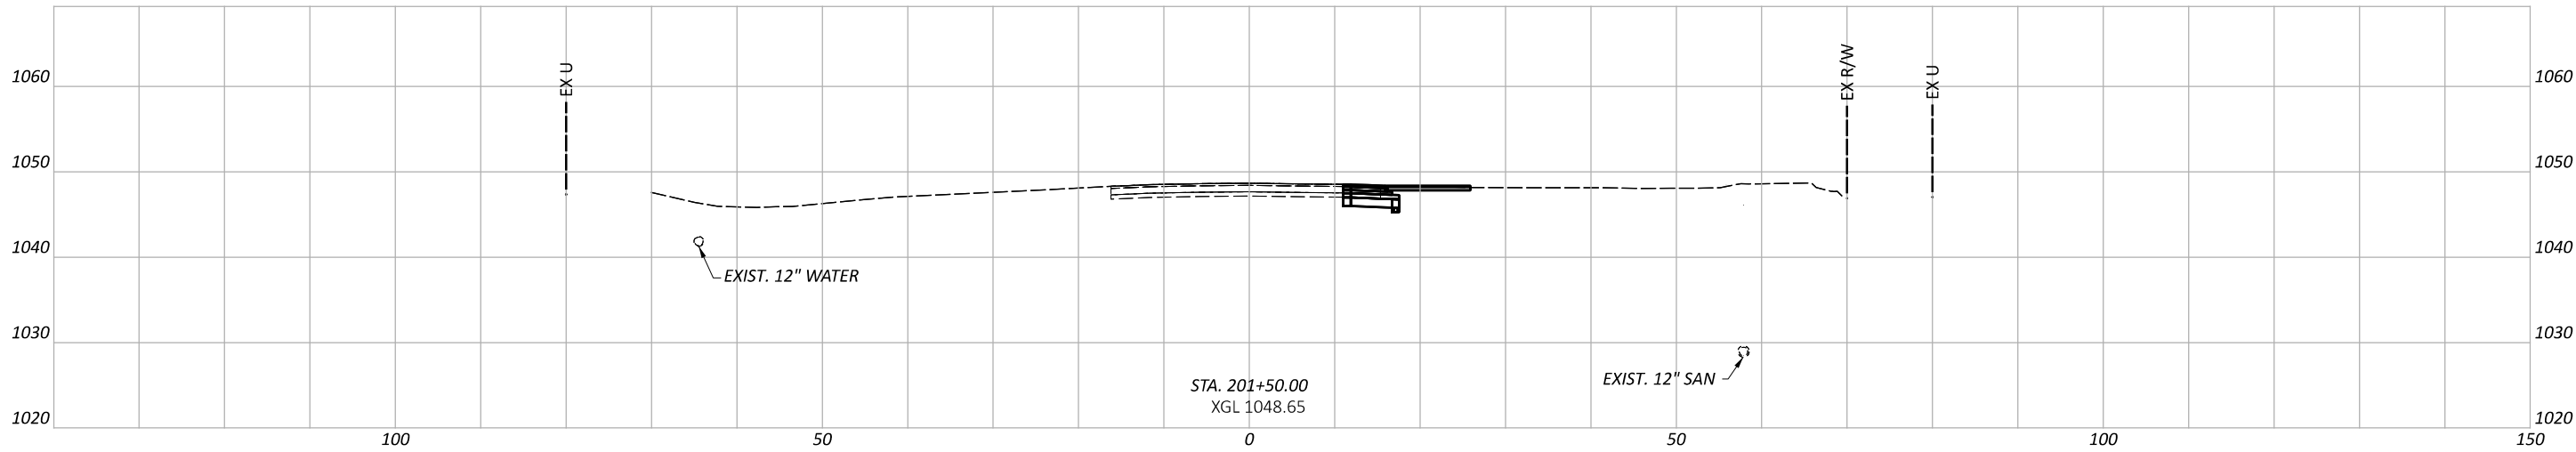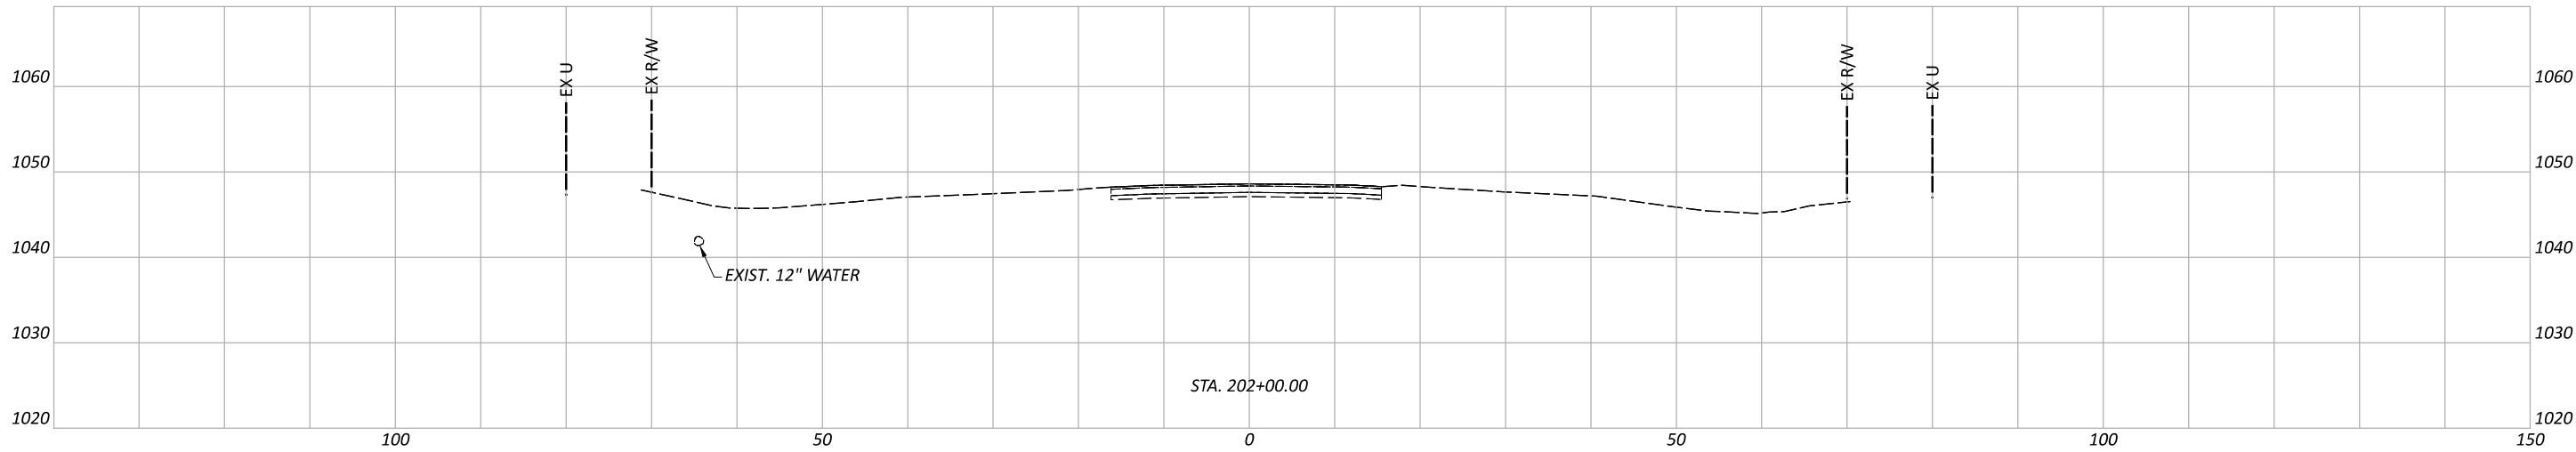

CROSS SECTIONS - BLUEGRASS - NORTH ROUNDABOUT APPROACH
 STA. 201+00 TO STA. 202+00

DESIGN AGENCY	
8350 E. KEMPER RD. SUITE B CINCINNATI, OH 45249 513-469-1600	
DESIGNER	
DPF	
REVIEWER	
DCJ MM-DD-YY	
PROJECT ID	
117955	
SHEET TOTAL	
P. 188	TOTAL 228



Sheet Totals		
Seeding	Cut	Fill

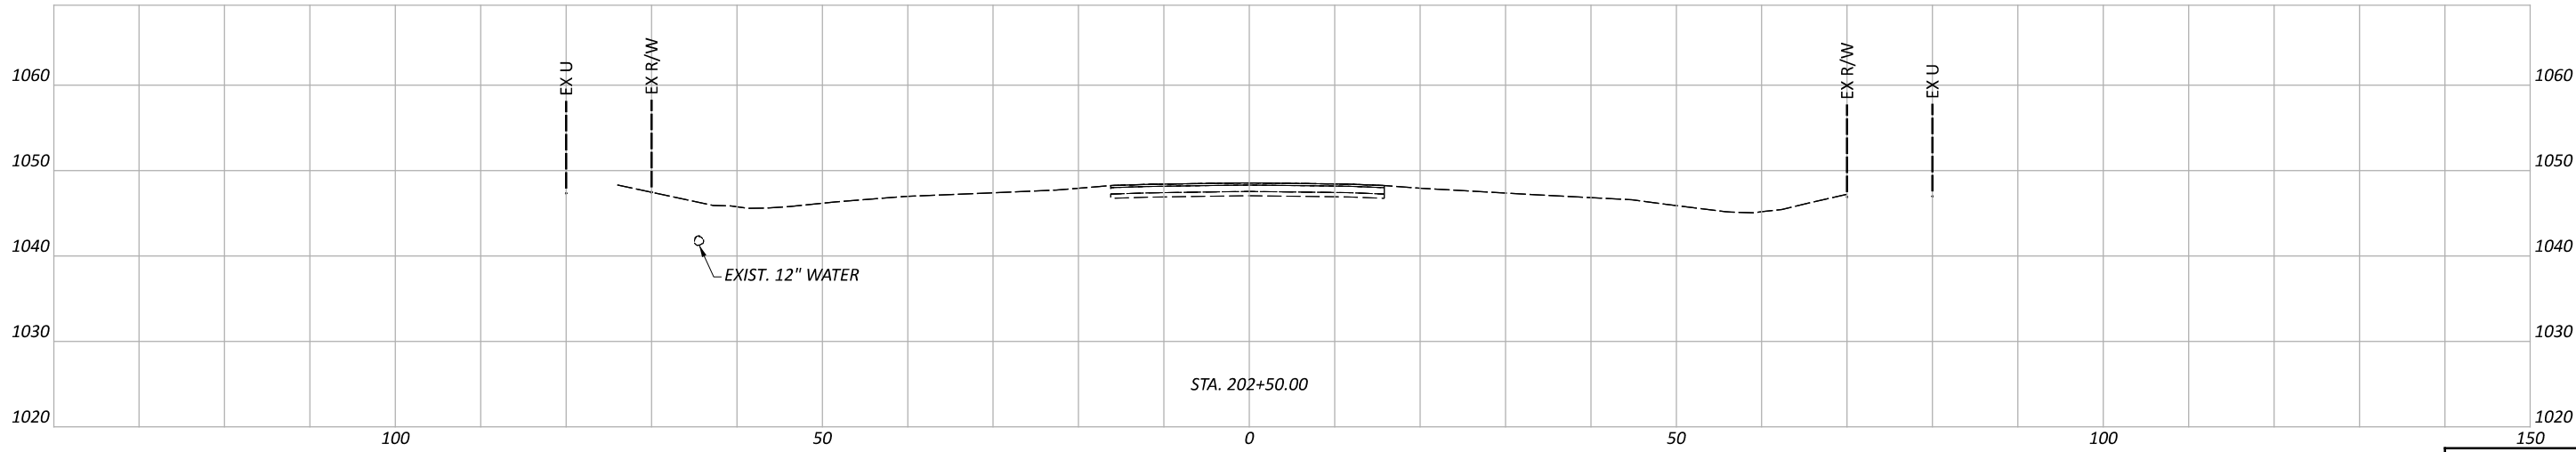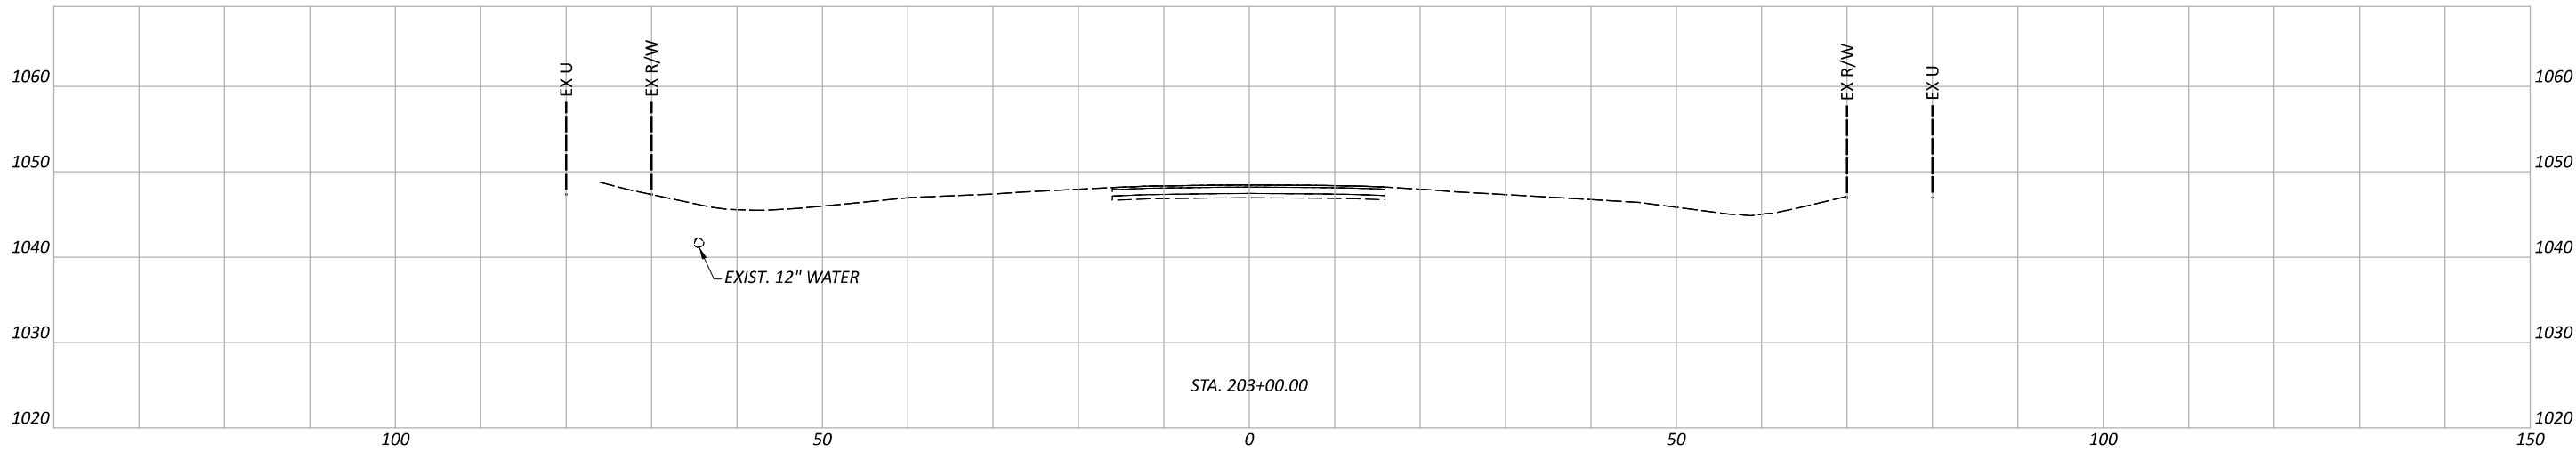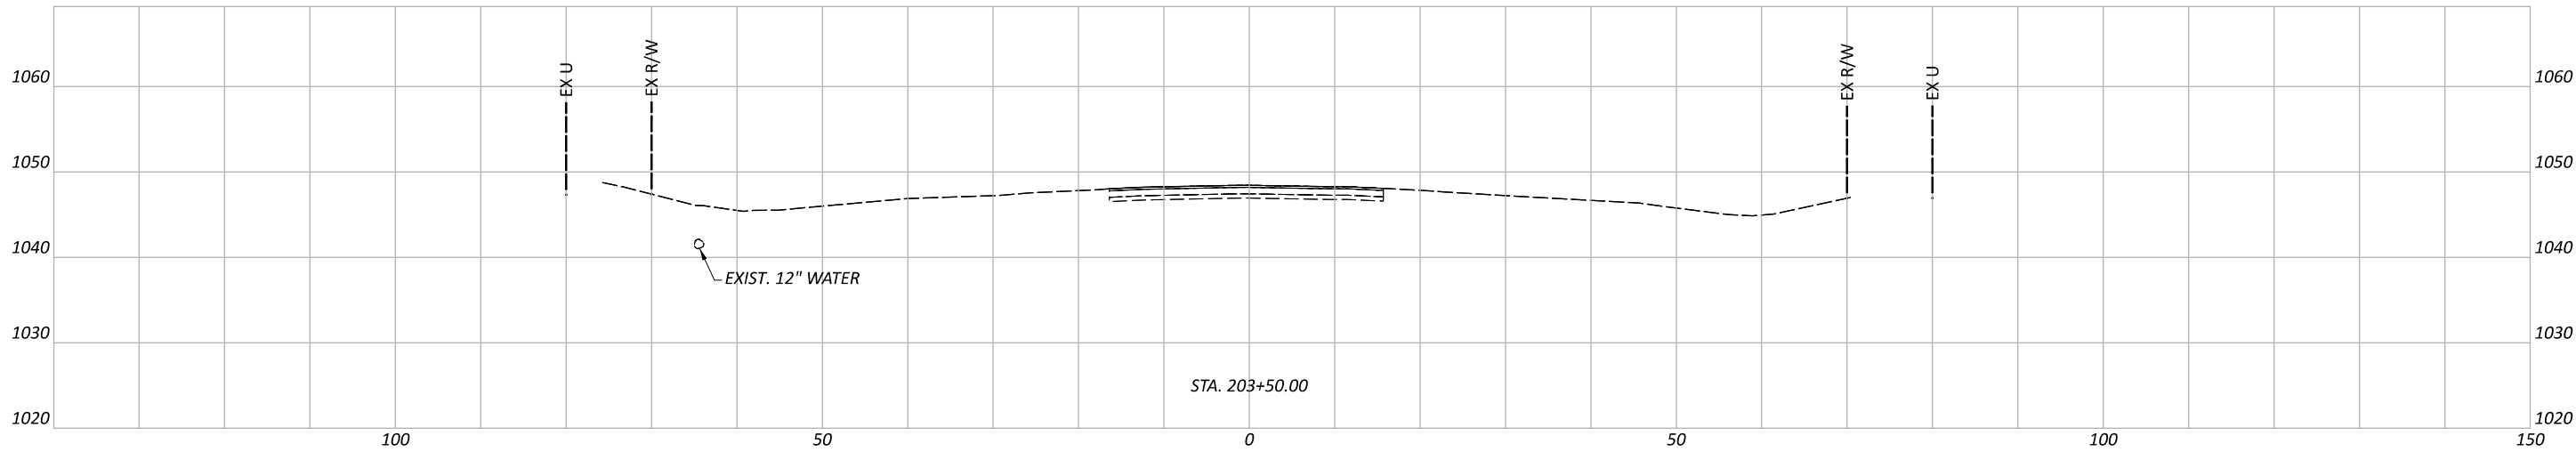

CROSS SECTIONS - BLUEGRASS - NORTH ROUNDABOUT APPROACH
 STA. 202+50 TO STA. 203+50

DESIGN AGENCY	
8350 E. KEMPER RD. SUITE B CINCINNATI, OH 45249 513-469-1600	
DESIGNER	
DPF	
REVIEWER	
DCJ MM-DD-YY	
PROJECT ID	
117955	
SHEET TOTAL	
P. 189	TOTAL 228

Sheet Totals		
Seeding	Cut	Fill

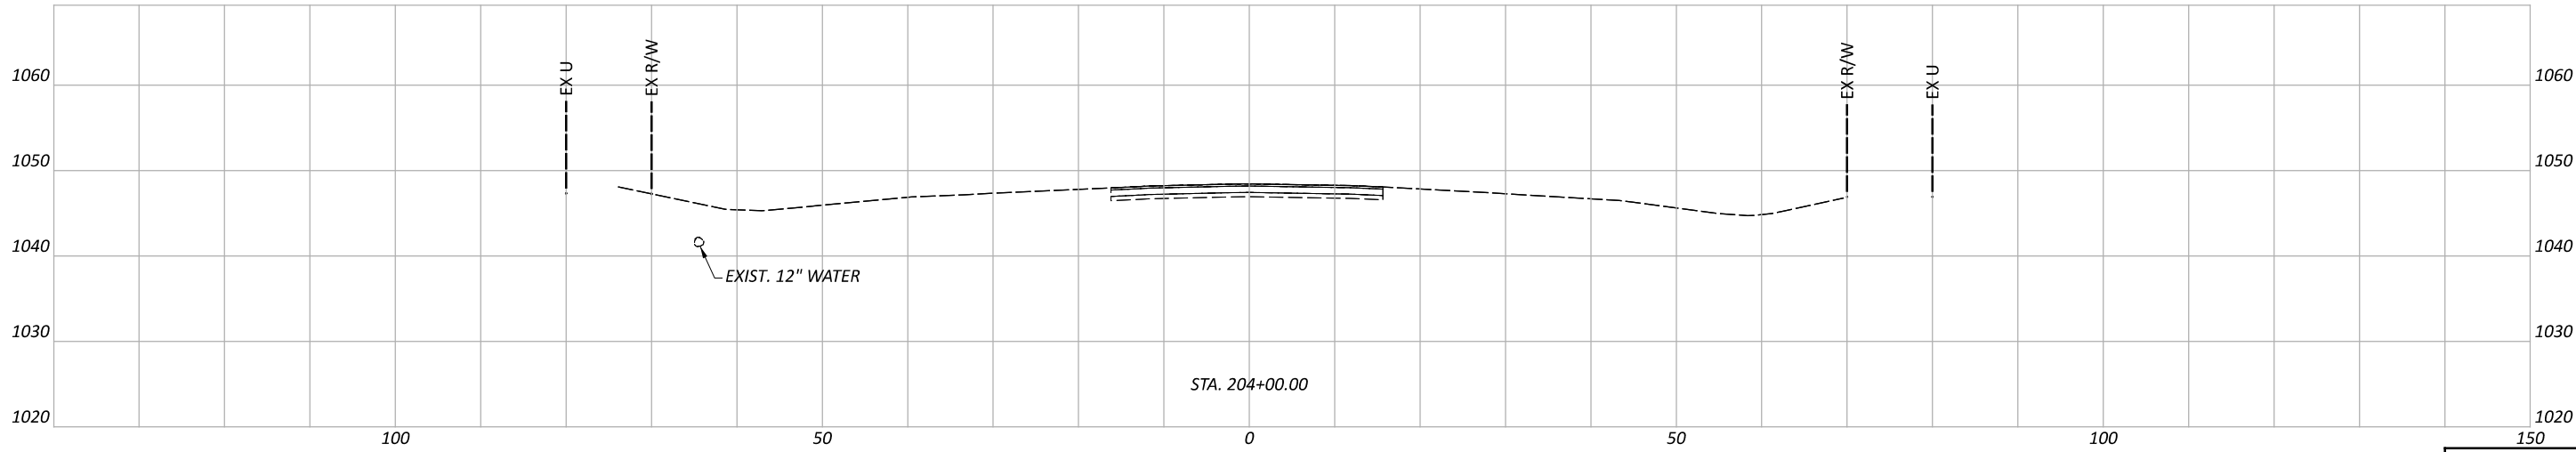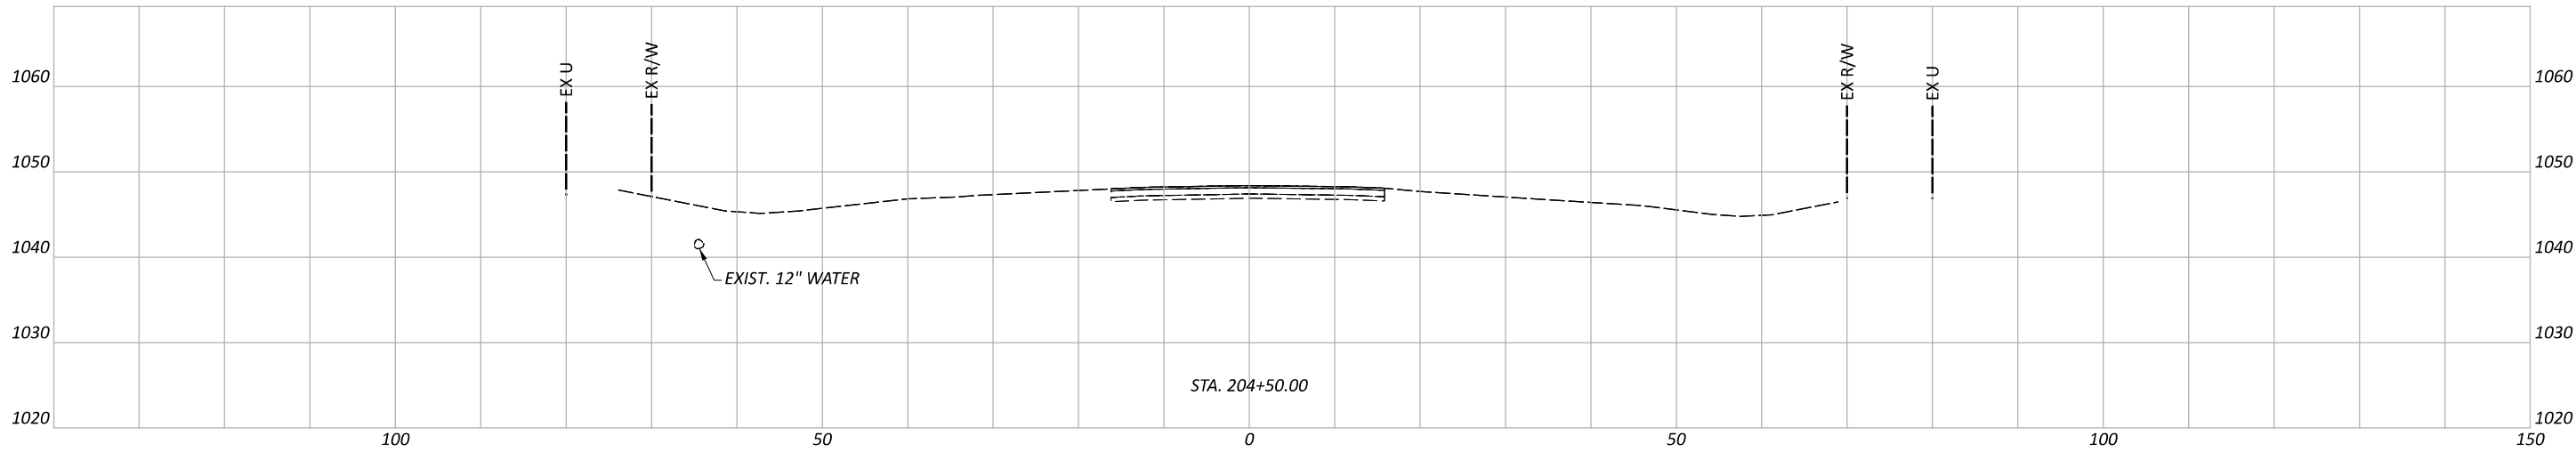

CROSS SECTIONS - BLUEGRASS - NORTH ROUNDABOUT APPROACH
 STA. 204+00 TO STA. 204+50

DESIGN AGENCY
Palmer
 ENGINEERING
 8350 E. KEMPER RD.
 SUITE B
 CINCINNATI, OH 45249
 513-469-1600






DESIGNER
 DPF

REVIEWER
 DCJ MM-DD-YY


PROJECT ID
 117955

Sheet Totals		
Seeding	Cut	Fill

SHEET	TOTAL
P. 190	228

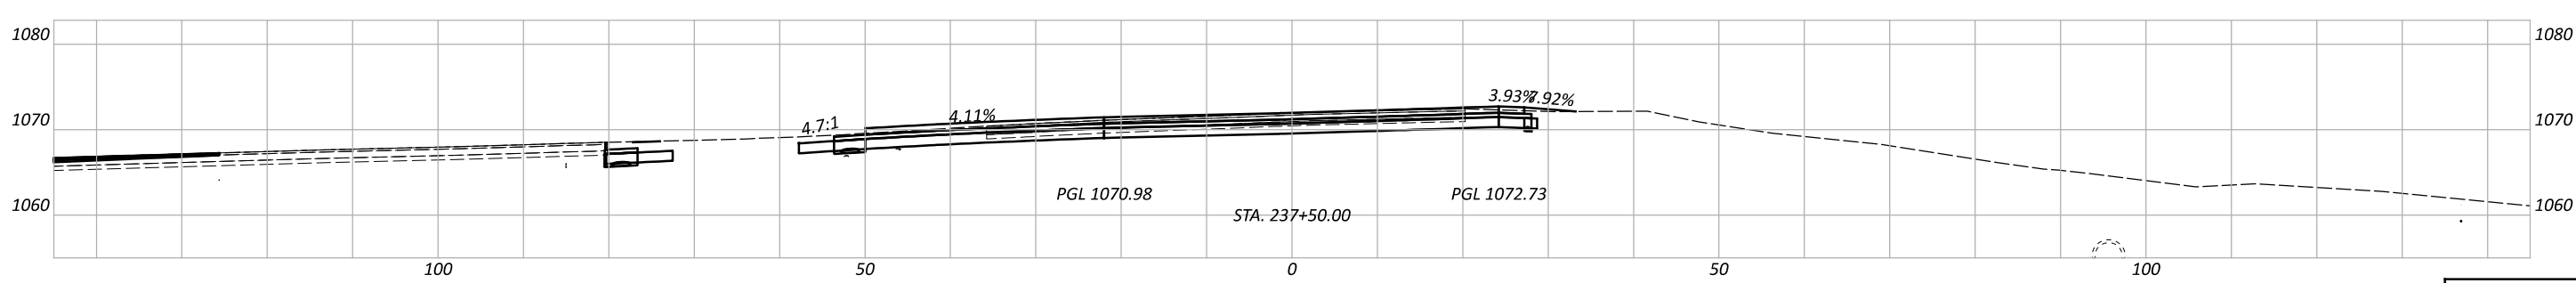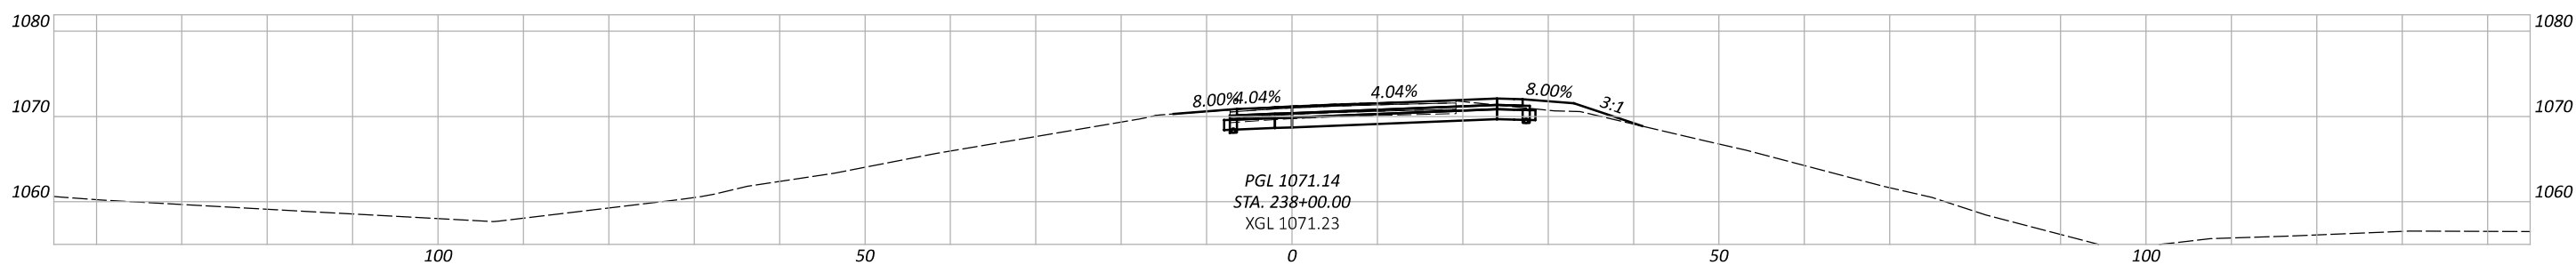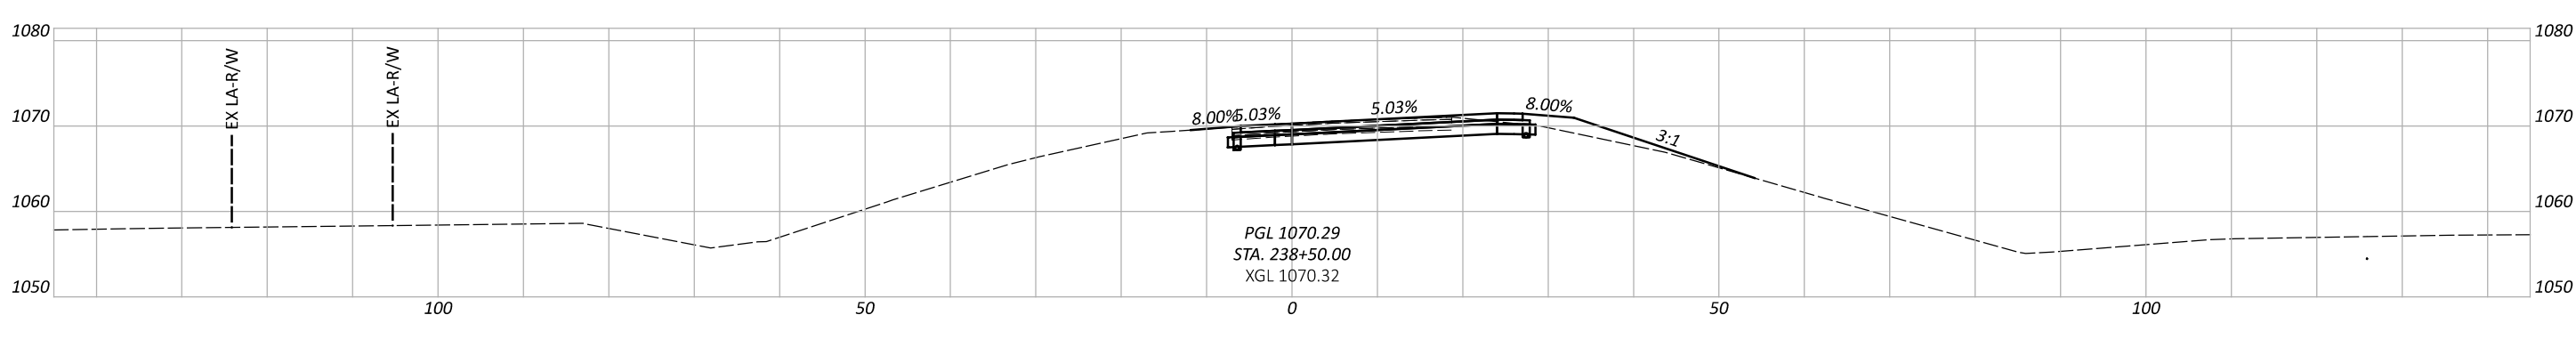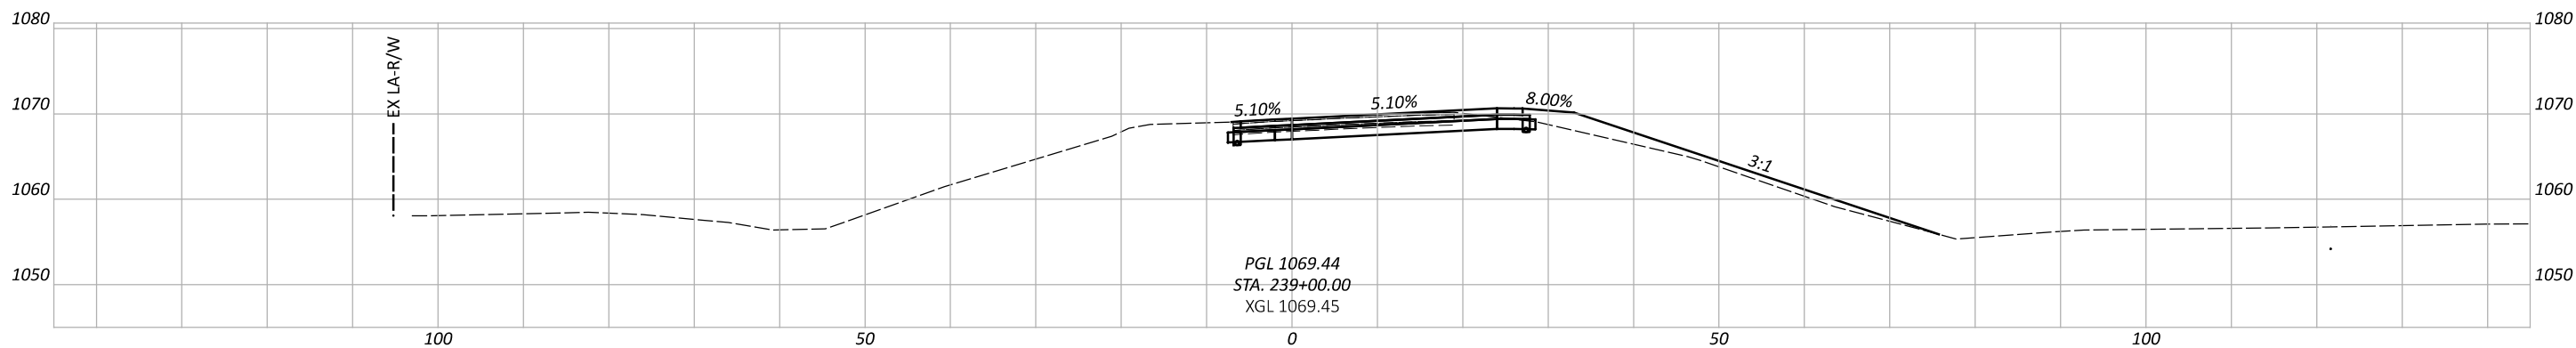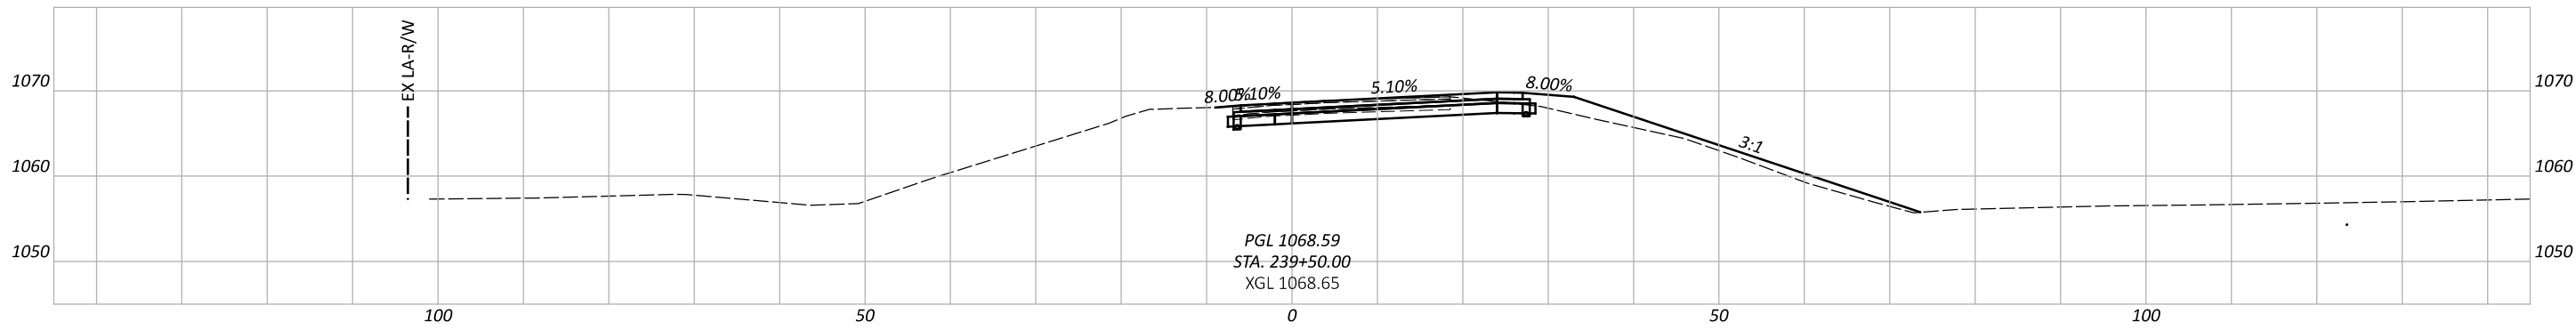

CROSS SECTIONS - US 35 RAMP D
 STA. 237+50 TO STA. 239+50





DESIGN AGENCY

 8350 E. KEMPER RD.
 SUITE B
 CINCINNATI, OH 45249
 513-469-1600

DESIGNER
 DPF

REVIEWER
 DCJ MM-DD-YY

PROJECT ID
 117955

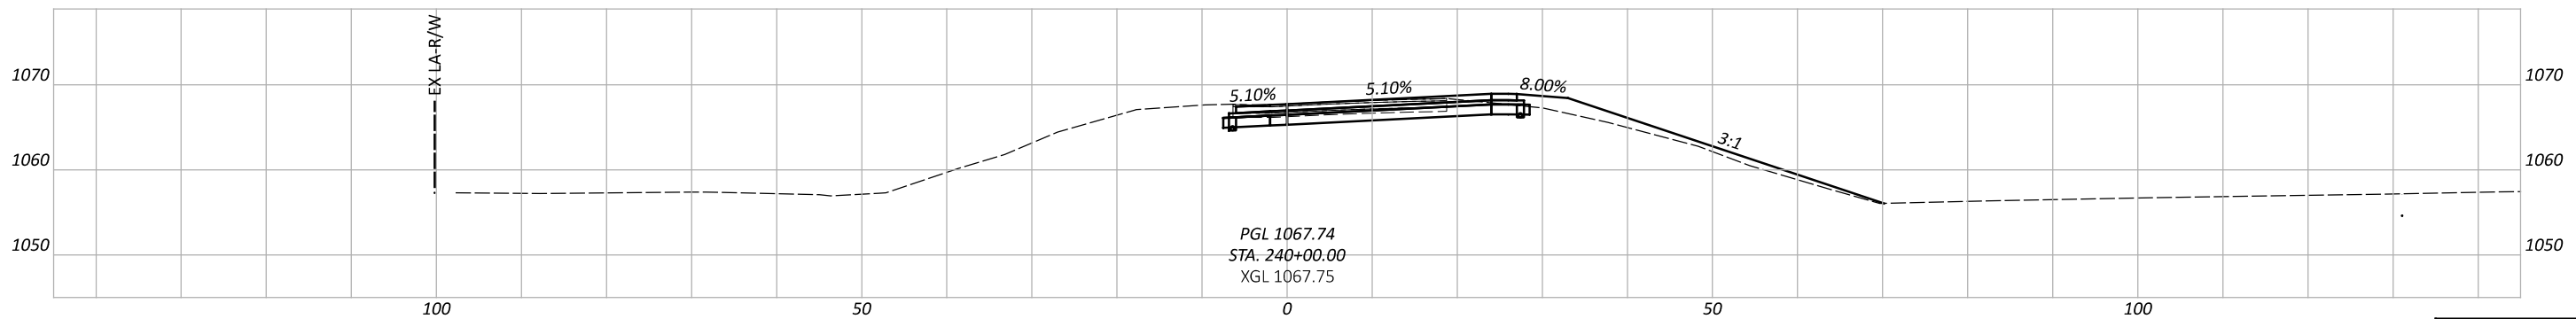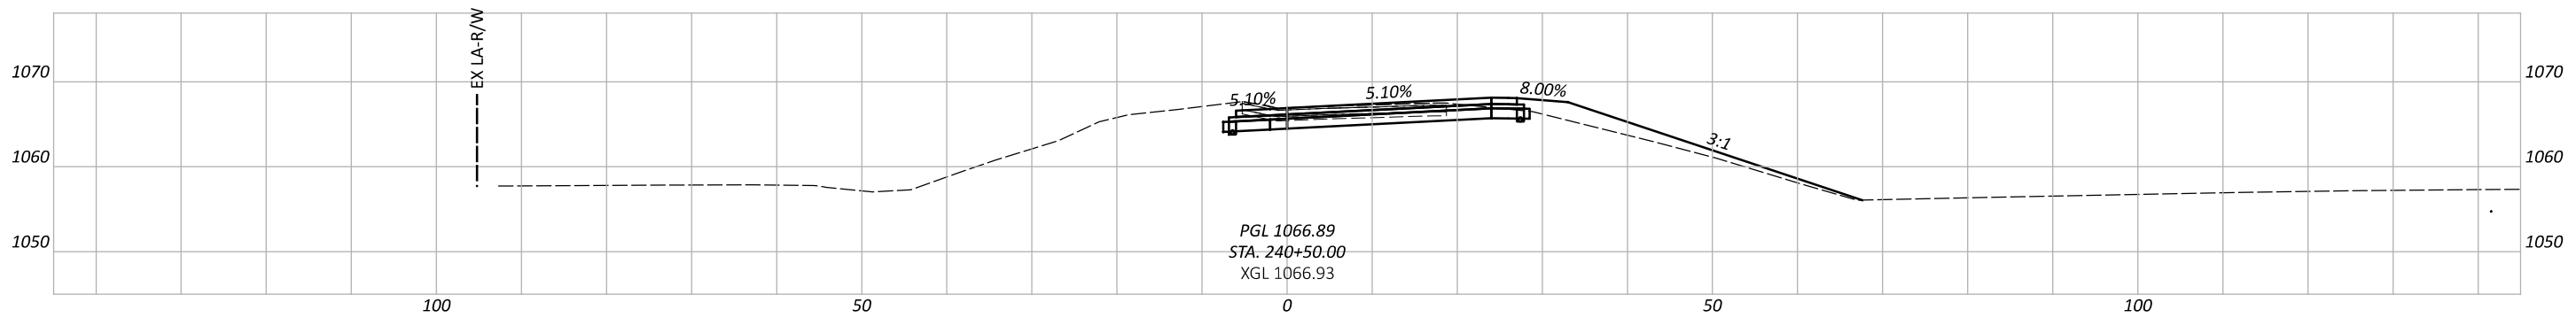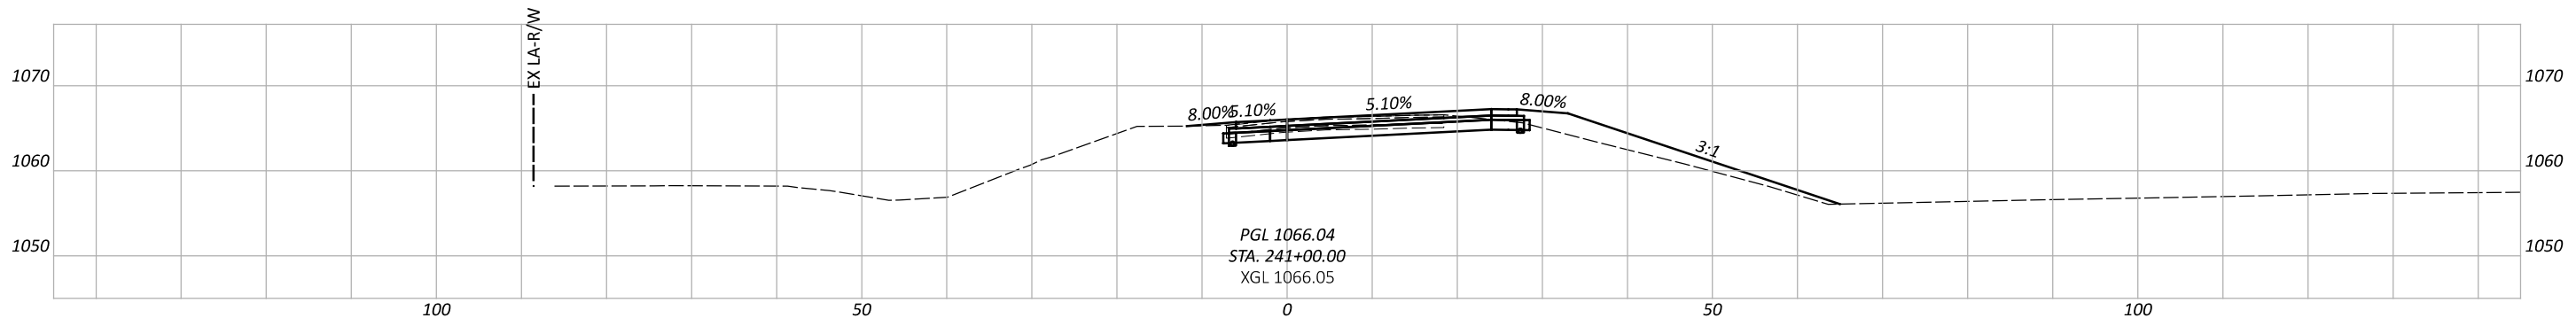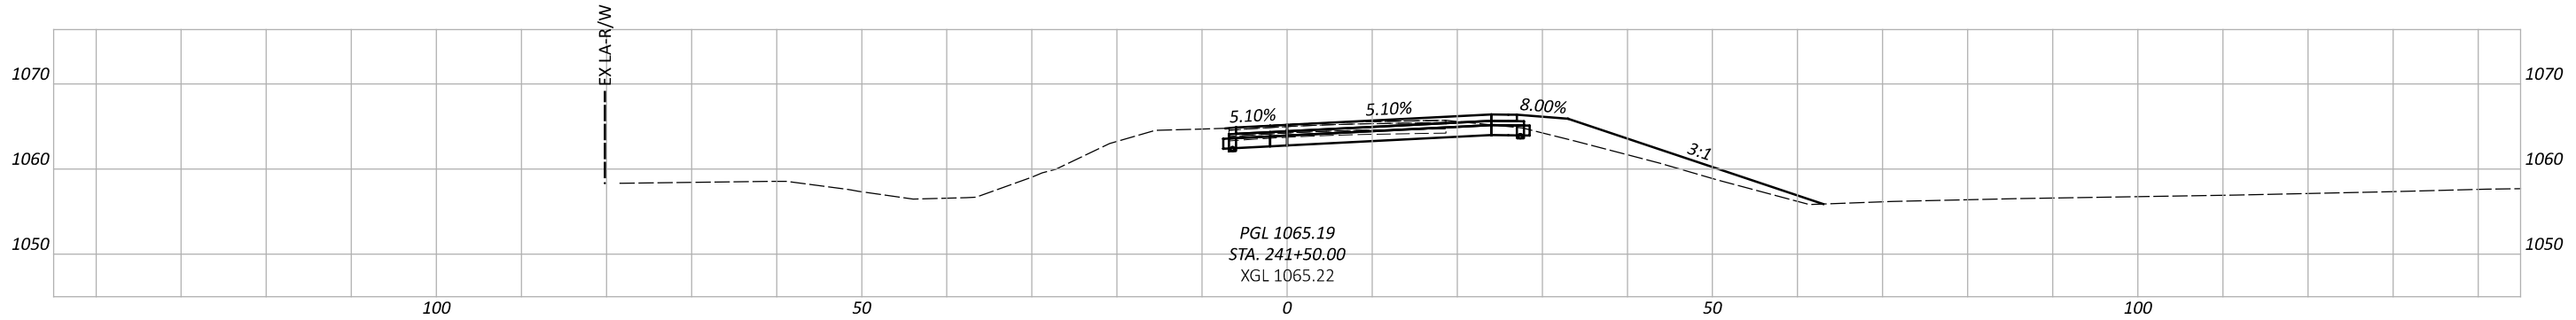Sheet Totals			TOTAL	
Seeding	Cut	Fill	SHEET	TOTAL
			P. 191	228




CROSS SECTIONS - US 35 RAMP D
 STA. 240+00 TO STA. 241+50

DESIGN AGENCY
Palmer
 ENGINEERING
 8350 E. KEMPER RD.
 SUITE B
 CINCINNATI, OH 45249
 513-469-1600

DESIGNER
 DPF
 REVIEWER
 DCJ MM-DD-YY

PROJECT ID
 117955
 SHEET TOTAL
 P. 192 228

Sheet Totals		
Seeding	Cut	Fill

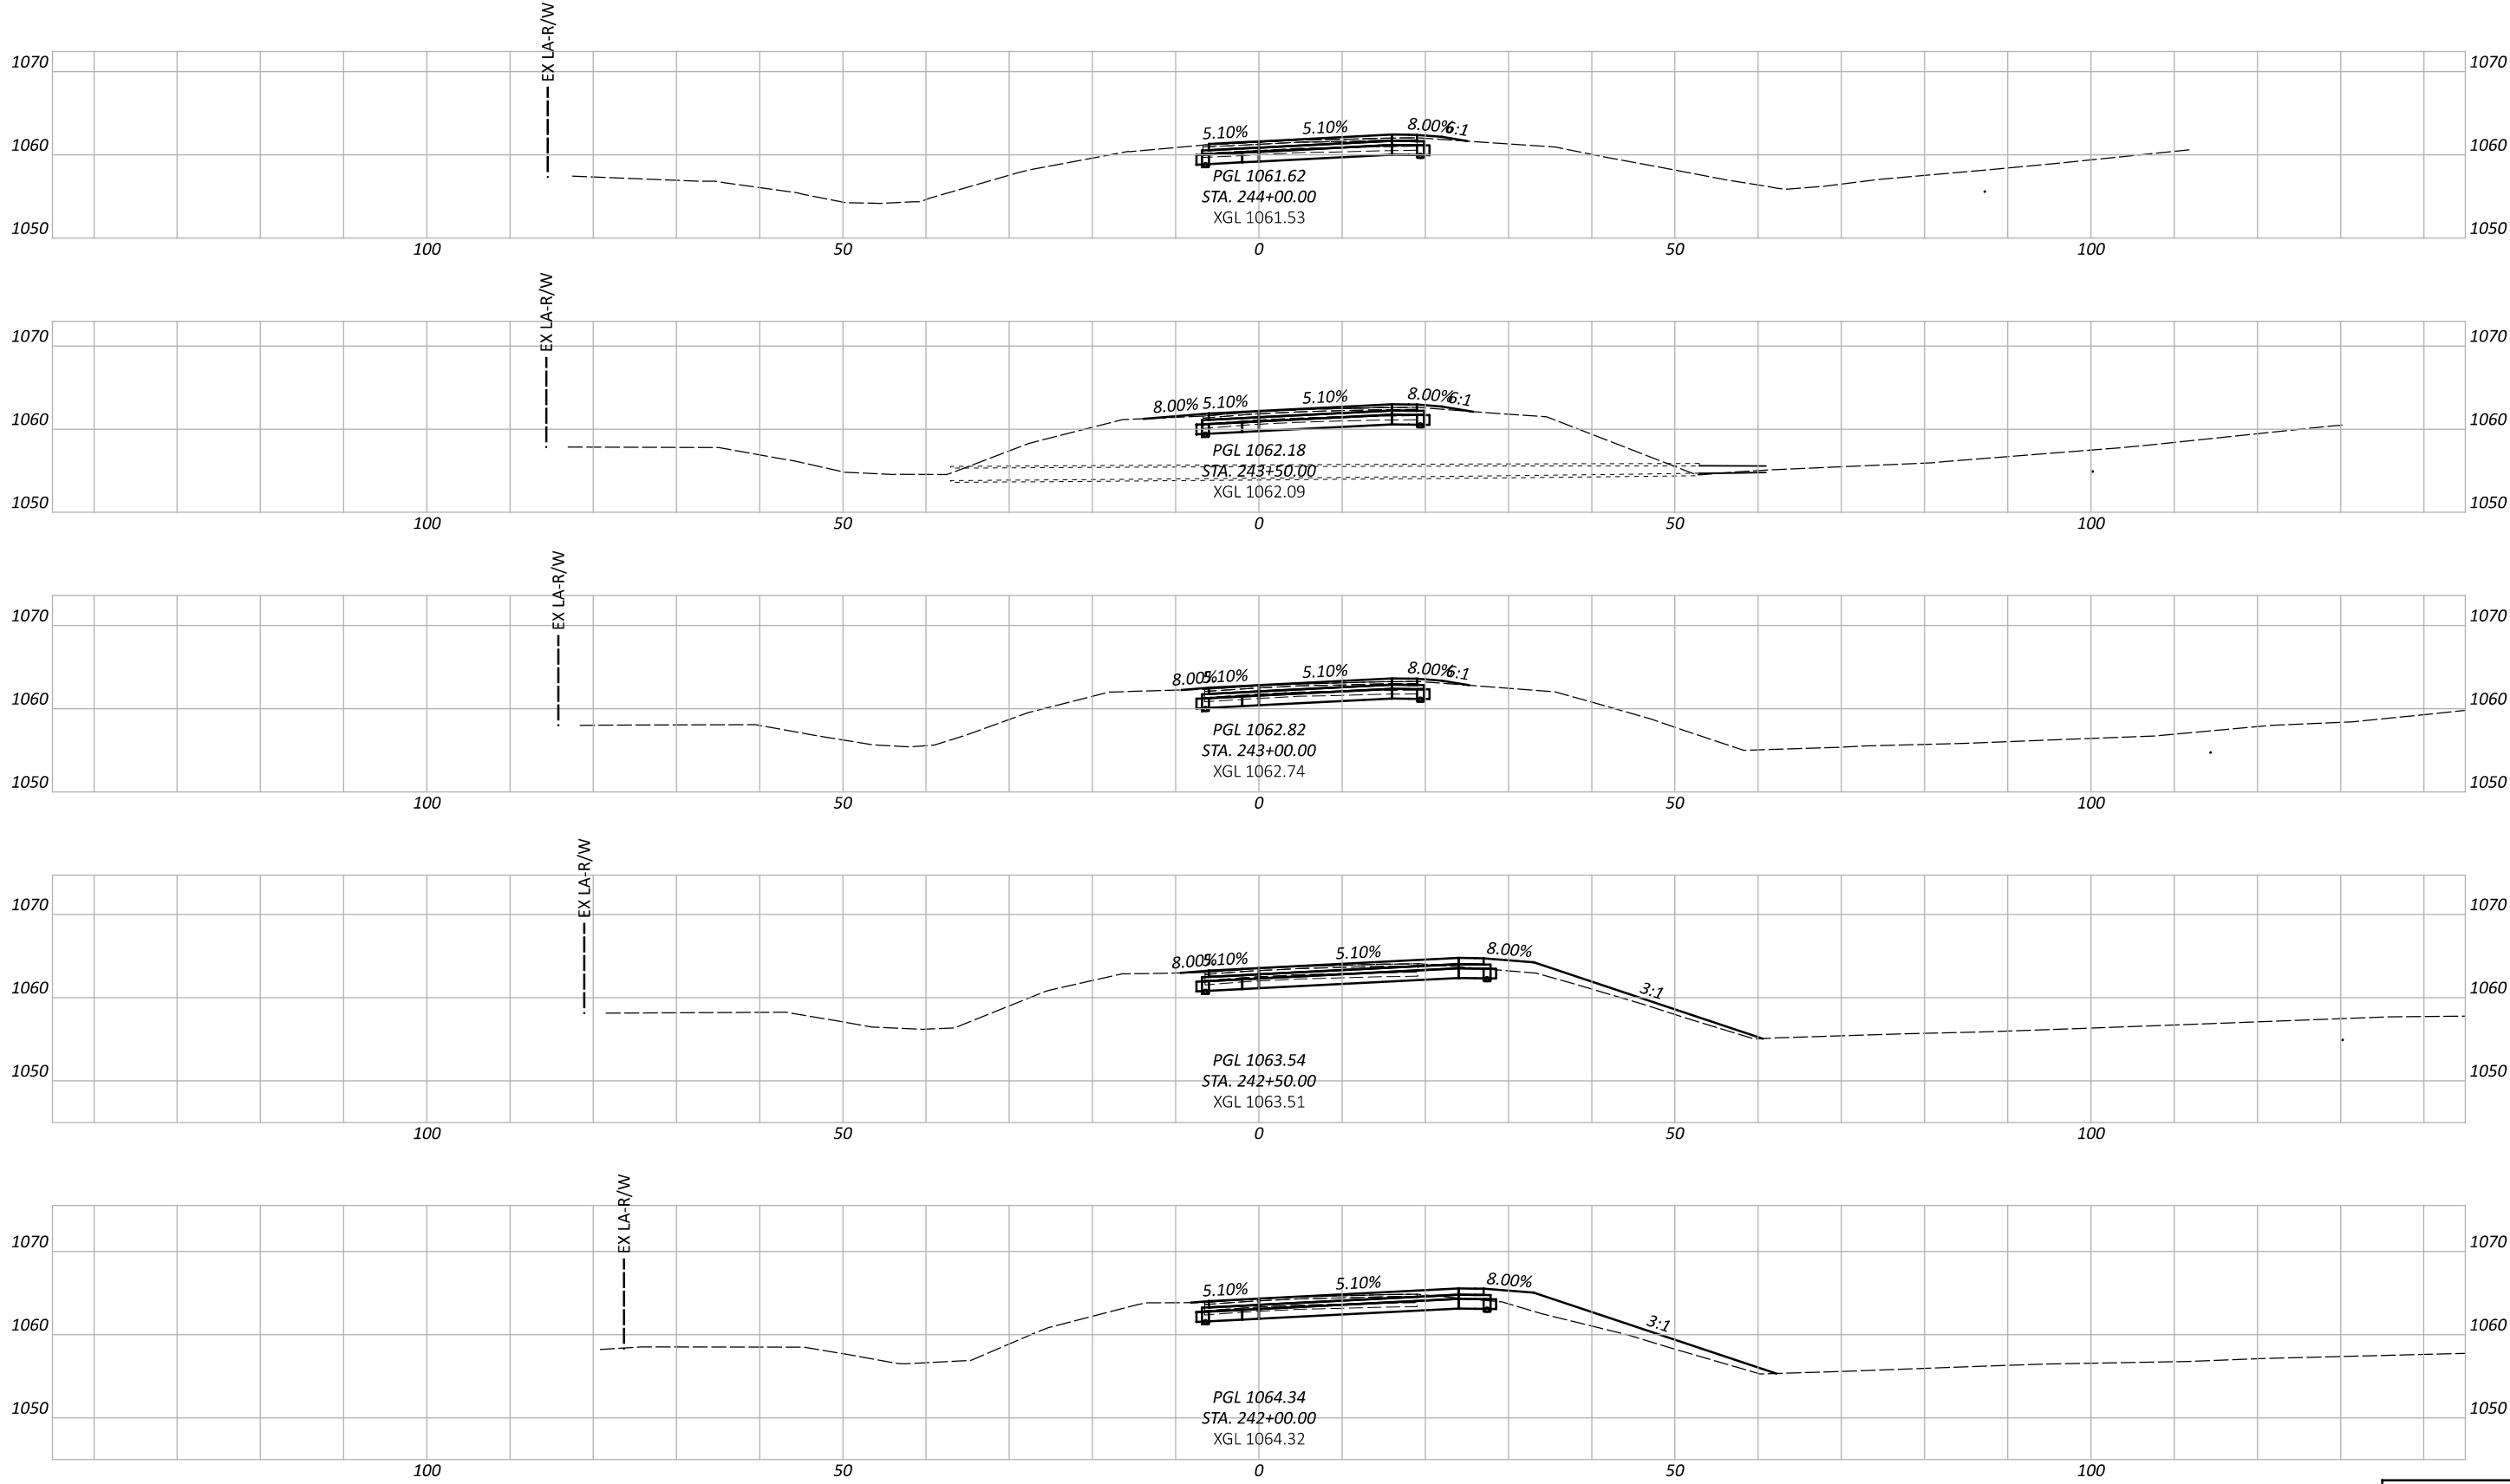

CROSS SECTIONS - US 35 RAMP D
 STA. 242+00 TO STA. 244+00

DESIGN AGENCY
Palmer
 ENGINEERING
 8350 E. KEMPER RD.
 SUITE B
 CINCINNATI, OH 45249
 513-469-1600






DESIGNER
 DPF

REVIEWER
 DCJ MM-DD-YY

PROJECT ID
 117955

Sheet Totals		
Seeding	Cut	Fill

SHEET	TOTAL
P. 193	228

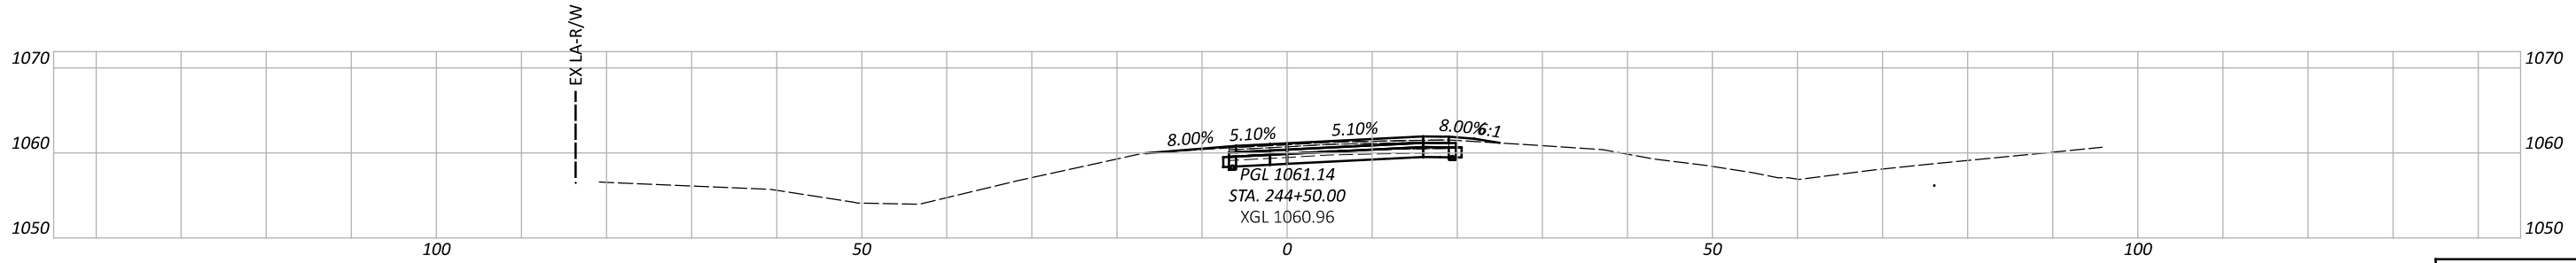
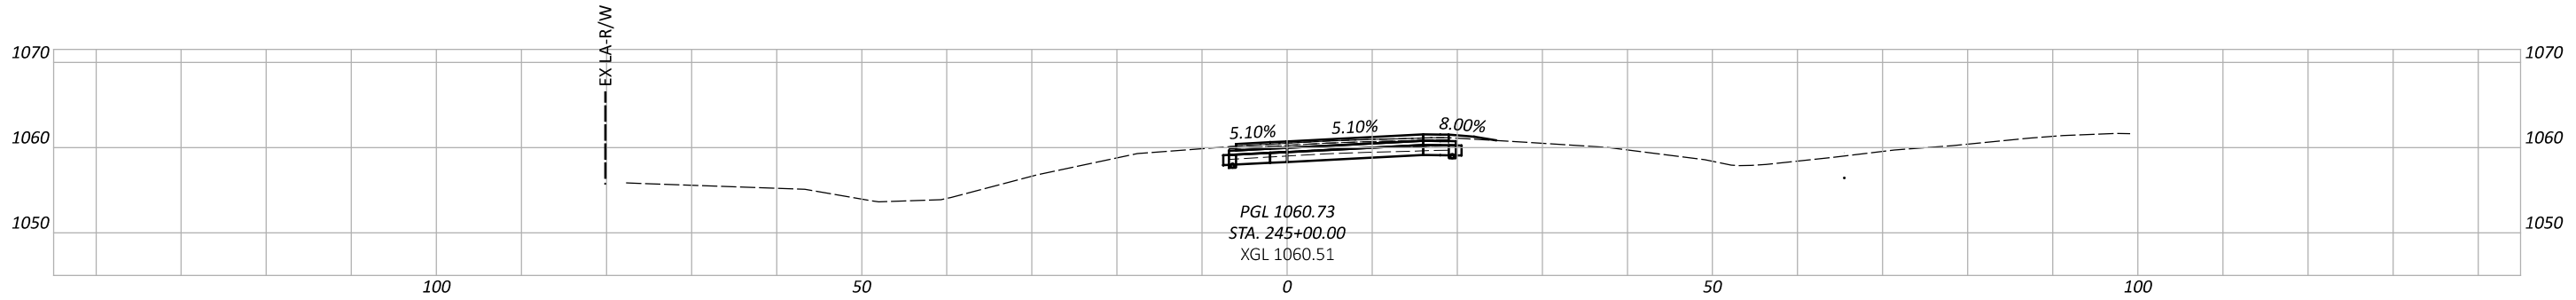
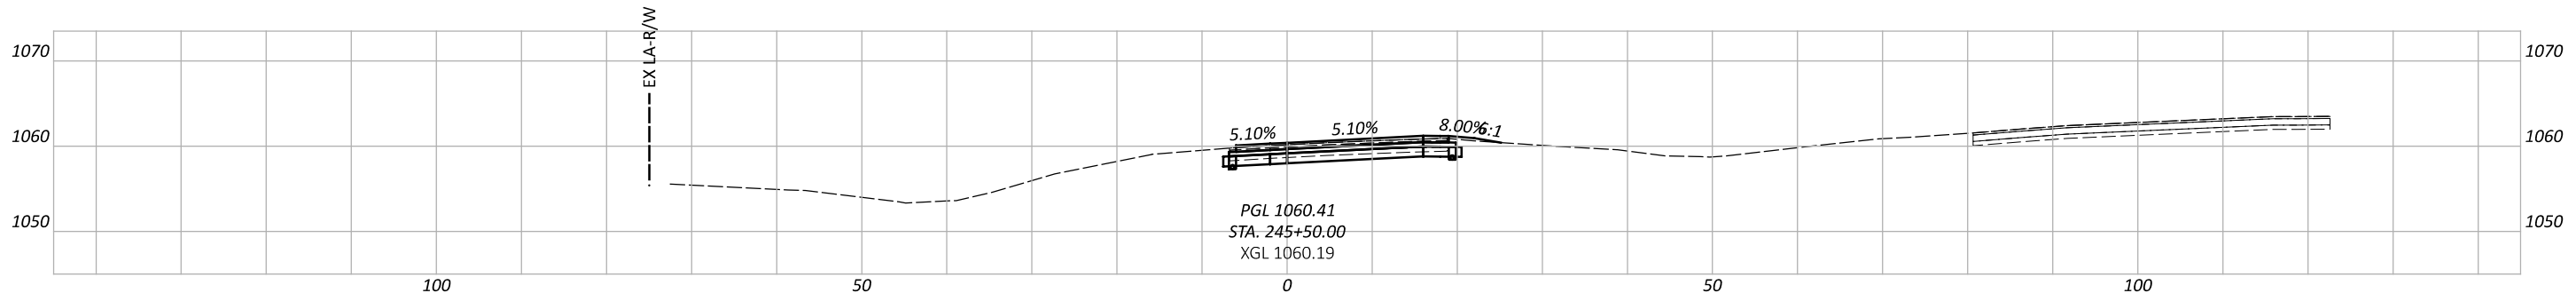
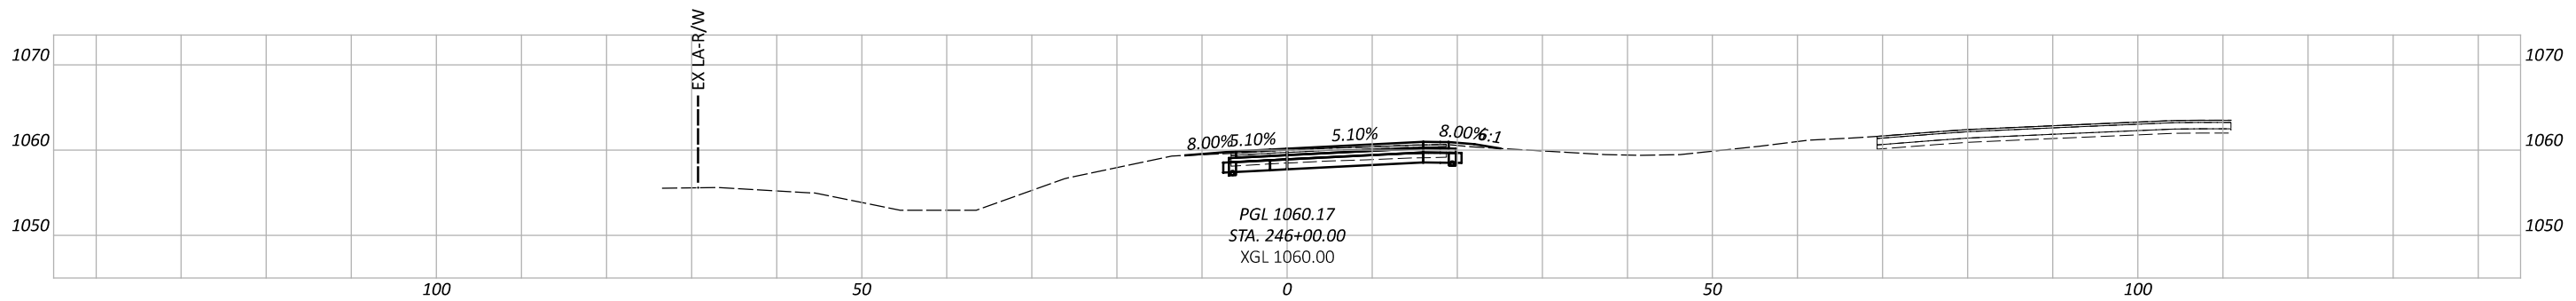
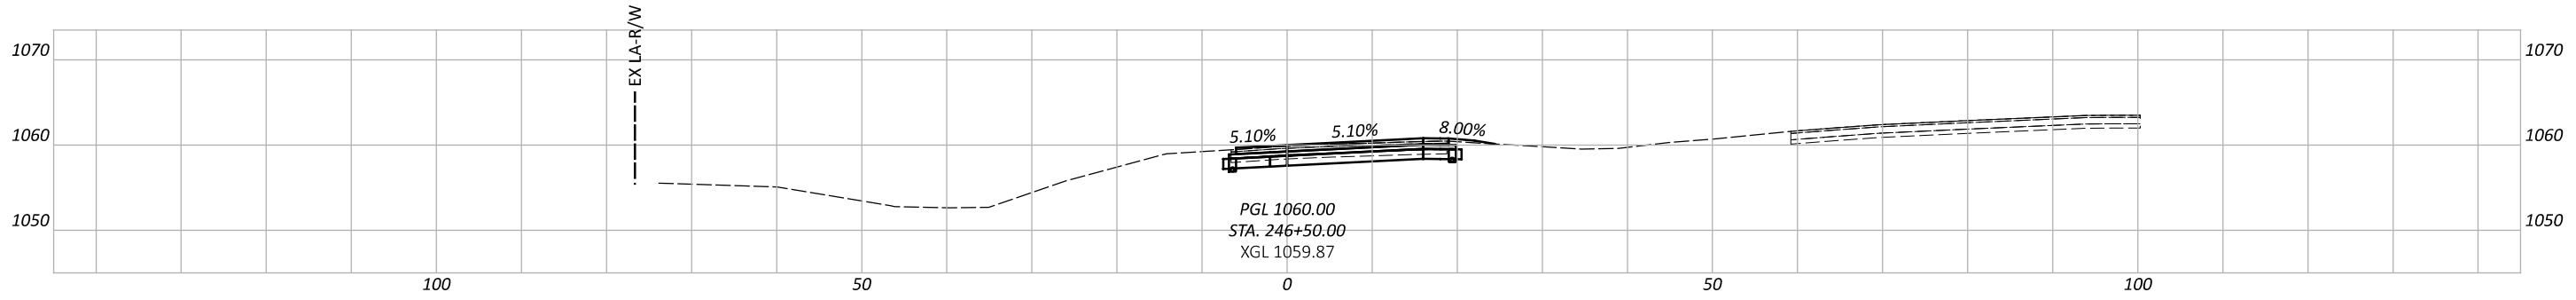


CROSS SECTIONS - US 35 RAMP D
 STA. 244+50 TO STA. 246+50

DESIGN AGENCY
Palmer
 ENGINEERING
 8350 E. KEMPER RD.
 SUITE B
 CINCINNATI, OH 45249
 513-469-1600

DESIGNER
 DPF
 REVIEWER
 DCJ MM-DD-YY
 PROJECT ID
 117955

Sheet Totals		
Seeding	Cut	Fill
SHEET	TOTAL	
P. 194	228	

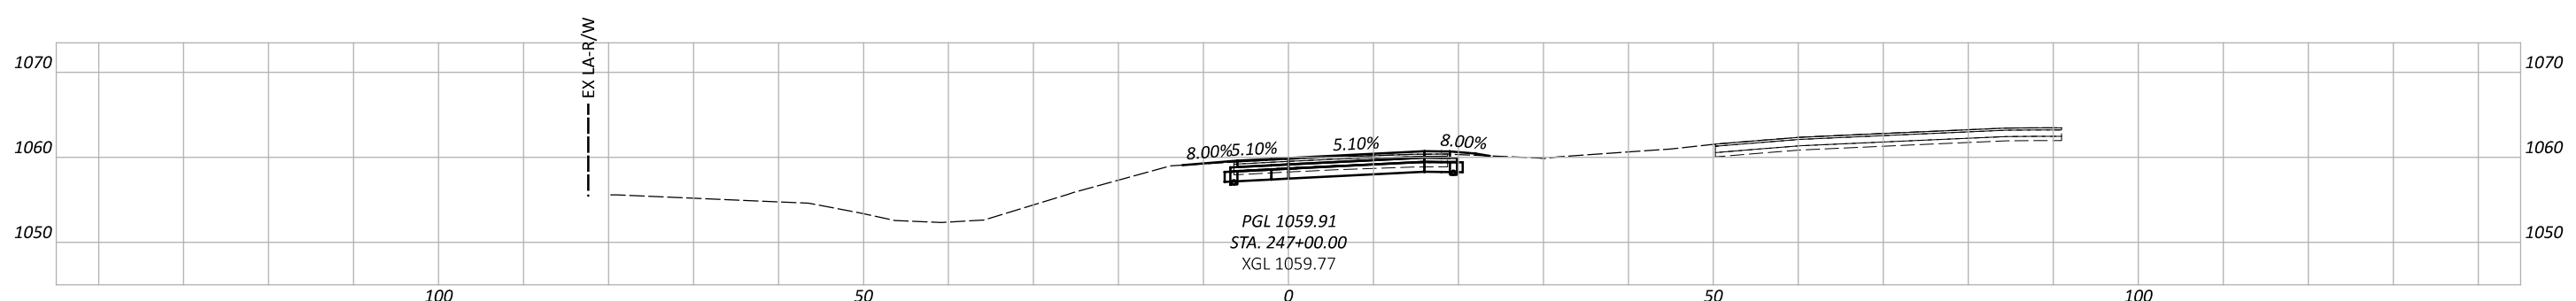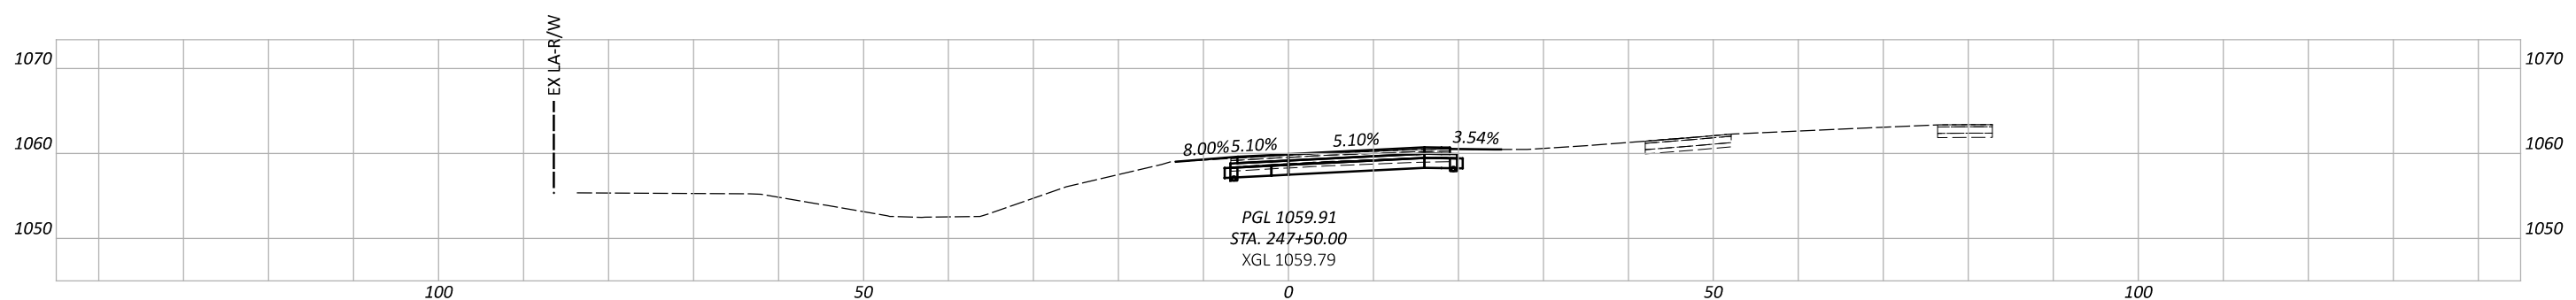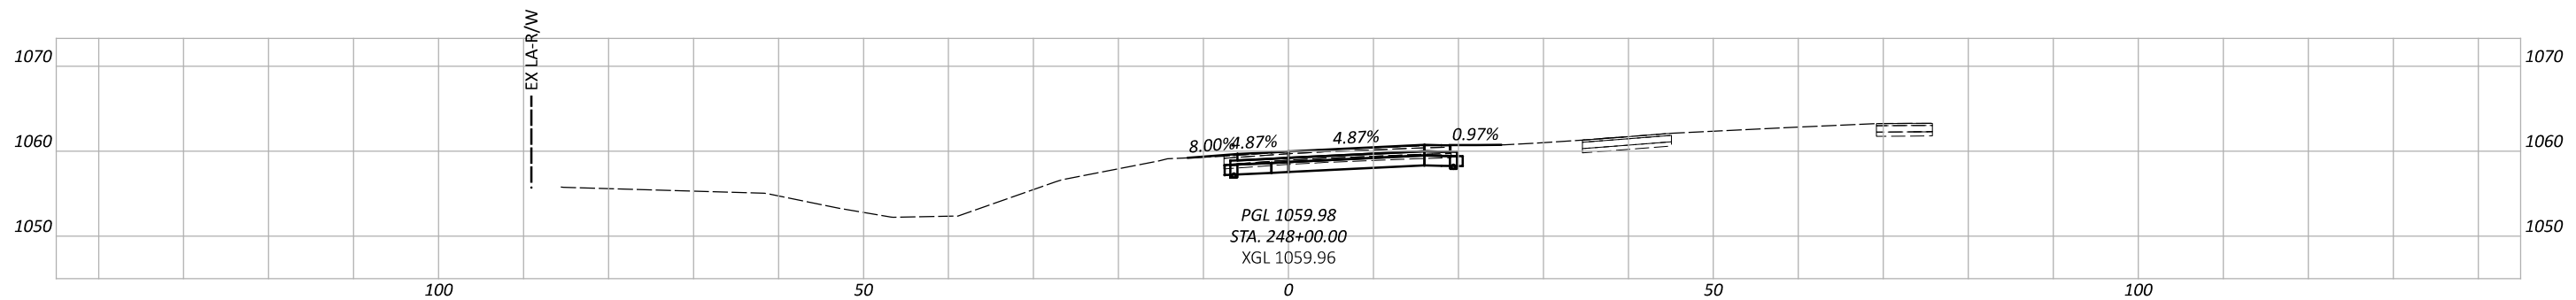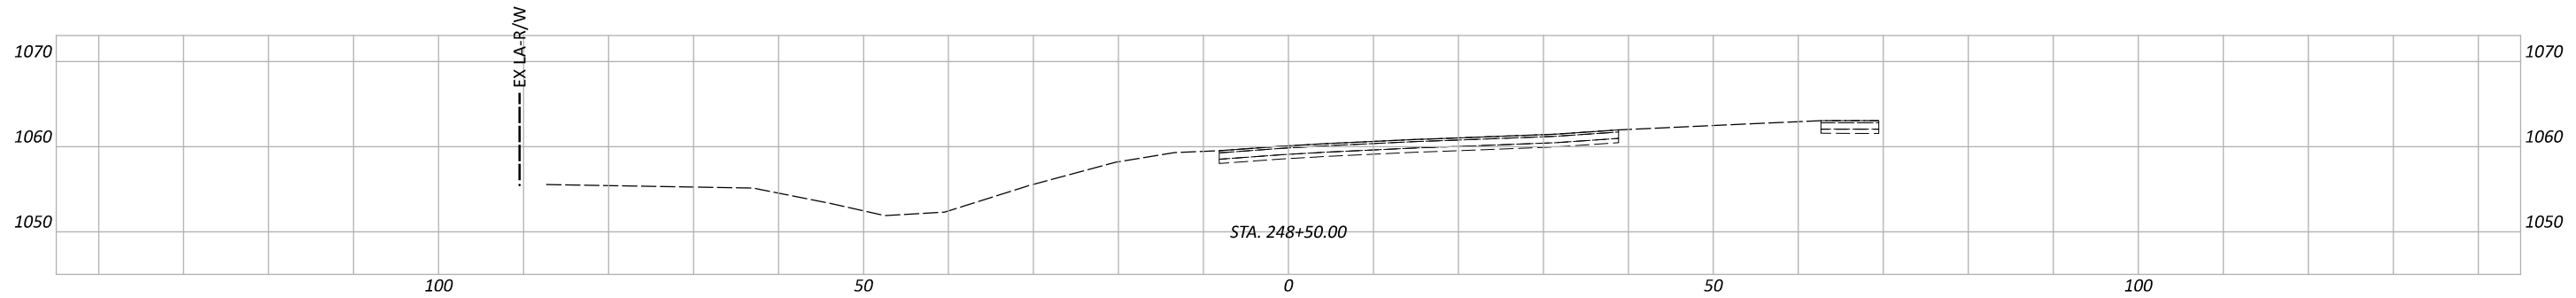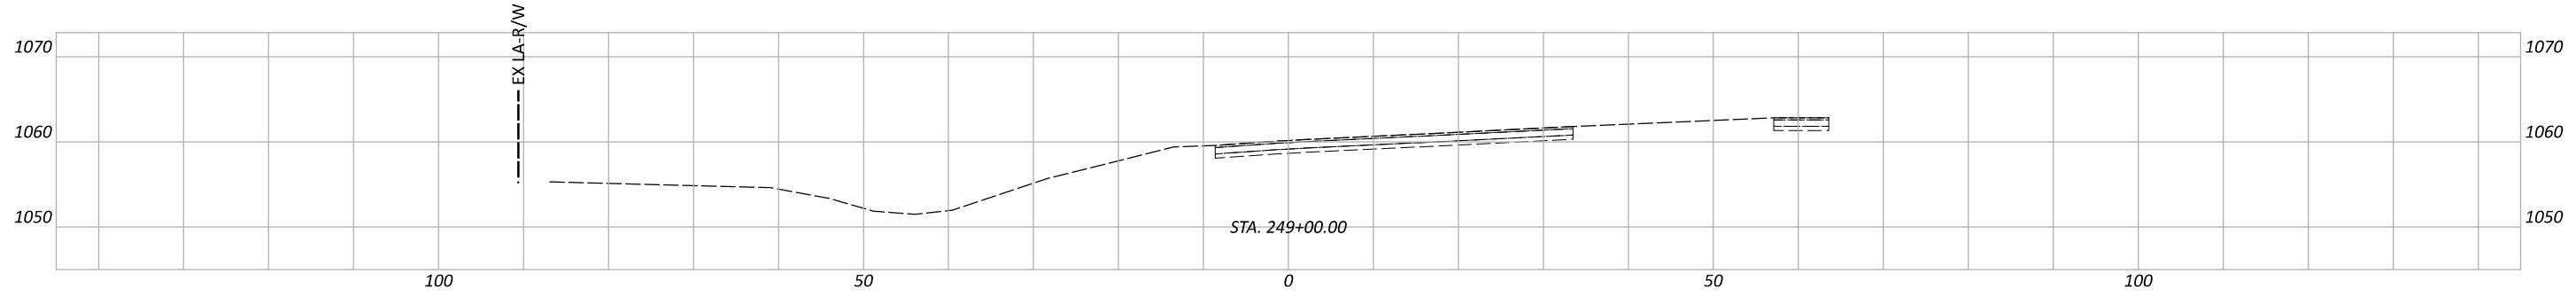

CROSS SECTIONS - US 35 RAMP D
 STA. 247+00 TO STA. 249+00

DESIGN AGENCY



DESIGNER

DPF

REVIEWER


DCJ MM-DD-YY

PROJECT ID

117955

Sheet Totals		
Seeding	Cut	Fill

SHEET	TOTAL
P. 195	228

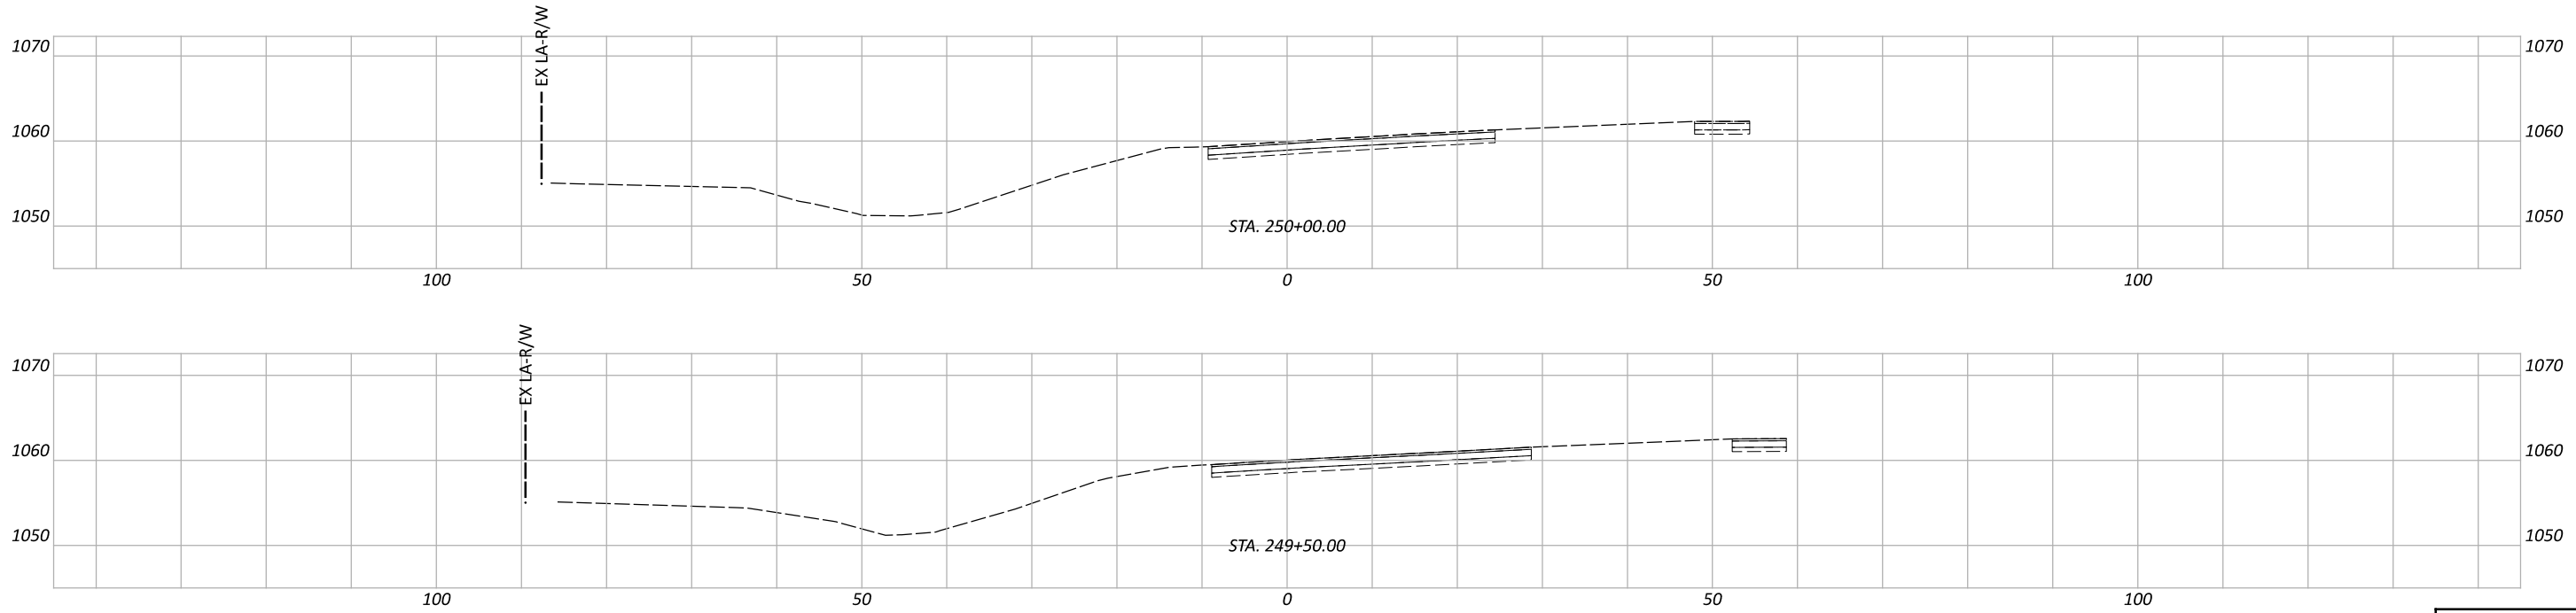

CROSS SECTIONS - US 35 RAMP D
STA. 249+50 TO STA. 250+00

DESIGN AGENCY



DESIGNER

DPF

REVIEWER

DCJ MM-DD-YY

PROJECT ID

117955

Sheet Totals			SHEET	TOTAL
Seeding	Cut	Fill	P. 196	228

SUPERELEVATION TABLE - RAMP D							REMARKS
P.I. STATION		Dc = 4^ 00' 00"					
CL CONTROL		RIGHT					
STATION	PROFILE GRADE	WIDTH	CROSS SLOPE	ELEVATION CORRECTION	TRANSITION RATE	ELEVATION	
							SEE PAV'T DETAIL
237+57.52	1071.86	24.00	0.0320	0.77		1072.63	
237+75.00	1071.56	24.00	0.0356	0.85	487:1	1072.42	
238+00.00	1071.14	24.00	0.0407	0.98	487:1	1072.12	
238+25.00	1070.71	24.00	0.0459	1.10	487:1	1071.81	
238+50.00	1070.29	24.00	0.0510	1.22	487:1	1071.51	
238+53.77	1070.23	24.00	0.0510	1.22		1071.45	
238+75.00	1069.86	24.00	0.0510	1.22		1071.09	
239+00.00	1069.44	24.00	0.0510	1.22		1070.66	
239+25.00	1069.01	24.00	0.0510	1.22		1070.24	
239+50.00	1068.59	24.00	0.0510	1.22		1069.81	
239+75.00	1068.16	24.00	0.0510	1.22		1069.39	
240+00.00	1067.74	24.00	0.0510	1.22		1068.96	
240+25.00	1067.31	24.00	0.0510	1.22		1068.54	
240+50.00	1066.89	24.00	0.0510	1.22		1068.11	
240+75.00	1066.46	24.00	0.0510	1.22		1067.69	
241+00.00	1066.04	24.00	0.0510	1.22		1067.26	
241+25.00	1065.61	24.00	0.0510	1.22		1066.84	
241+50.00	1065.19	24.00	0.0510	1.22		1066.41	
241+75.00	1064.76	24.00	0.0510	1.22		1065.99	
242+00.00	1064.34	24.00	0.0510	1.22		1065.56	
242+25.00	1063.93	24.00	0.0510	1.22		1065.16	
242+50.00	1063.54	24.00	0.0510	1.22		1064.77	
242+75.00	1063.17	20.00	0.0510	1.02		1064.19	
243+00.00	1062.82	16.00	0.0510	0.82		1063.64	
243+25.00	1062.49	16.00	0.0510	0.82		1063.31	
243+50.00	1062.18	16.00	0.0510	0.82		1063.00	
243+75.00	1061.89	16.00	0.0510	0.82		1062.71	
244+00.00	1061.62	16.00	0.0510	0.82		1062.44	
244+25.00	1061.37	16.00	0.0510	0.82		1062.19	
244+50.00	1061.14	16.00	0.0510	0.82		1061.95	
244+75.00	1060.93	16.00	0.0510	0.82		1061.74	
245+00.00	1060.73	16.00	0.0510	0.82		1061.55	
245+25.00	1060.56	16.00	0.0510	0.82		1061.38	
245+50.00	1060.41	16.00	0.0510	0.82		1061.23	
245+75.00	1060.28	16.00	0.0510	0.82		1061.09	
246+00.00	1060.17	16.00	0.0510	0.82		1060.98	
246+25.00	1060.07	16.00	0.0510	0.82		1060.89	
246+50.00	1060.00	16.00	0.0510	0.82		1060.82	
246+75.00	1059.95	16.00	0.0510	0.82		1060.76	
247+00.00	1059.91	16.00	0.0510	0.82		1060.73	
247+25.00	1059.90	16.00	0.0510	0.82		1060.72	
247+50.00	1059.91	16.00	0.0510	0.82		1060.72	
247+62.55	1059.92	16.00	0.0510	0.82		1060.74	
247+75.00	1059.93	16.00	0.0502	0.80	3273:1	1060.74	
248+00.00	1059.98	16.00	0.0487	0.78	1630:1	1060.76	
248+25.00	1060.03	16.00	0.0472	0.75	1630:1	1060.78	
248+31.00	1060.40	16.00	0.0468	0.75	1630:1	1061.15	MEET EXIST.

SUPERELEVATION TABLE
 US 35 - RAMP D

DESIGN AGENCY



DESIGNER
 DPF

REVIEWER
 DCJ MM-DD-YY

PROJECT ID
 117955

SHEET TOTAL
 P. 199 228

SUPERELEVATION TABLE - SR 435 (WEST)												
P.I. STATION 103+86.66						Dc = 7^ 45' 00"						
LEFT					CL CONTROL		RIGHT					REMARKS
ELEVATION	TRANSITION RATE	ELEVATION CORRECTION	CROSS SLOPE	WIDTH	STATION	PROFILE GRADE	WIDTH	CROSS SLOPE	ELEVATION CORRECTION	TRANSITION RATE	ELEVATION	
1056.24		-0.38	-0.0160	24.00	96+90.39	1056.62	24.00	-0.0160	-0.38		1056.24	NORMAL CROWN
1056.15		-0.38	-0.0160	24.00	97+00.00	1056.53	24.00	-0.0142	-0.34	533:1	1056.19	
1055.93		-0.38	-0.0160	24.00	97+25.00	1056.31	24.00	-0.0095	-0.23	533:1	1056.08	
1055.71		-0.38	-0.0160	24.00	97+50.00	1056.09	24.00	-0.0048	-0.12	533:1	1055.97	
1055.48		-0.38	-0.0160	24.00	97+75.00	1055.86	24.00	-0.0001	0.00	533:1	1055.86	
1055.48		-0.38	-0.0160	24.00	97+75.72	1055.86	24.00	0.0000	0.00	533:1	1055.86	1/2 FLAT
1055.26		-0.38	-0.0160	24.00	98+00.00	1055.64	24.00	0.0046	0.11	533:1	1055.75	
1055.04		-0.38	-0.0160	24.00	98+25.00	1055.42	24.00	0.0092	0.22	533:1	1055.64	
1054.82		-0.38	-0.0160	24.00	98+50.00	1055.20	24.00	0.0139	0.33	533:1	1055.53	
1054.72		-0.38	-0.0160	24.00	98+61.05	1055.10	24.00	0.0160	0.38	533:1	1055.48	R.C.
1054.53	534:1	-0.45	-0.0186	24.00	98+75.00	1054.98	24.00	0.0186	0.45	534:1	1055.43	
1054.19	534:1	-0.56	-0.0233	24.00	99+00.00	1054.75	24.00	0.0233	0.56	534:1	1055.31	
1053.86	534:1	-0.67	-0.0280	24.00	99+25.00	1054.53	24.00	0.0280	0.67	534:1	1055.20	
1053.53	534:1	-0.78	-0.0327	24.00	99+50.00	1054.31	24.00	0.0327	0.78	534:1	1055.09	
1053.19	534:1	-0.90	-0.0374	24.00	99+75.00	1054.09	24.00	0.0374	0.90	534:1	1054.99	
1052.85	534:1	-1.01	-0.0420	24.00	100+00.00	1053.86	24.00	0.0420	1.01	534:1	1054.87	
1052.50	534:1	-1.12	-0.0467	24.00	100+25.00	1053.62	24.00	0.0467	1.12	534:1	1054.74	
1052.15	534:1	-1.23	-0.0514	24.01	100+50.00	1053.38	24.00	0.0514	1.23	534:1	1054.61	
1051.98	534:1	-1.29	-0.0536	24.01	100+61.59	1053.27	24.00	0.0536	1.29	534:1	1054.56	P.C.
1051.79	534:1	-1.35	-0.0561	24.01	100+75.00	1053.14	24.00	0.0561	1.35	534:1	1054.49	
1051.37	534:1	-1.52	-0.0608	25.00	101+00.00	1052.89	25.03	0.0608	1.52	534:1	1054.41	
1050.96	534:1	-1.67	-0.0655	25.54	101+25.00	1052.63	26.82	0.0655	1.76	534:1	1054.39	
1050.54	534:1	-1.83	-0.0701	26.08	101+50.00	1052.37	29.48	0.0701	2.07	534:1	1054.44	
1050.12	534:1	-1.99	-0.0748	26.63	101+75.00	1052.11	32.30	0.0748	2.42	534:1	1054.53	
1049.80	534:1	-2.11	-0.0782	27.02	101+93.02	1051.91	34.10	0.0782	2.67	534:1	1054.58	FULL S.E. BEGIN RAB APPROACHES

SUPERELEVATION TABLE - SR 435 (EAST)												
P.I. STATION 111+39.51						Dc = 3^ 30' 00"						
LEFT					CL CONTROL		RIGHT					REMARKS
ELEVATION	TRANSITION RATE	ELEVATION CORRECTION	CROSS SLOPE	WIDTH	STATION	PROFILE GRADE	WIDTH	CROSS SLOPE	ELEVATION CORRECTION	TRANSITION RATE	ELEVATION	
1050.83		-1.63	-0.0740	22.04	112+12.62	1052.47	12.00	0.0740	0.89		1053.35	FULL S.E.
1050.90		-1.56	-0.0740	21.09	112+25.00	1052.47	12.00	0.0740	0.89		1053.35	
1051.14		-1.43	-0.0740	19.33	112+50.00	1052.57	12.00	0.0740	0.89		1053.46	
1051.25		-1.31	-0.0740	17.75	112+75.00	1052.56	12.00	0.0740	0.89		1053.45	
1051.23		-1.21	-0.0740	16.36	113+00.00	1052.44	12.00	0.0740	0.89		1053.33	
1051.17		-1.12	-0.0740	15.17	113+25.00	1052.30	12.00	0.0740	0.89		1053.18	
1051.11		-1.05	-0.0740	14.16	113+50.00	1052.15	12.00	0.0740	0.89		1053.04	
1051.02		-0.99	-0.0740	13.34	113+75.00	1052.01	12.00	0.0740	0.89		1052.90	
1050.93		-0.94	-0.0740	12.72	114+00.00	1051.87	12.00	0.0740	0.89		1052.76	
1050.86		-0.92	-0.0740	12.43	114+15.10	1051.78	12.00	0.0740	0.89		1052.67	BEGIN S.E. TRANSITION
1050.86	267:1	-0.86	-0.0703	12.29	114+25.00	1051.72	12.00	0.0703	0.84	267:1	1052.57	
1050.83	267:1	-0.73	-0.0609	12.04	114+50.00	1051.56	12.00	0.0609	0.73	267:1	1052.29	
1050.73	267:1	-0.62	-0.0515	12.00	114+75.00	1051.35	12.00	0.0515	0.62	267:1	1051.97	
1050.70	267:1	-0.59	-0.0496	12.00	114+80.22	1051.29	12.00	0.0496	0.59	267:1	1051.89	P.T.
1050.57	267:1	-0.51	-0.0422	12.00	115+00.00	1051.07	12.00	0.0422	0.51	267:1	1051.58	
1050.35	267:1	-0.39	-0.0328	12.00	115+25.00	1050.74	12.00	0.0328	0.39	267:1	1051.14	
1050.09	267:1	-0.28	-0.0234	12.00	115+50.00	1050.37	12.00	0.0234	0.28	267:1	1050.65	
1049.91	267:1	-0.19	-0.0160	12.00	115+69.76	1050.10	12.00	0.0160	0.19	267:1	1050.29	R.C.
1049.84		-0.19	-0.0160	12.00	115+75.00	1050.03	12.00	0.0140	0.17	267:1	1050.20	
1049.56		-0.19	-0.0160	12.00	116+00.00	1049.75	12.00	0.0047	0.06	267:1	1049.80	
1049.44		-0.19	-0.0160	12.00	116+12.43	1049.63	12.00	0.0000	0.00	267:1	1049.63	1/2 FLAT
1049.33		-0.19	-0.0160	12.00	116+25.00	1049.52	12.00	-0.0047	-0.06	267:1	1049.46	
1049.16		-0.19	-0.0160	12.00	116+50.00	1049.35	12.00	-0.0141	-0.17	267:1	1049.18	
1049.13		-0.19	-0.0160	12.00	116+55.09	1049.32	12.00	-0.0160	-0.19	267:1	1049.13	NORMAL CROWN

SUPERELEVATION TABLE
SR 435 ROUNDABOUT APPROACHES

DESIGN AGENCY



DESIGNER
DPF

REVIEWER
DCJ MM-DD-YY

PROJECT ID
117955

SHEET TOTAL
P. 197 228

SUPERELEVATION TABLE - BLUEGRASS BLVD.												
P.I. STATION 186+20.39/190+14.58						Dc = 6^ 00' 00"/2^ 06' 02"						
LEFT					CL CONTROL		RIGHT					REMARKS
ELEVATION	TRANSITION RATE	ELEVATION CORRECTION	CROSS SLOPE	WIDTH	STATION	PROFILE GRADE	WIDTH	CROSS SLOPE	ELEVATION CORRECTION	TRANSITION RATE	ELEVATION	
1053.58		2.67	-0.0700	-38.08	187+25.56	1050.91	30.00	0.0700	2.10		1053.01	FULL S.E.
1053.53		2.59	-0.0700	-37.03	187+50.00	1050.94	30.00	0.0700	2.10		1053.04	
1053.48		2.54	-0.0700	-36.35	187+65.74	1050.93	30.00	0.0700	2.10		1053.03	BEGIN S.E. TRANS.
1053.39	650:1	2.46	-0.0686	-35.94	187+75.00	1050.93	30.00	0.0686	2.06	650:1	1052.98	
1053.16	650:1	2.25	-0.0647	-34.82	188+00.00	1050.90	30.00	0.0647	1.94		1052.85	
1052.93	650:1	2.05	-0.0609	-33.67	188+25.00	1050.88	30.00	0.0609	1.83	650:1	1052.71	
1052.71	650:1	1.85	-0.0570	-32.51	188+50.00	1050.86	30.00	0.0570	1.71	650:1	1052.57	
1052.49	650:1	1.67	-0.0533	-31.34	188+74.52	1050.82	30.00	0.0533	1.60	650:1	1052.42	P.C.C.
1052.48	280:1	1.66	-0.0531	-31.32	188+75.00	1050.82	30.00	0.0531	1.59	280:1	1052.41	
1052.12	280:1	1.34	-0.0442	-30.38	189+00.00	1050.77	30.00	0.0442	1.33	280:1	1052.10	
1051.78	280:1	1.06	-0.0353	-30.01	189+25.00	1050.72	30.00	0.0353	1.06	280:1	1051.78	
1051.55	280:1	0.87	-0.0290	-30.00	189+42.52	1050.68	30.00	0.0290	0.87	280:1	1051.55	FULL S.E. (CURVE 2)
1051.53		0.87	-0.0290	-30.00	189+50.00	1050.66	30.00	0.0290	0.87		1051.53	
1051.47		0.87	-0.0290	-30.00	189+75.00	1050.60	30.00	0.0290	0.87		1051.47	
1051.41		0.87	-0.0290	-30.00	190+00.00	1050.54	30.00	0.0290	0.87		1051.41	
1051.35		0.87	-0.0290	-30.00	190+25.00	1050.48	30.00	0.0290	0.87		1051.35	
1051.30		0.87	-0.0290	-30.00	190+50.00	1050.43	30.00	0.0290	0.87		1051.30	
1051.24		0.87	-0.0290	-30.00	190+75.00	1050.37	30.00	0.0290	0.87		1051.24	
1051.18		0.87	-0.0290	-30.00	191+00.00	1050.31	30.00	0.0290	0.87		1051.18	
1050.98		0.73	-0.0290	-25.11	191+25.00	1050.25	30.00	0.0290	0.87		1051.12	
1050.94		0.70	-0.0290	-24.12	191+29.09	1050.24	30.00	0.0290	0.87		1051.11	FULL S.E. (CURVE 2)
1050.59	267:1	0.40	-0.0212	-19.11	191+50.00	1050.19	30.00	0.0212	0.63	267:1	1050.82	
1050.53	267:1	0.35	-0.0194	-18.00	191+54.60	1050.18	30.00	0.0194	0.58	267:1	1050.76	P.T.
1050.44	267:1	0.29	-0.0160	-17.84	191+63.76	1050.16	29.83	0.0160	0.48	267:1	1050.63	R.C.
1050.41		0.28	-0.0160	-17.65	191+75.00	1050.13	29.63	0.0118	0.35	267:1	1050.48	
1050.35		0.28	-0.0160	-17.21	192+00.00	1050.07	29.18	0.0024	0.07	267:1	1050.14	
1050.33		0.27	-0.0160	-17.10	192+06.42	1050.06	29.06	0.0000	0.00	267:1	1050.06	1/2 FLAT
1050.28		0.27	-0.0160	-16.78	192+25.00	1050.01	28.72	-0.0070	-0.20	267:1	1049.81	
1050.22		0.26	-0.0160	-16.36	192+49.09	1049.96	28.28	-0.0160	-0.45	267:1	1049.50	NORMAL CROWN

SUPERELEVATION TABLE - SR 729												
P.I. STATION 178+44.49						Dc = 7^ 00' 00"						
LEFT					CL CONTROL		RIGHT					REMARKS
ELEVATION	TRANSITION RATE	ELEVATION CORRECTION	CROSS SLOPE	WIDTH	STATION	PROFILE GRADE	WIDTH	CROSS SLOPE	ELEVATION CORRECTION	TRANSITION RATE	ELEVATION	
1059.67		-0.12	-0.0115	10.20	174+90.00	1059.79	10.30	-0.0199	-0.20		1059.59	MEET EXIST
1059.64	222:1	-0.12	-0.0121	10.19	174+91.44	1059.76	10.34	-0.0193	-0.20	222:1	1059.56	BEGIN S.E. TRANS
1059.40		-0.16	-0.0160	10.31	175+00.00	1059.57	10.45	-0.0154	-0.16	222:1	1059.41	
1058.85		-0.17	-0.0160	10.68	175+25.00	1059.02	10.79	-0.0041	-0.04	222:1	1058.98	
1058.66		-0.17	-0.0160	10.81	175+34.11	1058.84	10.91	0.0000	0.00		1058.84	1/2 FLAT
1058.34		-0.18	-0.0160	11.05	175+50.00	1058.52	11.12	0.0060	0.07	267:1	1058.59	
1057.88		-0.18	-0.0160	11.41	175+75.00	1058.06	11.46	0.0153	0.18	267:1	1058.24	
1057.85		-0.18	-0.0160	11.44	175+76.78	1058.03	11.49	0.0160	0.18	267:1	1058.21	
1057.36	267:1	-0.29	-0.0247	11.78	176+00.00	1057.65	11.80	0.0247	0.29	267:1	1057.94	
1056.87	267:1	-0.41	-0.0341	12.00	176+25.00	1057.28	12.00	0.0341	0.41	267:1	1057.69	
1056.44	267:1	-0.52	-0.0435	12.00	176+50.00	1056.96	12.00	0.0435	0.52	267:1	1057.48	
1056.05	267:1	-0.63	-0.0528	12.00	176+75.00	1056.68	12.00	0.0528	0.63	267:1	1057.32	
1056.02	267:1	-0.64	-0.0536	12.00	176+77.04	1056.66	12.00	0.0536	0.64	267:1	1057.31	P.C.
1055.71	267:1	-0.75	-0.0622	12.00	177+00.00	1056.45	12.33	0.0622	0.77	267:1	1057.22	
1055.41	267:1	-0.86	-0.0716	12.00	177+25.00	1056.27	13.43	0.0716	0.96	267:1	1057.23	
1055.18		-0.96	-0.0800	12.00	177+47.44	1056.14	15.08	0.0800	1.21	267:1	1057.34	
1055.16		-0.96	-0.0800	12.00	177+50.00	1056.12	15.30	0.0800	1.22		1057.34	
1054.99		-0.96	-0.0800	12.00	177+75.00	1055.95	17.37	0.0800	1.39		1057.34	
1054.78		-0.96	-0.0800	12.00	178+00.00	1055.74	19.33	0.0800	1.55		1057.28	
1054.52		-0.96	-0.0800	12.00	178+25.00	1055.48	21.18	0.0800	1.69		1057.18	
1054.23		-0.96	-0.0800	12.00	178+50.00	1055.19	22.90	0.0800	1.83		1057.02	
1053.90		-0.96	-0.0800	12.00	178+75.00	1054.86	24.50	0.0800	1.96		1056.82	
1053.53		-0.96	-0.0800	12.00	179+00.00	1054.49	25.98	0.0800	2.08		1056.56	
1053.11		-0.96	-0.0800	12.00	179+25.00	1054.07	27.34	0.0800	2.19		1056.26	
1052.88		-0.96	-0.0800	12.00	179+37.93	1053.84	27.99	0.0800	2.24		1056.08	
1052.71	267:1	-0.91	-0.0755	12.00	179+50.00	1053.62	28.56	0.0755	2.16	267:1	1055.77	
1052.33	267:1	-0.79	-0.0661	12.00	179+75.00	1053.13	29.66	0.0661	1.96	267:1	1055.09	
1052.19	267:1	-0.76	-0.0629	12.00	179+83.54	1052.95	30.00	0.0629	1.89	267:1	1054.84	
												P.T. 180+08.33

SUPERELEVATION TABLE
SR 729/BUEGRASS ROUNDABOUT APPROACHES

DESIGN AGENCY





DESIGNER
DPF

REVIEWER
DCJ MM-DD-YY



PROJECT ID
117955

SHEET TOTAL
P. 198 | 228

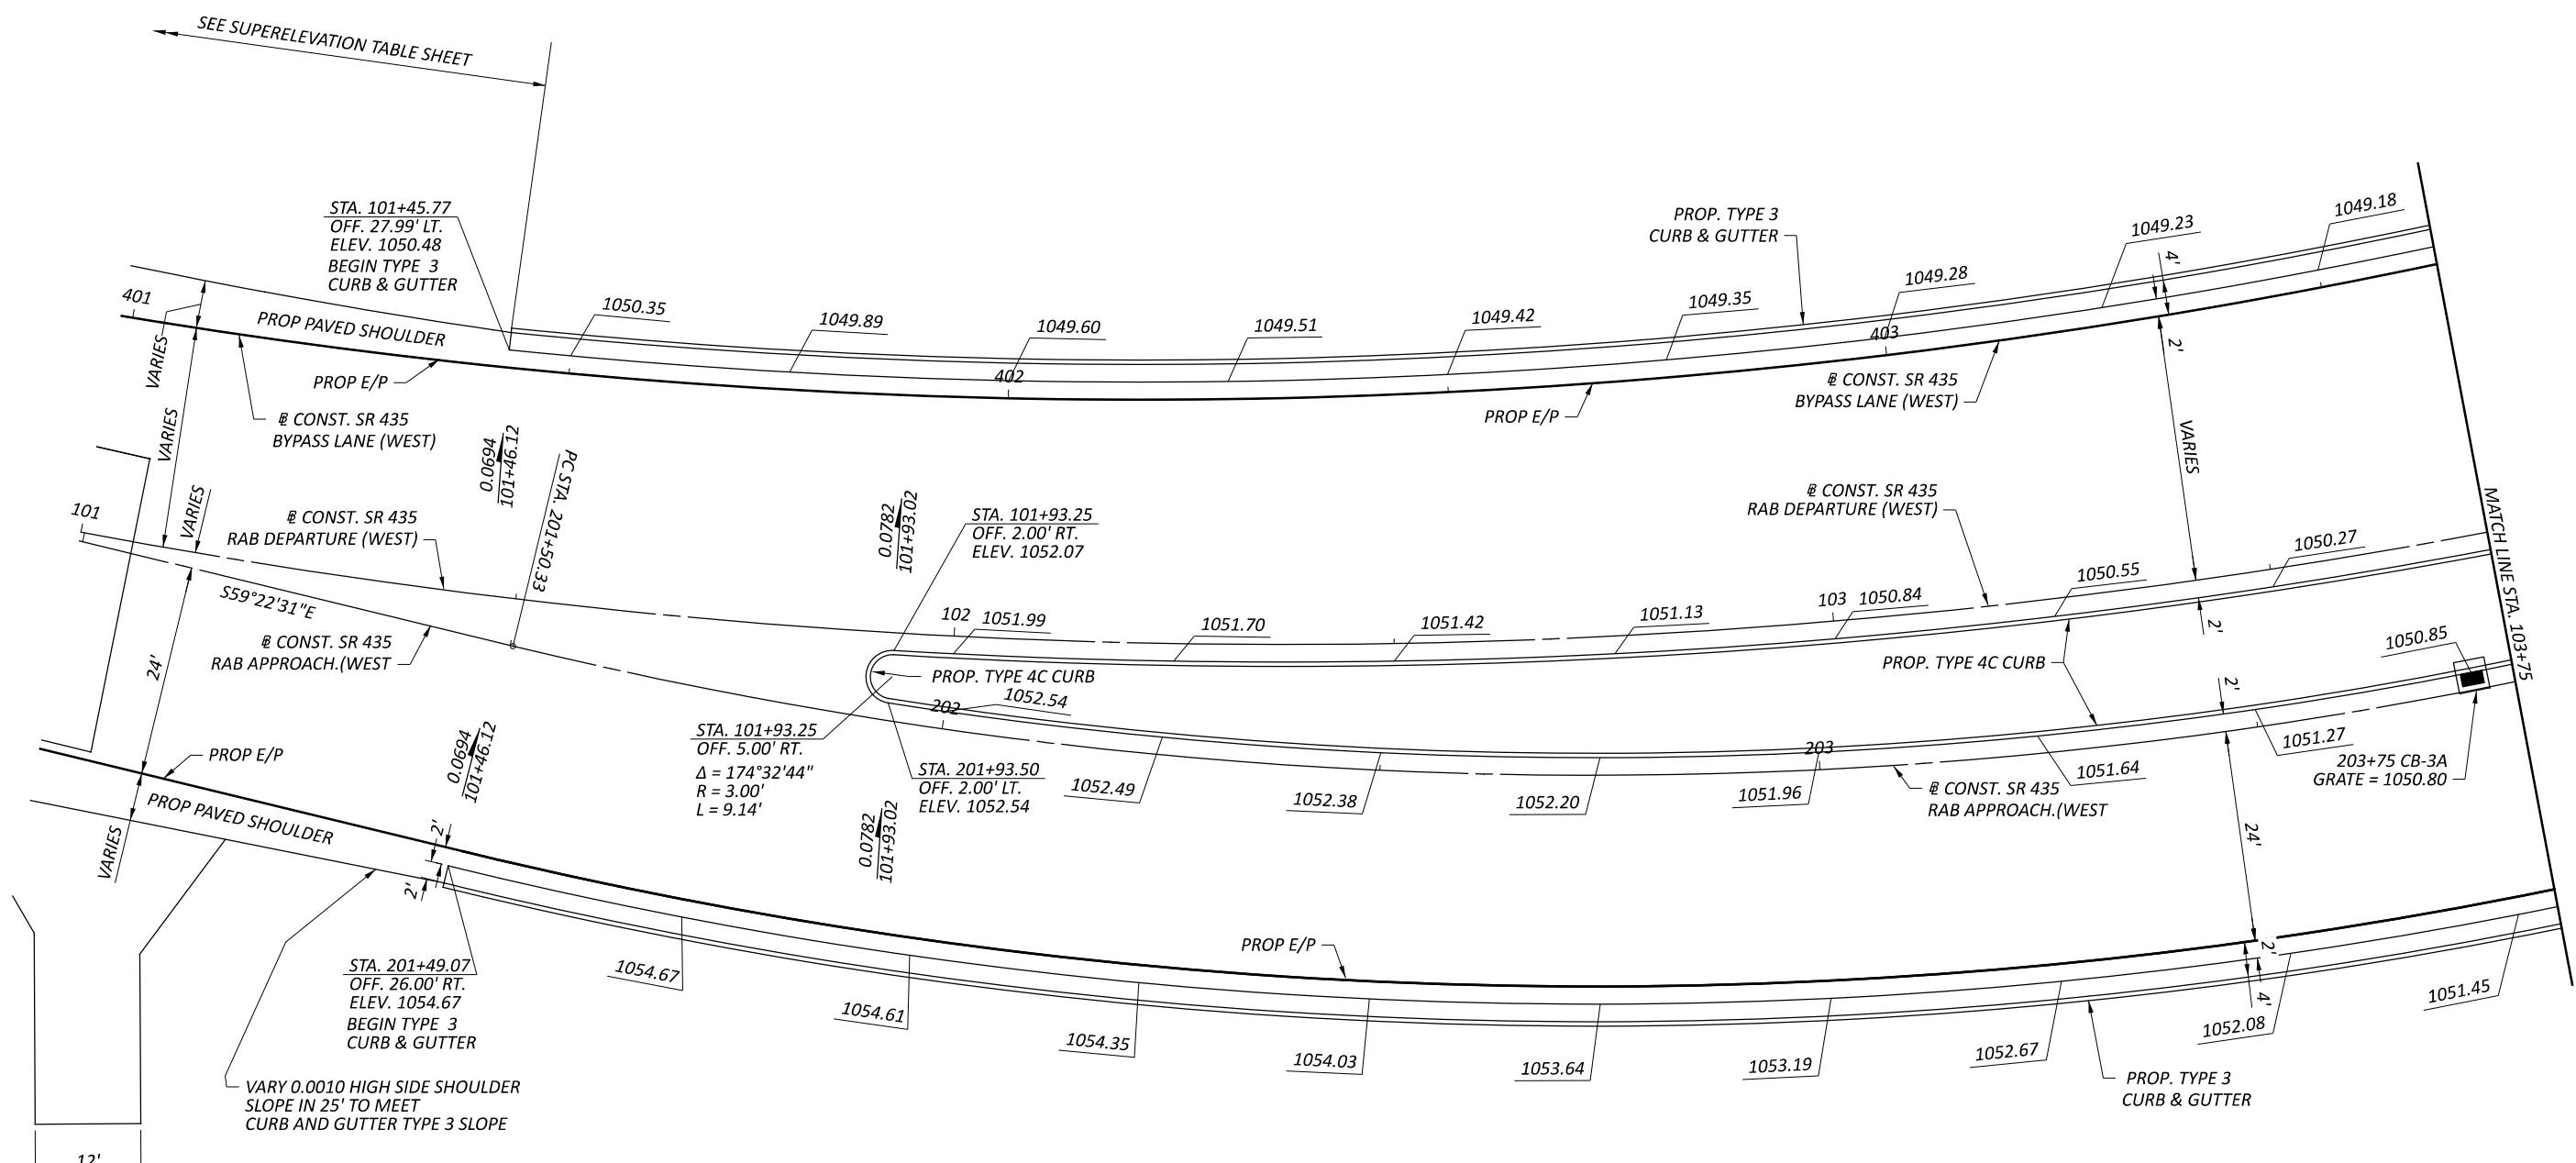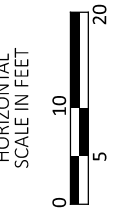



PAVEMENT DETAILS
 SR 435 (WEST) STA. 101+00 TO STA. 103+75

DESIGN AGENCY	
8350 E. KEMPER RD. SUITE B CINCINNATI, OH 45249 513-469-1600	
DESIGNER	DPF
REVIEWER	DCJ MM-DD-YY
PROJECT ID	117955
SHEET	TOTAL
P. 200	228

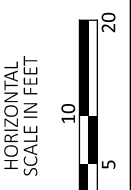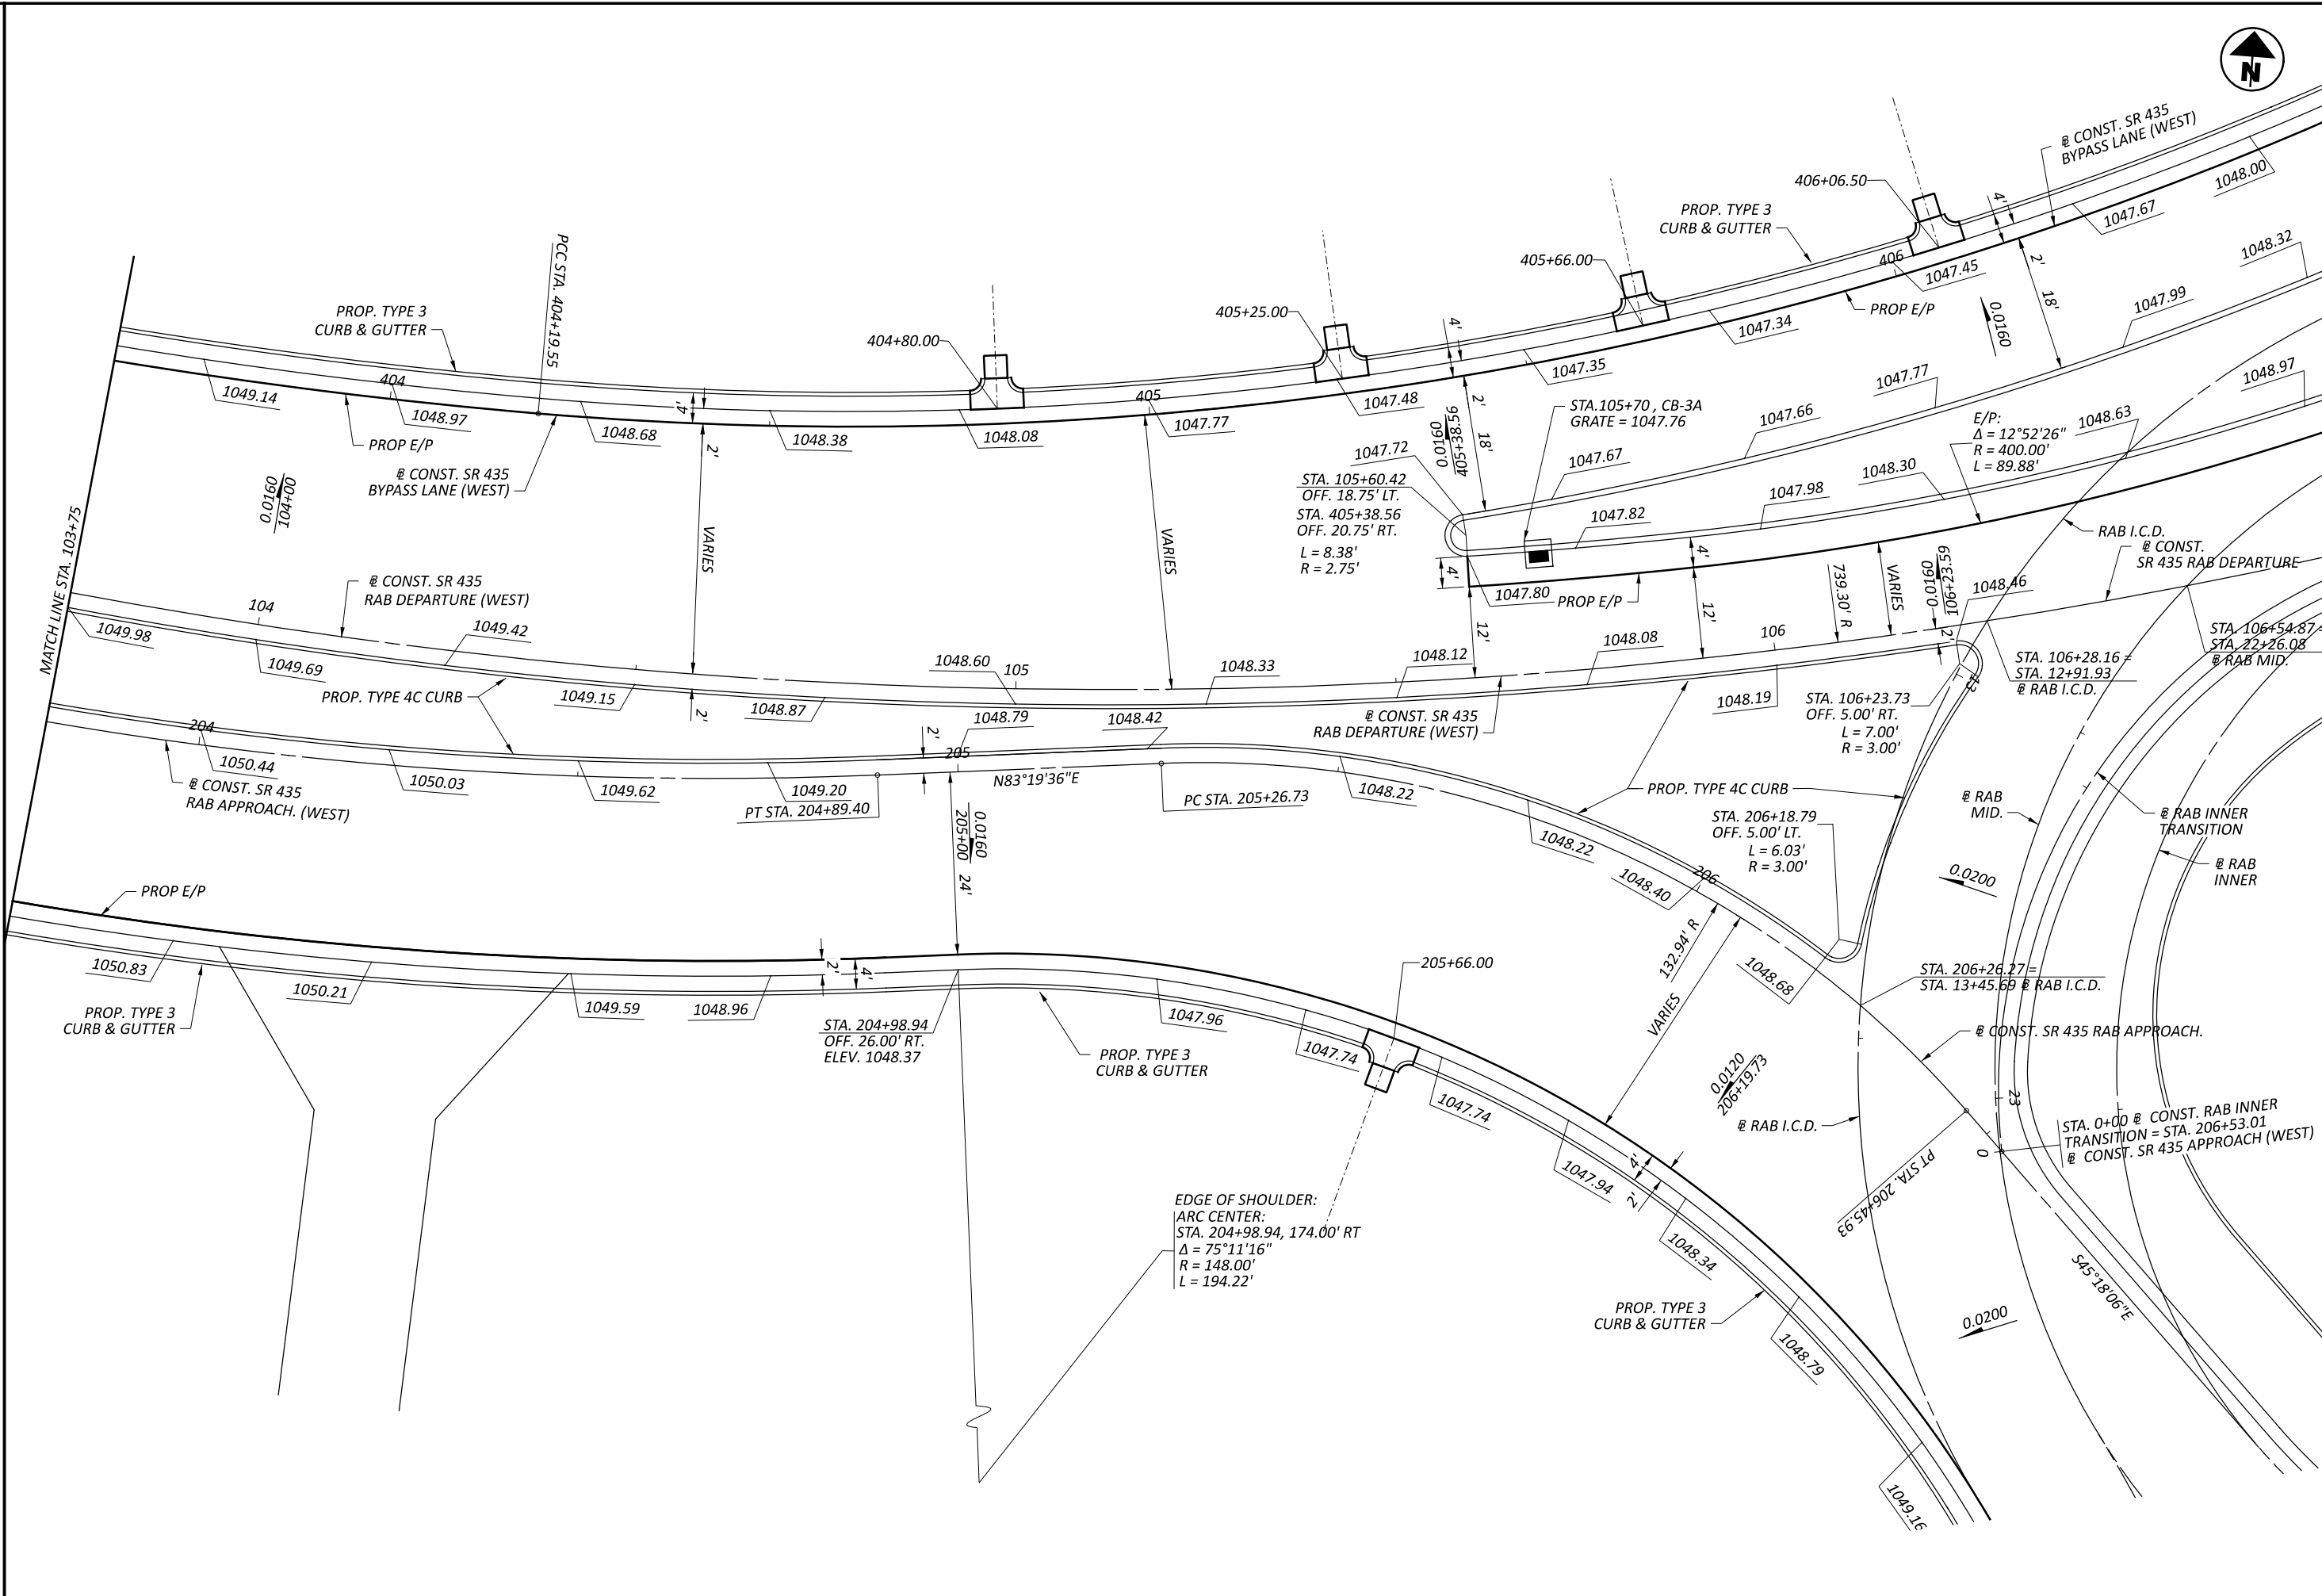

PAVEMENT DETAILS
SR 435 (WEST) STA. 103+75 TO STA. 106+50

DESIGN AGENCY	Palmer ENGINEERING
DESIGNER	DPF
REVIEWER	DCJ MM-DD-YY
PROJECT ID	117955
SHEET TOTAL	P. 201 228

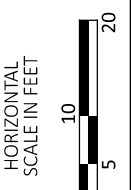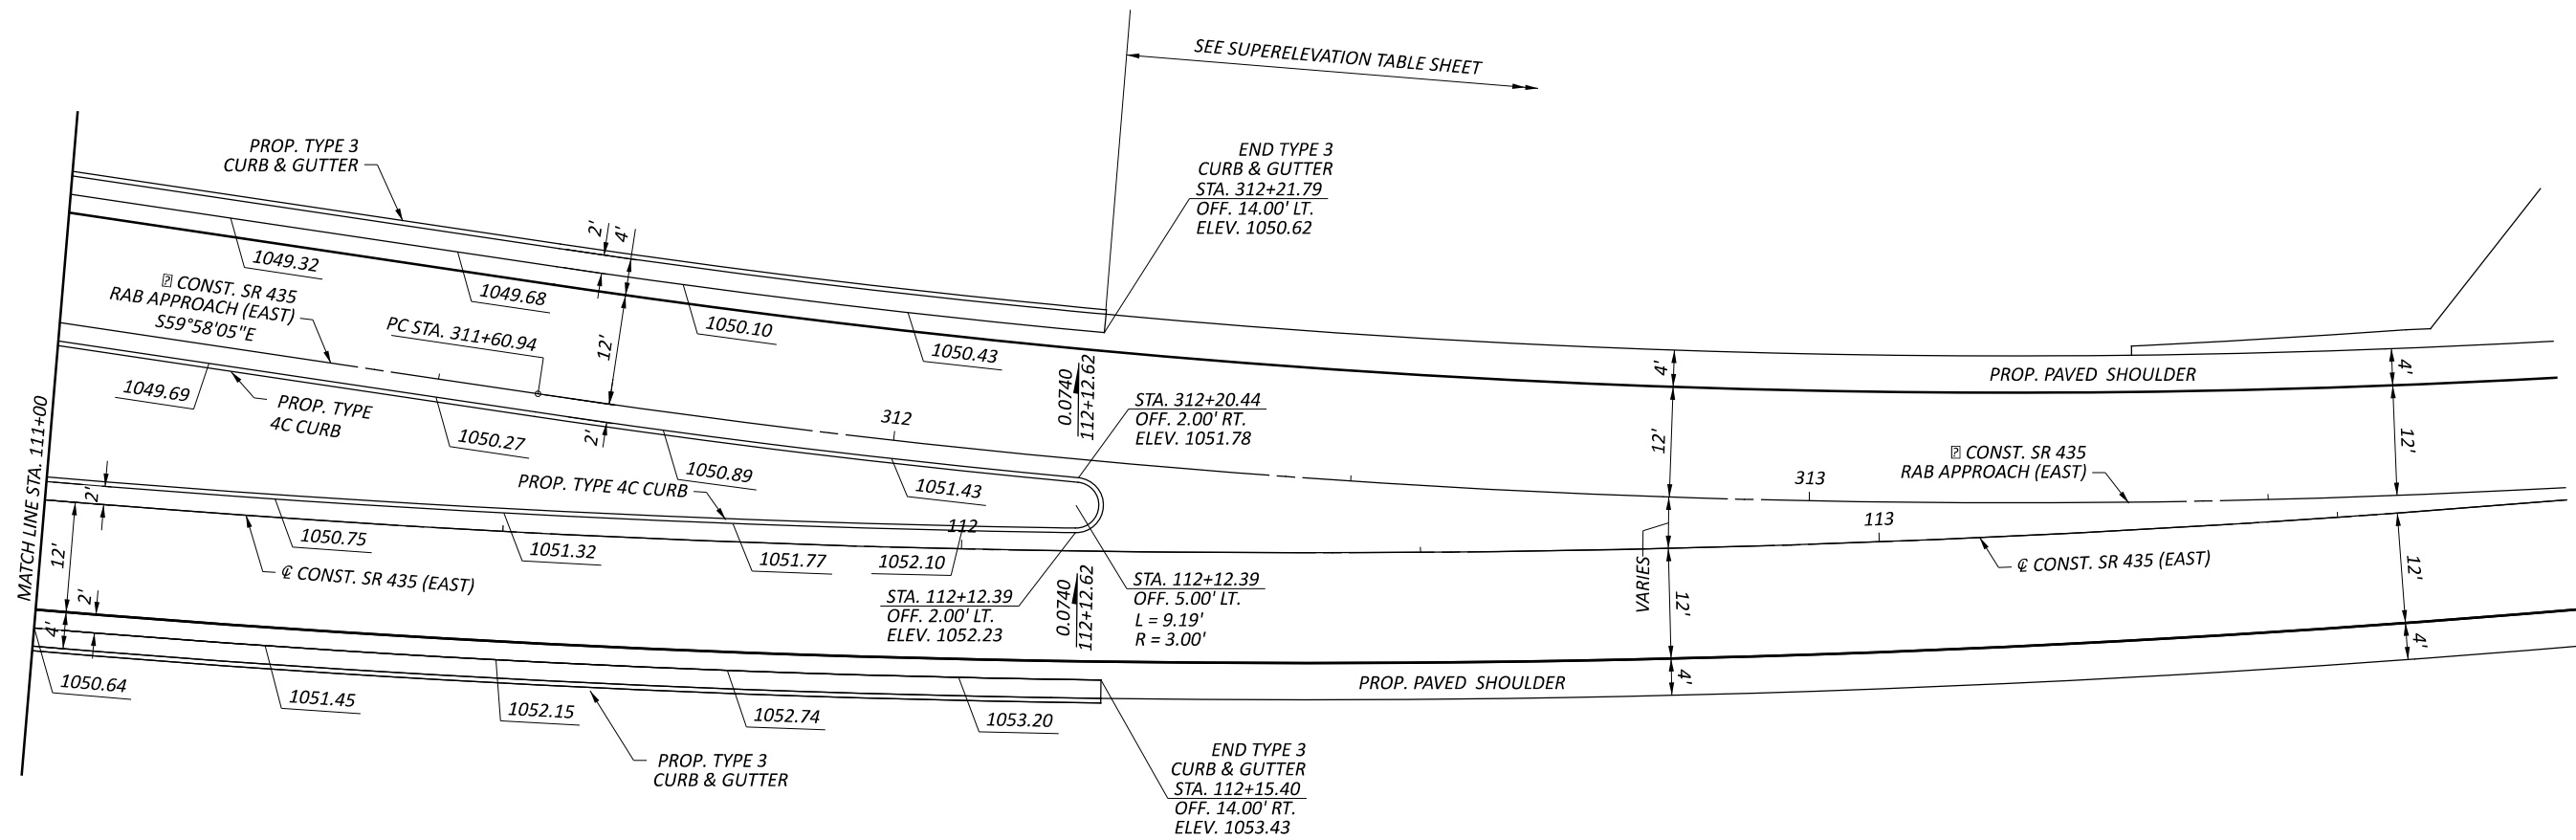

PAVEMENT DETAILS
 SR 435 (EAST) STA. 110+00 TO STA. 114+00

DESIGN AGENCY



DESIGNER
 DPF

REVIEWER
 DCJ MM-DD-YY

PROJECT ID
 117955

SHEET	TOTAL
P. 203	228

@ CONST. RAB INNER
CURVE DATA
P.I. = STA. 0+57.60
 $\Delta = 75^{\circ}47'44''$ RT
Dc = 77'25'36"
R = 74.00'
T = 57.6'
L = 97.89'
E = 19.78'


@ CONST. RAB INNER
CURVE DATA
P.I. = STA. 1+13.22
 $\Delta = 08^{\circ}46'02''$ RT
Dc = 28'38'52"
R = 200.00'
T = 15.33'
L = 30.6'
E = .59'

= @ CONST. RAB INNER
TRANSITION STATIONS

@ RAB I.C.D.
CURVE DATA
P.I. = STA. 10+00.00
 $\Delta = 360^{\circ}00'00''$ LT
Dc = 52'05'13"
R = 110.00'
T = 0.00'
L = 691.15'
E = 0.00'

@ RAB MID.
CURVE DATA
P.I. = STA. 20+00.00
 $\Delta = 360^{\circ}00'00''$ LT
Dc = 62'16'41"
R = 92.00'
T = 0.00'
L = 578.05'
E = 0.00'

@ RAB INNER
CURVE DATA
P.I. = STA. 30+00.00
 $\Delta = 360^{\circ}00'00''$ LT
Dc = 75'23'21"
R = 76.00'
T = 0.00'
L = 477.52'
E = 0.00'

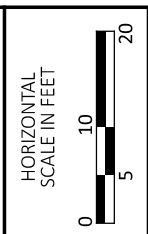

PAVEMENT DETAILS
ROUNDBOUT CENTRAL ISLAND

DESIGN AGENCY


Palmer
ENGINEERING
8350 E. KEMPER RD.
SUITE B
CINCINNATI, OH 45249
513-469-1600


DESIGNER
DPF

REVIEWER
DCJ MM-DD-YY

PROJECT ID
117955

SHEET TOTAL
P. 204 228

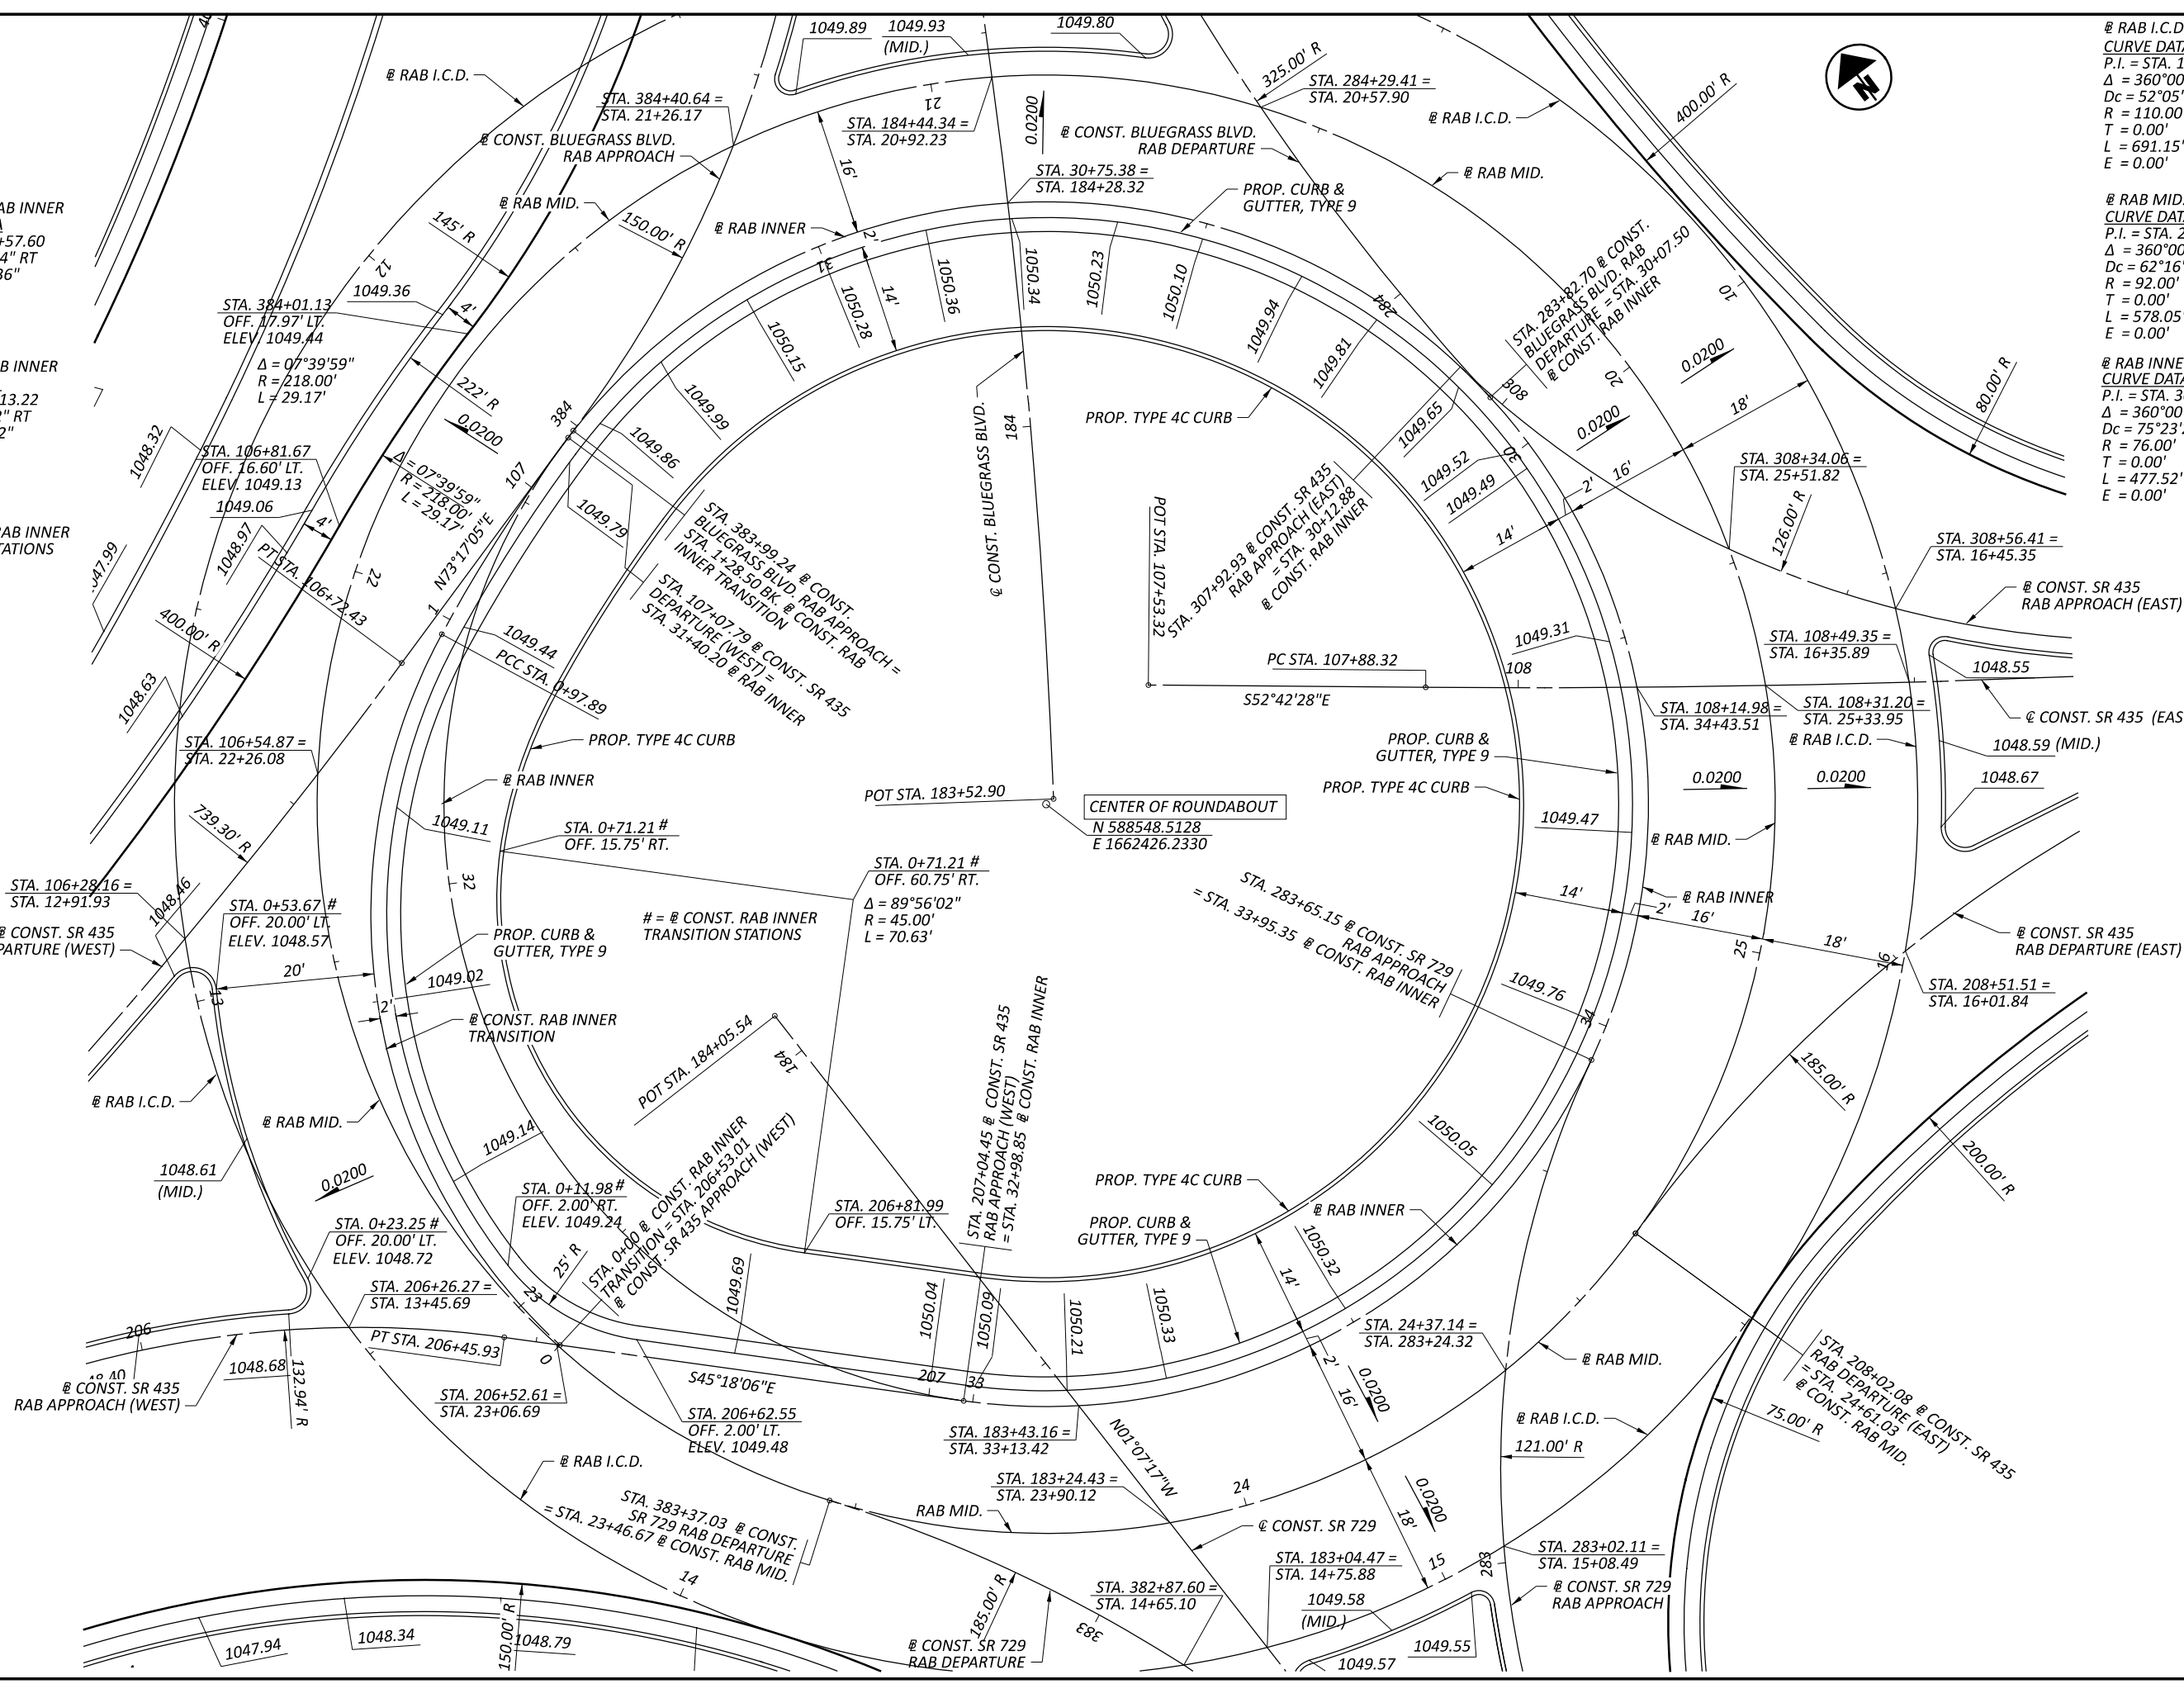

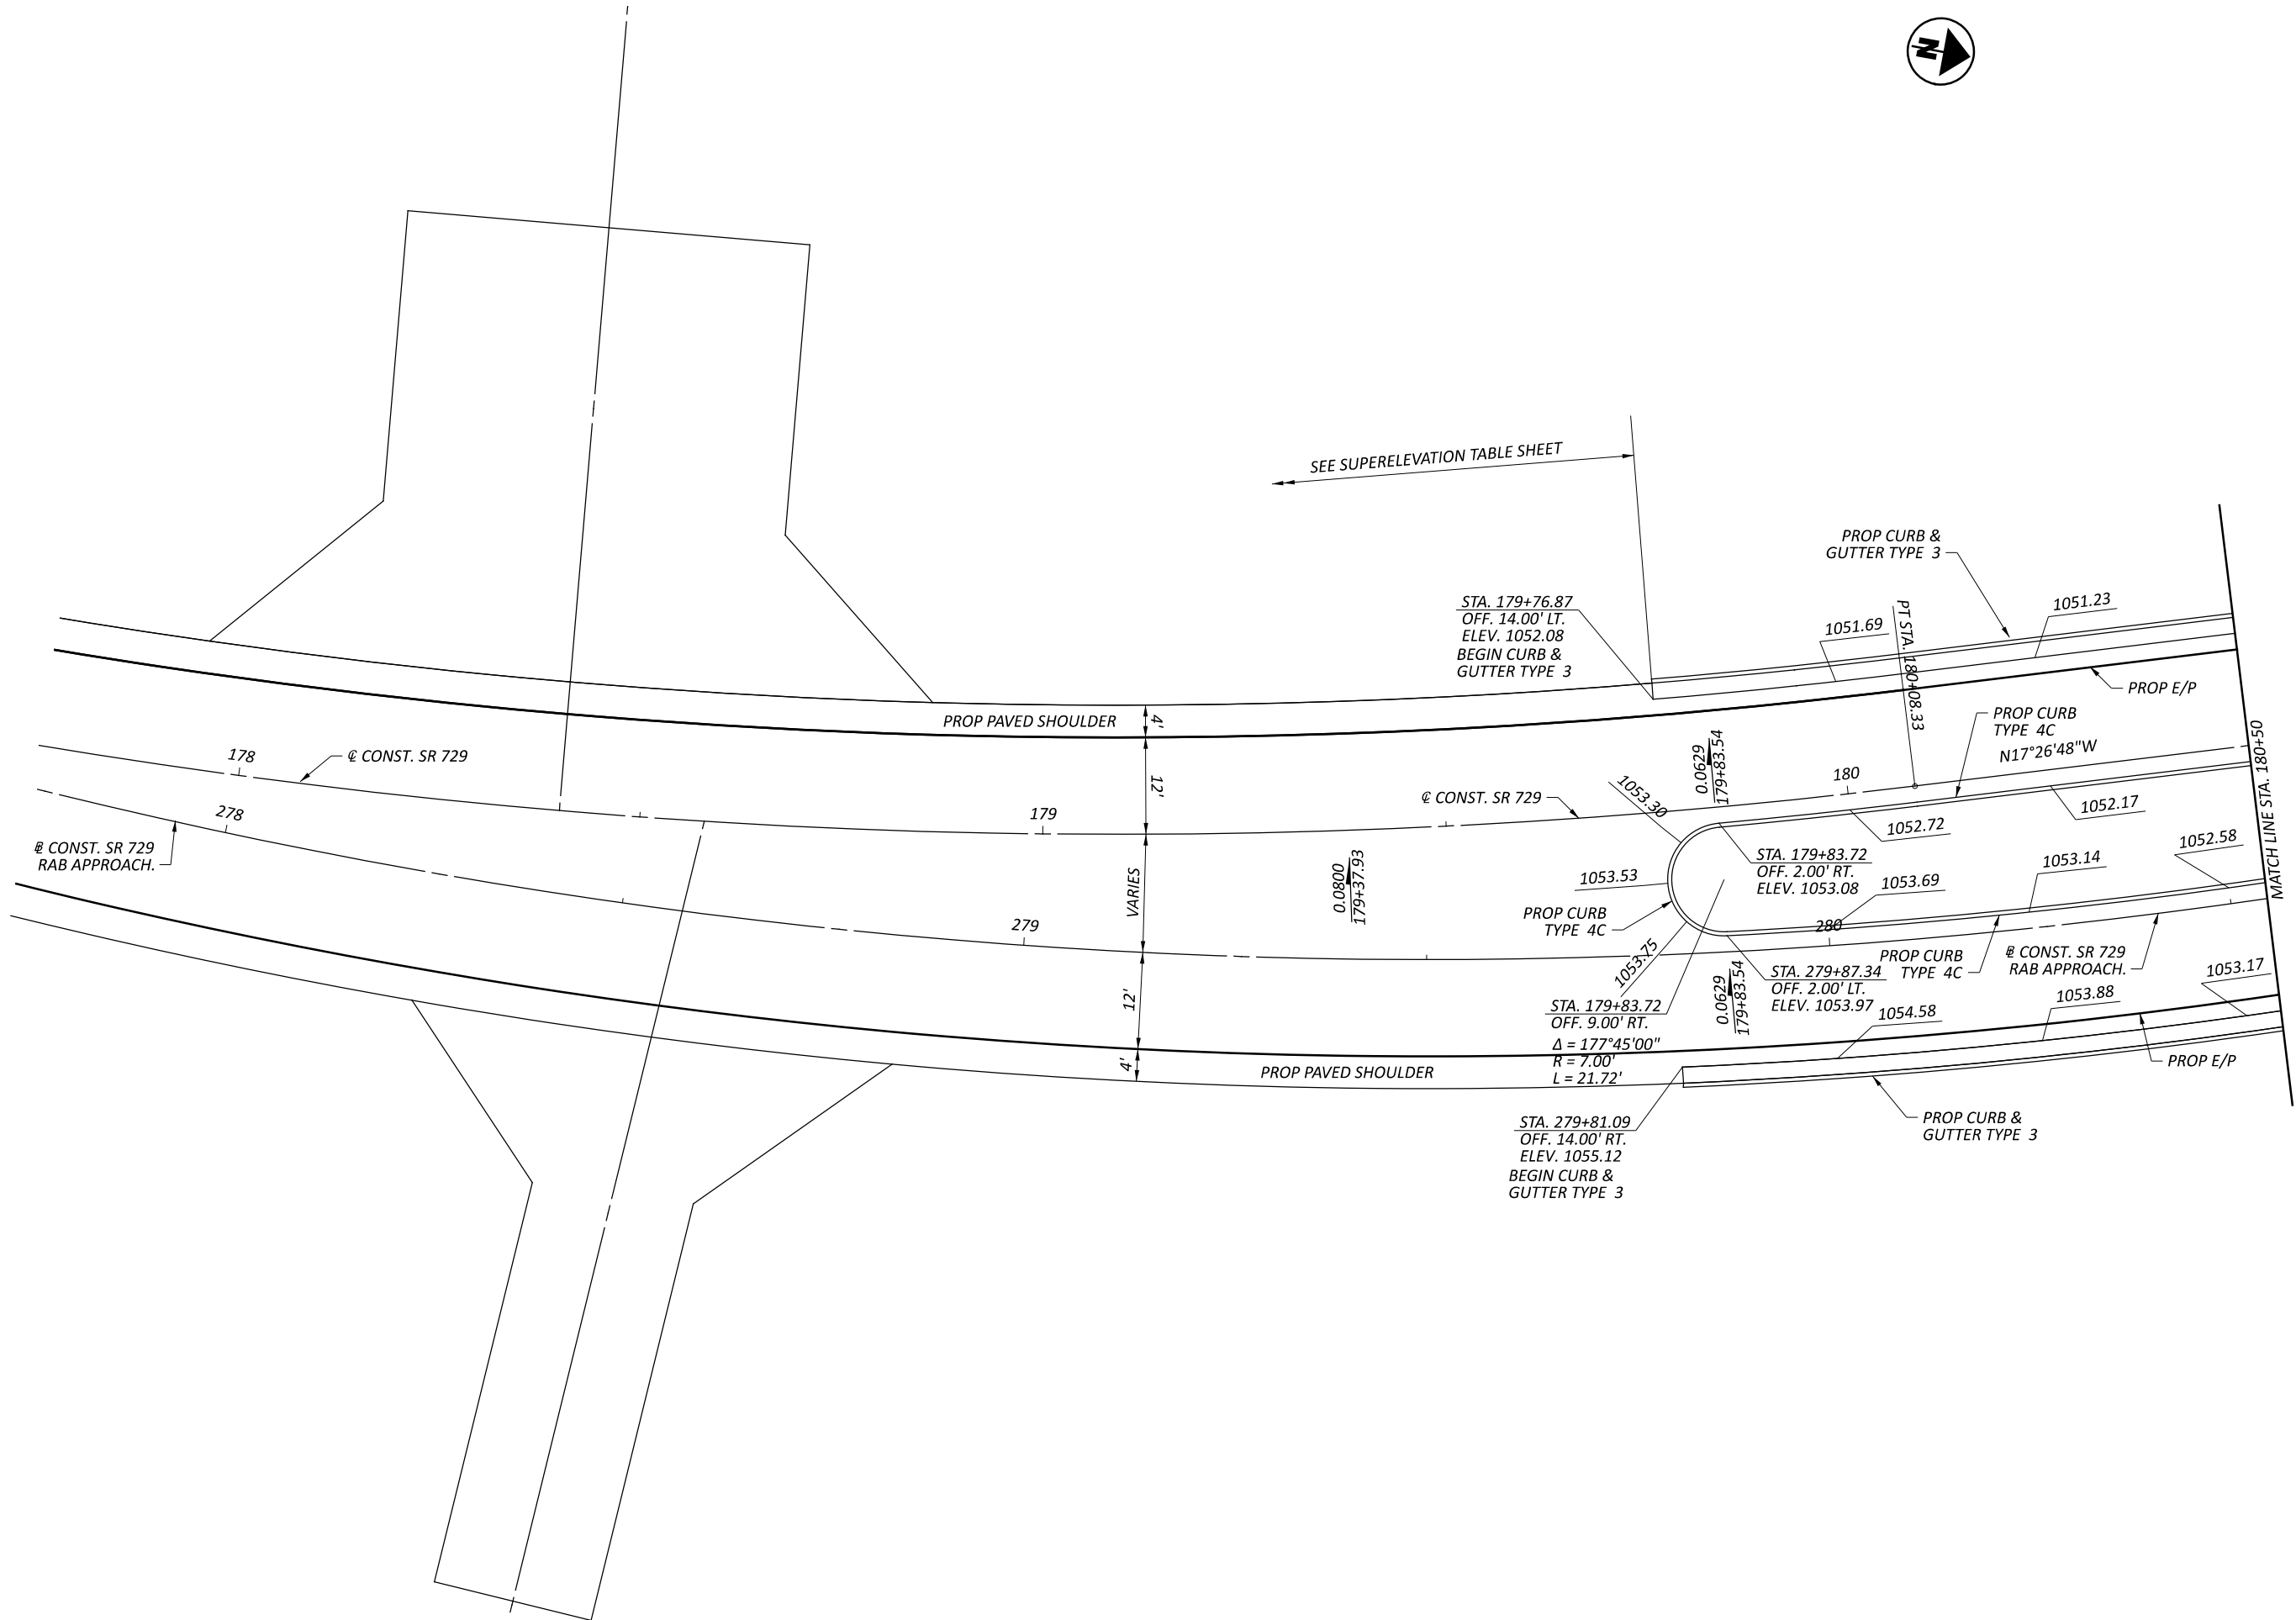

PAVEMENT DETAILS
 SR 729 STA. 177+75 TO STA. 180+50



DESIGN AGENCY



DESIGNER

DPF

REVIEWER



DCJ MM-DD-YY

PROJECT ID

117955

SHEET TOTAL


P. 205 228

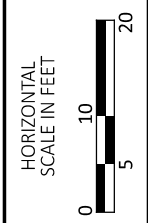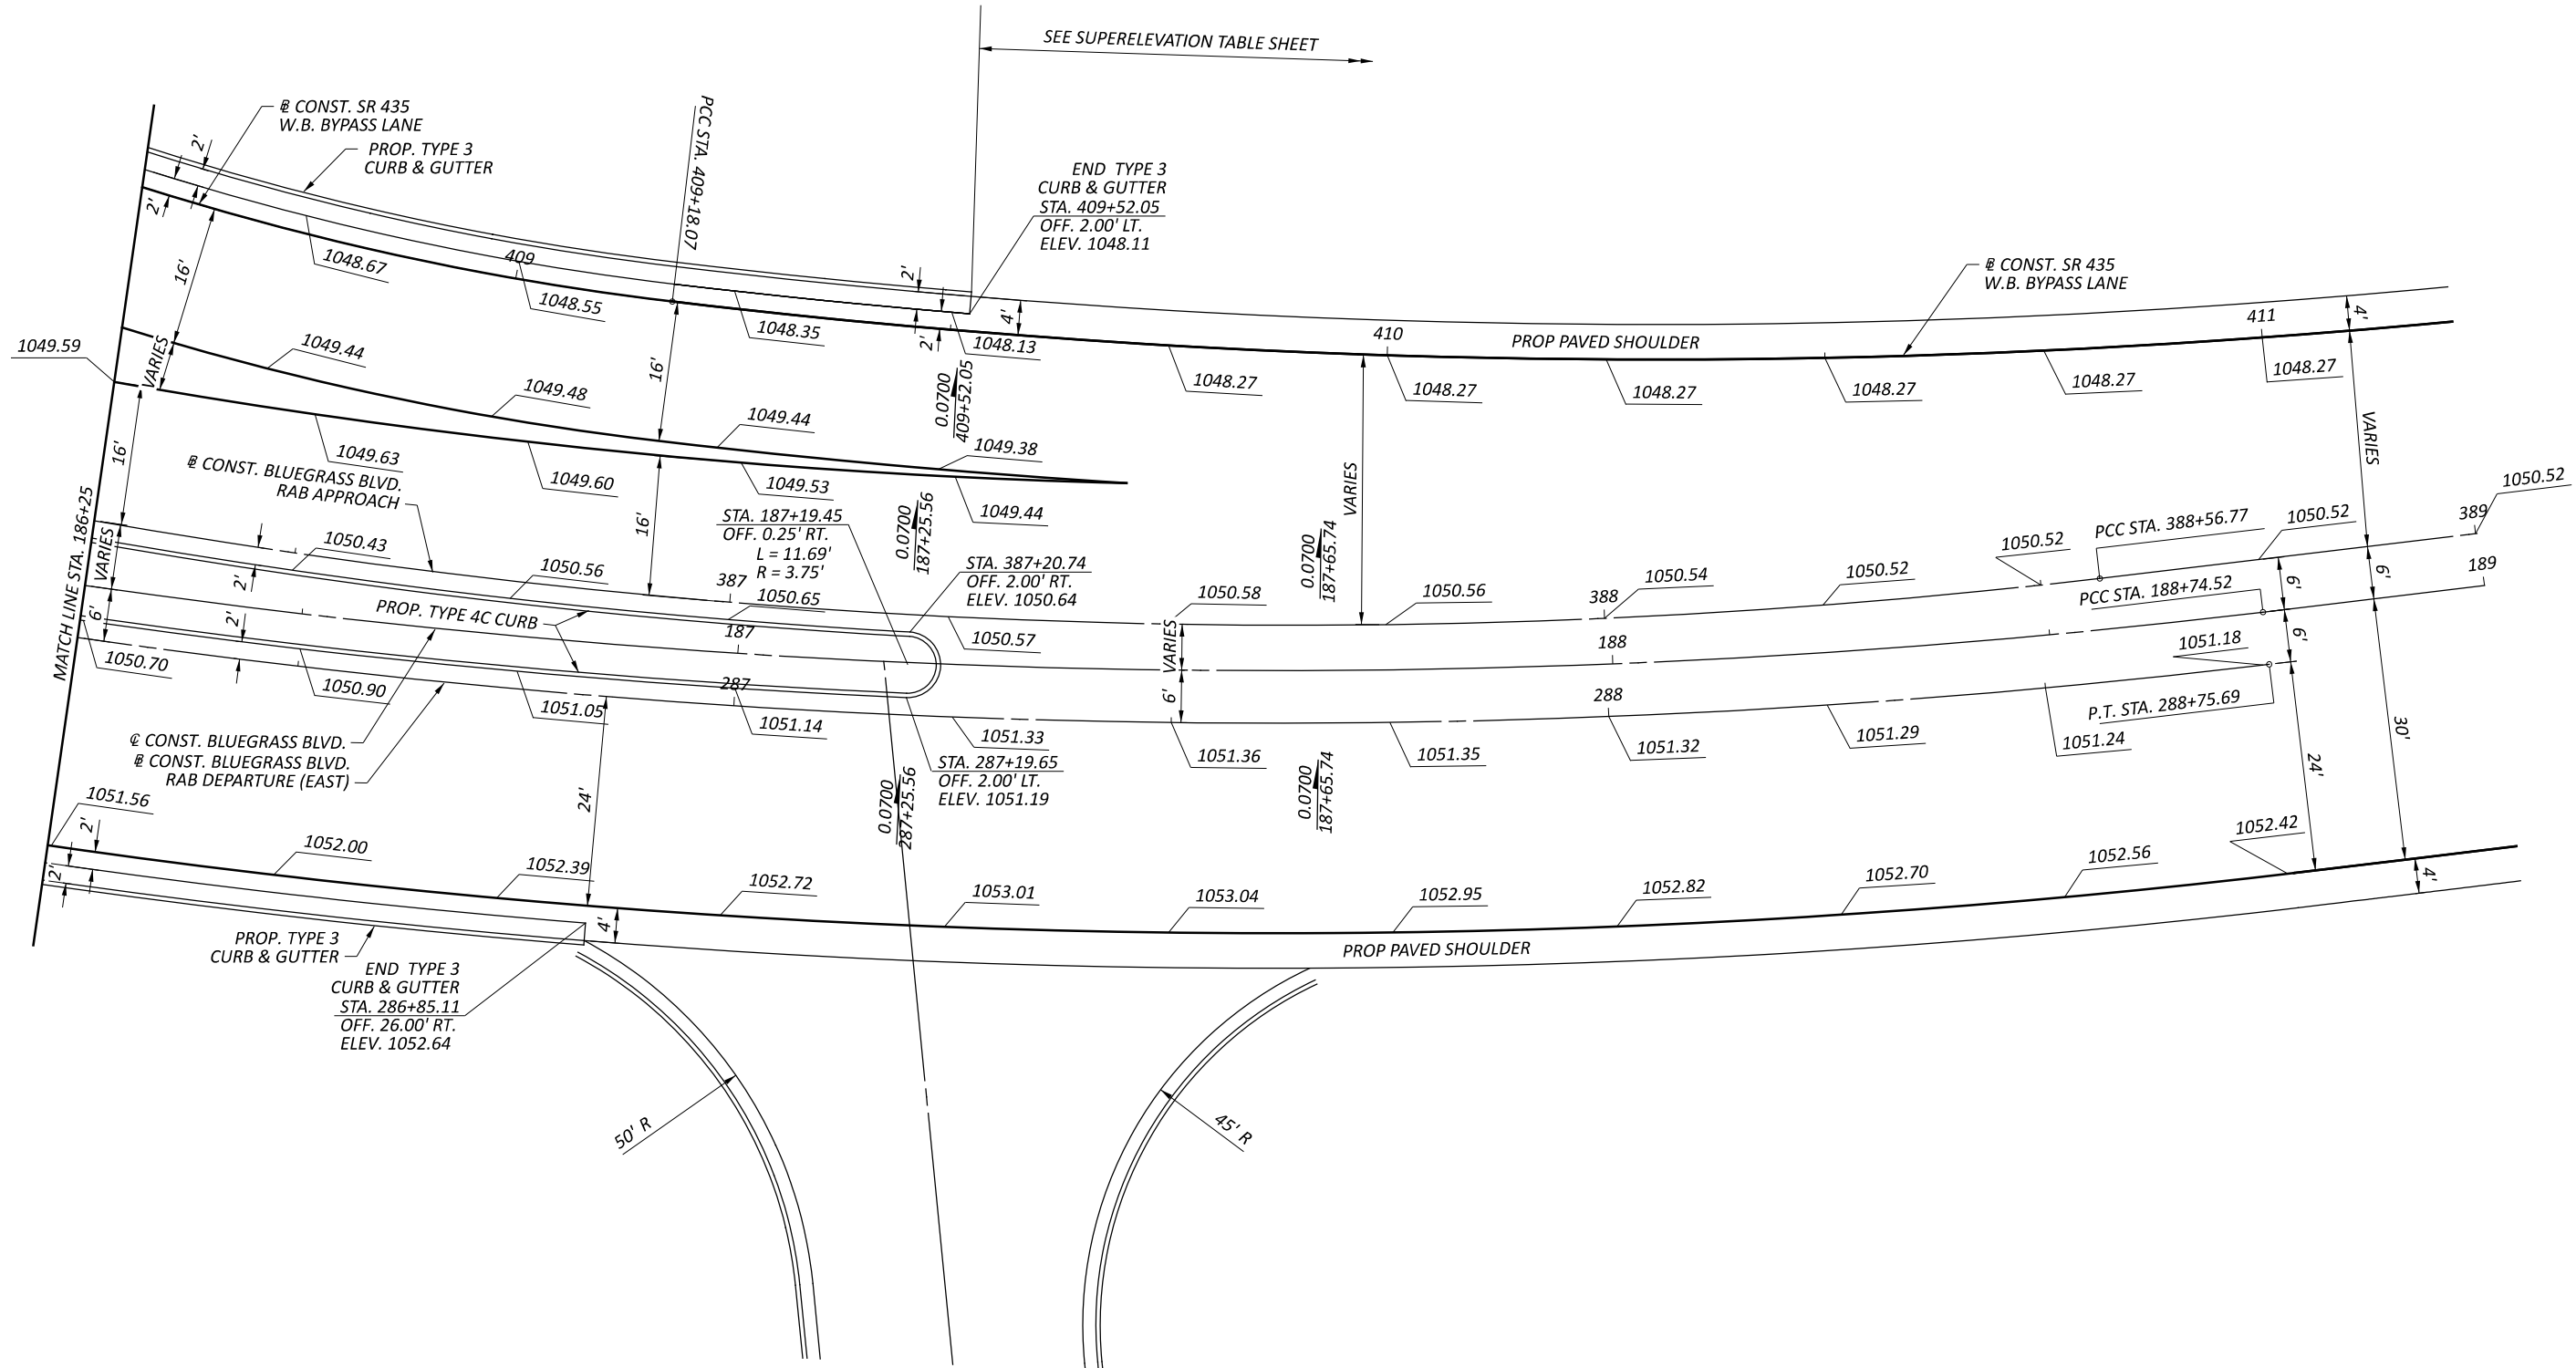

PAVEMENT DETAILS
 BLUEGRASS BLVD. STA. 186+25 TO STA. 189+00


DESIGN AGENCY	
 PALMER ENGINEERING 8350 E. KEMPER RD. SUITE B CINCINNATI, OH 45249 513-469-1600	
DESIGNER	
DPF	
REVIEWER	
DCJ MM-DD-YY	
PROJECT ID	
117955	
SHEET	TOTAL
P. 208	228

are these slabs larger than allowable limits?

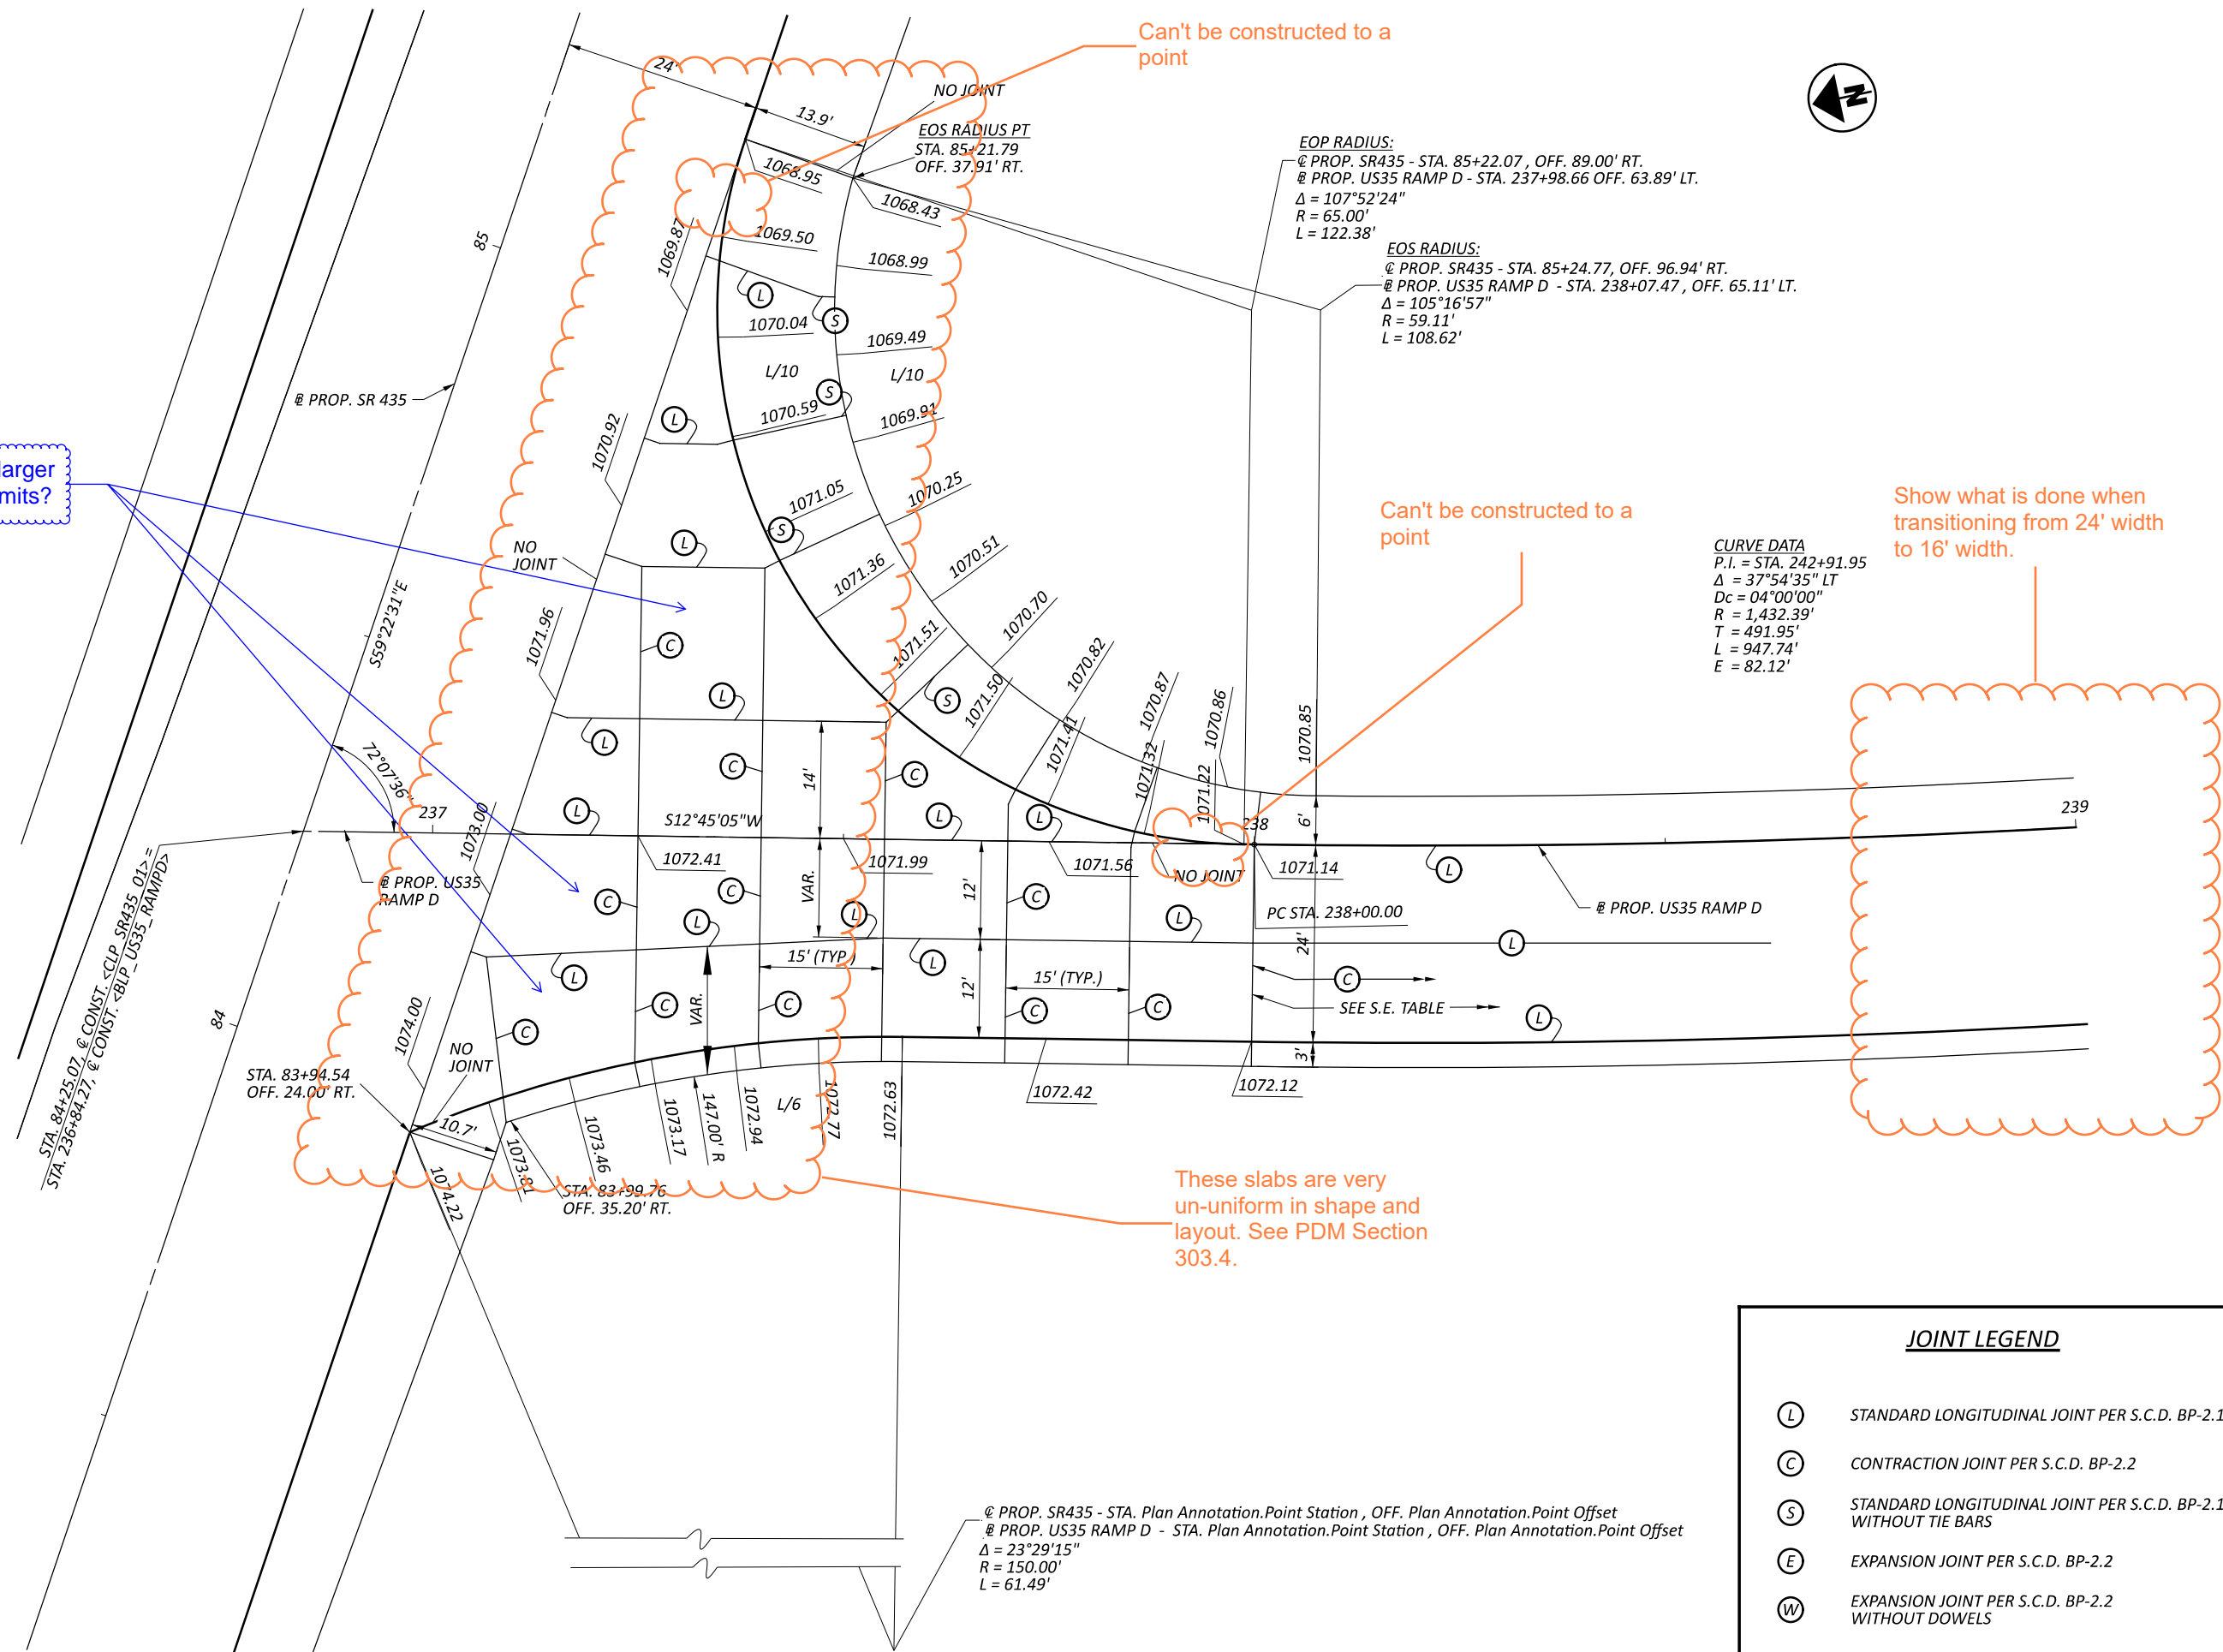


CURVE DATA
 P.I. = STA. 242+91.95
 Δ = 37°54'35" LT
 Dc = 04°00'00"
 R = 1,432.39'
 T = 491.95'
 L = 947.74'
 E = 82.12'

JOINT LEGEND	
(L)	STANDARD LONGITUDINAL JOINT PER S.C.D. BP-2.1
(C)	CONTRACTION JOINT PER S.C.D. BP-2.2
(S)	STANDARD LONGITUDINAL JOINT PER S.C.D. BP-2.1 WITHOUT TIE BARS
(E)	EXPANSION JOINT PER S.C.D. BP-2.2
(W)	EXPANSION JOINT PER S.C.D. BP-2.2 WITHOUT DOWELS

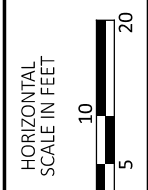


INTERSECTION DETAILS
 SR 435 / US 35 RAMP D

DESIGN AGENCY	Palmer ENGINEERING
DESIGNER	DPF
REVIEWER	DCJ MM-DD-YY
PROJECT ID	117955
SHEET TOTAL	P. 209 228

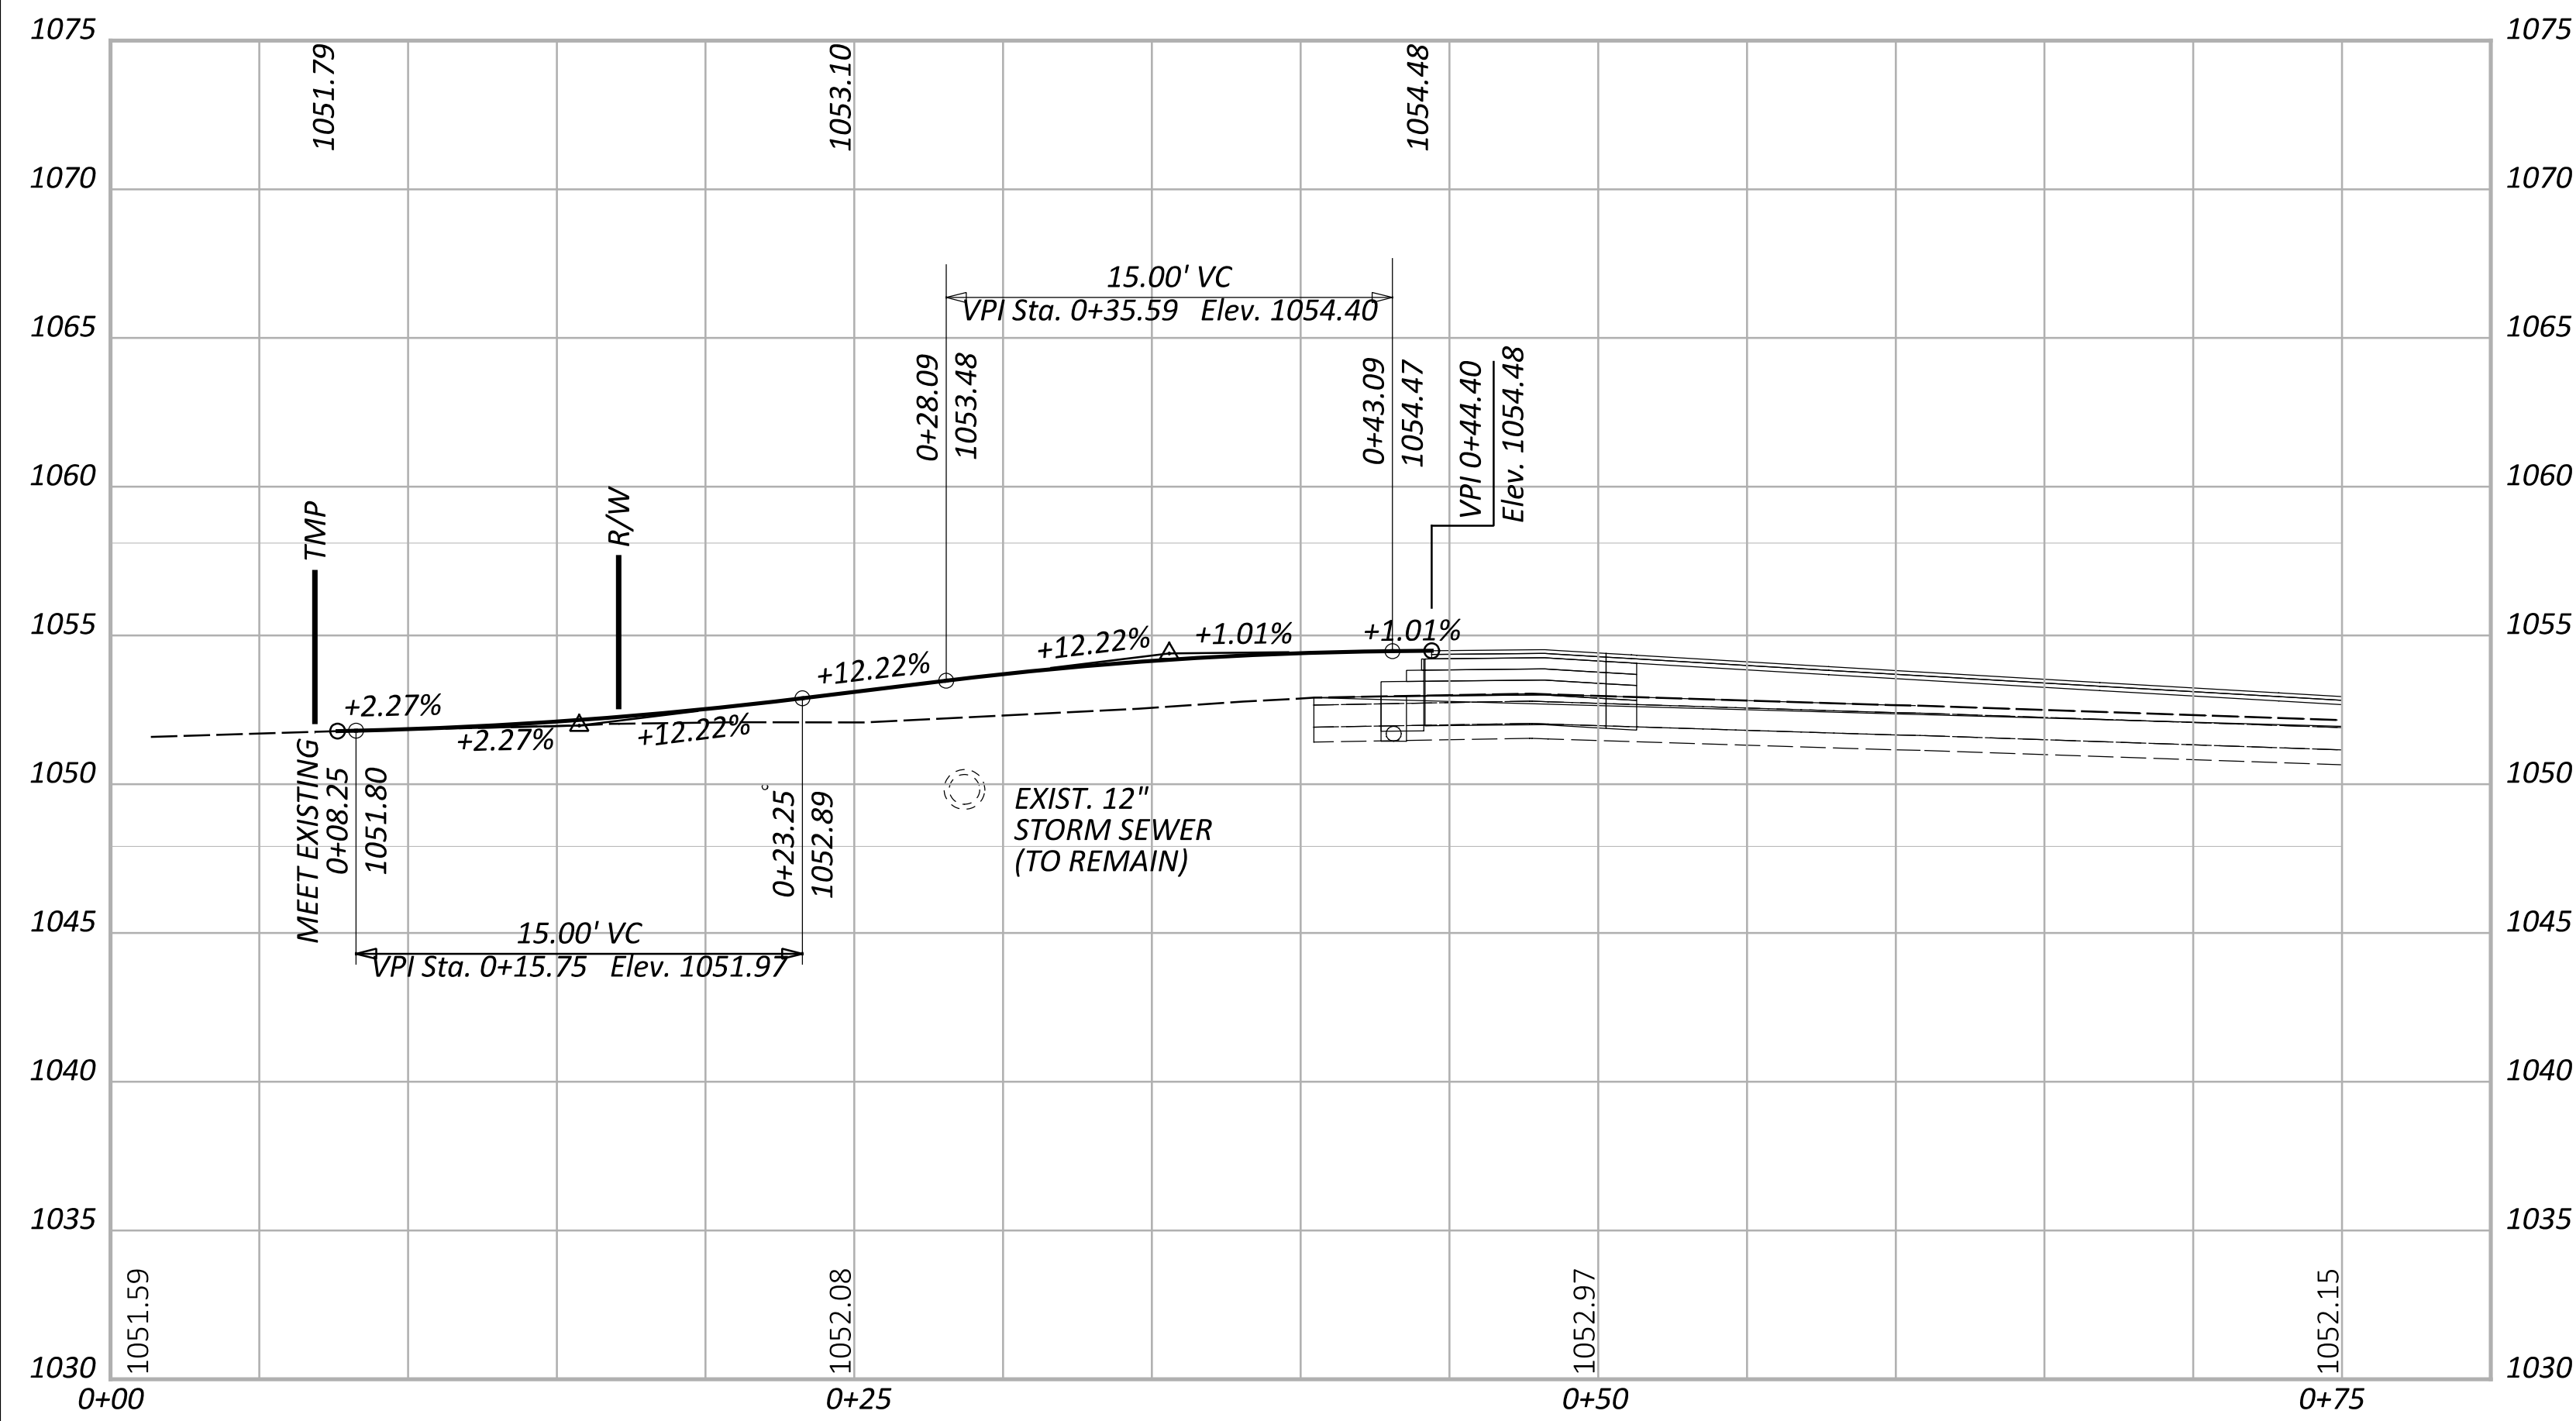


RESIDENTIAL DRIVE - RIGHT
 SR 435 WEST STA. 101+00.6

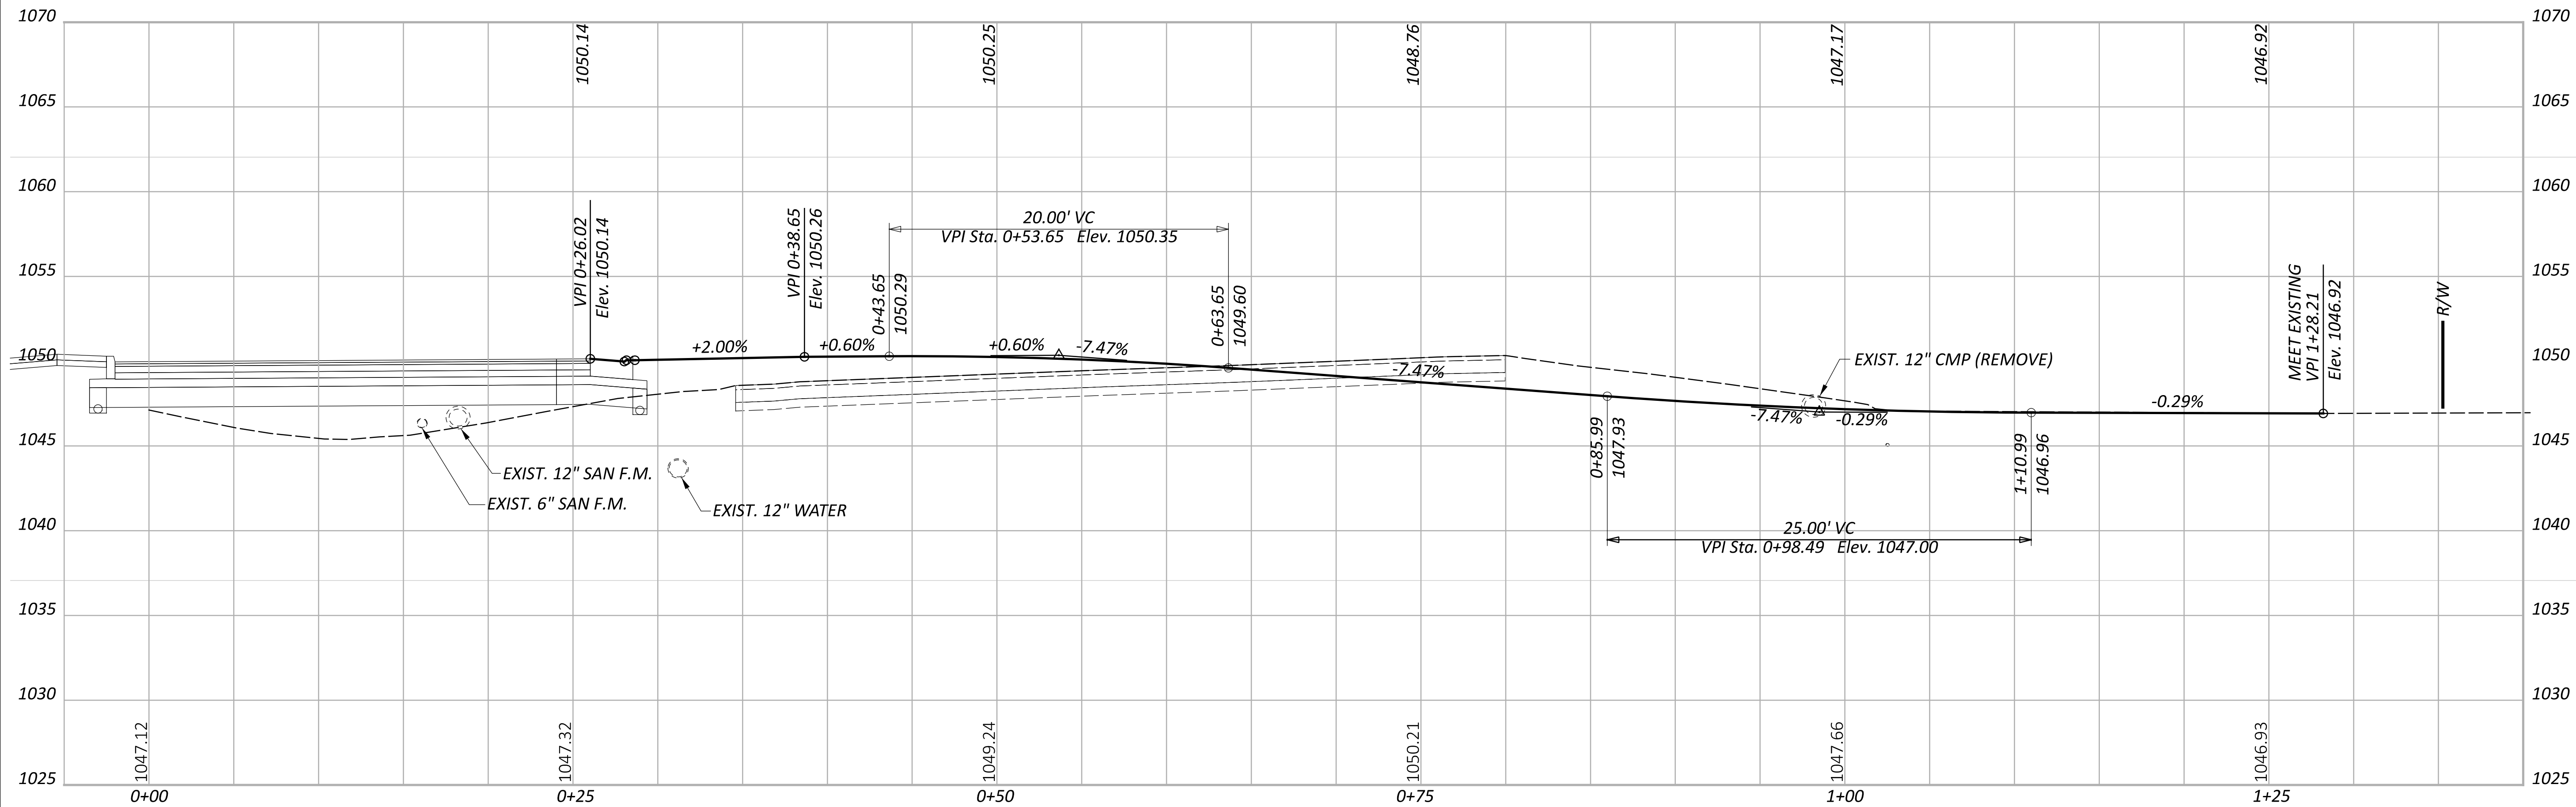


FIELD DRIVE - RIGHT
 SR 435 WEST RAB APPROACH STA. 204+24

DRIVE PROFILES
 STA 101+00.6 SR435 WEST STA 204+24.00 / SR435 WEST RAB APPROACH

DESIGN AGENCY	Palmer ENGINEERING
DESIGNER	DPF
REVIEWER	DCJ MM-DD-YY
PROJECT ID	117955
STA. ROAD TOTAL	P. 210 228

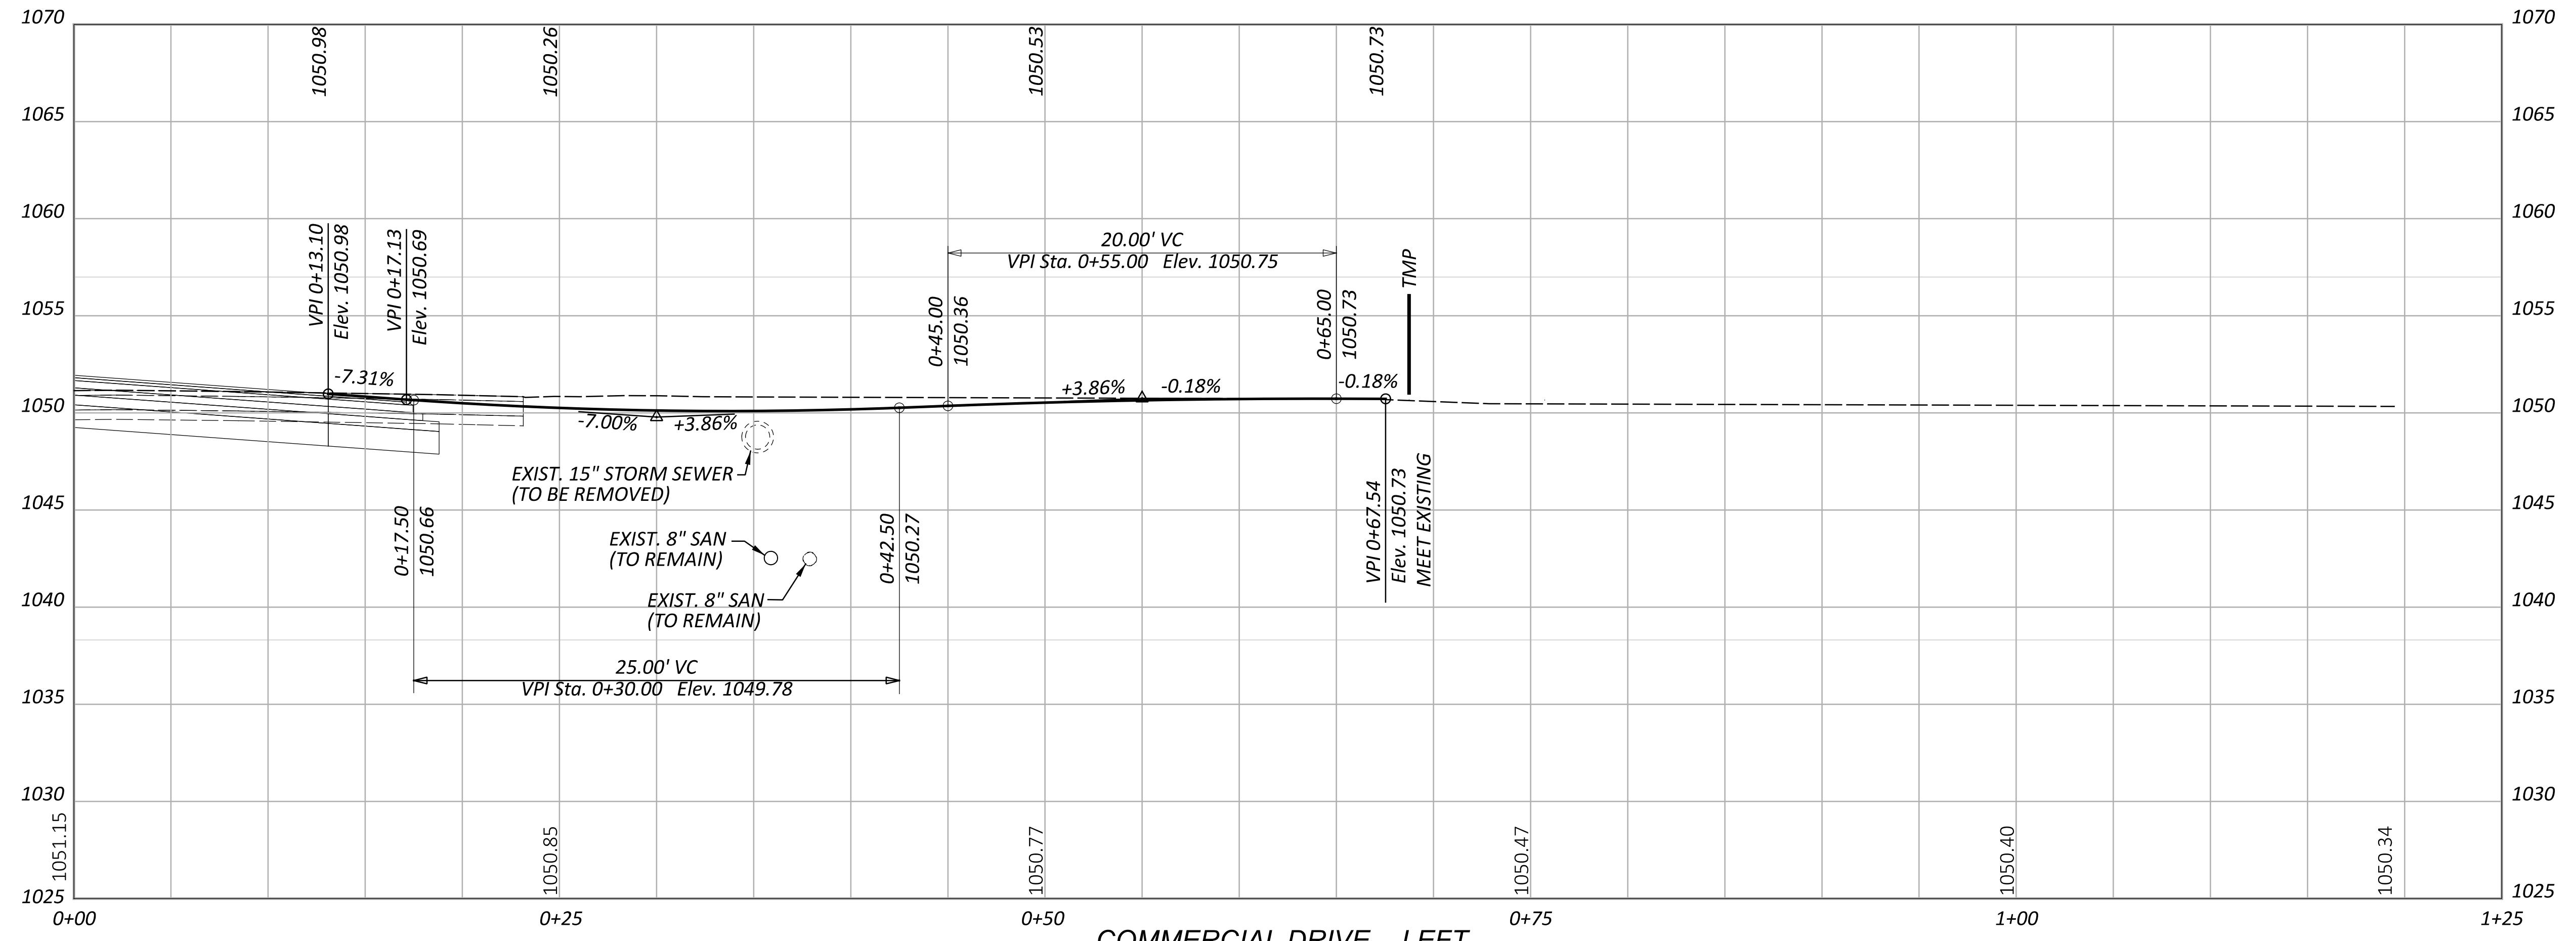

COMMERCIAL DRIVE - LEFT
 SR 435 EAST STA. 113+87.85

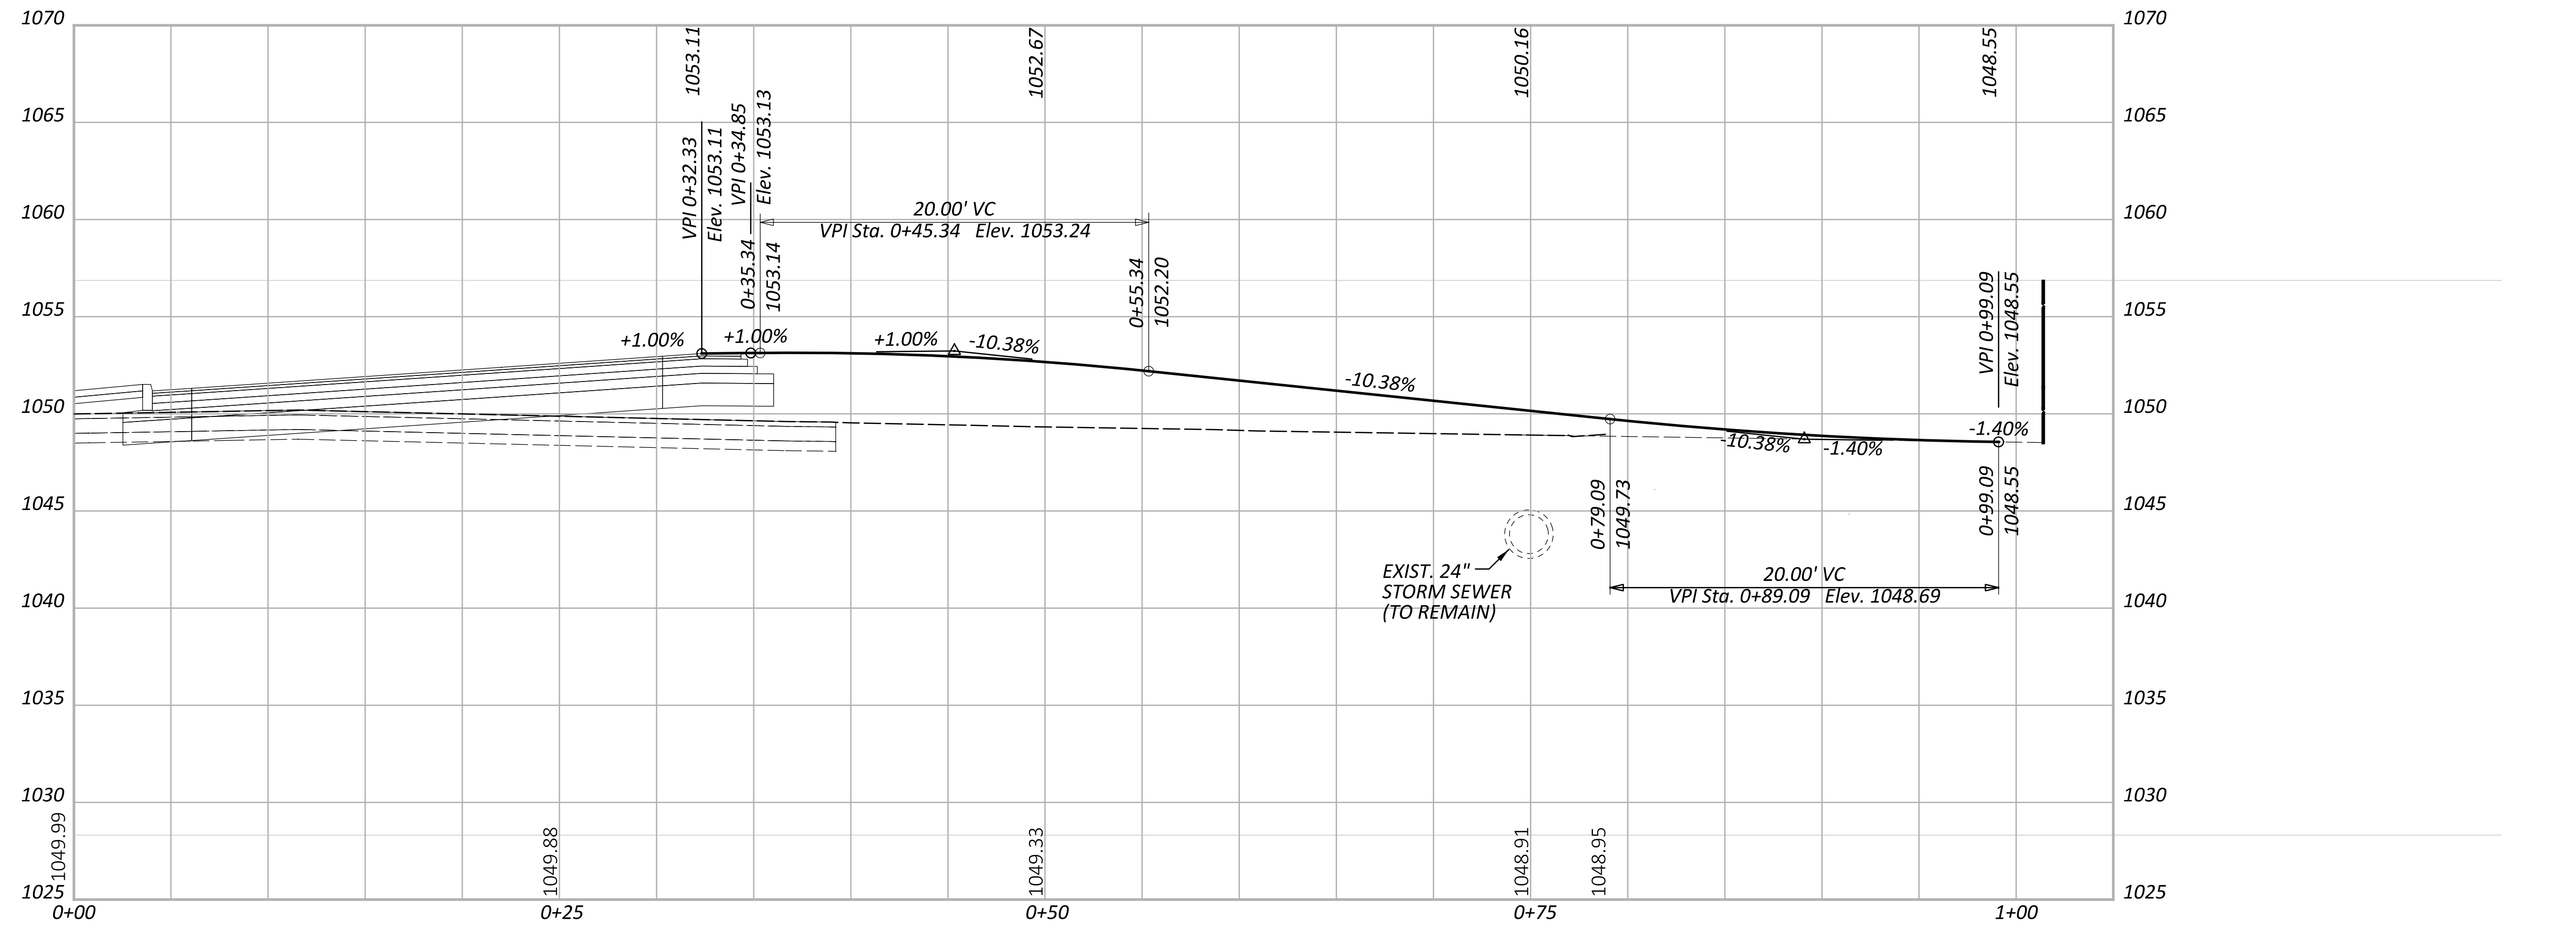

COMMERCIAL DRIVE - RIGHT
 BLUEGRASS BLVD STA. 187+16.69

DRIVE PROFILES
 STA 113+87.85 SR 435 EAST / STA 187+16.69 BLUEGRASS BLVD

DESIGN AGENCY



DESIGNER

DPF

REVIEWER


DCJ MM-DD-YY

PROJECT ID


117955

SHEET TOTAL

P. 211 228

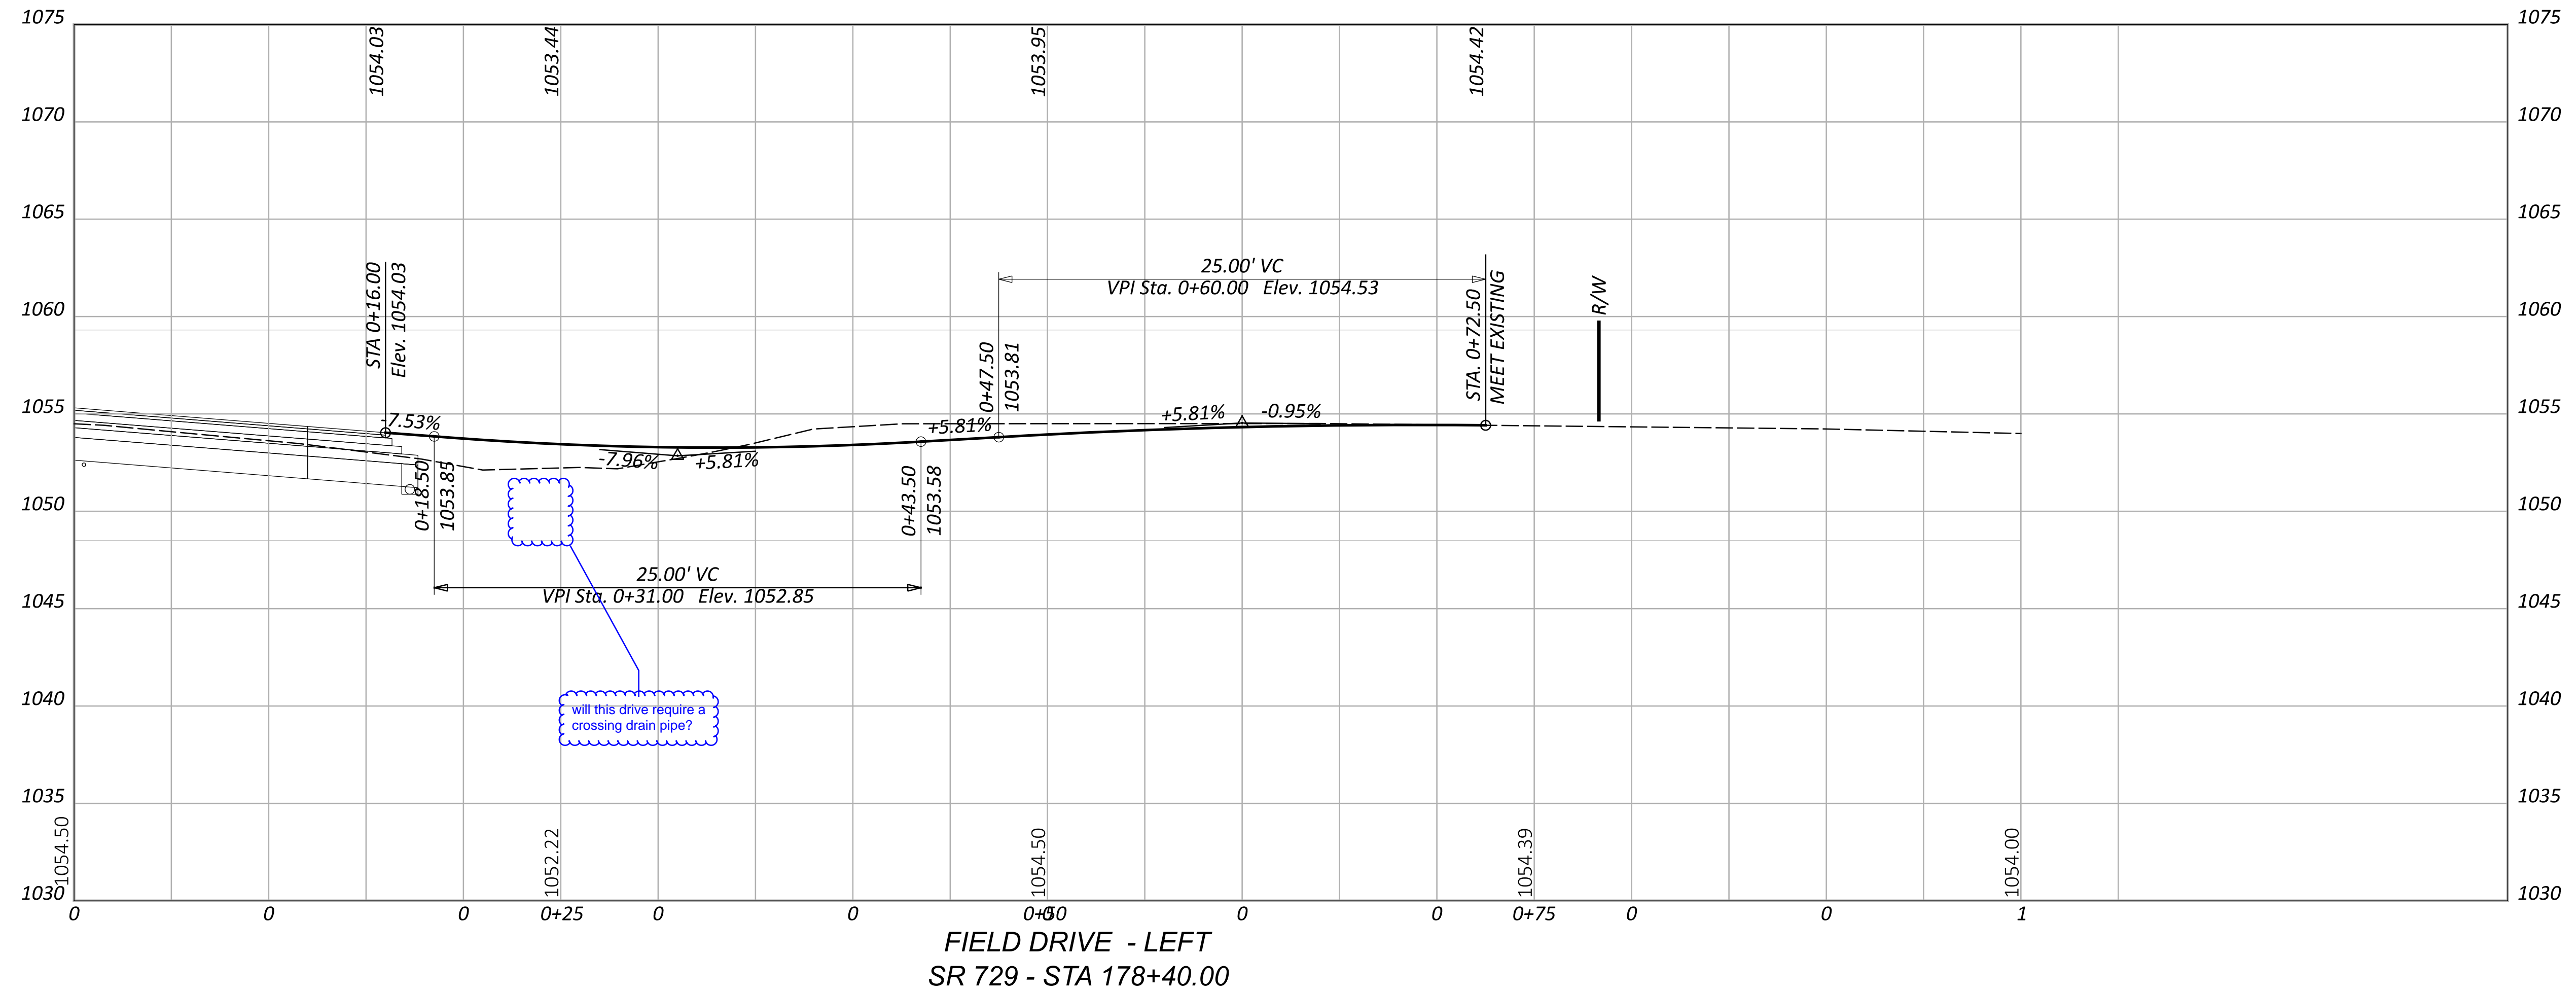


FIELD DRIVE - LEFT
 SR 729 - STA 178+40.00

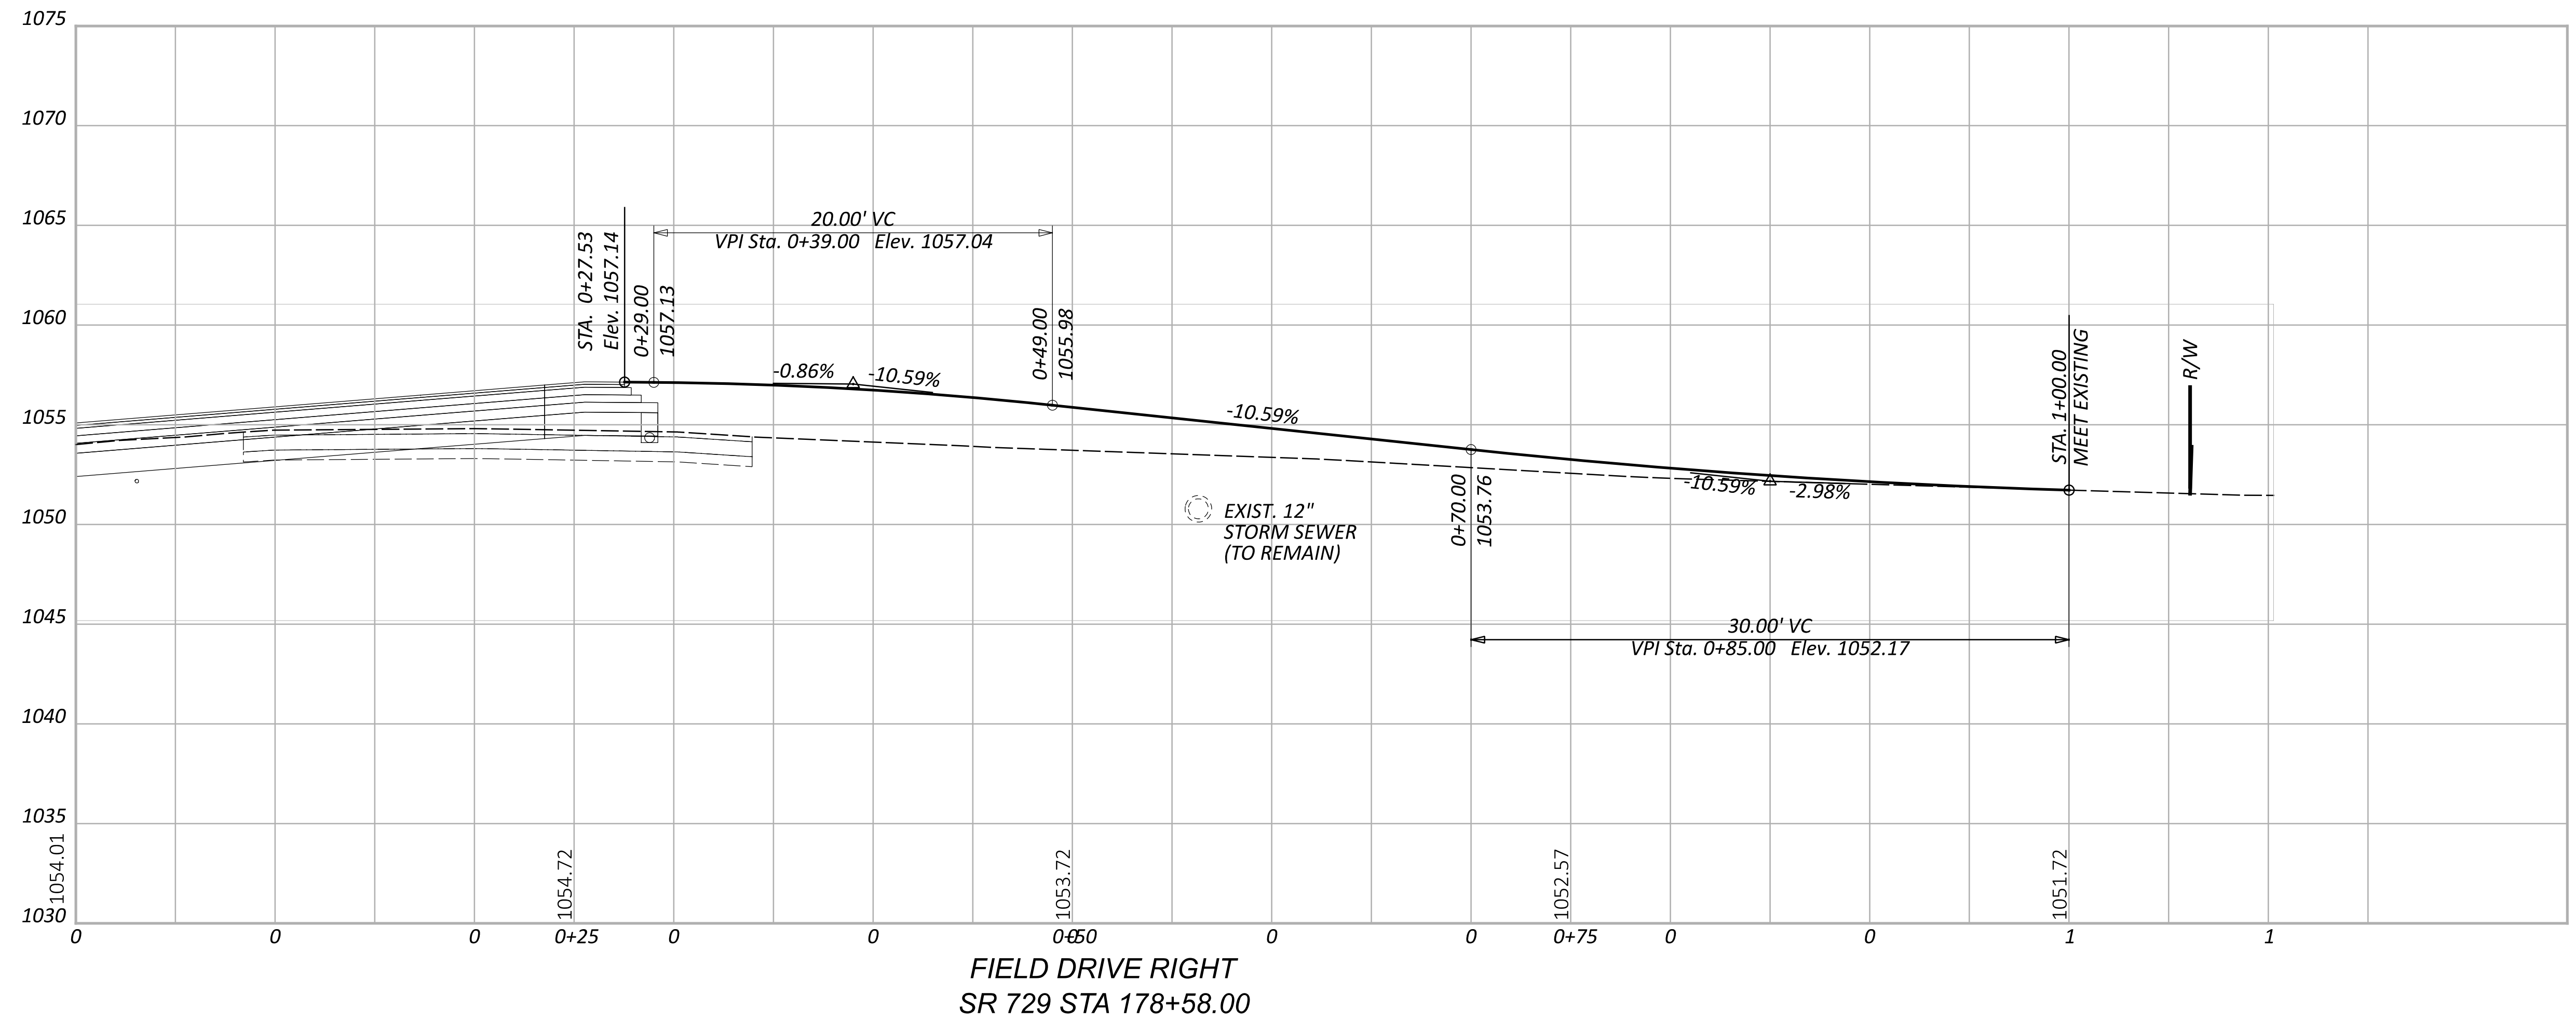


FIELD DRIVE RIGHT
 SR 729 STA 178+58.00

DRIVE PROFILES
 STA 178+40.00 SR 729 / STA 178+58.00 SR 729

DESIGN AGENCY	
8350 E. KEMPER RD. SUITE B CINCINNATI, OH 45249 513-469-1600	
DESIGNER	
DPF	
REVIEWER	
DCJ MM-DD-YY	
PROJECT ID	
117955	
SHEET	TOTAL
P. 212	228

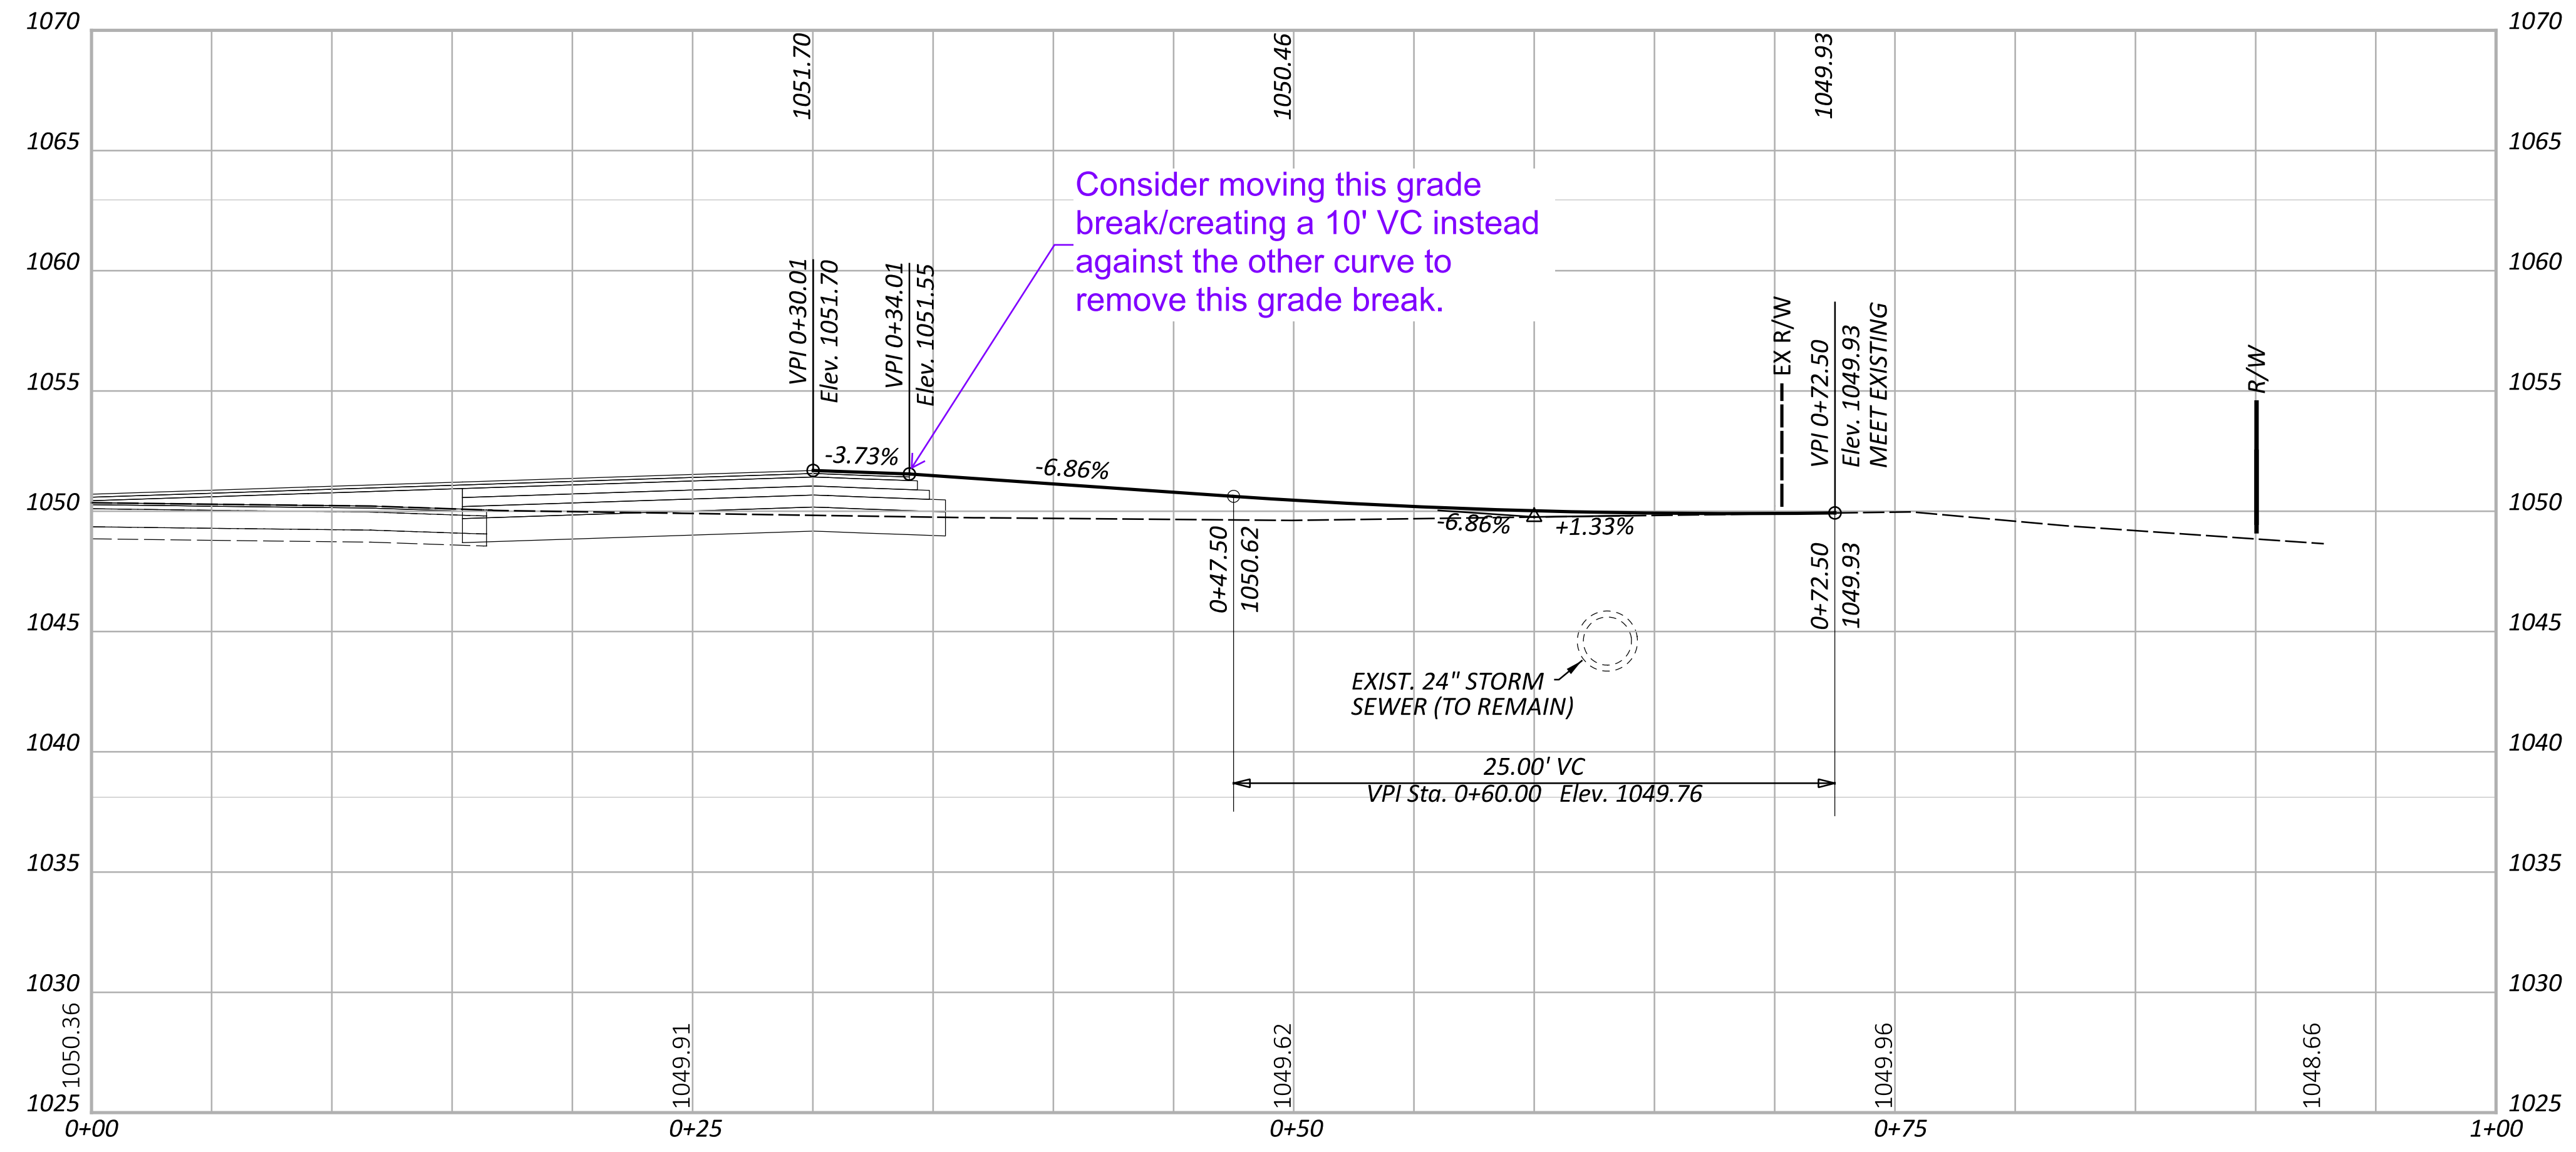


COMMERCIAL DRIVE - RIGHT
 BLUEGRASS BLVD - STA 189+30.28

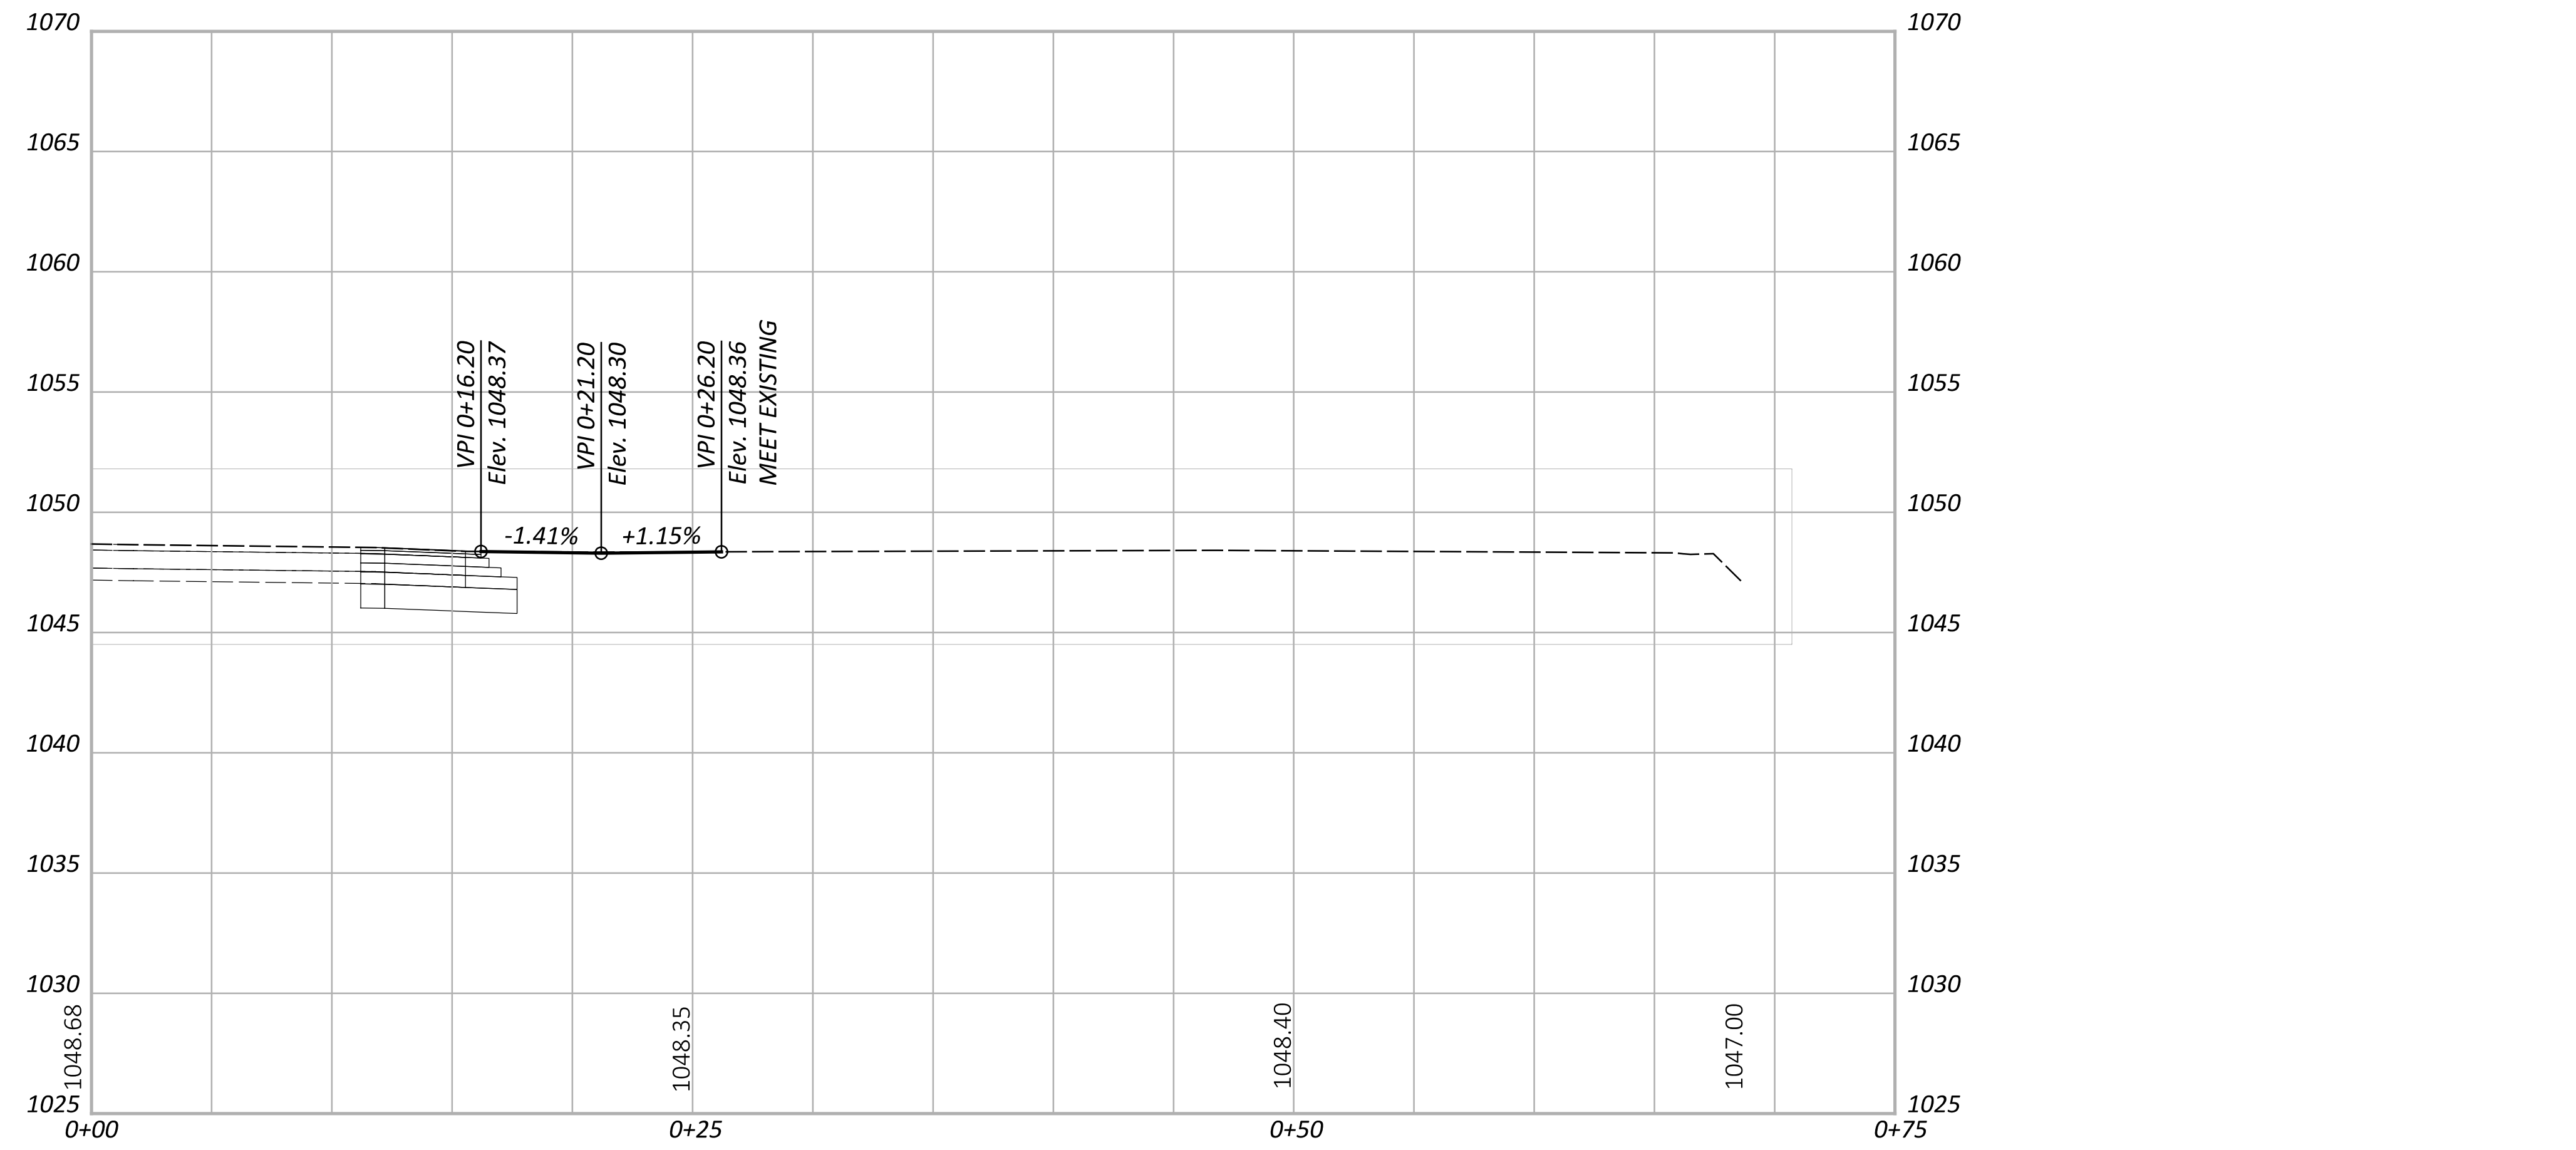


COMMERCIAL DRIVE - RIGHT
 BLUEGRASS BLVD - STA 201+33.67

DRIVE PROFILES
 STA 189+30.28 BLUEGRASS BLVD / STA 201+33.67 BLUEGRASS BLVD


DESIGN AGENCY	
8350 E. KEMPER RD. SUITE B CINCINNATI, OH 45249 513-469-1600	
DESIGNER	
DPF	
REVIEWER	
DCJ MM-DD-YY	
PROJECT ID	
117955	
SHEET	TOTAL
P. 213	228

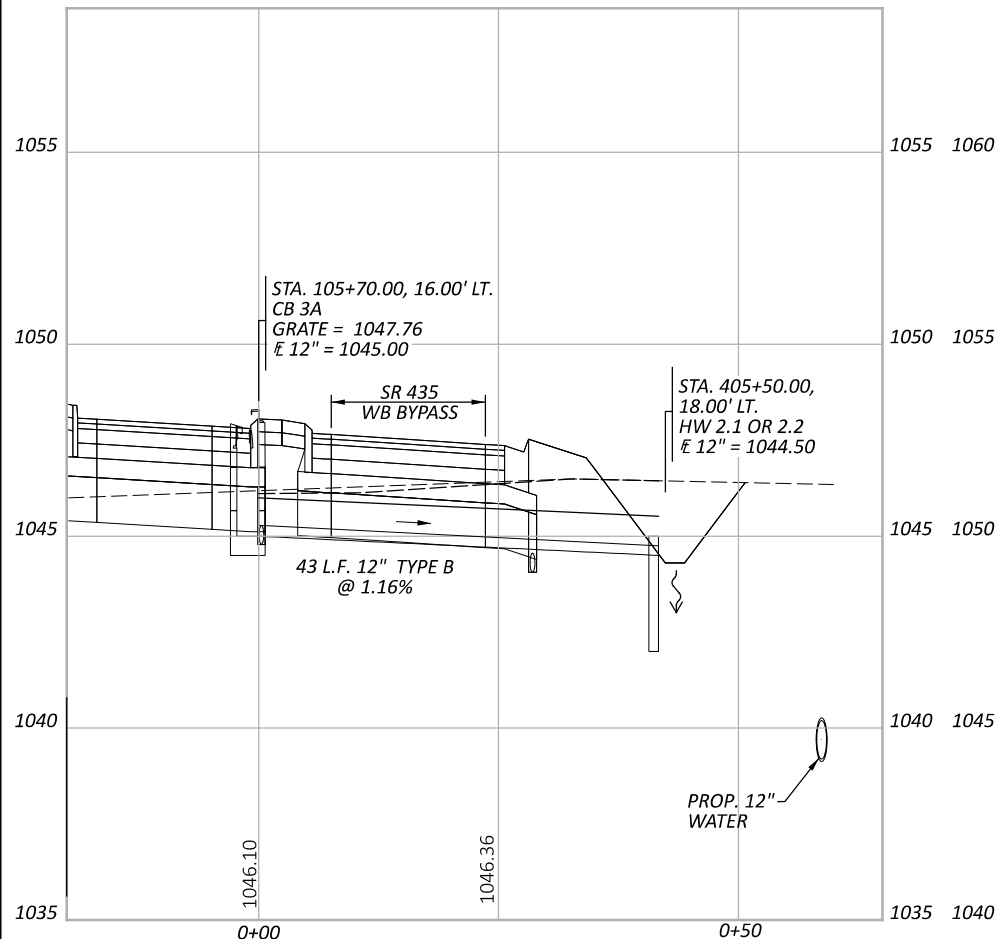


STA. 105+70 SR 435 WEST DEPARTURE
 STA. 405+50 SR 435 WEST BYPASS LANE

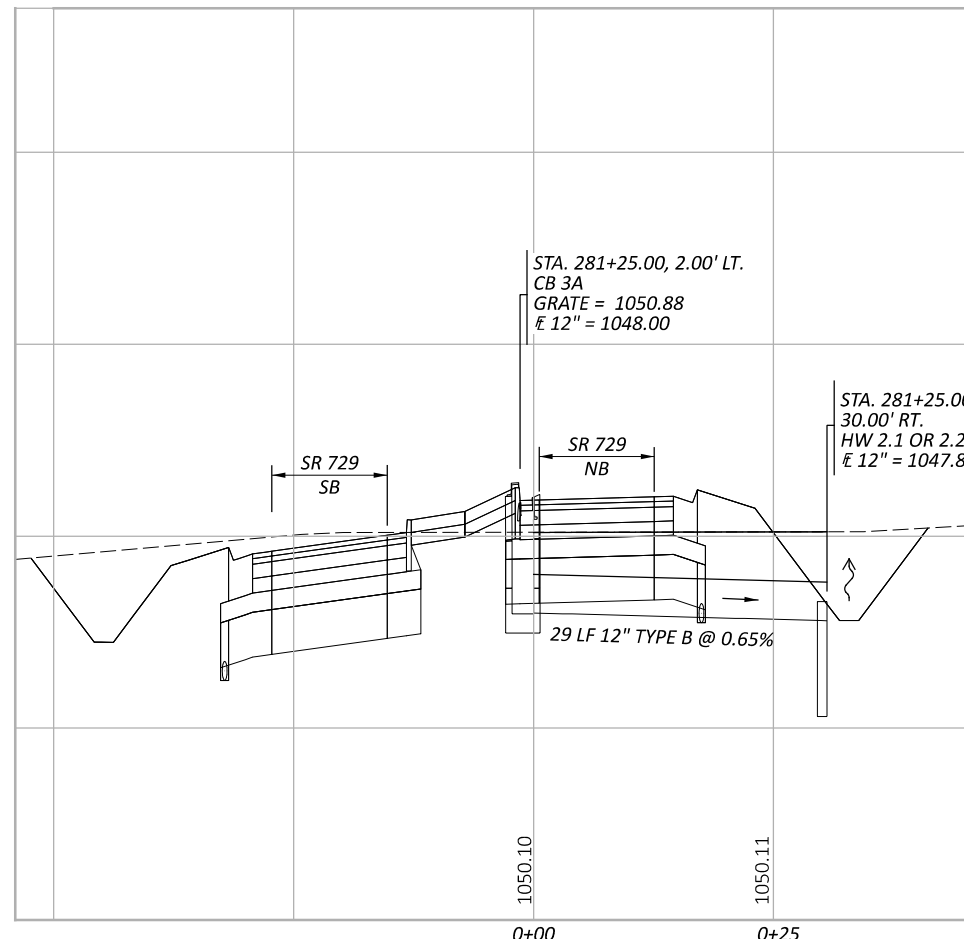


STA. 281+25 - SR 729

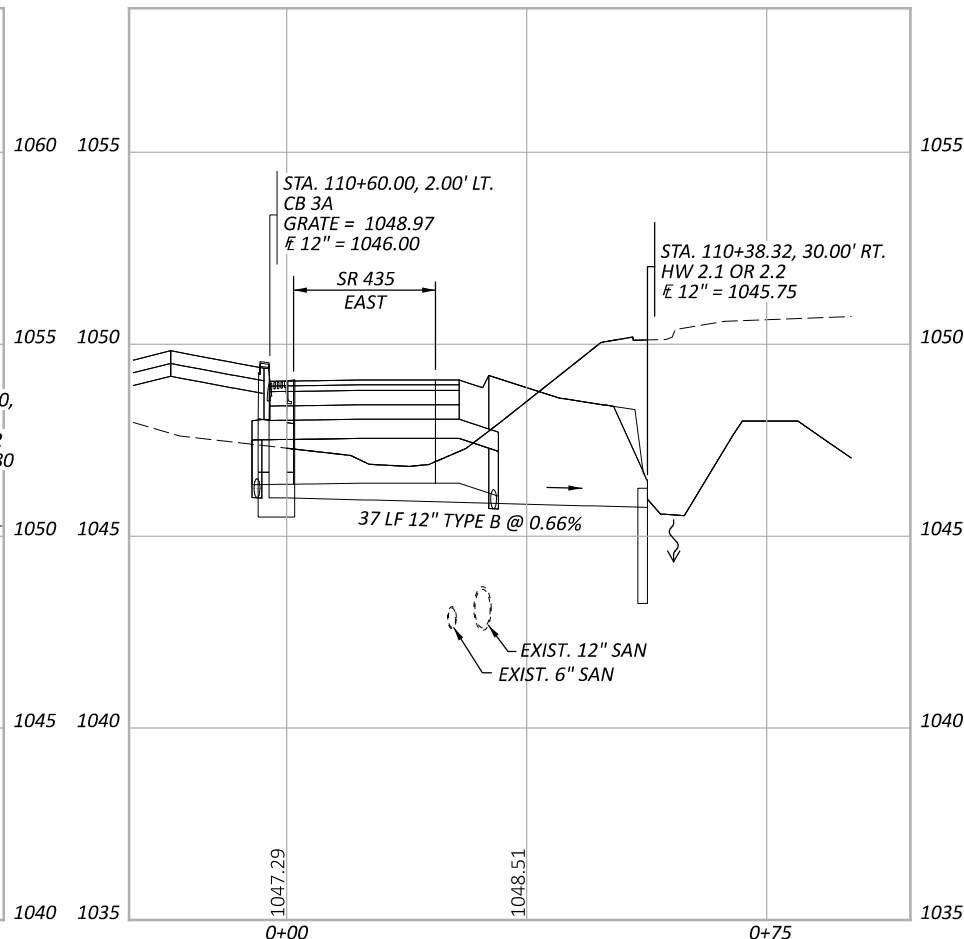



STA. 110+60 SR 435 EAST DEPARTURE

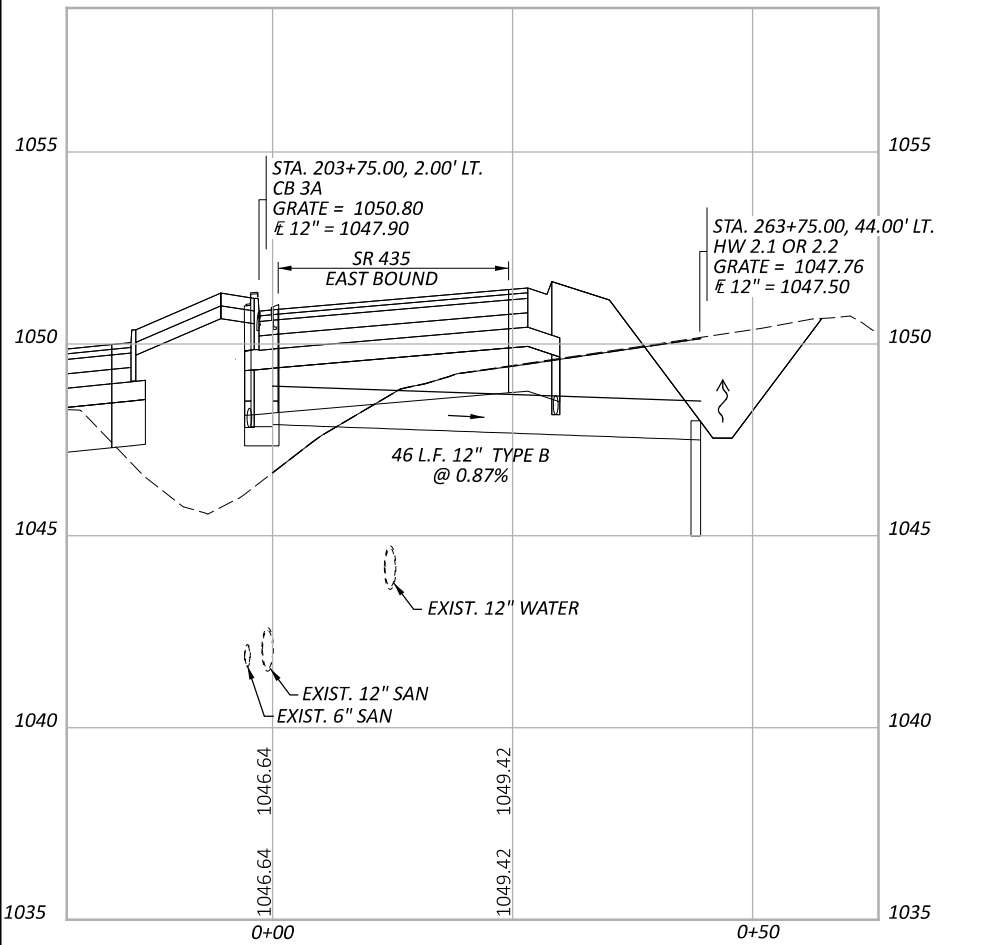

STA. 203+75 - SR 435 WEST RAB APPROACH

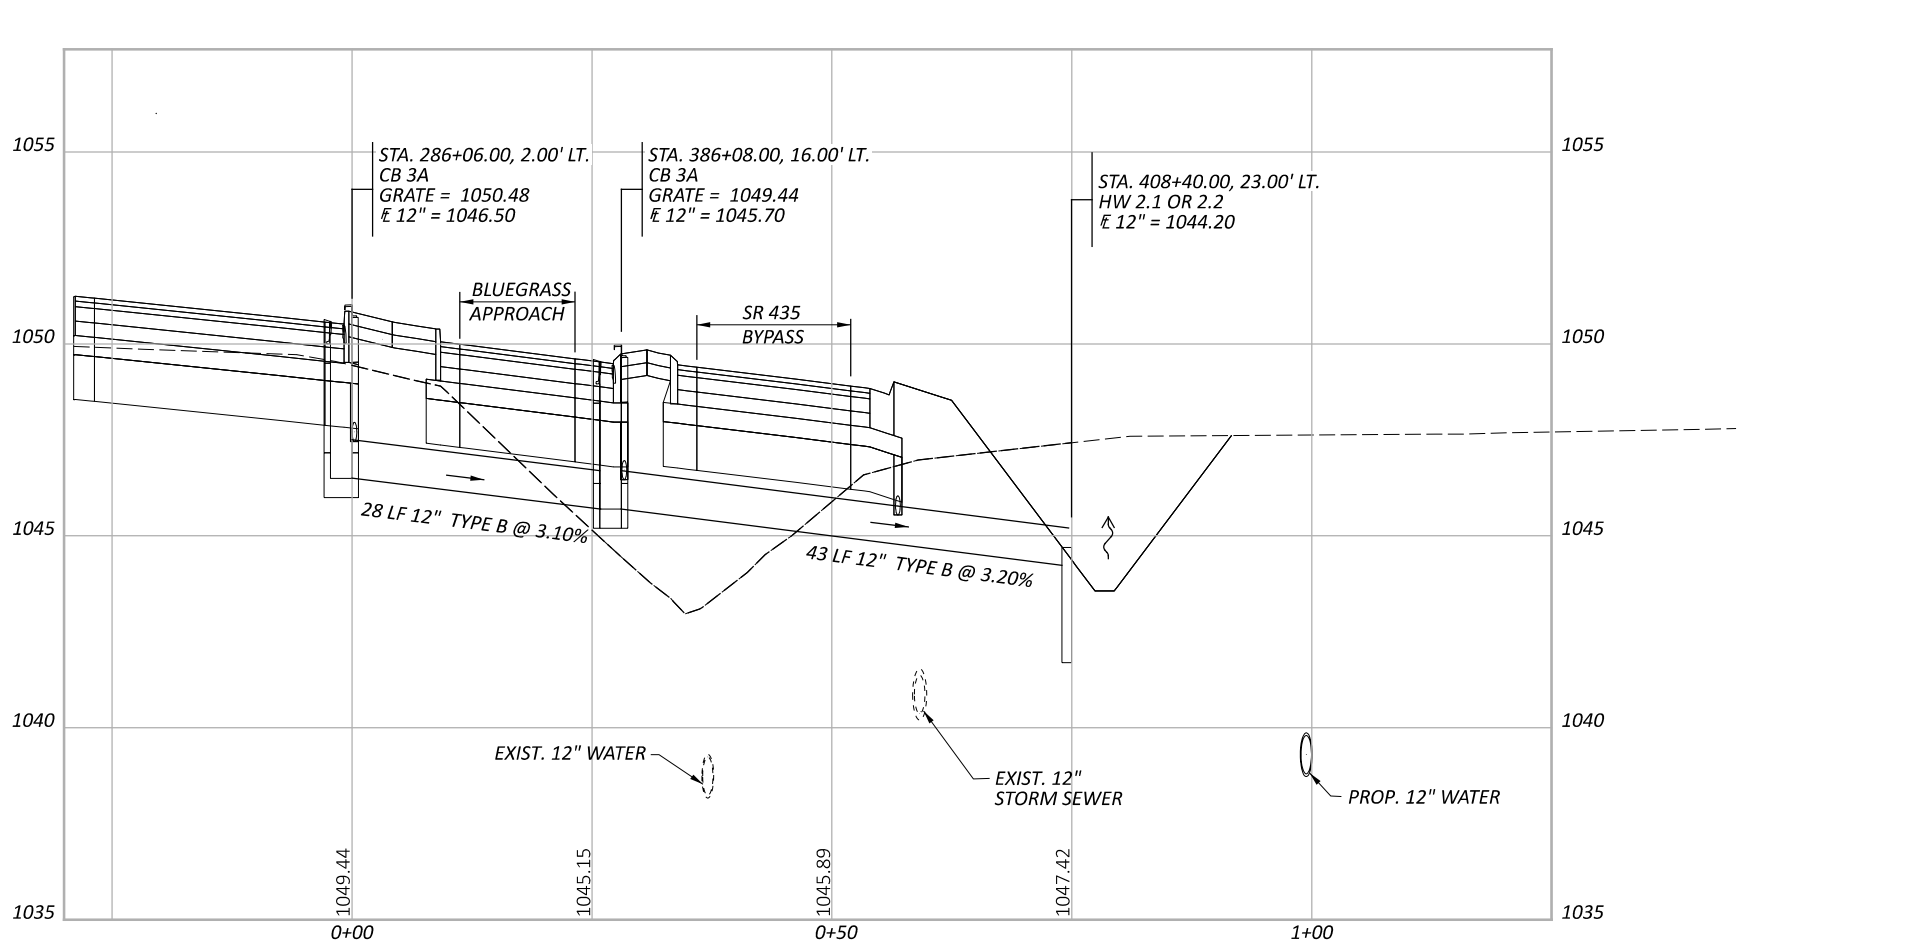


STA. 286+06 BLUE GRASS DEPARTURE / STA. 386+08 BLUE GRASS APPROACH

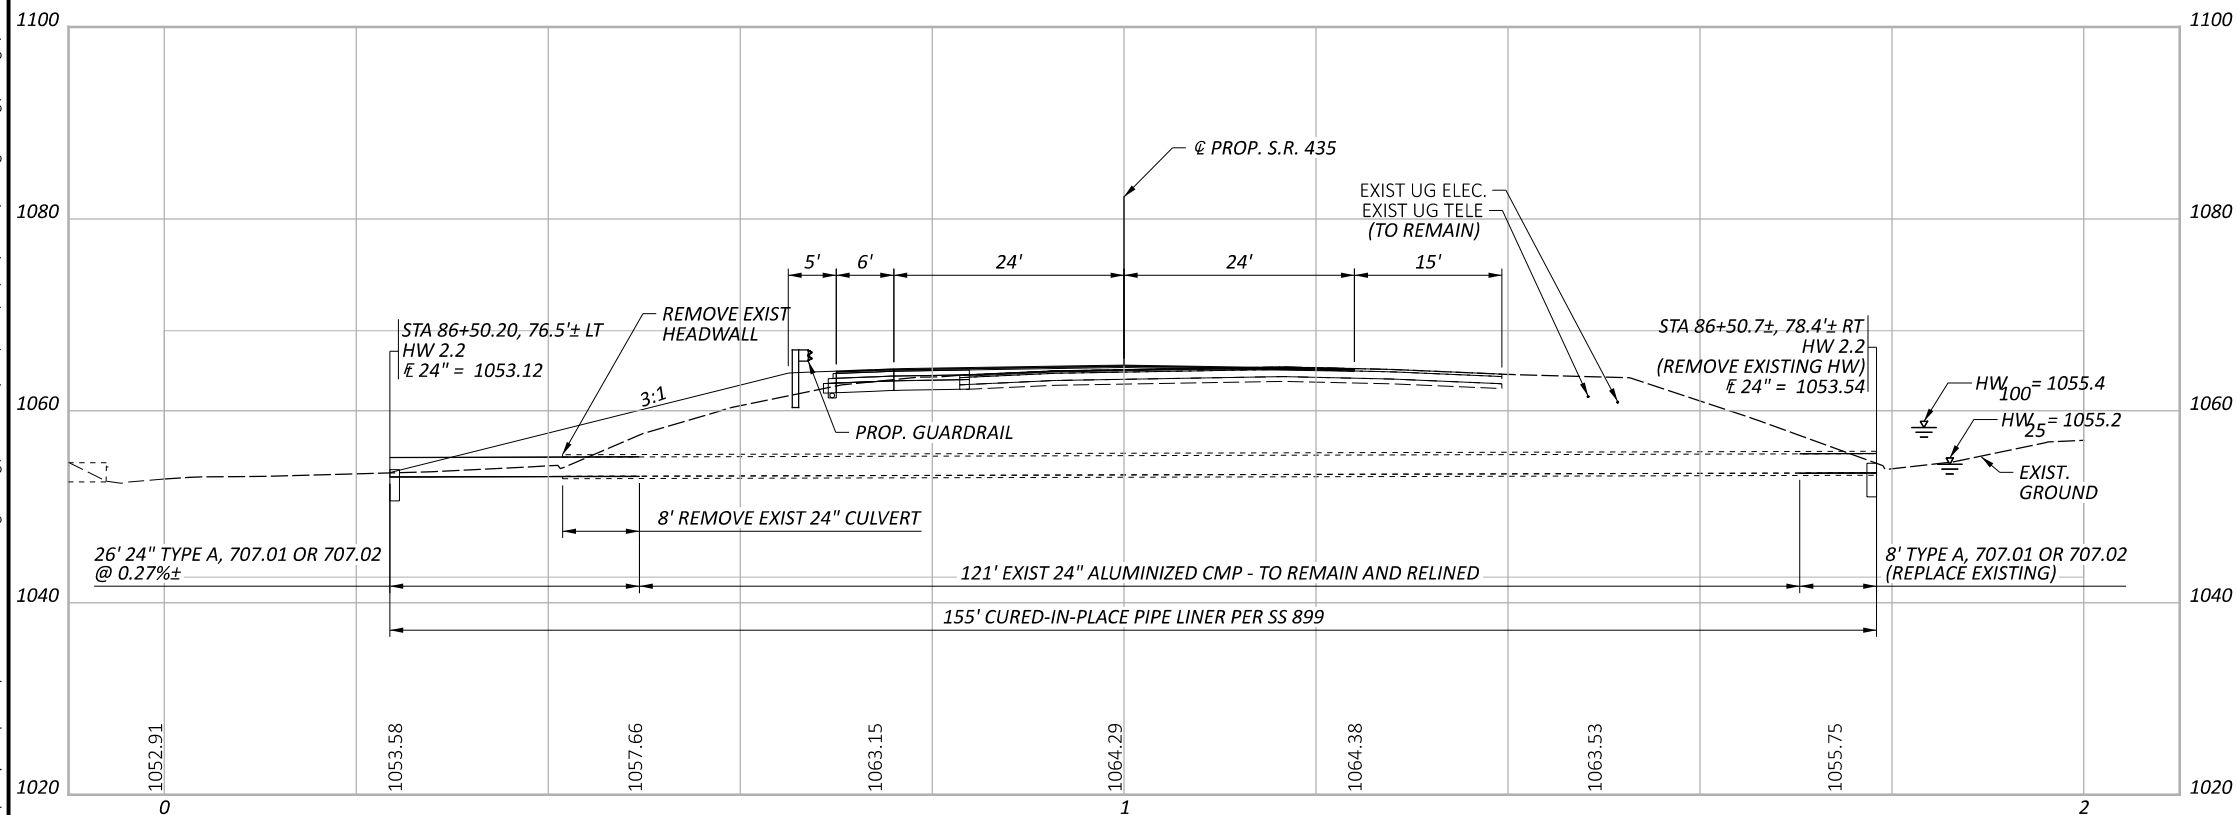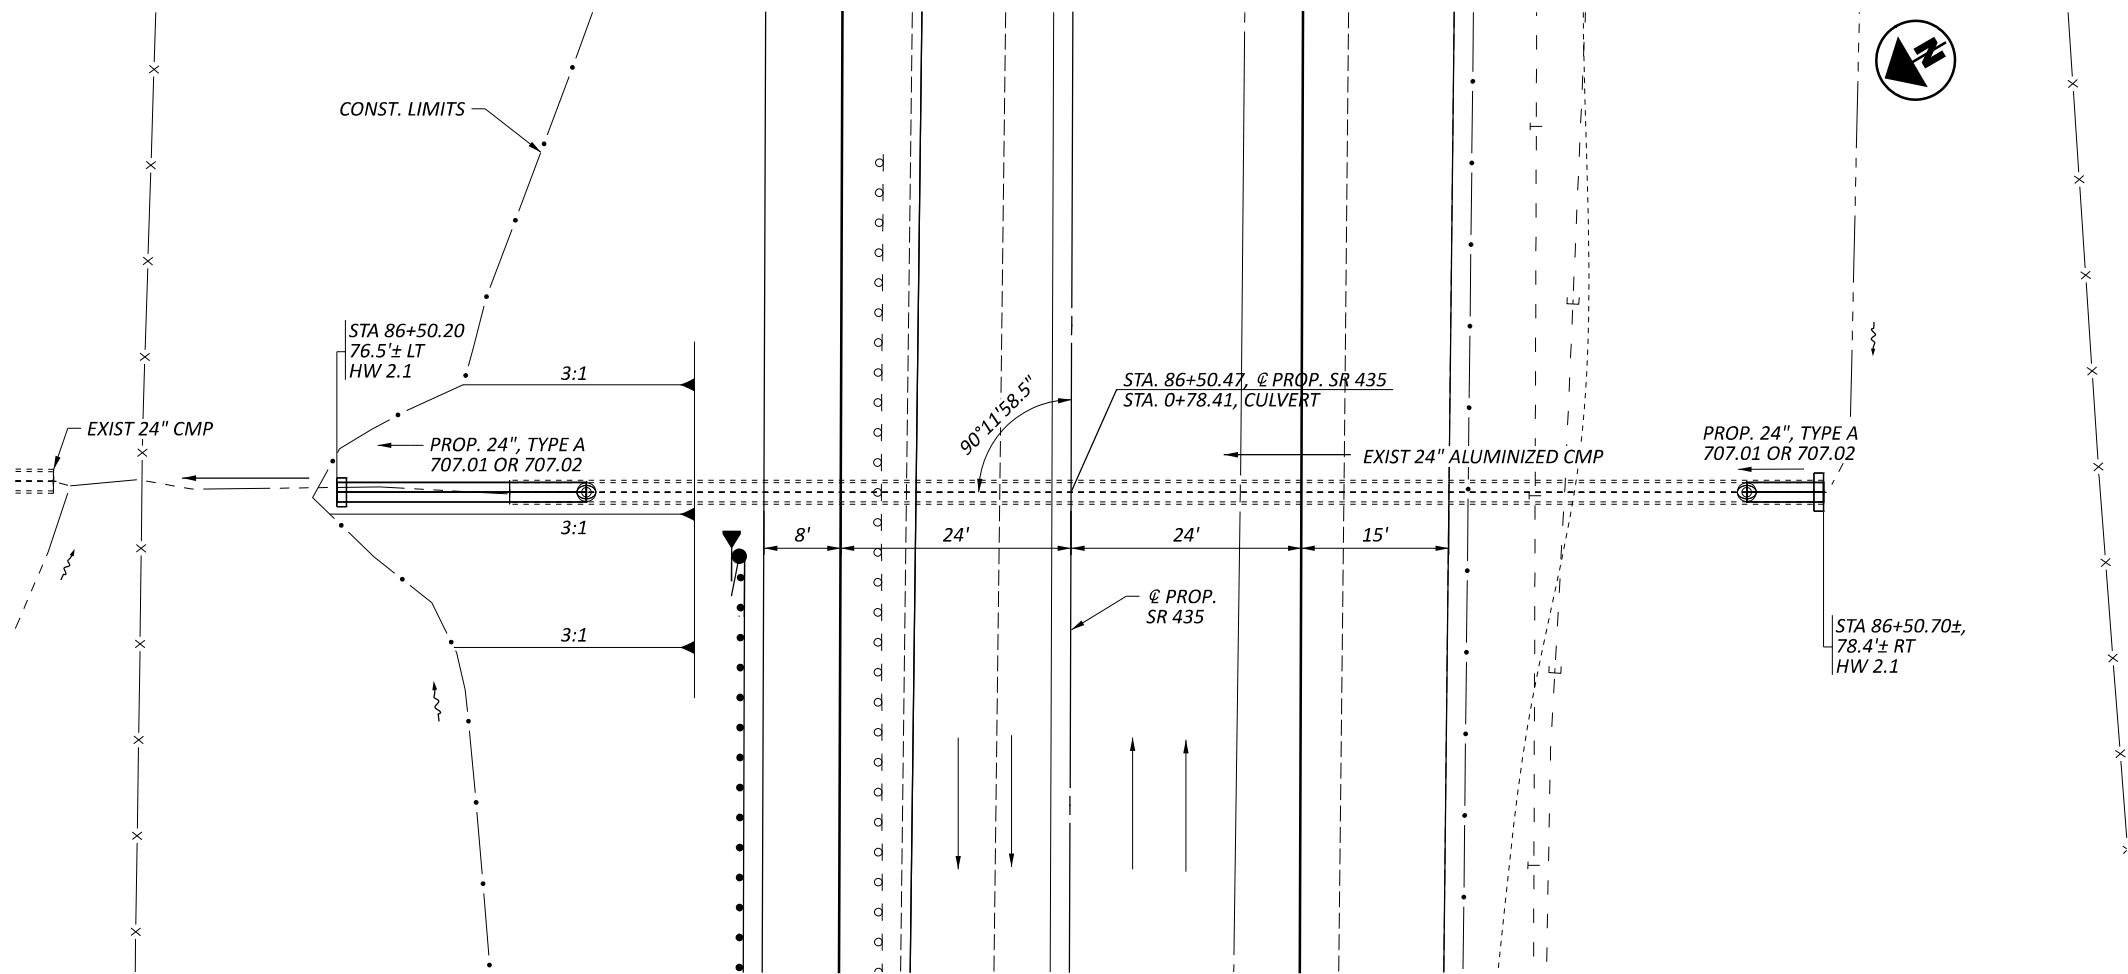

HYDRAULIC DATA		
DRAINAGE AREA =	4 ACRES	
Q (25) =	10.1 CFS	V (25) = 5.5 FT/S
Q (100) =	11.9 CFS	V (100) = 5.8 FT/S
ORDINARY HIGH WATER MARK:	FT	
DESIGN SERVICE LIFE:	75 YEARS	
ABRASION LEVEL:	2	
pH:	7.5	
HW (25) =	1055.2 FT	
HW (100) =	1055.4 FT	

EXISTING CULVERT	
TYPE:	ALUMINIZED CMP
SIZE:	24"
SKEW:	90°11'58.5"
ALIGNMENT:	TANGENT
DATE BUILT:	2001
CONDITION:	7
CFN:	1876628

PROPOSED CULVERT	
TYPE:	EXIST. 24" ALUMINIZED CMP RELINED, WITH 24" TYPE A EXTENSION/REPLACEMENT (707.01 OR 707.02)
SKEW:	90°11'58.5"
ALIGNMENT:	TANGENT
CFN:	1876628

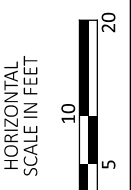

CULVERT PLAN AND PROFILE - FAY-435-2.440
 EXIST 24" ALUMINIZED CMP - EXTEND AND RELINE

DESIGN AGENCY

Palmer
ENGINEERING

8350 E. KEMPER RD.
SUITE B
CINCINNATI, OH 45249
513-469-1600



DESIGNER
DPF

REVIEWER
DCJ MM-DD-YY

PROJECT ID
117955

SUBSET	TOTAL
0	0


SHEET	TOTAL
P. 215	228

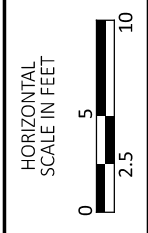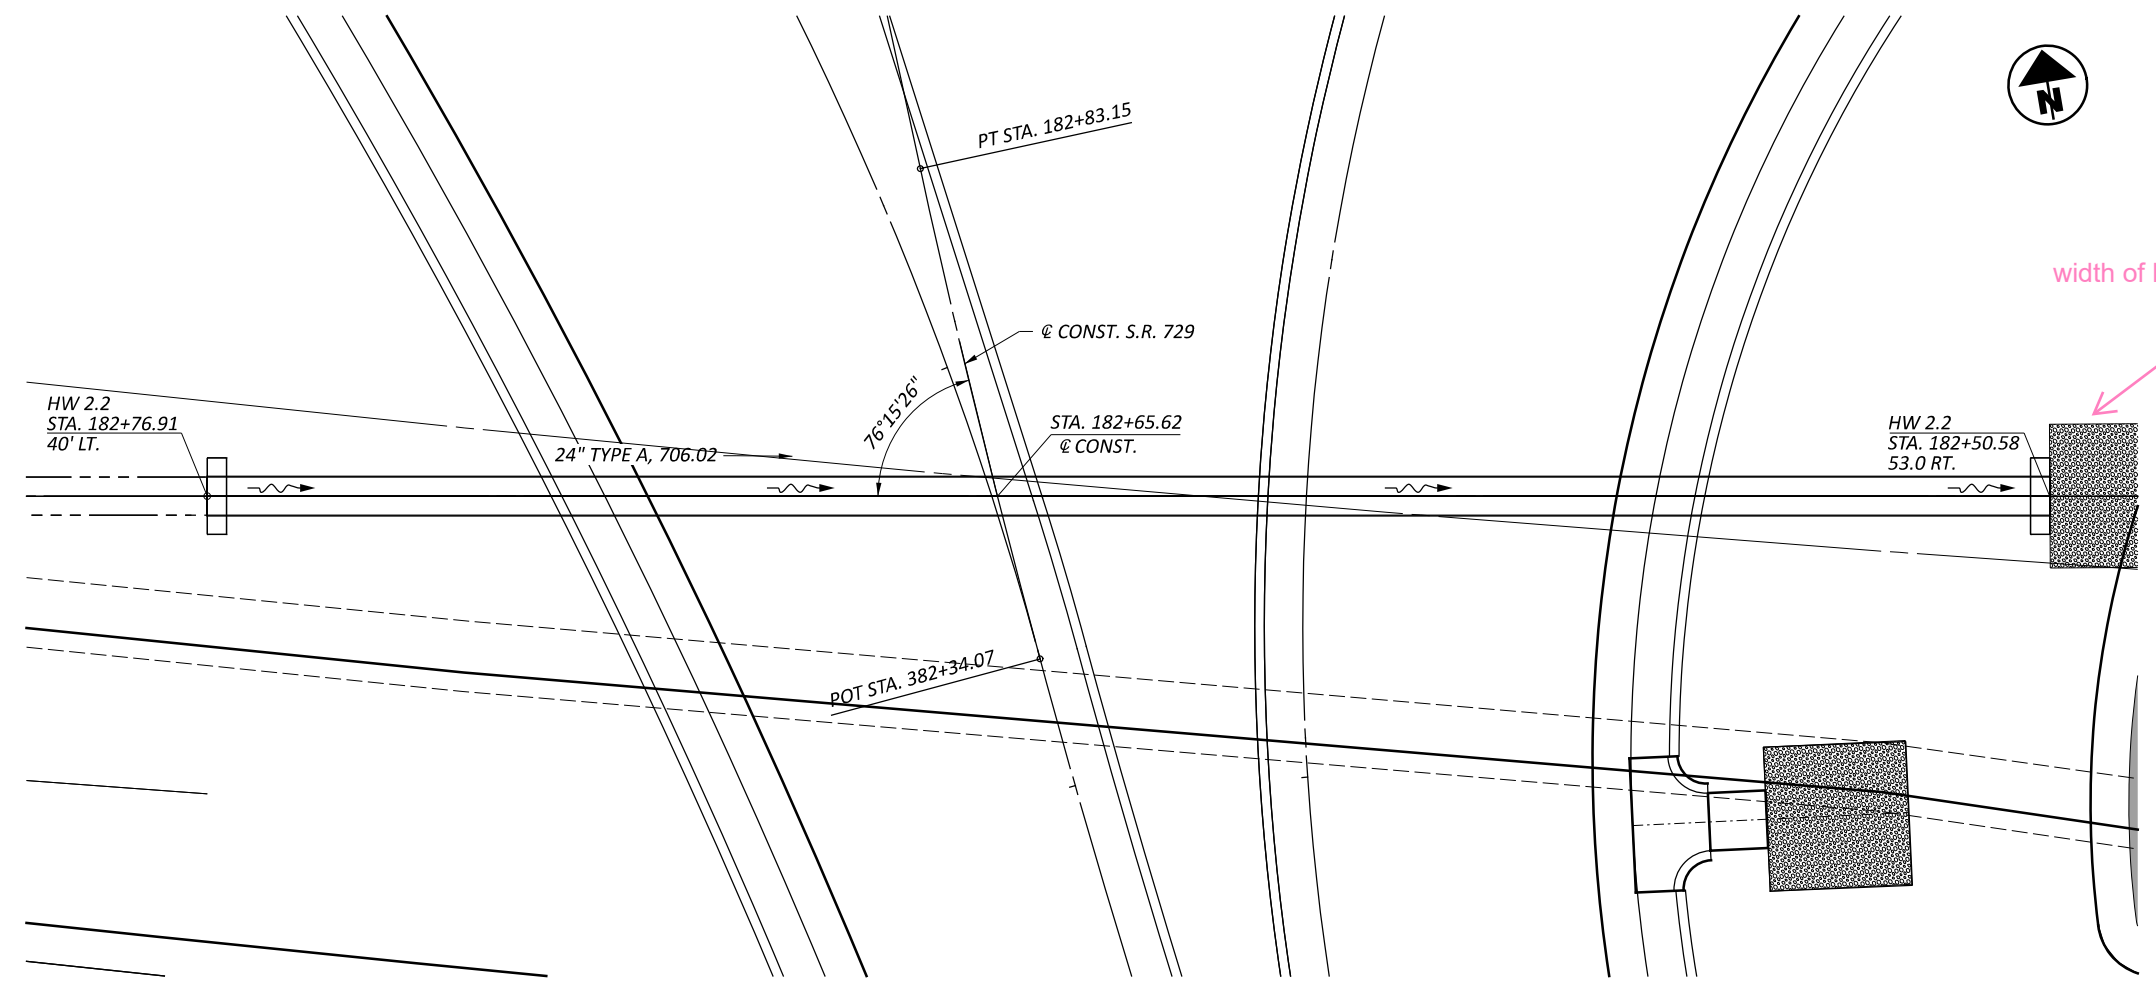


HYDRAULIC DATA		
DRAINAGE AREA =	25.89 ACRES	
Q (25) =	18.06 CFS	V (25) = 7.00 FT/S
Q (100) =	21.75 CFS	V (100) = 7.70 FT/S
ORDINARY HIGH WATER MARK:	1046.53 FT	
DESIGN SERVICE LIFE:	75 YEARS	
ABRASION LEVEL:	NON-ABRASIVE	
pH:	7.5	

PROPOSED CULVERT	
TYPE:	24" CULVERT
SKEW:	
ALIGNMENT:	
CFN:	T.B.D.

CULVERT PLAN AND PROFILE
SR 729 - PROPOSED 24" CULVERT


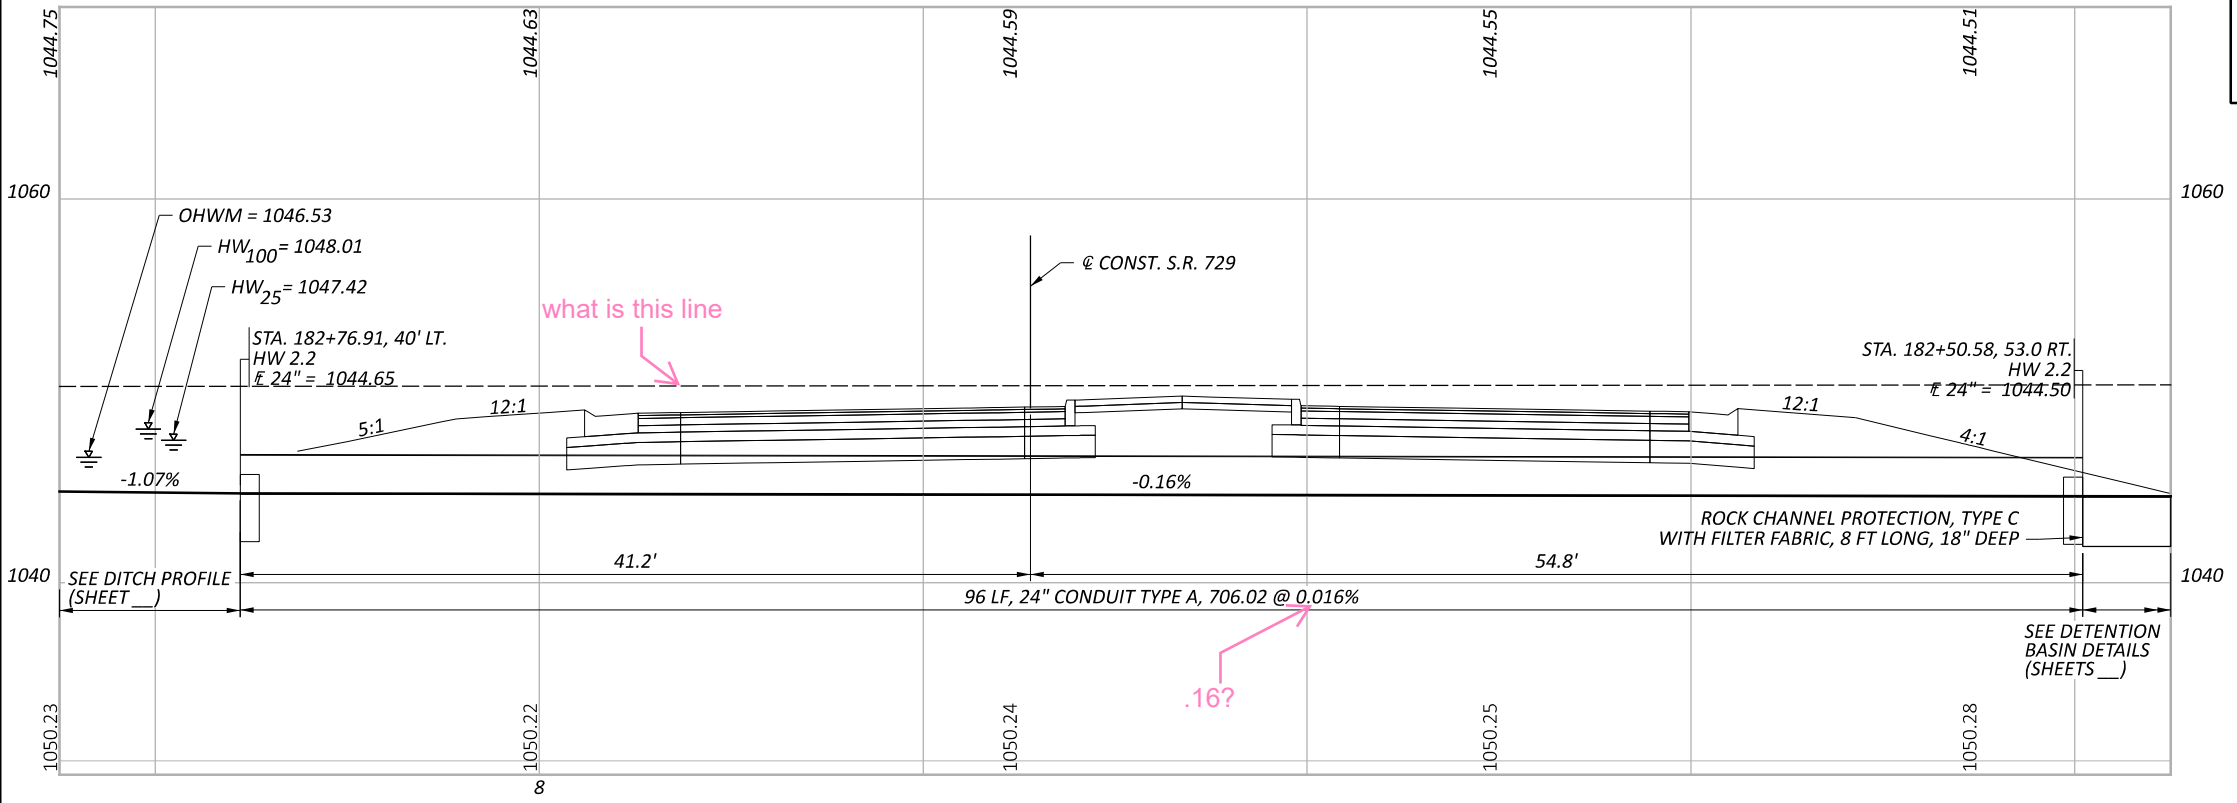


DESIGN AGENCY	Palmer ENGINEERING	
DESIGNER	DPF	
REVIEWER	DCJ MM-DD-YY	
PROJECT ID	117955	
SUBSET	0	TOTAL 0
SHEET	P. 216	TOTAL 228

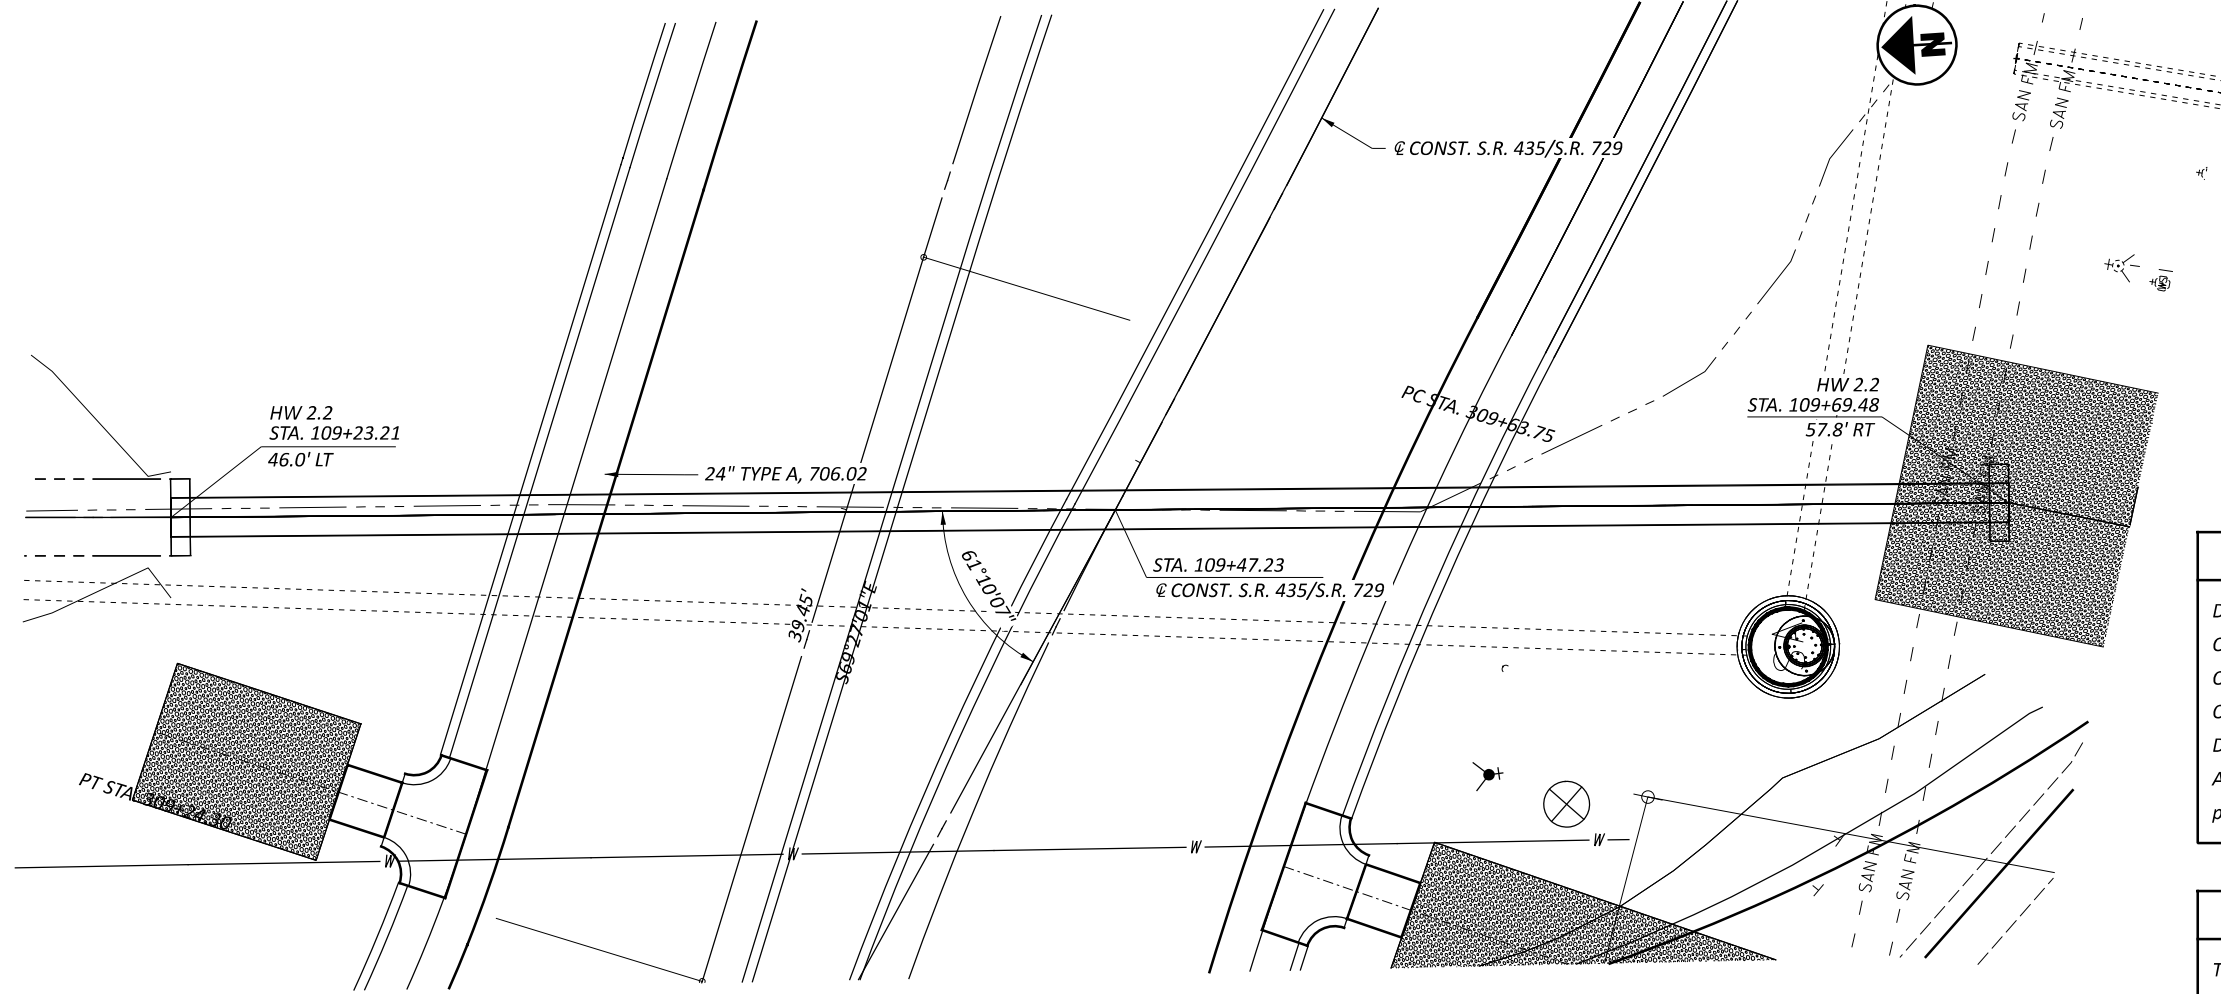

HYDRAULIC DATA		
DRAINAGE AREA =	27 ACRES	
Q (25) =	18.67 CFS	V (25) = 7.12 FT/S
Q (100) =	22.43 CFS	V (100) = 7.93 FT/S
ORDINARY HIGH WATER MARK:	1045.36 FT	
DESIGN SERVICE LIFE:	75 YEARS	
ABRASION LEVEL:	NON-ABRASIVE	
pH:	7.5	

PROPOSED CULVERT	
TYPE:	24" TYPE A, 706.02
SKEW:	61° 10' 07"
ALIGNMENT:	
CFN:	

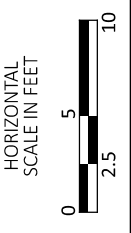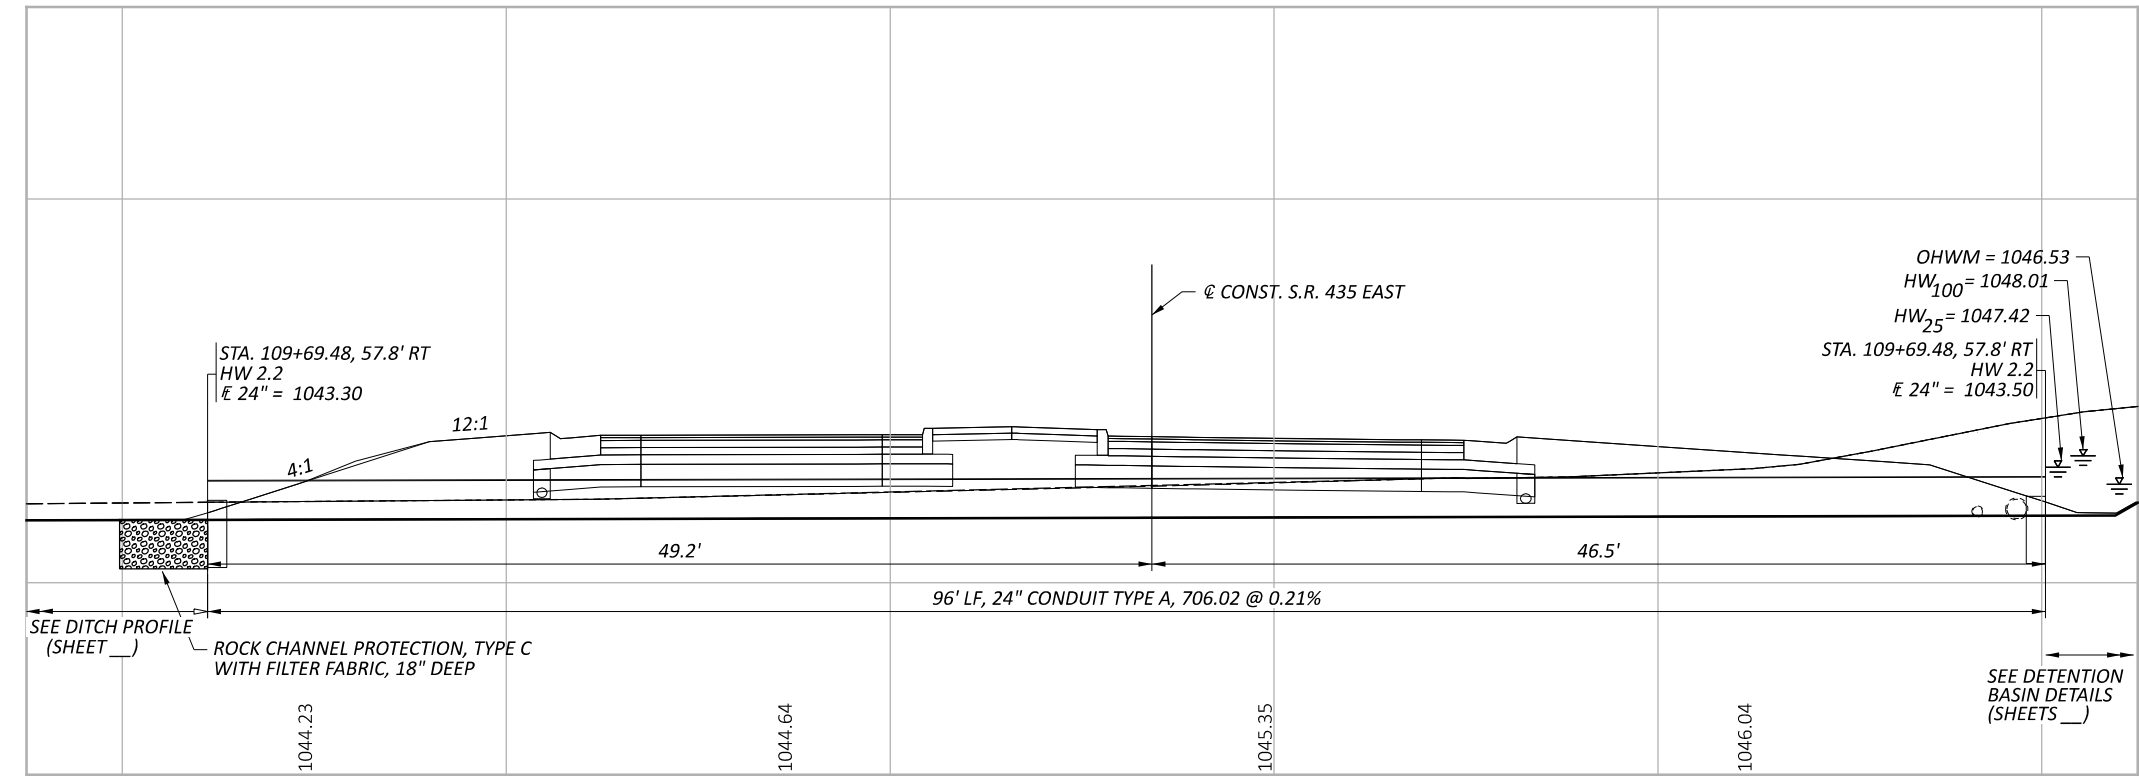

CULVERT PLAN AND PROFILE
 SR 435 EAST - PROPOSED 24" CULVERT

DESIGN AGENCY
Palmer
 ENGINEERING
 8350 E. KEMPER RD.
 SUITE B
 CINCINNATI, OH 45249
 513-469-1600




DESIGNER
 DPF

REVIEWER
 DCJ MM-DD-YY

PROJECT ID
 117955




SUBSET	TOTAL
0	0

SHEET	TOTAL
P. 217	228

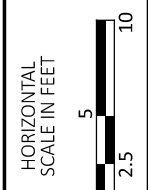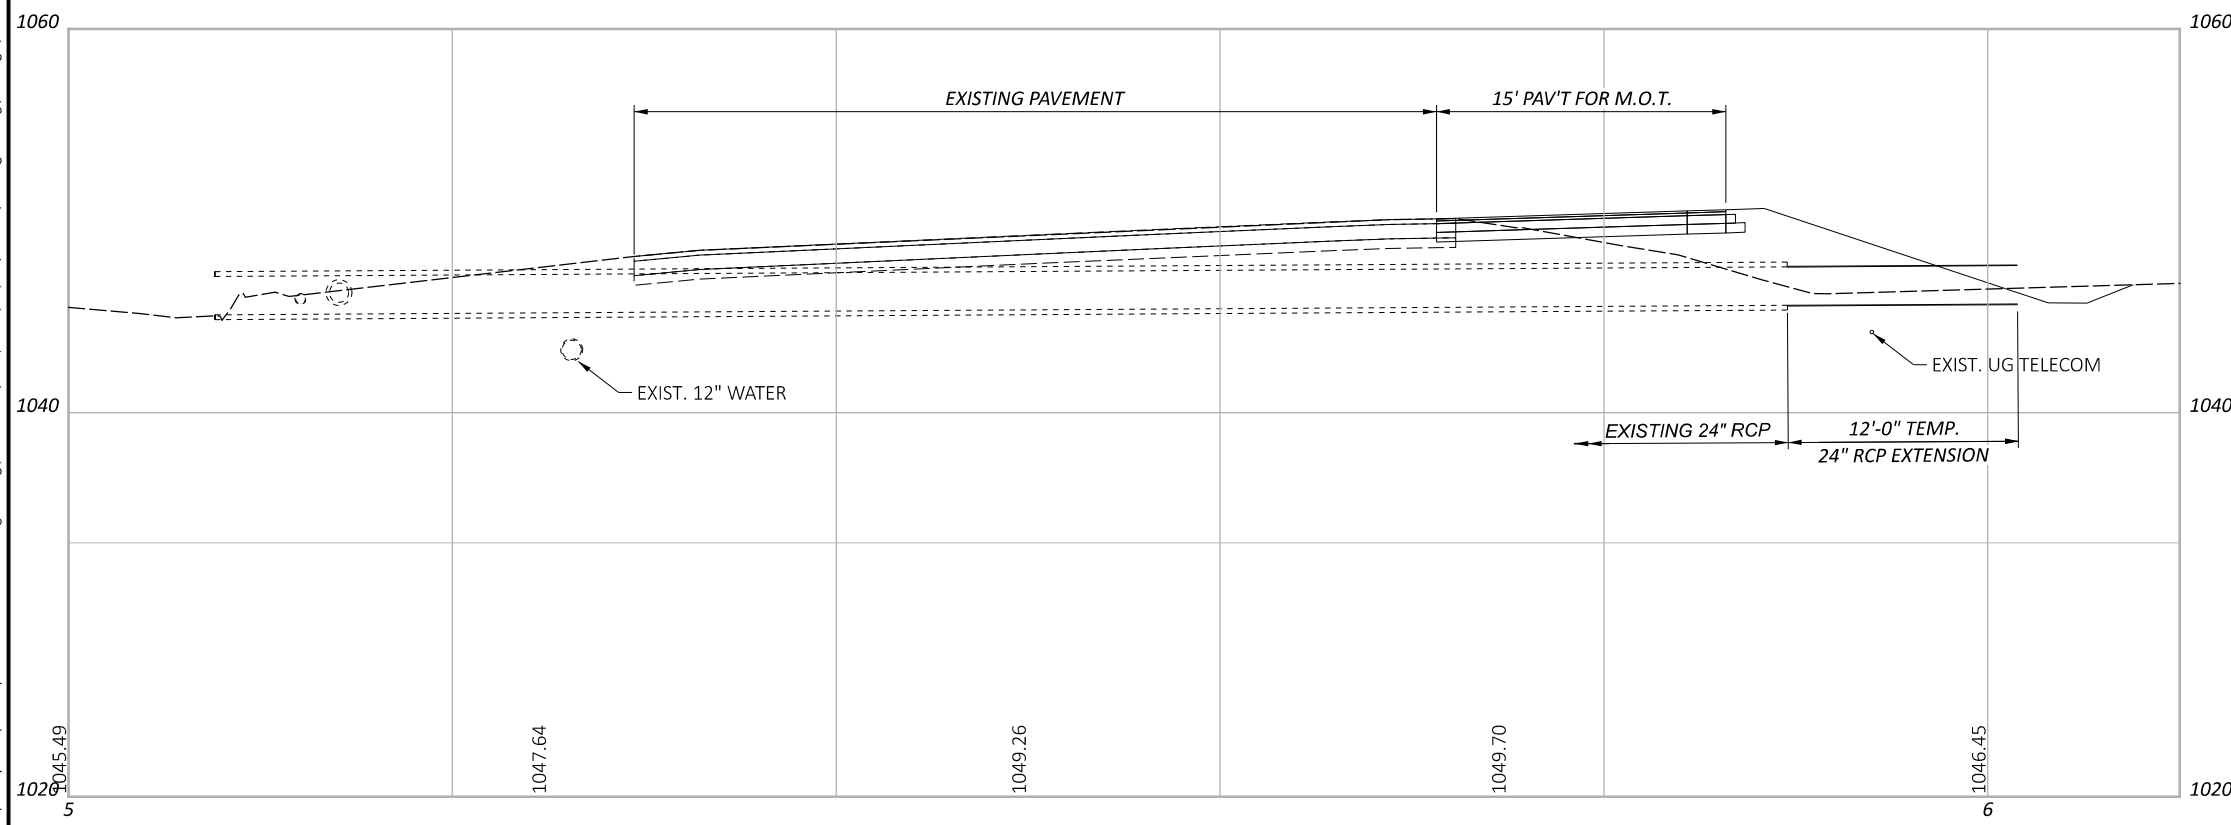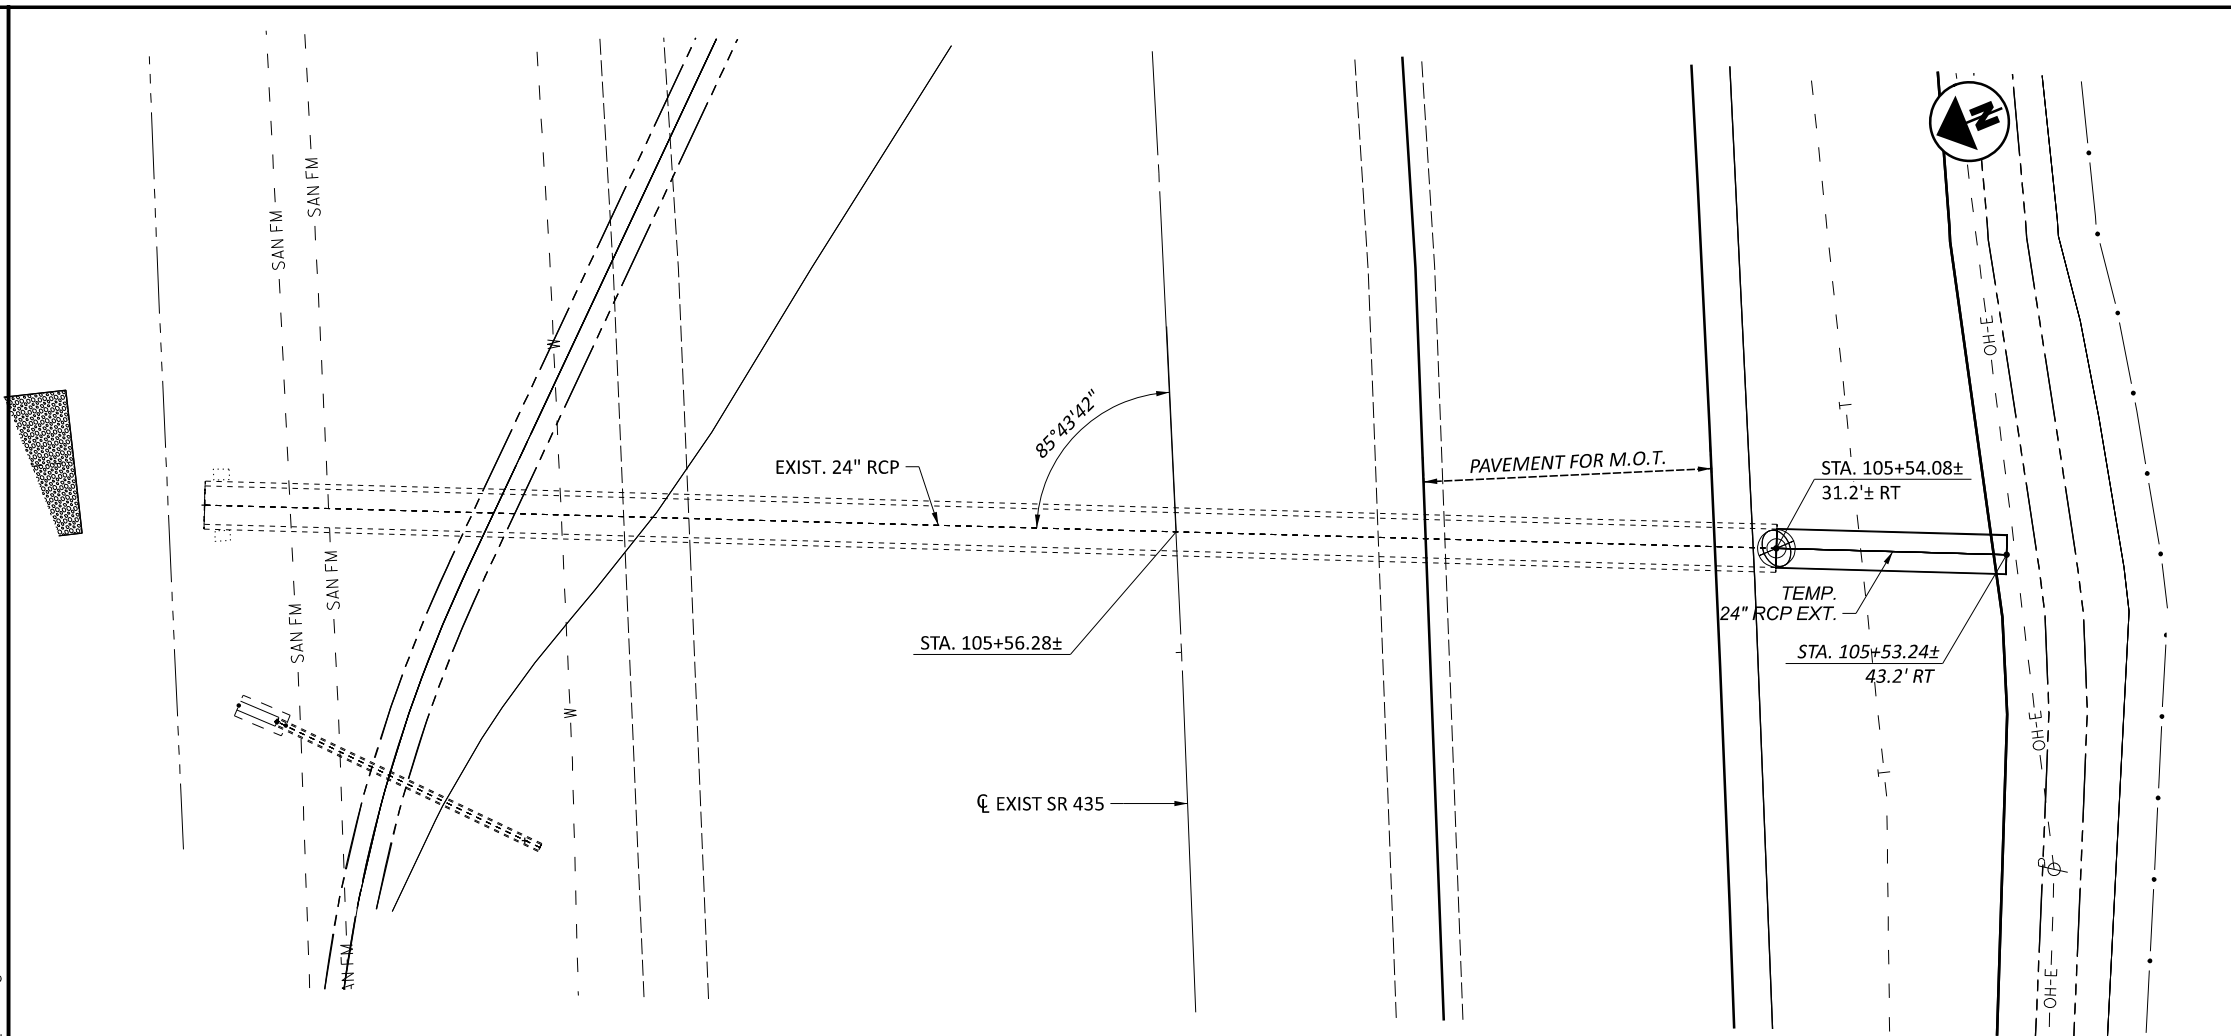




CULVERT PLAN AND PROFILE - SR 435 EXIST STA. ___ + ___
 EXIST 24" RCP - TEMPORARY EXTENSION

DESIGN AGENCY	
 8350 E. KEMPER RD. SUITE B CINCINNATI, OH 45249 513-469-1600	
DESIGNER	
DPF	
REVIEWER	
DCJ MM-DD-YY	
PROJECT ID	
117955	
SUBSET	TOTAL
0	0
SHEET	TOTAL
P. 218	228

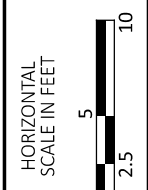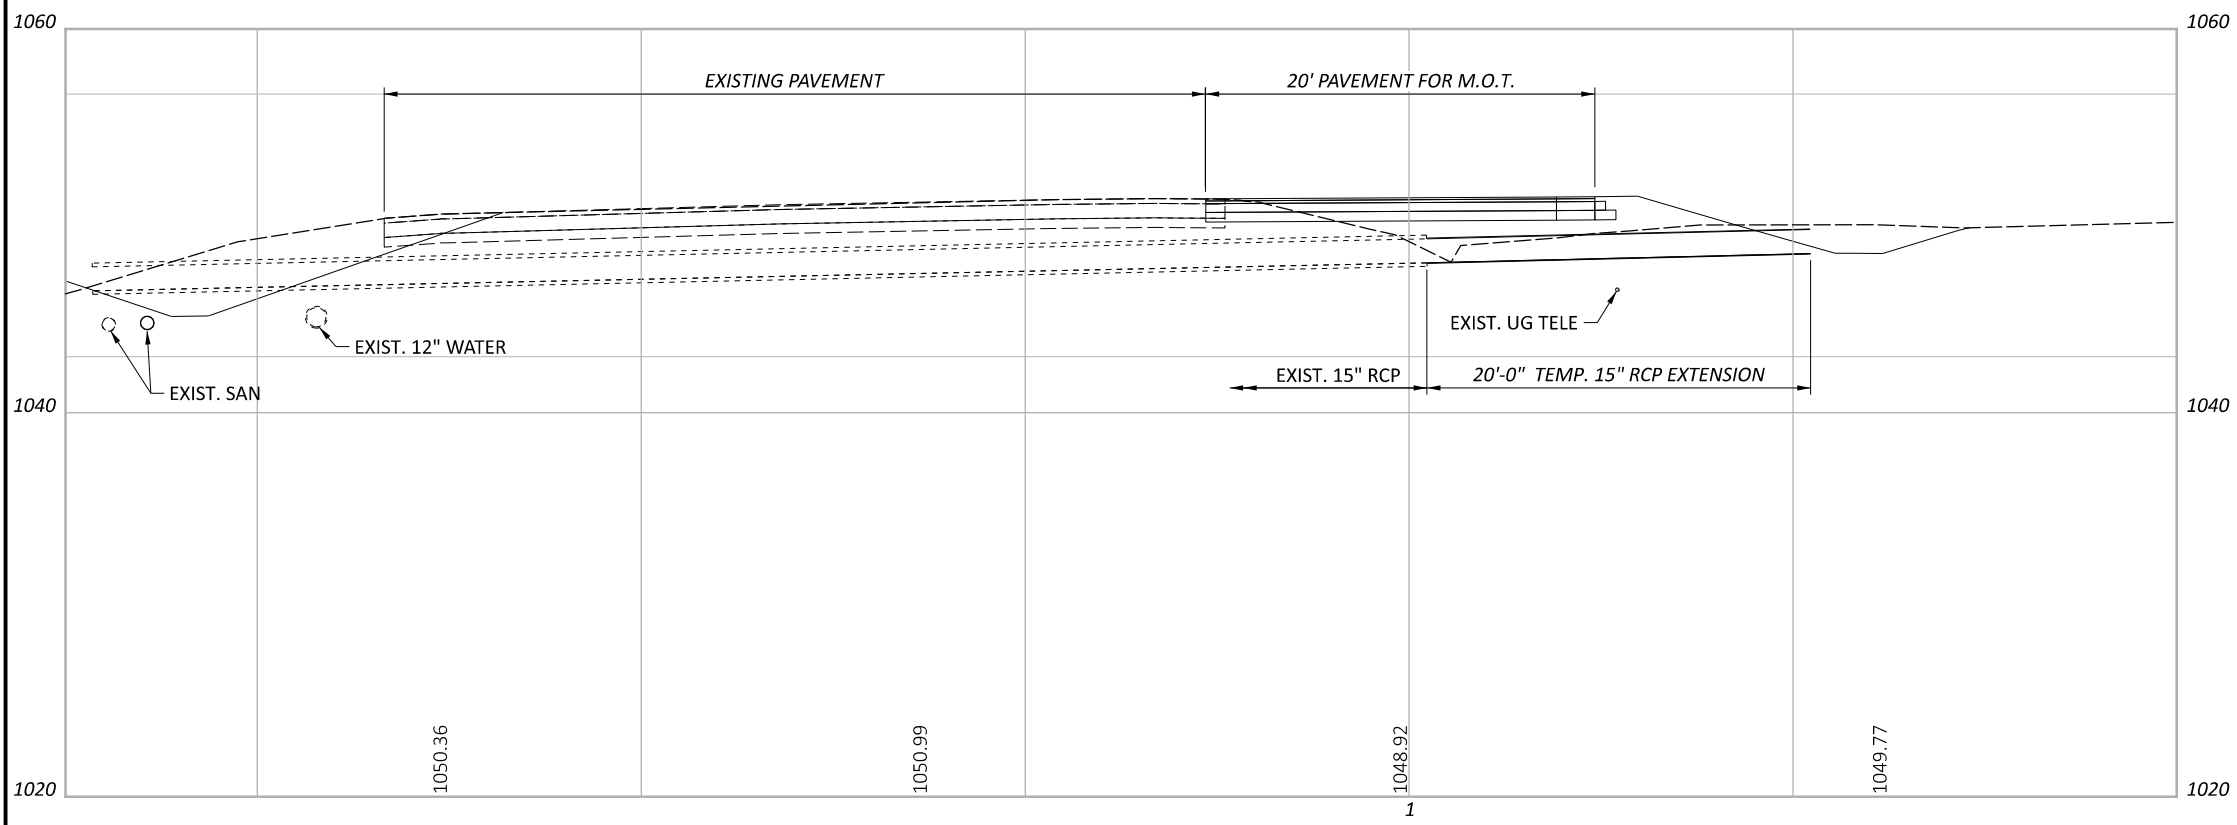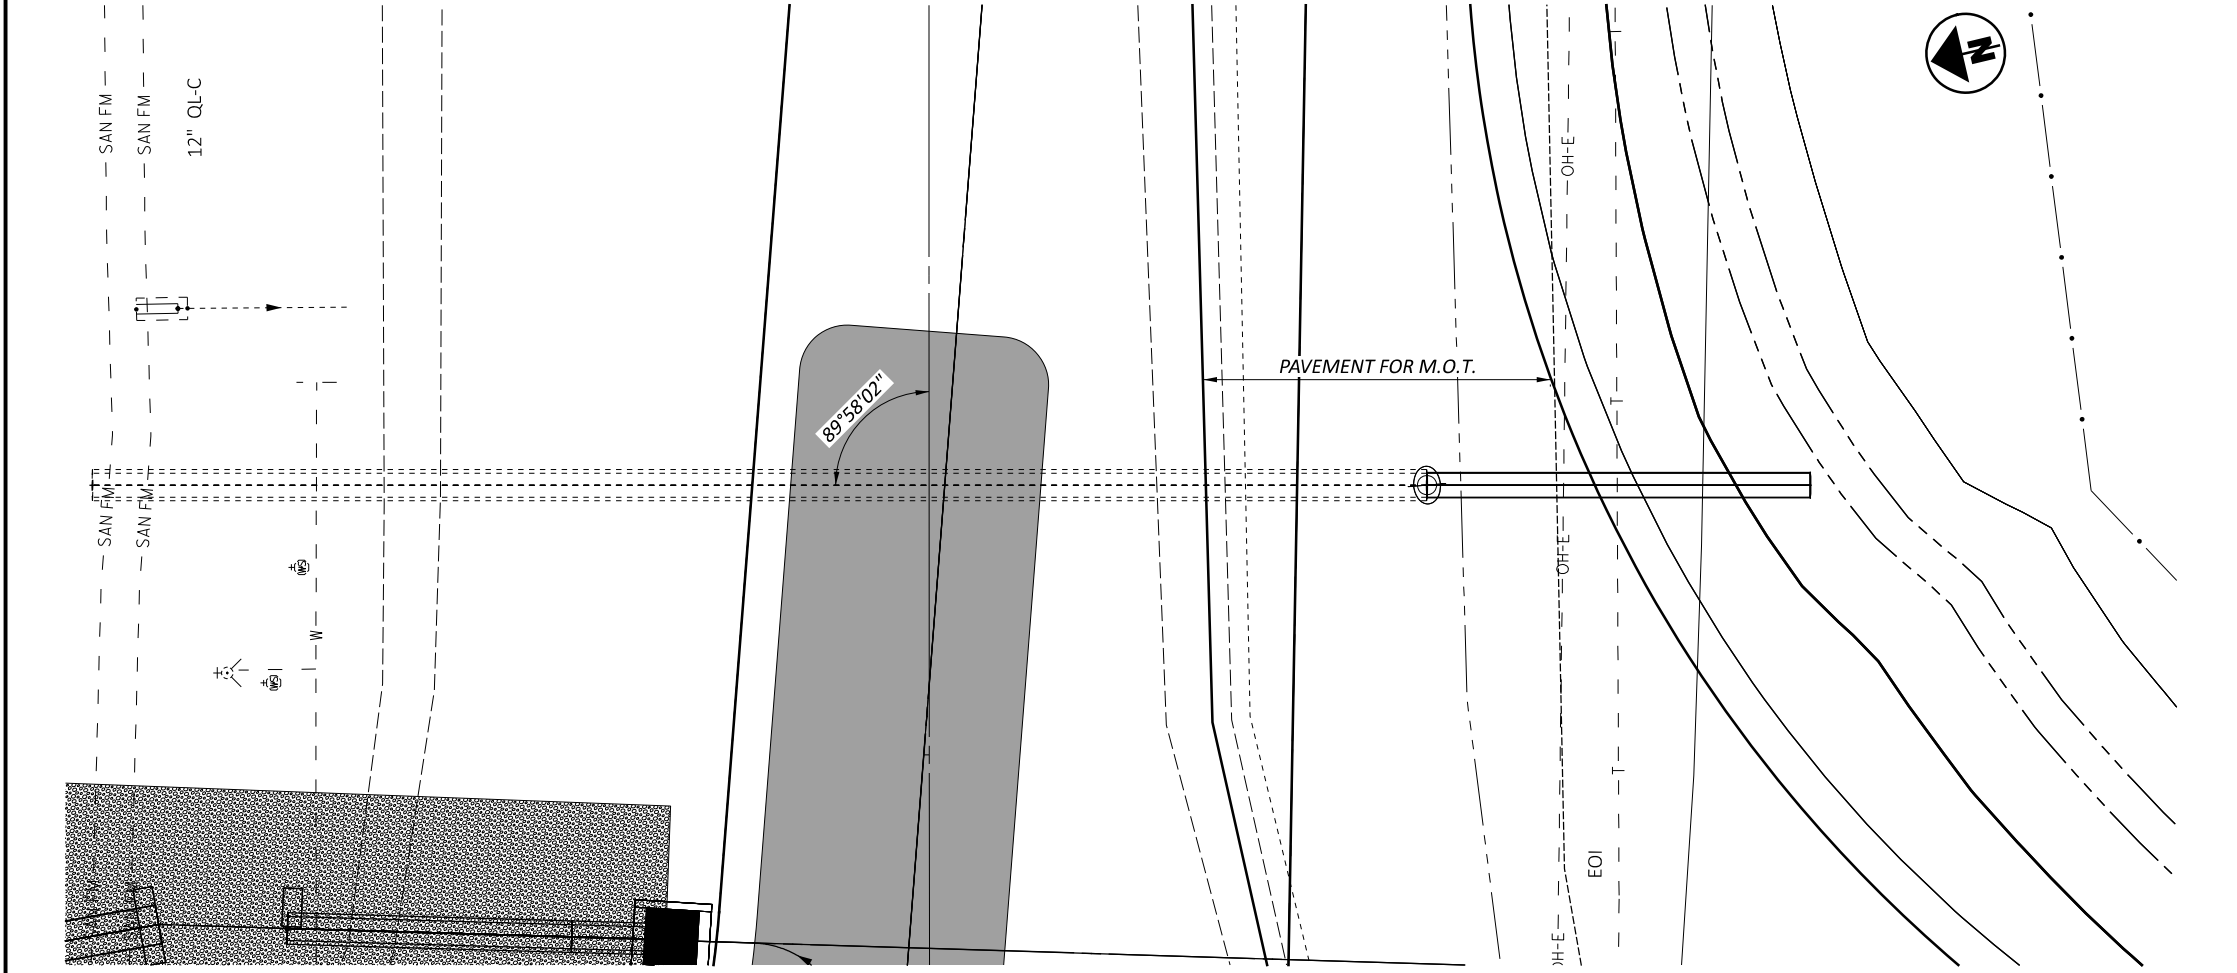



CULVERT PLAN AND PROFILE - SR 435 EXIST STA. +
 EXIST 15" RCP - TEMPORARY EXTENSION

DESIGN AGENCY	
 8350 E. KEMPER RD. SUITE B CINCINNATI, OH 45249 513-469-1600	
DESIGNER	
DPF	
REVIEWER	
DCJ MM-DD-YY	
PROJECT ID	
117955	
SUBSET	TOTAL
0	0
SHEET	TOTAL
P. 219	228

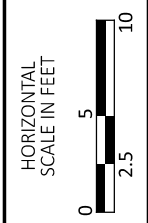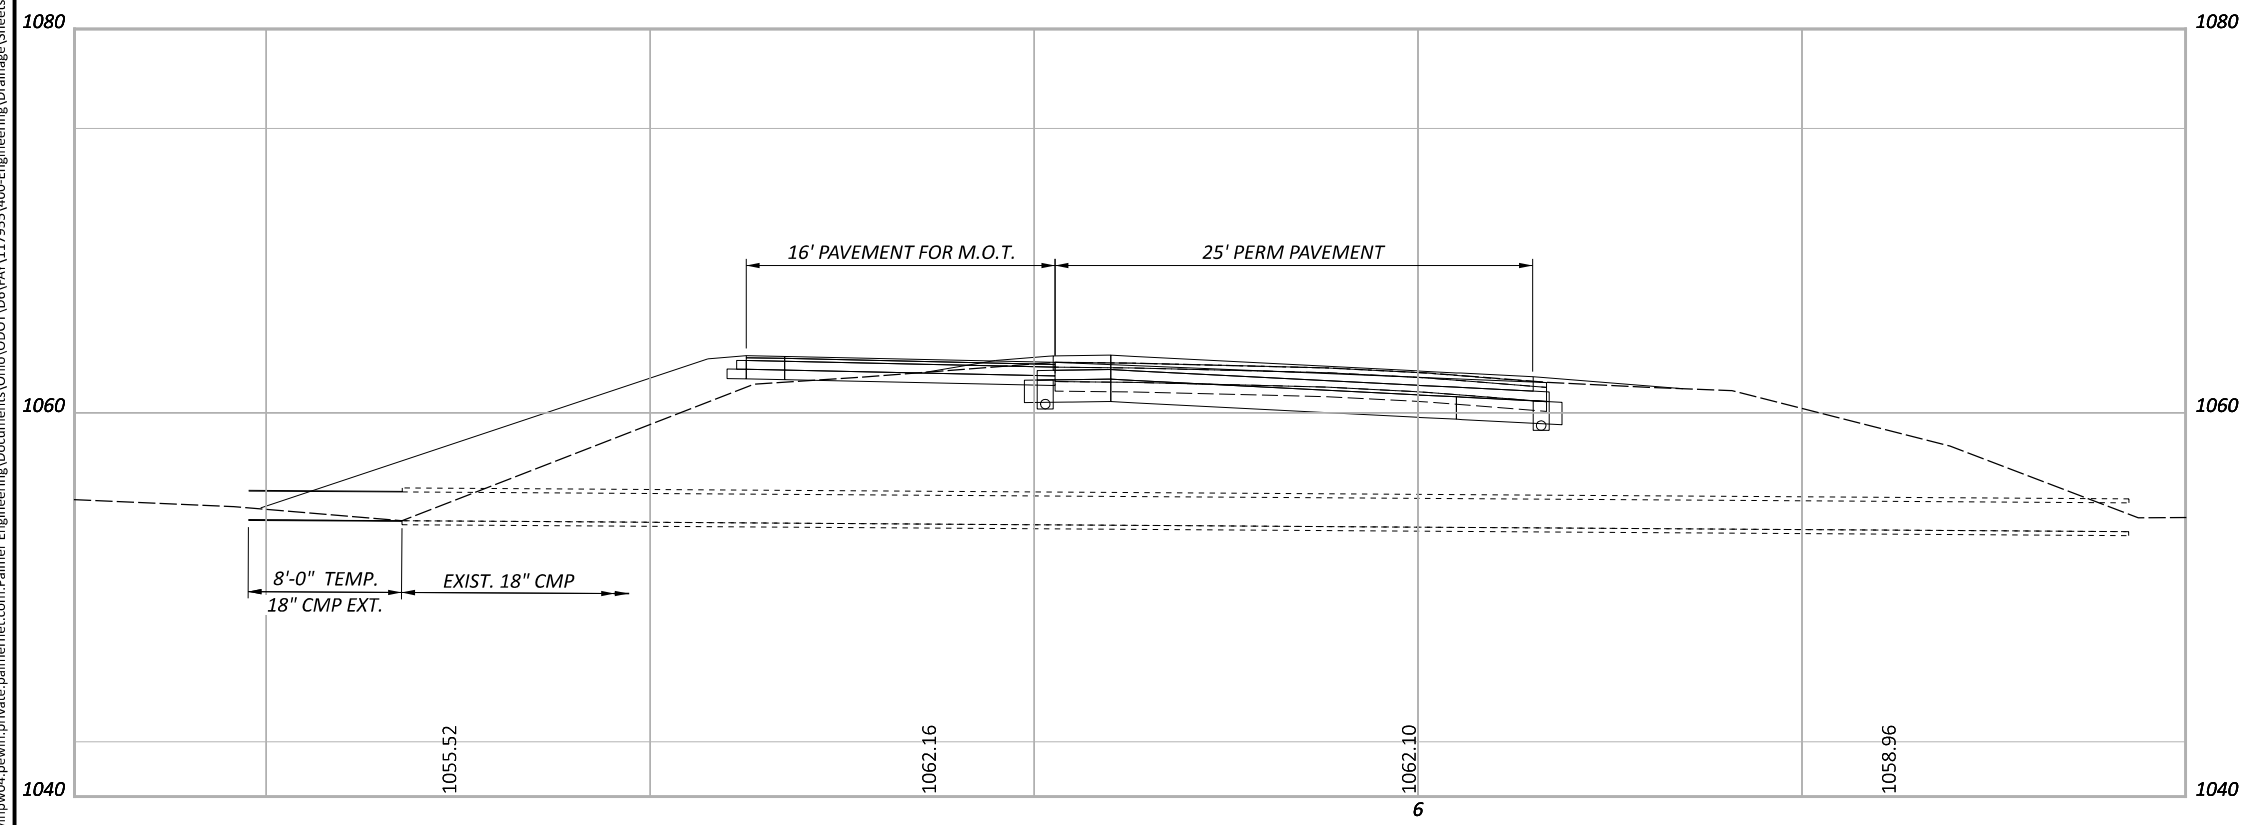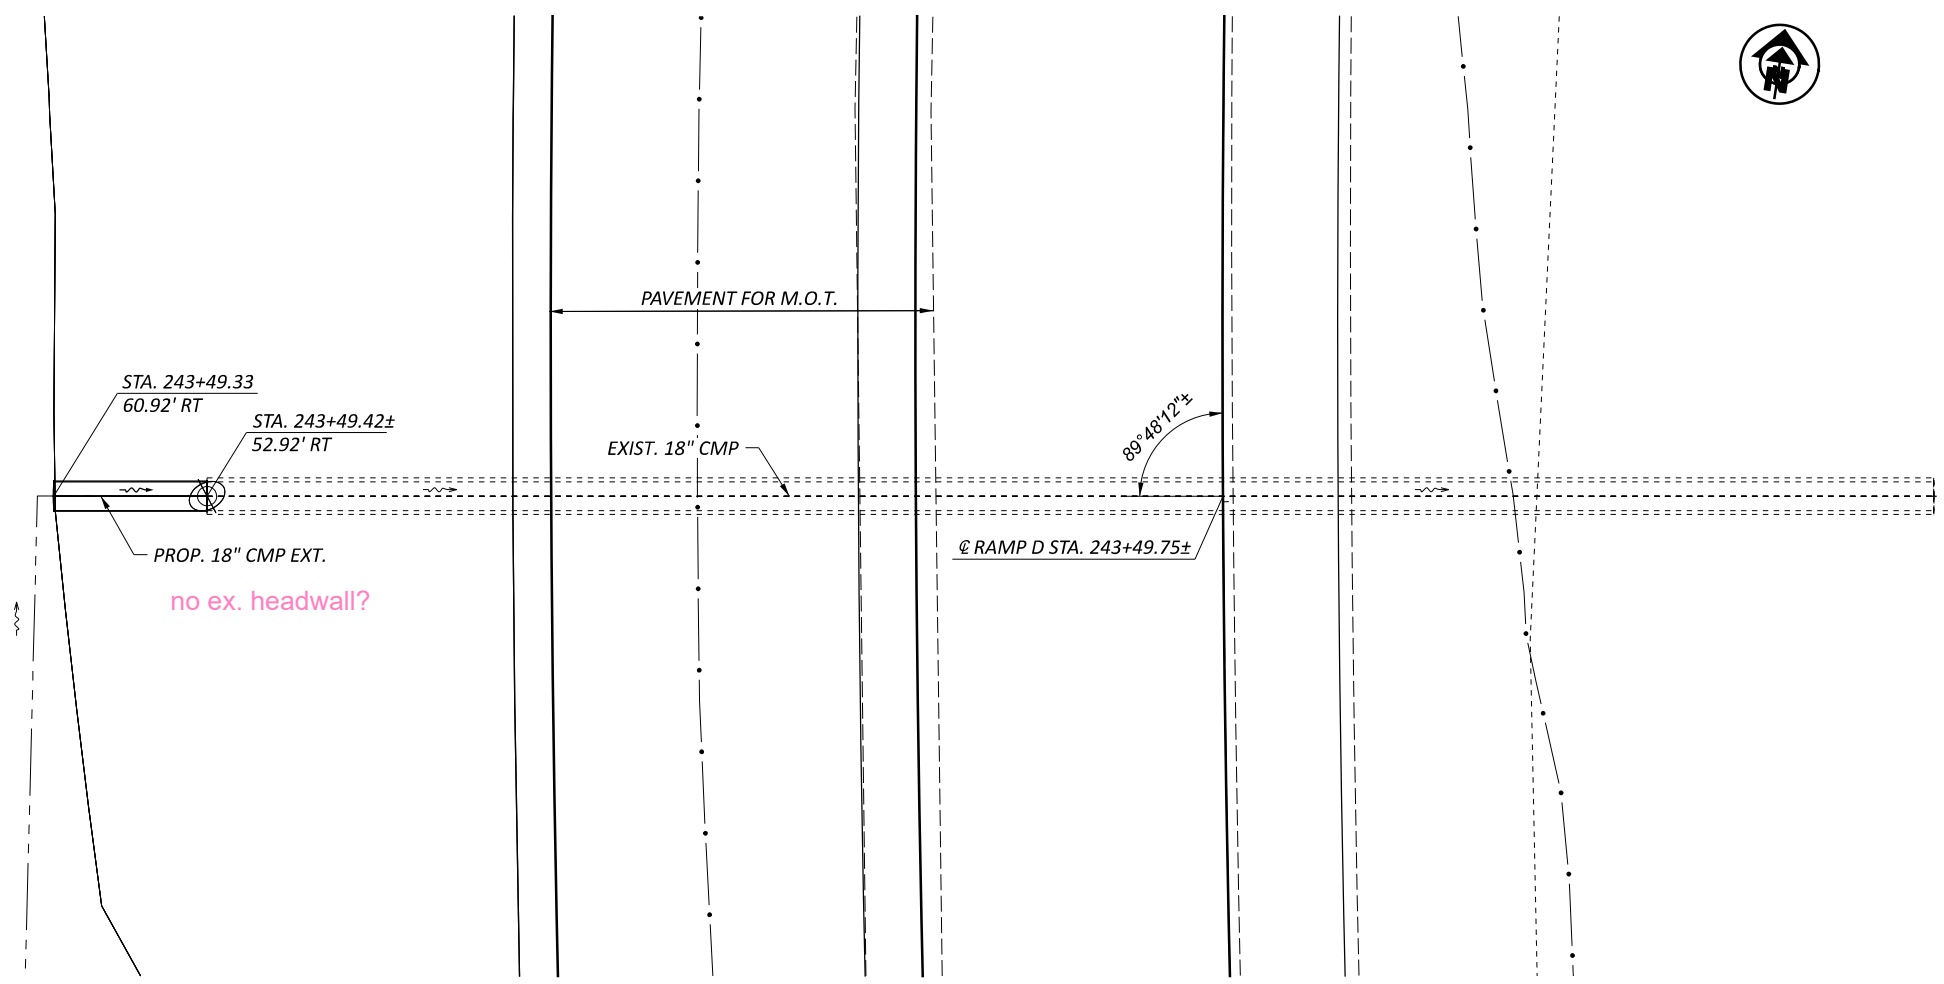

CULVERT PLAN AND PROFILE - RAMP D PROP STA. + —
 EXIST 18" CMP - TEMPORARY EXTENSION

DESIGN AGENCY	
 8350 E. KEMPER RD. SUITE B CINCINNATI, OH 45249 513-469-1600	
DESIGNER	
DPF	
REVIEWER	
DCJ MM-DD-YY	
PROJECT ID	
117955	
SUBSET	TOTAL
0	0
SHEET	TOTAL
P. 220	228

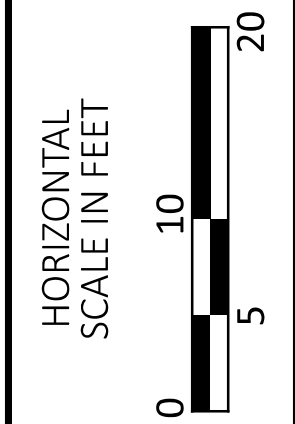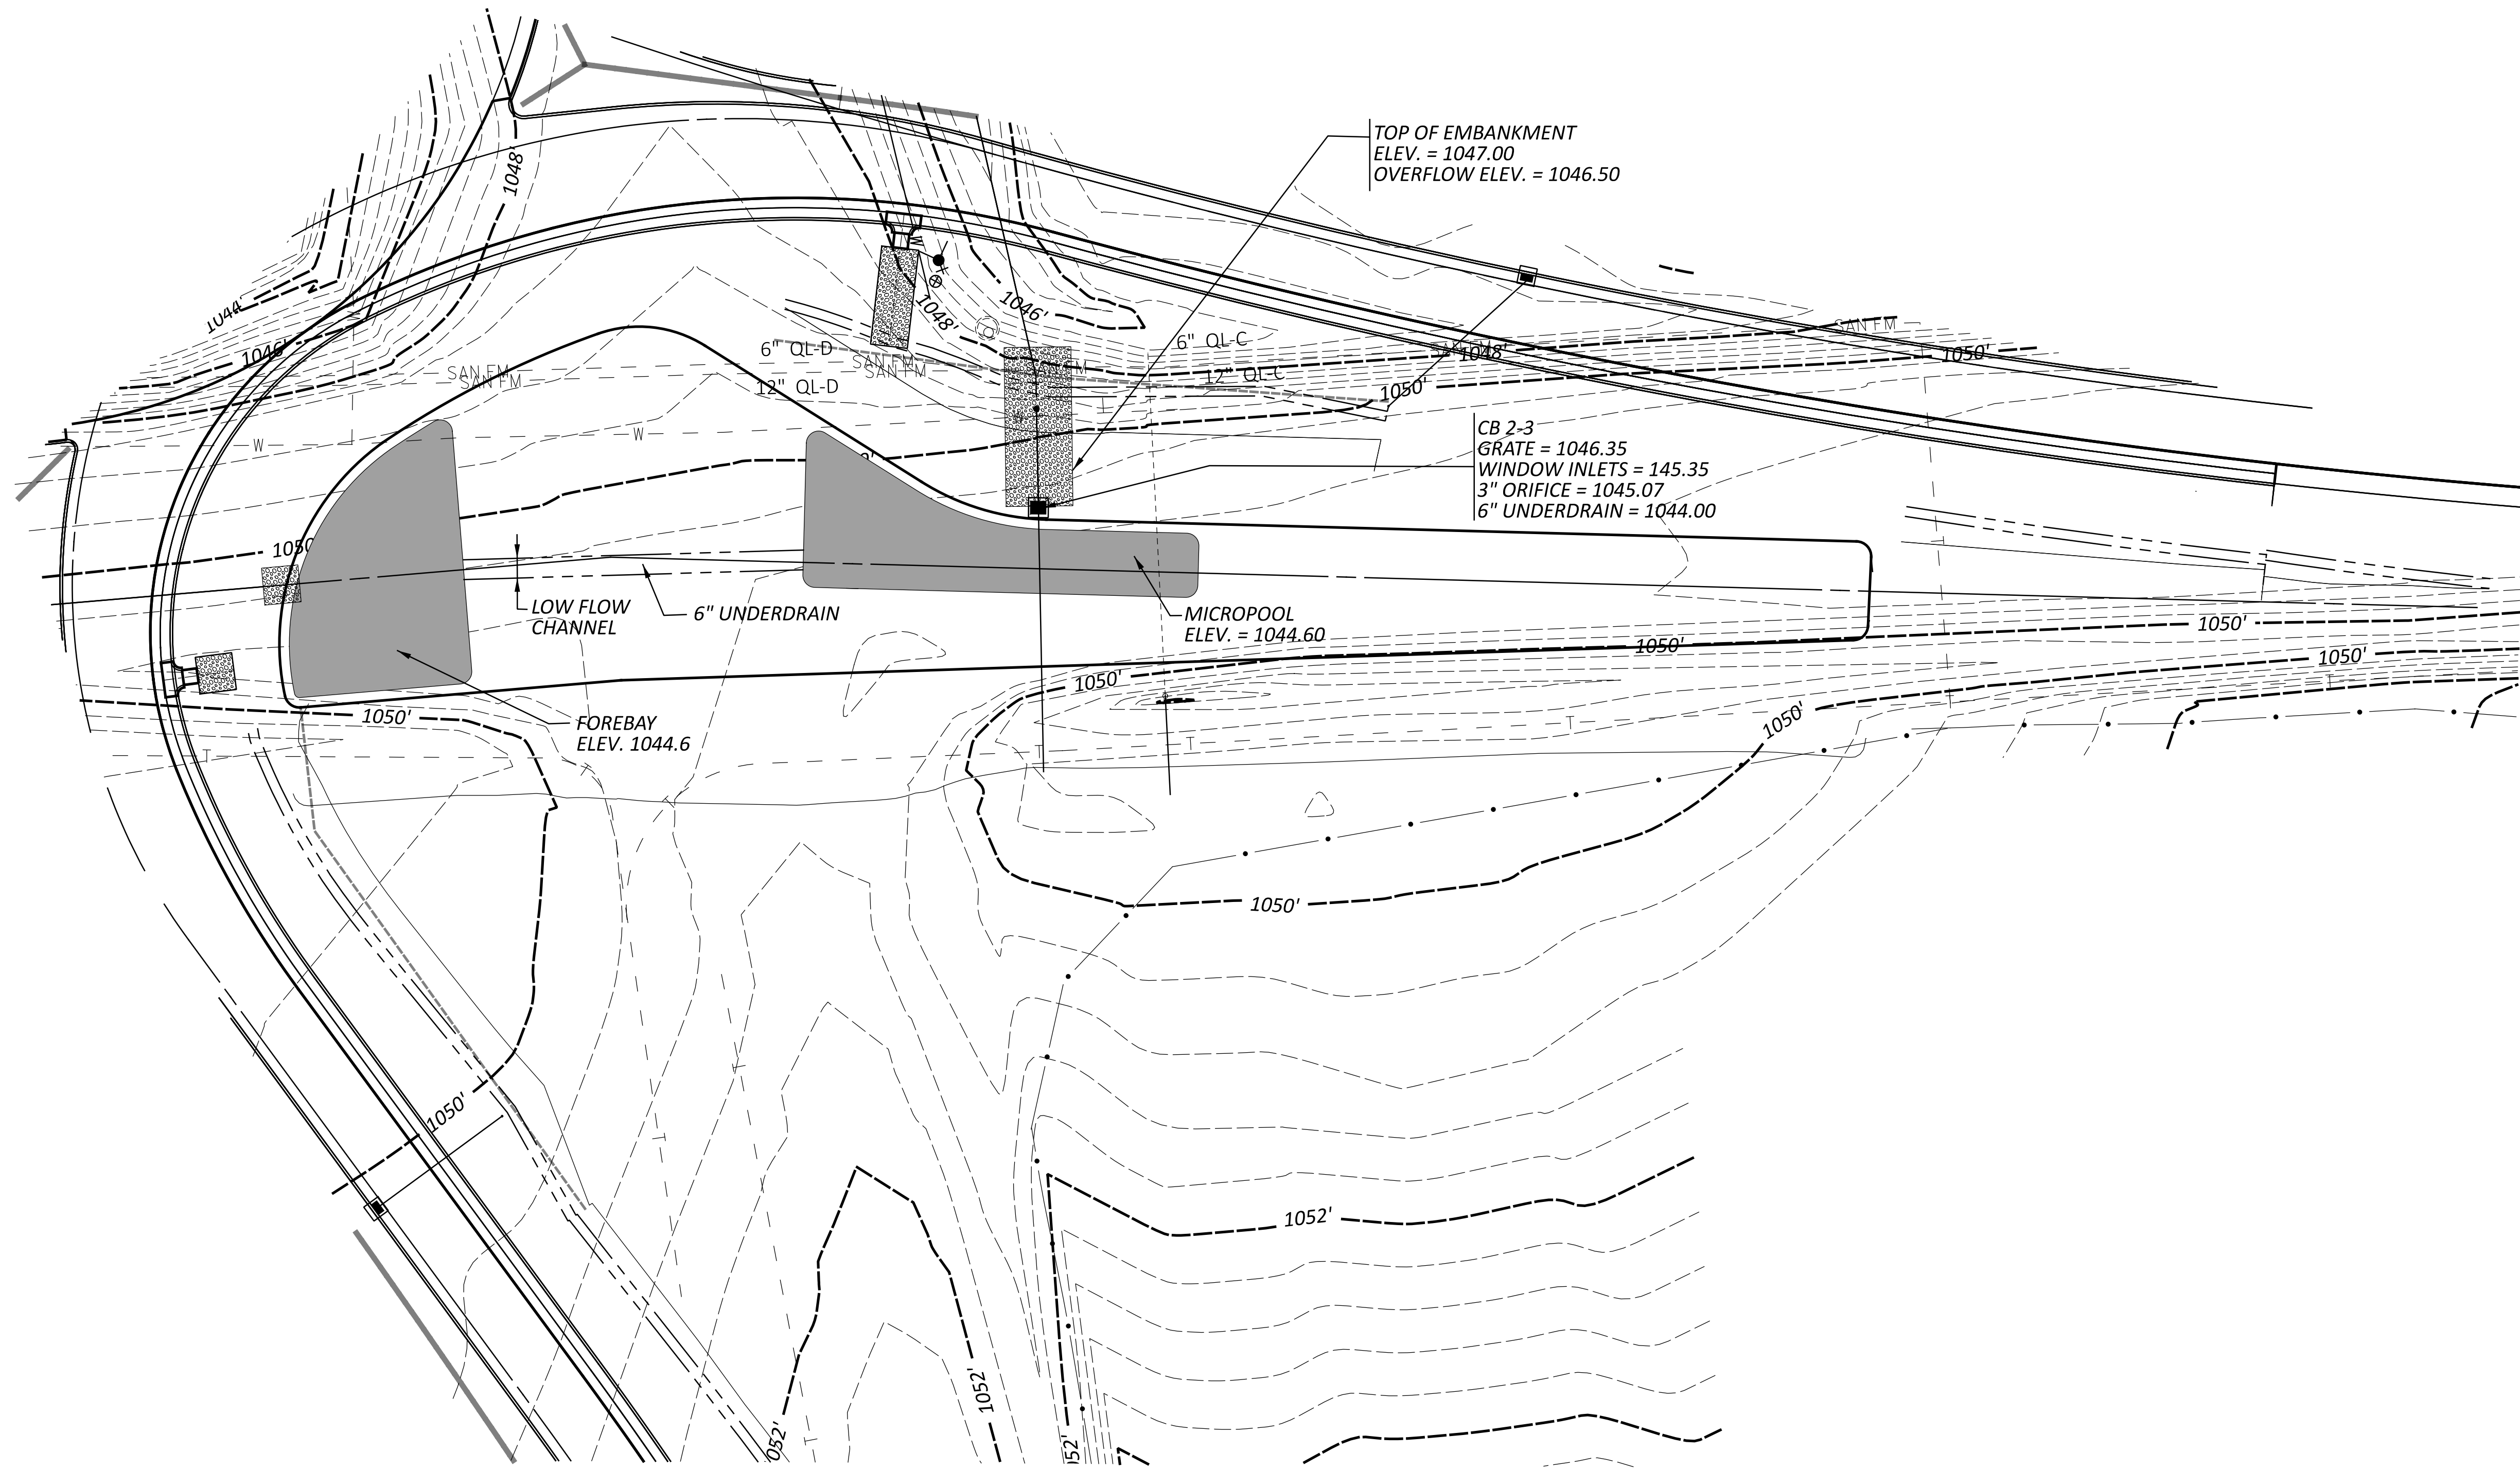

DRAINAGE DETAILS
 DETENTION POND

DESIGN AGENCY


Palmer
 ENGINEERING
 8350 E. KEMPER RD.
 SUITE B
 CINCINNATI, OH 45249
 513-469-1600

DESIGNER
 XXX

REVIEWER
 XXX MM-DD-YY

PROJECT ID
 0

SHEET	TOTAL
P.0	0

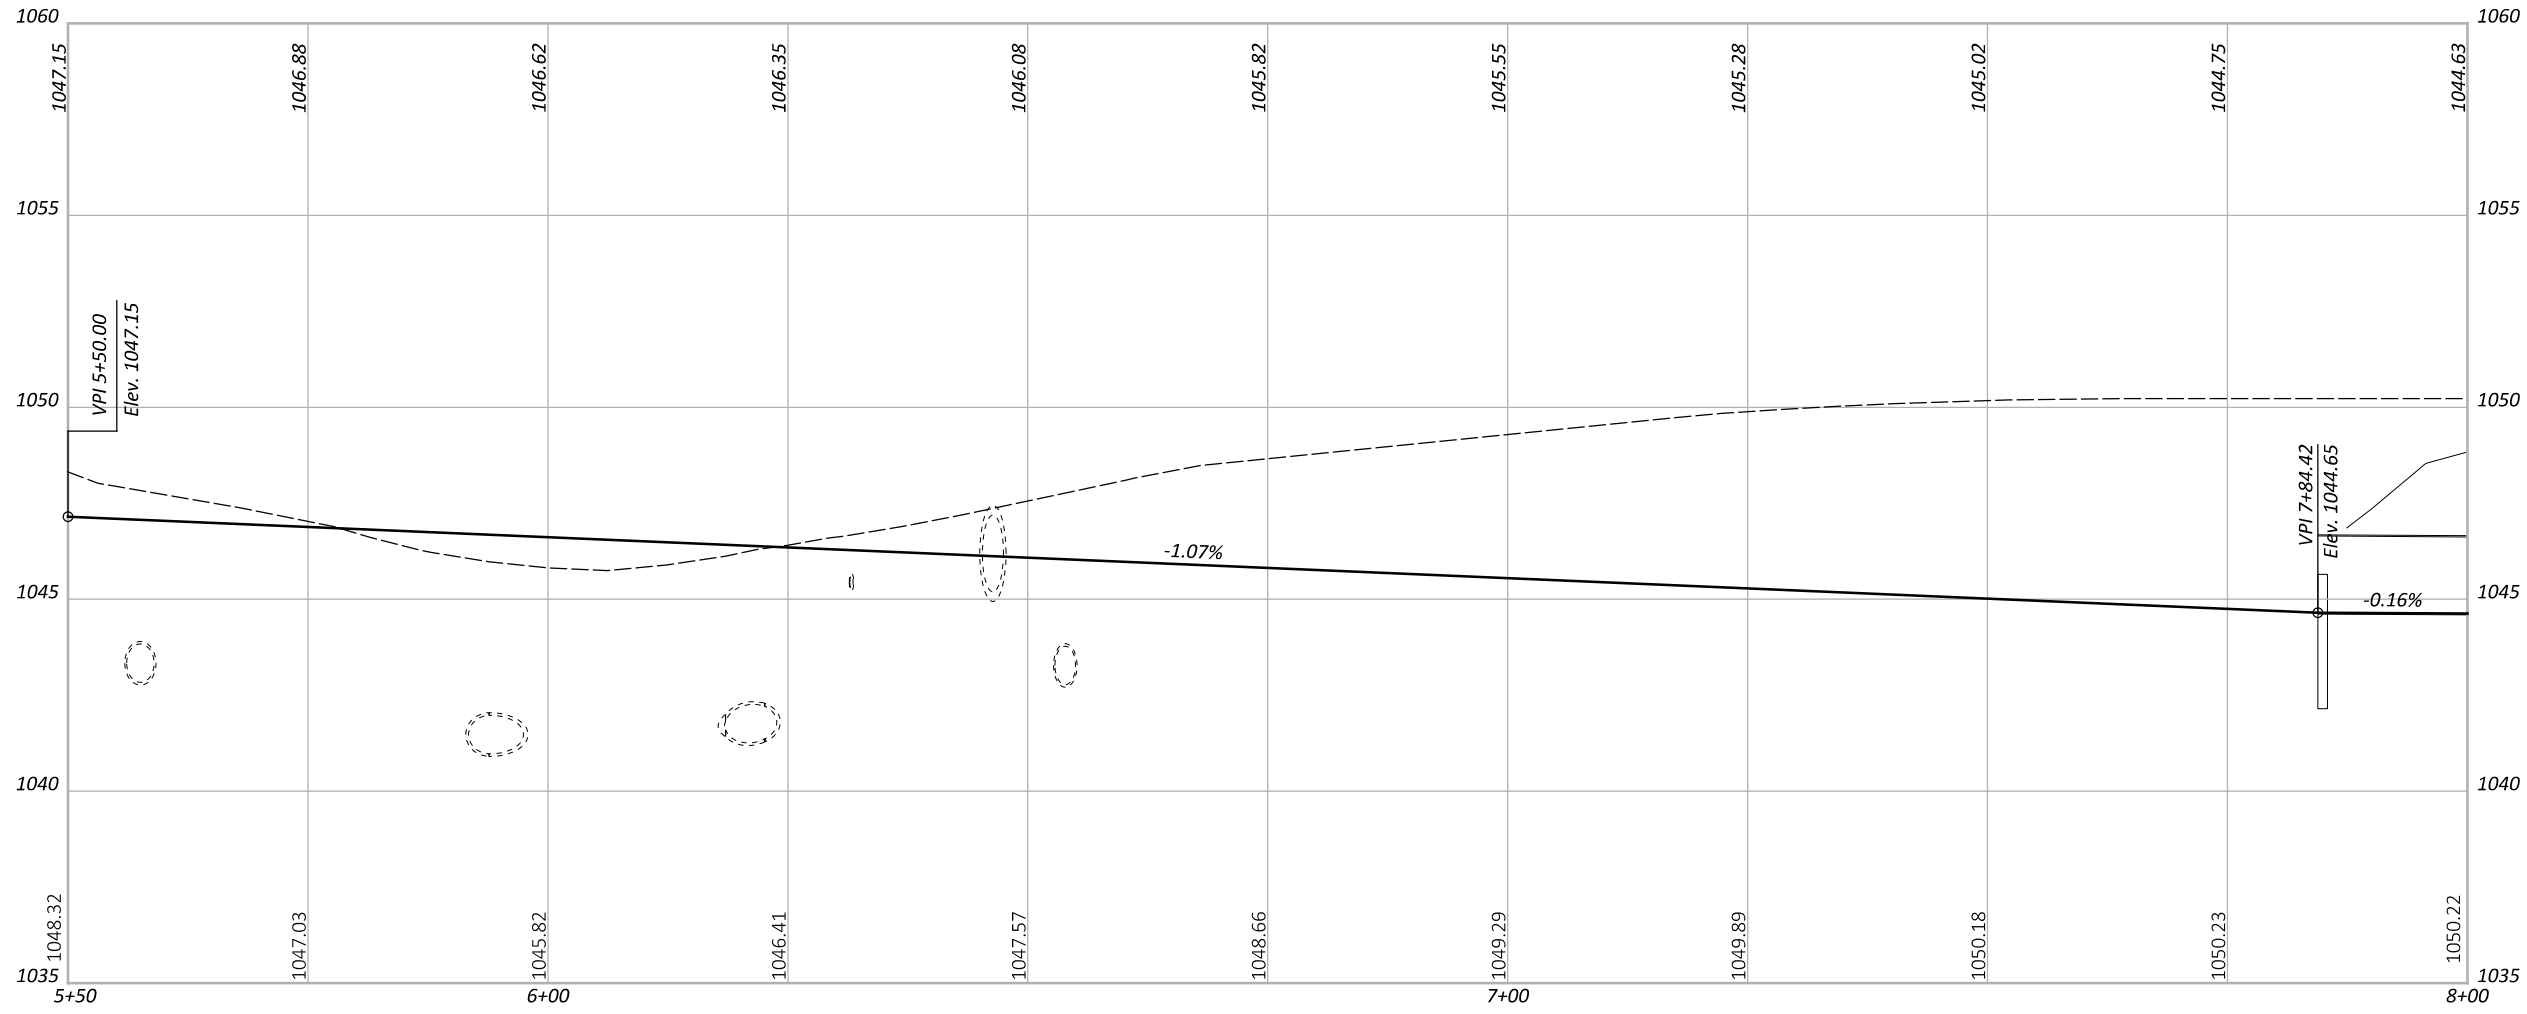

DRIVE PIPE AND OUTLET DITCH PROFILE
 STA. 5+50.00 - STA. 7+44.82

DESIGN AGENCY





DESIGNER
 DPF


REVIEWER
 DCJ MM-DD-YY


PROJECT ID
 117955

SHEET TOTAL
 P. 222 228

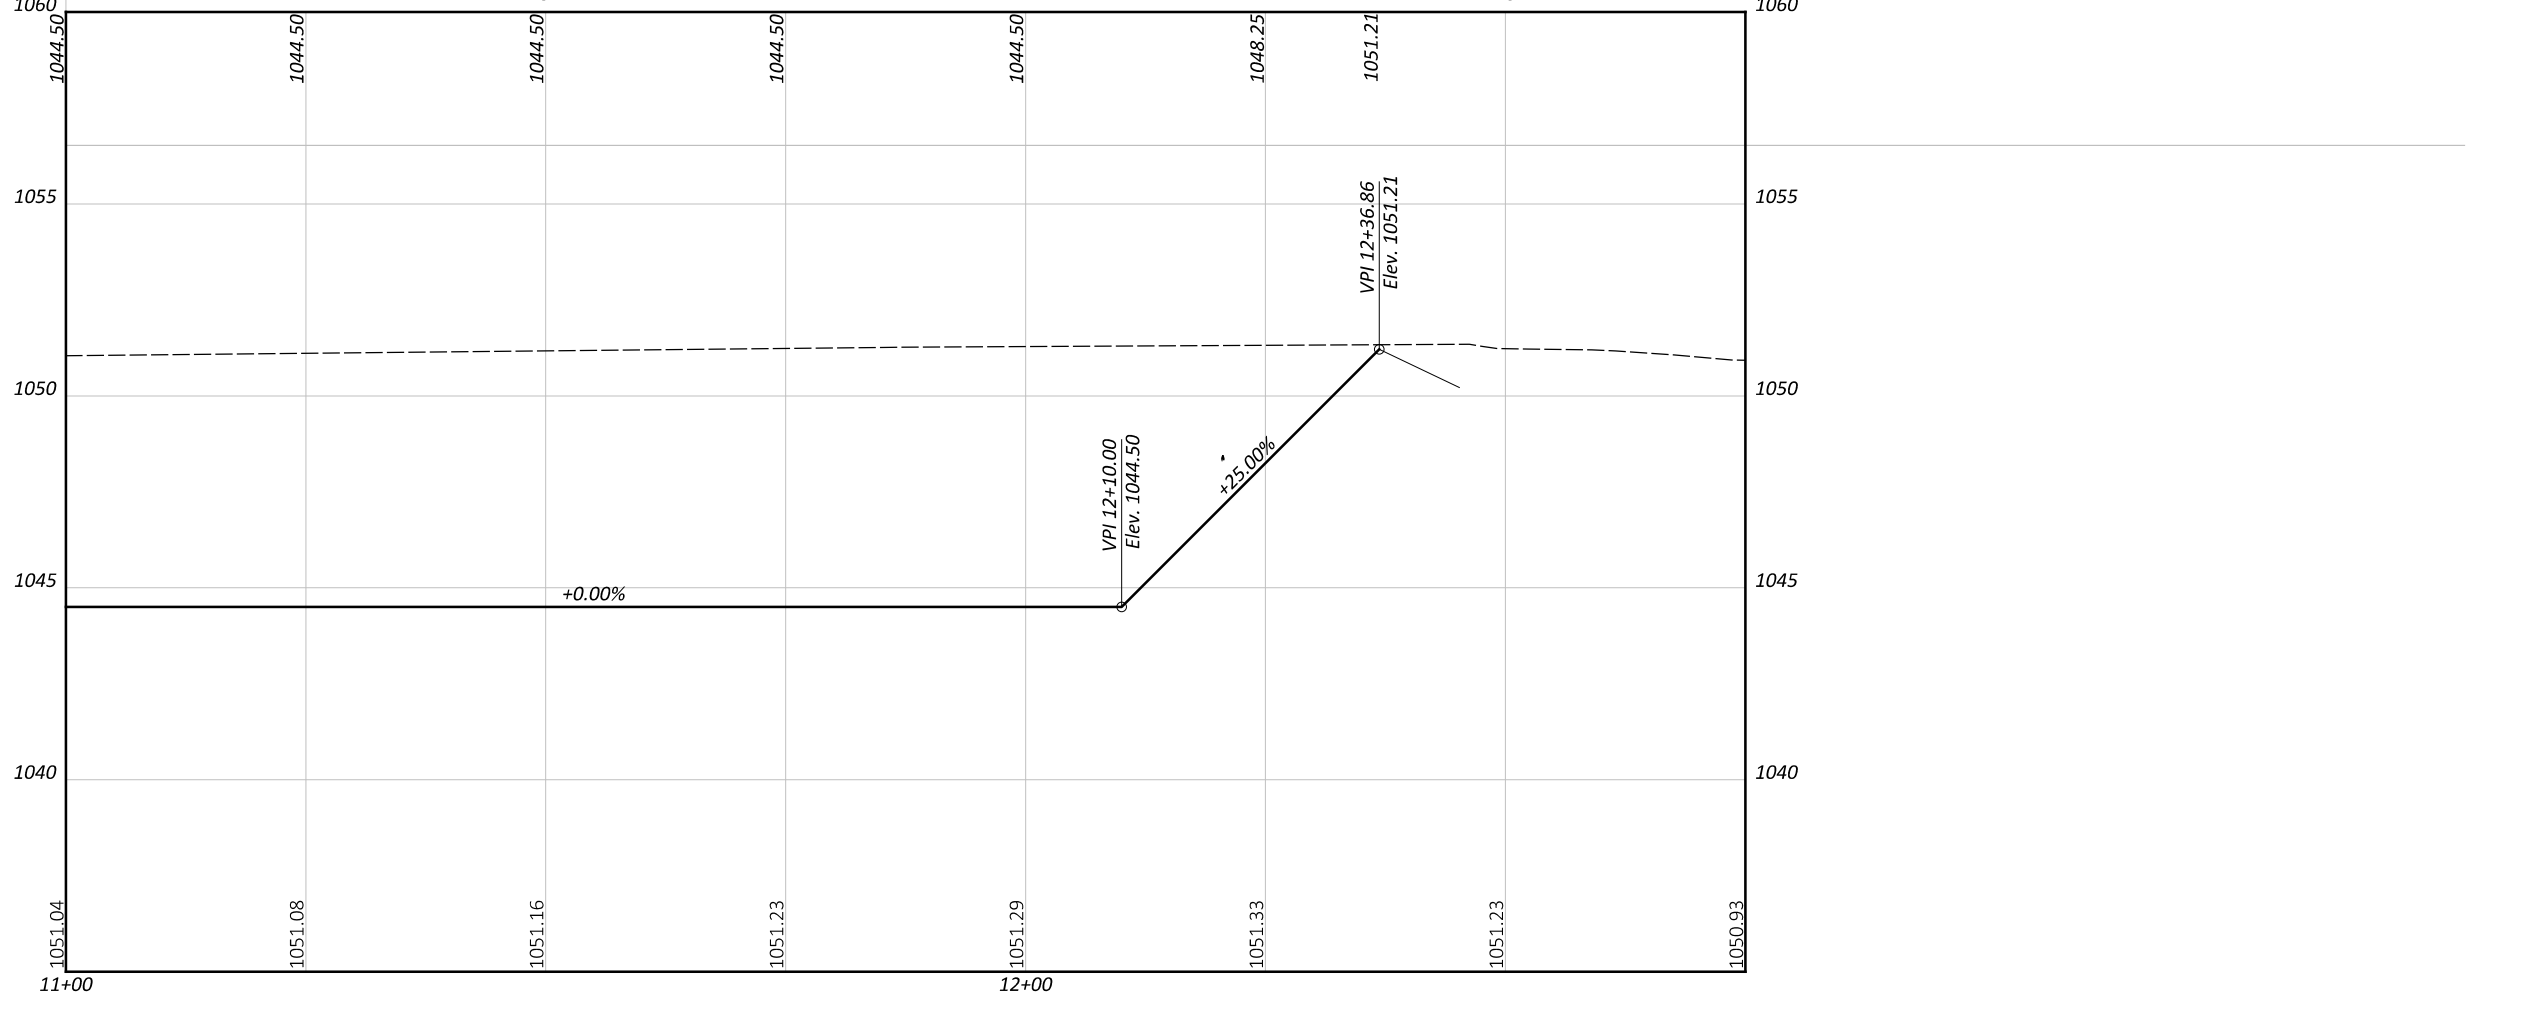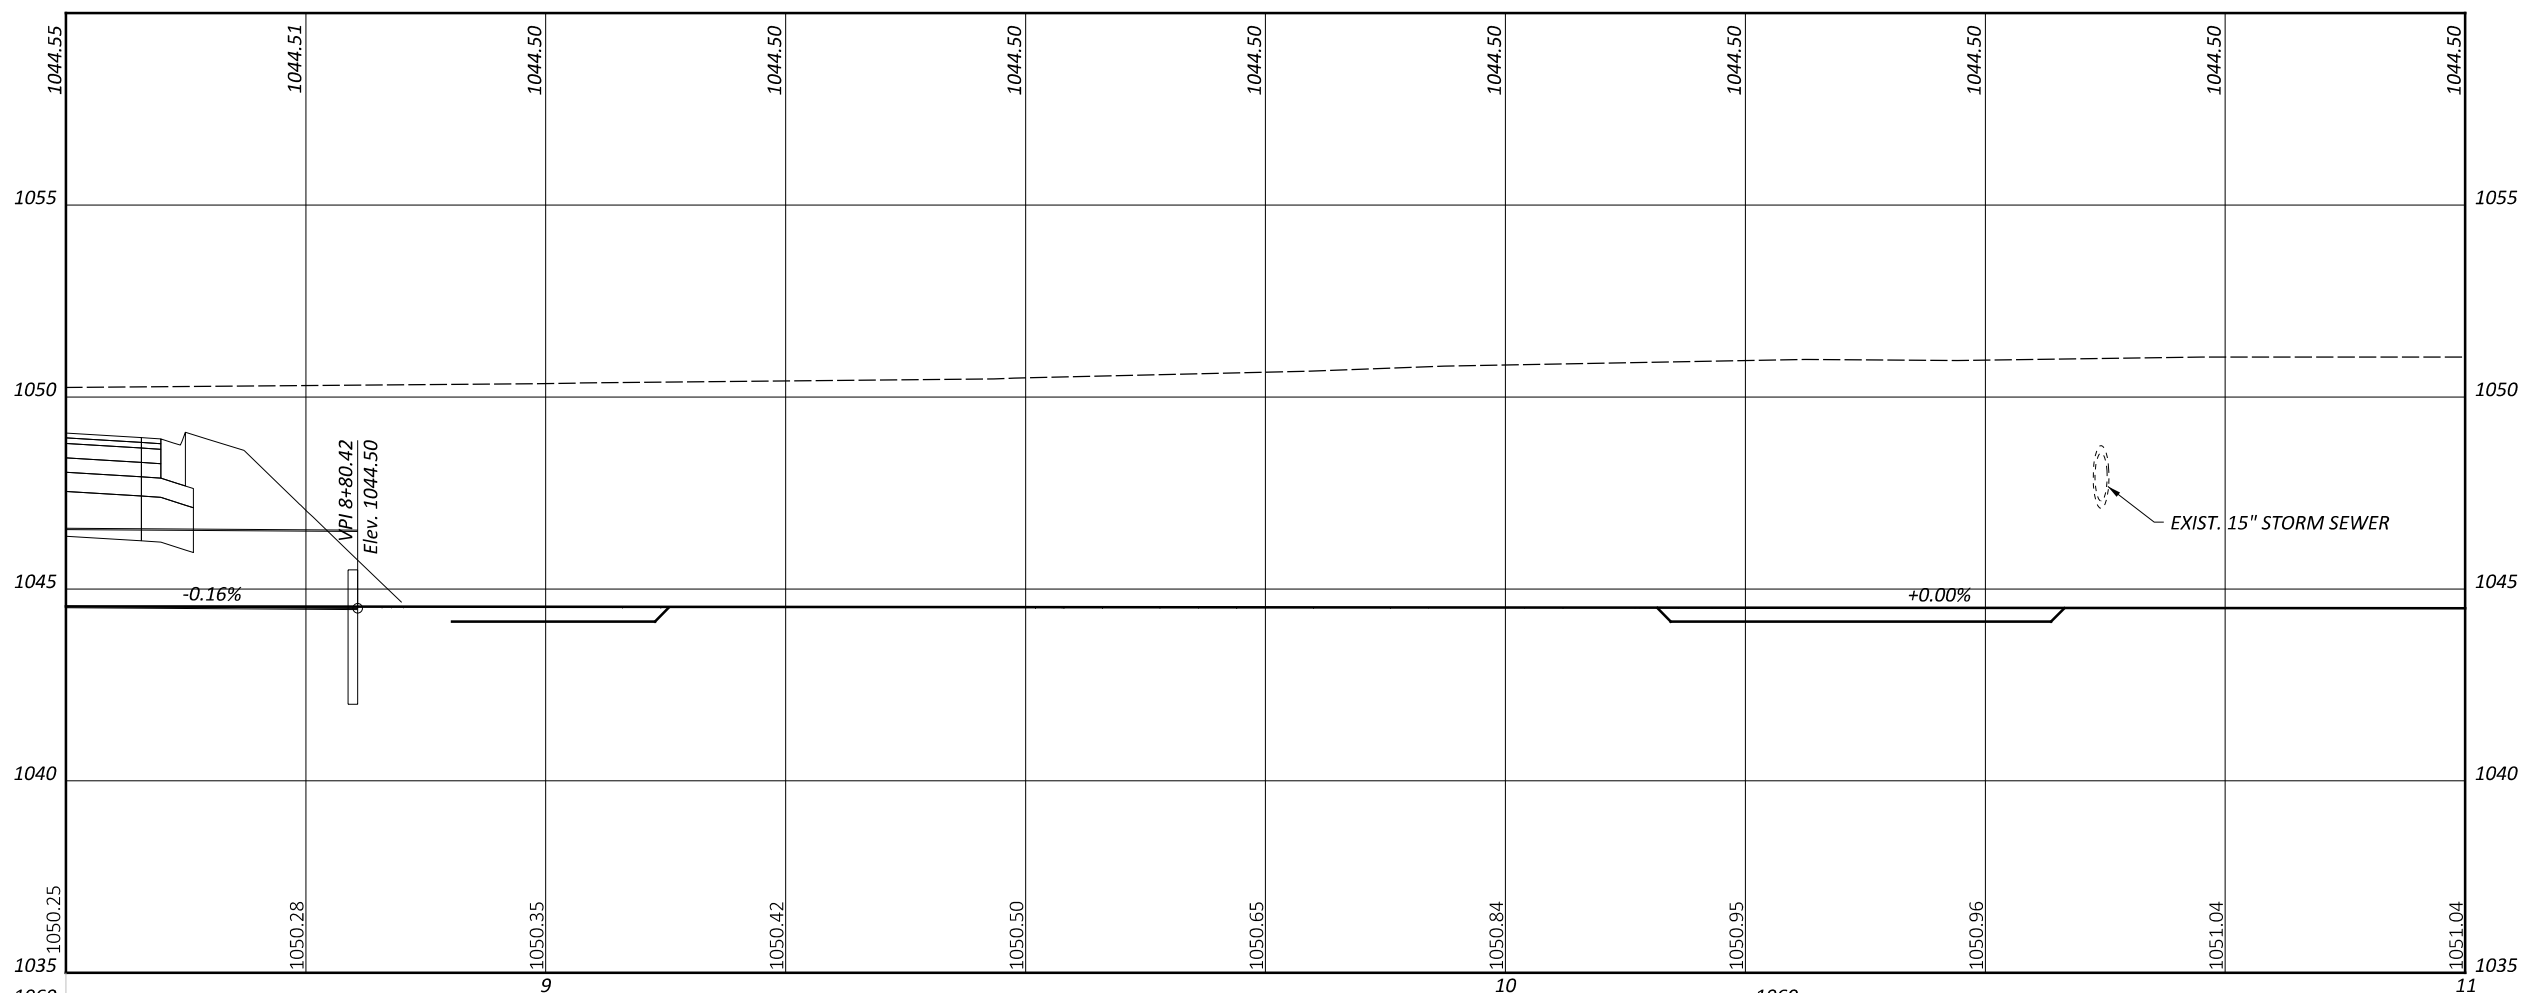


DRIVE PIPE AND OUTLET DITCH PROFILE
 STA. 8+50.00 - STA. 12+36.86

DESIGN AGENCY	
 8350 E. KEMPER RD. SUITE B CINCINNATI, OH 45249 513-469-1600	
DESIGNER	XXX
REVIEWER	XXX MM-DD-YY
PROJECT ID	0
SHEET	TOTAL
P.0	0

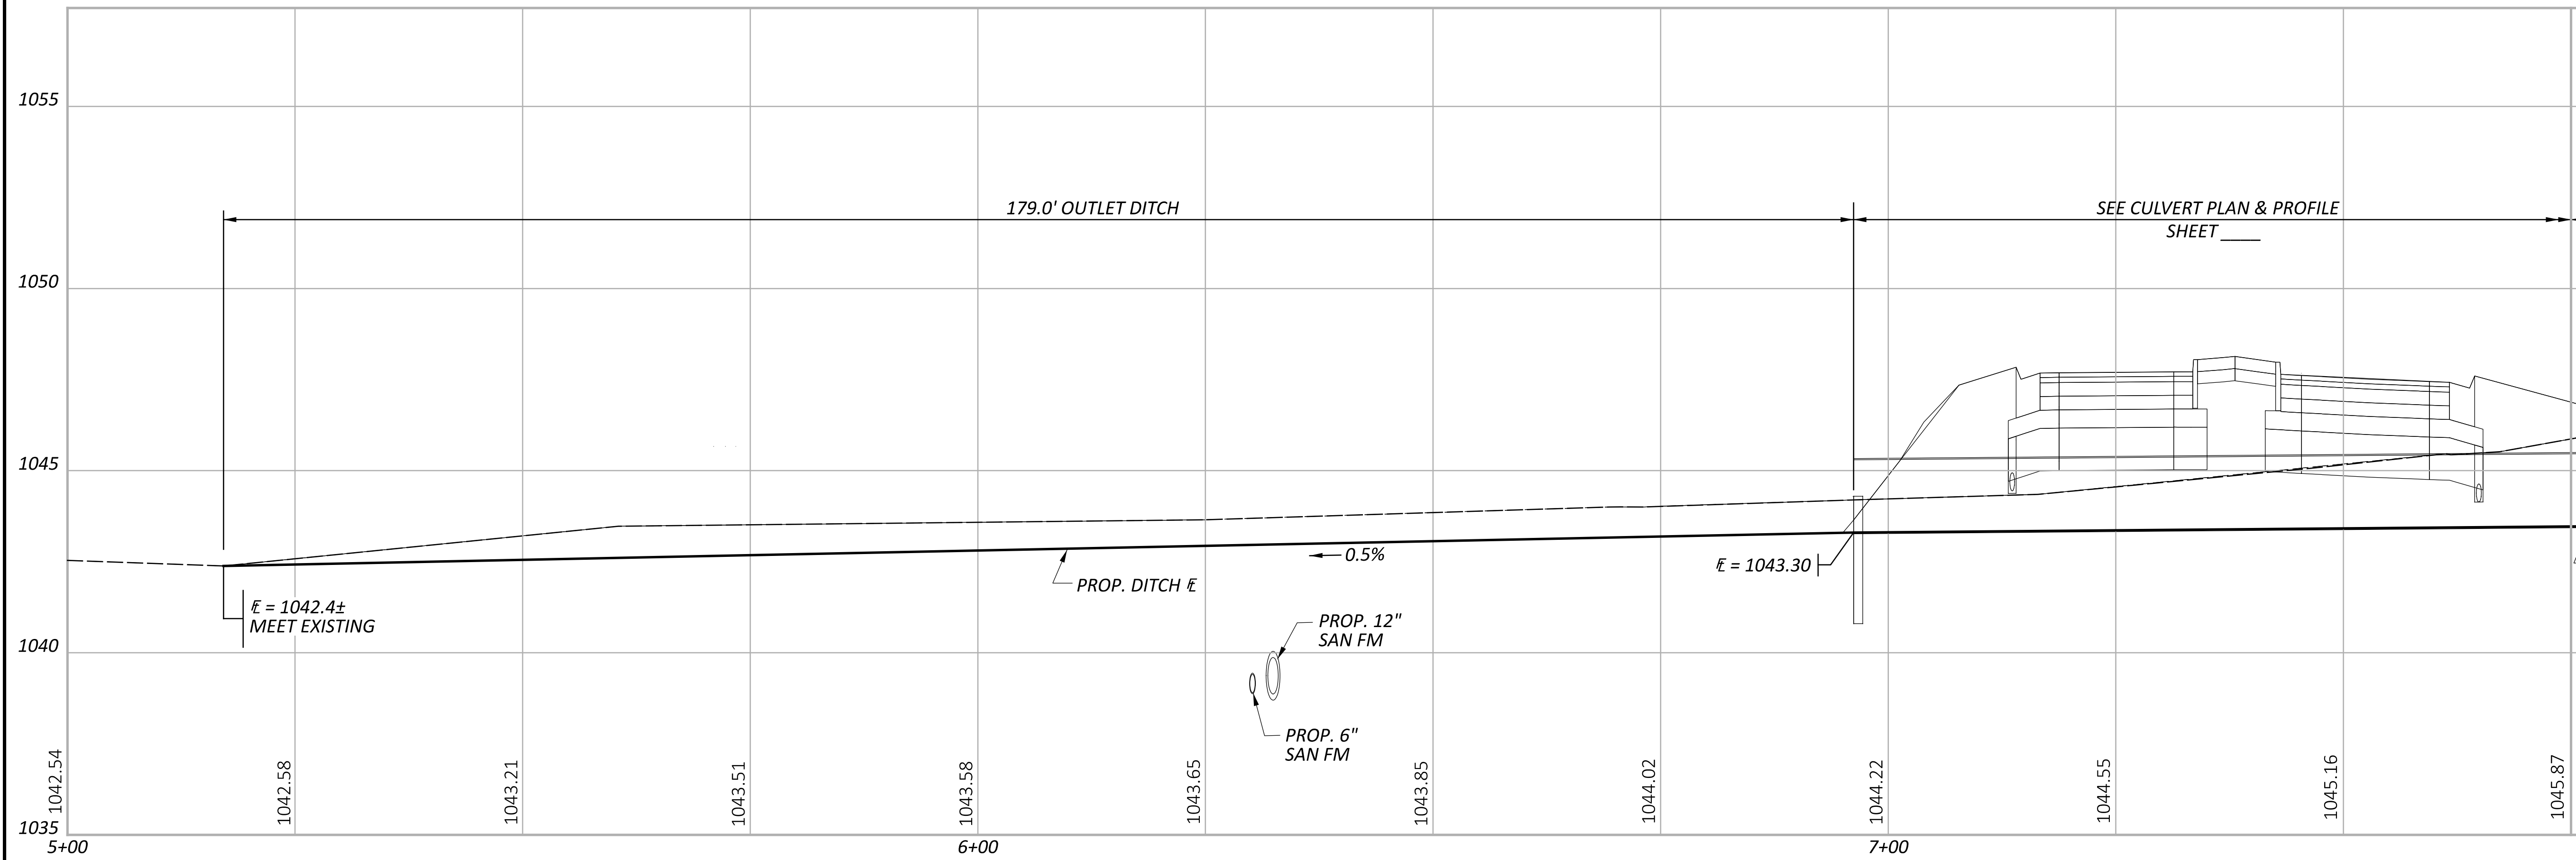

OUTLET DITCH BLUEGRASS STA. ----- TO STA. ----- RIGHT

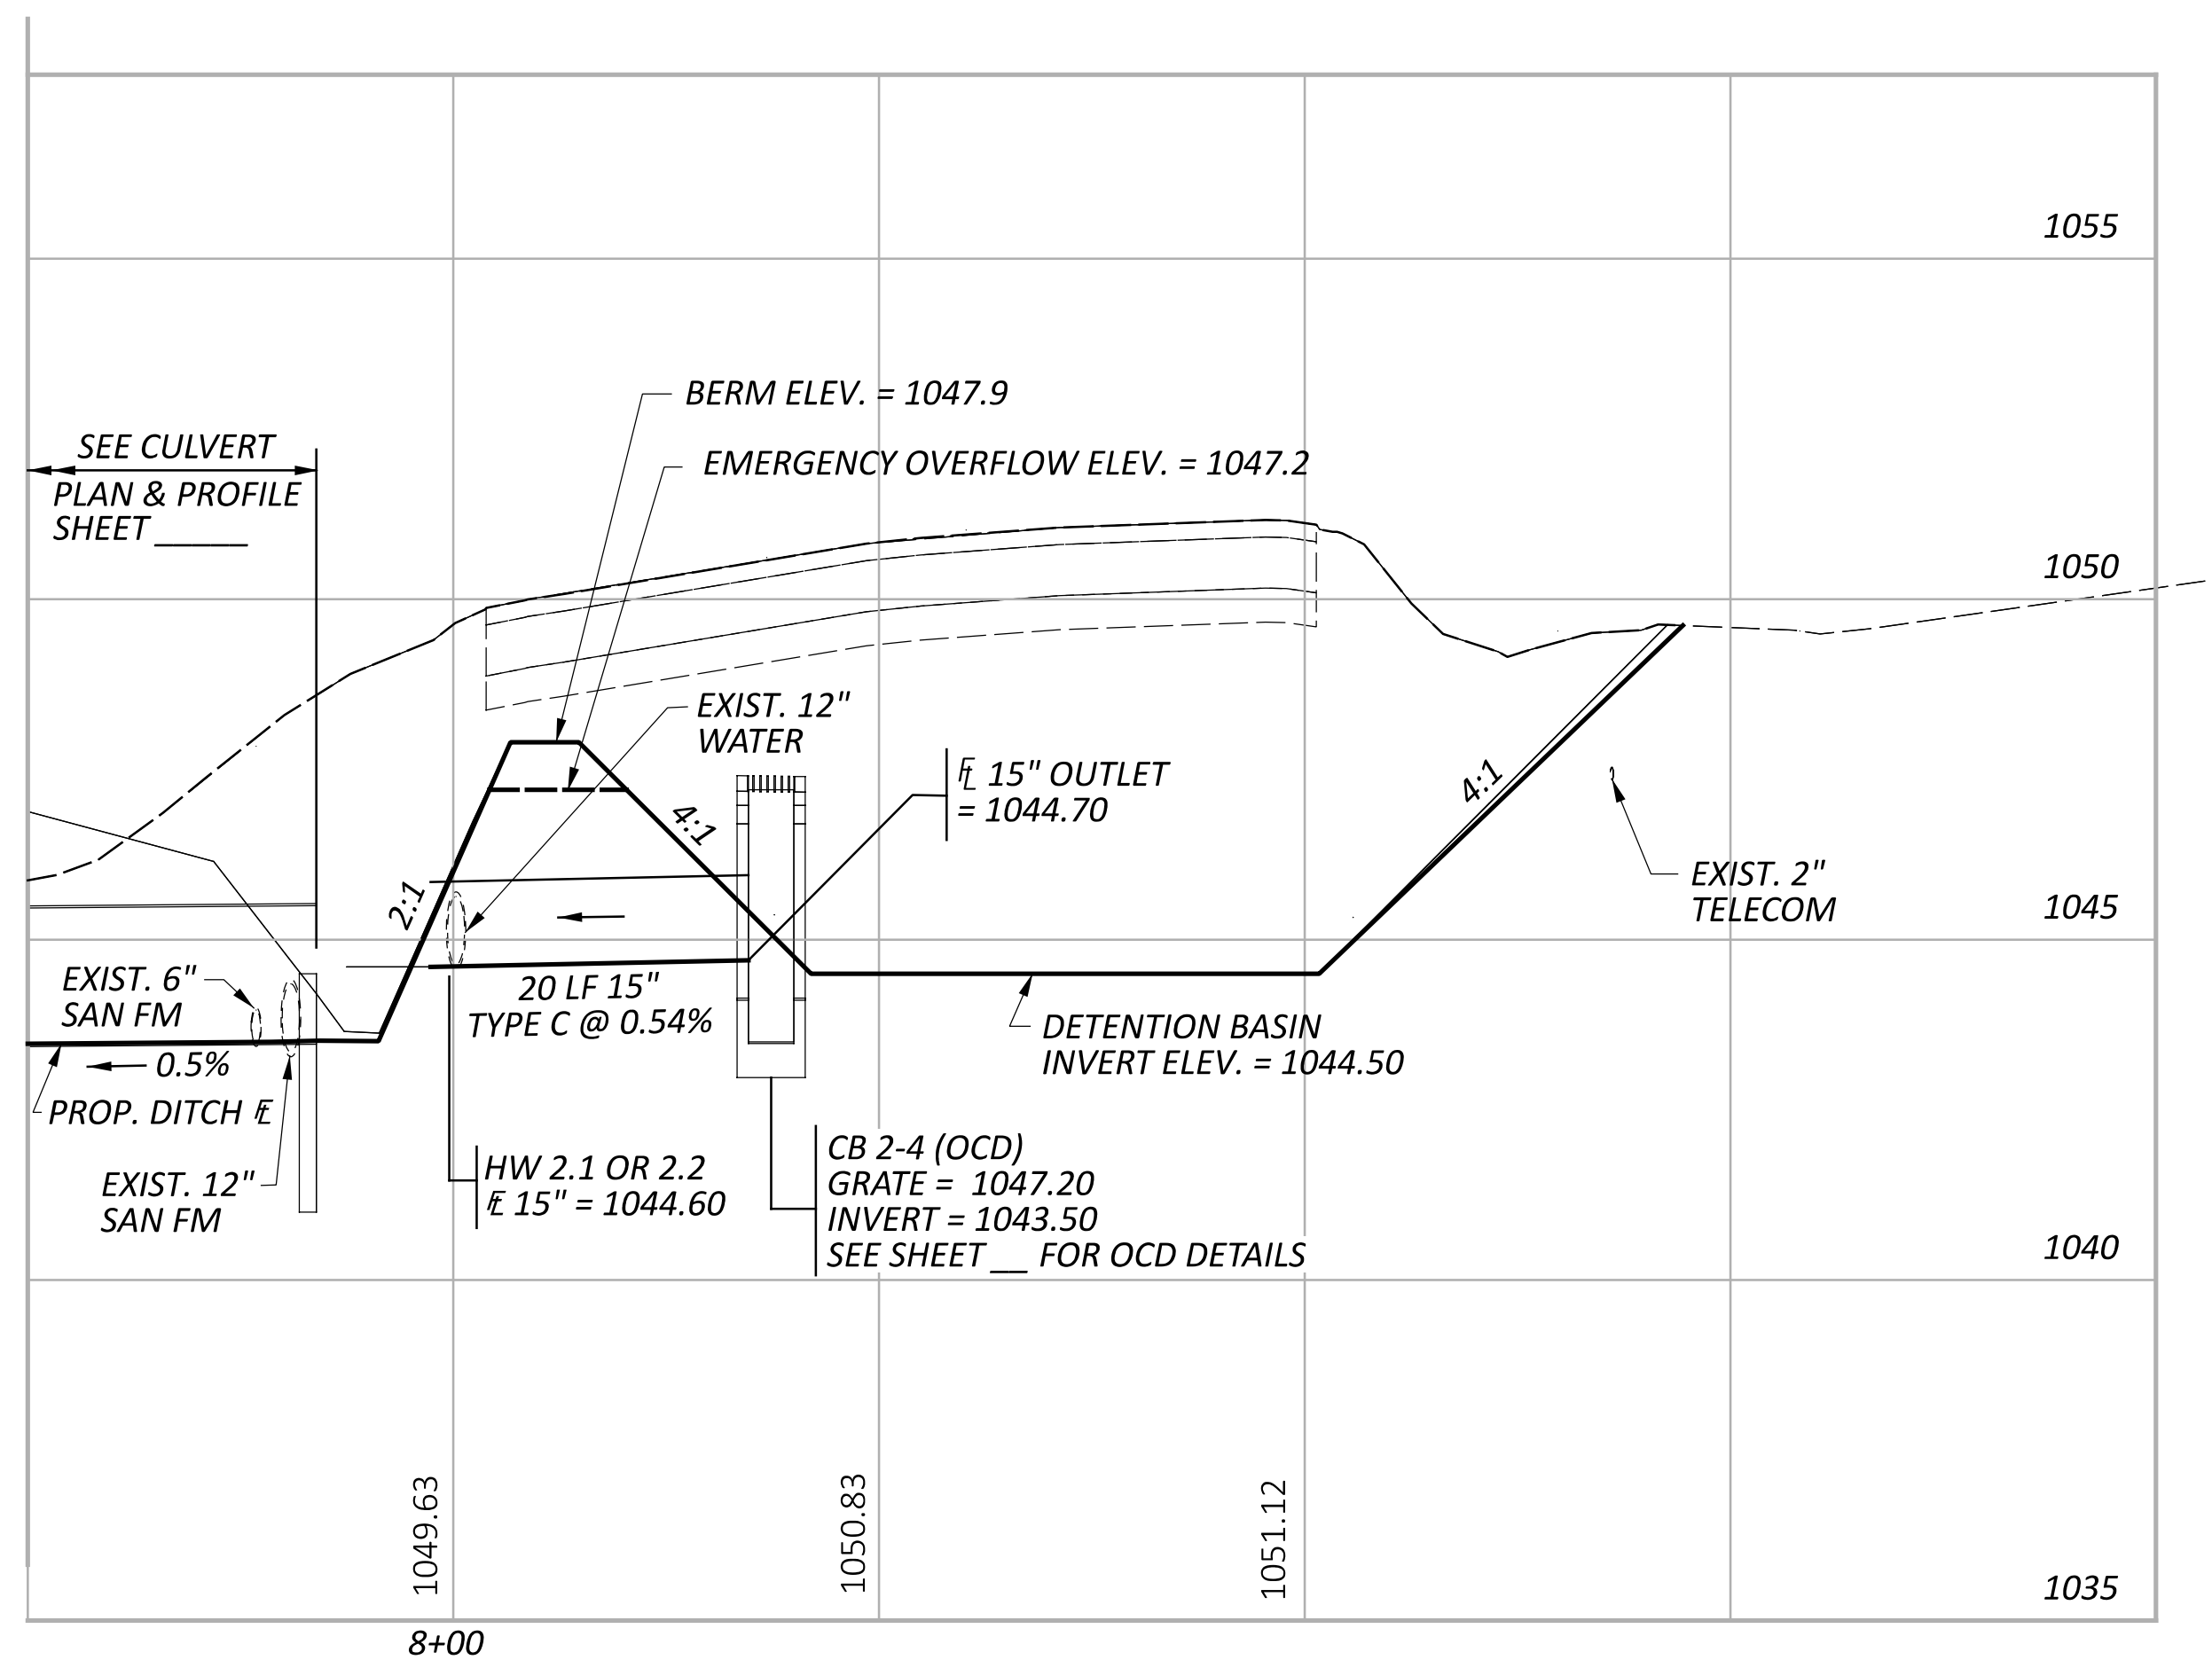

PROFILE - DETENTION BASIN OUTLET

DRAINAGE PROFILE
 DETENTION BASIN OUTLET

DESIGN AGENCY



8350 E. KEMPER RD.
 SUITE B
 CINCINNATI, OH 45249
 513-469-1600

DESIGNER

DPF

REVIEWER



DCJ MM-DD-YY

PROJECT ID

117955

SHEET TOTAL


P. 224 228

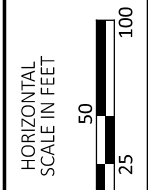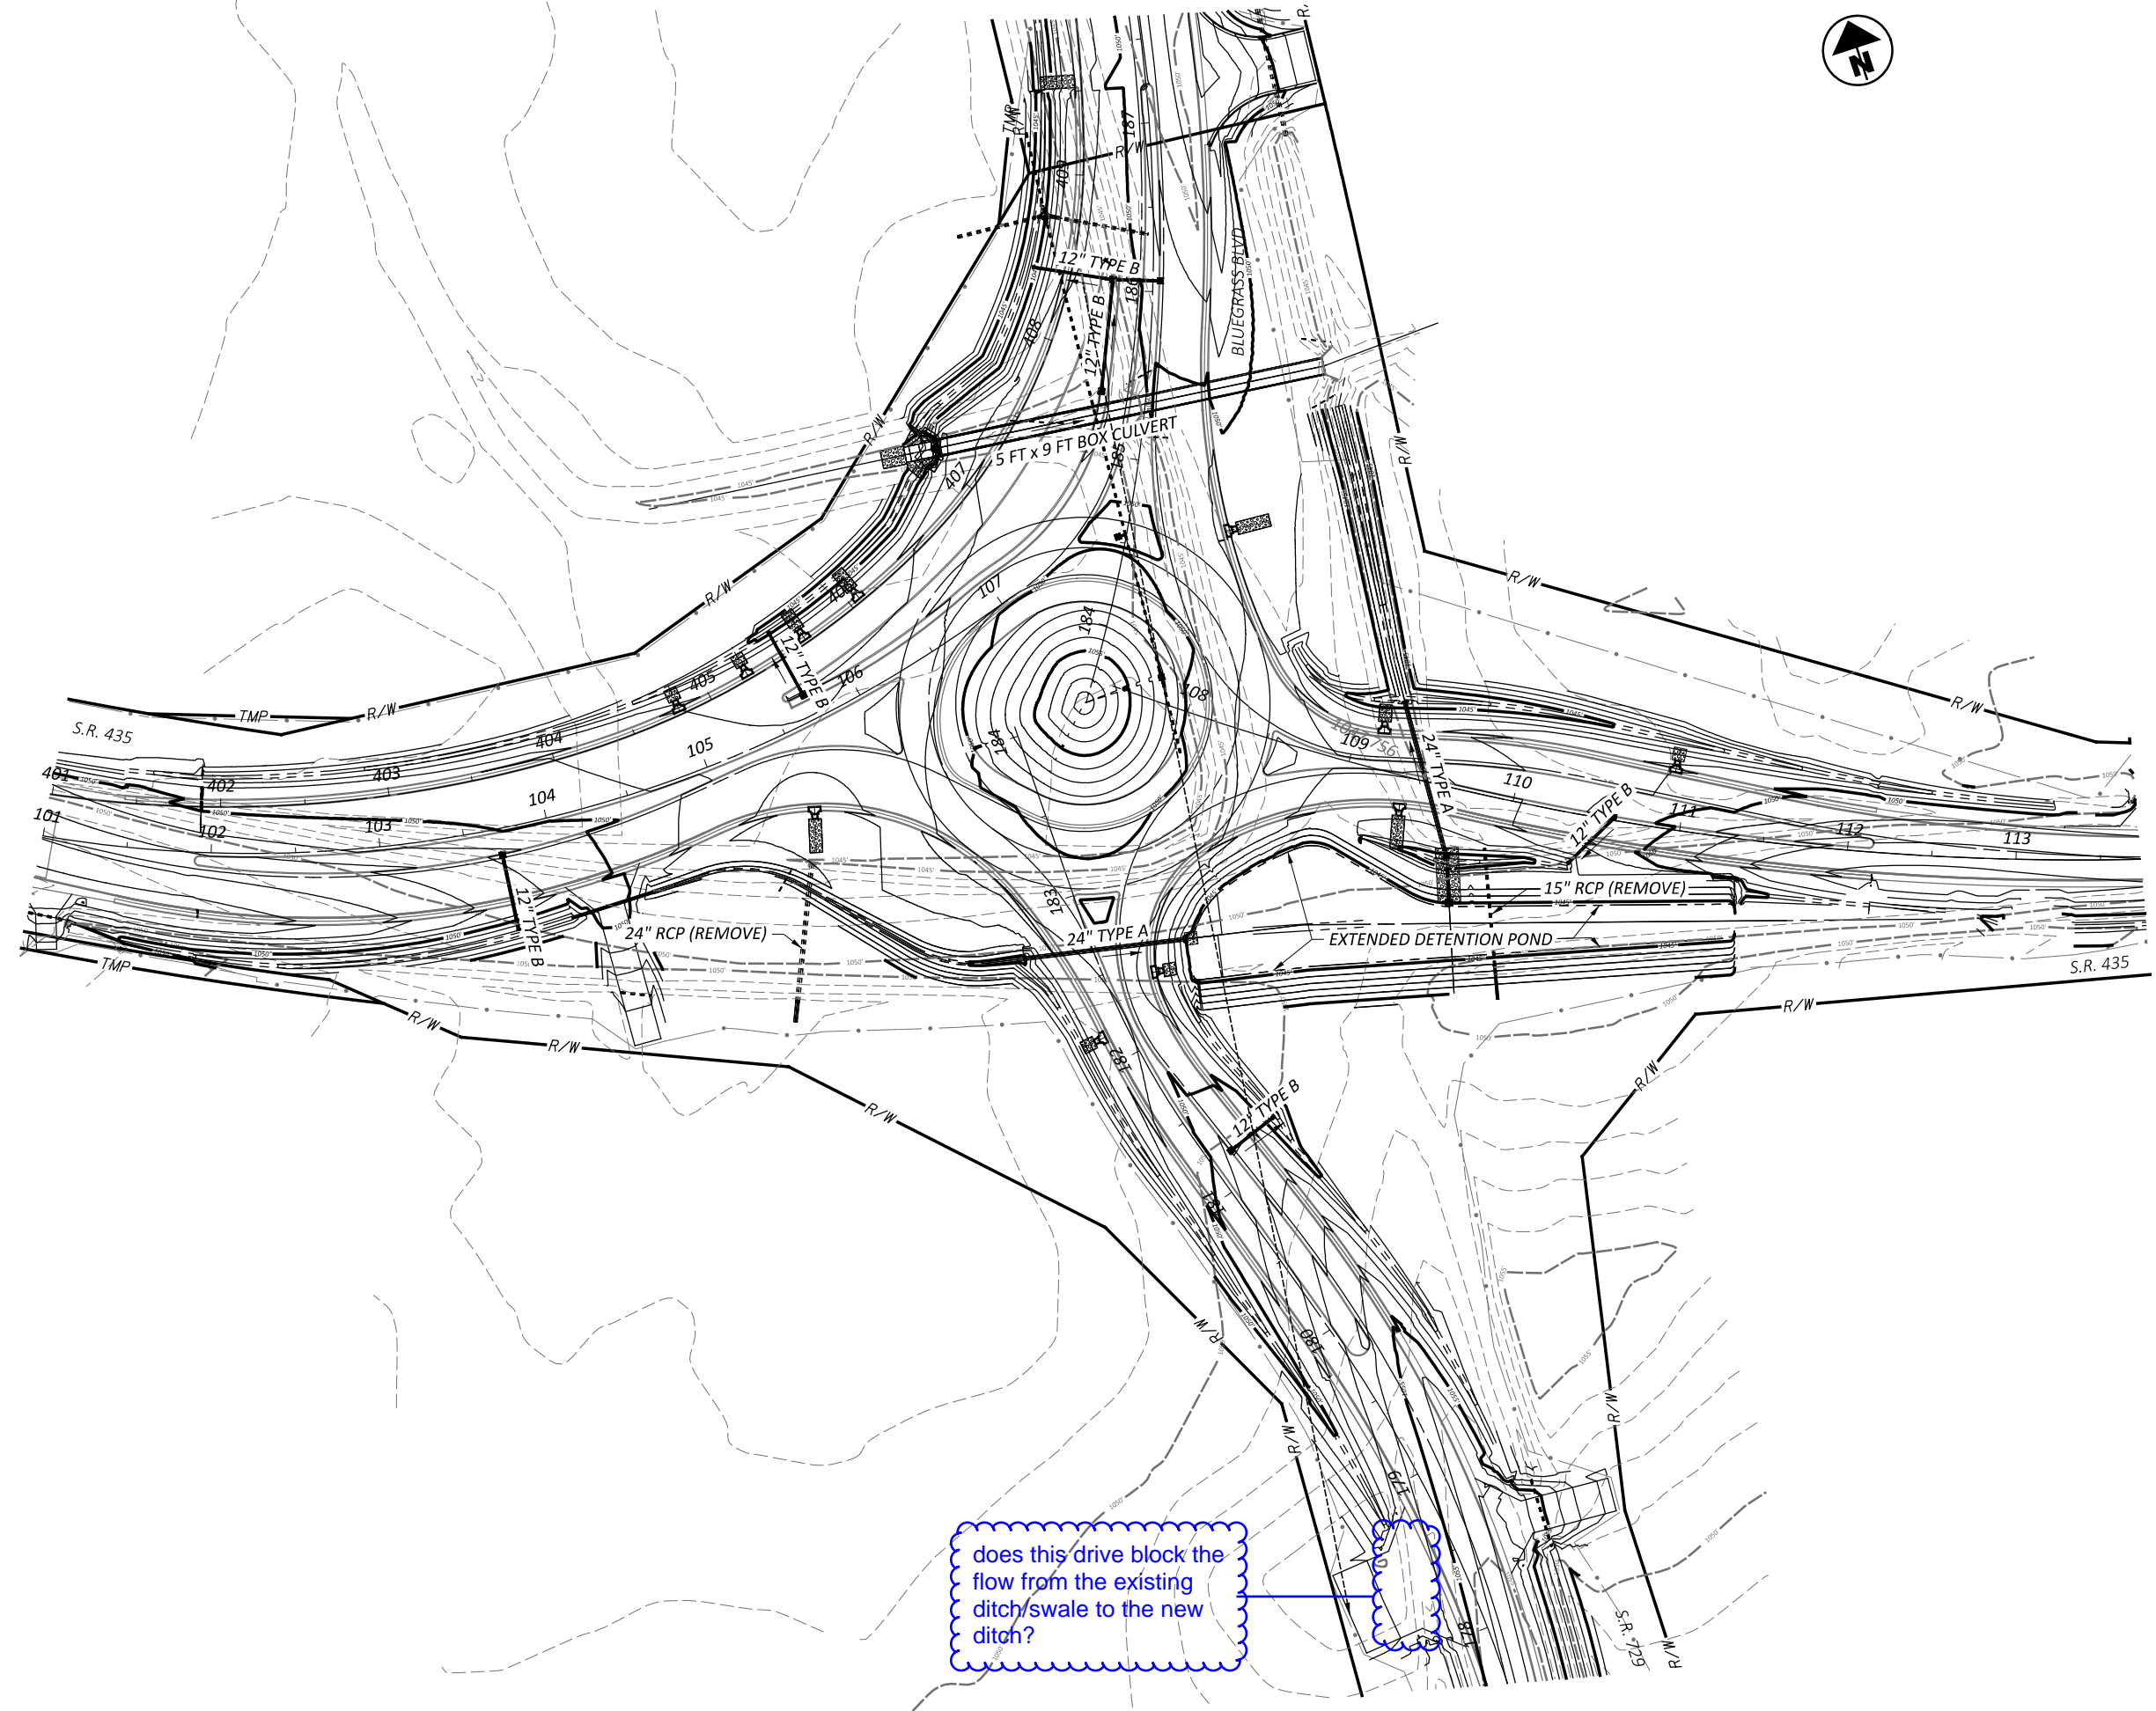

GRADING PLAN
 ROUNDABOUT - SR 435/SR725/BLUEGRASS BLVD.

does this drive block the flow from the existing ditch/swale to the new ditch?

DESIGN AGENCY	
 PALMER ENGINEERING 8350 E. KEMPER RD. SUITE B CINCINNATI, OH 45249 513-469-1600	
DESIGNER	DPF
REVIEWER	DCJ MM-DD-YY
PROJECT ID	117955
SHEET TOTAL	P. 226 228

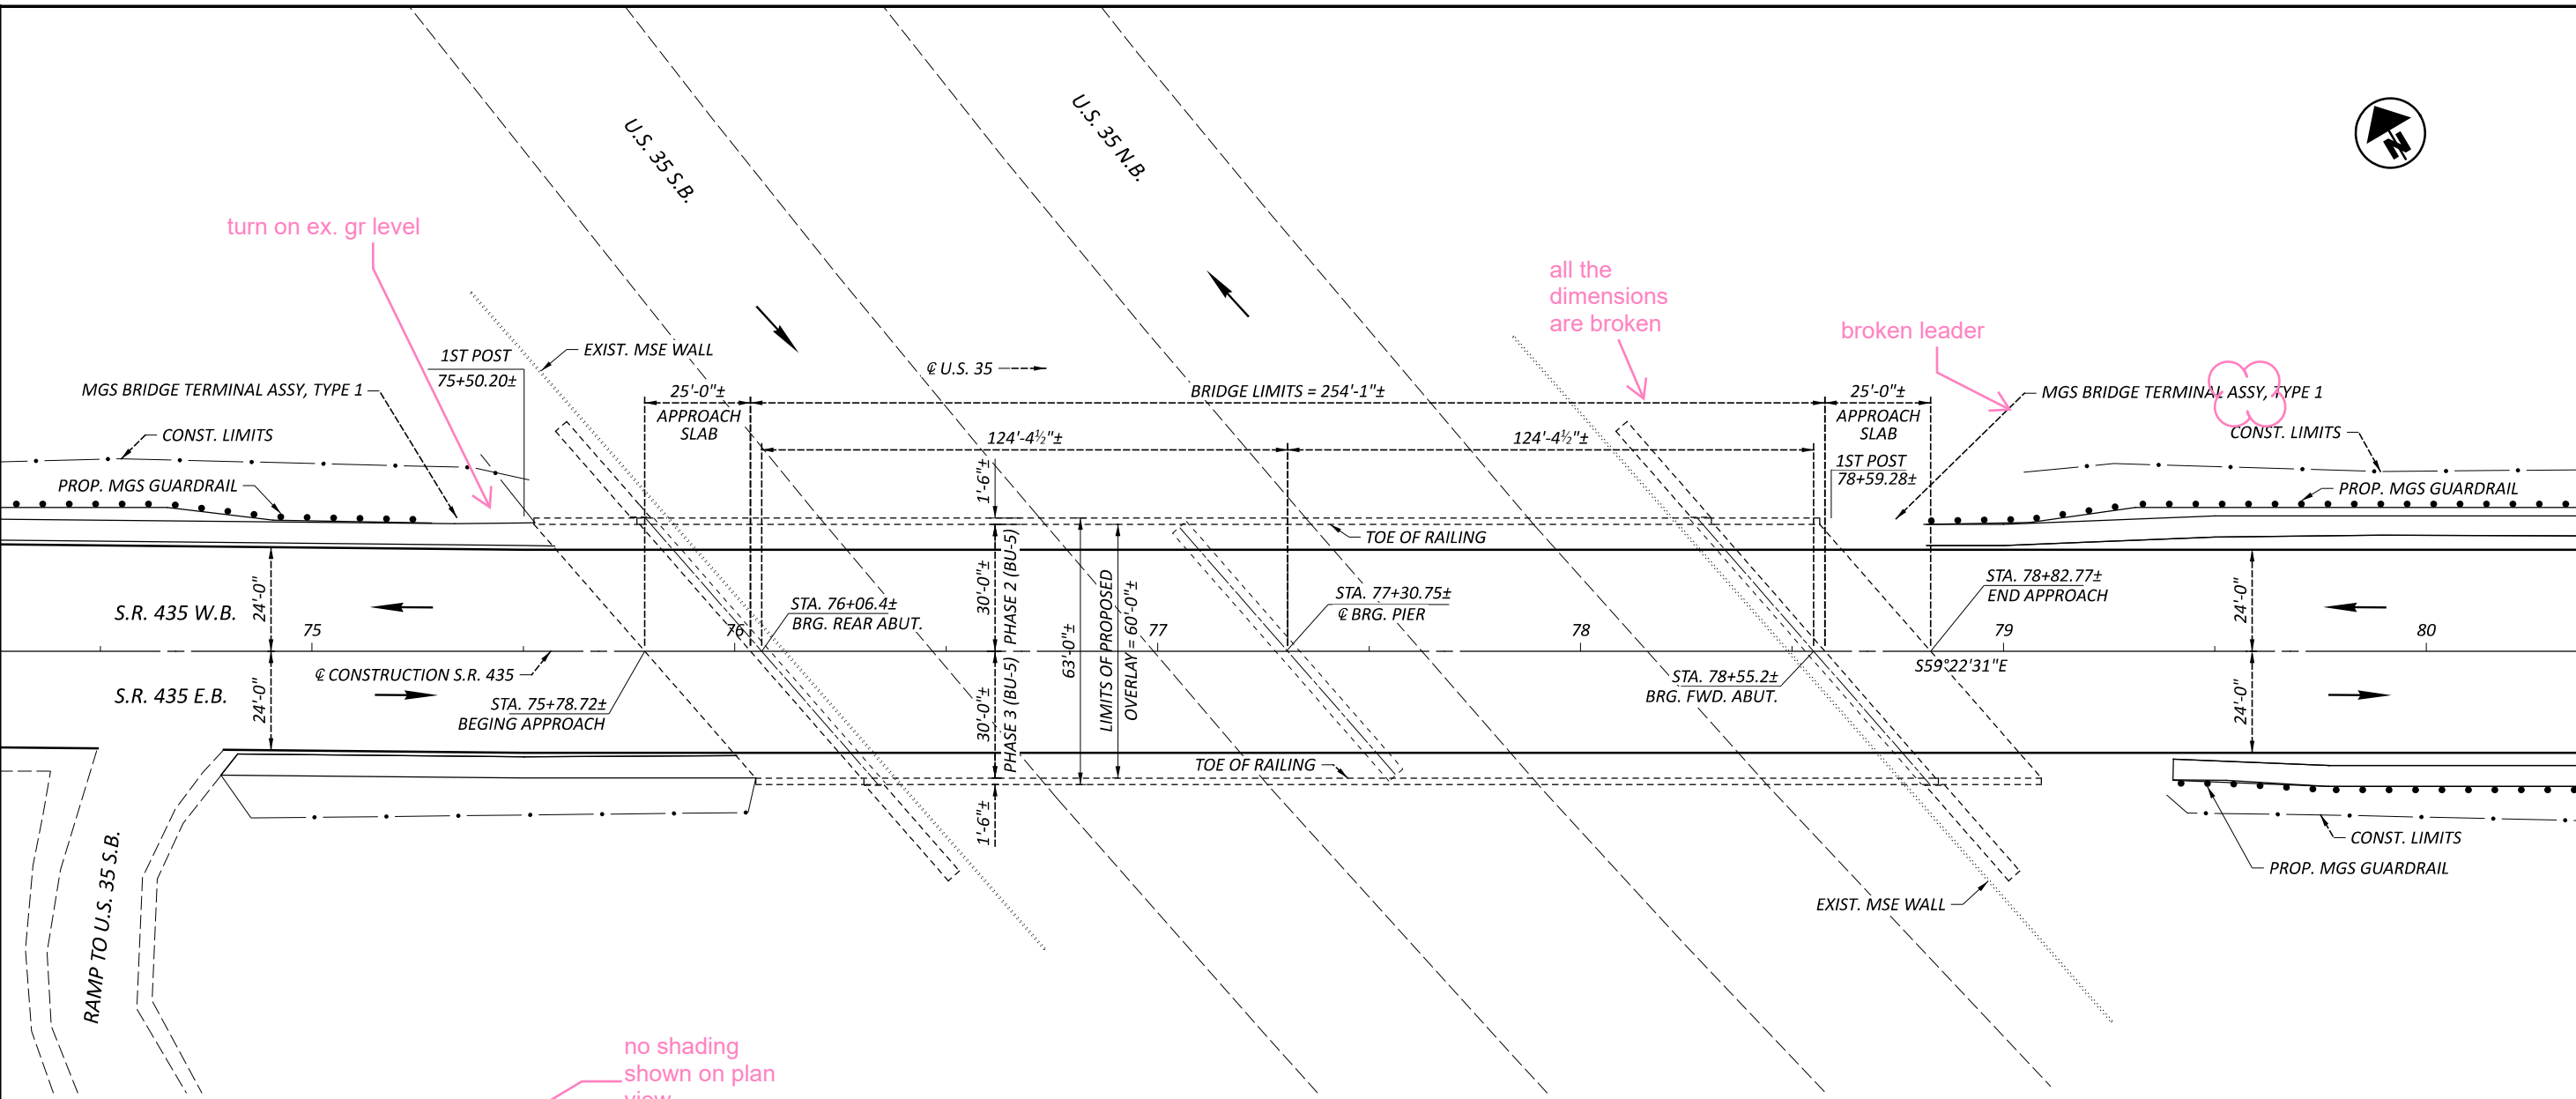


PLAN

LEGEND


■ LIMITS OF SDC OVERLAY
 W/MACRO-SYNTHETIC FIBERS

no shading
 shown on plan
 view

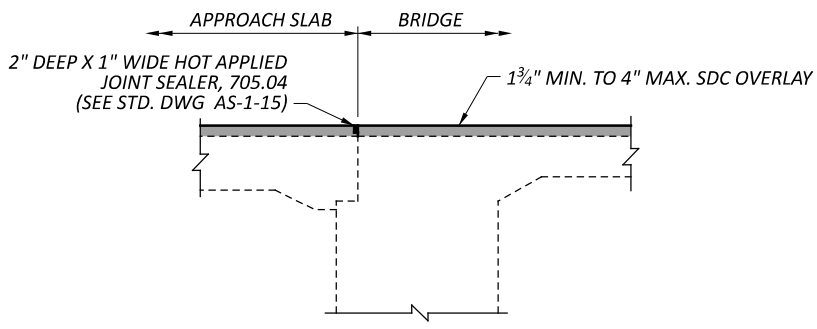


APPROACH SLAB JOINT DETAIL

EXISTING STRUCTURE	
TYPE:	2 - SPAN PCIB WITH SEMI- INTEGRAL ABUTMENTS, CAP & COLUMN, PIER, AND REINFORCED CONC. DECK
SPANS:	2 SPANS @ 124'-4 1/2"±
ROADWAY:	60'-0"± T/T RAILING
LOADING:	HS25
SKEW:	41°-08'-24" R.F.
WEARING SURFACE:	1" MONOLITHIC CONC.
APPROACH SLABS:	25'-0"± LONG (AS-1-81)
ALIGNMENT:	TANGENT
CROWN:	0.016 FT/FT
STRUCTURE FILE NUMBER:	2400308
DATE BUILT:	2001
DISPOSITION:	TO RECIEVE NEW SDC OVERLAY

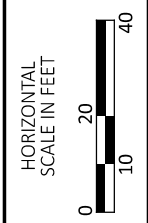


GENERAL PLAN
BRIDGE NO. FAY-035-0435
S.R. 435 OVER U.S. 35

SFN	
2400308	
DESIGN AGENCY	
8350 E. KEMPER RD. SUITE B CINCINNATI, OH 45249 513-469-1600	
DESIGNER	CHECKER
XXX	XXX
REVIEWER	
BJF MM-DD-YY	
PROJECT ID	
117955	
SUBSET	TOTAL
1	3
SHEET	TOTAL
P. 227	228

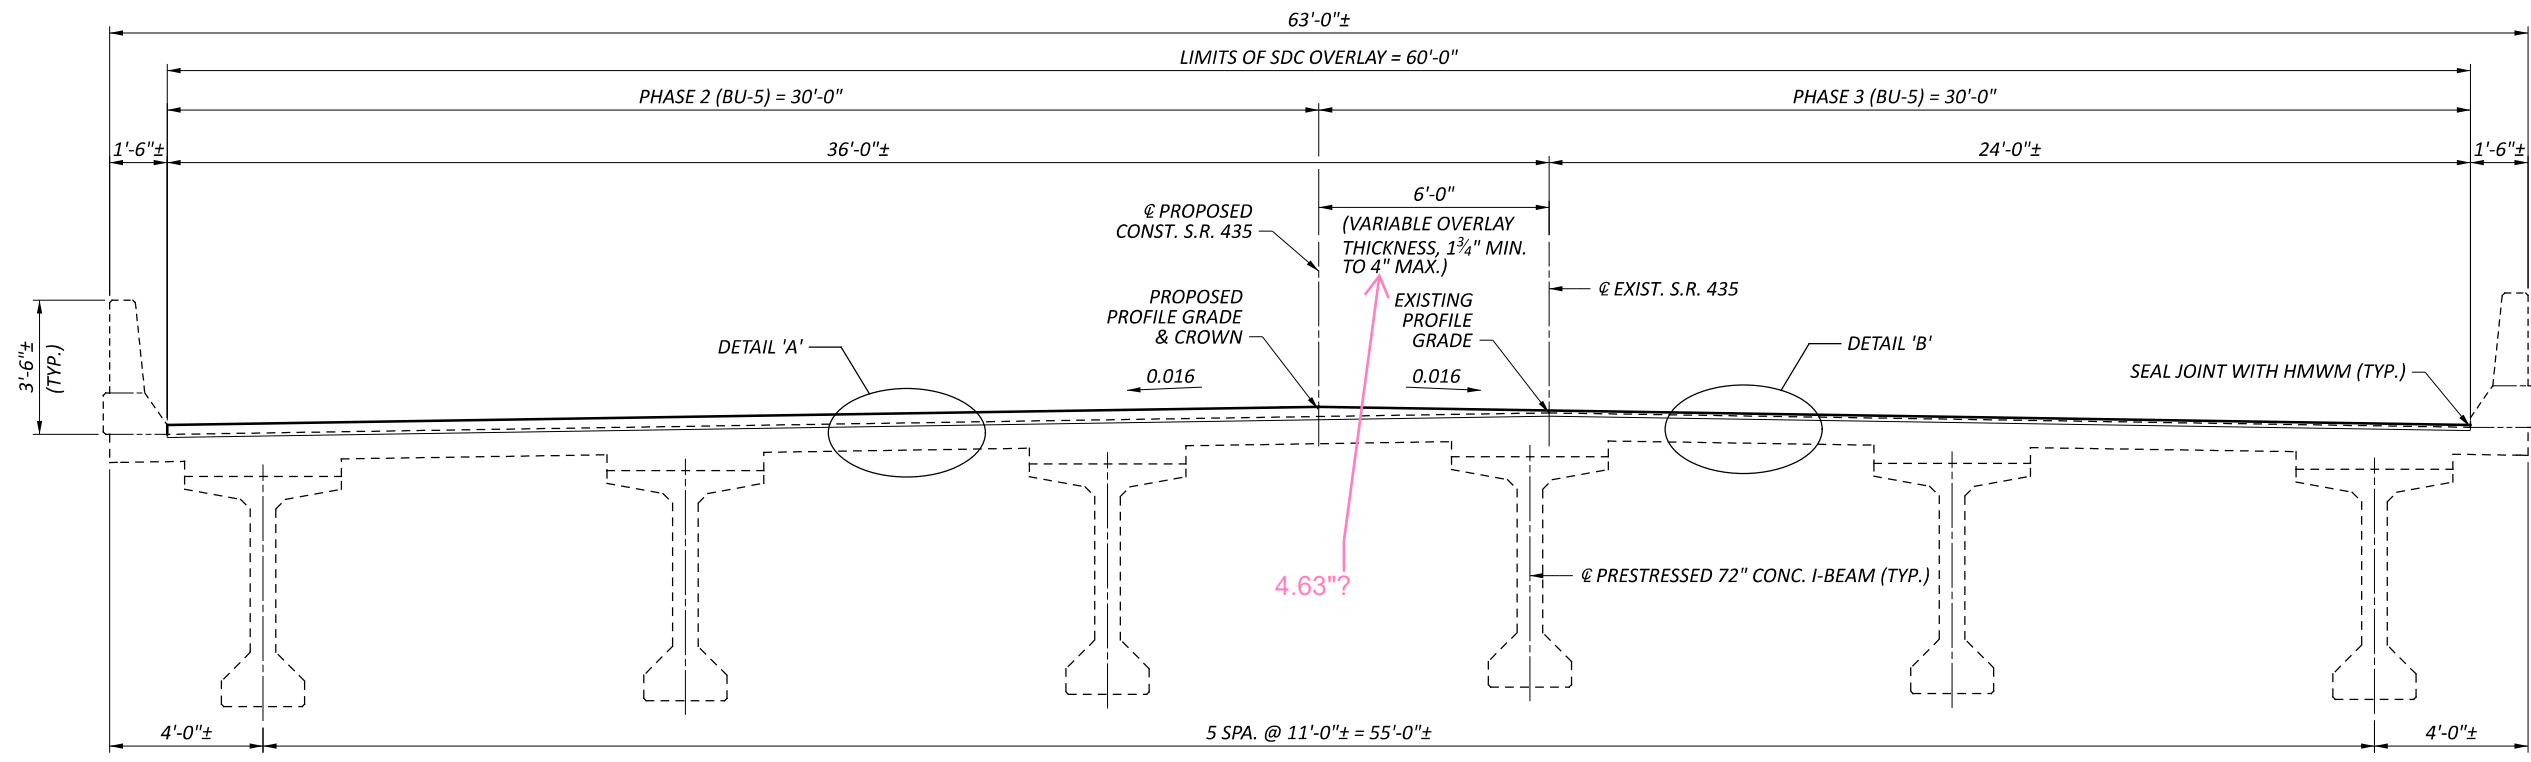

TRANSVERSE SECTION

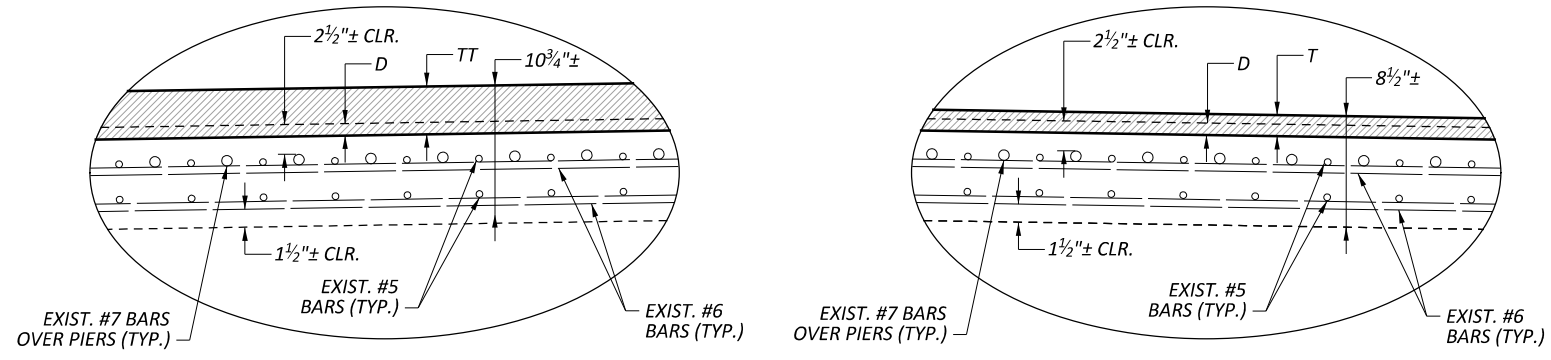

DETAIL A

DETAIL B

hydro demo
 D = 1" PLANING OF EXISTING CONCRETE DECK
 T = 1 3/4" SDC OVERLAY W/ MACRO-SYNTHETIC FIBERS
 TT = 4" SDC OVERLAY W/ MACRO-SYNTHETIC FIBERS

TRANSVERSE SECTION
 BRIDGE NO. FAY-035-0435
 S.R. 435 OVER U.S. 35

SFN	
2400308	
DESIGN AGENCY	
8350 E. KEMPER RD. SUITE B CINCINNATI, OH 45249 513-469-1600	
DESIGNER	CHECKER
XXX	XXX
REVIEWER	
BJF MM-DD-YY	
PROJECT ID	
117955	
SUBSET	TOTAL
2	3
SHEET	TOTAL
P. 228	228