


Subject	Pier Conne		Project	FRA-71-19.36			
Forces E	Q			Sheet #	1	of	2
Author	Asad	Date	10/13/22	Checker	MJR	Date	

Geotechnical Information

Per email by NEAS (Geotechnical Engineer) on 10/14/2022: a Seismic Site Class of D - Stiff Soil, is recommended.

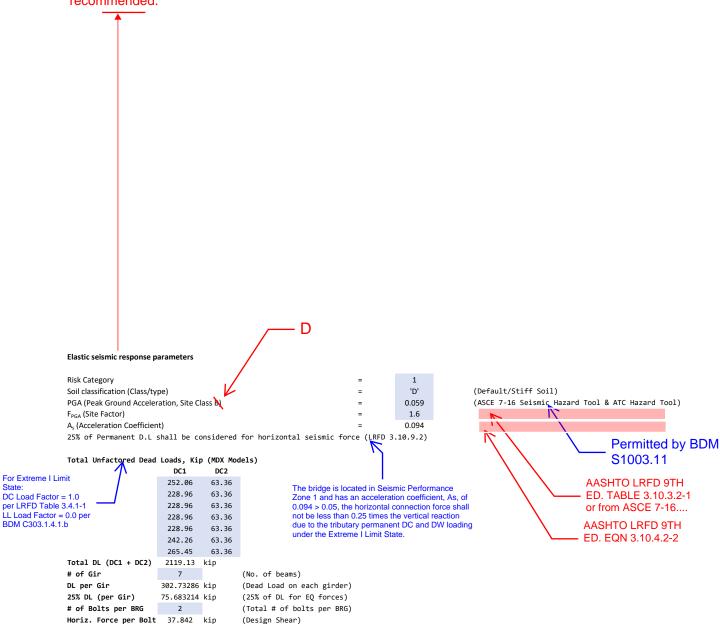


Scope: Check for minimum supports length for horizontal displacements at abutments and bearings strength at pier

Anchor Bolts Edge Distances & Spacing

State:

BRG PL. Width	2.792	Ft	
Dist. b/w bolts	2.4583	Ft	(Bolt line dia)
Exis. Column Dia	3.3333	Ft	
Min. Edge Distance	5.2500	In	

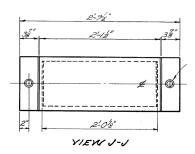



CHECKED BY: JTC **DATE:** 09/14/22 SHEET NO: 1 of 10

FRA-71-19.36 under Cleveland Ave. (Pier Bearings Strength Check/Anchor Bolts)

 $\phi_f := 1.0$

These calculations provide the capacity of a single anchor or an anchor group according to AASHTO LRFD (9th Ed.) and ACI 318 Appendix D.

 $w_{conc} \equiv 0.15$

DEFINE CONSTANTS:

Grade 36 was selected as the material for the structural bolts.

Material

Min. Yield $F_v := 36ksi$ Strength

 $F_u := 58ksi$ Min. Tensile

Strength $F_c := 4ksi$

Resistance Factors [AASHTO LRFD Bridge Design 6.5.4.2]

for Flexure (Steel)

Concrete

For ASTM F1554 bolts $\phi_{c} := 0.75$

in Shear

LRFD 6.5.5 allows us to use a resistance factor of 1.0 for bolts used as anchor rods as long as the bots are F1554. F1554 did not exist the mid 90s and therefore postdates the 1958 construction. For this reason I've left the resistance factors alone, but let talk with Fred on this...get a second opinion.

GEOMETRY AND PROPERTIES

 $d_{bolt} := 1.25in$ Nominal Anchor Bolt Diameter

 $A_{bolt} := \frac{\pi d_{bolt}^{2}}{4} = 1.23 \cdot in^{2}$ Nominal Anchor Bolt

Area

Table A.2 (a), smallest bearing area used $A_{bolt brg} := 1.817in^2$ Anchor bolt bearing area conservatively (Hex Head Bolt)


Number of Bolts per $N_{bolt} := 2$ Bearing

 $S_{\text{bolts}} := 29.5 \text{in}$ Spacing of

Bolts

Check Minimum Spacing b/w Centers of Bolts (in Standard Holes)

 $S_{min} := 3 \cdot d_{bolt} = 3.75 \cdot in$

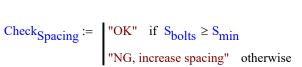

Check_{Spacing} = "OK"



CHECKED BY: JTC **DATE**: 09/14/22 SHEET NO: 2 of 10

Clear Distance b/w

Holes

$$L_c := S_{bolts} - \left(1 \cdot \frac{1}{16} in\right) = 29.44 \cdot in$$


Edge Distance

d_{edge} := 5.25in As-built plans

Effective

 $h_{ef} := 15in$ **Embedment**

As-built plans

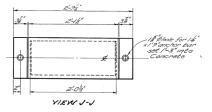

DESIGN LOADS


Refer to the load calcs above for shear forces under seismic event.

Shear Force on Bolt due to seismic effects:

Shear Load := 75.68kip

Total shear force (for both bolts)

$$V_u := max(Shear_Load) = 75.68 \cdot kip$$

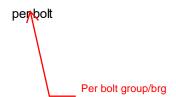



CHECKED BY: JTC **DATE**: 09/14/22 SHEET NO: 3 of 10

ANCHOR BOLT CAPACITY

[AASHTO LRFD Bridge Design

The shear resistance of anchor bolts shall be determined as specified in Article 6.13.2.12.

Shear [AASHTO LRFD Bridge Design 6.13.2.12]

Resistance

Calculation below is for shear resistance where threads are included in shear plane.

Factored Shear $R_r = \phi_s 0.50 \cdot A_{bolt} \cdot F_u \cdot N_s$

Resistance

Design Shear Force $R_{shear} := V_u$ $R_{shear} = 75.68 \cdot kip$

__ 0.75 x 0.50 x Abolt x Fu x Ns $N_s := 1N_{bolt}$ No. of Shear Planes per Anchor Bolt

 $R_n := 0.48 \cdot A_{bolt} \cdot F_u \cdot N_s$ Nominal Shear Resistance $R_n = 68.33 \cdot kip$

 $\begin{aligned} \text{Check}_s &:= & & \text{"Design is OK"} & \text{if } \varphi_s \cdot R_n > R_{shear} \\ & \text{"Revise"} & \text{otherwise} \end{aligned}$ **Shear Capacity** Check

Check_s = "Revise"

Change coding to "N.G"



CHECKED BY: JTC **DATE:** 09/14/22 **SHEET NO**: 4 of 10

CONCRETE CAPACITY

Concrete Breakout Strength in Tension (Calculated for concrete pryout strength):


[ACI D.5.2.1]

$$c_{a1} := d_{edge} = 5.25 \cdot in$$
 $S_1 := S_{bolts} = 29.50 \cdot in$ $c_{a2} := c_{a1} = 5.25 \cdot in$


Note (RD. 5.2.3): Since three edge distances (i.e. 5.25 inches) are less than the 1.5 h_{ef} (i.e. 22.5 inches), h'_{ef} shall be calculated. h'_{ef} is taken largest of $c_{a,max}/1.5 \& 1/3$ of bolts spacing. Therefore, (Bolts spacing/3 = 9.83") controls.


$$h'_{ef} := max \left(\frac{c_{a1}}{1.5}, \frac{S_{bolts}}{3} \right) = 9.83 \cdot in$$

For A_{nco} & A_{nc}, use reduced embedment of anchor.

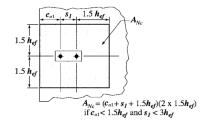

Cite: Per ACI 318-14, 17.4.2.3

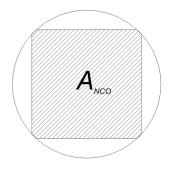

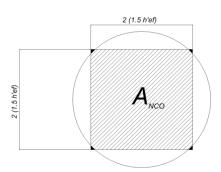

$$A_{Nco} := 866.71 \text{in}^2$$

$$N_{holt} \cdot A_{Nco} = 1.73 \times 10^3 \cdot in^2$$

 (A_{nco}) (for non ciruclar edges) = $9h_{ef}^2$ = 870 in². However, due to ciruclar edge constraints, the area is slightly reduced. Reduced (or effective) h'_{ef} shall be used for calculation of area.

$$A_{Nc} := (S_1) \cdot (27.01 \text{ in})$$
 (27.01" is taken from 0

(27.01" is taken from CAD for given bolt spacing)

$$A_{Nc} = 796.80 \cdot in^2$$

check :=
$$| \text{"ok"} \text{ if } A_{Nc} \leq N_{bolt} \cdot A_{Nco}$$
 $| \text{"NG"} \text{ otherwise} |$

$$A_{Nc} = \min(A_{Nc}, N_{bolt} \cdot A_{Nco}) = 796.80 \cdot in^2$$



modification for eccentric load (D5.2.4)

 $e_N := 0$ in For single corner anchor in tension, e'_N shall be 0

$$\begin{split} \Psi_{ec,N} \coloneqq \frac{1}{1 + \frac{2e_N}{3h_{ef}}} = 1.00 \\ & \qquad \qquad \Psi_{ec,N} \coloneqq \min \left(\Psi_{ec,N}, 1.0 \right) = 1.0 \end{split}$$



CHECKED BY: JTC **DATE:** 09/14/22

SHEET NO: 5 of 10

CALCULATION SHEET

modification for edge effects (D5.2.5)

 $\Psi_{\rm ed,N} := \begin{bmatrix} 1 & \text{if } c_{a1} \ge 1.5h_{\rm ef} \\ \\ 0.7 + 0.3 \cdot \frac{c_{a1}}{1.5h_{\rm ef}} & \text{if } c_{a1} < 1.5h_{\rm ef} \end{bmatrix}$ = 0.77Per ACI 318-14, $\Psi_{\rm C.N} := 1.25$ for cast-in anchors R17.4.2.3. Should he be h'ef here too?

Modification for cracked section (D5.2.6)

Modification for post-installed anchors (D5.2.6)

 $\Psi_{cp,N} \coloneqq 1.0 \quad \text{for cast-in anchors}$

Basic concrete breakout strength of a single anchor in tension in cracked concrete

 $k_c := 24$ for cast-in-anchors

17 = Post-installed anchors 24 = Cast-in anchors

$$N_b := k_c \cdot \sqrt{\frac{F_c}{(psi)}} \cdot \left[\frac{h_{ef}}{(in)} \right]^{1.5} \cdot (lbf) = 88.18 \cdot kip$$

Nominal concrete breakout strength (D5.2)

$$N_{cbg} := \frac{A_{Nc}}{A_{Nco}} \cdot \left(\Psi_{ec,N} \cdot \Psi_{ed,N} \cdot \Psi_{c,N} \cdot \Psi_{cp,N} \cdot N_b \right) = 78.03 \cdot kip$$
 Compare to Nua



CHECKED BY: <u>JTC</u>

DATE: <u>09/14/22</u>

SHEET NO: <u>6 of 10</u>


Concrete Breakout Strength in Shear:


Assembly 1

Projected Area for single anchor in a deep member Projected Area of Failure Surface (at 35 deg cone) at its edge for a single or group of anchors.)

$$A_{Vco} := 4.5c_{a1}^{2} = 124.03 \cdot in^{2}$$

$$A_{Vc} := \left[S_1 + \left(\frac{c_{a1}}{\cos(35 \text{deg})} \right) \cdot 2 \right] \cdot 1.5c_{a1} = 333.26 \cdot \text{in}^2$$

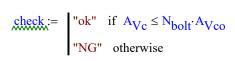

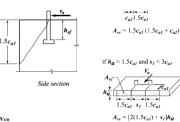

check = "NG"

$$A_{\text{Vc}} = \min(A_{\text{Vc}}, N_{\text{bolt}} \cdot A_{\text{Vco}}) = 248.06 \cdot \text{in}^2$$

Basic concrete breakout strength (cracked concrete)

$$V_b = 8 \cdot \left(\frac{l_e}{d_{bolt}}\right)^{0.2} \cdot \sqrt{\frac{d_{bolt}}{in}} \cdot \sqrt{\frac{F_c}{psi}} \cdot \left(\frac{c_{a1}}{in}\right)^{1.5} \cdot (lbf)$$

$$d_{bolt} = \frac{5}{4} \cdot in$$
 $l_e := h_{ef} = 15.00 \cdot in$ D.6.2.2

35°



CHECKED BY: <u>JTC</u>

DATE: <u>09/14/22</u>

SHEET NO: <u>7 of 10</u>

$$V_b := 8 \cdot \left(\frac{l_e}{d_{bolt}}\right)^{0.2} \cdot \sqrt{\frac{d_{bolt}}{in}} \cdot \sqrt{\frac{F_c}{psi}} \cdot \left(\frac{c_{a1}}{in}\right)^{1.5} \cdot (lbf) = 11.19 \cdot kip$$

Modification for eccentricity (D6.2.5)

$$\Psi_{\text{ec},V} := \frac{1}{1 + \frac{2 \cdot e_{V}}{3 \cdot c_{a1}}} = 1.00$$

(iii) Concrete breakout

Modification for edge effect (D6.2.6)

$$\Psi_{\rm ed,V} := \begin{bmatrix} 1 & \text{if } c_{a2} \ge 1.5c_{a1} \\ \\ 0.7 + 0.3 \cdot \frac{c_{a2}}{1.5c_{a1}} & \text{if } c_{a2} < 1.5c_{a1} \end{bmatrix} = 0.90$$

$$\Psi_{\rm ed,V} = 0.90$$

Modification for cracked concrete (D6.2.7)

 $\Psi_{c,V} := 1.2$ for anchors in cracked concrete with supplementary reinforcement of a No. 4 bar or greater between the anchor and the edge

Nominal Concrete Breakout Strength

$$V_{cbg} \coloneqq \frac{A_{Vc}}{A_{Vco}} \cdot \Psi_{ec,V} \cdot \Psi_{ed,V} \cdot \Psi_{c,V} \cdot V_b = 24.16 \cdot \text{kip}$$
 [ACID.6.2.1]

Concrete Pryout Strength:

$$\begin{aligned} & h_{ef} = 15.00 \cdot in \\ & k_{cp} := \begin{vmatrix} 1.0 & \text{if } h_{ef} < 2.5 \text{in} \\ 2.0 & \text{if } h_{ef} \ge 2.5 \text{in} \end{vmatrix} \\ & N_{cbg} = 7.80 \times 10^4 \cdot lbf \end{aligned}$$

$$V_{cpg} := k_{cp} \cdot N_{cbg} = 1.56 \times 10^5 \cdot lbf$$

Factored Strength:

$$\phi V_n \ge V_u$$
$$\phi N_n \ge N_u$$



CHECKED BY: JTC **DATE**: 09/14/22 SHEET NO: 8 of 10

Note: Condition is determined from ACI

355.2 conc<u>rete breakout, side-face blowout, pullout or pryout strength</u>

 $\phi_{c,V} := 0.75$ i) shear loads

Condition A is applied due to provision of supplemental reinf.

ii) tension loads $\phi_{c,N} := 0.75$

Shear:

Concrete breakout strength

 $\varphi_{c,V} = 0.75 \qquad V_{cbg} = 24160 \cdot lbf \qquad \varphi_{c,V} \cdot V_{cbg} = 18 \cdot kip$

Concrete pryout strength

 $\phi_{c,V} = 0.75$ $V_{cpg} = 156056 \cdot lbf$ $\phi_{c,V} \cdot V_{cpg} = 117 \cdot kip$

FACTORED SHEAR CAPACITY

 $\Phi V_n := \min(\Phi_{c,V} \cdot V_{cbg}, \Phi_{c,V} \cdot V_{cpg}) = 18 \cdot \text{kip}$

 $\label{eq:Check2} \begin{array}{ll} \text{Check}_2 := & \text{"OK"} & \text{if } \varphi V_n > V_u \\ \\ \text{"Not OK, Modify"} & \text{otherwise} \end{array}$

Check₂ = "Not OK, Modify"

Embedment Length

 $l_e = 15.00 \cdot in$



 Subject
 Min.
 Connection
 Lengths
 Project
 FRA-71-19.36

 Expansion
 BRG
 at Abut.
 Sheet#
 1
 of
 2

 Author
 Asad
 Date
 10/14/22
 Checker
 MJR
 Date

Minimum Support Length Requirements BDM 303.1.4.1.a & LRFD 9th Ed. 4.7.4.4 for seismic zone 1 Revise to read, 266.68 FT (Length b/w adjacent expansion joints, bridge length) Footing Thickness All the bearings are fixed. For the min support Column average heights length at the abutments this should be 1/2 Span. Bot. of FTG elev. Depth of FTG 793.9 FT (Record Plans) Should add the 3' 3 FT (Record Plans) footing thickness Top of FTG elev. 790.9 FT Top of Col. 1 elev. 813.97 FT (Record Plans) Col. 1 Ht 23.07 FT Top of Col. 2 elev. 814.23 FT Col. 2 Ht 23.33 FT (Record Plans) 814.48 FT Top of Col. 3 elev. (Record Plans) Col. 3 Ht 23.58 FT Top of Col. 4 elev. 814.72 FT (Record Plans) Col. 4 Ht 23.82 FT Top of Col. 5 elev. 814.68 FT (Record Plans) Col. 5 Ht 23.78 FT Top of Col. 6 elev. 814.63 FT 814.57 FT (Record Plans) 23.73 FT Col. 6 Ht Top of Col. 7 elev. (Record Plans) Col. 7 Ht 23.67 FT Average Ht. of a column 23.56857 FT Skew 55.9025 Deg Per ODOT BDM 2020,C405.7 21.16 In Thermal Movement Per ODOT BDM 2020, S.1003.21 Expansion Coefficient, α 6.5E-06 1 / deg F 120 F T_{max} $\Delta r = \alpha L (T_{MaxParism} - T_{MinP})$ (3.12.2.3-1)-30 $\mathsf{T}_{\mathsf{min}}$ Construction Temp. 60 L = expansion length (in.) $\alpha = \text{coefficient of thermal expansion (in./in./°F)}$ Delt_T 90 Span Expansion Length 770.64 In Thermal Force 0.45082 In Total Required Beam Seat 21.9684 In LRFD 9th Ed. 3.12.2.3-1 Available Beam Seat 36 In (Record Plans) Requirement OK Face o brgs backwall. Thermal 34° 05′ 51″ Movement, DeltaT Egirder Face of breastwall. TYPICAL SECTION G-G

AS INDICATED ON SHEET Nº. 193.