STATE OF OHIO
DEPARTMENT OF TRANSPORTATION
AUG-CR33A-15.02
DUCHOUQUET TOWNSHIP
AUGLAIZE COUNTY

P.I.D. 9046
SJW!

FHWA REGION	STATE	PROJECT
5	OHIO	

AUGLAIZE COUN
AUG-CR33A-15.0

RIGHT-OF-W

ACQUIRING AGENCY: AUGLAIZE C

DESIGN DESGNATION

Current ADT (1990).....3015
Design Year ADT (2010).....4225
DHV..... 355
D..... 55%
T..... 13%
Design speed..... 45 MPH
Legal speed..... 45 MPH
Functional Classification Major Collector

Design Exception: Shoulder width 8' left, 7' right
Approved January 17,1992

CONVENTIONAL SIGNS

County Line
Township Line
Section Line
Corporation Line
Center Line 24
Trees Stumps (to be removed)
construct on limit sign

Railroad
Right of way (existing) R/W
Right of way (proposed) R/W
Property Line
Guardrail (existing) (proposed)
Utilities poles Telephone Power

INDEX OF SHEETS

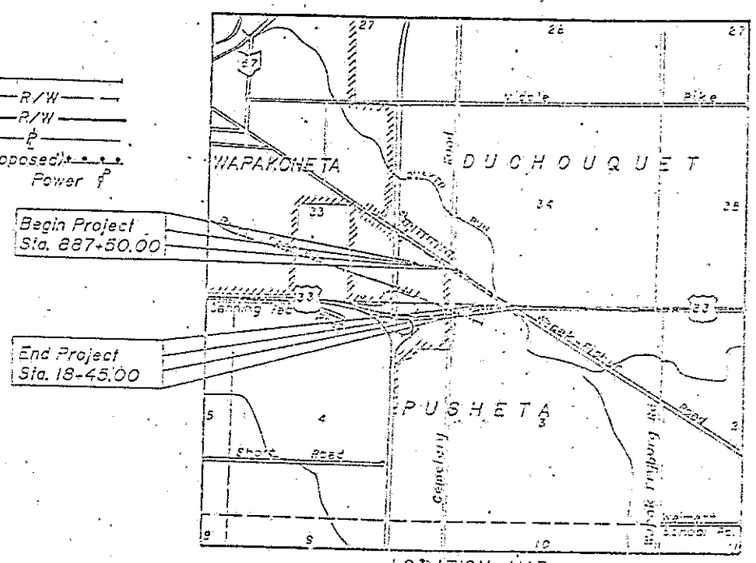

LOCATION MAP

SCALE IN MILES
0 .25 .50 1 2

Portion to be improved
State & Federal Routes
Detour
Other Roads

SCALES

Plan: 0' 5' 10' 20'
Profile: Horizontal 0' 50' 100' Vertical 0' 1' 2' 3' 4' 5' 10'
Cross-Section: 0' 1' 2' 3' 4' 5' 10'

We, the Commissioners of Auglaize County in formal session hereby approve these plans and certify that the necessary right of way is available. We agree to maintain the project in a manner satisfactory to the Director of the State of Ohio or his duly authorized representative and will make ample provision each year for such maintenance.

Done under authority of Section 5535.01 and 5555.02 et seq of the Ohio's Revised Code.

Approved: _____
Date _____

1993 SPECIFICATIONS

The standard specifications of the State of Ohio, Departmen of Transportation, including changes and supplemental specificati listed in the proposal shall govern this improvement.

I hereby approve these plans and declare that the making of this improvement will require the closing to traffic of this highwa and that detours will be provided as indicated on these plans.

Approved _____ Auglaize County Engineer
Date _____

Approved _____ District Deputy Director ~~of Transporta~~
Date _____ Estate Administratio

Approved _____ Engineer, Bureau of Bridges and Stru Design
Date _____

Approved _____ Chief Engineer, Planning and Design
Date _____

Approved _____ Director Department of Transportatio
Date _____

FEB 25 1993

Plans Prepared By
Auglaize County Engineer's Office
1014 South Blackhoof Street
Wapakoneta, Ohio 45895

STATE OF OHIO DAN ALLEN BENNETT 42353 REGISTERED PROFESSIONAL ENGINEER

SUPPLEMENTAL PRINTS OF STANDARD CONSTRUCTION DRAWINGS				SUPPLEMENTAL SPECIFICATIONS	
DRAWING	DATE	DRAWING	DATE	NUMBER	DATE

DEPARTMENT OF TRANSPOR
FEDERAL HIGHWAY ADMINIST

APPROVED:

DIVISION ADMINISTRATOR

Project AUG-CR33A-15.02
Date of Letting _____, 199__ Contract No. _____

PROPERTY MAP
AUGLAIZE COUNTY
DUCHOUQUET TOWNSHIP

Is This Also the Center Line?

FHWA REGION	STATE	PROJECT
5	OHIO	

AUGLAIZE COUN
AUG-CR33A-15.

ACQUIRING AGENCY: AUGLAI

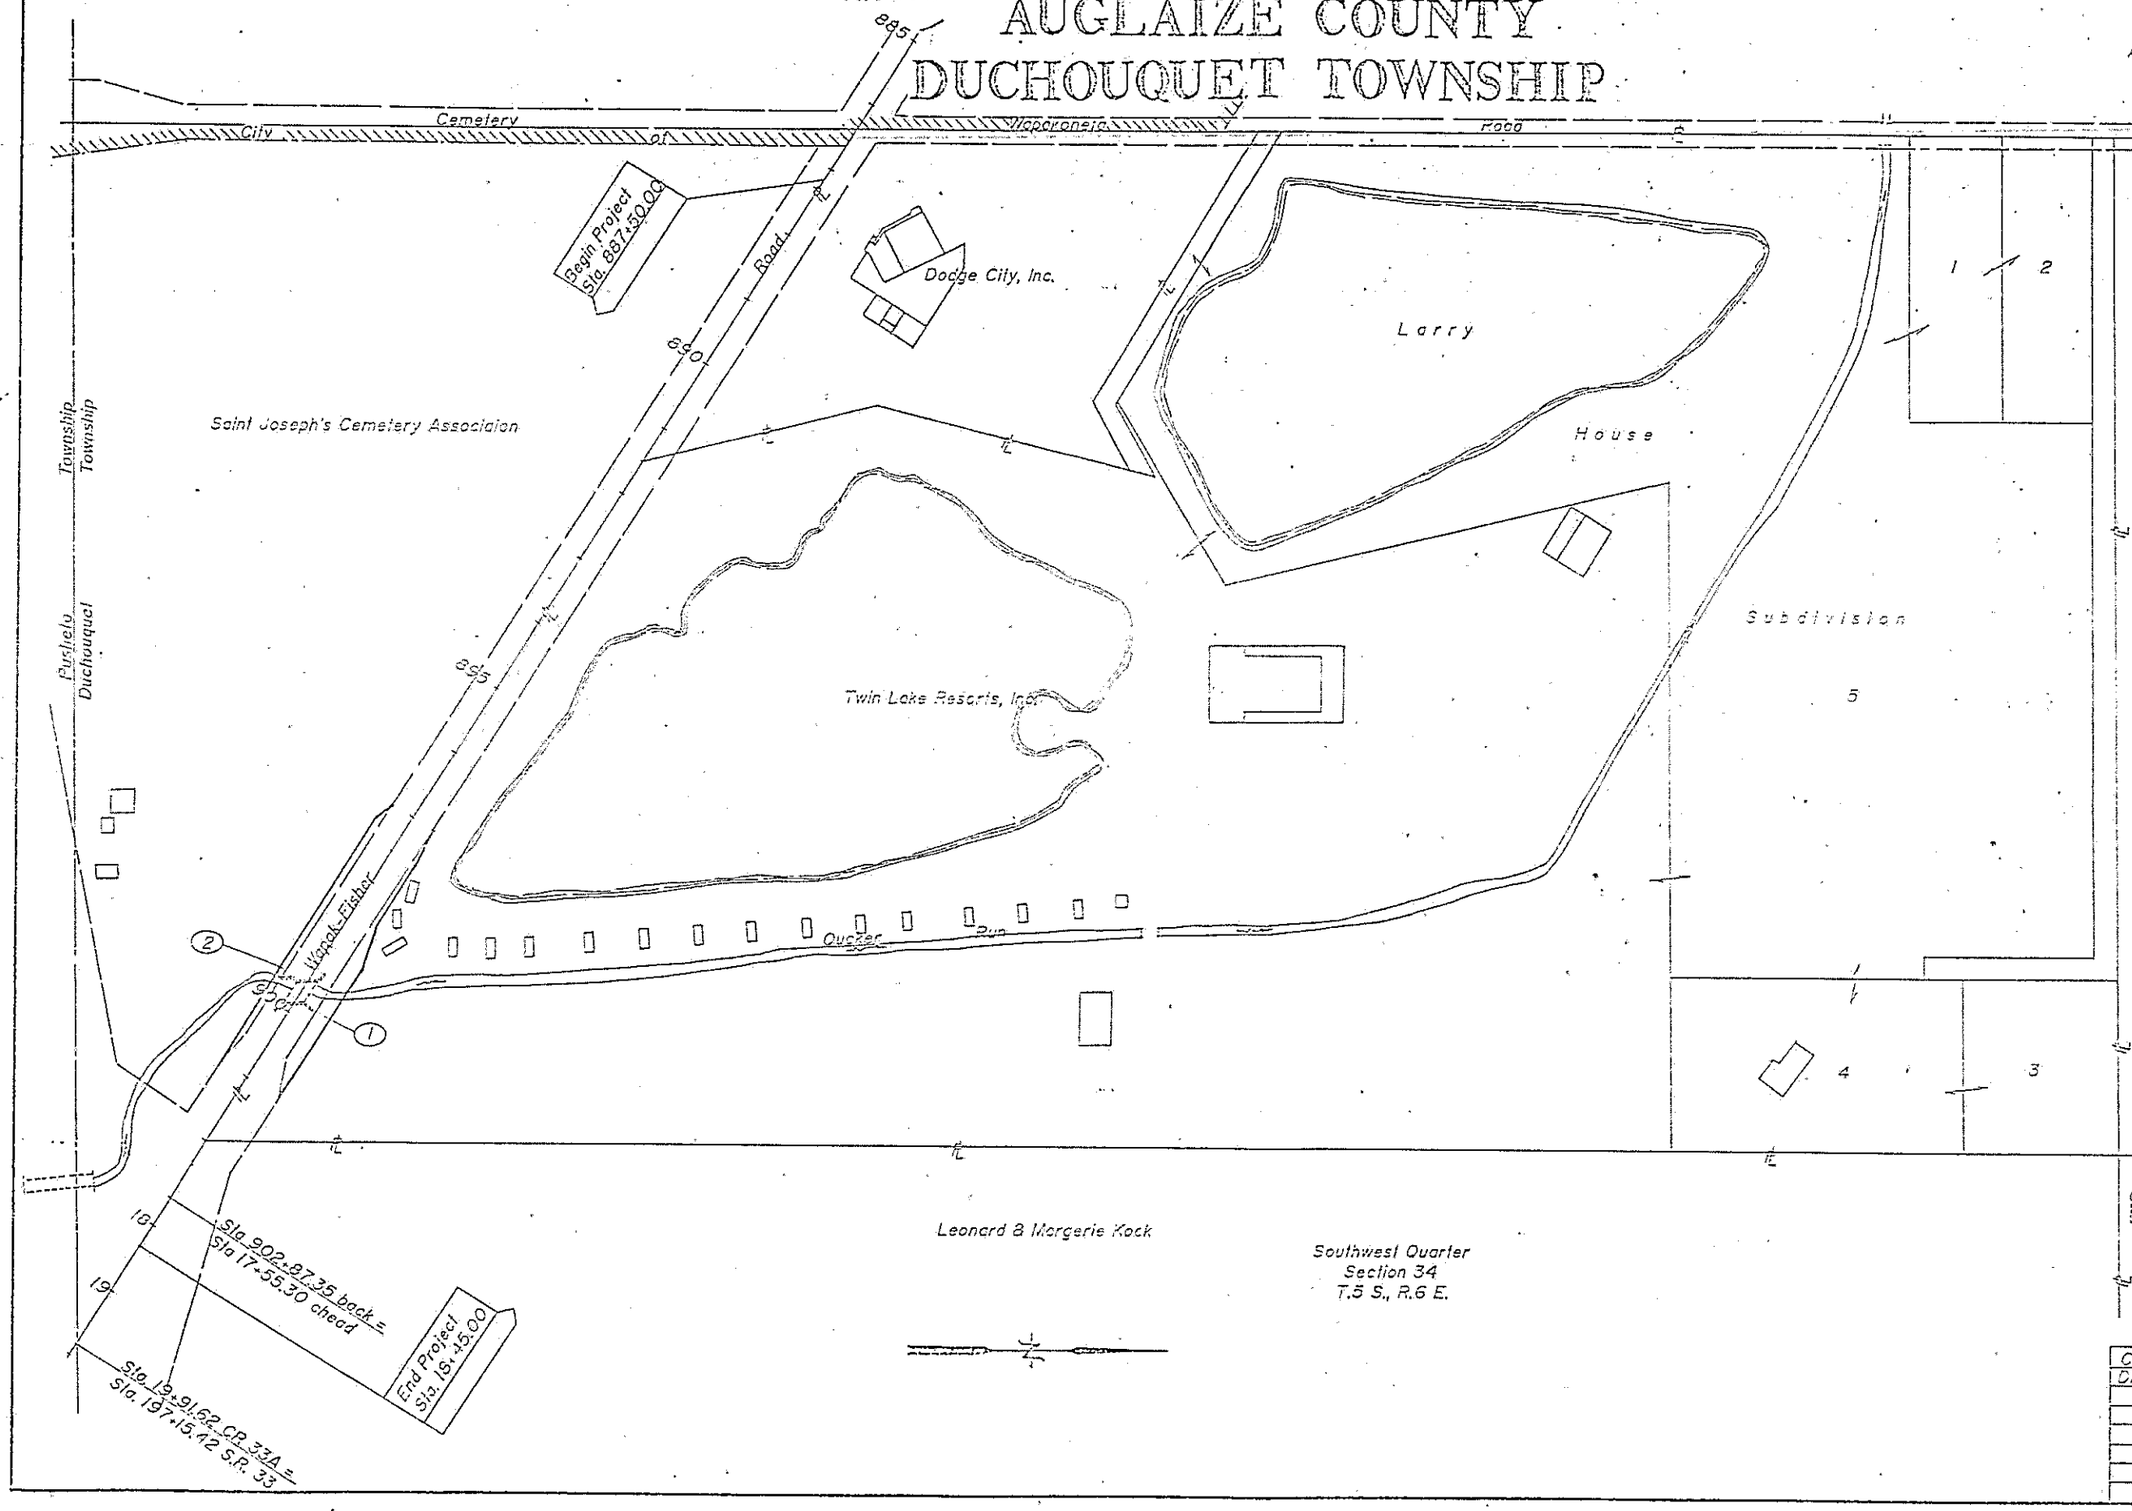

UTILITIE

Electric: Dayton Power
409 East Mor
Dayton, Ohio
Phone No. (51

Telephone: Telephone Ser
2 Willipie Stre
Wapakoneta, O
Phone No. (41

Water: City of Wapako
102 Perry Stre
Wapakoneta, O
Phone No. (41

Gas: West Ohio Gas
319 West Mark
Lima, Ohio 45
Phone No. (41

Needs!
Parcel Lo
Structure Ke

Show any sign
utility Easem
Recording

FEB 25 1993

0' 100' 200' 300'
Scale in feet

COMPLETION DATE: October 23,

DATE	REVISION

AUG-CR33A-15.02 PROPERTY MAP

EXTRA REGION	STATE
5	OHIO

AUGL
AUG-

Show distance between the new permanent take and any structures
show all trees or personality in the proposed take
mark SAVE or to be removed on all trees, shrubs etc

Cemetery Road - 35' R/W
Established 1855
B.O.C.C. Jr. I, page 255

Twin Lake Resorts, Inc.

pond

metal building
1 story

Dodge City, Inc.

stone

asphalt
concrete

Begin Project
Sta. 887+50.00

sign

propane tank

R/W

℄ County Road 33A

℄ construction
℄ survey

S56°25'08"E

887 888 889 890 2+10" 891 892 893 894 895 896

shrub
24" maple
2" cedar
stone drive
16" buckeye
Wapakoneta 10.15.32
1° 00'
R/W

18" pine
5" pine
18" pine
15" pine
18" pine
15" pine
21" pine
24" tulip tree
12" pine
8" apple
24" pine
shrub
24" pine
24" pine
12" pine
15" pine
18" pine
18" pine

stone drive

Monument box
SW corner Sec. 34

Saint Joseph's Cemetery Association

Cemetery Road - 40' R/W
Established 1850
B.O.C.C. Jr. I, page 87

Southwest Quarter
Section 34

County Road 33A - 60' R/W
Established 1839
O.L.L. 37, page 319

Southwest Quarter
Section 34

Leonard C. & Margerie I. Kock

Twin Lake Resorts, Inc.

Weed margin & End Lines
for acquisition work

Conc. Frame Cabin
Conc. Frame Cabin
Conc. Frame Cabin
Deck
Conc. Frame Cabin
Conc. Frame Cabin
Quaker
stone?
Pond

Sta. 897+00
Left 30.00'
S64°56'59"E 50.56'
Sta. 897+50
Left 37.50'
Sta. 898+50
Left 37.50'
Sta. 899+00
Left 50.00'
Sta. 901+00
Left 50.00'
LINE

P.C. Sta. 901+68.30, LL 2.00'
P.I. Sta. 901+81.77, LL 2.00'
P.T. Sta. 901+95.24, LL 2.03'
R/W Mon.
+51.0

End Project
Sta. 16+45.00

Sta. 902+87.35 back
Sta. 17+55.30 ahead
Sta. 19+91.62 C.R. 33A
Sta. 19+45.42 S.R. 33

℄ Construction
P.I. Sta. 901+6
Δ = 0°08'05"
Radius = 11,459.16'
Curve length = 26.
M = 0.01'
P.C. Sta 901+68.30
P.T. Sta. 901+95.24

S56°25'08"E 200.00'
R/W
S70°27'18"E 51.54'
S56°25'08"E
R/W Mon.

℄ construction
℄ survey
S56°25'08"E
899 899 2+00 901 902 S56°21'27"E
S56°33'13"E
℄ County Road 33A 22

shrub
tree
R/W
R/W
S56°25'08"E 375.00'
R/W Mon.
R/W
shrubs

Sta. 897+00
Right 30.00'
MATCH LINE
S25°27'10"E 29.15'
Sta. 897+25
Right 45.00'

20.89
AUG-33-1690

P.I. Sta. 195+11.16
State Route 33 195

Northwest Quarter
Section 3

Number of owners: 4
Number of owners with structures: 0
Number of owners as total takes: 0

Saint Joseph's Cemetery Assoc.

SUMMARY OF ADDITIONAL RIGHT-OF-WAY — P.I.D. No. 9046

PAR.	OWNERS	Deed Book Vol.	Deed Book Page	Record Area	Total P.R.O.	Gross Take	P.R.O. in Take	Net Take	Net Residual Left	Net Residual Right	Type Fund	Remarks	COMPLET DATE
1	Twin Lake Resorts, Inc.	O.R.	26 112	26.184	0.776	0.405	0.287	0.118	25.290		Local		
2	Saint Joseph's Cem. Assoc.	63	299	18.09	1.534	0.409	0.284	0.125		17.965	Local		