WE 5/9/03

Location Map

Structure Number: AUG-75-0498 L (33-1635)
Structure File Number: 0602043
(Feature Intersected): SB IR-75 over USR-33
Project Number: 552-58
Plan Reference:
Date Measured: 1-4-93
Personnel: Thaman
Payne

Inventory File Revised _____ Date _____

Irons, May, Kremmer 3/07/03

HORIZONTAL CLEARANCE

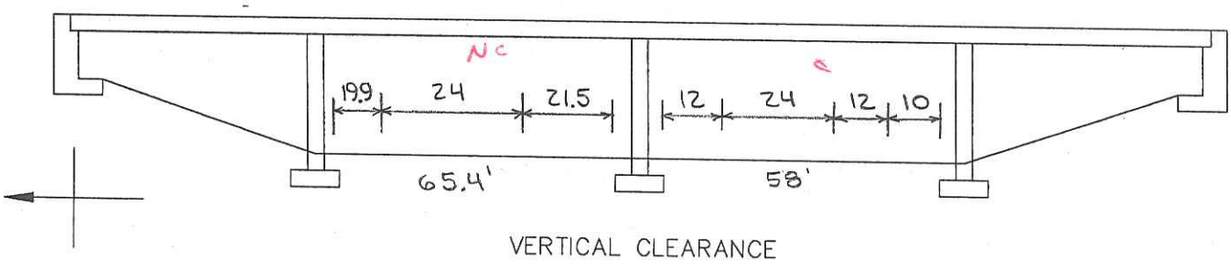

VERTICAL CLEARANCE

