WE 5/9/03

Structure Number: AUG-75-0498 R (33-1636)
Structure File Number: 0602078
(Feature Intersected): NB IR-75 over USR-33
Project Number: 552-58
Plan Reference:
Date Measured: 1-4-93
Personnel: Thaman
Payne

Location Map

Inventory File Revised _____ Date _____

Irons, Muy, Kraemer 3/07/03

HORIZONTAL CLEARANCE

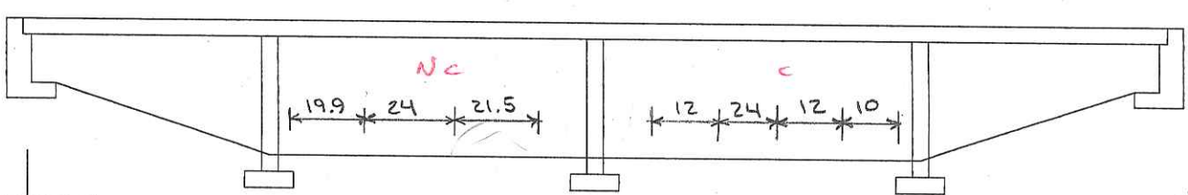

NORTH

VERTICAL CLEARANCE

