
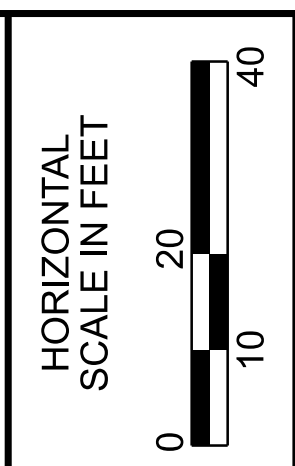


**BARRIER LEGEND**  
 Φ - END SECTION, TYPE D  
 Ω - END ANCHORAGE, TYPE D  
 Ψ - END ANCHORAGE, TYPE C1  
 Σ - BARRIER TRANSITION PIECE  
 Δ - END ANCHORAGE, TYPE C1, APP  
 Θ - SS BARRIER, TYPE C1

AREA OF SUITABLE WOODED HABITAT FOR ENDANGERED BAT SPECIES. FOR DETAILS, SEE SHEET P.011.

**CURVE DATA**  
 P.I. = STA. 4+63.03  
 Δ = 31°35'13" RT  
 Dc = 03°30'00"  
 R = 1,637.02'  
 T = 463.03'  
 L = 902.48'  
 E = 64.22'

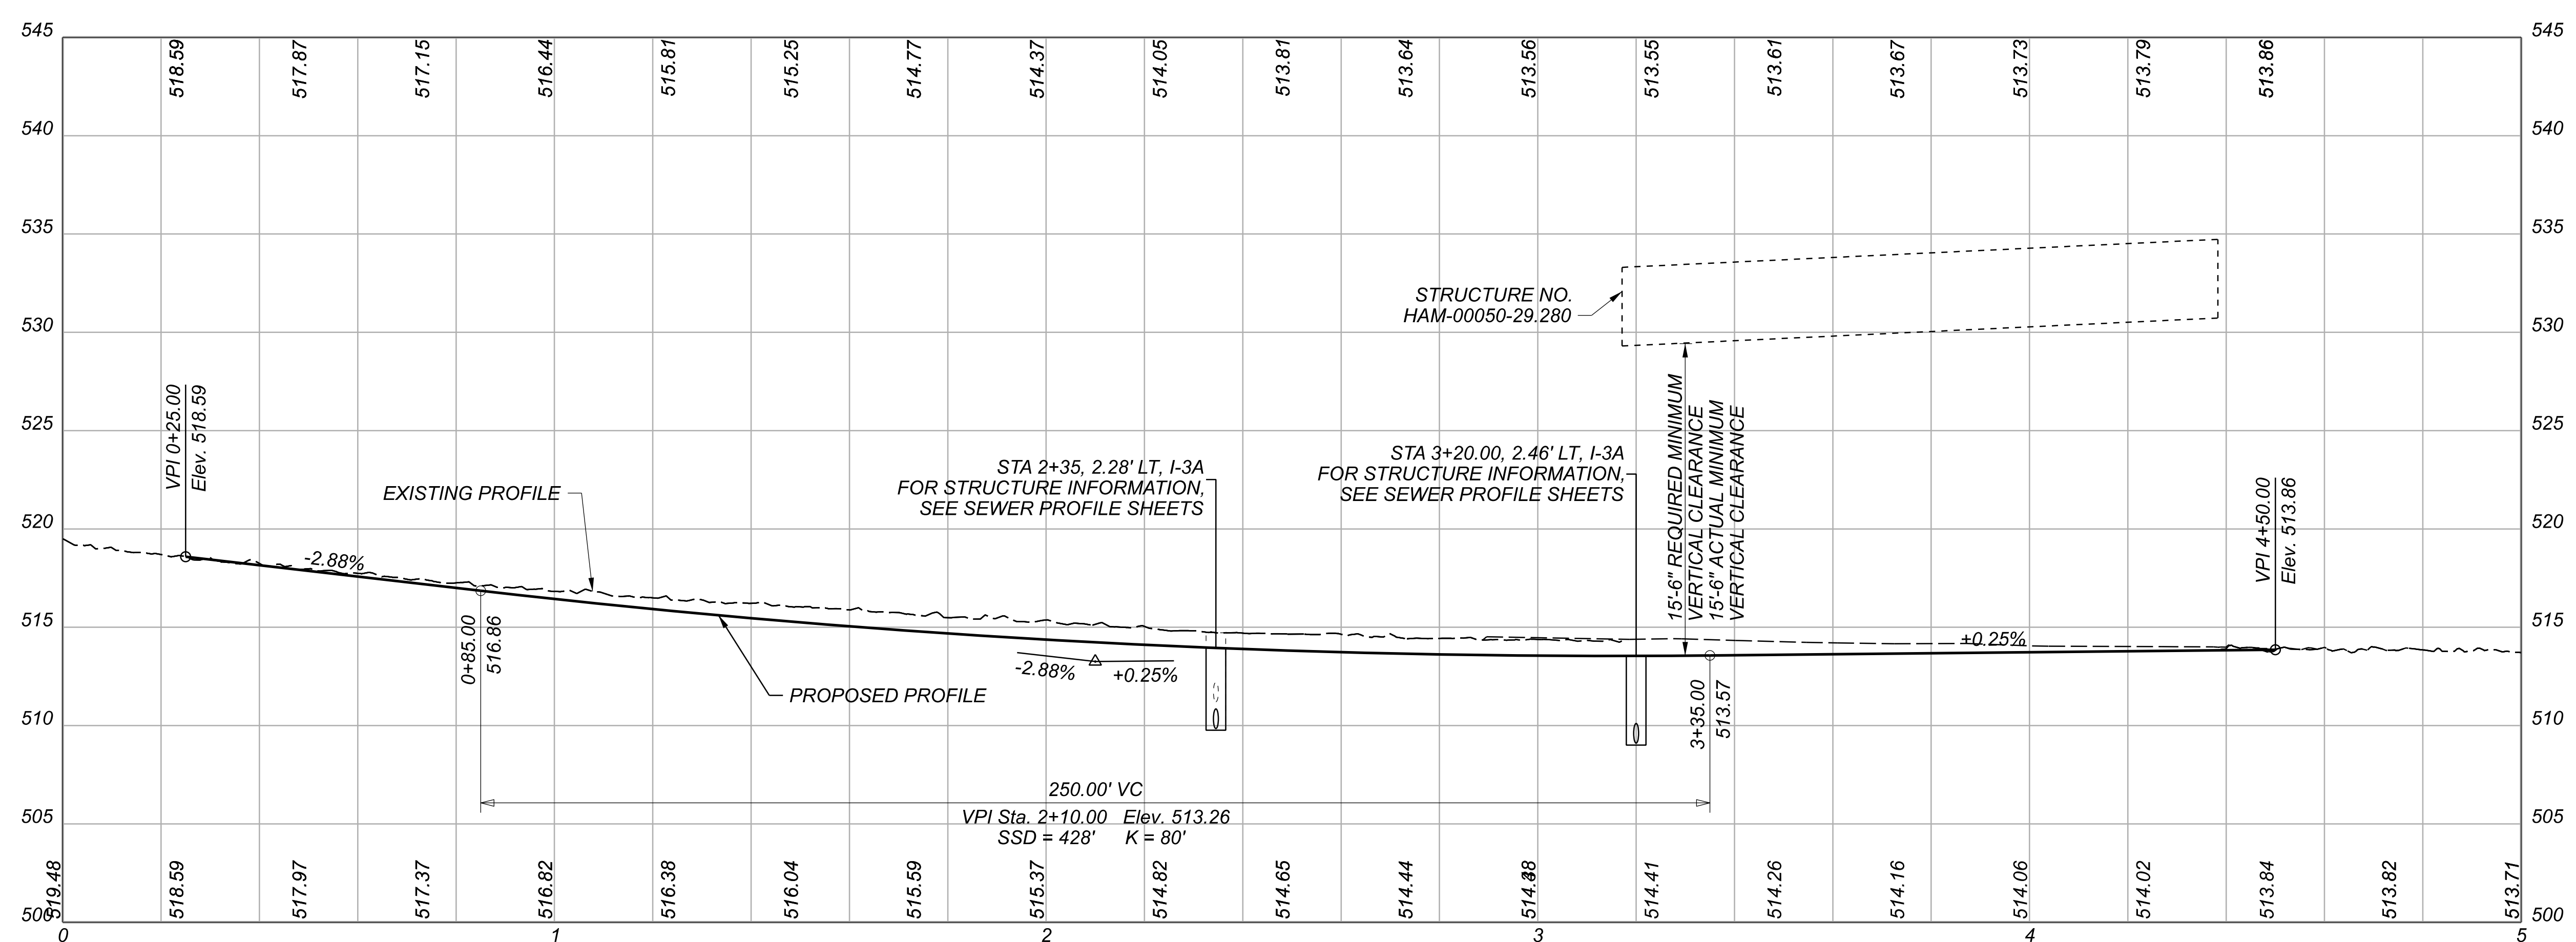

**PLAN AND PROFILE  
 RAMPS M & L**