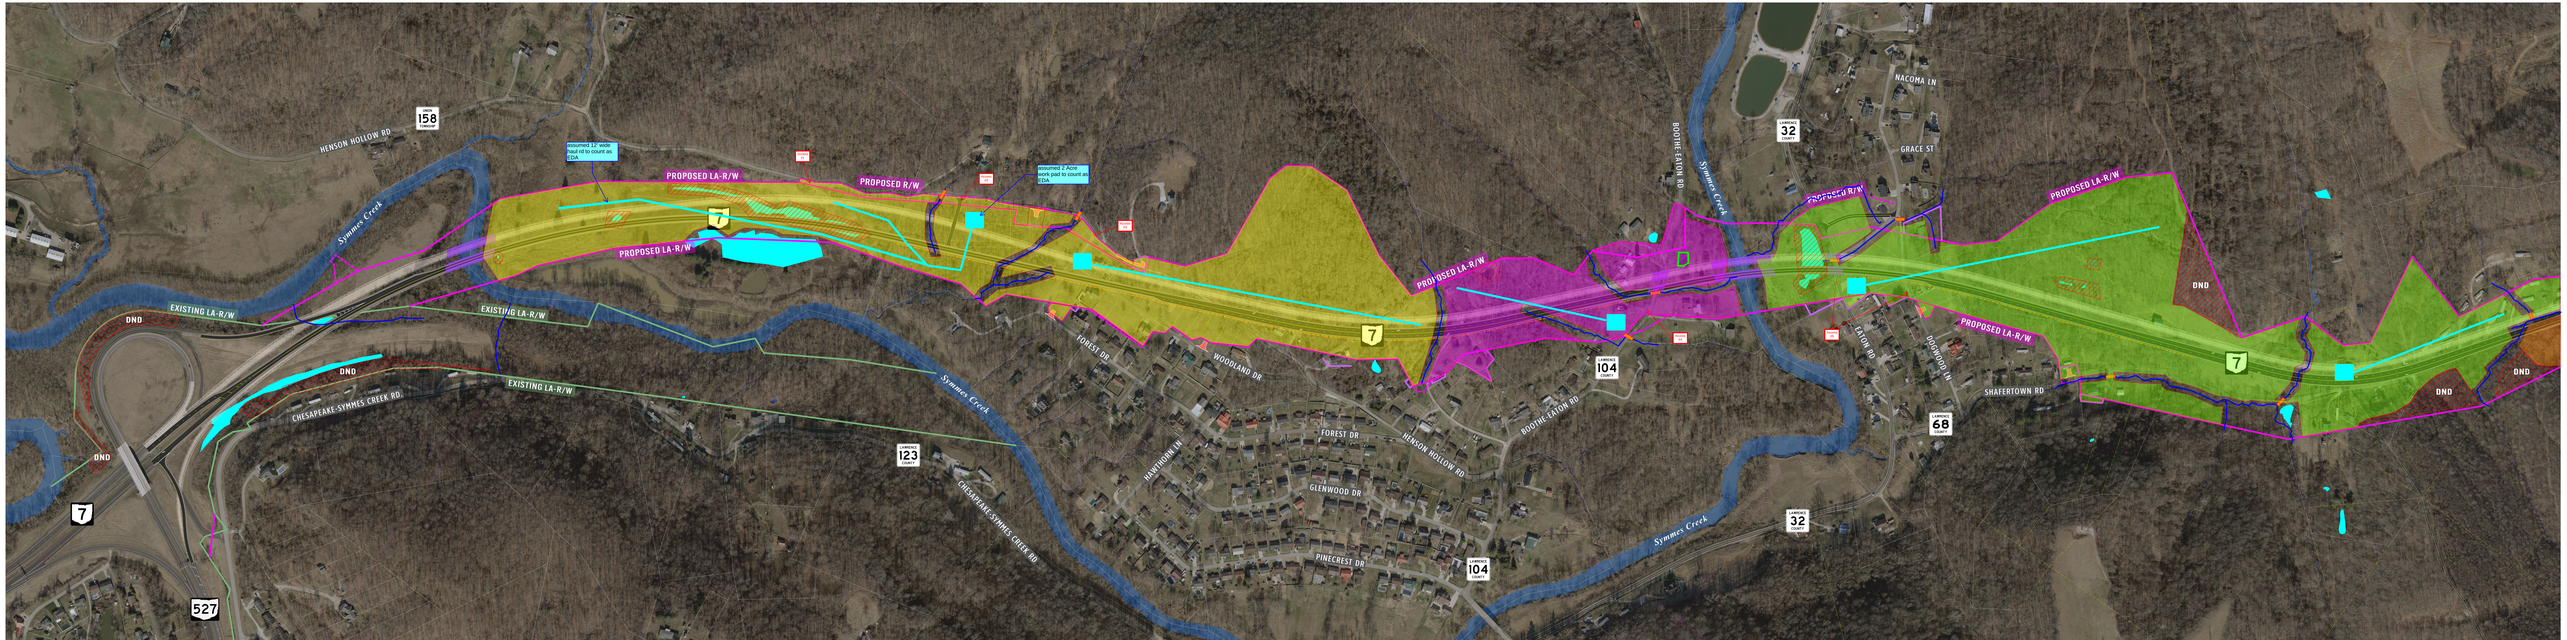

0 200 500 FEET 1000

NORTH

Stantec

Chesapeake Bypass - Phase 2

State Route 7 PID 75923

Stantec

NORTH

0 200 500 FEET 1000