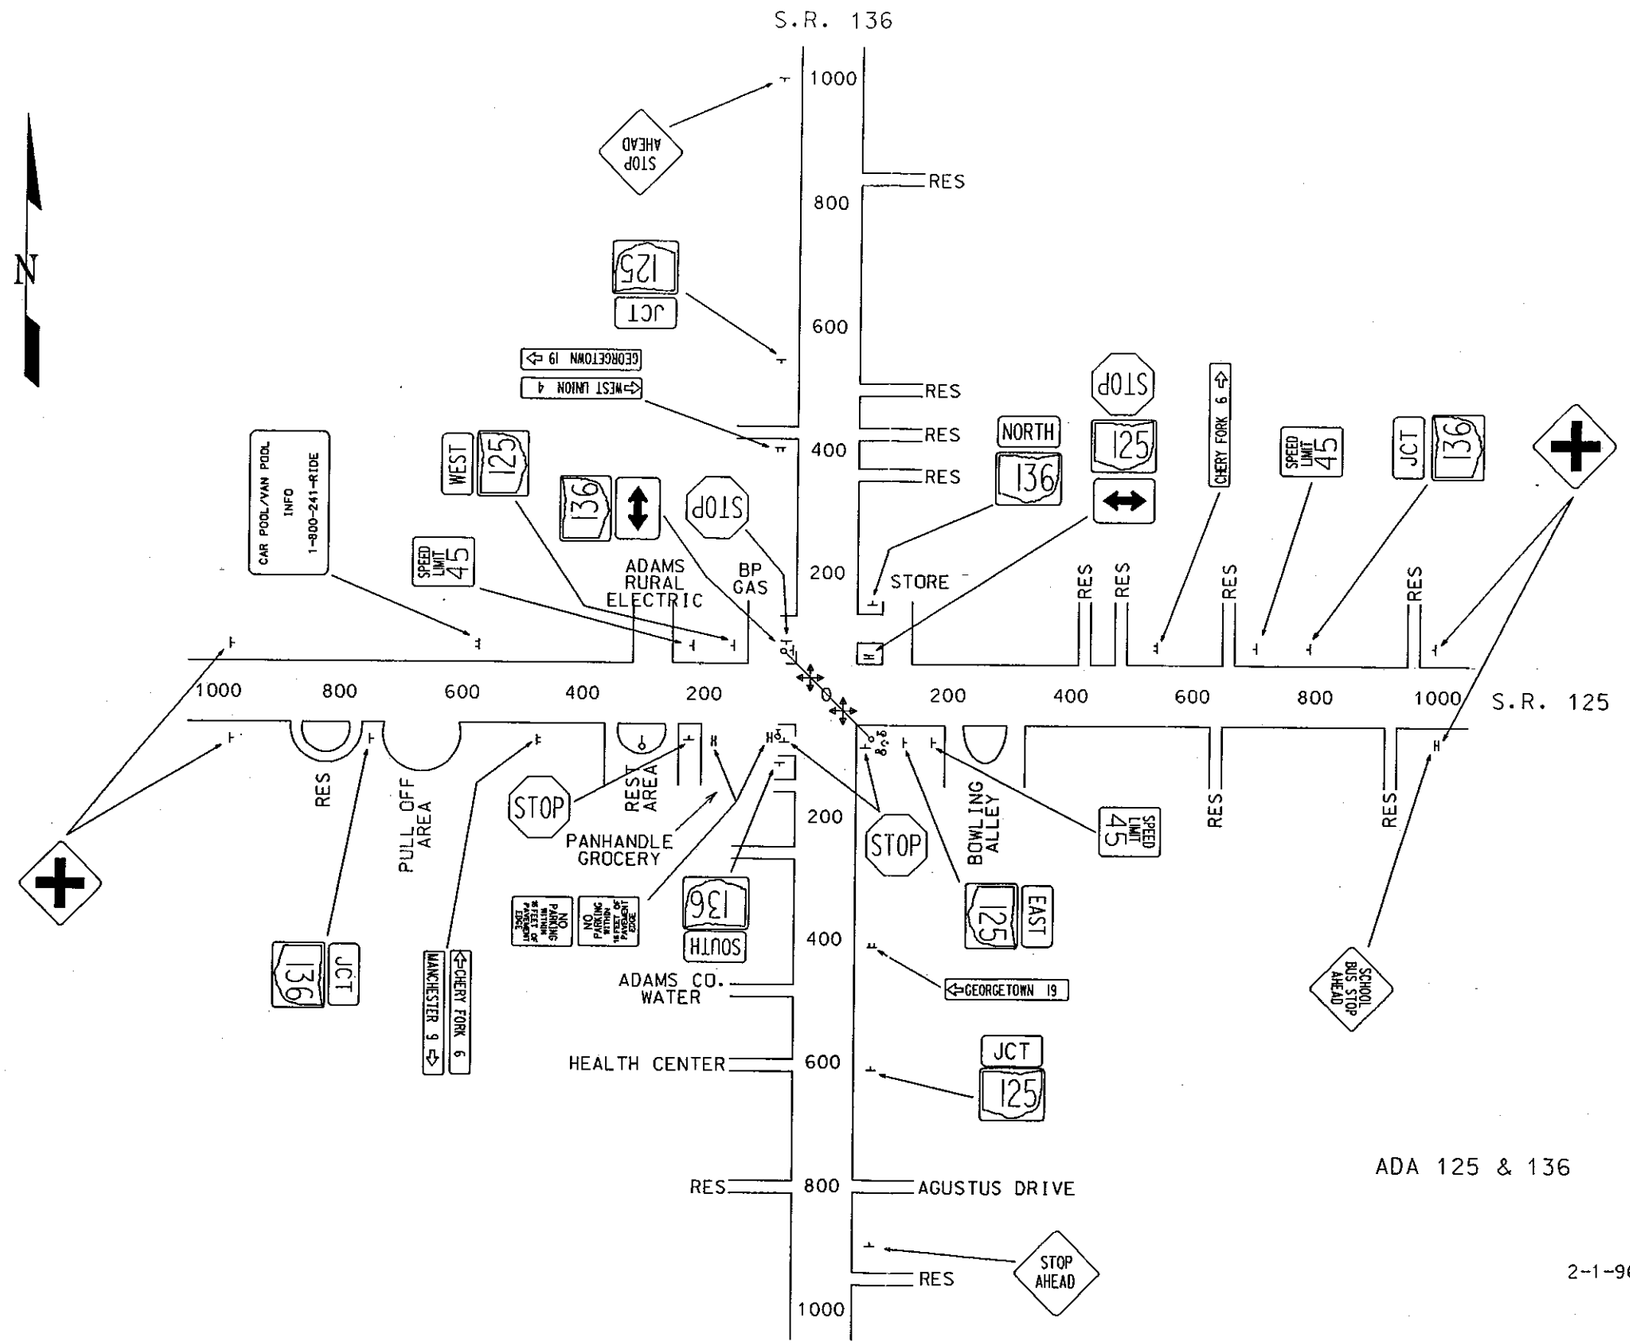
S.R. 136
S.R. 125
N
STOP AHEAD
JCT 125
GEORGETOWN 19
WEST LIMION 4
CAR POOL/VAN POOL INFO 1-800-241-RIDE
WEST 125
136
STOP
SPEED LIMIT 45
ADAMS RURAL ELECTRIC
BP GAS
NORTH 136
STOP 125
CHERY FORK 6
SPEED LIMIT 45
JCT 136
STORE
RES
PULL OFF AREA
REST AREA
PANHANDLE GROCERY
NO PARKING WITHIN 15 FEET OF PAVED EDGE
SOUTH 136
ADAMS CO. WATER
HEALTH CENTER
MANCHESTER 9
CHERY FORK 6
JCT 136
BOWLING ALLEY
SPEED LIMIT 45
EAST 125
GEORGETOWN 19
JCT 125
SCHOOL BUS STOP AHEAD
AGUSTUS DRIVE
STOP AHEAD
ADA 125 & 136
2-1-96