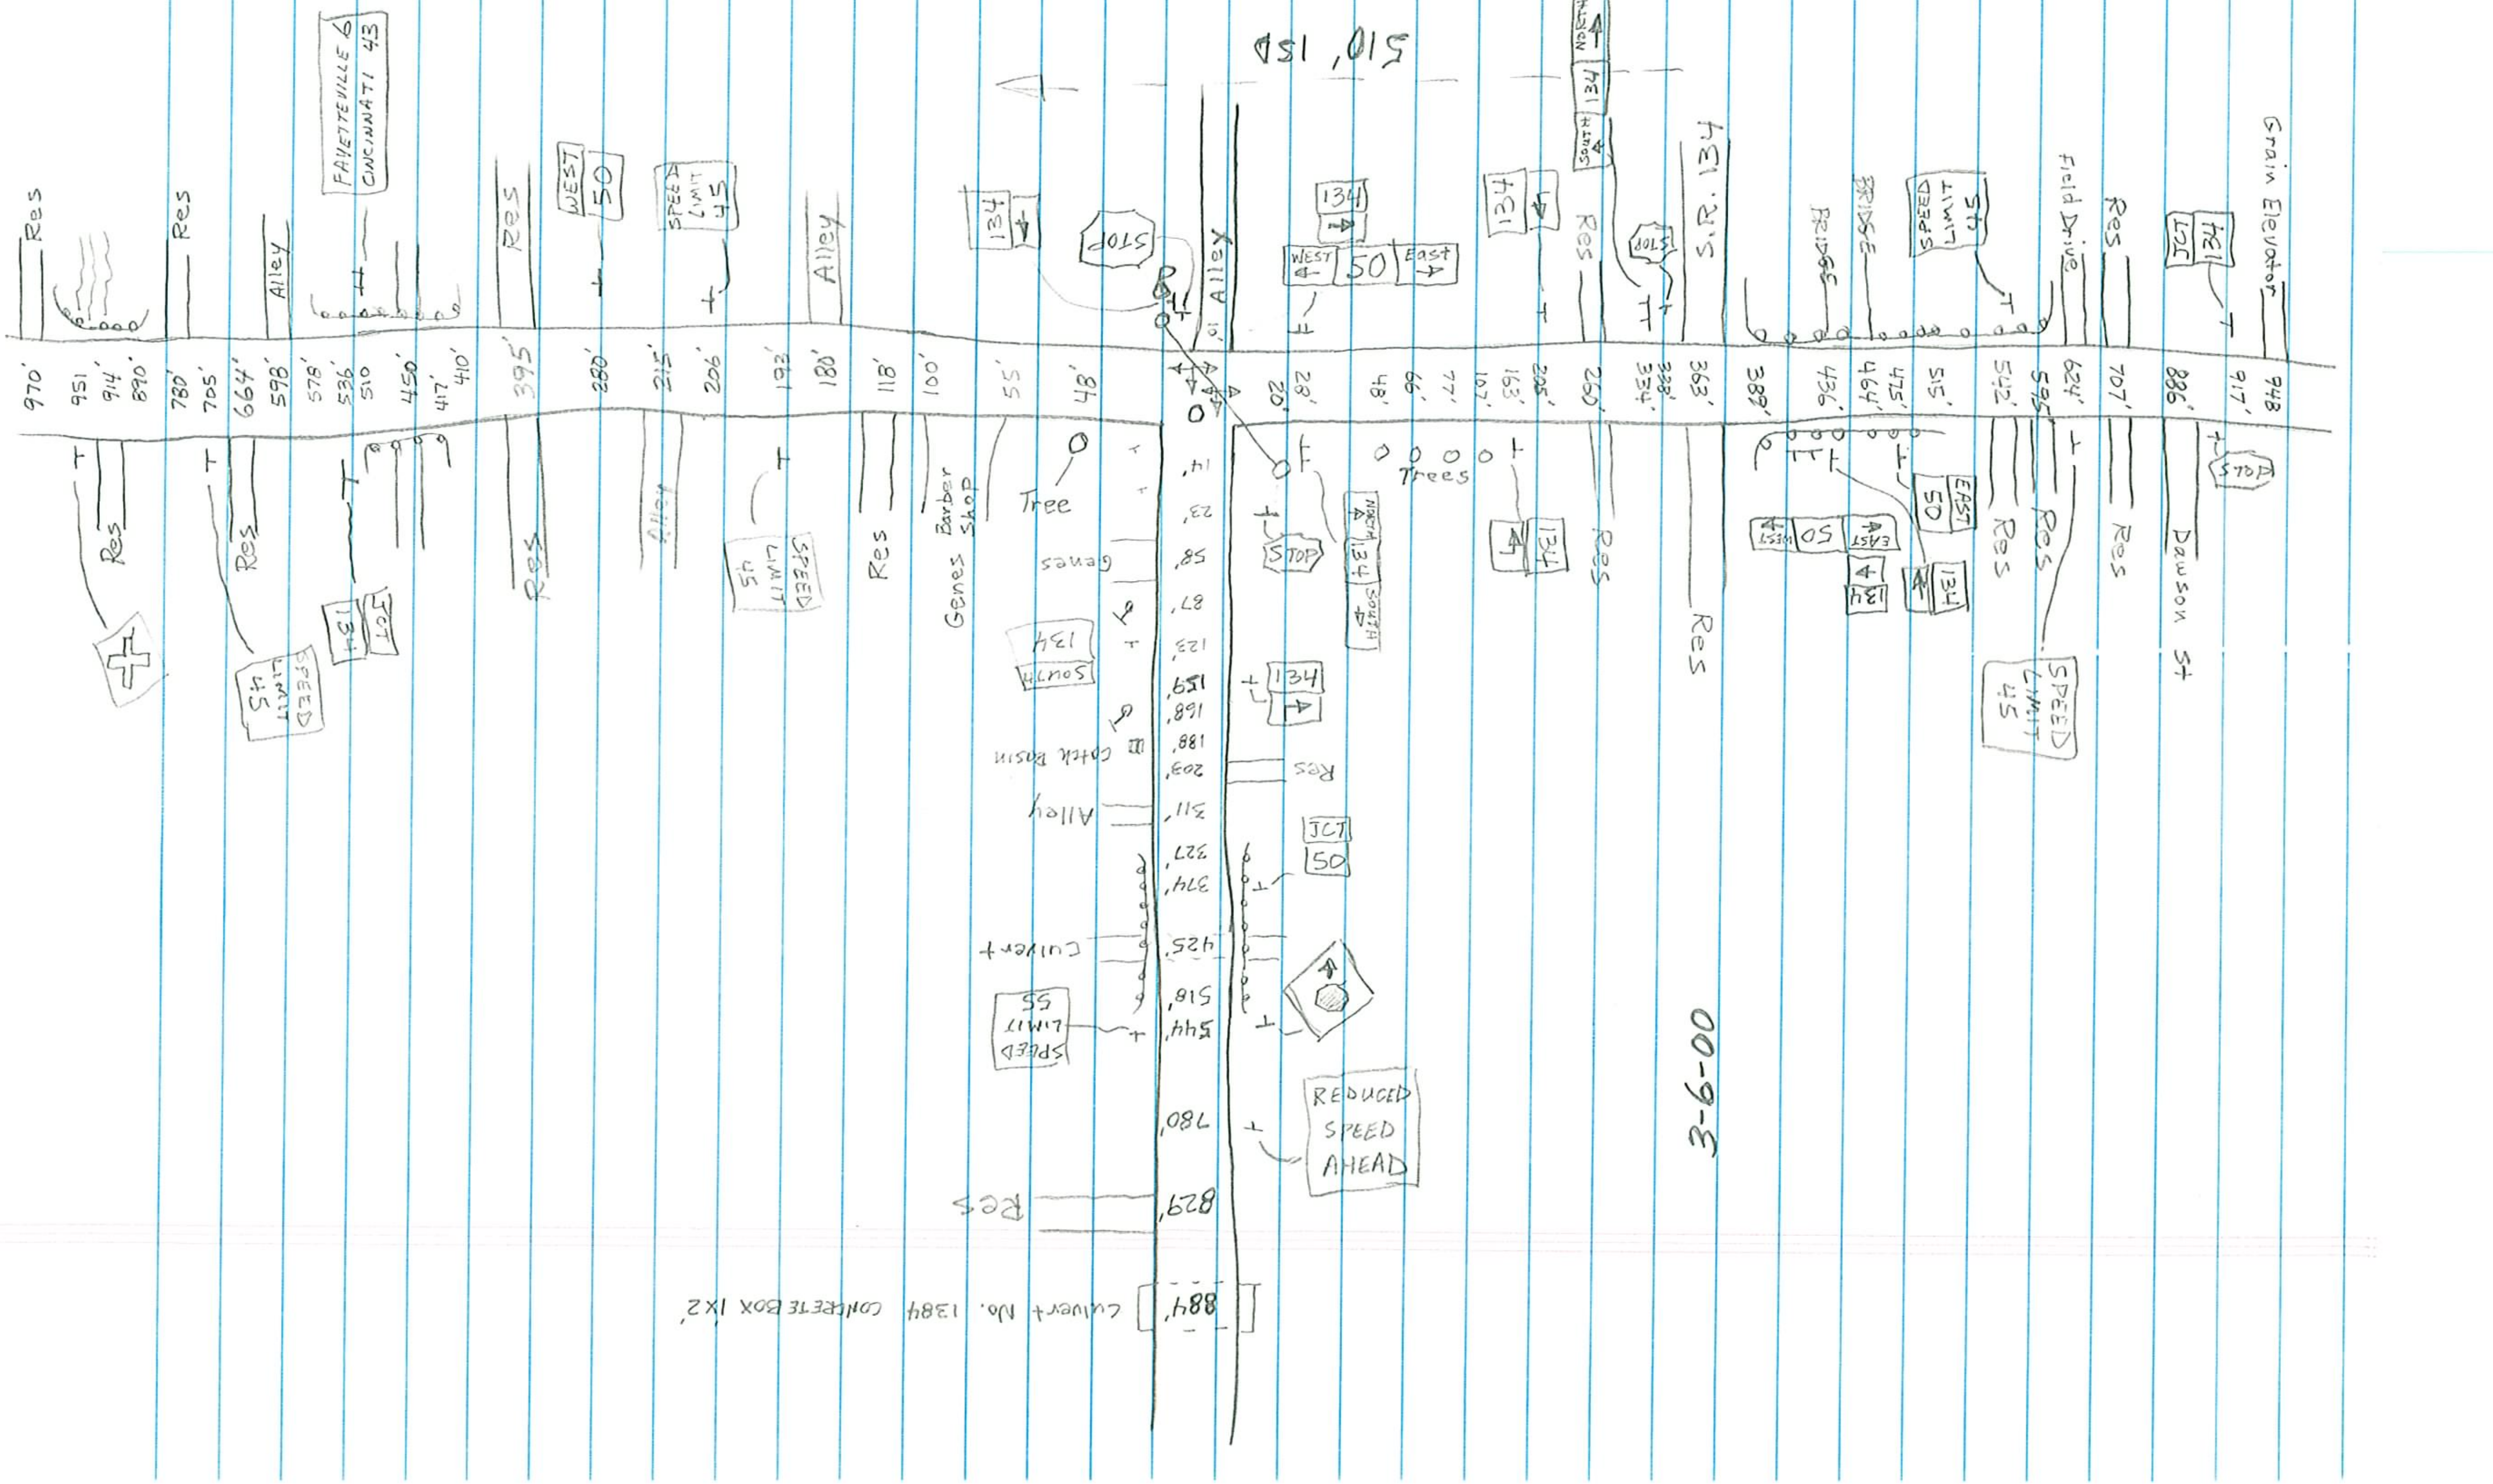

S.R. 134
FAYETTEVILLE 6 CINCINNATI 43
SPEED LIMIT 45
SPEED LIMIT 55
REDUCED SPEED AHEAD
JCT 50
WEST 50
EAST 50
STOP
Alley
Res
Genes Barber Shop
Tree
Trees
Catch Basin
Culvert
BRIDGE
Field Drive
Grain Elevator
Dawson St
Culvert No. 1384 CONCRETE BOX 1X2'
3-6-00