
MICROFILMED
APR 29 1992


F.H.W.A. REGION	STATE	PROJECT	
5	OHIO		

21 / 27


BELMONT COUNTY
BEL-148-14.03

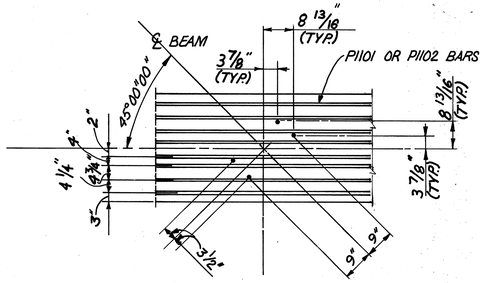


DETAIL "A"
(PIER 2 ONLY)

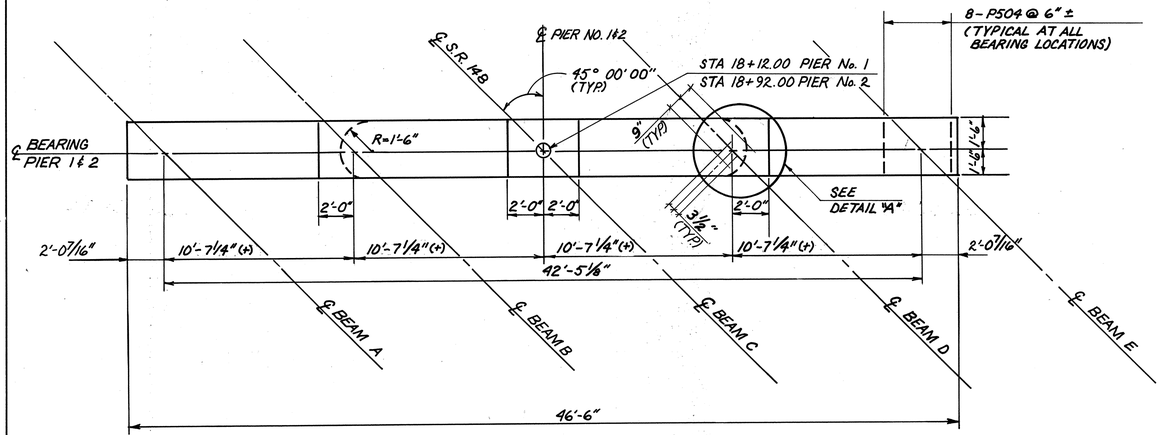


PLAN

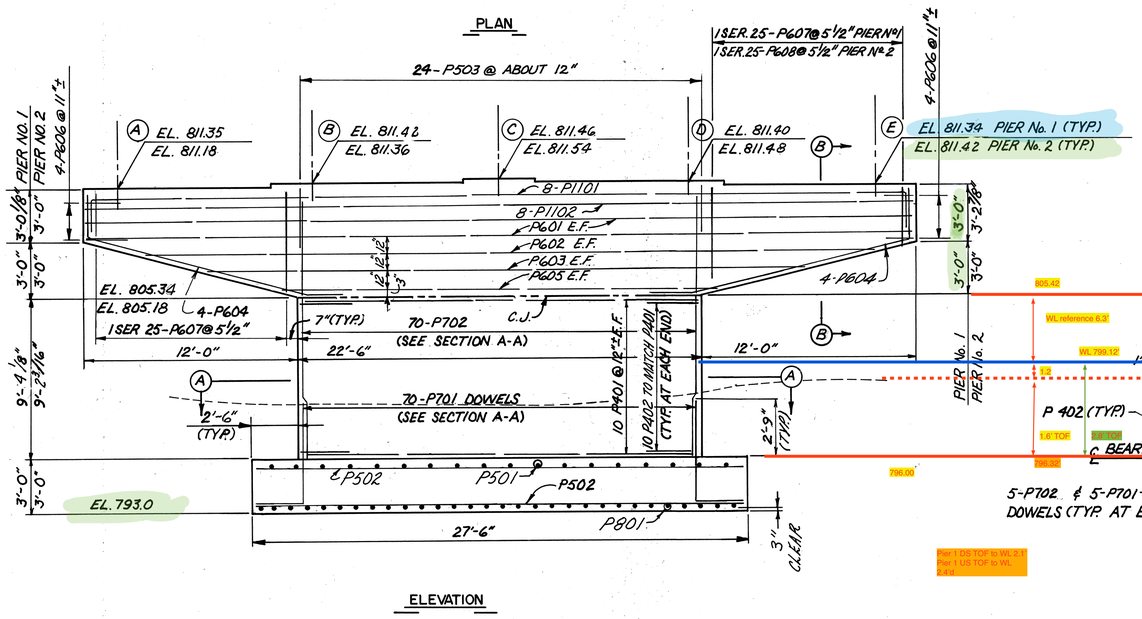


ELEVATION

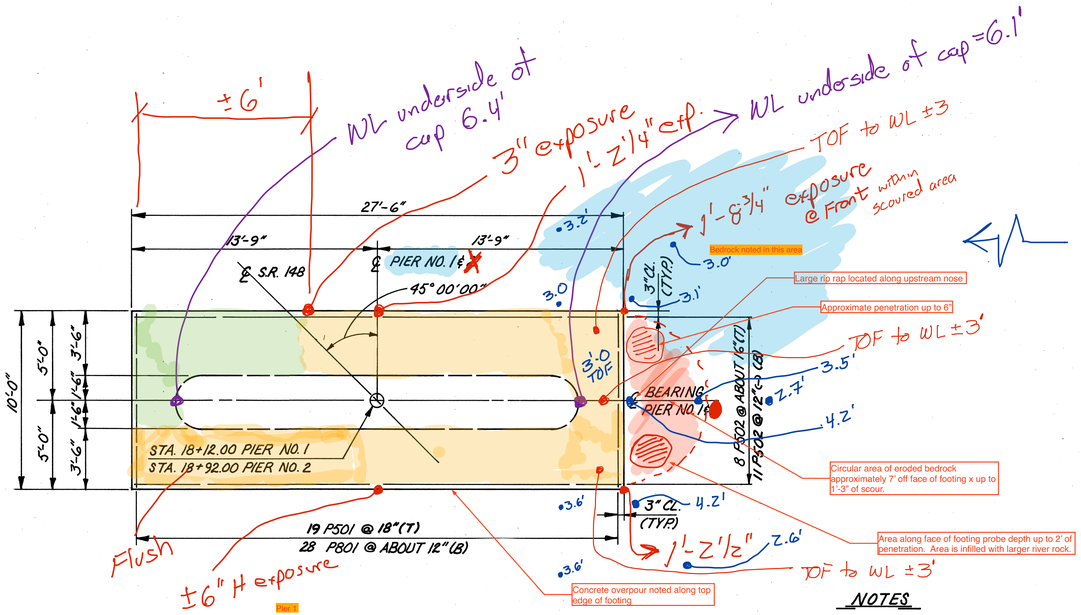

FOOTING PLAN

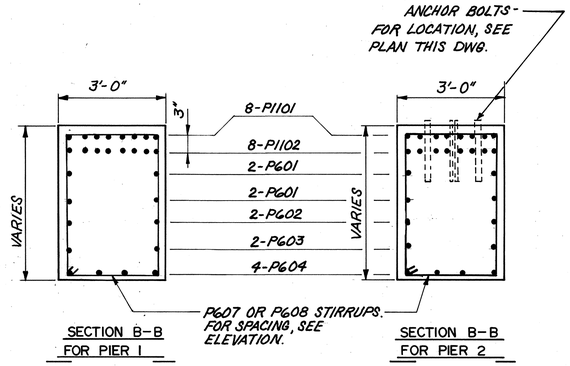

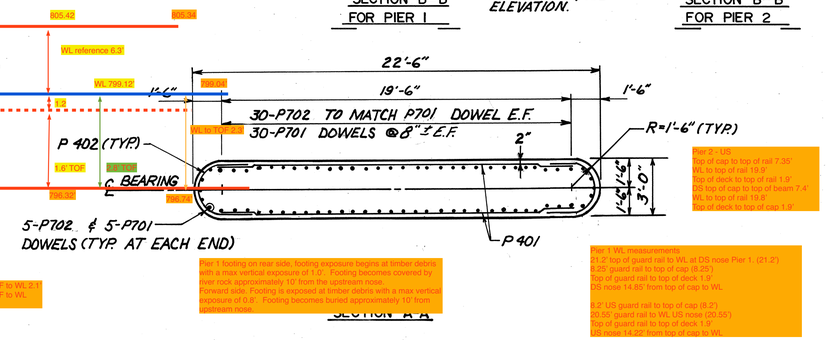

SECTION A-A

NOTES

1. Elevations written above arrow line are for Pier №1, those written below are for Pier №2.
2. CAP stirrups shall be placed with the hooks on the bottom.
3. Bridge seat reinforcing: reinforcing steel in the vicinity of the bridge seat shall be accurately placed to avoid interferance with the drilling of the bearing anchor holes or the pre-setting of bearing anchors.
4. Bearing anchors: at the option of the contractor, bearing anchors (or formed holes), located and supported by templates, may be cast in place.
5. For abbreviations, see sheet 5 / 10 .
6. For reinforcement schedule see sheet 10 / 10 .

ADLAKA AND ASSOCIATES
ENGINEERS & SURVEYORS
YOUNGSTOWN, OH.

6 / 10

PIER 1 & PIER 2
DETAILS

BRIDGE NO. BEL-148-1403
OVER
CAPTINA CREEK

DESIGNED	DRAWN	TRACED	CHECKED	REVIEWED	DATE	REVISED
M.B.	Mod C.	D.R.S.	S.U.R.	S.A.	7/86	