TUS-250-18.90
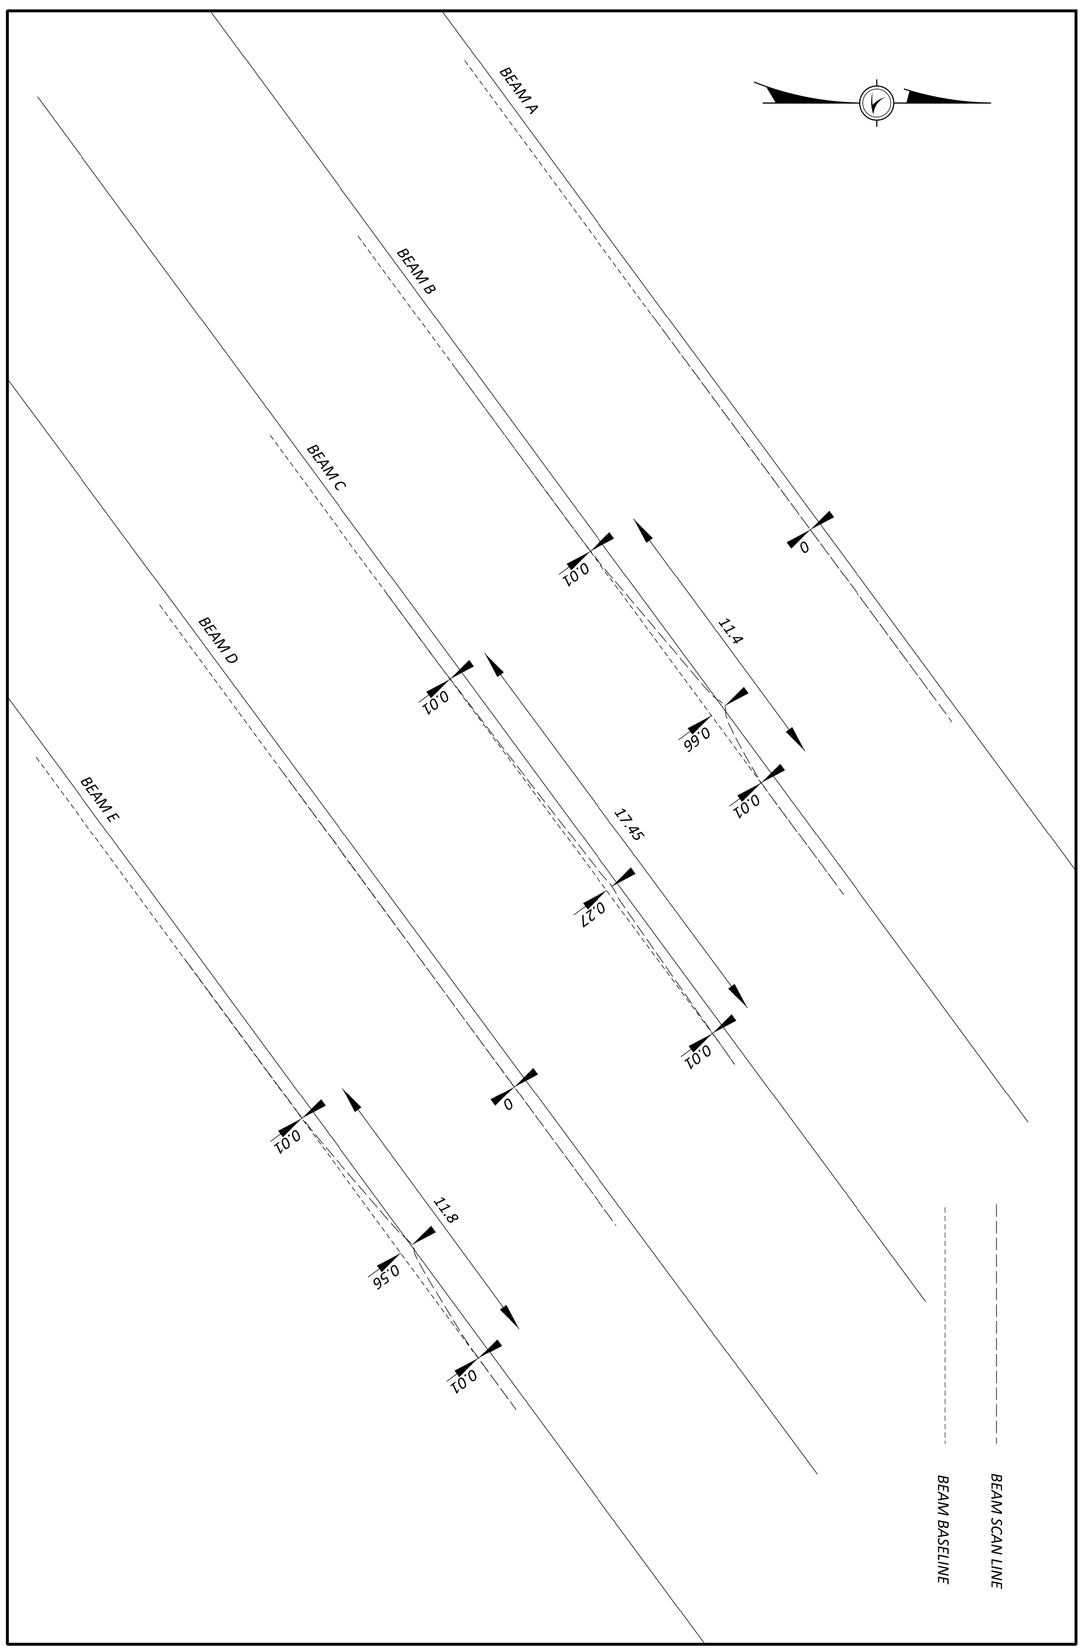
MODEL: Untitled [Sheet] PAPERSIZE: 34x22 (in.) DATE: 9/24/2026 TIME: 1:47:57 PM PLTDRV: OHDOT_PDF.pltcfg PENTBL: OHDOT_Pen.tbl USER: Jon.Penix@dot.ohio.gov WORKSPACE: OHDOTCEv02 WORKSET: 127143 PRODUCT: OpenRoadsDesigner 24.00.00.205
pw:\\ohiodot-pw.bentley.com:ohiodot-pw-02\Documents\01 Active Projects\District 11\Tuscarawas\127143\300-Survey\Basemaps\127143_FB001.dgn