


SECTION	NO.

CALC. DATE		OHIO REGION
CHKD. DATE		
DATE		

CUYAHOGA COUNTY
CUY - 176 - 10.14

62
275

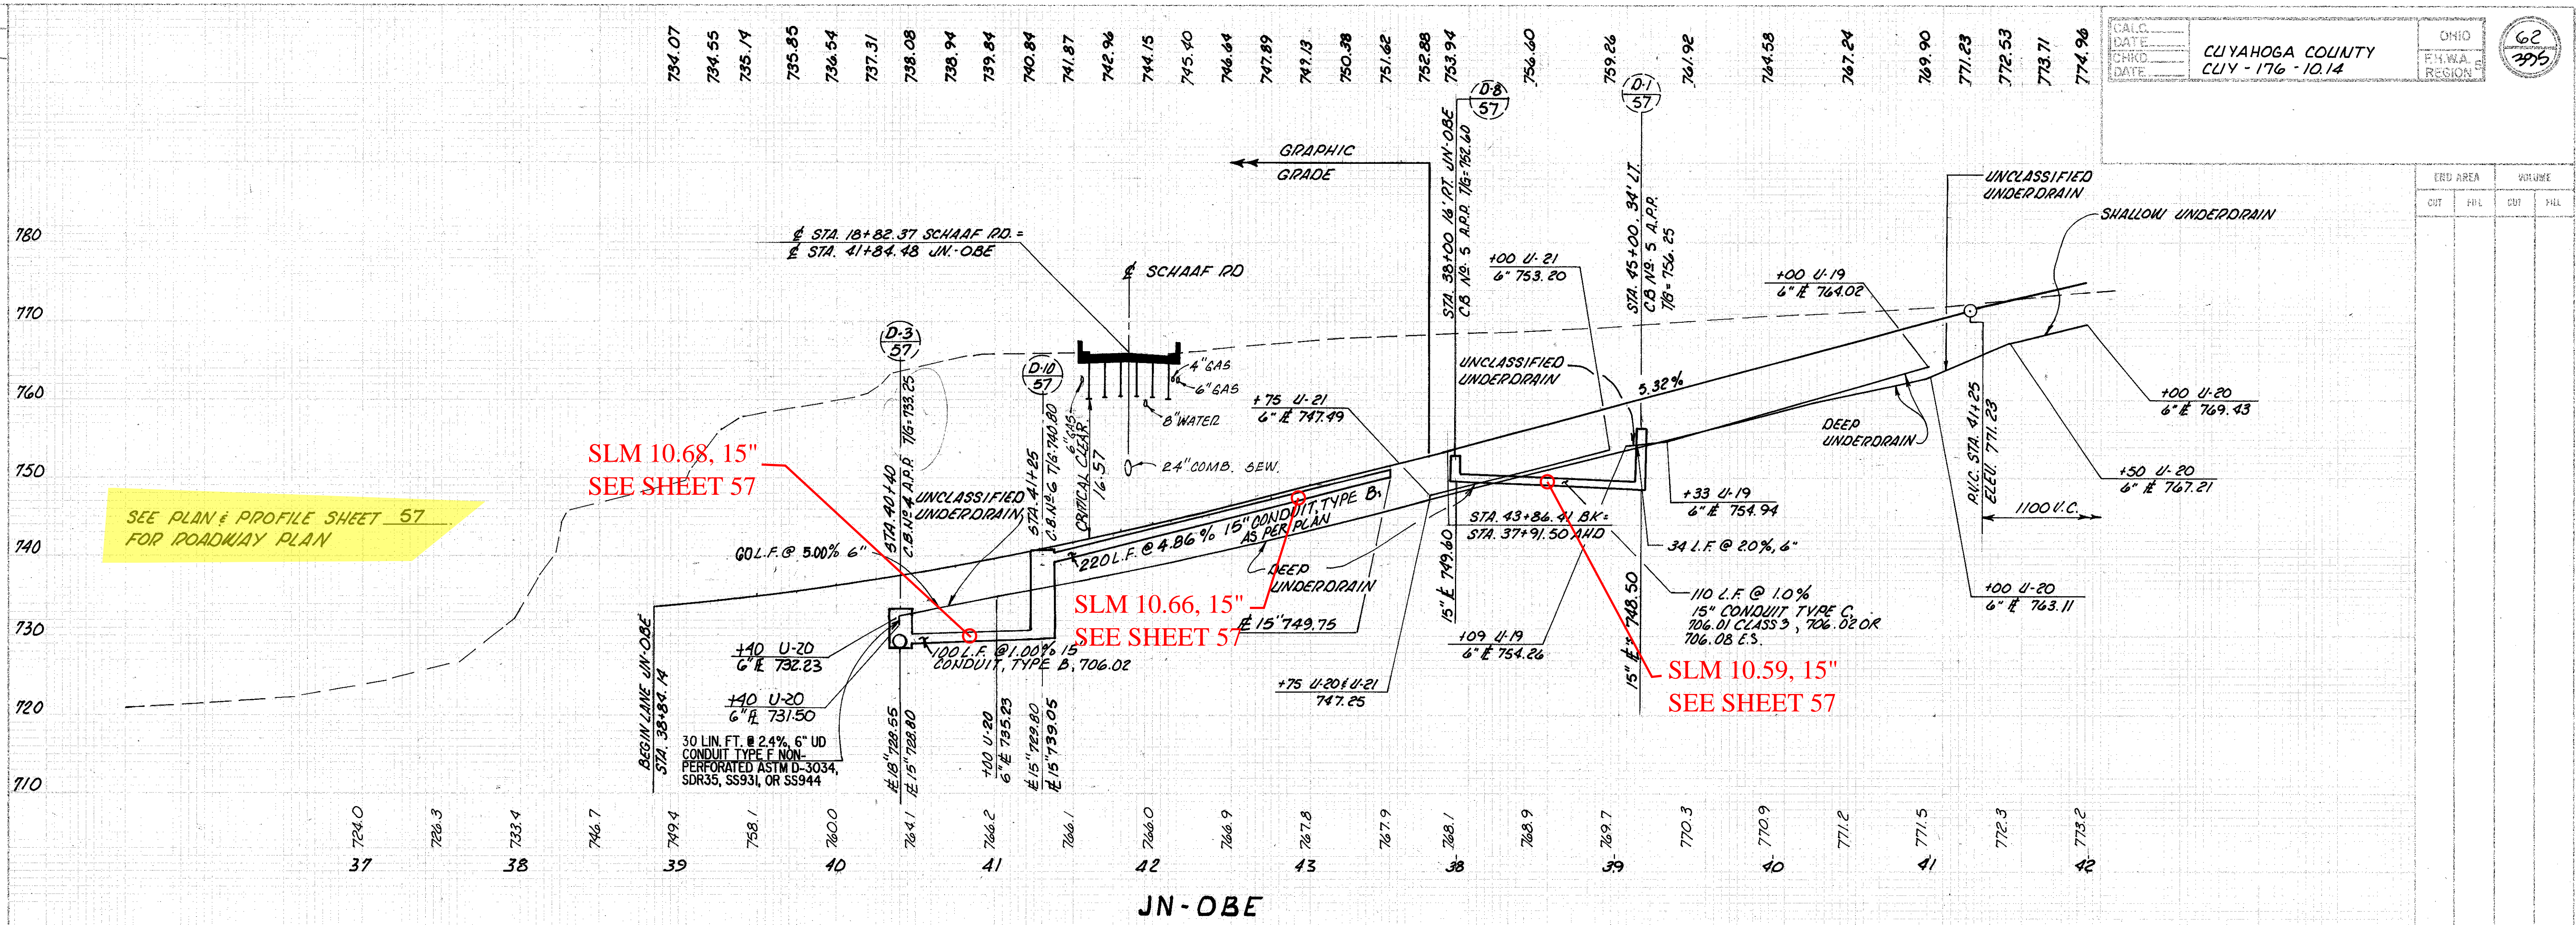


SEE PLAN & PROFILE SHEET 57 FOR ROADWAY PLAN

SLM 10.68, 15"
SEE SHEET 57

SLM 10.66, 15"
SEE SHEET 57

SLM 10.59, 15"
SEE SHEET 57

ERU AREA		VOLUME	
CUT	FILL	CUT	FILL

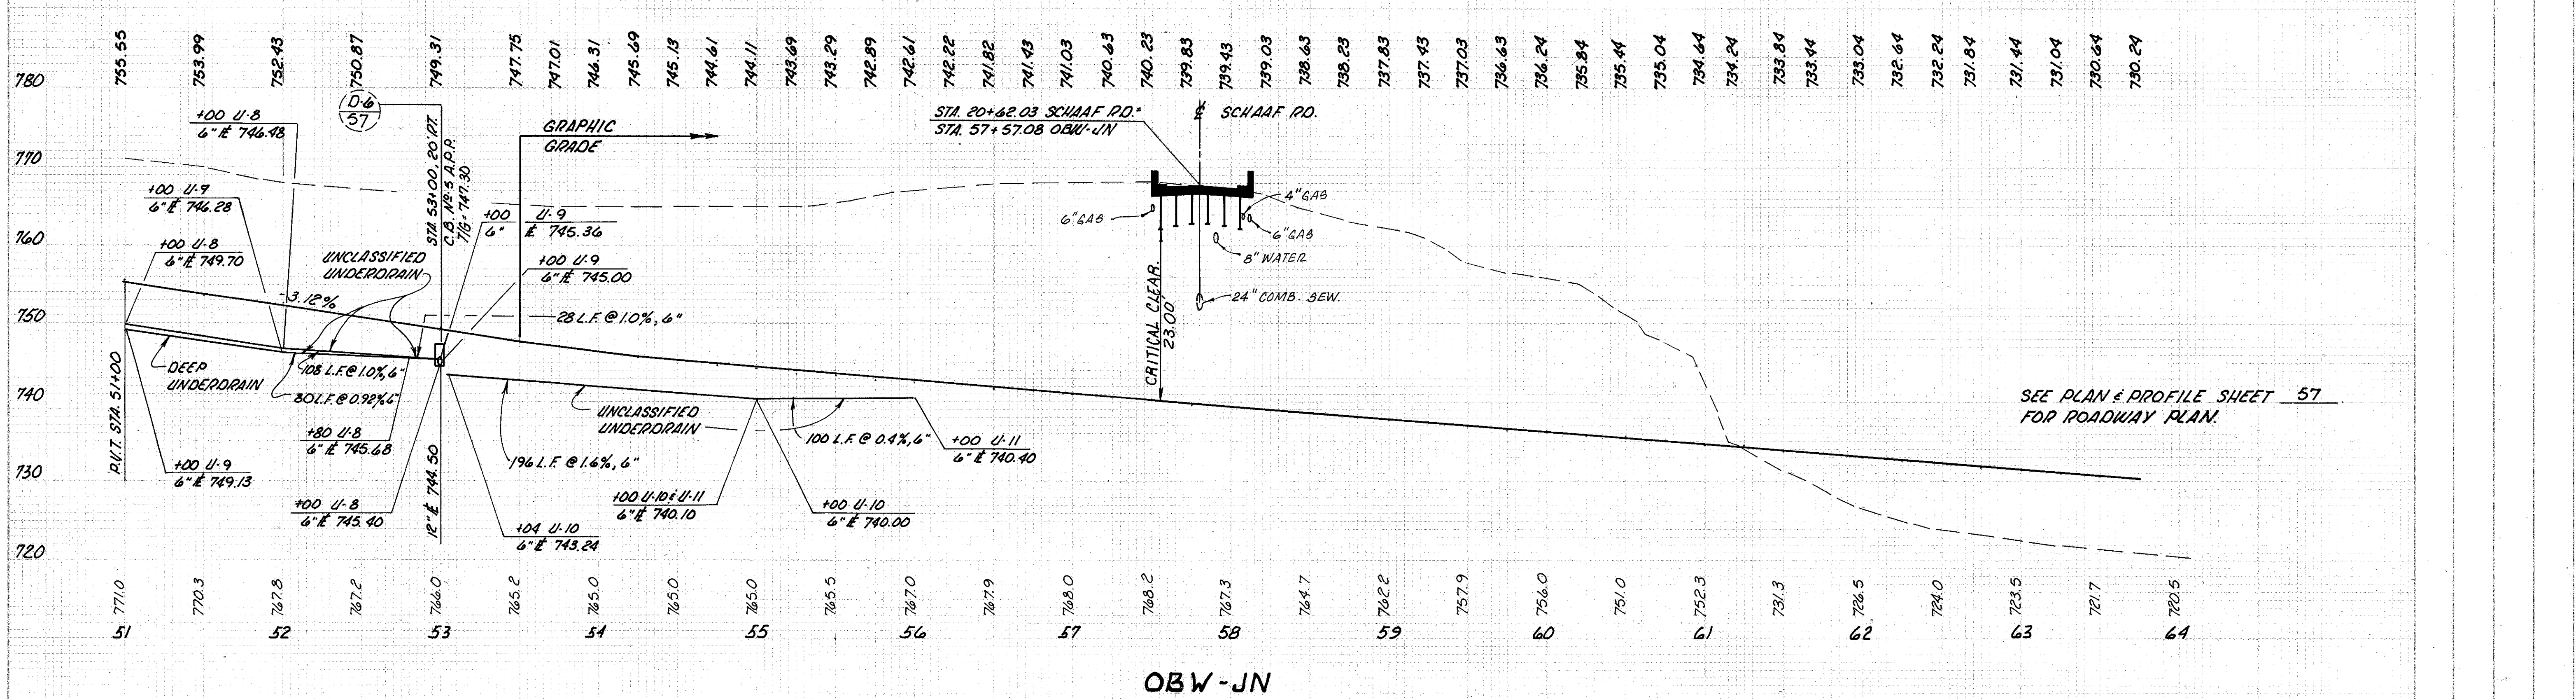

SEE PLAN & PROFILE SHEET 57 FOR ROADWAY PLAN.

PROFILE LANES OBW-JN & JN-OBE STA. 51+00 TO STA. 64+00

RELOC. S.R.-176