


1-7

CALC.	CUYAHOGA COUNTY	OHIO
DATE	CLY - 176 - 10.14	F.H.W.A. REGION
CHKD.		
DATE		

176
325

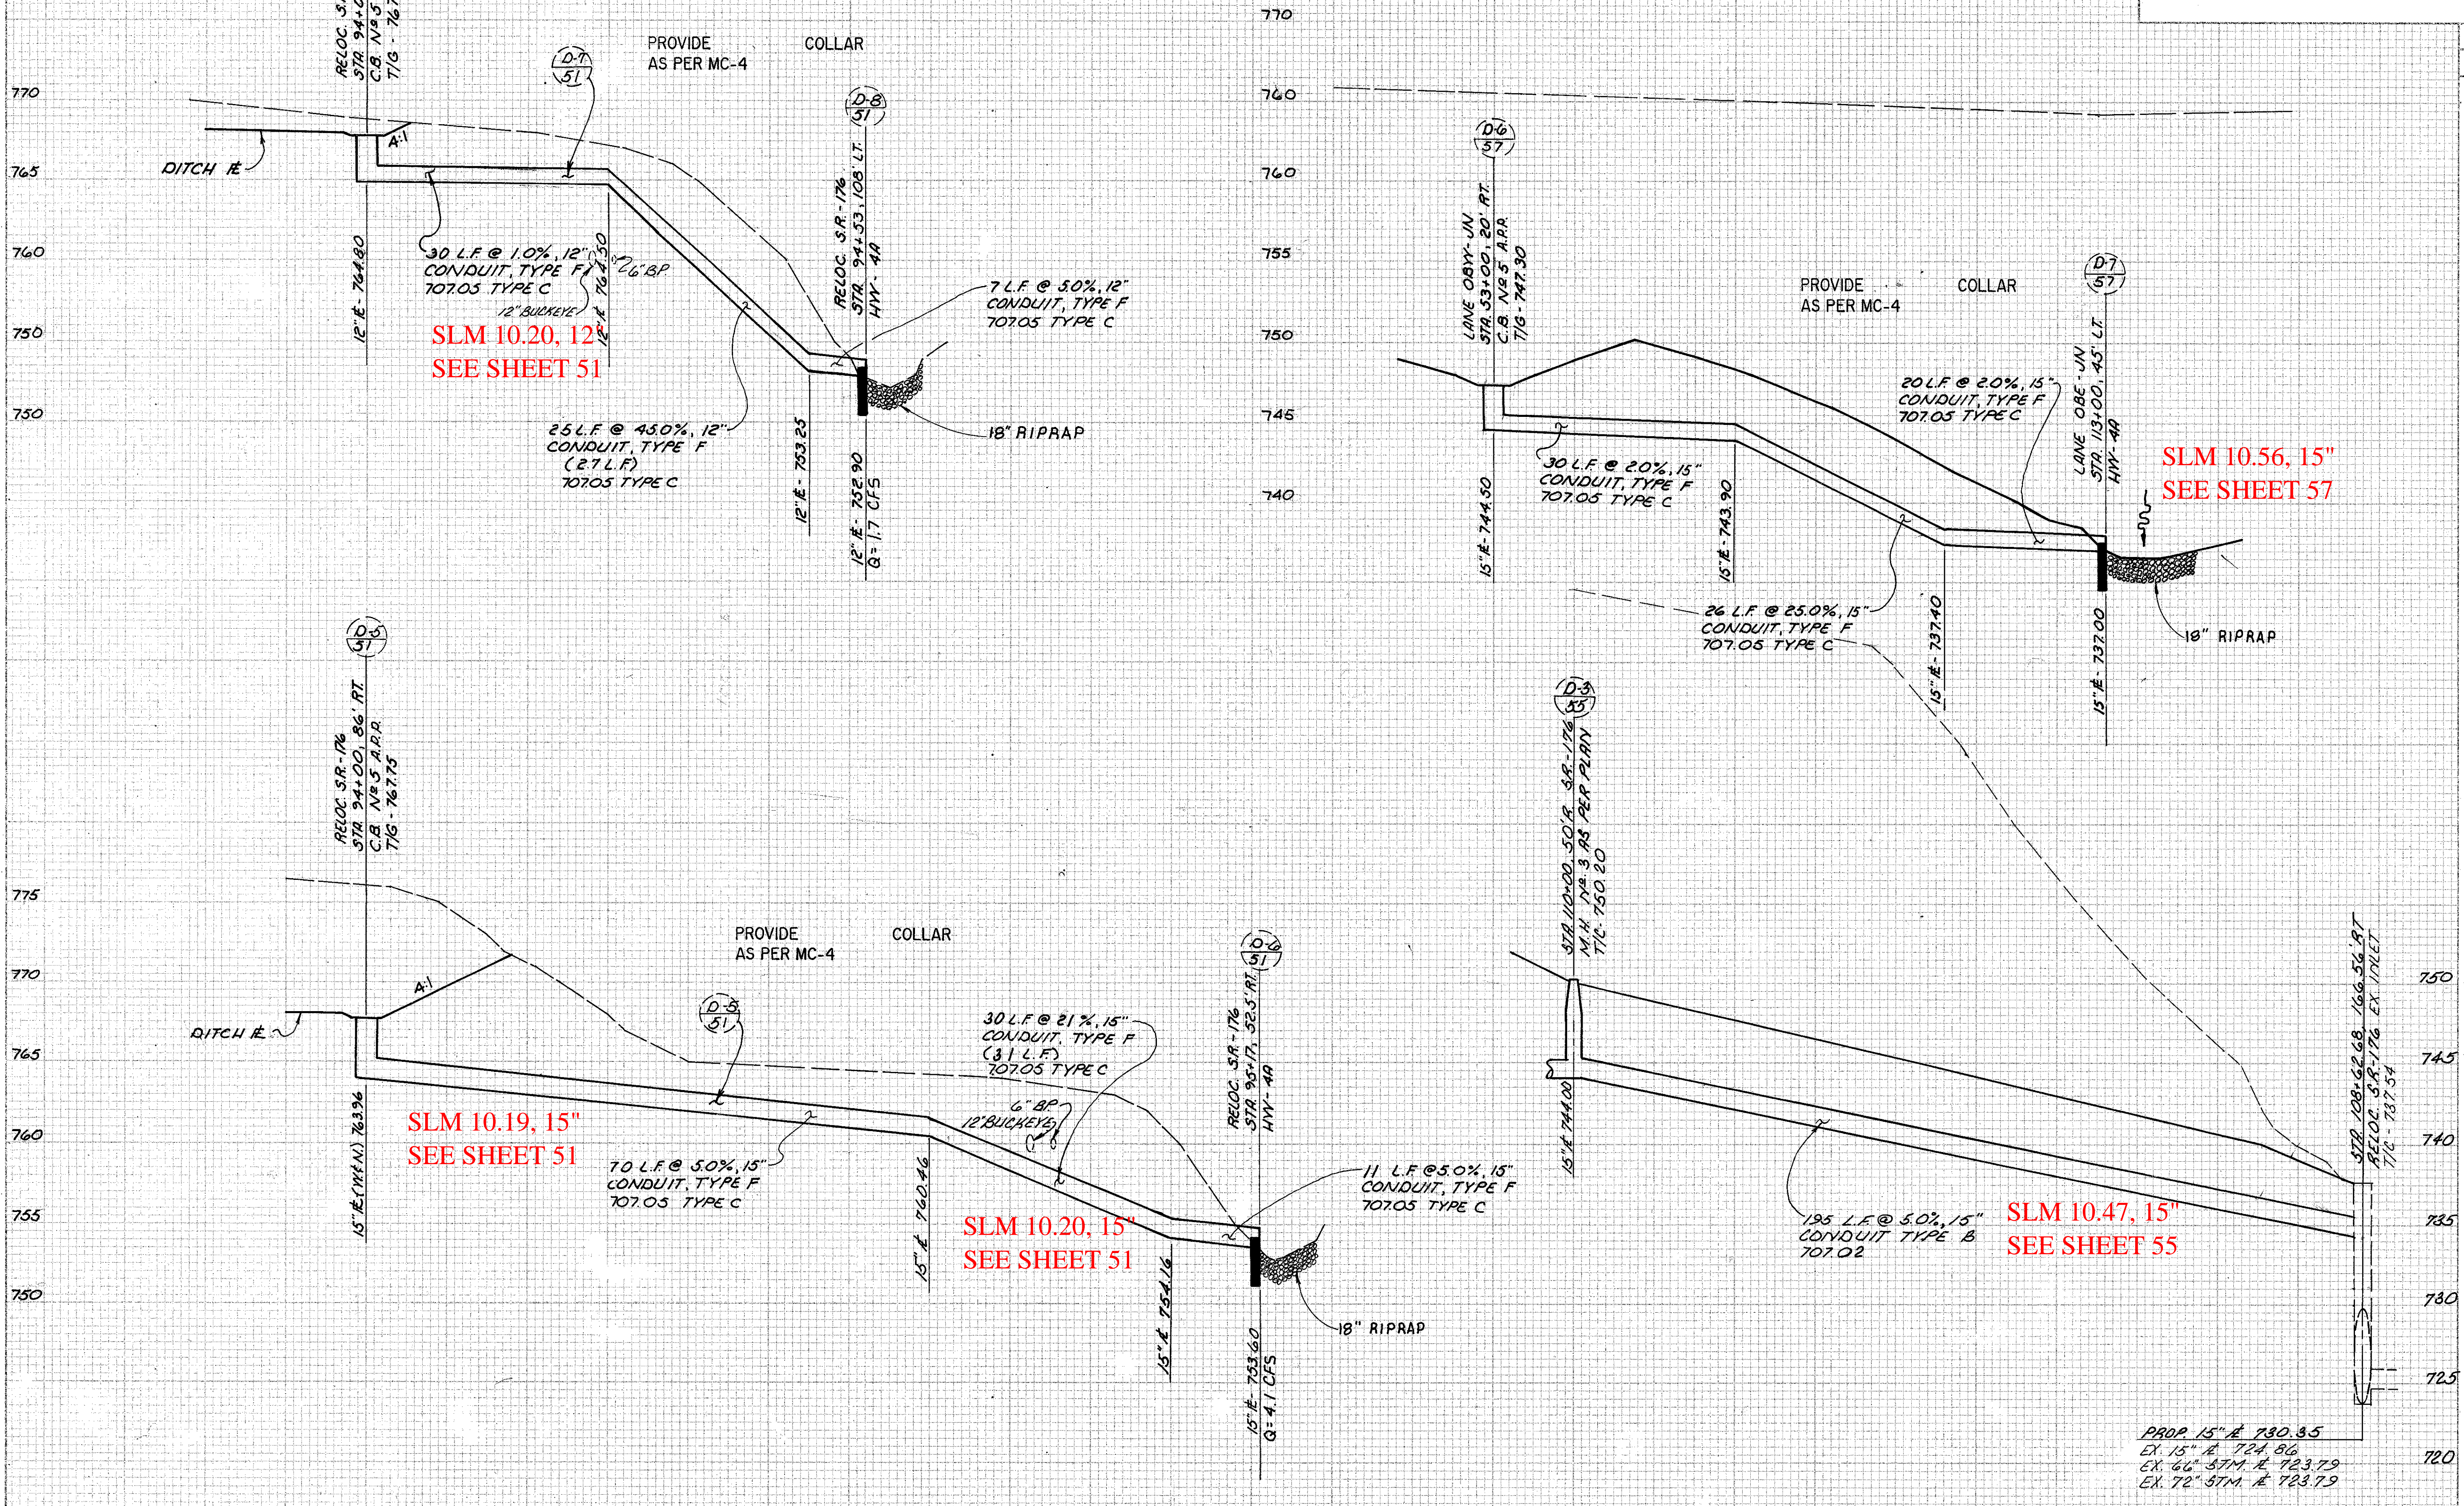

END AREA		VOLUME	
CUT	FILL	CUT	FILL

PROP 15" @ 730.35
EX. 15" @ 724.86
EX. 66" 57M @ 723.79
EX. 72" 57M @ 723.79

PIPE PROFILES

RELOC. S.R. - 176