



**CUY-90-14.90**

**PID 82119**

---

**APPENDIX GE-10**

---

**Soil Profile from CCG1  
(Reference Document)**


State of Ohio Department of Transportation  
Jerry Wray, Director

**Innerbelt Bridge  
Construction Contract Group 2 (CCG2)**


INDEX OF SHEETS		
LOCATION FROM STA.	TO STA.	PLAN VIEW & PROFILE SHEET NUMBERS
<b>W.B. I-90 MAINLINE</b>		
97+02.06	198+50	47, 49, 51-53, 56-61, 64-66, 69-70, 73, 73A
<b>TEMPORARY W.B. I-90 MAINLINE</b>		
501+50.00	515+50.00	64, 69, 71
<b>TEMPORARY RAMP A3</b>		
2999+00	3009+20.95	69, 73, 74
<b>RAMP A4</b>		
600+26.44	609+41.34	64, 69, 72
<b>RAMP A5</b>		
697+89.30	720+42.80	59, 62-64, 67
<b>RAMP A6</b>		
800+00	814+00	51, 54, 56
<b>RAMP A7</b>		
1000+00	1013+96	47-50
<b>W. 14TH ST. EXT.</b>		
100+00	108+80.78	51, 55
<b>ONTARIO ST.</b>		
690+69.56	697+89.30	64, 68
<b>COMMERCIAL RD.</b>		
10+00	20+07.23	64, 75, 77
<b>E. 9TH ST.</b>		
11+54.79	26+00	59, 75-76, 78
<b>BROADWAY AVE.</b>		
10+00	24+73.88	78-79
<b>E. 14TH ST.</b>		
10+01.13	14+75.51	78, 80
STATION	CROSS SECTION SHEET NUMBERS	
<b>W.B. I-90 MAINLINE</b>		
111+00	81	
114+00	82	
115+00	83	
118+50	84-85	
126+50	86-87	
128+00	88-89	
131+00	90-91	
134+00	92-93	
137+00	94-95	
139+50	96-97	
158+50	98-99	
161+00	100-101	
167+00	102	
171+50	103	
<b>WEST ABUTMENT</b>		
A-A'	104-105	
B-B'	106-107	
C-C'	108-109	
D-D'	110-111	
E-E'	112-113	
<b>TEMPORARY RAMP A3</b>		
3000+10	114	
3003+50	115	
<b>RAMP A6</b>		
806+50	116	

**LEGEND**

DESCRIPTION	ODOT CLASS
GRAVEL AND/OR STONE FRAGMENTS	A-1-a
GRAVEL AND/OR STONE FRAGMENTS W/ SAND	A-1-b
GRAVEL AND/OR STONE FRAGMENTS W/ SAND & SILT	A-2-4
GRAVEL AND/OR STONE FRAGMENTS W/ SAND, SILT, & CLAY	A-2-6
FINE SAND	A-3
COURSE & FINE SAND	A-3a
SANDY SILT	A-4a
SILT	A-4b
SILT AND CLAY	A-6a
SILTY CLAY	A-6b
ELASTIC CLAY	A-7-5
CLAY	A-7-6
ORGANIC SILT	A-8a
ORGANIC CLAY	A-8b
ORGANIC	VISUAL
WOODY PEAT	VISUAL
BOULDERY ZONE	VISUAL
SHALE	VISUAL
WEATHERED SHALE	VISUAL
UNCONTROLLED FILL	VISUAL
CONCRETE	VISUAL
PAVEMENT OR BASE = X = APPROXIMATE THICKNESS (ASPHALT, CONCRETE, BRICK, SANDSTONE OR GRANITE PAVERS, BERM)	VISUAL
SOD AND TOPSOIL = X = APPROXIMATE THICKNESS	VISUAL
BORING LOCATION - PLAN VIEW	
INSTRUMENTED BORING LOCATION - PLAN VIEW	
HISTORIC BORING LOCATION (PRE-2006) - PLAN VIEW	
DRIVE SAMPLE AND/OR ROCK CORE BORING PLOTTED TO VERTICAL SCALE ONLY. HORIZONTAL BAR INDICATES A CHANGE IN STRATIGRAPHY.	
N60 INDICATES STANDARD PENETRATION RESISTANCE NORMALIZED TO 60% DRILL ROD ENERGY RATIO.	
X/Y/Z INDICATES NUMBER OF BLOWS FOR "STANDARD PENETRATION TEST" X = NUMBER OF BLOWS FOR FIRST 6 INCHES Y = NUMBER OF BLOWS FOR SECOND 6 INCHES Z = NUMBER OF BLOWS FOR THIRD 6 INCHES	
N INDICATES NUMBER OF BLOWS FOR 12 INCHES.	
Nφ INDICATES NUMBER OF BLOWS FOR 12 INCHES IN 6-INCH INCREMENTS.	
WC INDICATES WATER CONTENT IN PERCENT.	
W INDICATES STATIC WATER ELEVATION.	
W INDICATES FREE WATER ELEVATION.	
• INDICATES A PLASTIC MATERIAL WITH A MOISTURE CONTENT EQUAL TO OR GREATER THAN THE LIQUID LIMIT MINUS 3.	
⊕ INDICATES A NON-PLASTIC MATERIAL WITH A MOISTURE CONTENT GREATER THAN 25 % OR GREATER THAN 19 % WITH A WET APPEARANCE.	
R REFUSAL OF SPLIT-BARREL SAMPLER IN HARD OR VERY-DENSE SOIL.	
P INDICATES A SHELBY TUBE OR PRESS SAMPLE.	
ST INDICATES A SHELBY TUBE.	
TR INDICATES TOP OF BEDROCK.	

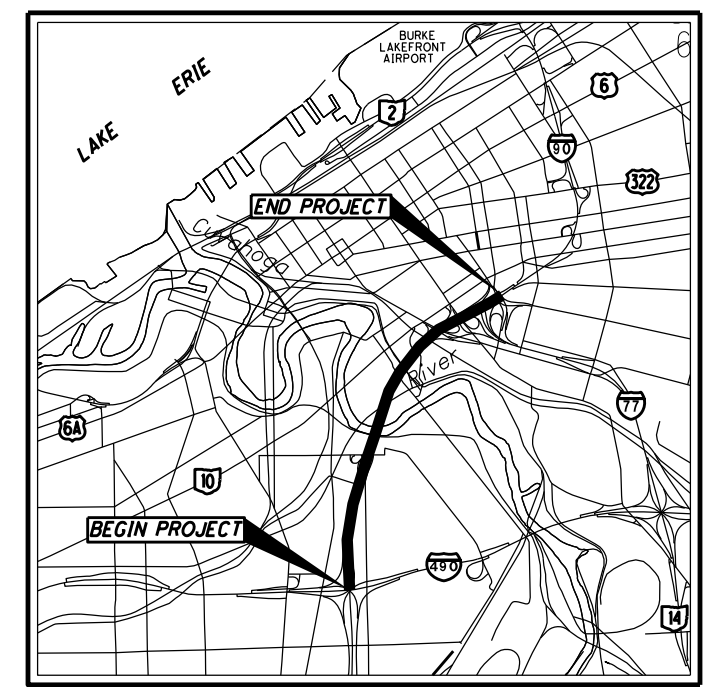

LOCATION MAP  
SCALE IN MILES

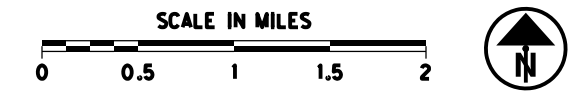


NOTE: PROJECT RFP BORING LOGS AND/OR PROFILES (BASED ON INFORMATION AVAILABLE AT THE TIME OF SUBMITTAL) ARE SUBMITTED IN A BINDER UNDER SEPARATE COVER. SHANNON & WILSON (S&W) BORING LOGS ARE SUBMITTED AS APPENDIX B OF THE PROJECT GEOTECHNICAL REPORT. COPIES OF THE PROJECT GEOTECHNICAL REPORT ARE LOCATED IN THE ODOT DISTRICT OFFICE, THE ODOT OFFICE OF GEOTECHNICAL ENGINEERING, AND THE ODOT OFFICE OF STRUCTURAL ENGINEERING.

**PROJECT DESCRIPTION**

AS PART OF THE CUY-90-14.90 (FORMERLY CUY-90-14.52) PROJECT, IT IS PLANNED TO RECONFIGURE APPROXIMATELY 1.6 MILES OF WESTBOUND I-90 (STA. 97+02.06 TO APPROXIMATE STA. 177+65) IN CLEVELAND, CUYAHOGA COUNTY, OHIO. ASSOCIATED WORK INVOLVED IN THIS PROJECT IS THE CONSTRUCTION OF A NEW FIVE-LANE BRIDGE STRUCTURE OVER THE CUYAHOGA RIVER VALLEY. ENTRANCE AND EXIT RAMP AT EAST 14TH STREET, EAST 9TH STREET, ONTARIO STREET AND ABBEY AVENUE WILL BE RECONFIGURED AND CONSTRUCTED. RECONFIGURATION OF THE WEST 14TH STREET EXTENSION, COMMERCIAL ROAD, BROADWAY AVENUE, AND EAST 9TH STREET IS ALSO INCLUDED IN THIS PROJECT.

- CONTINUED ON SHEET 2 -

**PARTICLE SIZE DEFINITIONS**

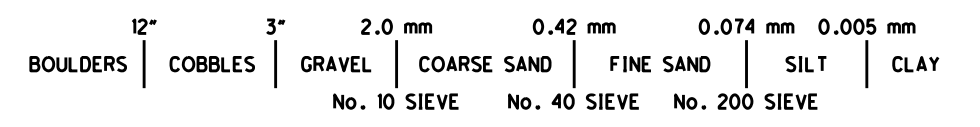

- RECON. - VARIOUS (BBCM, B&P, S&W) 2006, 2009, 2010, 2011
- DRILLING - BBCM 2006, 2009; B&P 2009, 2010; S&W 2010, 2011
- DRAWN - TJM/MRM
- REVIEWED - BKS/JLS
- REVISIONS TO ADD S&W 2010, 2011 INFORMATION
- DRAWN - CNT
- REVIEWED - MDH

"This document was originally issued by BBCM Engineering Inc. on 5/28/10. This document is not considered a sealed document."

AVAILABLE INFORMATION

NUMEROUS HISTORICAL RECORDS WERE SEARCHED TO GATHER HISTORICAL BORING INFORMATION IN THE GENERAL VICINITY OF THIS PROJECT. SEVERAL SUBSURFACE INVESTIGATIONS HAVE BEEN PERFORMED IN THE GENERAL PROJECT VICINITY AS EARLY AS 1923. AVAILABLE INFORMATION WITHIN THE PROJECT LIMITS OBTAINED FROM THE HISTORICAL RECORDS SEARCH IS LISTED AS FOLLOWS:

- SOIL PROFILES WERE AVAILABLE FOR THE 1923 INVESTIGATION PERFORMED BY THE CLEVELAND UNION TERMINAL COMPANY FOR THE CUYAHOGA VIADUCT BRIDGE... MULTIPLE SUBSURFACE INVESTIGATIONS WERE CONDUCTED BY ODOT IN 1958, 1963, 1964, 1990 AND 1992... HOWARD, NEEDLES, TAMMEN & BERGENOFF CONSULTING ENGINEERS (HNTB) PERFORMED INVESTIGATIONS BETWEEN 1954 AND 1956... SOIL PROFILES WERE AVAILABLE FOR THE 1955 INVESTIGATION BY NEW YORK, CHICAGO AND ST. LOUIS RAILROAD COMPANY... IN 1986, BORINGS WERE PERFORMED BY THE DAVID V. LEWIN CORPORATION... IN 1986 AND 1987, R&R INTERNATIONAL, INC. (R&R) PERFORMED BORINGS... IN 2000 AND 2001, DLZ CORPORATION (DLZ) PERFORMED THREE (3) BORINGS... BBC&M ENGINEERING, INC. (BBCM) PERFORMED SUBSURFACE INVESTIGATIONS BETWEEN 1994 AND 2006... BBCM PERFORMED A PRELIMINARY SUBSURFACE INVESTIGATION IN 2006...

ALL AVAILABLE SOIL INFORMATION THAT CAN BE CONVENIENTLY SHOWN ON THE SOIL PROFILE SHEETS HAS BEEN SO REPORTED. THE LOGS OF PRE-DESIGN PHASE BORINGS, SOIL PROFILES (WHERE BORINGS WERE NOT AVAILABLE), AND CPT LOGS HAVE BEEN SUBMITTED SEPARATELY FROM THESE SOIL PROFILE SHEETS IN A BINDER PER ODOT'S REQUEST.

ADDITIONAL SUBSURFACE EXPLORATIONS MAY HAVE BEEN MADE TO STUDY SOME SPECIAL ASPECT OF THE PROJECT. COPIES OF THIS DATA, IF ANY, MAY BE INSPECTED IN THE DISTRICT DEPUTY DIRECTOR'S OFFICE, THE OFFICE OF GEOTECHNICAL ENGINEERING AT 1600 WEST BROAD STREET OR THE OFFICE OF STRUCTURAL ENGINEERING AT 1980 WEST BROAD STREET.

SUBSURFACE EXPLORATION

TO SUPPLEMENT THE SUBSURFACE INVESTIGATIONS PERFORMED BY BBCM BETWEEN 1994 AND 2006 BASED ON THE MOST RECENT PLANS FOR THE CUY-90-14.90 PROJECT, BARR & PREVOST (B&P) PERFORMED 80 BORINGS BETWEEN MAY AND OCTOBER OF 2009 AND BBCM PERFORMED SEVEN (7) BORINGS BETWEEN JUNE AND SEPTEMBER OF 2009. ADDITIONALLY, ODOT PERFORMED TWO (2) CPT TESTS ON AUGUST 18, 2009. AN ADDITIONAL SIX (6) BORINGS WERE PERFORMED BY B&P BETWEEN APRIL AND MAY OF 2010. AT LOCATIONS REQUESTED BY THE DESIGN BUILD TEAM FINALISTS, BETWEEN NOVEMBER 2010 AND JANUARY 2011 SHANNON & WILSON PERFORMED AN ADDITIONAL SEVENTEEN (17) BORINGS AND FOURTEEN (14) CPTS. WALSH CONSTRUCTION ALSO COMPLETED TWO (2) BORINGS, B-047-5-11 AND B-047-6-11, IN NOVEMBER 2011.

THE BORINGS WERE DRILLED WITH EITHER AN ATV-MOUNTED (ALL-TERRAIN VEHICLE) OR A TRUCK-MOUNTED DRILLING RIG. SHANNON & WILSON DESIGN PHASE BORINGS WERE COMPLETED USING TWO DRILL RIGS; A MOBILE B-57 AND A SIMCO 2800 HSHT. DISTURBED, BUT REPRESENTATIVE, SOIL SAMPLES WERE OBTAINED BY LOWERING A 2-INCH O.D. SPLIT-BARREL SAMPLER TO THE BOTTOM OF THE BORING AND DRIVING IT INTO THE SOIL BY BLOWS FROM A 140-POUND HAMMER FREELY FALLING 30 INCHES (ASTM D1586 - STANDARD PENETRATION TEST). THE Hammers USED TO DRIVE THE SPLIT-BARREL SAMPLES FOR SHANNON & WILSON'S BORINGS WERE LAST CALIBRATED ON JANUARY 14, 2011 FOR THE MOBILE B-57 AND SIMCO 2800 HSHT AS DELIVERING AVERAGE ENERGY EFFICIENCIES OF 81.3% AND 73.5%, RESPECTIVELY. SPLIT BARREL SAMPLES WERE EXAMINED IMMEDIATELY AFTER RECOVERY AND REPRESENTATIVE PORTIONS WERE PRESERVED IN AIRTIGHT GLASS JARS. WHERE DESIRED AND POSSIBLE, 3-INCH O.D. SHELBY TUBE SAMPLERS WERE HYDRAULICALLY PUSHED IN SOIL

EXHIBITING COHESION TO OBTAIN "UNDISTURBED" SAMPLES. WHERE ENCOUNTERED, BEDROCK WAS CORED USING AN NX OR SIMILAR SIZED DIAMOND BIT ROCK CORE BARREL WITH WATER AS A CIRCULATING/COOLING FLUID. RETRIEVED ROCK CORE SAMPLES WERE STORED IN COMPARTMENTAL CORE BOXES. UPON COMPLETION, THE DEPTH TO ANY ACCUMULATED GROUNDWATER WAS MEASURED. THE BORINGS WERE BACKFILLED OR SEALED IN ACCORDANCE WITH ODOT REQUIREMENTS, AND THE SURFACE OF THE EXISTING PAVEMENT AT THE BORING LOCATIONS WAS REPAIRED USING COLD-PATCH ASPHALT OR CONCRETE, WHERE APPROPRIATE.

THE LOGS OF BORINGS FOR THE 2009 SUBSURFACE INVESTIGATIONS HAVE ALSO BEEN INCLUDED SEPARATELY IN THE AFOREMENTIONED BINDER OF LOGS AND SOIL PROFILES. THE LOGS OF SHANNON & WILSON'S 2010/2011 DESIGN PHASE BORINGS WERE SUBMITTED SEPARATELY IN THE PROJECT GEOTECHNICAL REPORT, COPIES OF WHICH ARE MAINTAINED IN THE ODOT DISTRICT OFFICE, OFFICE OF GEOTECHNICAL ENGINEERING, AND OFFICE OF STRUCTURAL ENGINEERING.

GEOLOGY AND EXPLORATION FINDINGS

THE MAJORITY OF THE PROJECT LIMITS LIE WITHIN THE PRESENT CUYAHOGA RIVER VALLEY. A LARGE PORTION OF THE CUYAHOGA RIVER VALLEY IS CLASSIFIED AS "MADE LAND" WITH URBAN COVER COMPOSED OF FILL MATERIALS OF VARIABLE COMPOSITION AND DEPTH. BENEATH THE FILL MATERIALS, SUBSURFACE INVESTIGATIONS PERFORMED BY BBCM, B&P, AND OTHERS HAVE ENCOUNTERED APPROXIMATELY 20 TO 50 FEET OF ALLUVIUM DEPOSITS OF HOLOCENE AGE CONSISTING PREDOMINANTLY OF VERY-LOOSE TO MEDIUM-DENSE SANDS AND SILTS AND VERY-SOFT TO MEDIUM STIFF SILTY CLAY AND CLAY OF VARIABLE ORGANIC CONTENT. THE ALLUVIUM MATERIALS WERE DEPOSITED BY THE PRECURSOR TO THE CUYAHOGA RIVER. BENEATH THE ALLUVIUM DEPOSITS, APPROXIMATELY 55 TO 100 FEET OF LACUSTRINE DEPOSITS CONSISTING PRIMARILY OF MEDIUM-STIFF TO VERY STIFF SILTY CLAYS WERE GENERALLY ENCOUNTERED. THESE LACUSTRINE SOILS WERE DEPOSITED BY A SERIES OF LARGE PROGLACIAL LAKES WHICH COVERED THE GREATER CLEVELAND AREA NEAR THE END OF THE WISCONSINAN GLACIAL PERIOD. SLOPE FAILURES OBSERVED IN THE RIVER VALLEY SIDE SLOPES HAVE OCCURRED PRIMARILY WITHIN THESE LACUSTRINE DEPOSITS. MANY SLOPE FAILURES HAVE BEEN OBSERVED OVER THE YEARS ON THE SIDE SLOPES ADJACENT TO THE CUYAHOGA RIVER. THE LACUSTRINE DEPOSITS OVERLIE APPROXIMATELY 25 TO 65 FEET OF TILL FROM THE WISCONSINAN OR ILLINOIAN GLACIAL PERIODS. THE TILL PRIMARILY CONSISTS OF DENSE TO VERY-DENSE SANDY SILT OR VERY-STIFF TO HARD CLAYEY SILT. BENEATH THE TILL, OHIO DEVONIAN SHALE WAS ENCOUNTERED, WHICH CONTAINS ORGANIC MATTER AND NATURAL GAS. THIS GAS IS KNOWN TO PERCOLATE UPWARDS THROUGH THE SHALE BECOMING TRAPPED IN POCKETS THROUGHOUT THE LOWER PORTION OF THE OVERLYING SEDIMENTS.

SPECIFICATIONS

ALL BORINGS PERFORMED BY BBCM IN 2006 WERE GENERALLY PERFORMED IN ACCORDANCE WITH THE 1995 ODOT "SPECIFICATIONS FOR SUBSURFACE INVESTIGATIONS." BORINGS PERFORMED IN 2006 TO INVESTIGATE THE PAVEMENT SUBGRADES WERE ALSO PERFORMED IN GENERAL ACCORDANCE WITH ODOT OFFICES OF CONSTRUCTION ADMINISTRATION AND GEOTECHNICAL ENGINEERING GEOTECHNICAL BULLETIN GBI, "PLAN SUBGRADES", REVISED JUNE 29, 2005. ALL BORINGS PERFORMED BY BBCM AND B&P IN 2009 AND 2010 WERE GENERALLY PERFORMED IN ACCORDANCE WITH THE ODOT "SPECIFICATIONS FOR GEOTECHNICAL EXPLORATIONS", REVISED JANUARY 16, 2009. THE BORINGS PERFORMED BY B&P IN 2009 TO INVESTIGATE THE PAVEMENT SUBGRADES WERE ALSO PERFORMED IN GENERAL ACCORDANCE WITH THE GBI DOCUMENT, REVISED JANUARY 18, 2007. ALL BORINGS PERFORMED BY SHANNON & WILSON IN 2010/2011 WERE PERFORMED IN GENERAL ACCORDANCE WITH THE 2010 ODOT "SPECIFICATIONS FOR GEOTECHNICAL EXPLORATIONS". THE BORINGS PERFORMED BY ODOT AND BBCM IN THE 1990'S WERE PRESUMABLY PERFORMED IN GENERAL ACCORDANCE WITH THE 1984 ODOT "SPECIFICATIONS FOR SUBSURFACE INVESTIGATIONS" ALTHOUGH THIS COULD NOT BE VERIFIED. IT IS UNKNOWN IF THE OTHER INVESTIGATIONS LOCATED WITHIN THE PROJECT LIMITS WERE PERFORMED IN ACCORDANCE WITH ANY SPECIFICATIONS.

SUMMARY OF UNCONFINED COMPRESSION STRENGTH (UCS) TESTING DATA - SOIL

Table with columns: ORIGINAL BORING NO., SGE BORING NO., SAMPLE NO., SAMPLE ELEVATION (MSL), UNCONFINED COMPRESSIVE STRENGTH (PSF). Includes rows for borings B-044-1-10 through B-106A-58\*\*.

\*BORING B-022-1-09 WAS PERFORMED TO RECOVER SHELBY TUBE SAMPLES AND NO LOG WAS CREATED. RESULTS FOR TESTS FROM BORING B-022-1-09 ARE SHOWN ON LOG FOR BORING B-022-0-09. \*\*SAMPLE ELEVATIONS ARE APPROXIMATE.

SUMMARY OF SLAKE DURABILITY (SD) TESTING DATA ON SHALE BEDROCK


Table with columns: SGE BORING NO., SAMPLE NO., SAMPLE ELEVATION (MSL), TEST FLUID/ SLURRY TYPE, SLAKE DURABILITY INDEX, I d2 (%). Includes rows for borings B-022-0-09 through B-045-0-09.



PID NO. 77332

SOIL PROFILE

CUY-90-14.90

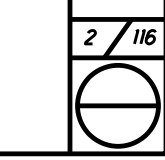







One Dimensional Consolidation Properties (Oedometer) Pro Geotech, Inc.

Client	Shannon & Wilson, Inc	Lab Ref	
Project	CUY-90-14.90	Job	G10022G
Borehole	B-022-2-10	Sample	ST-19
Location	Cleveland, OH	Depth	73.5'

Test Details			
Standard	ASTM D2435-96 / AASHTO T216-84	Particle Specific Gravity	2.74
Sample Type	Thin walled push in sample	Lab. Temperature	72.0 deg.F
Method of Testing (A/B)	B		
Sample Description	Gray SILT AND CLAY (A-6a), trace sand, trace rock fragments		
Variations from Procedure	None		

Specimen Details			
Specimen Reference	C	Description	No fissures
Depth within Sample	20.0000in	Orientation within Sample	Random
Specimen Mass	0.2768 lb	Condition	Inundated
Specimen Height	0.7900 in	Preparation	Undisturbed (very minor patching)
Comments			

Apparatus			
Ring Number	1	Ring Diameter	2.5030 in
Ring Height	0.7900 in	Ring Weight	0.1431 lb
Lever Ratio	10.00 : 1	Drainage	Double-Sided

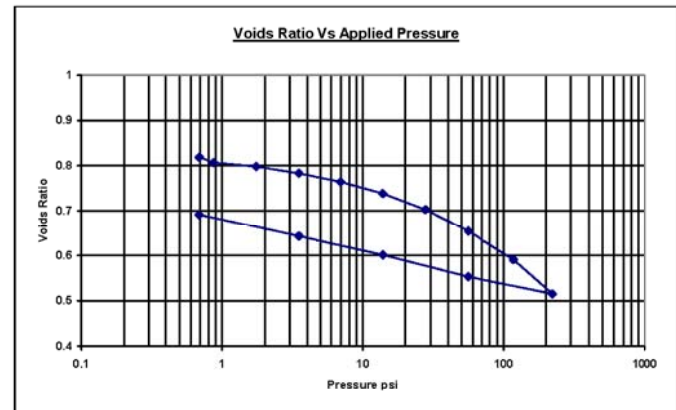


Figure E-35  
Sheet 1 of 12

One Dimensional Consolidation Properties (Oedometer) Pro Geotech, Inc.

Client	Shannon & Wilson, Inc	Lab Ref	
Project	CUY-90-14.90	Job	G10022G
Borehole	B-022-2-10	Sample	ST-19
Location	Cleveland, OH	Depth	73.5'

Initial Moisture Content*	30.7 % (trimmings: 29.2 %)	Final Moisture Content	26.8 %
Initial Bulk Density	123.05 lb/ft3	Final Bulk Density	128.41 lb/ft3
Initial Dry Density	94.18 lb/ft3	Final Dry Density	101.28 lb/ft3
Initial Void Ratio	0.8189	Final Void Ratio	0.6813
Initial Degree of Saturation	102.71%	Final Degree of Saturation	106.32%
Seating Pressure	0.69 psi		

\* Calculated from initial and dry weights of whole specimen


Pressure (Loading)	Load Increment Duration	Deformation (Corrected)	d <sub>100</sub> (Corrected)	Coefficient of Consolidation (c <sub>v</sub> )
0.00				
0.87 psi	1080.000 min	0.0051 in	0.0035 in	0.03279 in <sup>2</sup> /min
1.74 psi	381.000 min	0.0090 in	0.0073 in	0.02807 in <sup>2</sup> /min
3.48 psi	960.000 min	0.0155 in	0.0127 in	0.02218 in <sup>2</sup> /min
6.95 psi	605.000 min	0.0239 in	0.0219 in	0.00903 in <sup>2</sup> /min
13.86 psi	762.000 min	0.0353 in	0.0331 in	0.00874 in <sup>2</sup> /min
27.74 psi	480.000 min	0.0506 in	0.0479 in	0.01062 in <sup>2</sup> /min
55.55 psi	960.000 min	0.0715 in	0.0676 in	0.01068 in <sup>2</sup> /min
117.10 psi	1260.000 min	0.0989 in	0.0939 in	0.01252 in <sup>2</sup> /min
221.80 psi	1080.000 min	0.1319 in	0.1249 in	0.01778 in <sup>2</sup> /min
55.55 psi	480.000 min	0.1157 in	-----	-----
13.86 psi	960.000 min	0.0945 in	-----	-----
3.48 psi	480.000 min	0.0763 in	-----	-----
0.69 psi	1080.000 min	0.0554 in	-----	-----

Method of Time Fitting Used Square Root Time

Figure E-35  
Sheet 2 of 12

One Dimensional Consolidation Properties (Oedometer) Pro Geotech, Inc.

Client	Shannon & Wilson, Inc	Lab Ref	
Project	CUY-90-14.90	Job	G10022G
Borehole	B-022-2-10	Sample	ST-19
Location	Cleveland, OH	Depth	73.5'

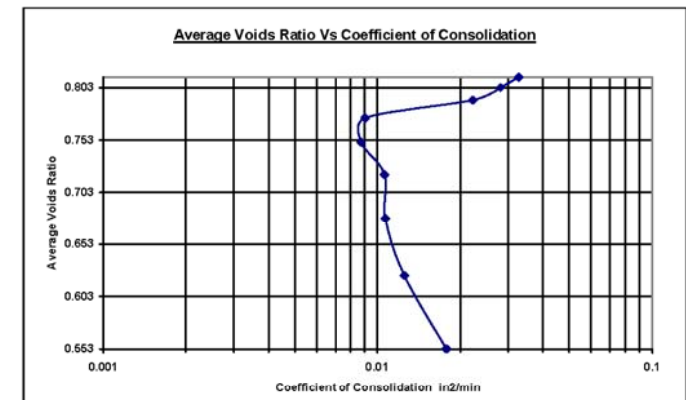

Tested By and Date:	FB/12/22/2010
Checked By and Date:	SS/1/14/2011
Approved By and Date:	WN/1/17/2011

Figure E-35  
Sheet 3 of 12



One Dimensional Consolidation Properties (Oedometer)



Client	Shannon & Wilson, Inc.	Lab Ref	
Project	CUY-90-14.90	Job	G100022G
Borehole	B-022-2-10	Sample	ST-21
Location	Cleveland, OH	Depth	83.0'

Test Details			
Standard	ASTM D2435-96 / AASHTO T216-84	Particle Specific Gravity	2.71
Sample Type	Thin walled push in sample	Lab. Temperature	72.0 deg.F
Method of Testing (A/B)	A		
Sample Description	Gray SILT "and" clay, trace sand		
Variations from Procedure	None		

Specimen Details			
Specimen Reference	A	Description	No fissures
Depth within Sample	22.000in	Orientation within Sample	Random
Specimen Mass	0.2920 lb	Condition	Inundated
Specimen Height	0.7900 in	Preparation	Undisturbed
Comments			

Apparatus			
Ring Number	1	Ring Diameter	2.5030 in
Ring Height	0.7900 in	Ring Weight	0.1431 lb
Lever Ratio	10.00 : 1	Drainage	Double-Sided

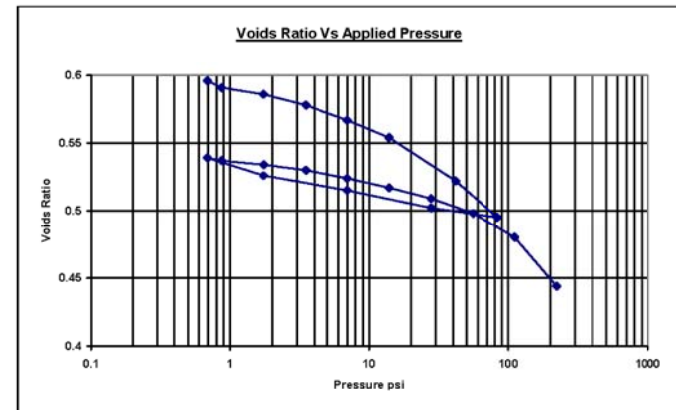


Figure E-36 Sheet 1 of 20

One Dimensional Consolidation Properties (Oedometer)



Client	Shannon & Wilson, Inc.	Lab Ref	
Project	CUY-90-14.90	Job	G100022G
Borehole	B-022-2-10	Sample	ST-21
Location	Cleveland, OH	Depth	25.30

Initial Moisture Content*	22.3 % (trimmings: 23.4 %)	Final Moisture Content	18.2 %
Initial Bulk Density	129.79 lb/ft <sup>3</sup>	Final Bulk Density	138.66 lb/ft <sup>3</sup>
Initial Dry Density	106.16 lb/ft <sup>3</sup>	Final Dry Density	117.35 lb/ft <sup>3</sup>
Initial Void Ratio	0.5960	Final Void Ratio	0.4438
Initial Degree of Saturation	101.38%	Final Degree of Saturation	111.04%
Seating Pressure	0.69 psi		

\* Calculated from initial and dry weights of whole specimen

Pressure (Loading)	Load Increment Duration	Deformation (Corrected)	d <sub>100</sub> (Corrected)	Coefficient of Consolidation (c <sub>v</sub> )
0.00				
0.87 psi	1440.000 min	0.0025 in	0.0019 in	0.00396 in <sup>2</sup> /min
1.74 psi	1920.000 min	0.0050 in	0.0043 in	0.00522 in <sup>2</sup> /min
3.48 psi	1260.000 min	0.0088 in	0.0076 in	0.01217 in <sup>2</sup> /min
6.95 psi	1260.000 min	0.0143 in	0.0129 in	0.01452 in <sup>2</sup> /min
13.87 psi	1080.000 min	0.0210 in	0.0193 in	0.02378 in <sup>2</sup> /min
41.62 psi	1440.000 min	0.0368 in	0.0341 in	0.03314 in <sup>2</sup> /min
83.11 psi	1440.000 min	0.0500 in	0.0463 in	0.04897 in <sup>2</sup> /min
27.74 psi	1080.000 min	0.0463 in	-----	-----
6.95 psi	2880.000 min	0.0401 in	-----	-----
1.74 psi	1260.000 min	0.0348 in	-----	-----
0.69 psi	1080.000 min	0.0283 in	-----	-----
0.87 psi	302.000 min	0.0294 in	0.0291 in	0.01348 in <sup>2</sup> /min
1.74 psi	1260.000 min	0.0306 in	0.0303 in	0.01144 in <sup>2</sup> /min
3.48 psi	1080.000 min	0.0329 in	0.0322 in	0.01562 in <sup>2</sup> /min
6.95 psi	381.000 min	0.0356 in	0.0353 in	0.01663 in <sup>2</sup> /min
13.87 psi	762.000 min	0.0392 in	0.0386 in	0.02840 in <sup>2</sup> /min
27.74 psi	302.000 min	0.0433 in	0.0427 in	0.05330 in <sup>2</sup> /min
55.55 psi	1680.000 min	0.0488 in	0.0475 in	0.09079 in <sup>2</sup> /min
111.00 psi	1080.000 min	0.0575 in	0.0548 in	0.07304 in <sup>2</sup> /min
221.80 psi	1440.000 min	0.0753 in	0.0701 in	0.06865 in <sup>2</sup> /min


Method of Time Fitting Used: Square Root Time

Figure E-36 Sheet 2 of 20

One Dimensional Consolidation Properties (Oedometer)



Client	Shannon & Wilson, Inc.	Lab Ref	
Project	CUY-90-14.90	Job	G100022G
Borehole	B-022-2-10	Sample	ST-21
Location	Cleveland, OH	Depth	83.0'

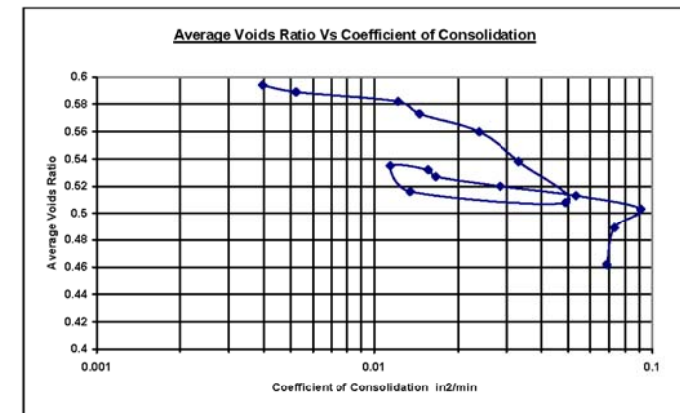

Tested By and Date:	FB/1/6/2011
Checked By and Date:	SS/1/28/2011
Approved By and Date:	WN/1/31/2011

Figure E-36 Sheet 3 of 20





One Dimensional Consolidation Properties (Oedometer)  Pro Geotech, Inc.

Client	Shannon & Wilson, Inc.	Lab Ref	
Project	CUY-90-14.90	Job	G100022G
Borehole	B-053-2-10	Sample	ST-26
Location	Cleveland, OH	Depth	105.5'

Test Details			
Standard	ASTM D2435-96 / AASHTO T216-84	Particle Specific Gravity	2.73
Sample Type	Thin walled push in sample	Lab. Temperature	72.0 deg.F
Method of Testing (A/B)	B		
Sample Description	Gray SILT "and" clay trace sand trace rock fragments		
Variations from Procedure	None		

Specimen Details			
Specimen Reference	A	Description	No fissures
Depth within Sample	20.00in	Orientation within Sample	Random
Specimen Mass	0.2875 lb	Condition	Inundated
Specimen Height	0.7900 in	Preparation	Undisturbed
Comments			

Apparatus			
Ring Number	1	Ring Diameter	2.5030 in
Ring Height	0.7900 in	Ring Weight	0.1431 lb
Lever Ratio	10.00 : 1	Drainage	Double-Sided

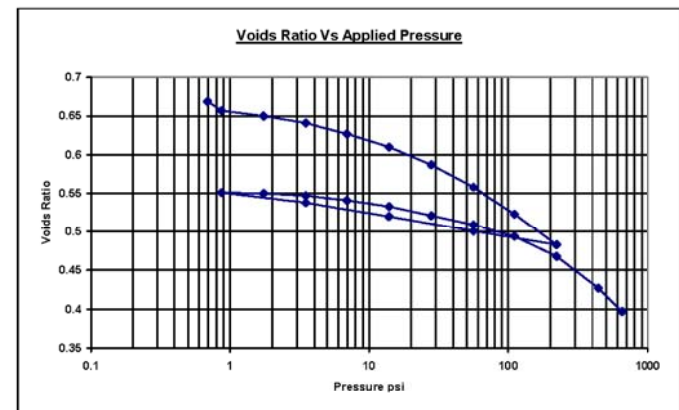


Figure E-37  
Sheet 1 of 23

One Dimensional Consolidation Properties (Oedometer)  Pro Geotech, Inc.

Client	Shannon & Wilson, Inc.	Lab Ref	
Project	CUY-90-14.90	Job	G100022G
Borehole	B-053-2-10	Sample	ST-26
Location	Cleveland, OH	Depth	105.5'

Initial Moisture Content*	25.1 % (trimmings: 22.5 %)	Final Moisture Content	18.2 %
Initial Bulk Density	127.78 lb/ft <sup>3</sup>	Final Bulk Density	144.19 lb/ft <sup>3</sup>
Initial Dry Density	102.11 lb/ft <sup>3</sup>	Final Dry Density	121.99 lb/ft <sup>3</sup>
Initial Void Ratio	0.6690	Final Void Ratio	0.3971
Initial Degree of Saturation	102.59%	Final Degree of Saturation	125.13%
Seating Pressure	0.69 psi		

\* Calculated from initial and dry weights of whole specimen


Pressure (Loading)	Load Increment Duration	Deformation (Corrected)	d <sub>100</sub> (Corrected)	Coefficient of Consolidation (c <sub>v</sub> )
0.00				
0.87 psi	960.000 min	0.0058 in	0.0046 in	0.08198 in <sup>2</sup> /min
1.74 psi	1260.000 min	0.0088 in	0.0076 in	0.09026 in <sup>2</sup> /min
3.48 psi	605.000 min	0.0133 in	0.0117 in	0.11168 in <sup>2</sup> /min
6.95 psi	762.000 min	0.0199 in	0.0179 in	0.12382 in <sup>2</sup> /min
13.87 psi	480.000 min	0.0281 in	0.0258 in	0.17702 in <sup>2</sup> /min
27.74 psi	1080.000 min	0.0390 in	0.0360 in	0.20811 in <sup>2</sup> /min
55.55 psi	1260.000 min	0.0524 in	0.0493 in	0.21814 in <sup>2</sup> /min
111.00 psi	1440.000 min	0.0689 in	0.0653 in	0.23239 in <sup>2</sup> /min
221.90 psi	960.000 min	0.0879 in	0.0830 in	0.40739 in <sup>2</sup> /min
55.55 psi	480.000 min	0.0798 in	-----	-----
13.87 psi	1080.000 min	0.0704 in	-----	-----
3.48 psi	302.000 min	0.0619 in	-----	-----
0.87 psi	762.000 min	0.0558 in	-----	-----
1.74 psi	480.000 min	0.0563 in	0.0561 in	0.28895 in <sup>2</sup> /min
3.48 psi	2160.000 min	0.0578 in	0.0574 in	0.11305 in <sup>2</sup> /min
6.95 psi	302.000 min	0.0604 in	0.0598 in	0.16441 in <sup>2</sup> /min
13.87 psi	240.000 min	0.0646 in	0.0638 in	0.19368 in <sup>2</sup> /min
27.74 psi	762.000 min	0.0699 in	0.0689 in	0.31738 in <sup>2</sup> /min
55.55 psi	605.000 min	0.0759 in	0.0752 in	0.30870 in <sup>2</sup> /min
111.00 psi	762.000 min	0.0829 in	0.0818 in	0.58393 in <sup>2</sup> /min
221.90 psi	960.000 min	0.0953 in	0.0921 in	1.19459 in <sup>2</sup> /min
441.54 psi	190.000 min	0.1143 in	0.1107 in	0.50681 in <sup>2</sup> /min

Method of Time Fitting Used: Square Root Time

Figure E-37  
Sheet 2 of 23

One Dimensional Consolidation Properties (Oedometer)  Pro Geotech, Inc.

Client	Shannon & Wilson, Inc.	Lab Ref	
Project	CUY-90-14.90	Job	G100022G
Borehole	B-053-2-10	Sample	ST-26
Location	Cleveland, OH	Depth	105.5'

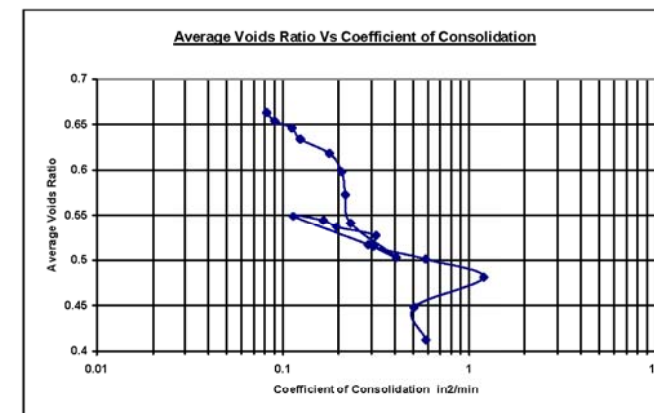

Tested By and Date:	FB/2/2011
Checked By and Date:	SS/2/14/2011
Approved By and Date:	WN/2/14/2011

Figure E-37  
Sheet 3 of 23



One Dimensional Consolidation Properties (Oedometer)  Pro Geotech, Inc.

Client	Shannon & Wilson, Inc.	Lab Ref	
Project	CUY-90-14.90	Job	G10022G
Borehole	B-053-2-10	Sample	ST-30
Location	Cleveland, OH	Depth	117.5'

Test Details			
Standard	ASTM D2435-96 / AASHTO T216-84	Particle Specific Gravity	2.746
Sample Type	Thin walled push in sample	Lab. Temperature	72.0 deg.F
Method of Testing (A/B)	B		
Sample Description	Gray SILT AND CLAY trace sand		
Variations from Procedure	None		

Specimen Details			
Specimen Reference	B	Description	No fissures
Depth within Sample	16.000in	Orientation within Sample	Random
Specimen Mass	0.3030 lb	Condition	Inundated
Specimen Height	0.7840 in	Preparation	Undisturbed
Comments			

Apparatus			
Ring Number	1	Ring Diameter	2.5030 in
Ring Height	0.7840 in	Ring Weight	0.1431 lb
Lever Ratio	10.00 : 1	Drainage	Double-Sided

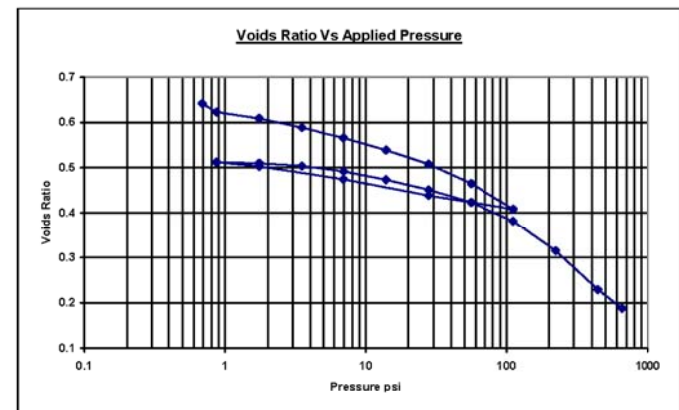


Figure E-38  
Sheet 1 of 22

One Dimensional Consolidation Properties (Oedometer)  Pro Geotech, Inc.

Client	Shannon & Wilson, Inc.	Lab Ref	
Project	CUY-90-14.90	Job	G10022G
Borehole	B-053-2-10	Sample	ST-30
Location	Cleveland, OH	Depth	117.5'

Initial Moisture Content*	30.3 % (trimmings: 28.3 %)	Final Moisture Content	25.1 %
Initial Bulk Density	135.73 lb/ft <sup>3</sup>	Final Bulk Density	180.14 lb/ft <sup>3</sup>
Initial Dry Density	104.19 lb/ft <sup>3</sup>	Final Dry Density	143.99 lb/ft <sup>3</sup>
Initial Void Ratio	0.8417	Final Void Ratio	0.1880
Initial Degree of Saturation	129.27%	Final Degree of Saturation	365.97%
Seating Pressure	0.69 psi		

\* Calculated from initial and dry weights of whole specimen. Note: Final weight of the wet soil was estimated because some soil was pushed out of the ring during consolidation.


Pressure (Loading)	Load Increment Duration	Deformation (Corrected)	d <sub>100</sub> (Corrected)	Coefficient of Consolidation (c <sub>v</sub> )
0.00				
0.87 psi	960.000 min	0.0091 in	0.0065 in	0.10794 in <sup>2</sup> /min
1.74 psi	302.000 min	0.0154 in	0.0125 in	0.07737 in <sup>2</sup> /min
3.48 psi	960.000 min	0.0251 in	0.0213 in	0.03959 in <sup>2</sup> /min
6.95 psi	381.000 min	0.0360 in	0.0326 in	0.01600 in <sup>2</sup> /min
13.87 psi	1080.000 min	0.0488 in	0.0471 in	0.01178 in <sup>2</sup> /min
27.74 psi	151.000 min	0.0638 in	0.0611 in	0.01828 in <sup>2</sup> /min
55.55 psi	1260.000 min	0.0845 in	0.0794 in	0.02554 in <sup>2</sup> /min
111.00 psi	302.000 min	0.1116 in	0.1062 in	0.02159 in <sup>2</sup> /min
27.74 psi	605.000 min	0.0973 in	-----	-----
6.95 psi	480.000 min	0.0800 in	-----	-----
1.74 psi	762.000 min	0.0662 in	-----	-----
0.87 psi	480.000 min	0.0621 in	-----	-----
1.74 psi	762.000 min	0.0628 in	0.0627 in	0.01298 in <sup>2</sup> /min
3.48 psi	302.000 min	0.0655 in	0.0650 in	0.00888 in <sup>2</sup> /min
6.95 psi	381.000 min	0.0716 in	0.0710 in	0.00752 in <sup>2</sup> /min
13.87 psi	480.000 min	0.0805 in	0.0794 in	0.01048 in <sup>2</sup> /min
27.74 psi	151.000 min	0.0912 in	0.0899 in	0.01864 in <sup>2</sup> /min
55.55 psi	381.000 min	0.1045 in	0.1029 in	0.02532 in <sup>2</sup> /min
111.00 psi	762.000 min	0.1244 in	0.1207 in	0.02627 in <sup>2</sup> /min
221.80 psi	190.000 min	0.1561 in	0.1508 in	0.02450 in <sup>2</sup> /min
441.54 psi	95.000 min	0.1969 in	0.1914 in	0.02853 in <sup>2</sup> /min
651.67 psi	95.000 min	0.2167 in	0.2118 in	0.03106 in <sup>2</sup> /min

Method of Time Fitting Used: Square Root Time

Figure E-38  
Sheet 2 of 22



One Dimensional Consolidation Properties (Oedometer)  Pro Geotech, Inc.

Client	Shannon & Wilson, Inc.	Lab Ref	
Project	CUY-90-14.90	Job	G10022G
Borehole	B-053-2-10	Sample	ST-30
Location	Cleveland, OH	Depth	117.5'

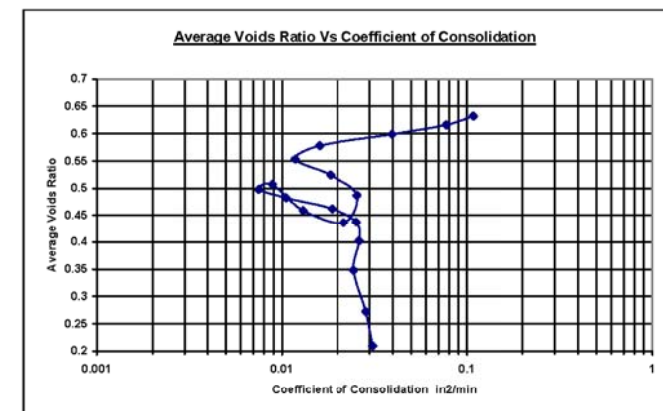

Tested By and Date:	FB/2/17/2011
Checked By and Date:	SS/2/24/2011
Approved By and Date:	WN/2/25/2011

Figure E-38  
Sheet 3 of 22

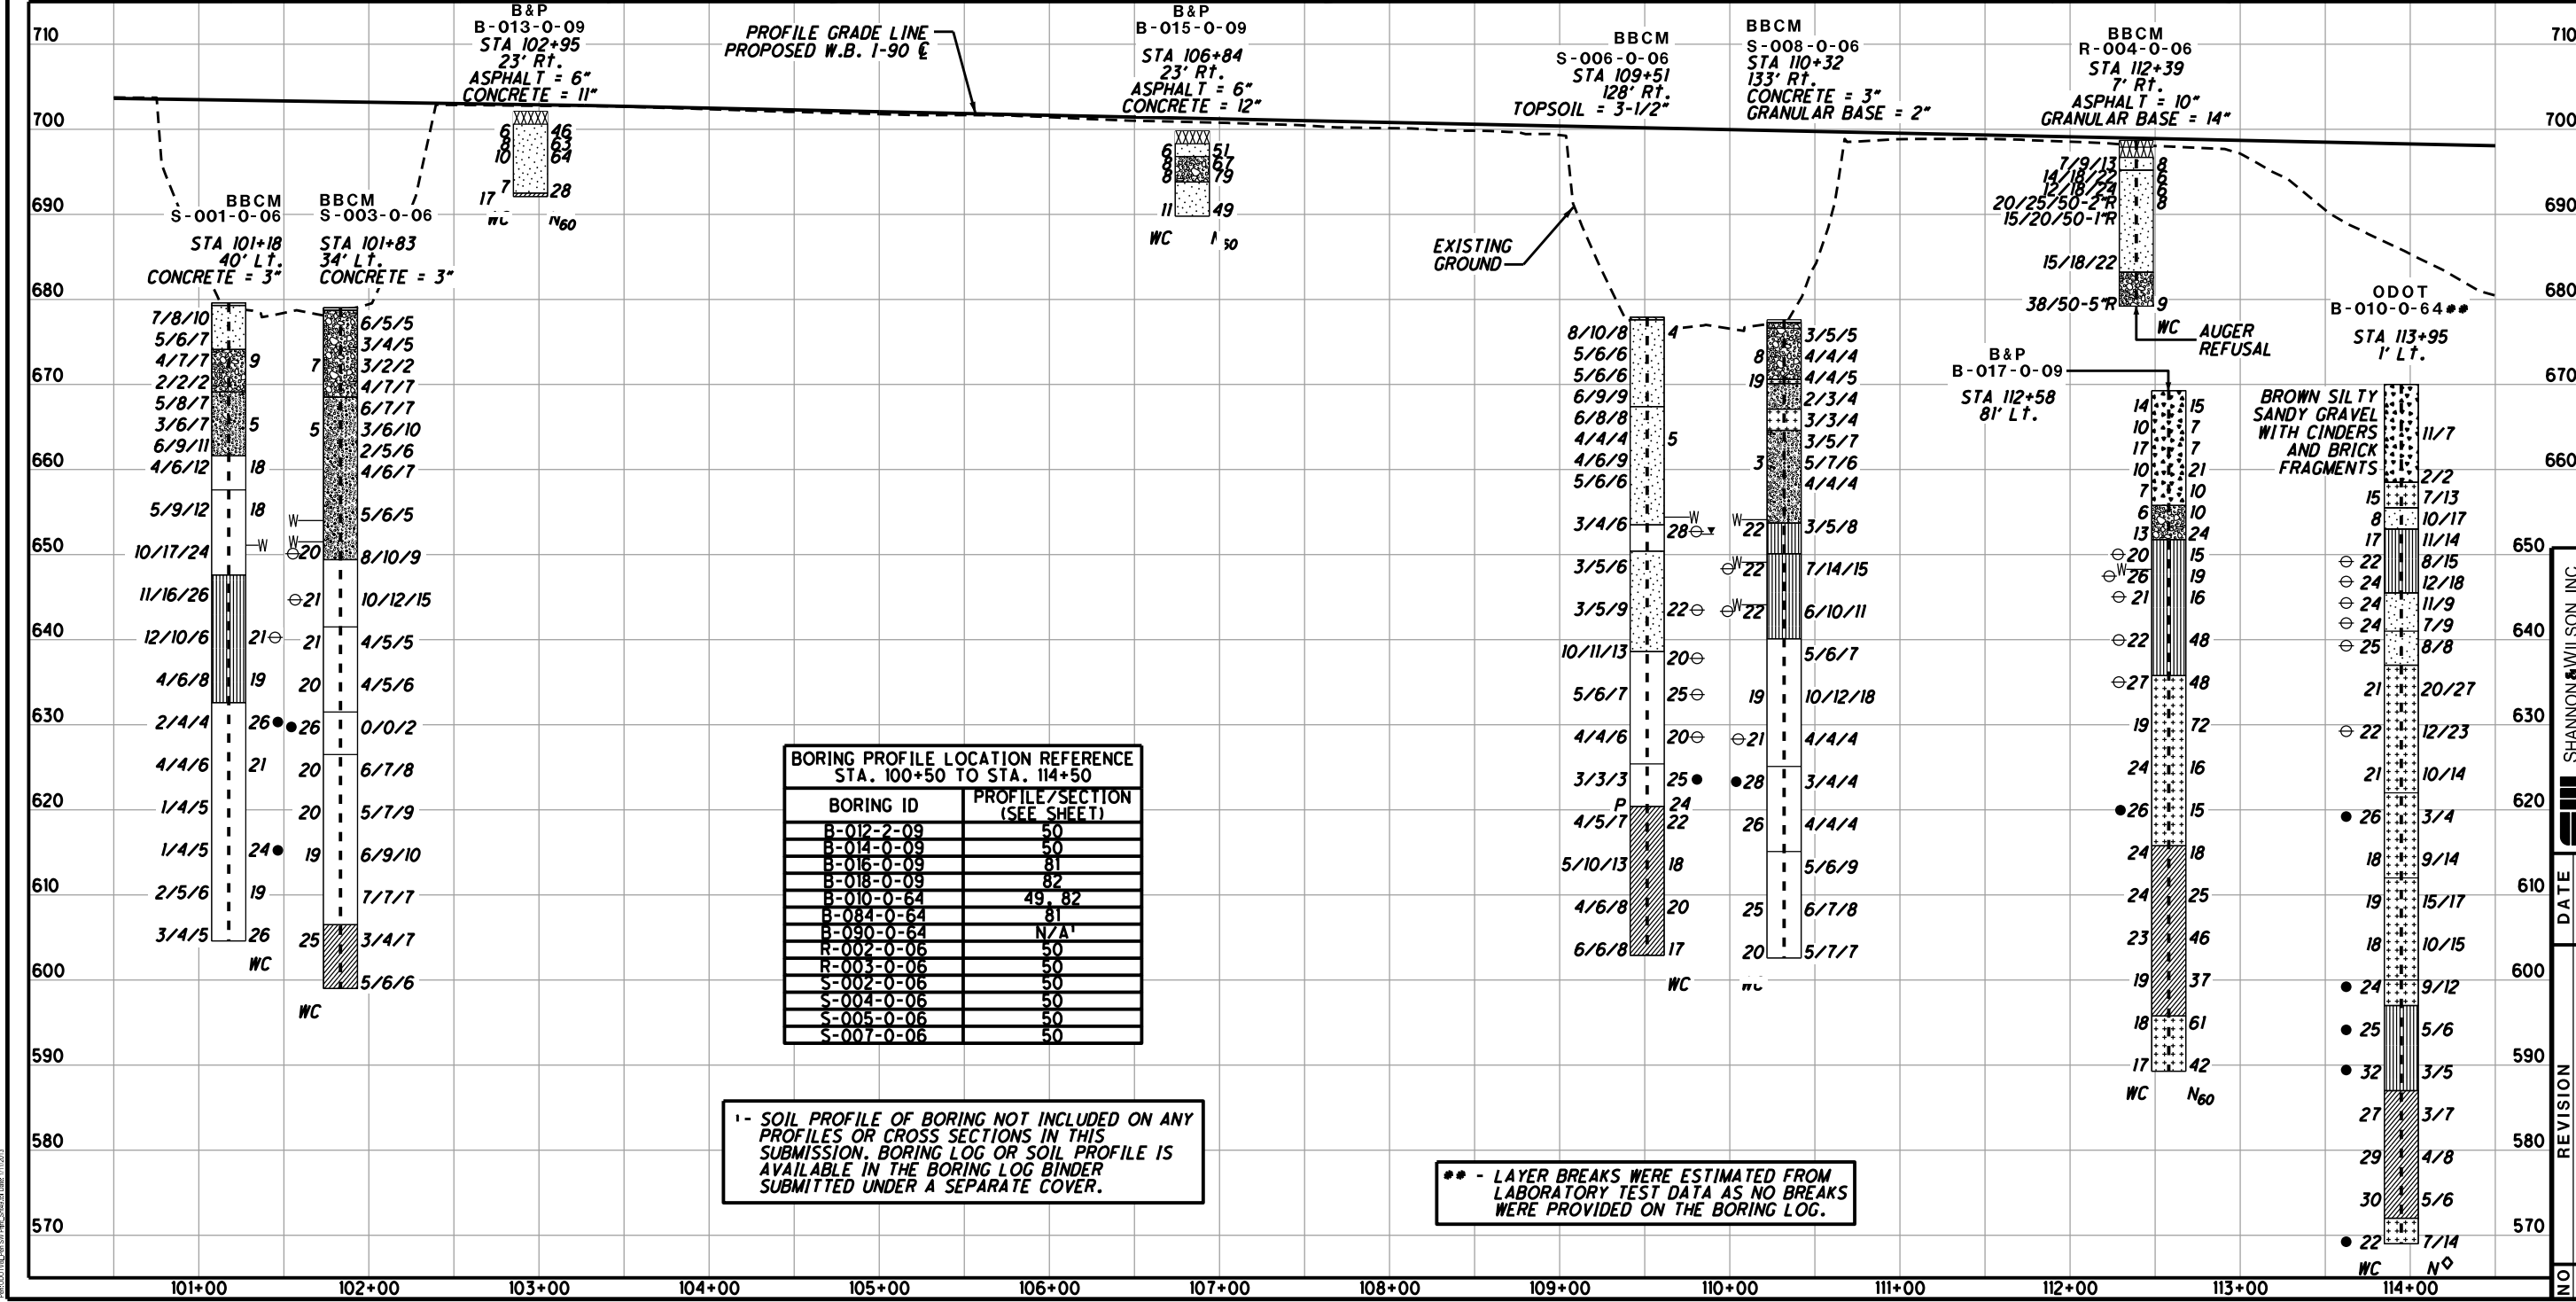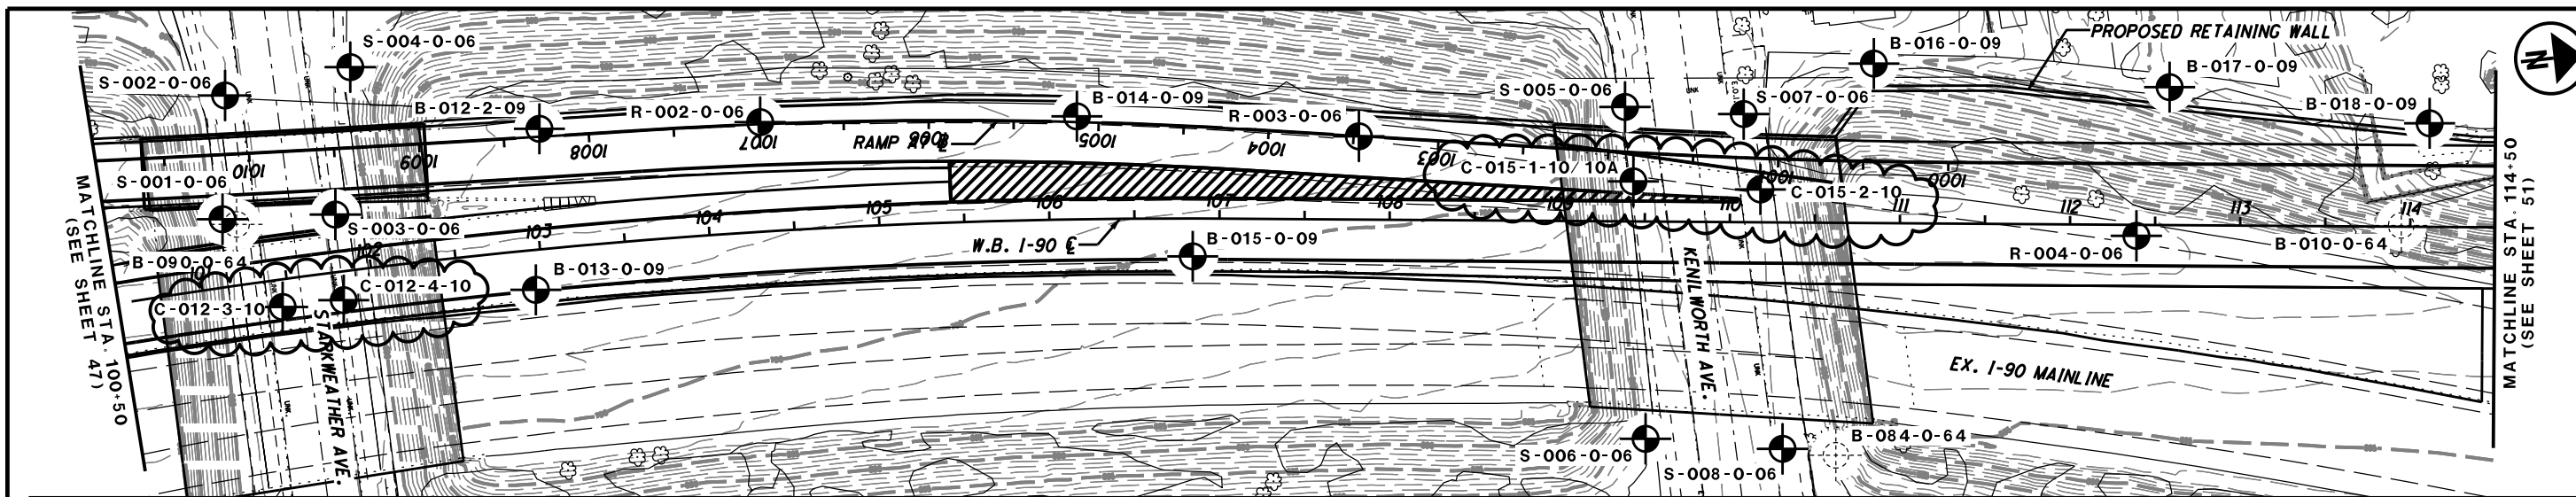

**BORING PROFILE LOCATION REFERENCE  
STA. 100+50 TO STA. 114+50**

BORING ID	PROFILE/SECTION (SEE SHEET)
B-012-2-09	50
B-014-0-09	50
B-016-0-09	81
B-018-0-09	82
B-010-0-64	49, 82
B-084-0-64	81
B-090-0-64	N/A
R-002-0-06	50
R-003-0-06	50
S-002-0-06	50
S-004-0-06	50
S-005-0-06	50
S-007-0-06	50

1 - SOIL PROFILE OF BORING NOT INCLUDED ON ANY PROFILES OR CROSS SECTIONS IN THIS SUBMISSION. BORING LOG OR SOIL PROFILE IS AVAILABLE IN THE BORING LOG BINDER SUBMITTED UNDER A SEPARATE COVER.

\*\* - LAYER BREAKS WERE ESTIMATED FROM LABORATORY TEST DATA AS NO BREAKS WERE PROVIDED ON THE BORING LOG.



SHANNON & WILSON, INC.  
Geotechnical and Environmental Consultants

NO	REVISION	DATE	ADDED
1	CCGT DESIGN PHASE BORINGS	12-21-2012	

B:\114\11452\11452.dwg, 12/21/2012, 11:51:00 AM, SHANNON & WILSON, INC.

BORING PROFILE LOCATION REFERENCE STA. 114+50 TO STA. 128+50			
BORING ID	PROFILE/SECTION (SEE SHEET)	BORING ID	PROFILE/SECTION (SEE SHEET)
B-019-0-09	83	B-023-0-63	N/A
B-019-1-09	83	B-004-W-55	N/A
B-020-0-09	52, 83	B-005-W-55	N/A
B-021-0-09	52	B-006-W-55	86
B-022-0-09	52, 84	C-005-0-06	N/A
B-022-1-09	N/A	C-006-0-06	N/A
B-023-0-09	52	C-007-0-06	N/A
B-023-1-09	116	C-008-0-06	N/A
B-023-2-09	54, 116	C-009-0-06	N/A
B-024-0-09	55	C-010-0-06	N/A
B-025-0-09	52	S-009-0-06	52
B-027-0-09	54	S-010-0-06	84
B-027-1-09	54	S-011-0-06	52
B-028-0-09	54	S-012-0-06	52
B-029-0-09	55	W-001-0-06	53
B-030-0-09	54	W-002-0-06	53
B-031-0-09	52	W-003-0-06	54
B-032-0-09	54, 55	W-004-0-06	54
B-033-0-09	54	B-022-2-10	52
B-034-0-09	55, 86	B-029-1-10	52
B-007-0-06	88	B-033-1-10	54
B-008-0-06	52, 86	B-033-2-10	52
B-008-0-86	N/A	B-034-1-10	52
B-006-0-63	N/A	C-022-3-10	N/A
B-013-0-63	N/A		

- 1 - SOIL PROFILE OF BORING NOT INCLUDED ON ANY PROFILES OR CROSS SECTIONS IN THIS SUBMISSION. BORING LOG OR SOIL PROFILE IS AVAILABLE IN THE BORING LOG BINDER SUBMITTED UNDER A SEPARATE COVER.
- 2 - OFFSET BORING FOR SHELBY TUBE SAMPLING ONLY. NO BORING LOG CREATED. REFER TO B-002-0-09 FOR SOIL PROFILE DATA.
- 3 - SOIL PROFILE OF BORING OR CONE PENETRATION TEST NOT INCLUDED ON ANY PROFILES OR CROSS SECTIONS IN THIS SUBMISSION. BORING OR CONE PENETRATION LOG IS AVAILABLE IN THE PROJECT GEOTECHNICAL REPORT FOR CUY-90-14.90 CONSTRUCTION CONTRACT GROUP 1.

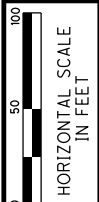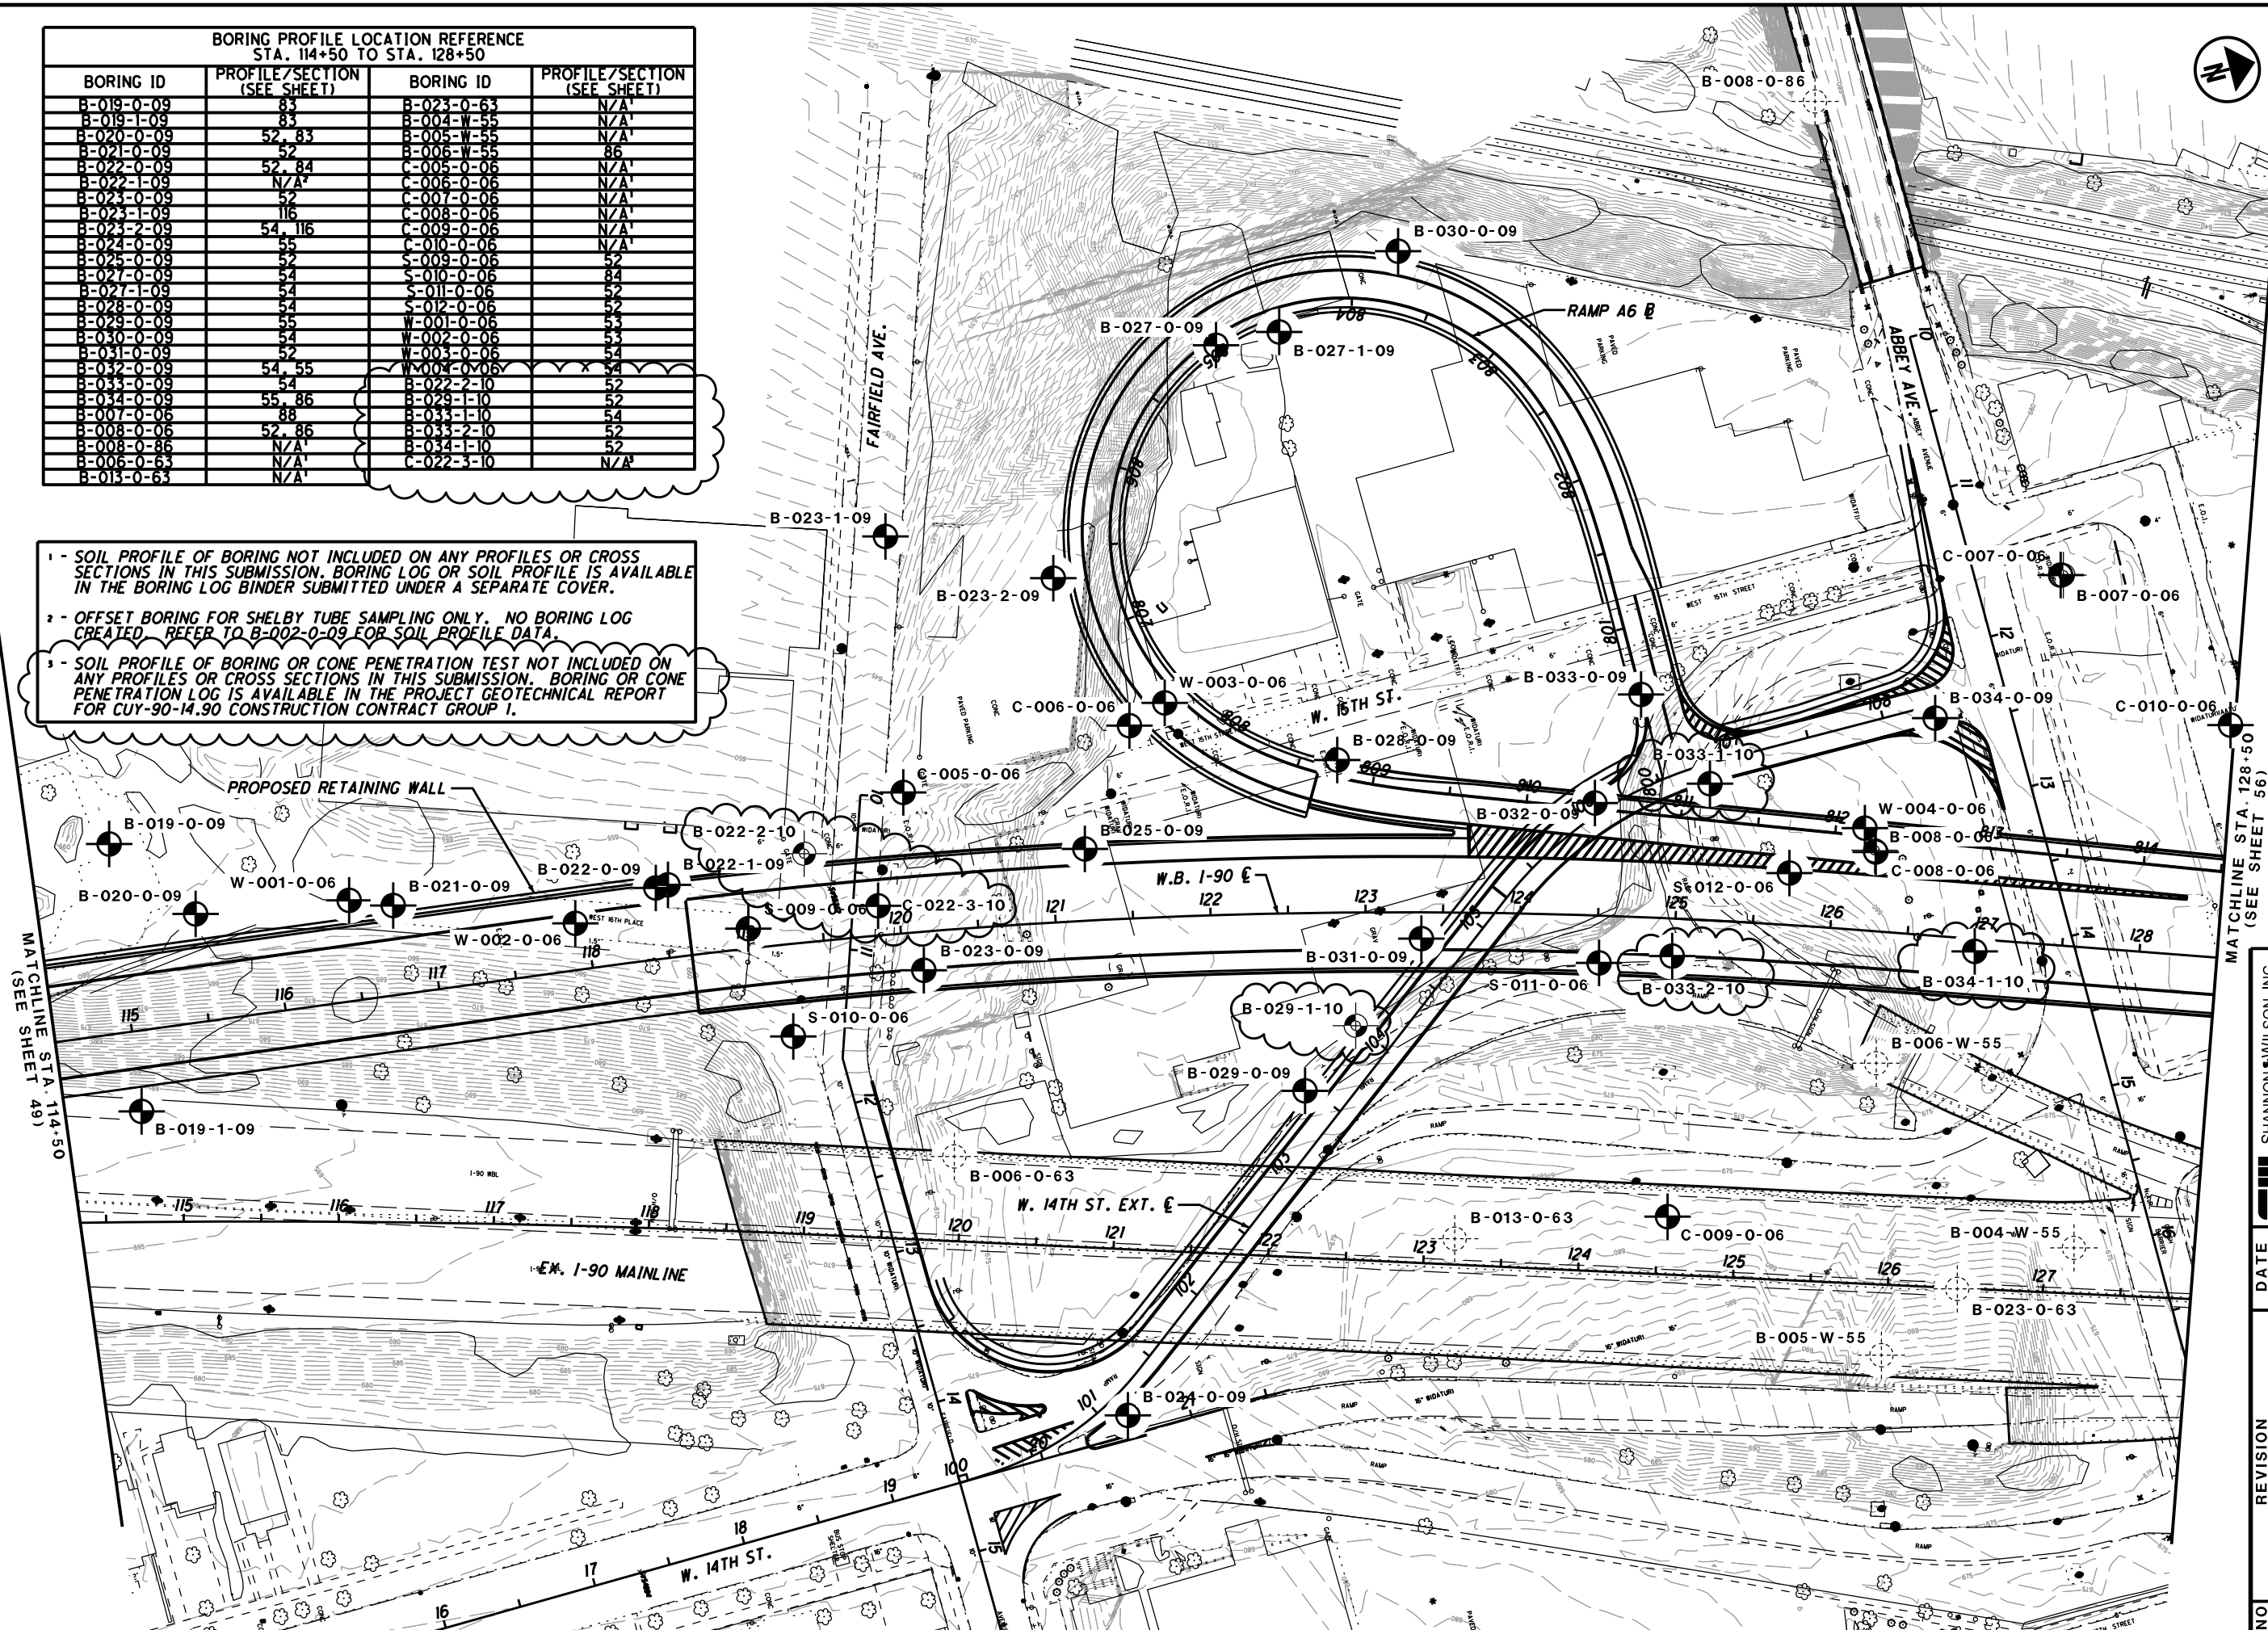

**BBCM**  
Geotechnical and Environmental Consultants

MATCHLINE STA. 128+50  
(SEE SHEET 56)


MATCHLINE STA. 114+50  
(SEE SHEET 49)

SHANNON WILSON, INC.  
Geotechnical and Environmental Consultants


NO	REVISION	DATE
1	CCGT DESIGN PHASE BORINGS ADDED	12-21-2012

CUY-90-14.52  
51 / 114

SOIL PROFILE - W.B. I-90  
STA. 114+50 TO STA. 128+50

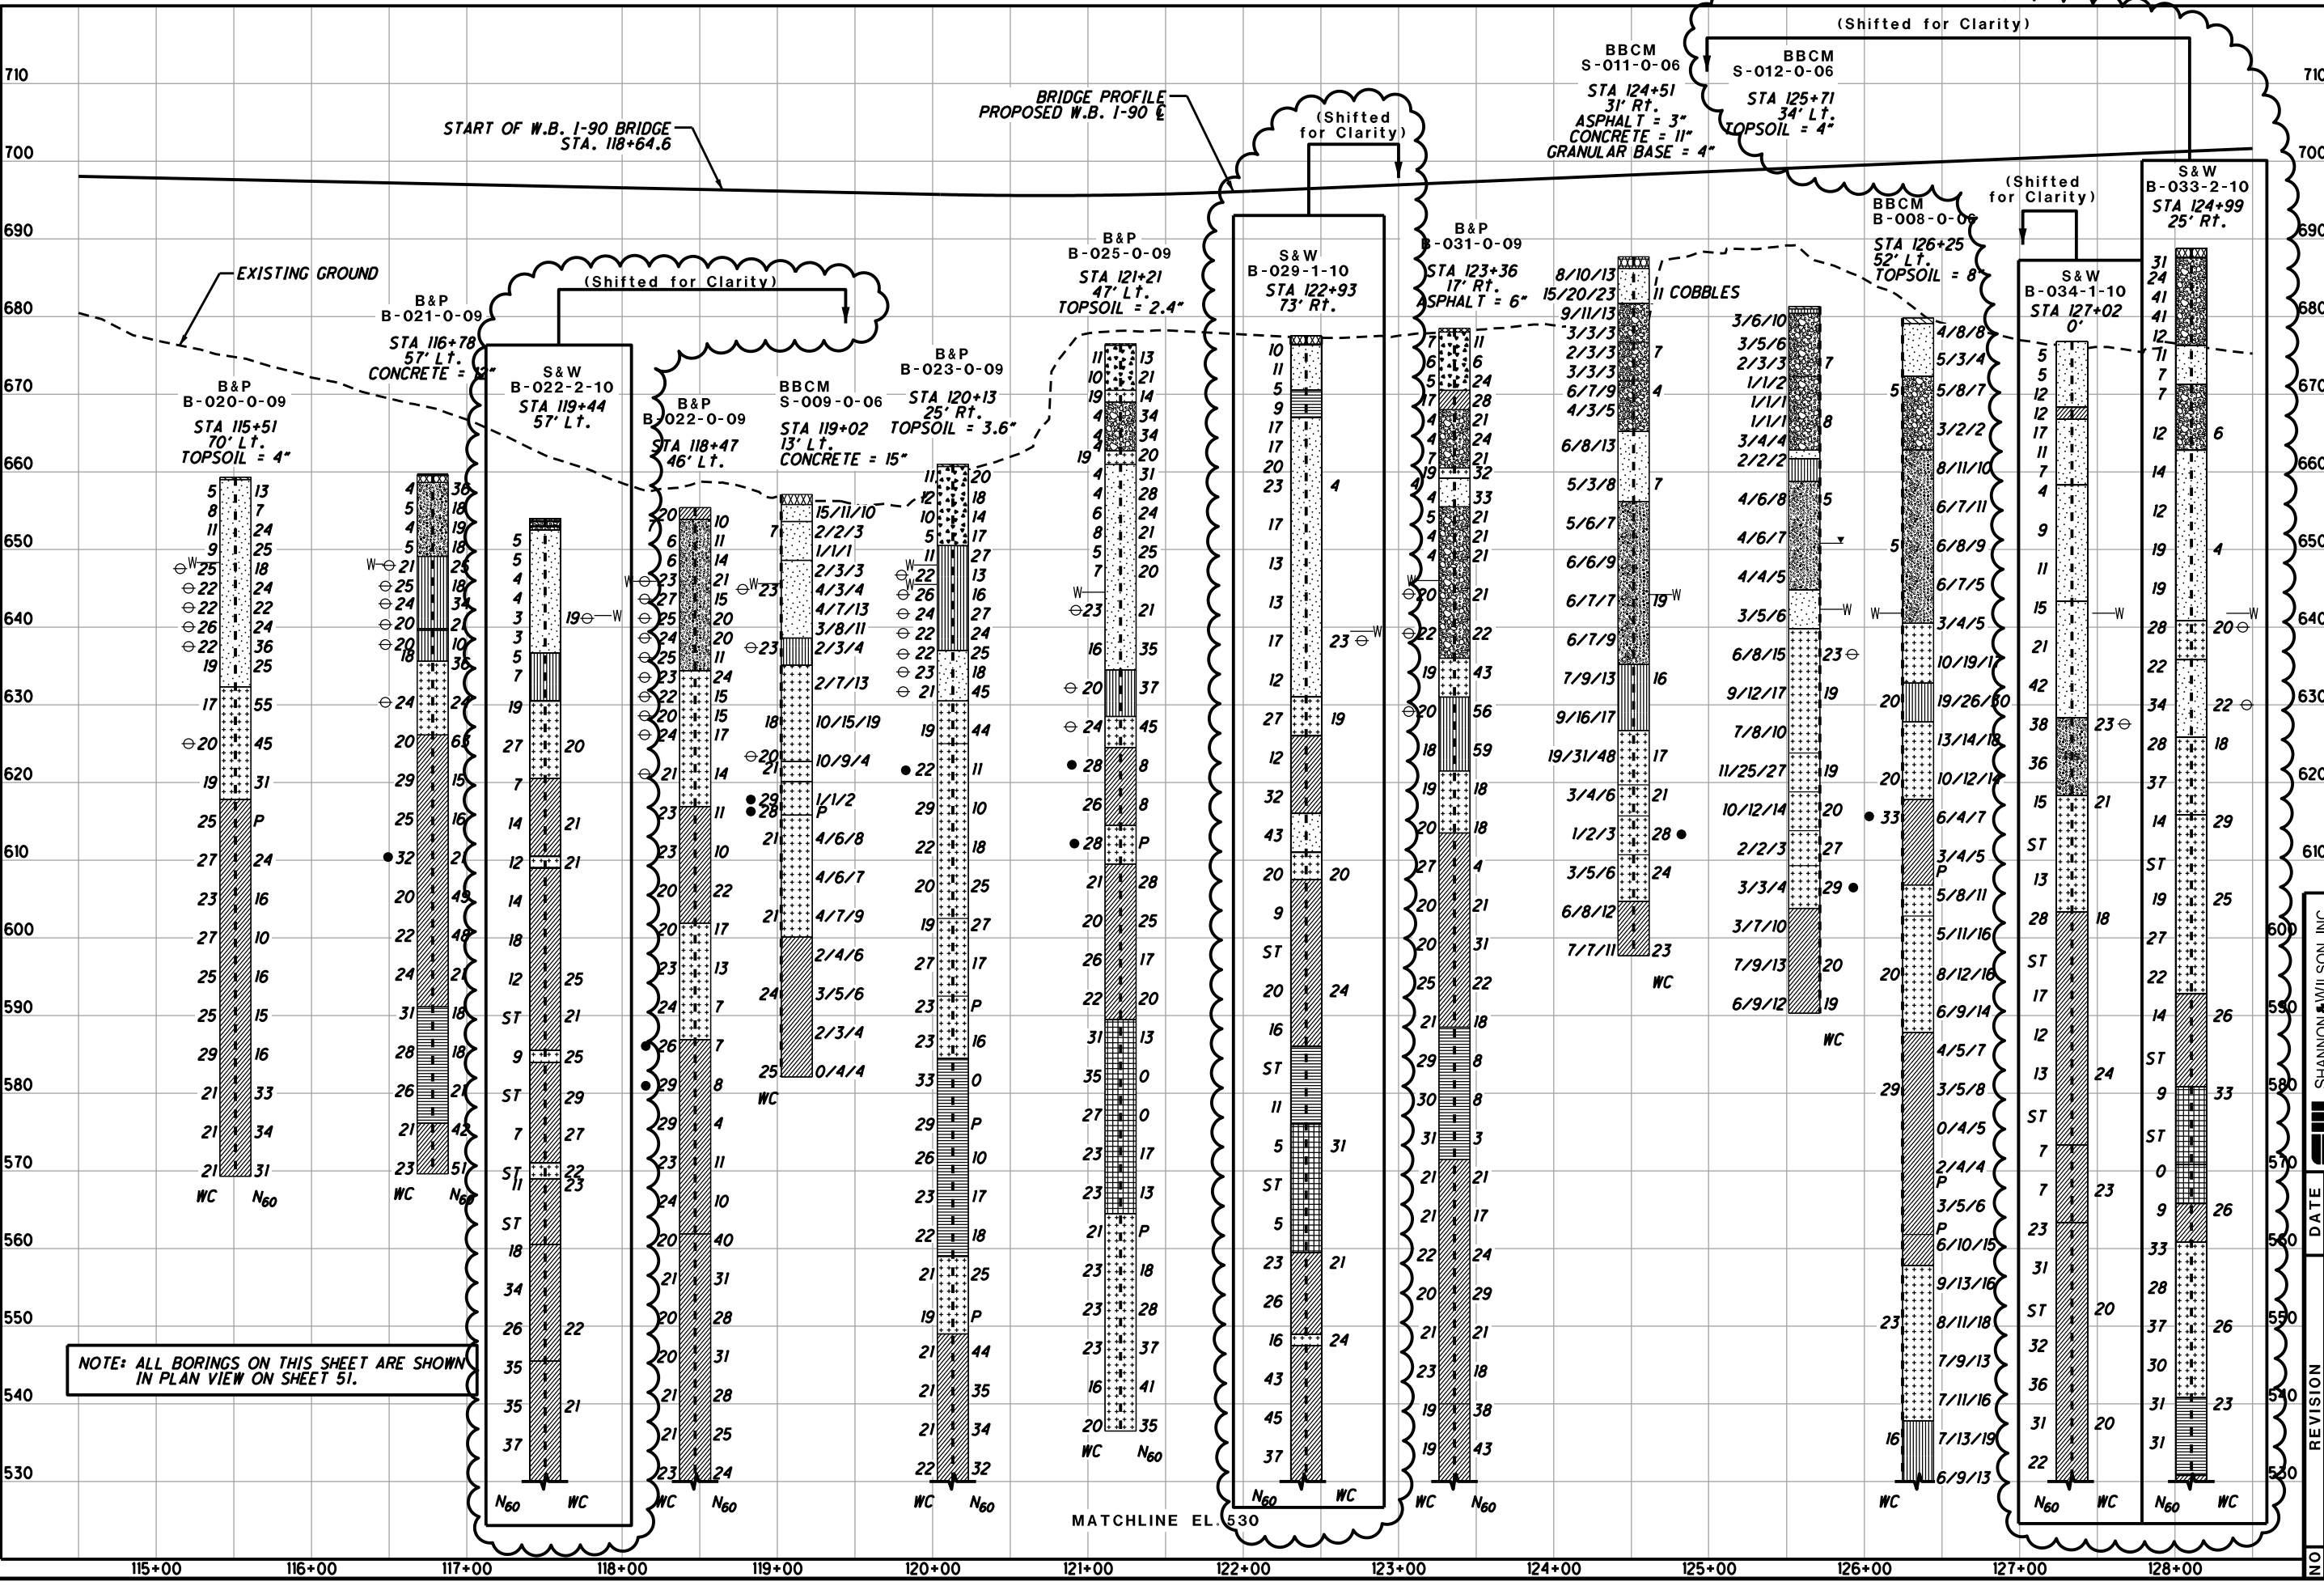

Date: 12/21/12  

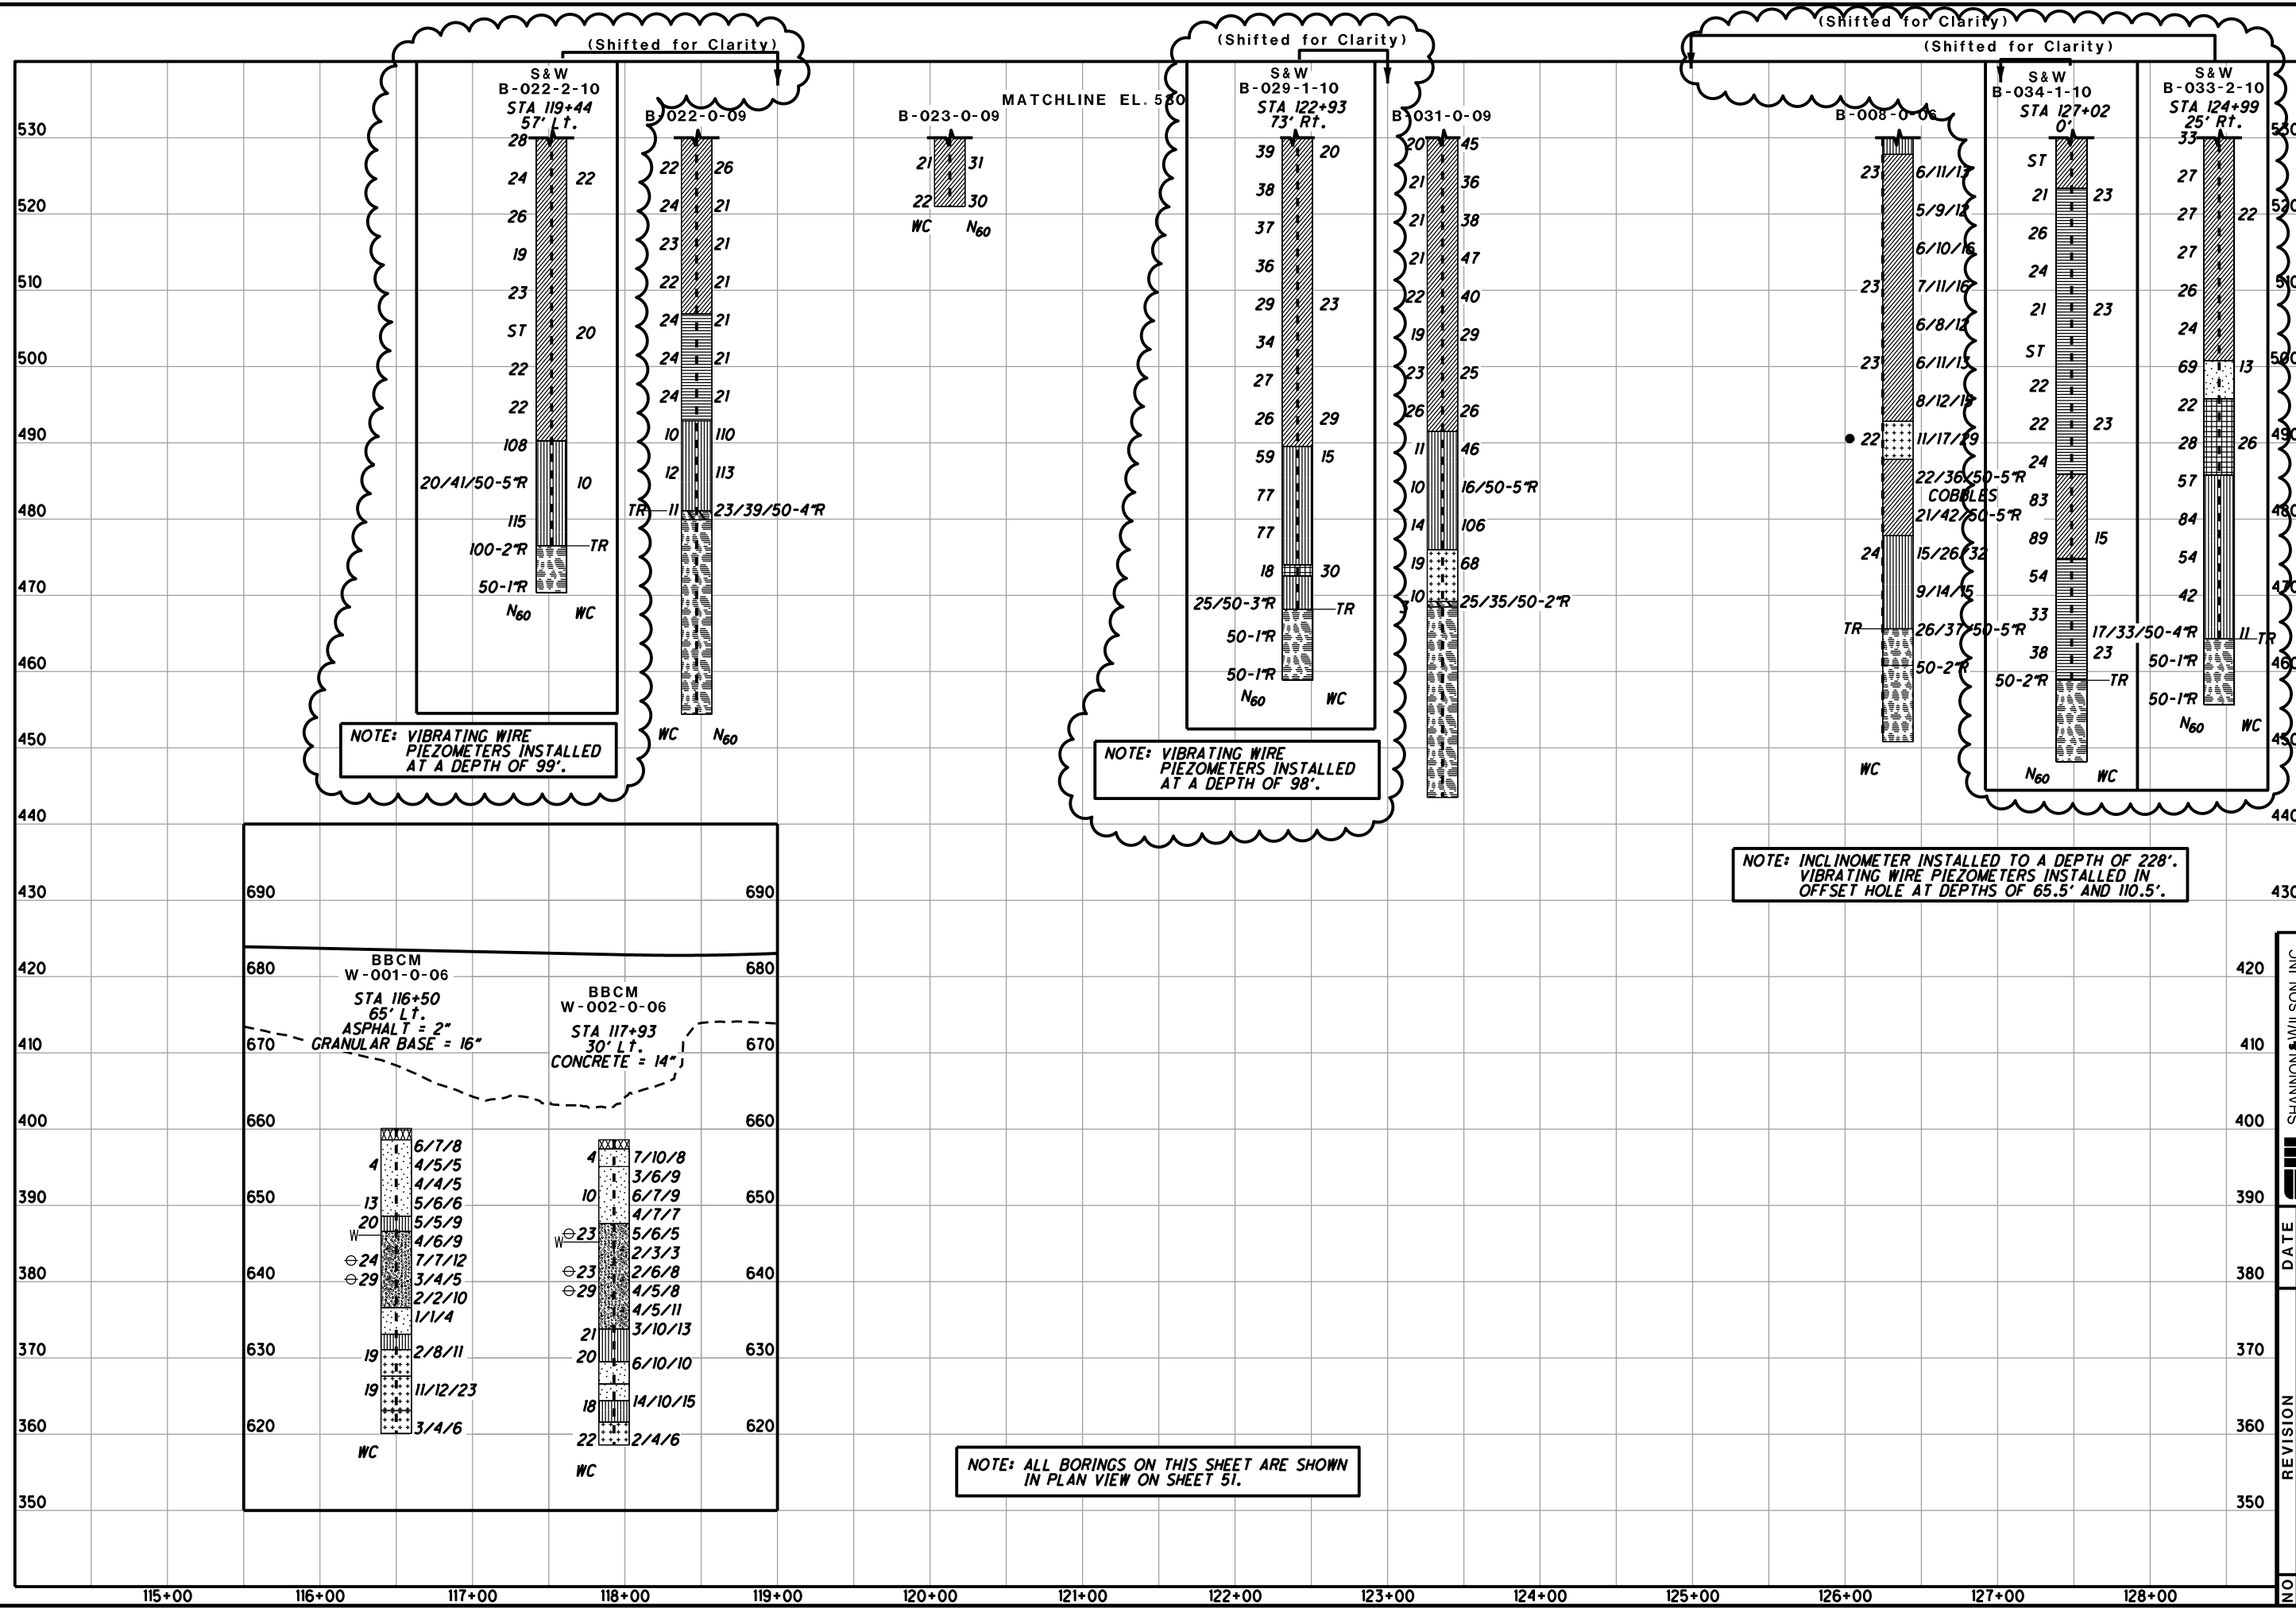

**BBCM**

HORIZONTAL SCALE  
IN FEET

SOIL PROFILE - W.B. I-90  
STA. 114+50 TO STA. 128+50


**SHANNON WILSON, INC.**  
Geotechnical and Environmental Consultants

**SW**

DATE 12-21-2012

REVISION 1 CCGI DESIGN PHASE BORINGS ADDED

NO. 53 / 114

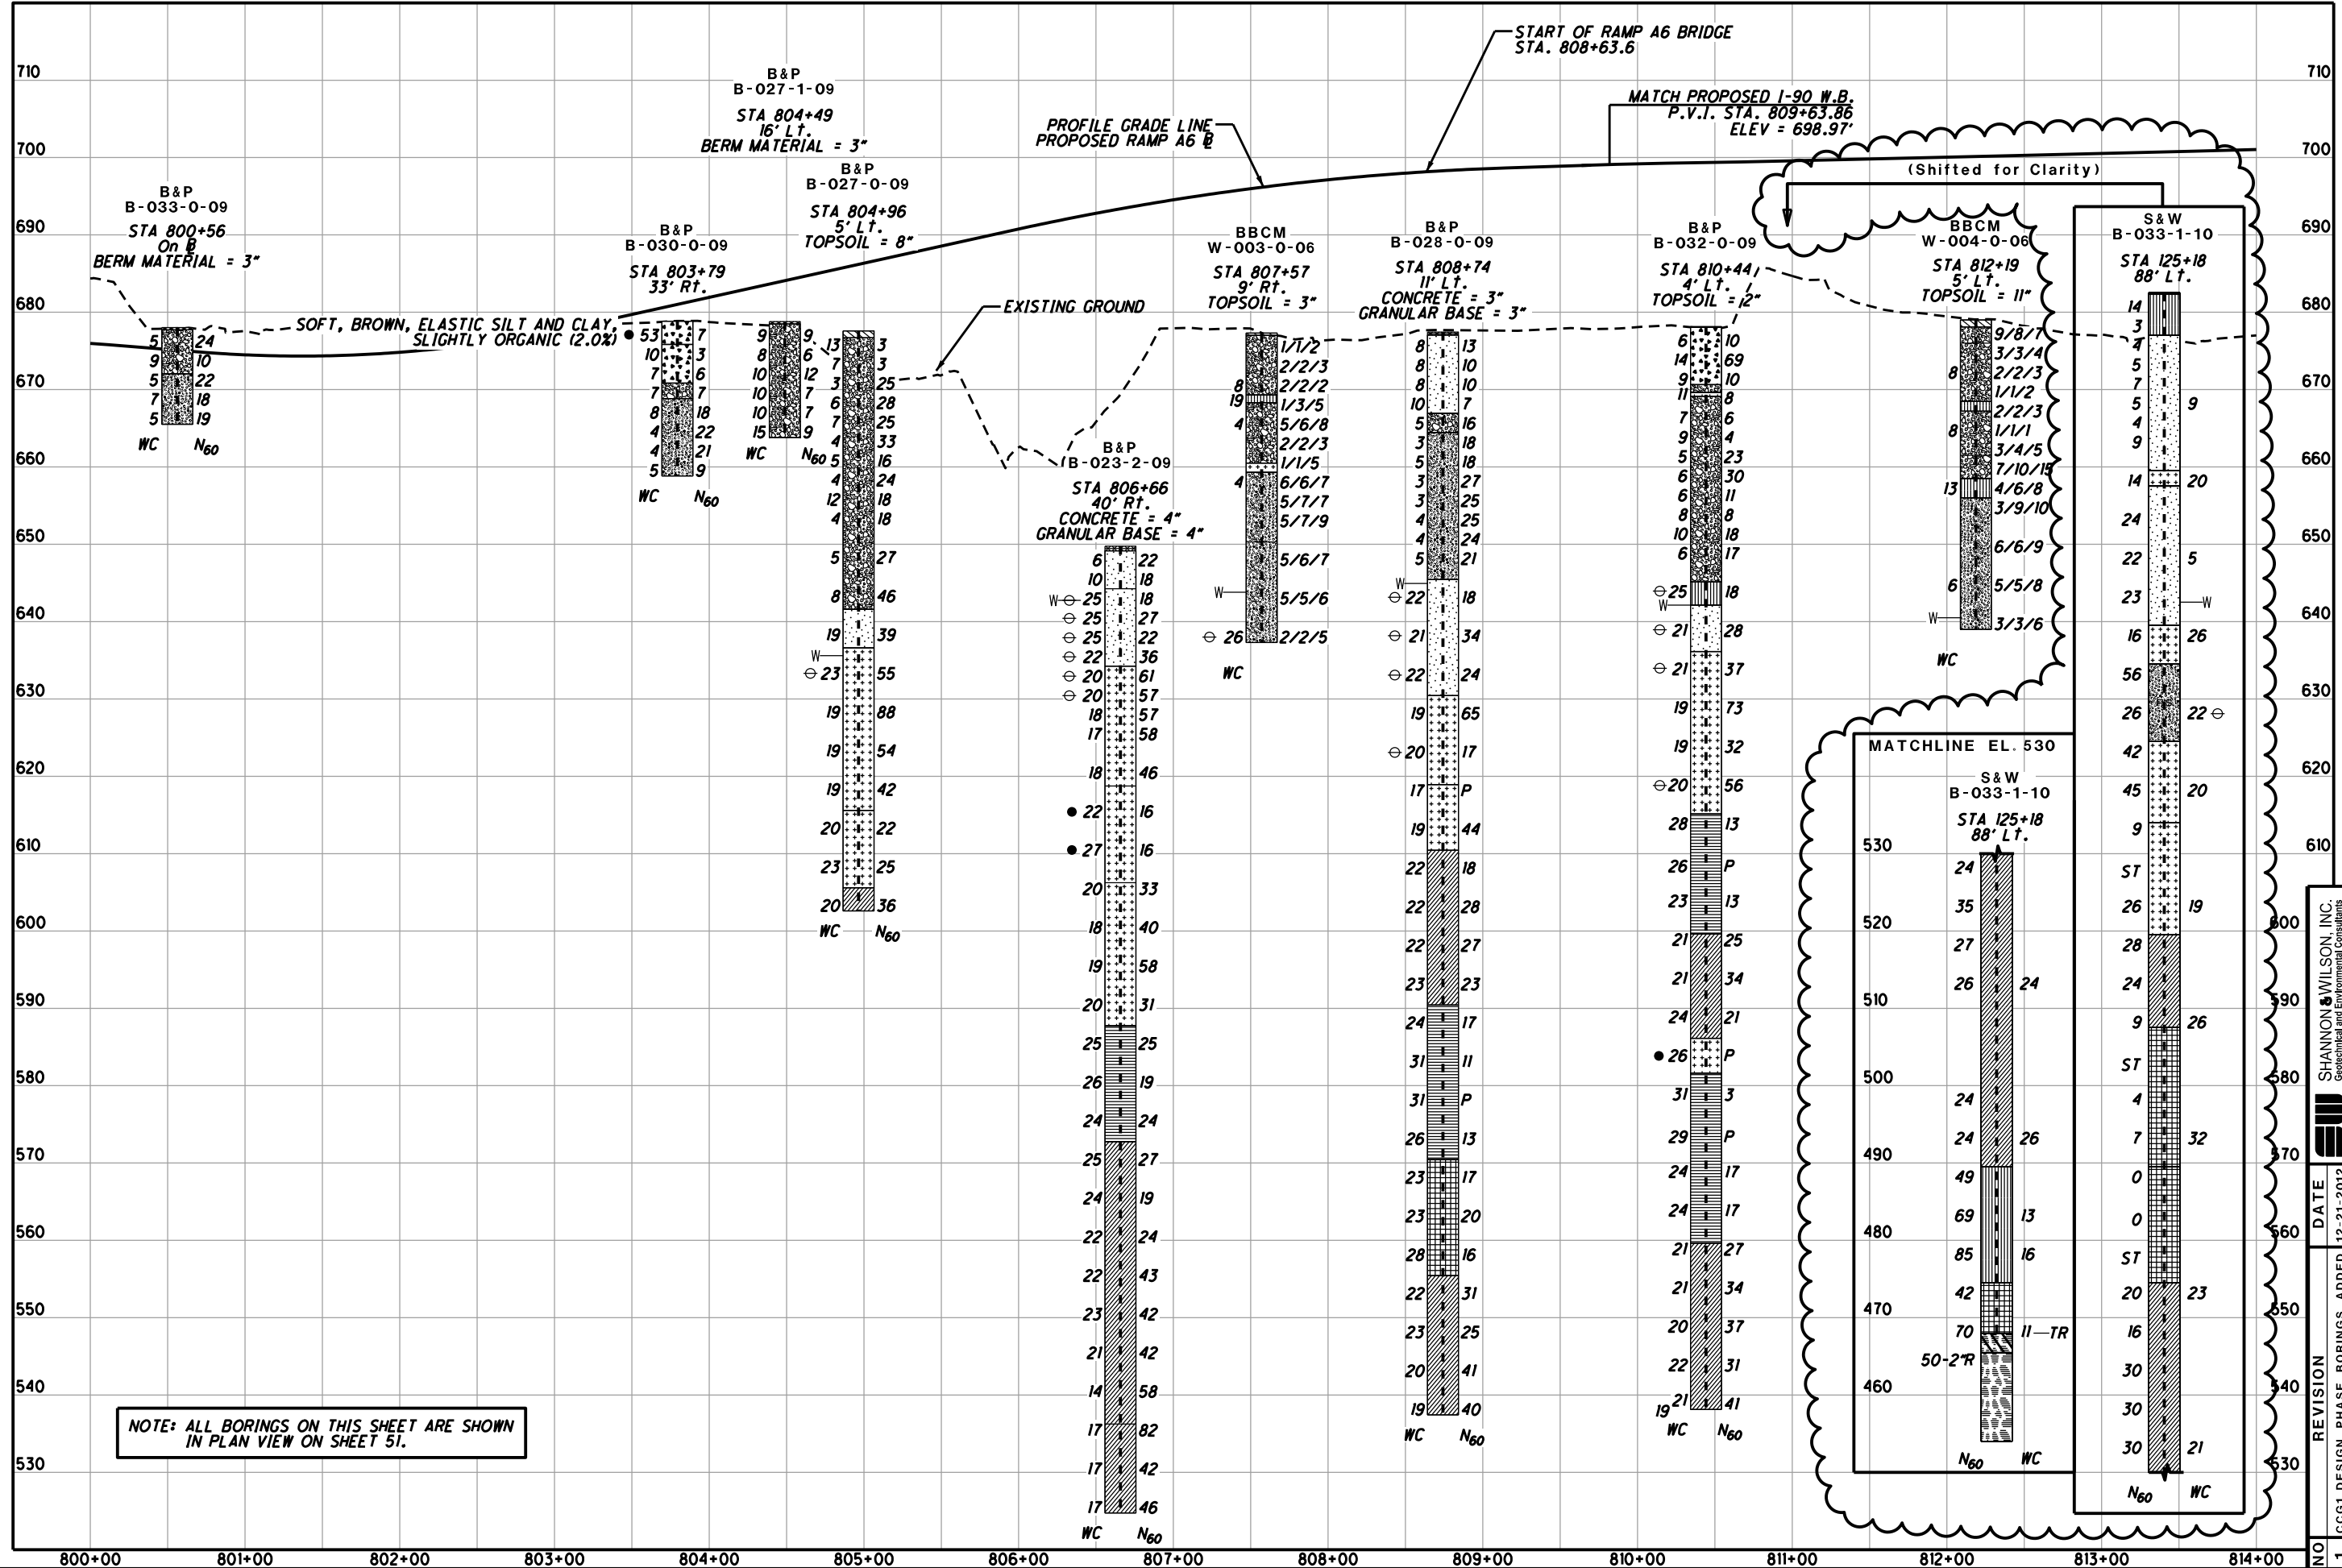

SHANNON & WILSON, INC.  
Geotechnical and Environmental Consultants

DATE: 12-21-2012

REVISION: ADDING PHASE BORINGS


NO. 1



1 - SOIL PROFILE OF BORING NOT INCLUDED ON ANY PROFILES OR CROSS SECTIONS IN THIS SUBMISSION. BORING LOG OR SOIL PROFILE IS AVAILABLE IN THE BORING LOG BINDER SUBMITTED UNDER A SEPARATE COVER.

2 - BORING PERFORMED SOLELY FOR THE PURPOSE OF INCLINOMETER INSTALLATION. NO SAMPLING WAS PERFORMED AND NO BORING LOG WAS CREATED.

BORING PROFILE LOCATION REFERENCE STA. 128+50 TO STA. 142+50					
BORING ID	PROFILE/SECTION (SEE SHEET)	BORING ID	PROFILE/SECTION (SEE SHEET)	BORING ID	PROFILE/SECTION (SEE SHEET)
B-039-1-10	57	B-203-0-96	N/A'	B-002-W-55	106
B-035-0-09	57, 88	B-101-0-94	104	B-003-W-55	N/A'
B-036-0-09	112	B-102-0-94	104	B-001-0-54	N/A'
B-037-0-09	112	B-103-0-94	N/A'	B-002-0-54	N/A'
B-037-1-09	57, 90	B-104-0-94	N/A'	B-003-0-54	N/A'
B-037-2-09	113	B-105-0-94	N/A'	B-004-0-54	N/A'
B-038-0-09	112	B-106-0-94	N/A'	B-005-0-54	N/A'
B-038-1-09	113	B-107-0-94	110	B-006-0-54	N/A'
B-039-0-09	94	B-108-0-94	N/A'	B-007-0-54	N/A'
B-040-0-09	57	B-109-0-94	92, 110	B-008-0-54	N/A'
B-001-0-06	57	B-110-0-94	92	C-001-0-06	N/A'
B-002-0-06	110	B-010-0-92	N/A'	C-002-0-06	N/A'
B-003-0-06	104	B-001-0-90	N/A'	C-003-0-06	N/A'
B-004-0-06	108	B-002-0-90	108	C-004-0-06	N/A'
B-011-0-06	88	B-003-0-90	106	C-011-0-06	N/A'
B-012-0-06	90	B-004-0-90	N/A'	C-012-0-06	N/A'
B-013-0-06	94	B-005-0-90	108	C-013-0-06	N/A'
B-014-0-06	94	B-006-0-90	N/A'	C-014-0-06	N/A'
B-015-0-06	57, 96	B-007-0-90	N/A'	C-015-0-06	N/A'
B-016-0-06	57, 92	B-008-0-90	92, 108	P-001-0-94	N/A'
B-105-A-06	92, 106	B-009-0-90	N/A'	P-002-0-94	106
B-108-A-06	110	B-001-0-55	112	P-003-0-94	N/A'
B-002-0-00	94	B-002-0-55	92, 112	P-004-0-94	N/A'
B-003-0-00	96	B-003-0-55	94	P-005-0-94	N/A'
B-204-0-98	N/A'	B-004-0-55	N/A'	V-002-0-06	96
B-303-0-98	N/A'	B-001-1-55	N/A'	V-003-0-06	N/A'
B-201-0-96	N/A'	B-002-1-55	N/A'	B-038-1-10	57
B-202-0-96	N/A'	B-001-W-55	N/A'	B-039-3-10	57

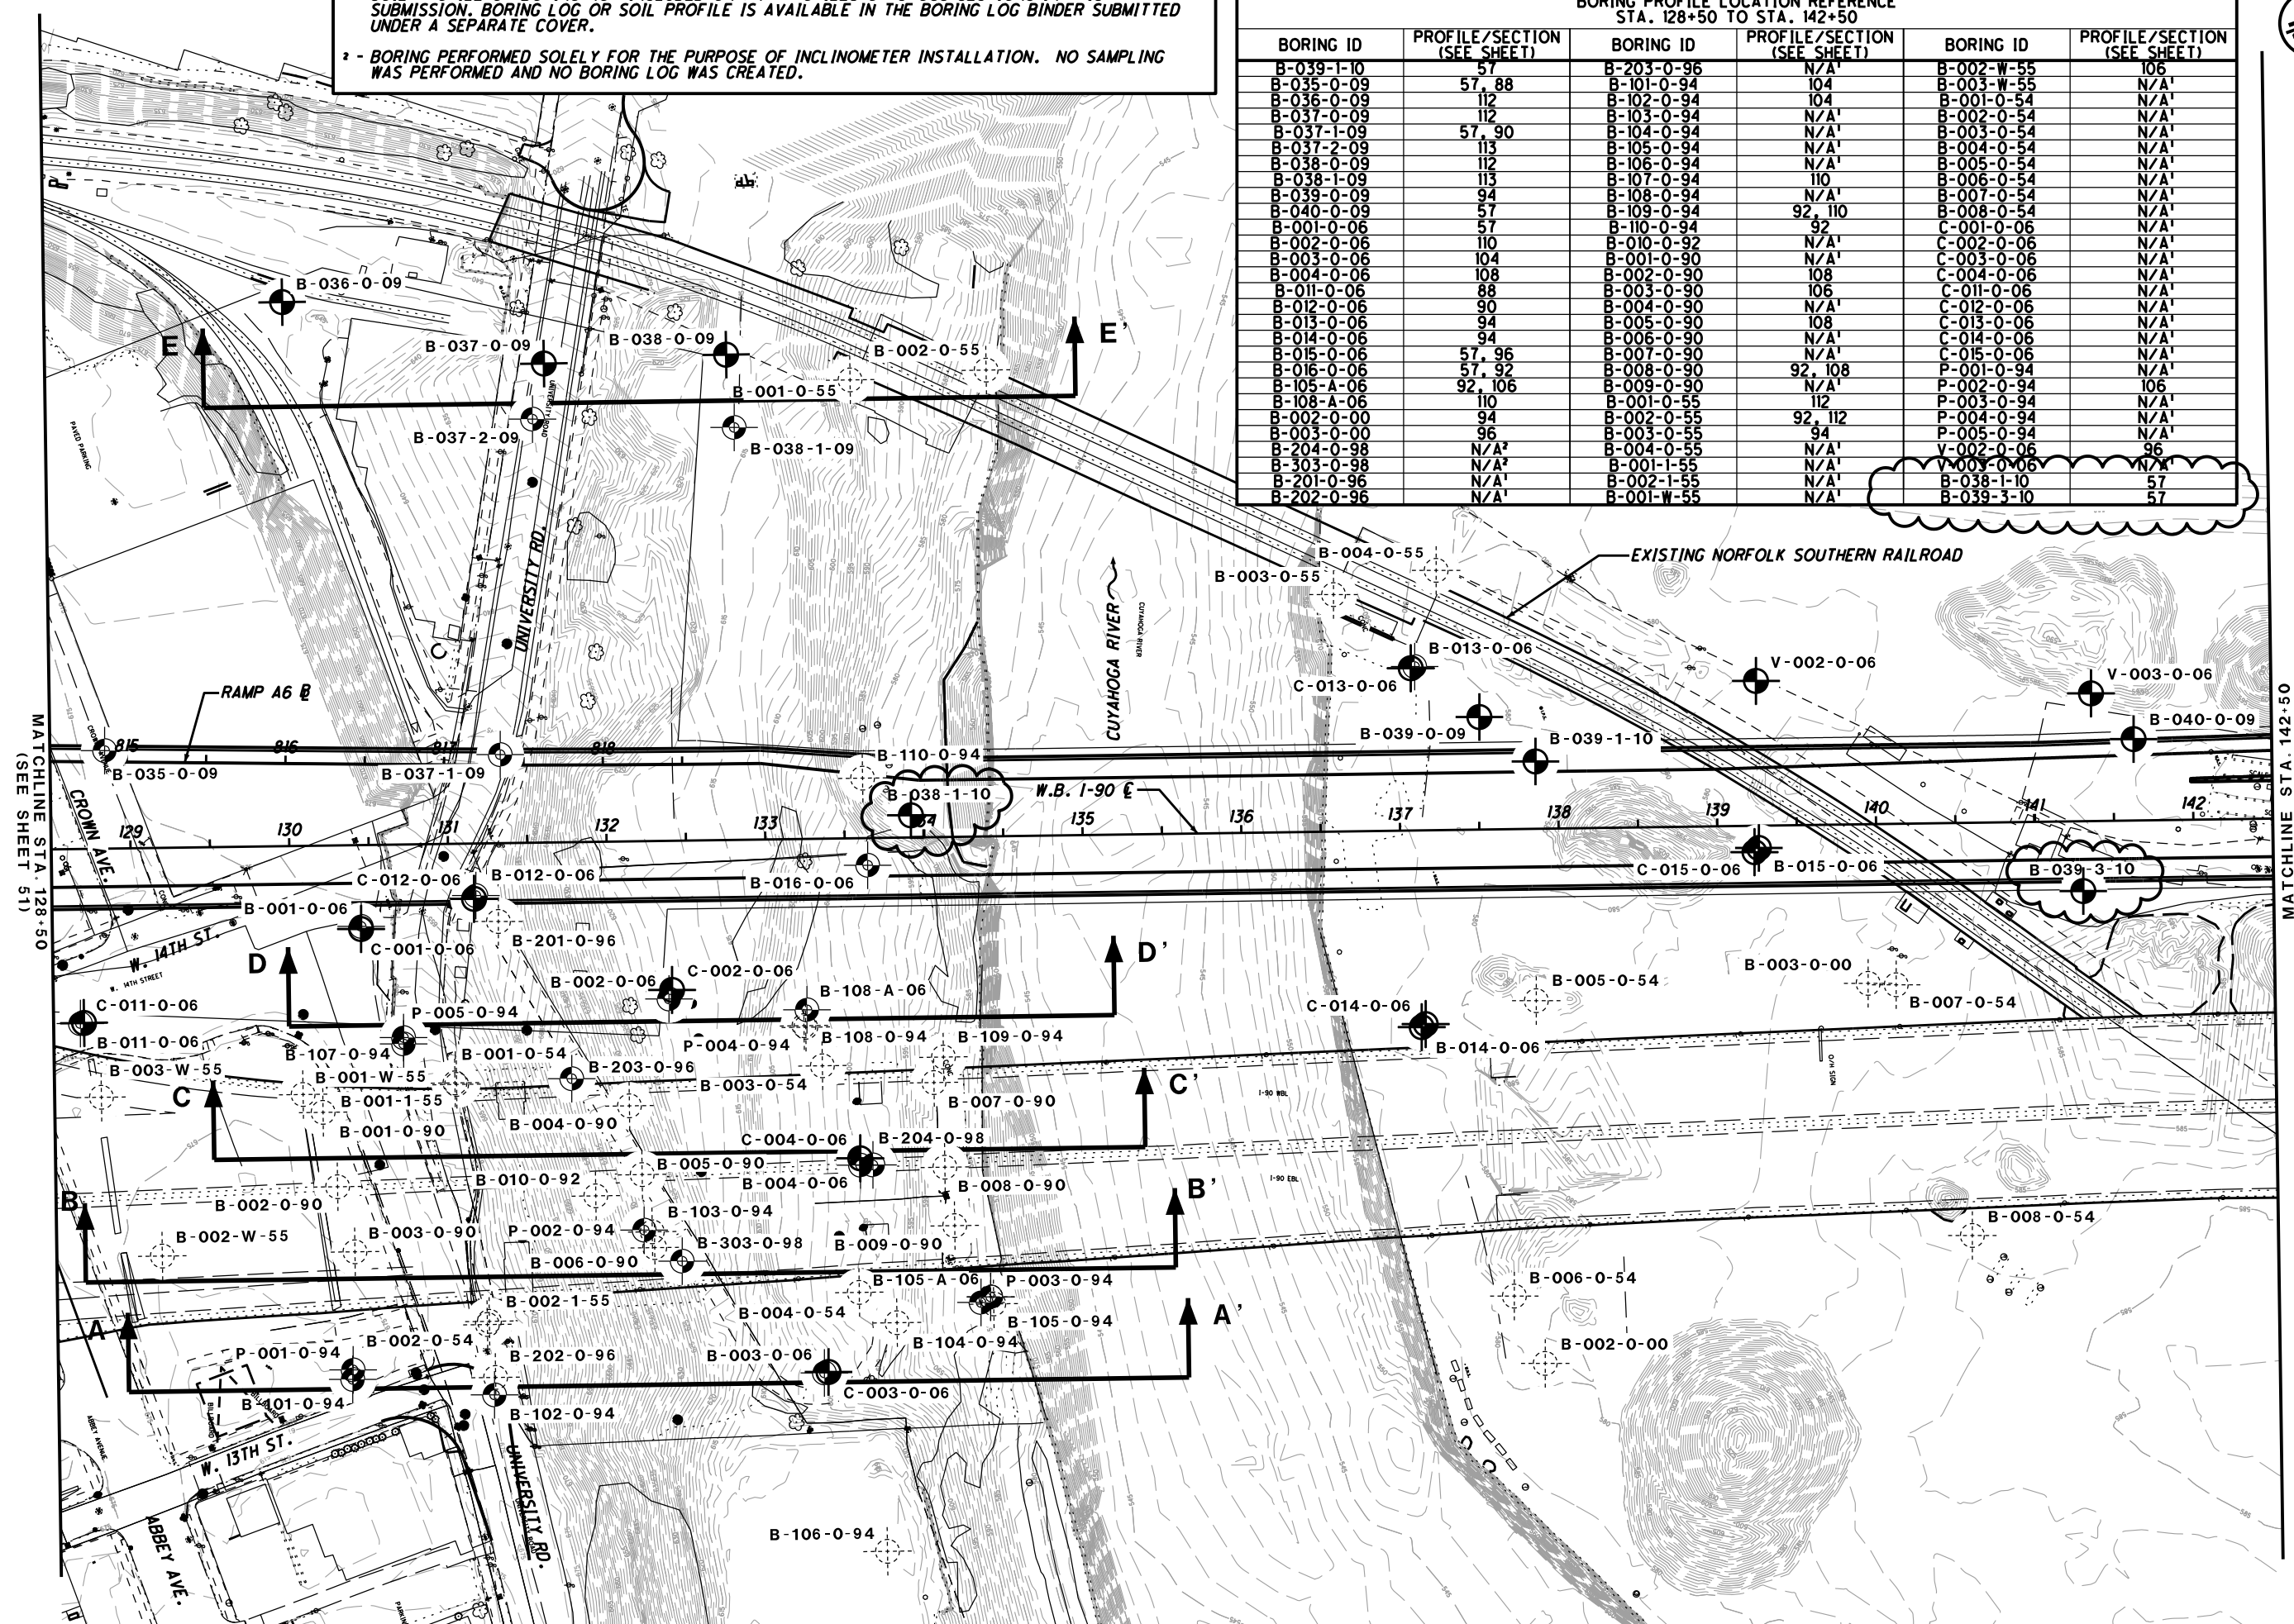

**BBCM**

HORIZONTAL SCALE  
IN FEET

0 50 100

NO. 1

REVISION 1

DATE 12-21-2012

DESCRIPTION CCGT DESIGN PHASE BORINGS ADDED

SHANNON WILSON, INC.  
Geotechnical and Environmental Consultants

SOIL PROFILE - W.B. I-90  
STA. 128+50 TO STA. 142+50

CUY-90-14.52


56 / 114




BRIDGE PROFILE  
PROPOSED W.B. 1-90 E


NOTE: ALL BORINGS ON THIS SHEET ARE SHOWN  
IN PLAN VIEW ON SHEET 56.

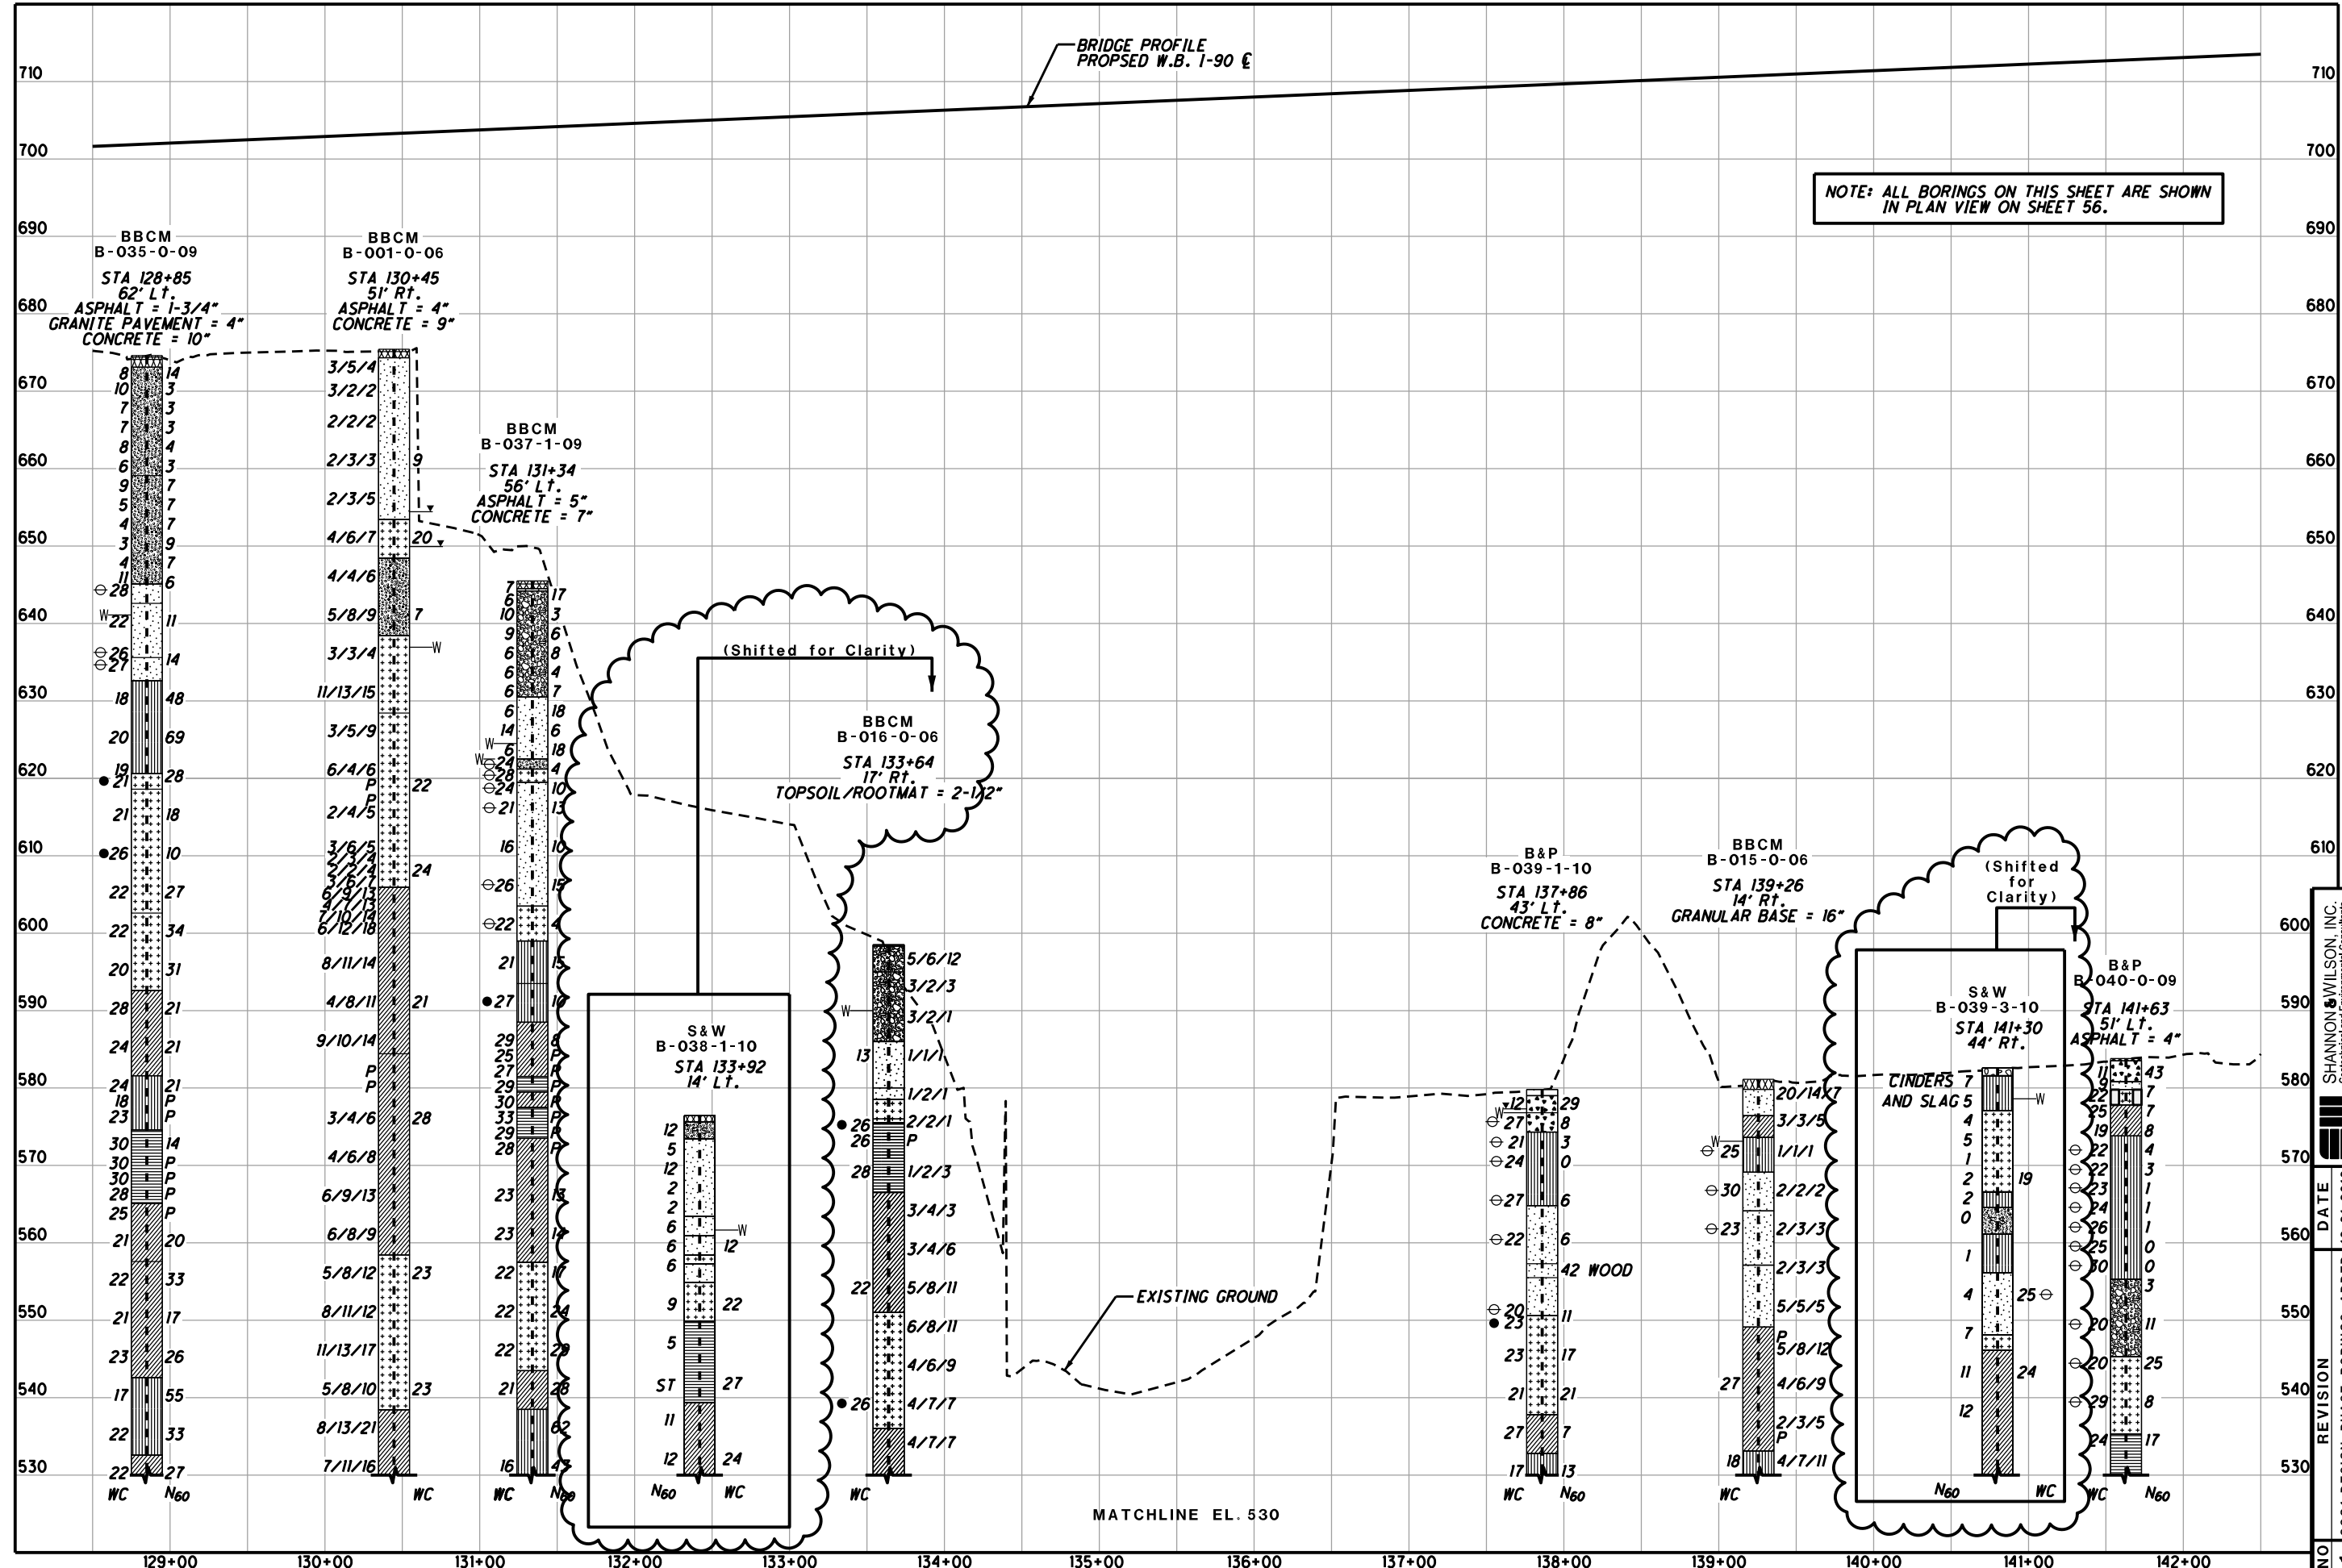

NO.	REVISION	DATE
1	CCGT DESIGN PHASE BORINGS ADDED	12-21-2012



DATE PLOTTED: 12/21/2012  
DRAWN BY: J. WILSON  
CHECKED BY: J. WILSON

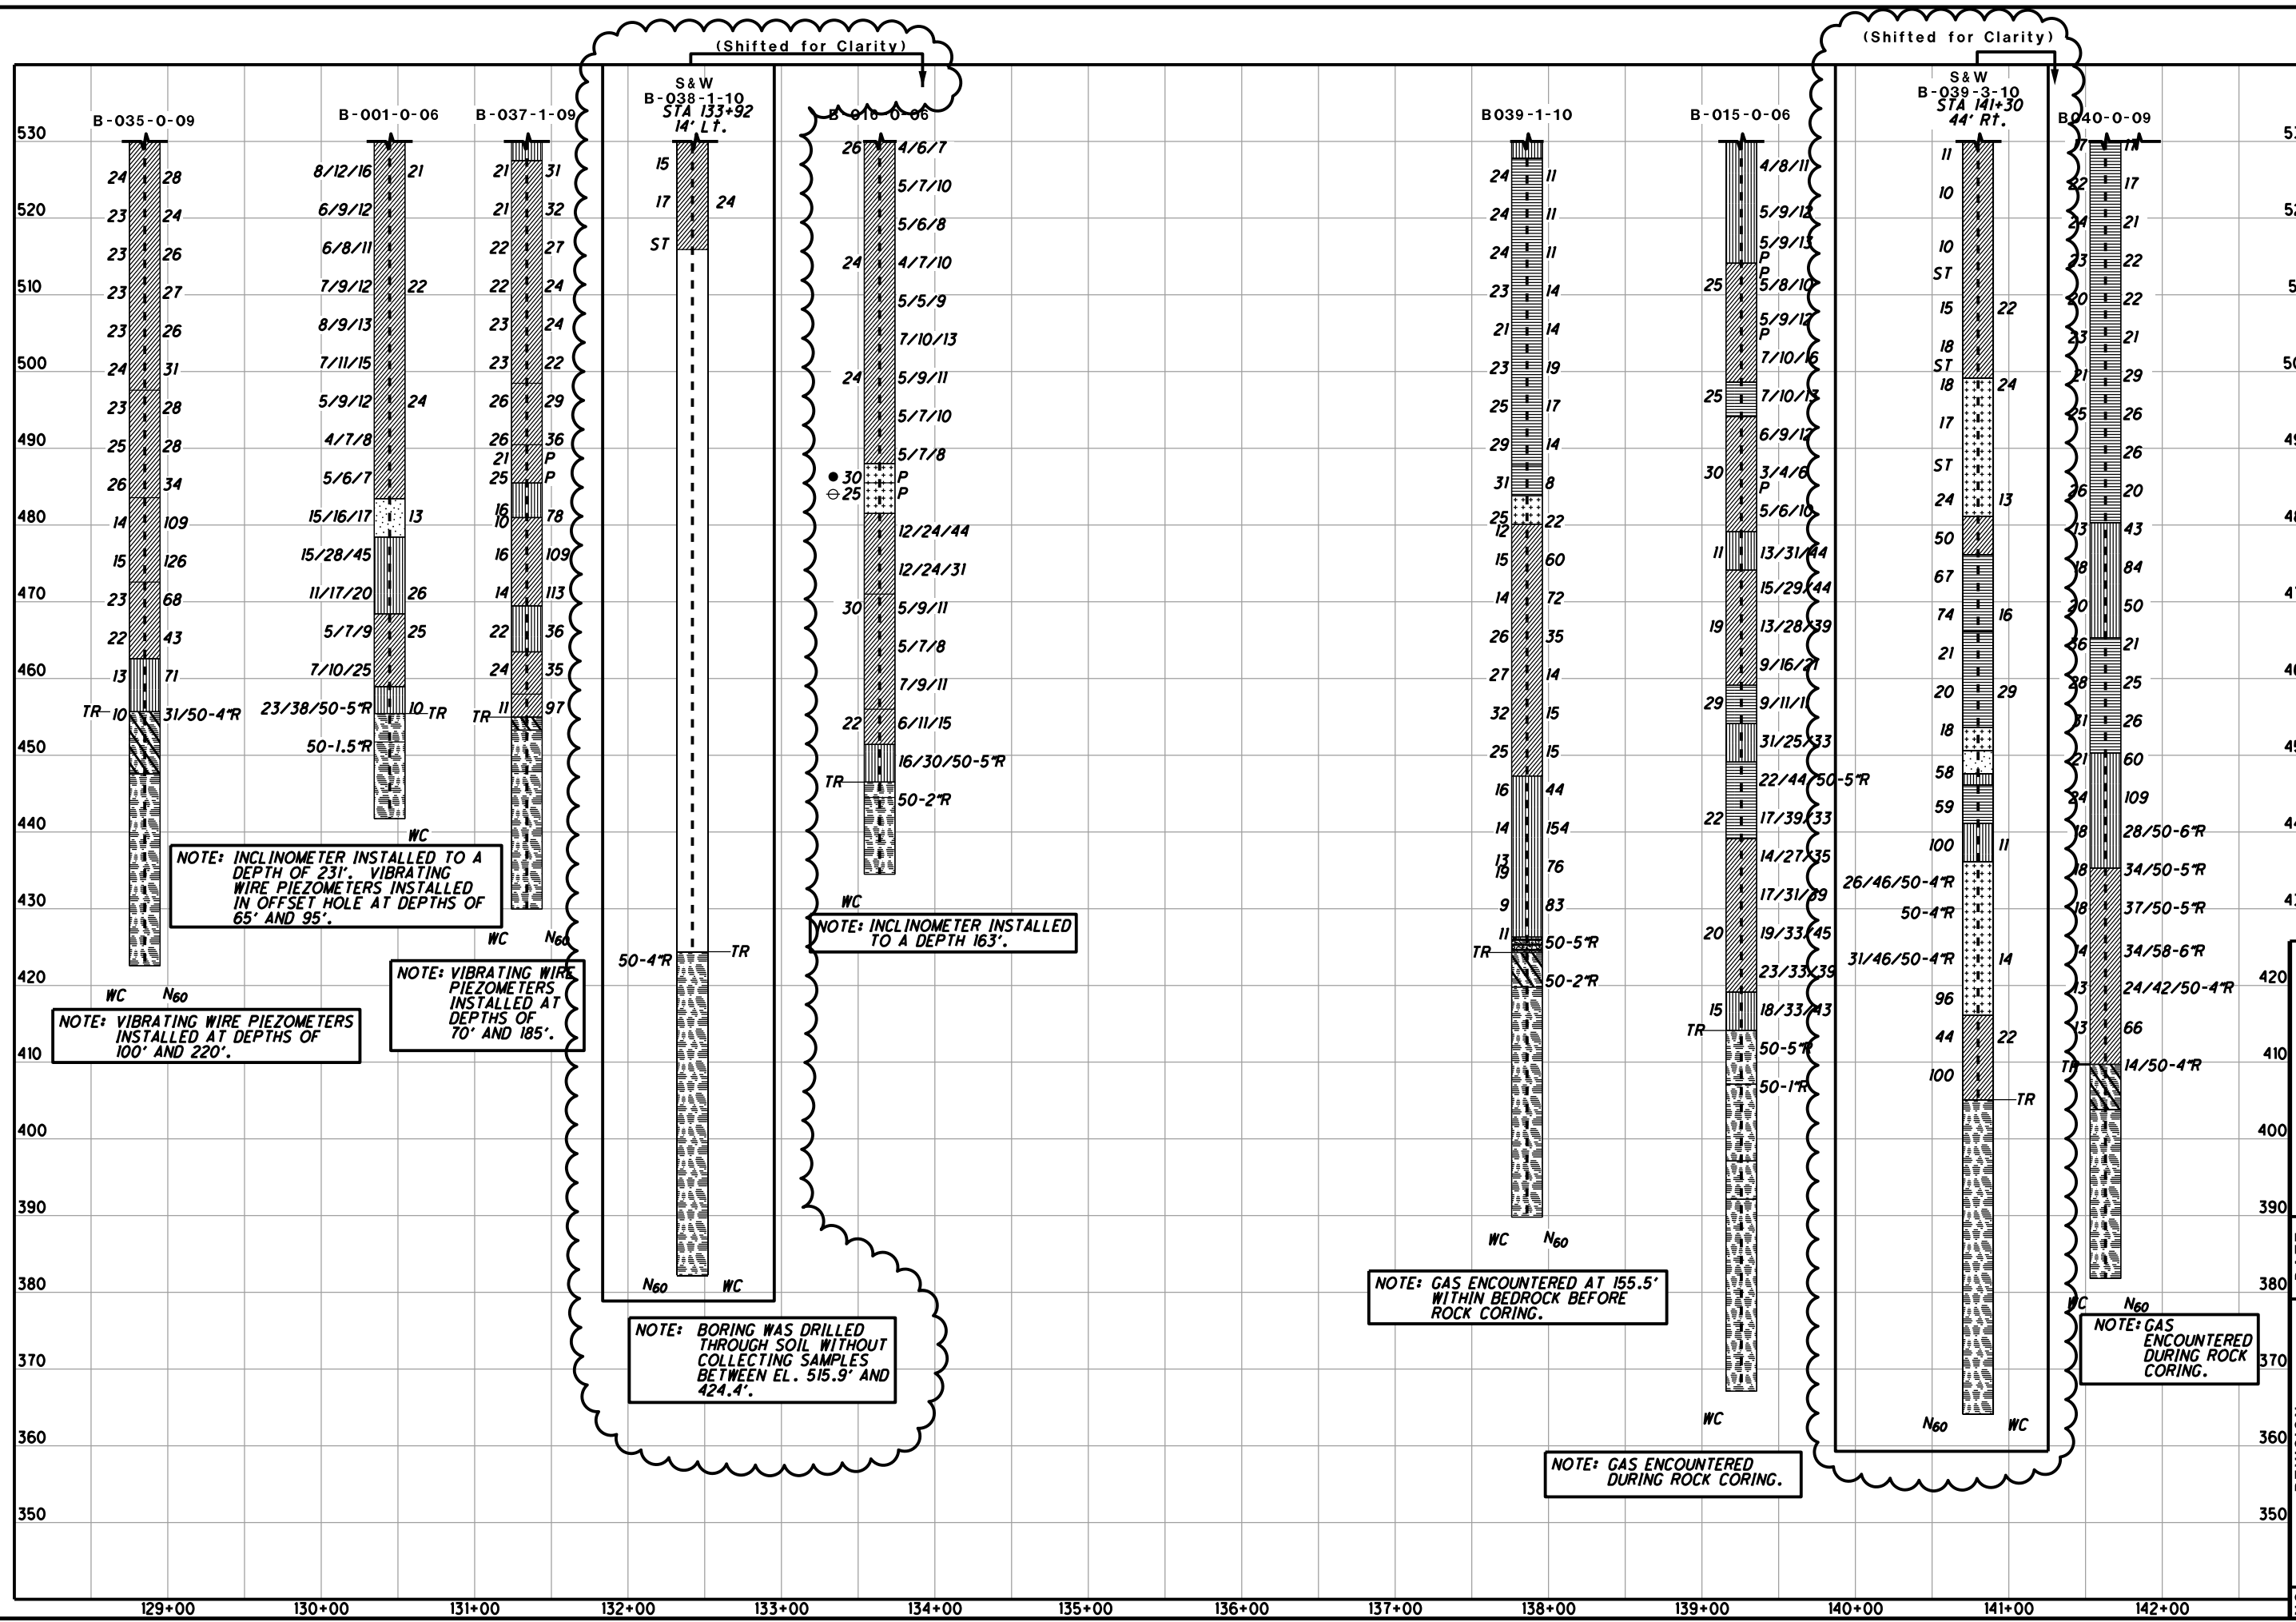


SOIL PROFILE - W.B. I-90  
STA. 128+50 TO STA. 142+50

NO	1	REVISION	DESIGN PHASE BORINGS ADDED	DATE	12-21-2012
----	---	----------	----------------------------	------	------------

NO	REVISION	DATE
1	CCGT DESIGN PHASE BORINGS ADDED	12-21-2012


SHANNON WILSON, INC.  
Geotechnical and Environmental Consultants

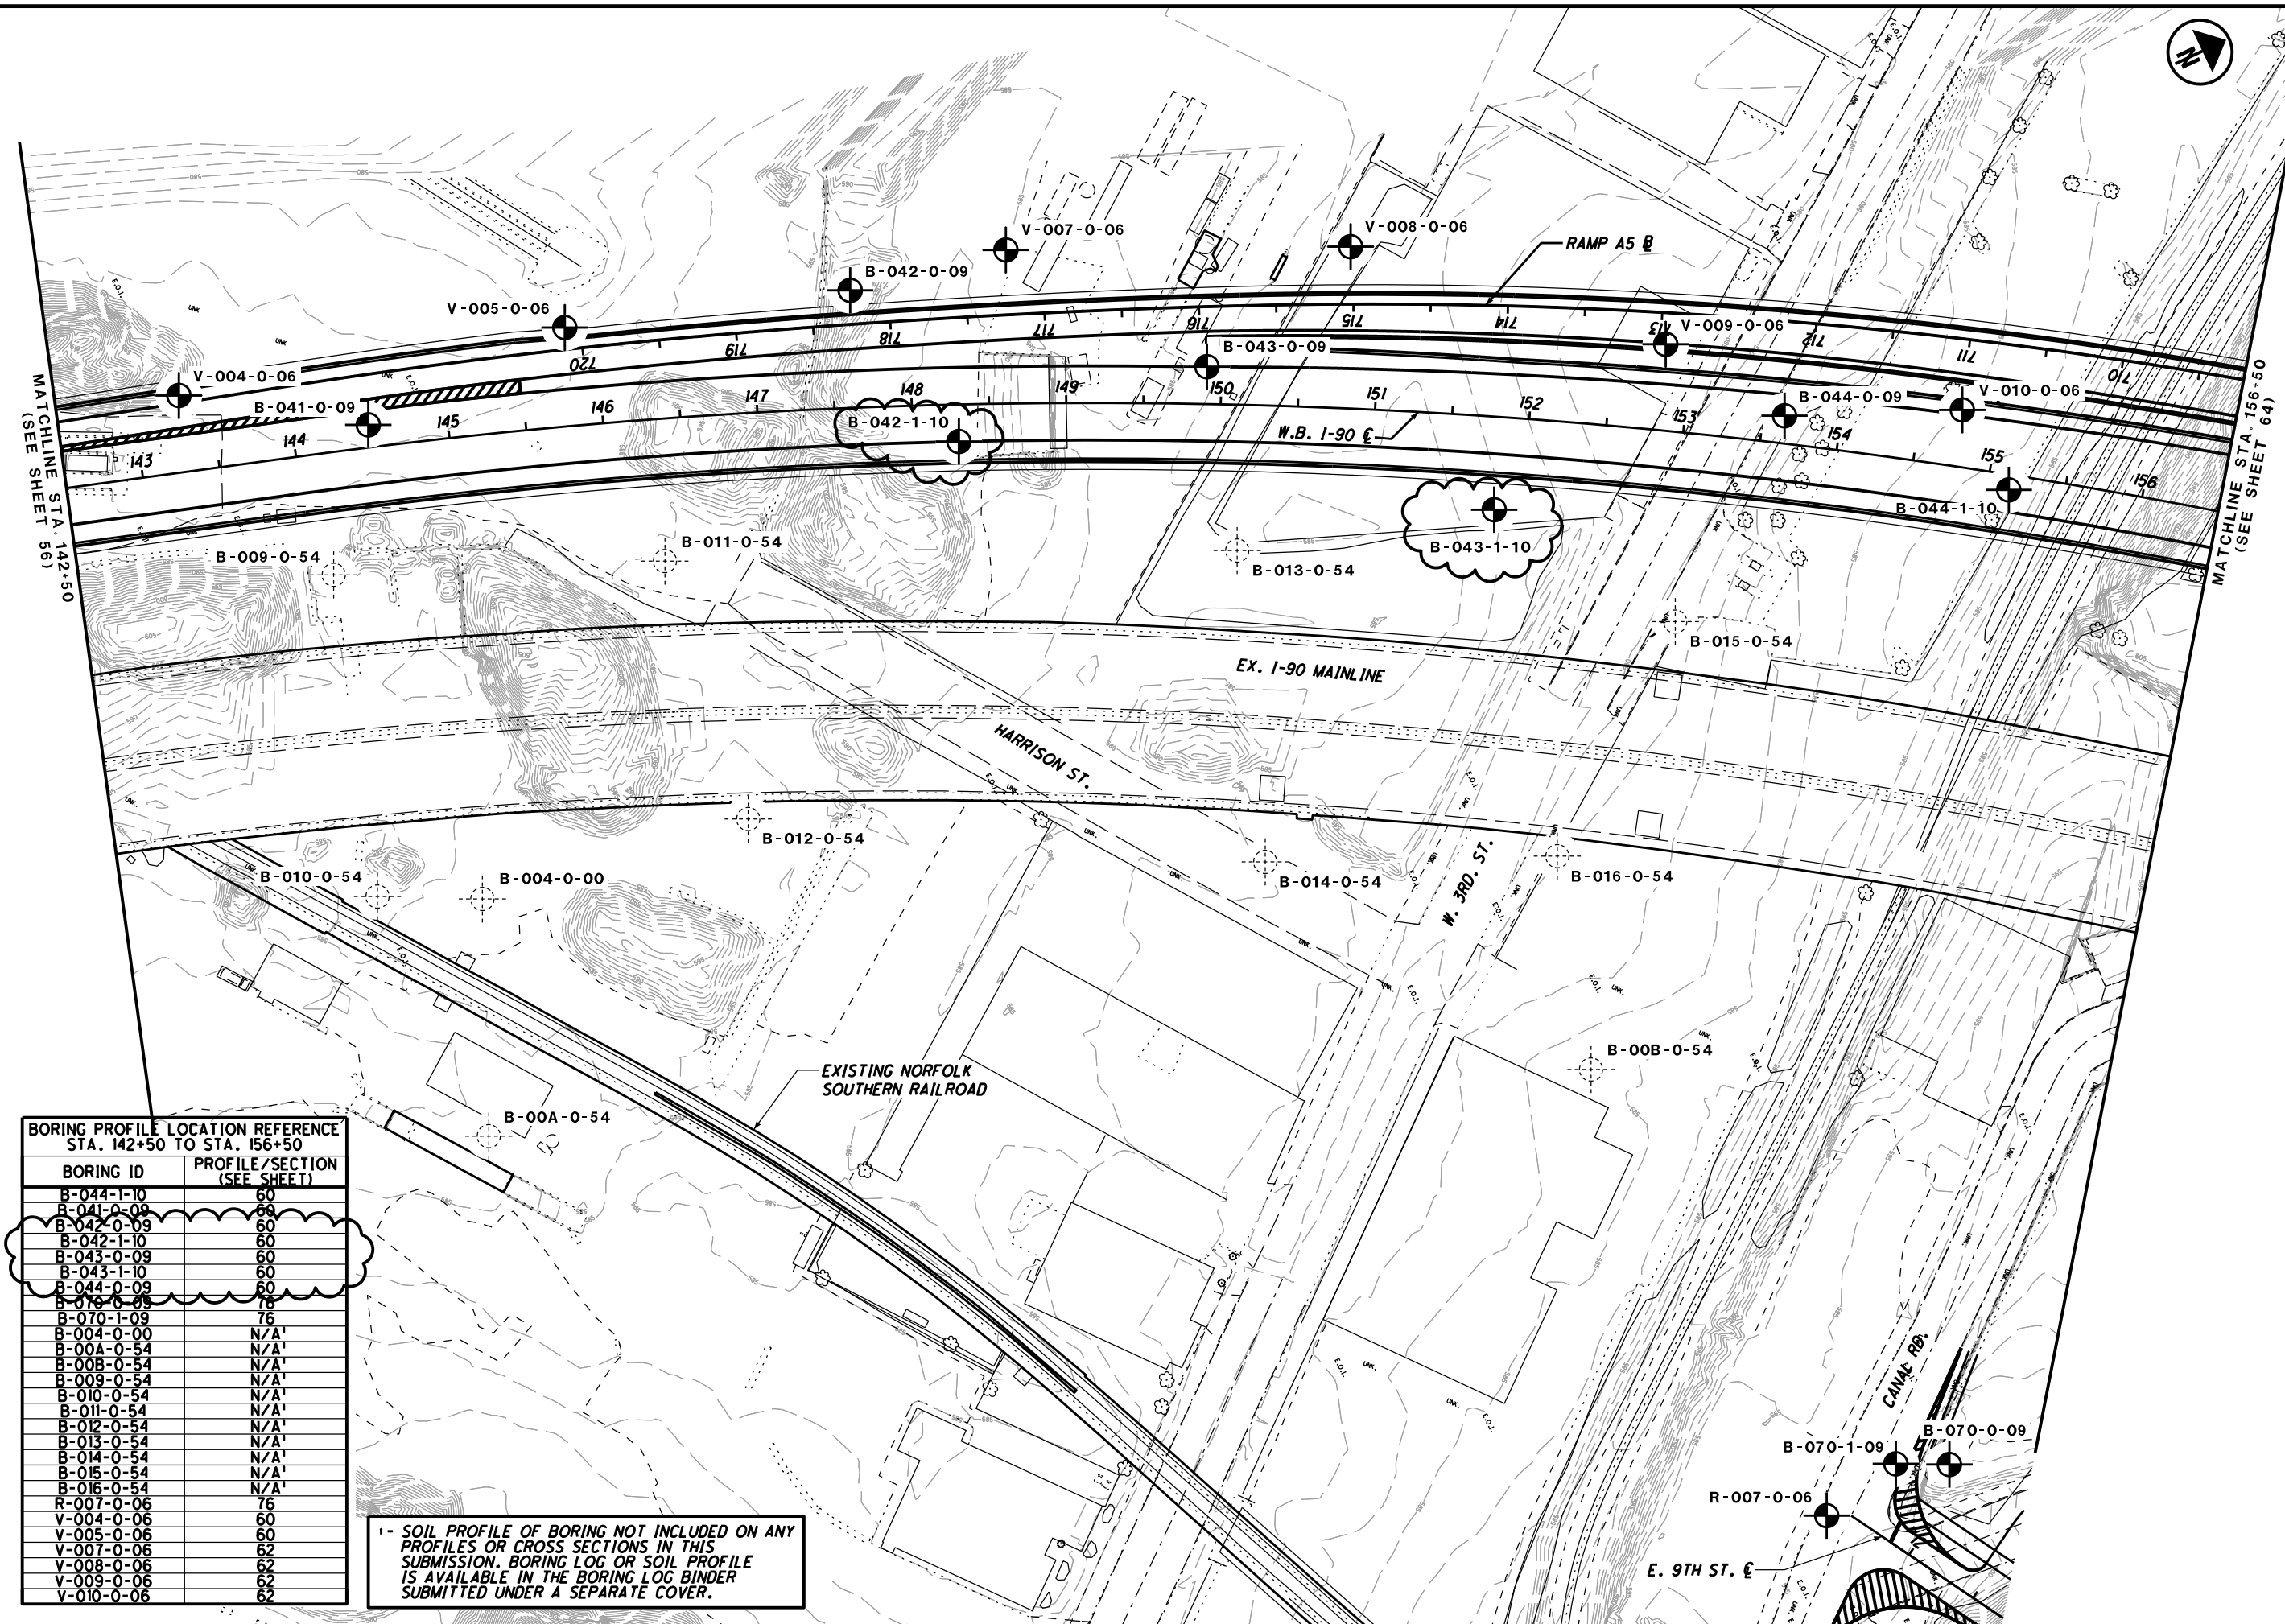

BORING PROFILE LOCATION REFERENCE STA. 142+50 TO STA. 156+50	
BORING ID	PROFILE/SECTION (SEE SHEET)
B-044-1-10	60
B-041-0-09	60
B-042-0-09	60
B-042-1-10	60
B-043-0-09	60
B-043-1-10	60
B-044-0-09	60
B-016-0-09	76
B-070-1-09	76
B-004-0-00	N/A
B-00A-0-54	N/A
B-00B-0-54	N/A
B-009-0-54	N/A
B-010-0-54	N/A
B-011-0-54	N/A
B-012-0-54	N/A
B-013-0-54	N/A
B-014-0-54	N/A
B-015-0-54	N/A
B-016-0-54	N/A
R-007-0-06	76
V-004-0-06	60
V-005-0-06	60
V-007-0-06	62
V-008-0-06	62
V-009-0-06	62
V-010-0-06	62

1 - SOIL PROFILE OF BORING NOT INCLUDED ON ANY PROFILES OR CROSS SECTIONS IN THIS SUBMISSION. BORING LOG OR SOIL PROFILE IS AVAILABLE IN THE BORING LOG BINDER SUBMITTED UNDER A SEPARATE COVER.


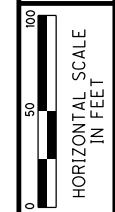

SOIL PROFILE - W.B. I-90  
STA. 142+50 TO STA. 156+50

SHANNON & WILSON, INC.  
Geotechnical and Environmental Consultants




DATE 12-21-2012  
REVISION NO. 1 CCGT DESIGN PHASE BORINGS ADDED


60/114

NOTE: ALL BORINGS ON THIS SHEET ARE SHOWN IN PLAN VIEW ON SHEET 59.

BRIDGE PROFILE PROPOSED W.B. I-90 €

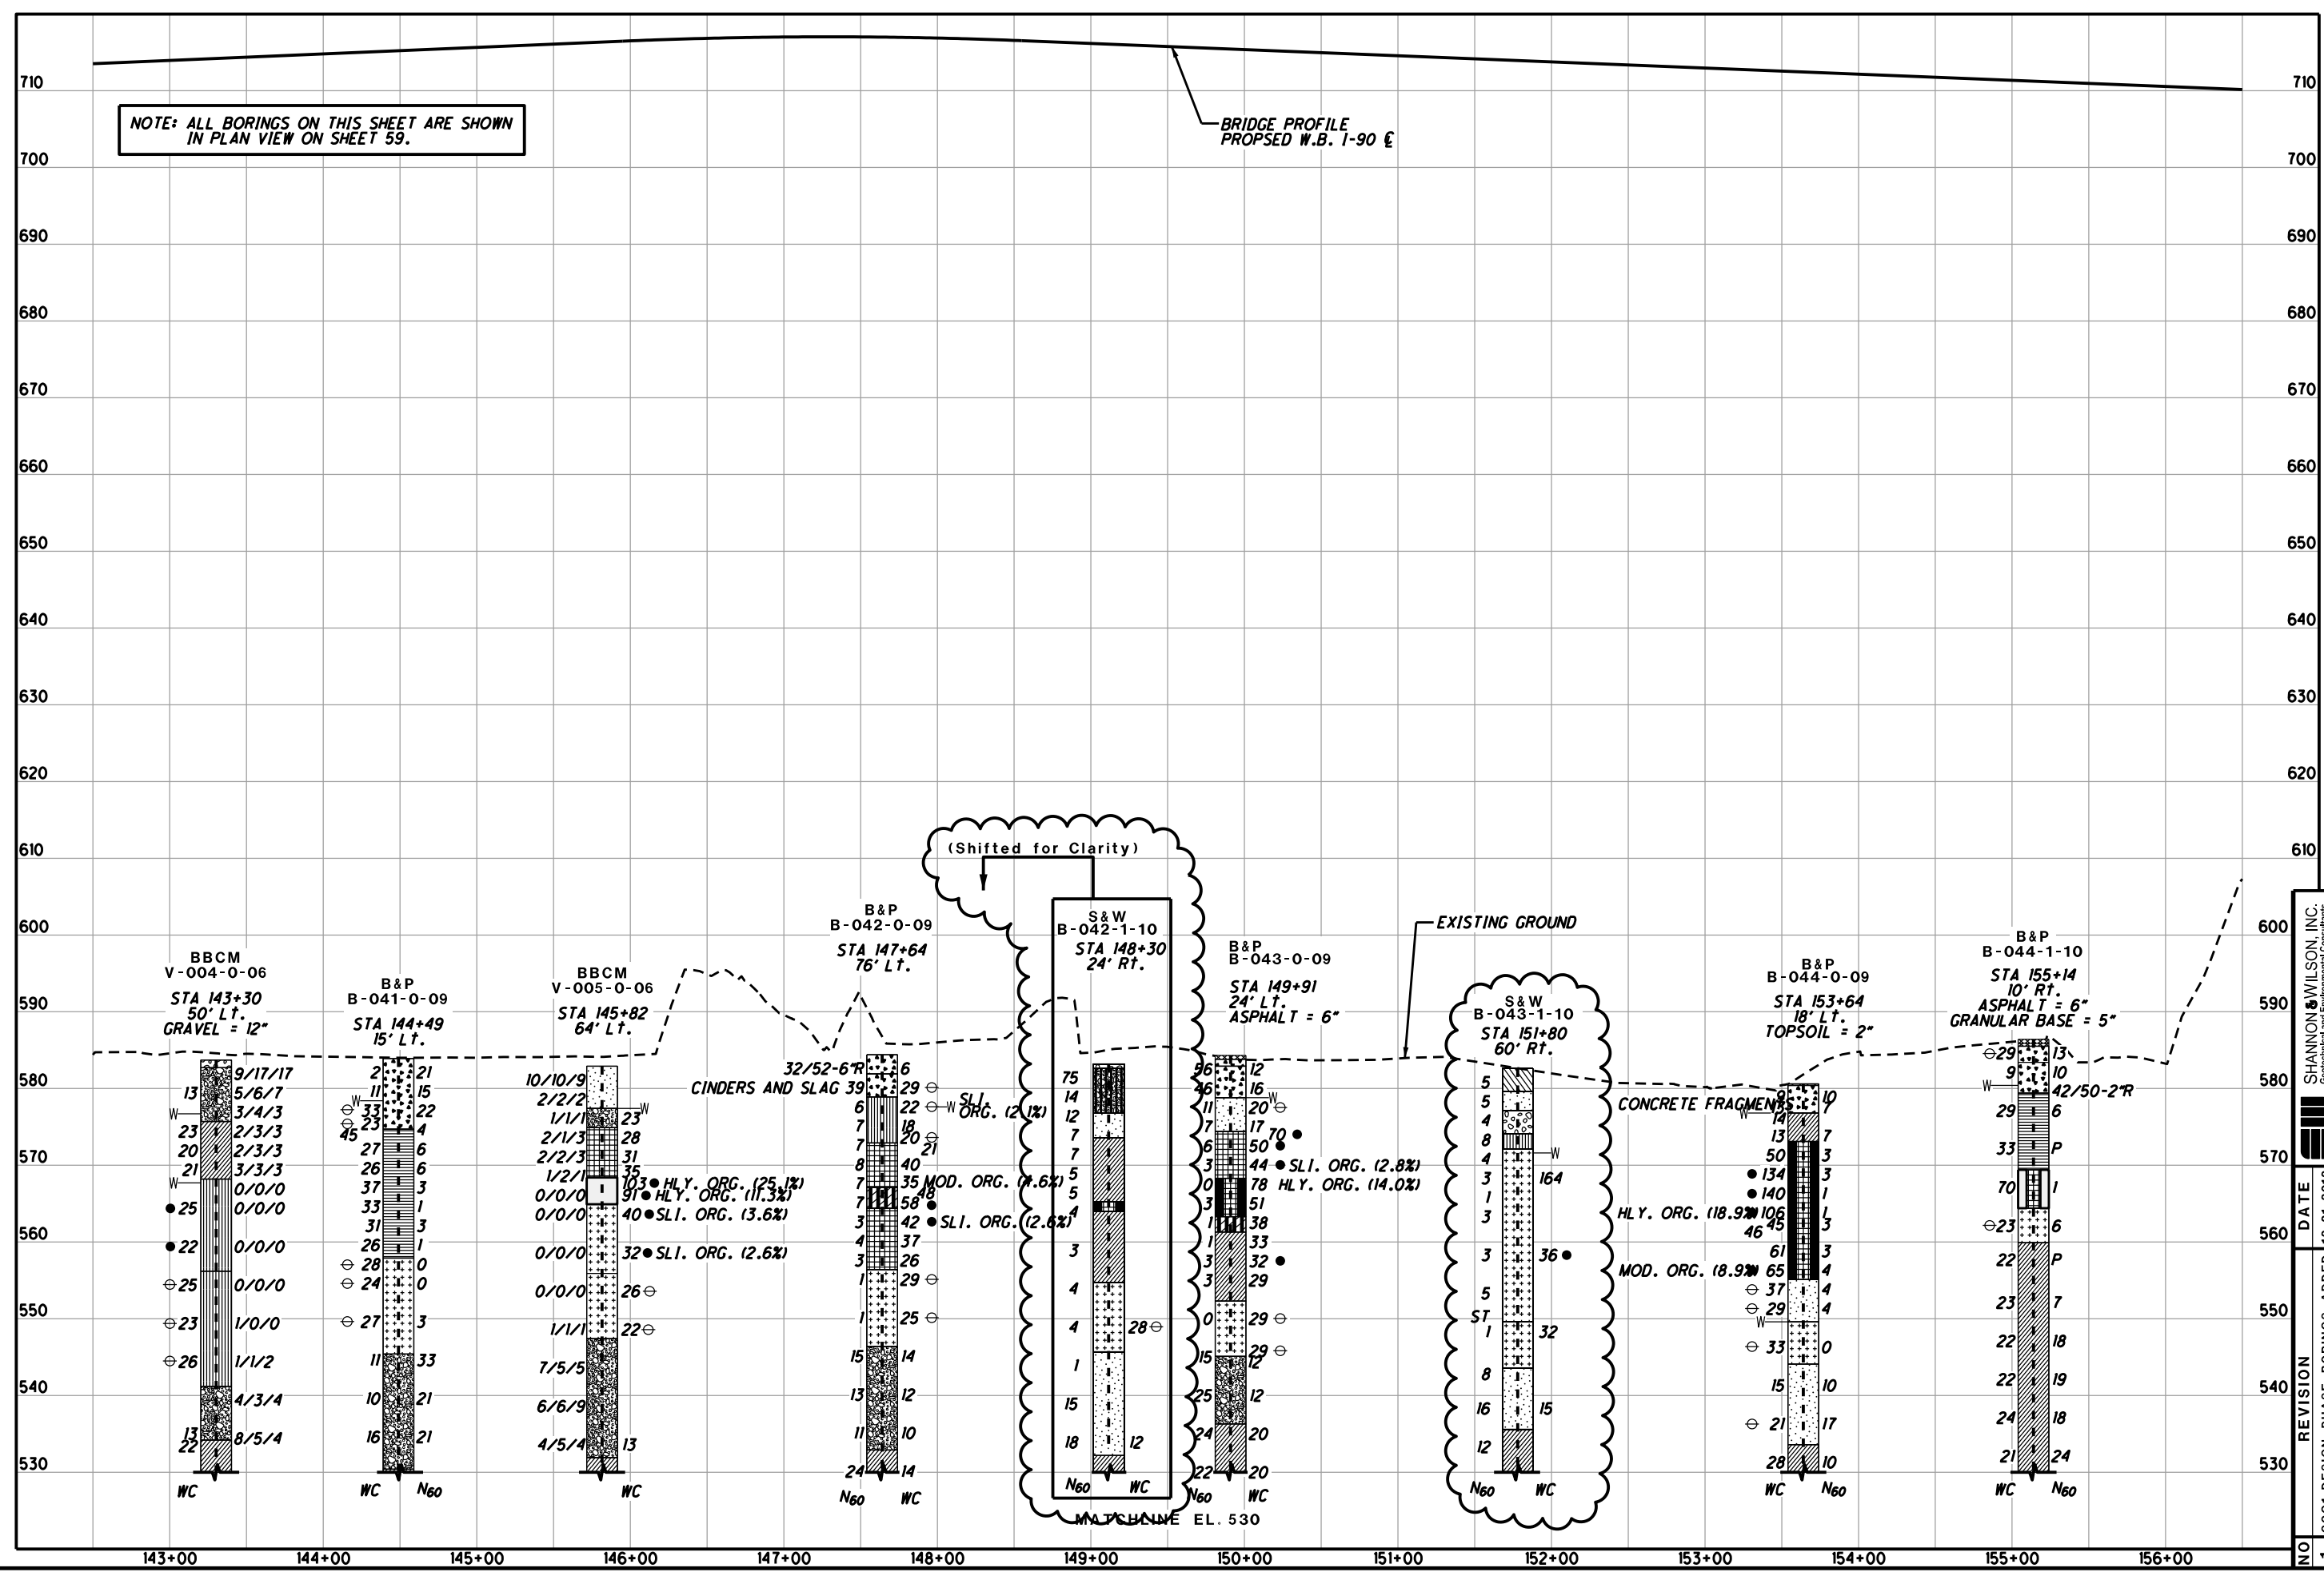


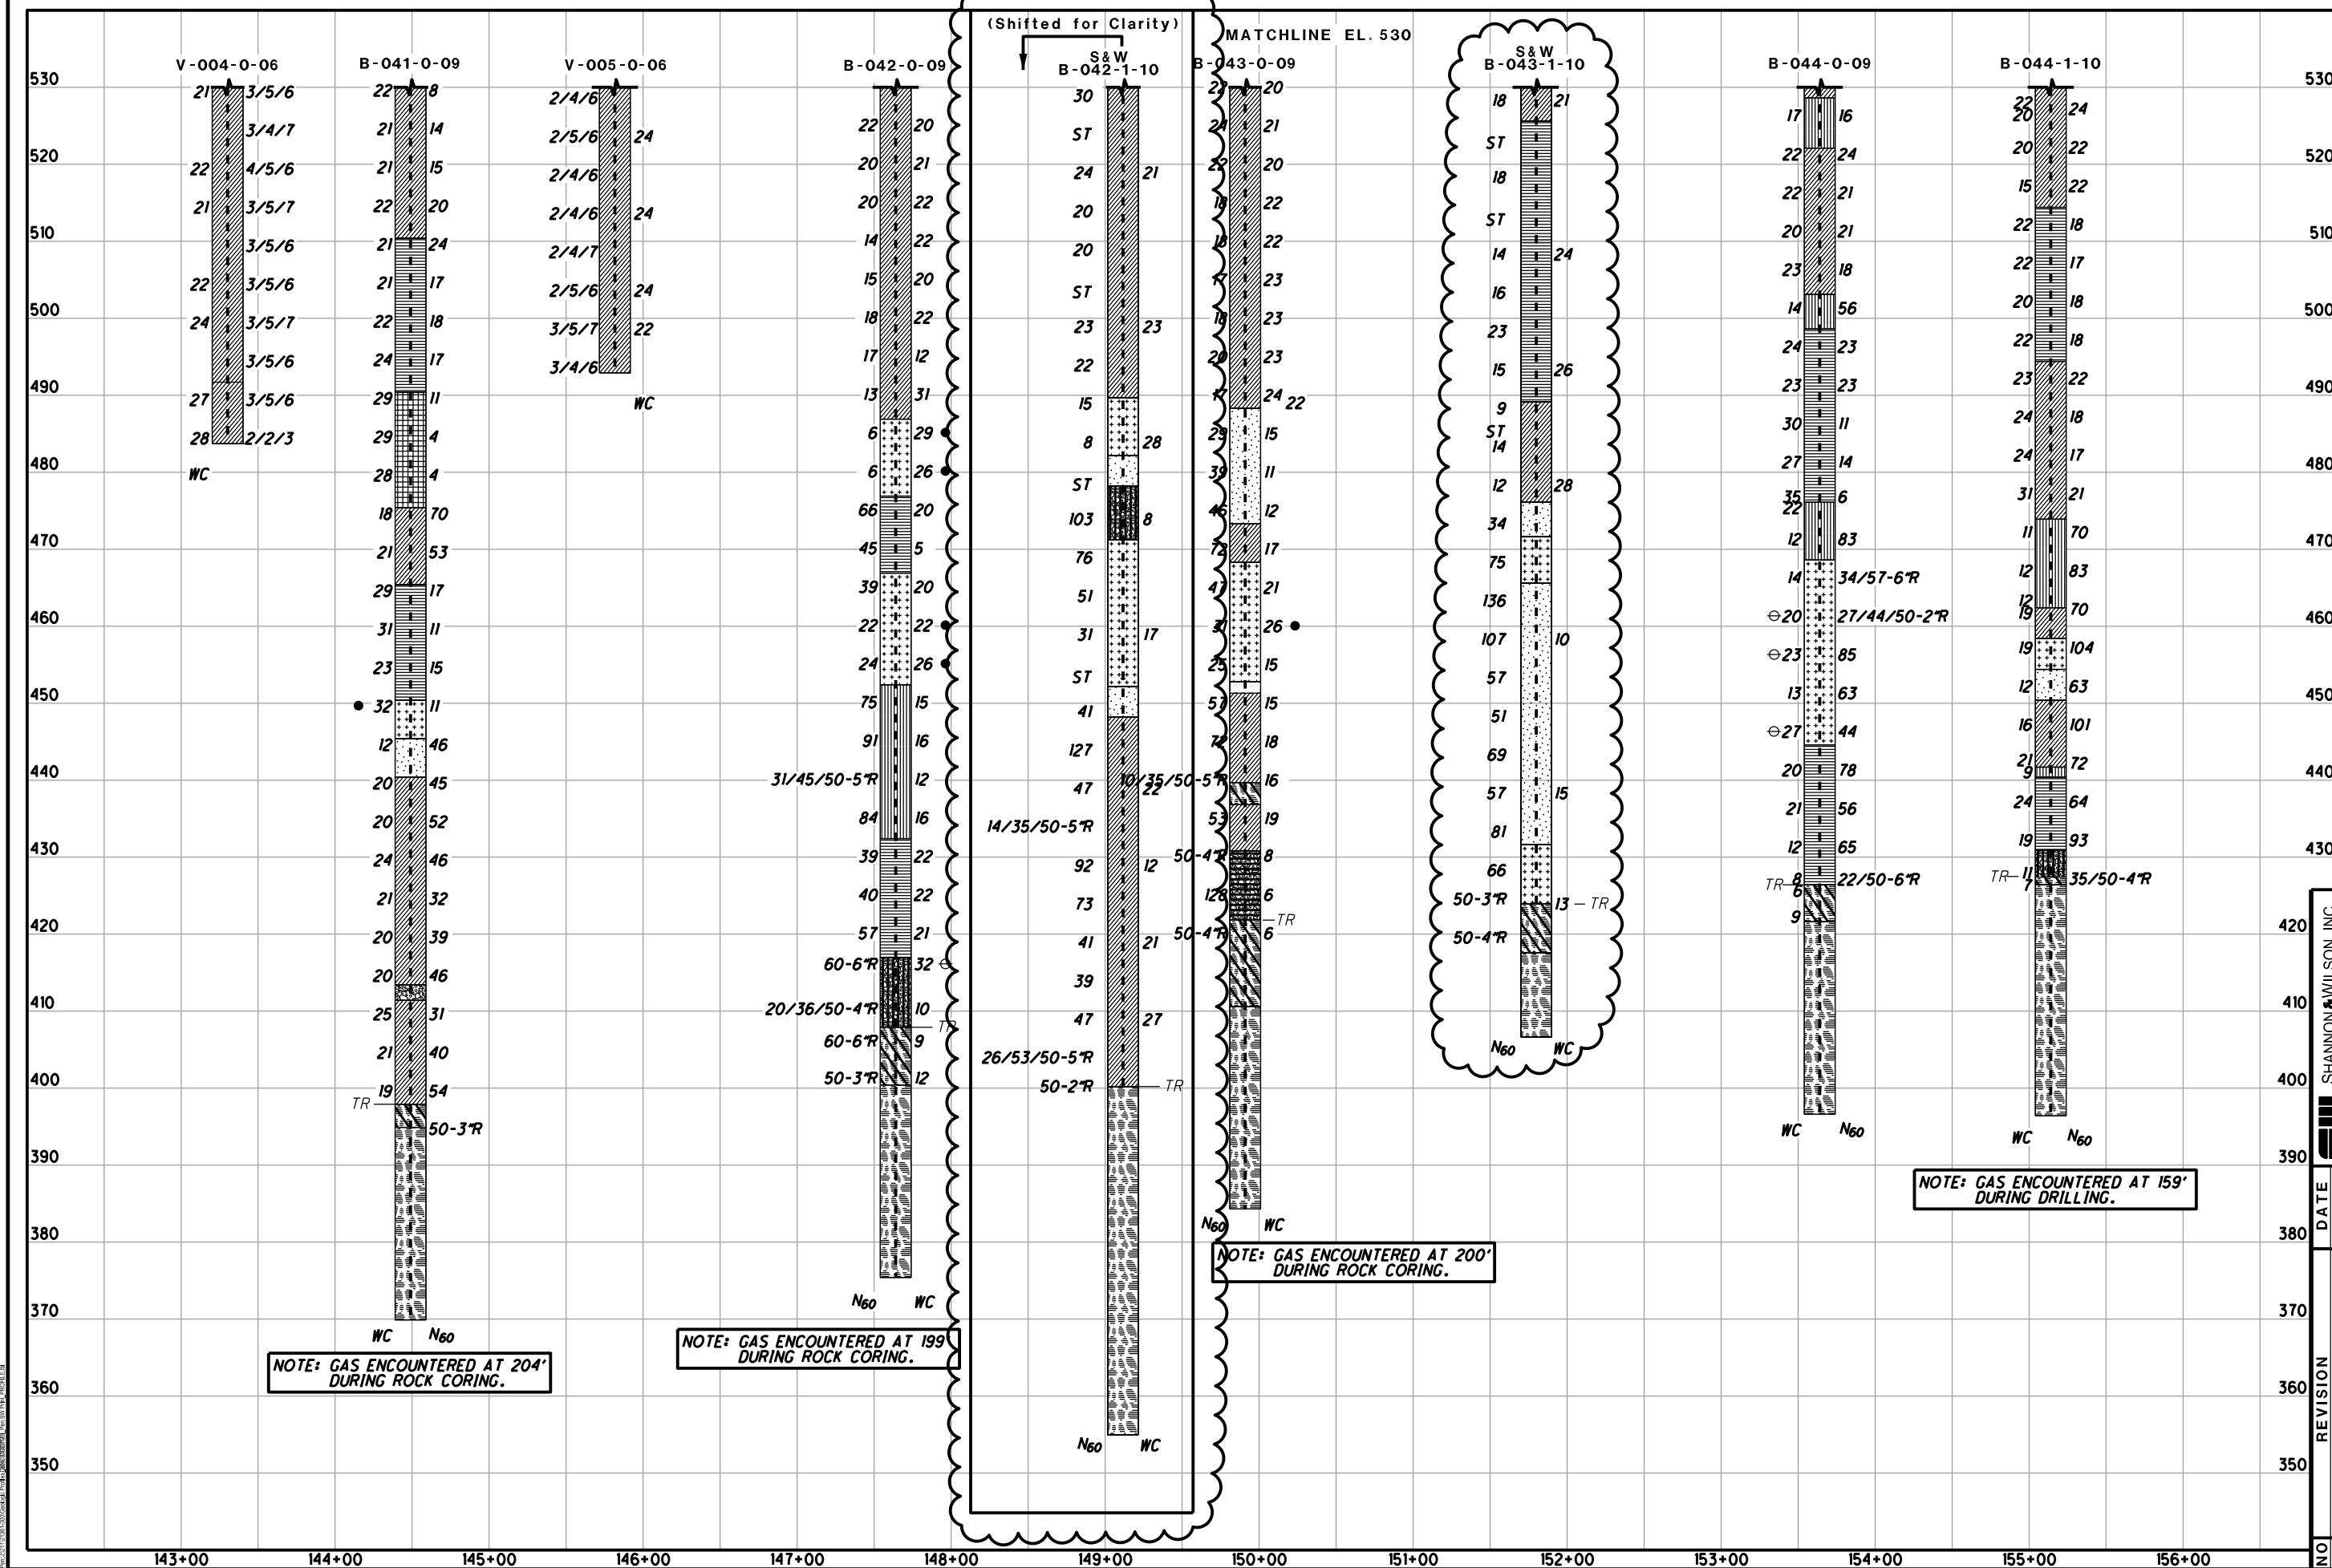

SOIL PROFILE OF BORING NOT INCLUDED ON ANY PROFILES OR CROSS SECTIONS IN THIS SUBMISSION. BORING LOG OR SOIL PROFILE IS AVAILABLE IN THE BORING LOG BINDER SUBMITTED UNDER A SEPARATE COVER.

SOIL PROFILE OF BORING OR CONE PENETRATION TEST NOT INCLUDED ON ANY PROFILES OR CROSS SECTIONS IN THIS SUBMISSION. BORING OR CONE PENETRATION LOG IS AVAILABLE IN THE PROJECT GEOTECHNICAL REPORT FOR CUY-90-14.90 CONSTRUCTION CONTRACT GROUP 1.



**BBCM**

HORIZONTAL SCALE  
IN FEET


SOIL PROFILE - W.B. I-90  
STA. 156+50 TO STA 170+50

SHANNON & WILSON, INC.  
Geotechnical and Environmental Consultants

DATE 12-21-2012  
REVISION 1 CCGT DESIGN PHASE BORINGS ADDED

CUY-90-14.52


64 / 114

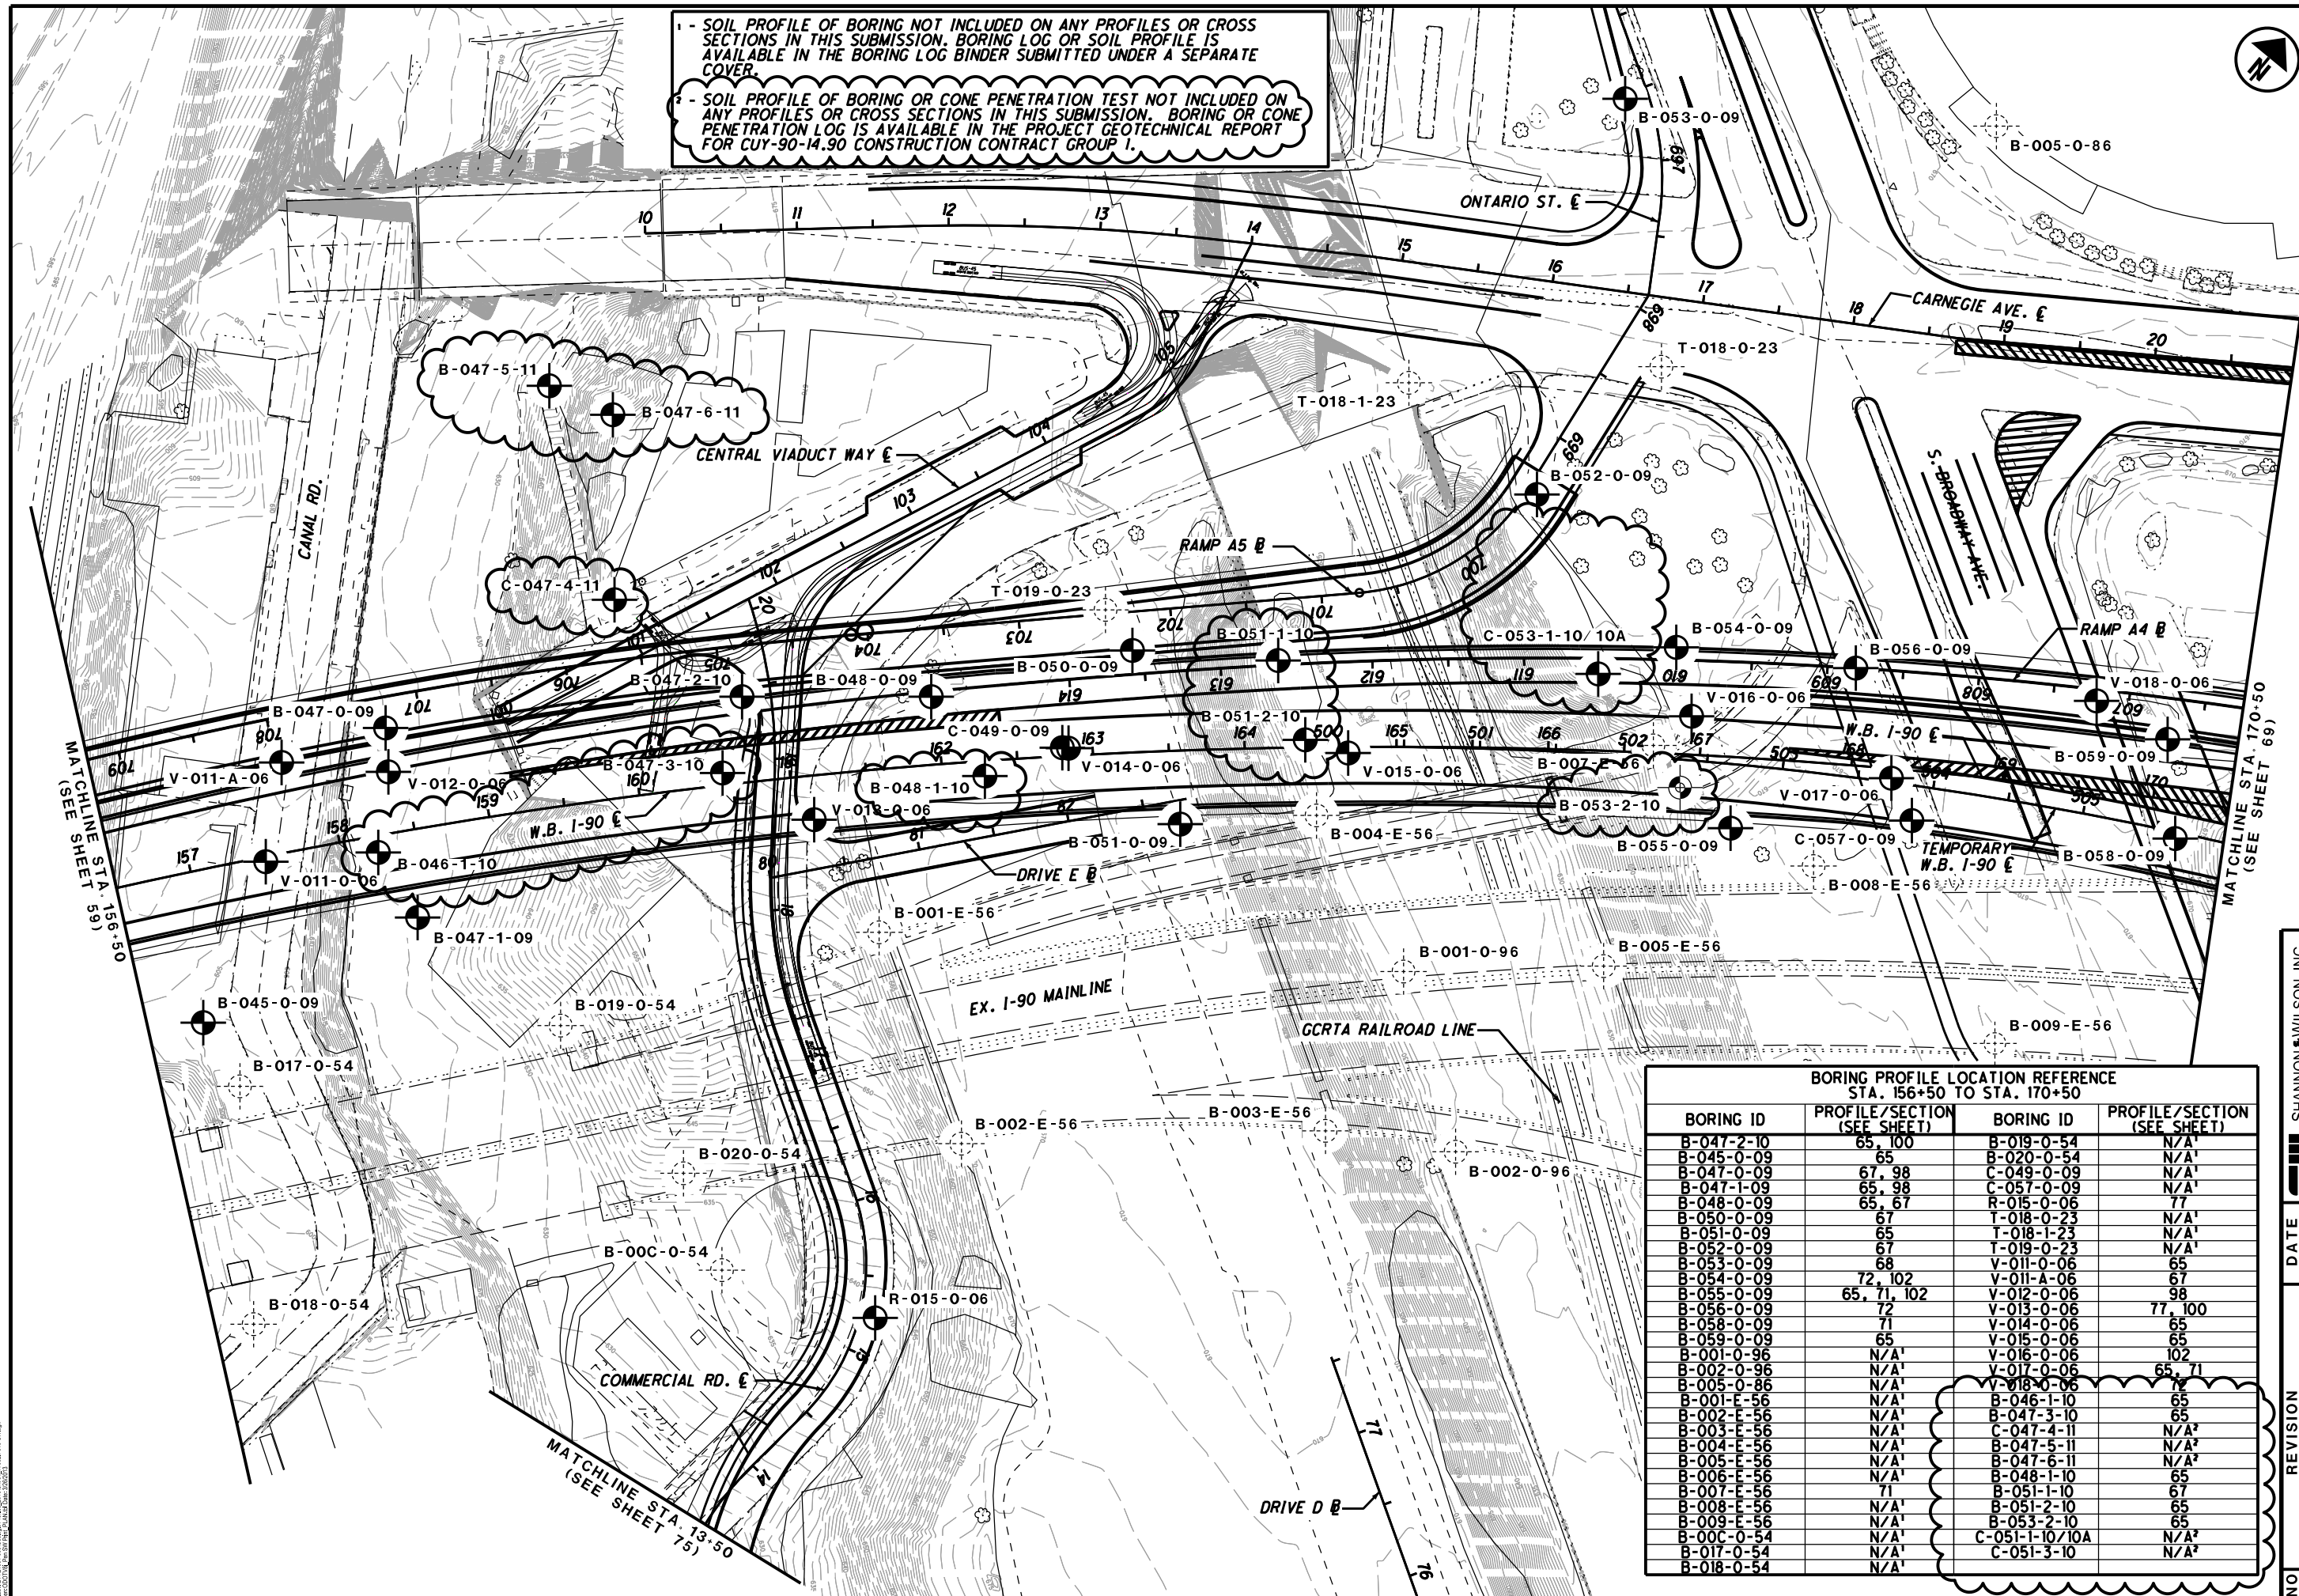

**BORING PROFILE LOCATION REFERENCE  
STA. 156+50 TO STA. 170+50**

BORING ID	PROFILE/SECTION (SEE SHEET)	BORING ID	PROFILE/SECTION (SEE SHEET)
B-047-2-10	65, 100	B-019-0-54	N/A <sup>1</sup>
B-045-0-09	65	B-020-0-54	N/A <sup>1</sup>
B-047-0-09	67, 98	C-049-0-09	N/A <sup>1</sup>
B-047-1-09	65, 98	C-057-0-09	N/A <sup>1</sup>
B-048-0-09	65, 67	R-015-0-06	77
B-050-0-09	67	T-018-0-23	N/A <sup>1</sup>
B-051-0-09	65	T-018-1-23	N/A <sup>1</sup>
B-052-0-09	67	T-019-0-23	N/A <sup>1</sup>
B-053-0-09	68	V-011-0-06	65
B-054-0-09	72, 102	V-011-A-06	67
B-055-0-09	65, 71, 102	V-012-0-06	98
B-056-0-09	72	V-013-0-06	77, 100
B-058-0-09	71	V-014-0-06	65
B-059-0-09	65	V-015-0-06	65
B-001-0-96	N/A <sup>1</sup>	V-016-0-06	102
B-002-0-96	N/A <sup>1</sup>	V-017-0-06	65, 71
B-005-0-86	N/A <sup>1</sup>	V-018-0-06	71
B-001-E-56	N/A <sup>1</sup>	B-046-1-10	65
B-002-E-56	N/A <sup>1</sup>	B-047-3-10	65
B-003-E-56	N/A <sup>1</sup>	C-047-4-11	N/A <sup>2</sup>
B-004-E-56	N/A <sup>1</sup>	B-047-5-11	N/A <sup>2</sup>
B-005-E-56	N/A <sup>1</sup>	B-047-6-11	N/A <sup>2</sup>
B-006-E-56	N/A <sup>1</sup>	B-048-1-10	65
B-007-E-56	71	B-051-1-10	67
B-008-E-56	N/A <sup>1</sup>	B-051-2-10	65
B-009-E-56	N/A <sup>1</sup>	B-053-2-10	65
B-00C-0-54	N/A <sup>1</sup>	C-051-1-10/10A	N/A <sup>2</sup>
B-017-0-54	N/A <sup>1</sup>	C-051-3-10	N/A <sup>2</sup>
B-018-0-54	N/A <sup>1</sup>		

THE INFORMATION CONTAINED HEREIN IS THE PROPERTY OF SHANNON & WILSON, INC. AND IS NOT TO BE REPRODUCED OR TRANSMITTED IN ANY FORM OR BY ANY MEANS, ELECTRONIC OR MECHANICAL, INCLUDING PHOTOCOPYING, RECORDING, OR BY ANY INFORMATION STORAGE AND RETRIEVAL SYSTEM, WITHOUT THE WRITTEN PERMISSION OF SHANNON & WILSON, INC.

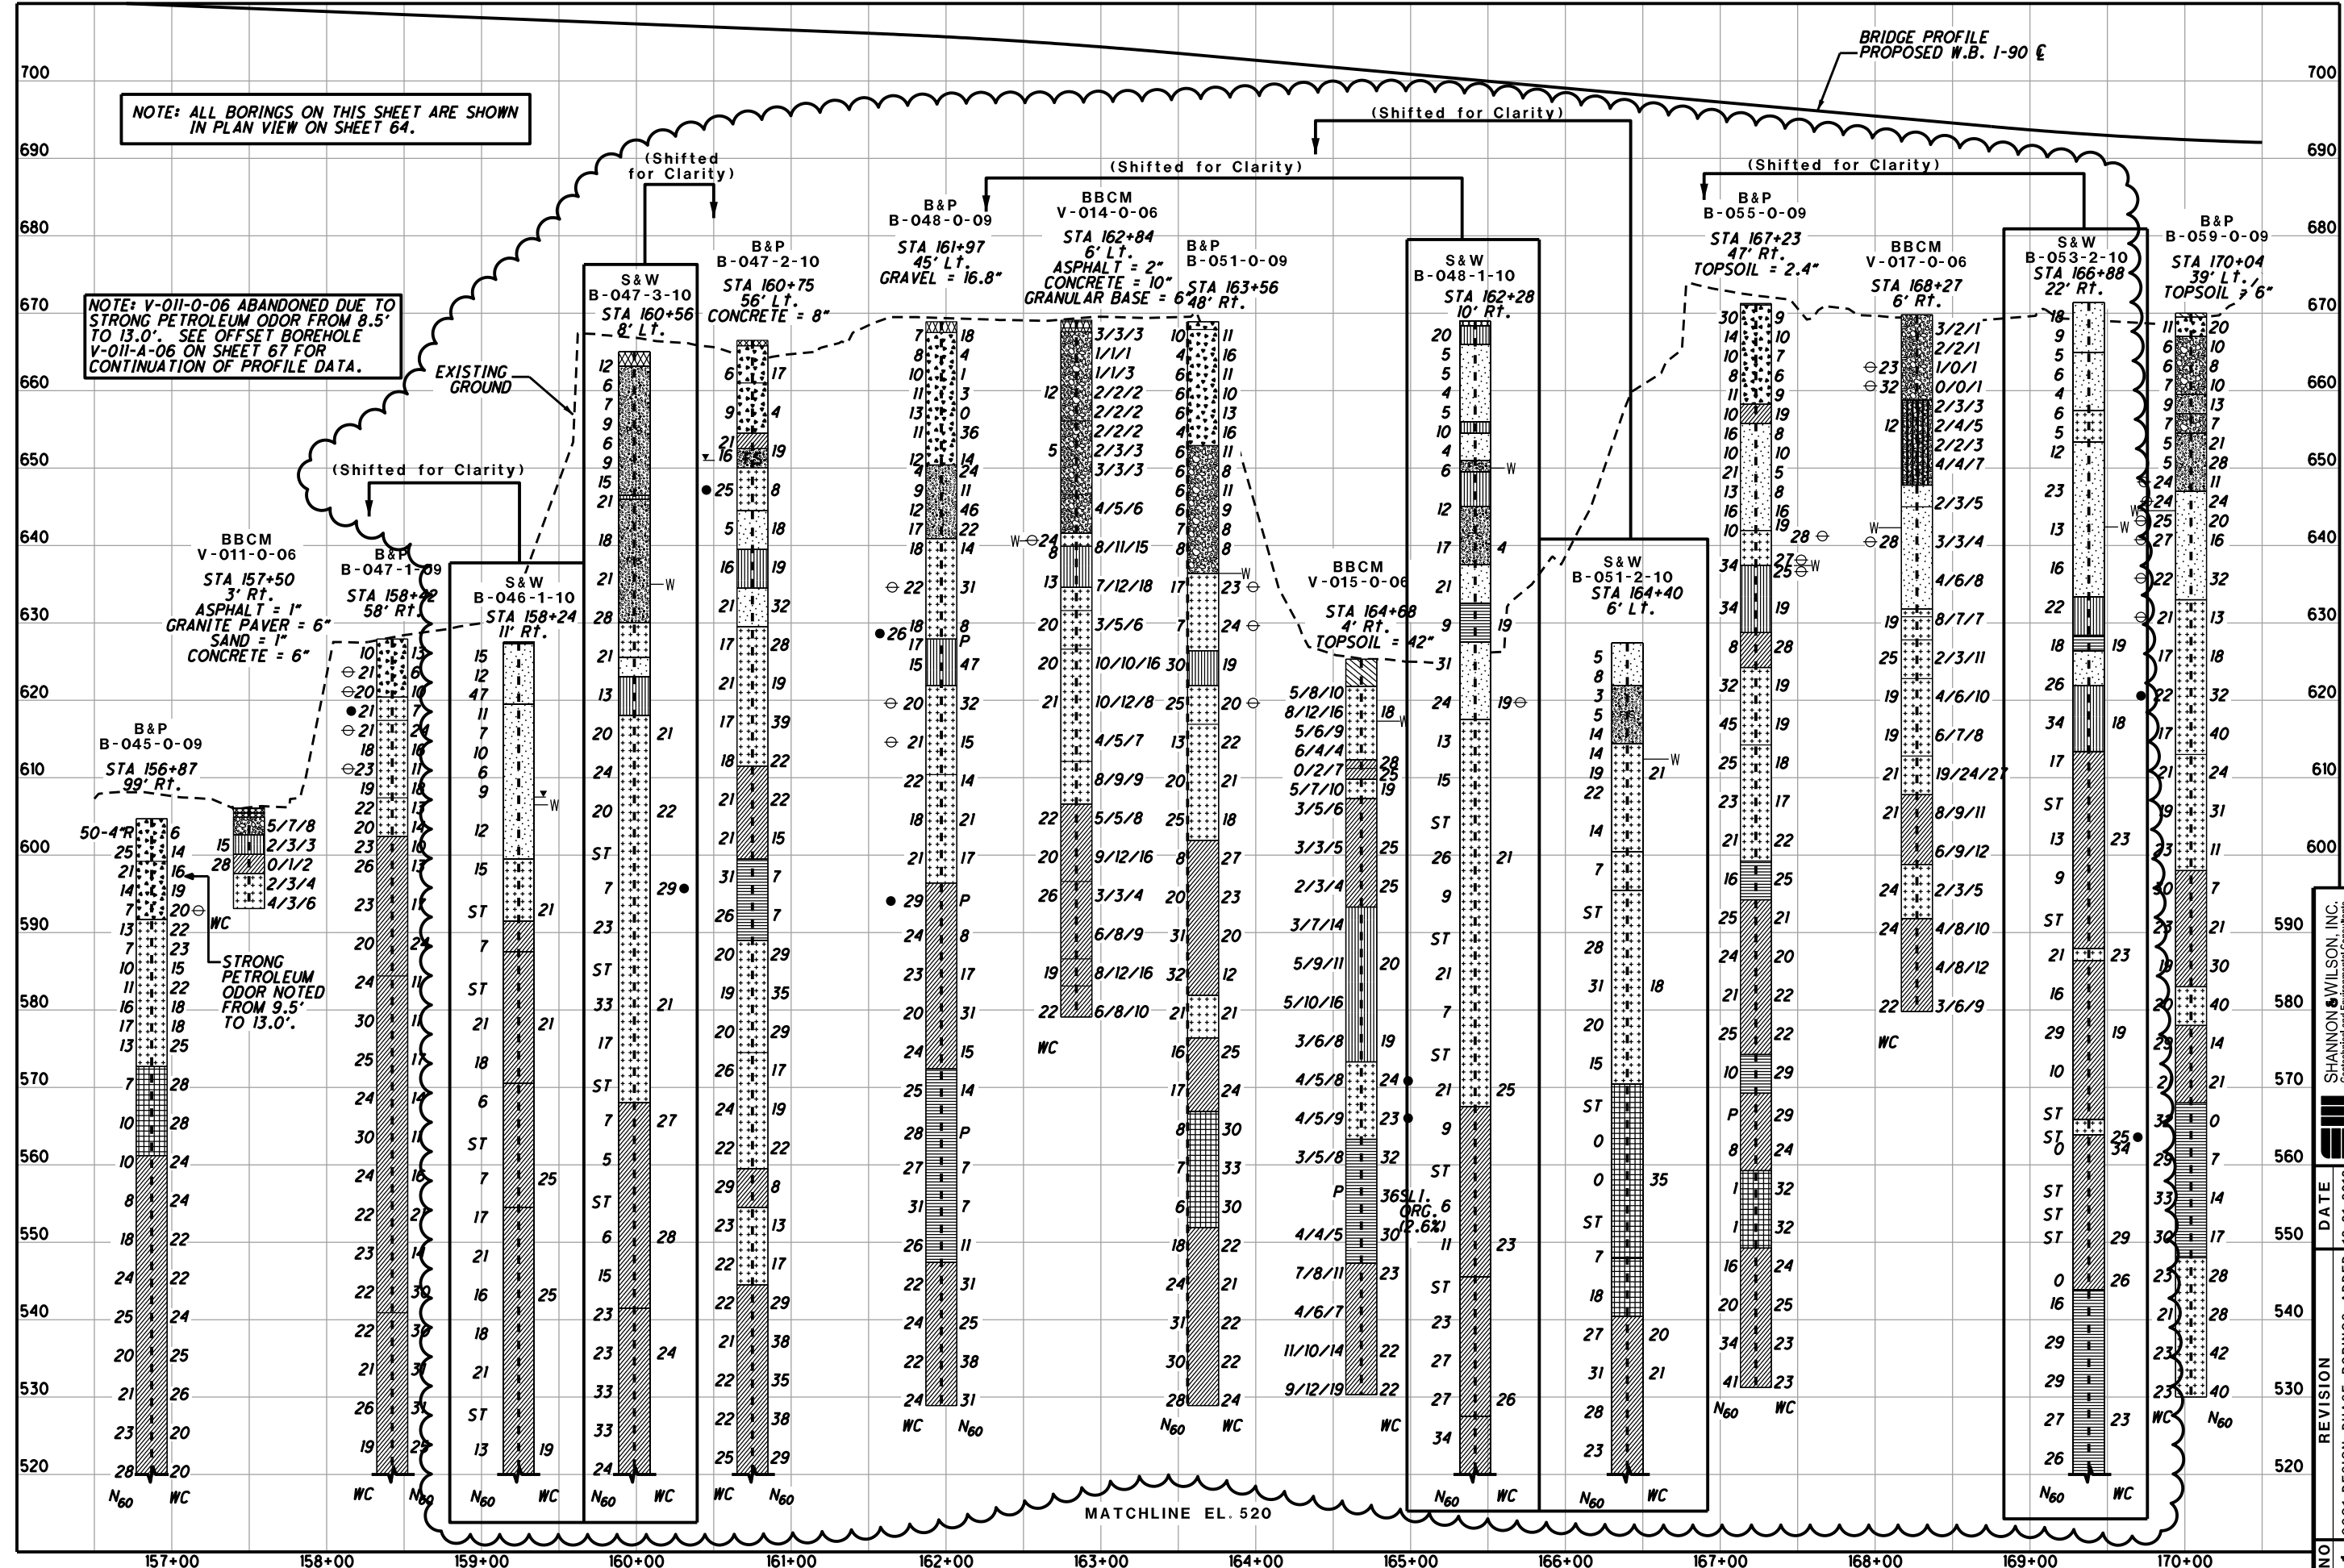


NO	REVISION	DATE
1	CCGT DESIGN PHASE BORINGS ADDED	12-21-2012

SHANNON WILSON, INC.  
Geotechnical and Environmental Consultants

Revised: 12/21/2012  


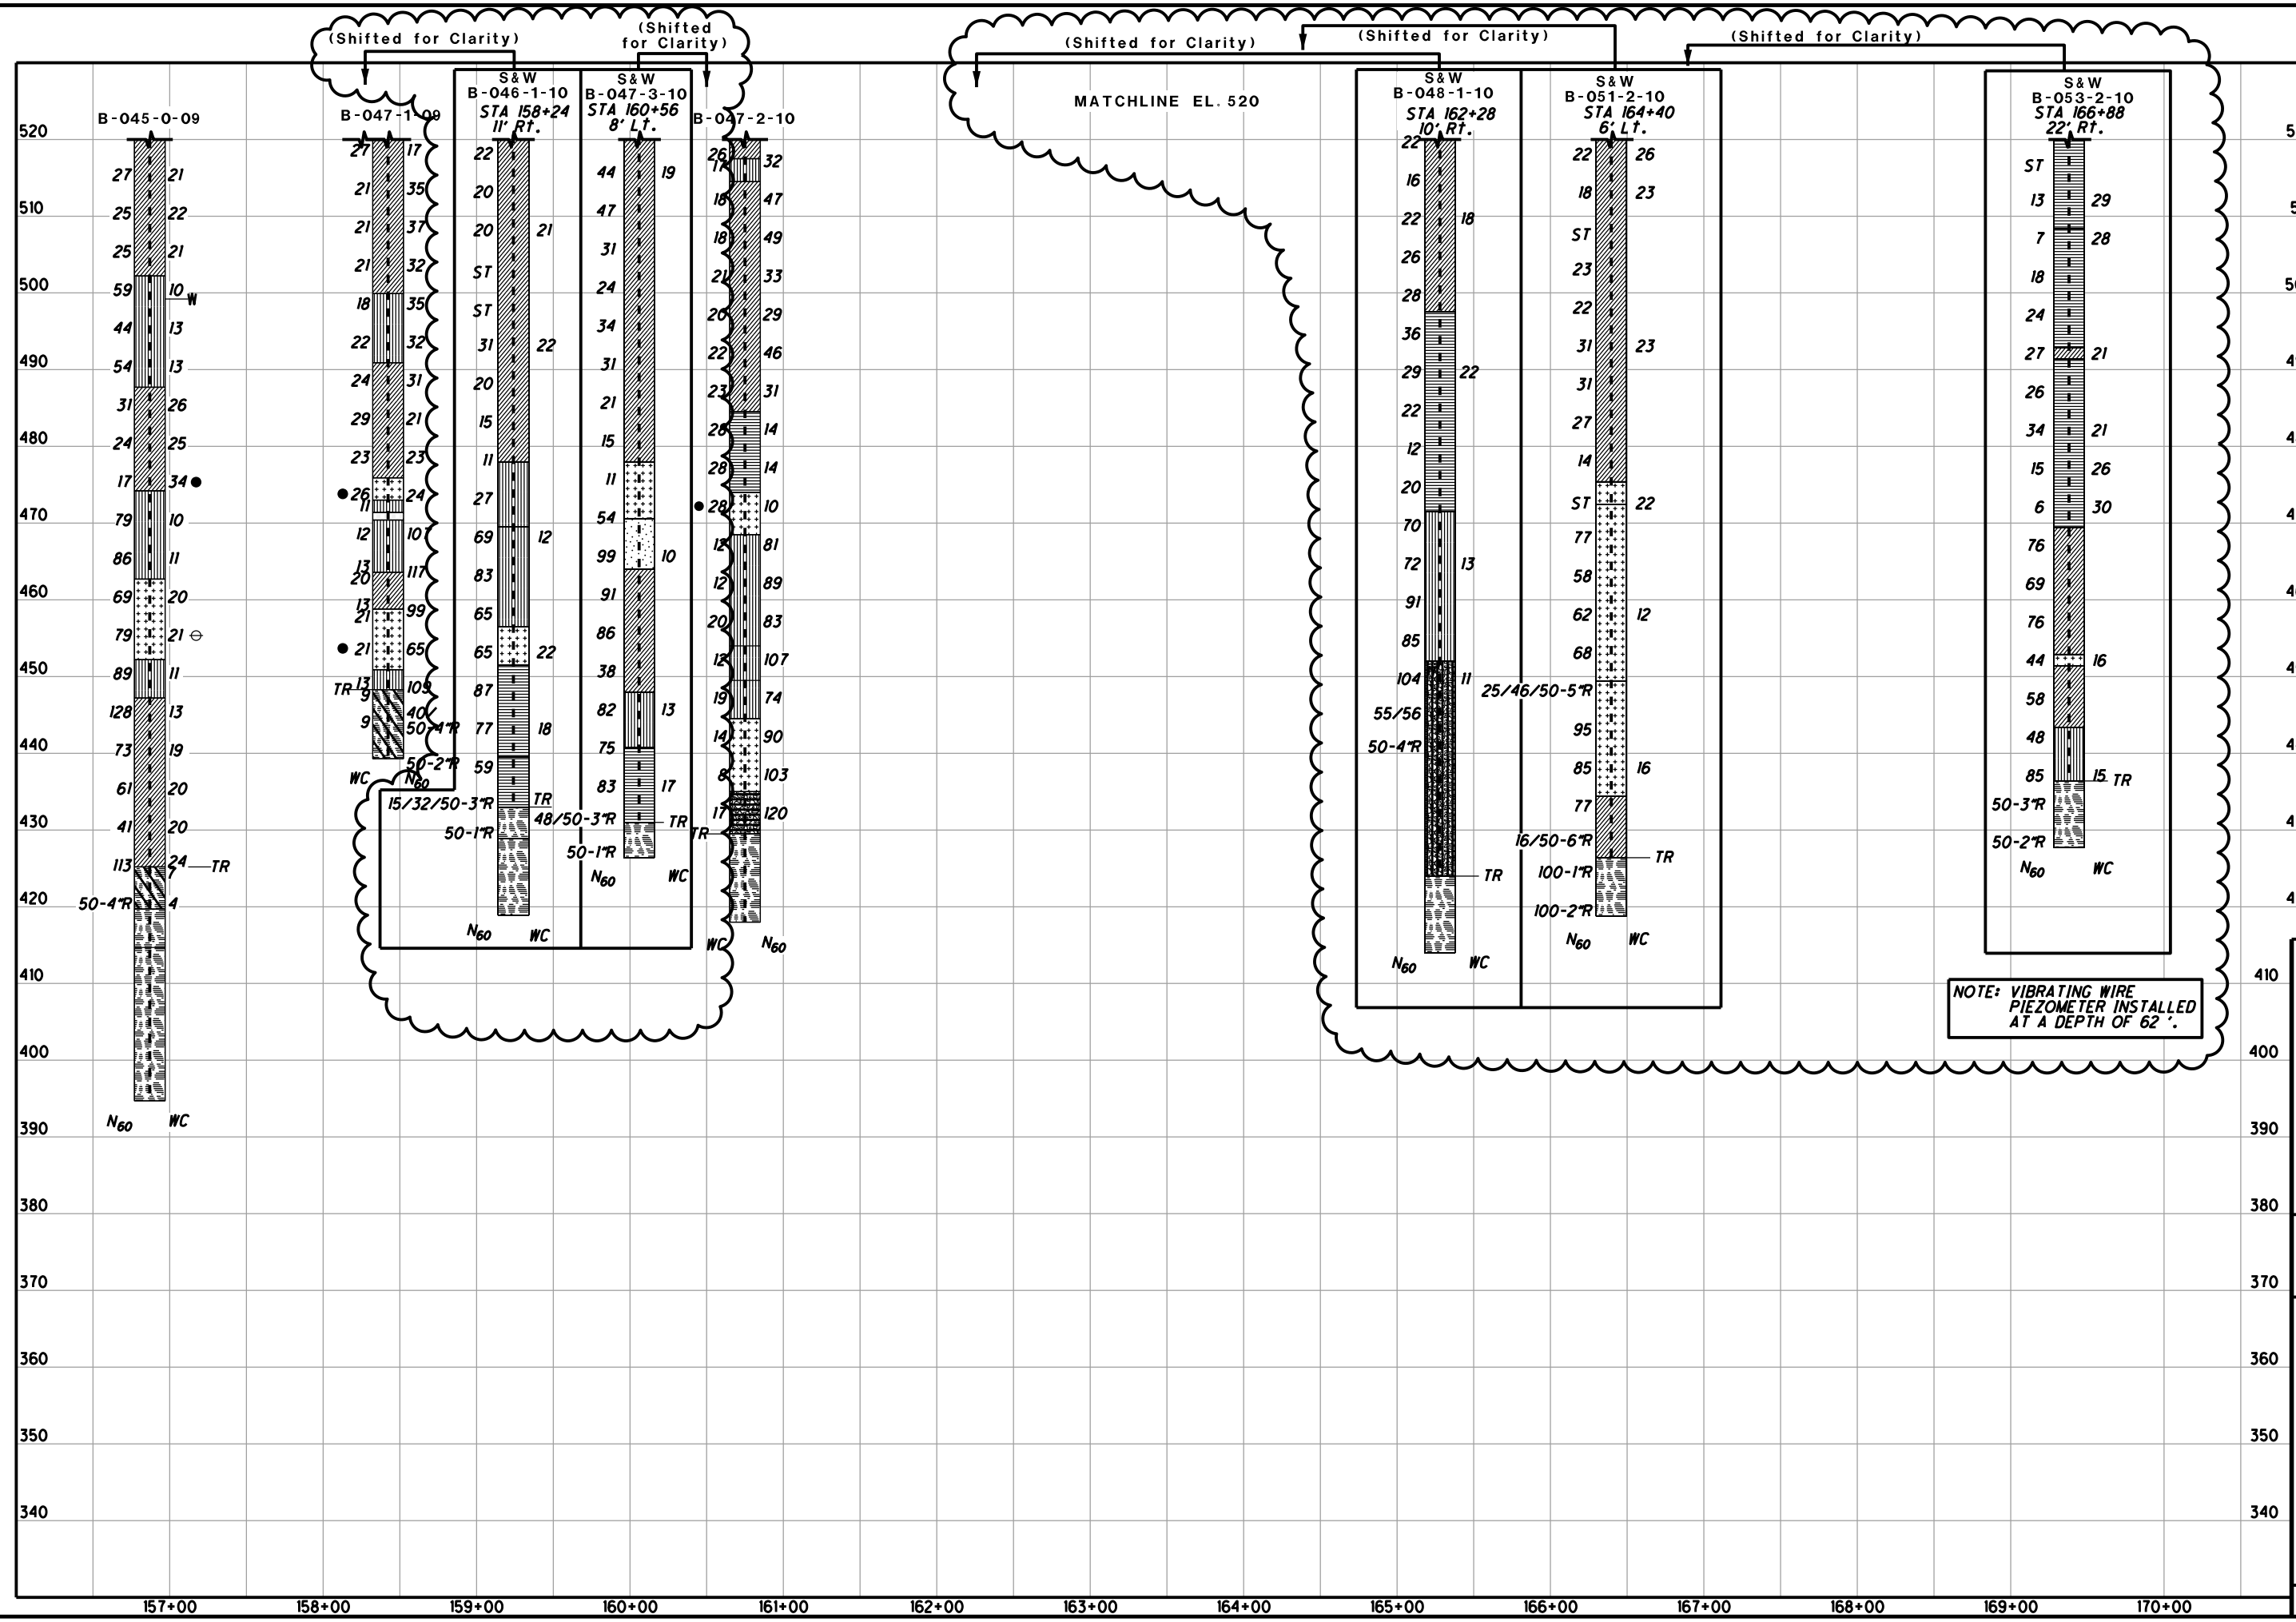

SHANNON & WILSON, INC.  
Geotechnical and Environmental Consultants

SOIL PROFILE - W.B. I-90  
STA. 156+50 TO STA. 170+50

CUY-90-14.52


66 / 114


REVISION DATE  
1 CCGT DESIGN PHASE BORINGS ADDED 12-21-2012

HORIZONTAL SCALE  
IN FEET

NO. 1



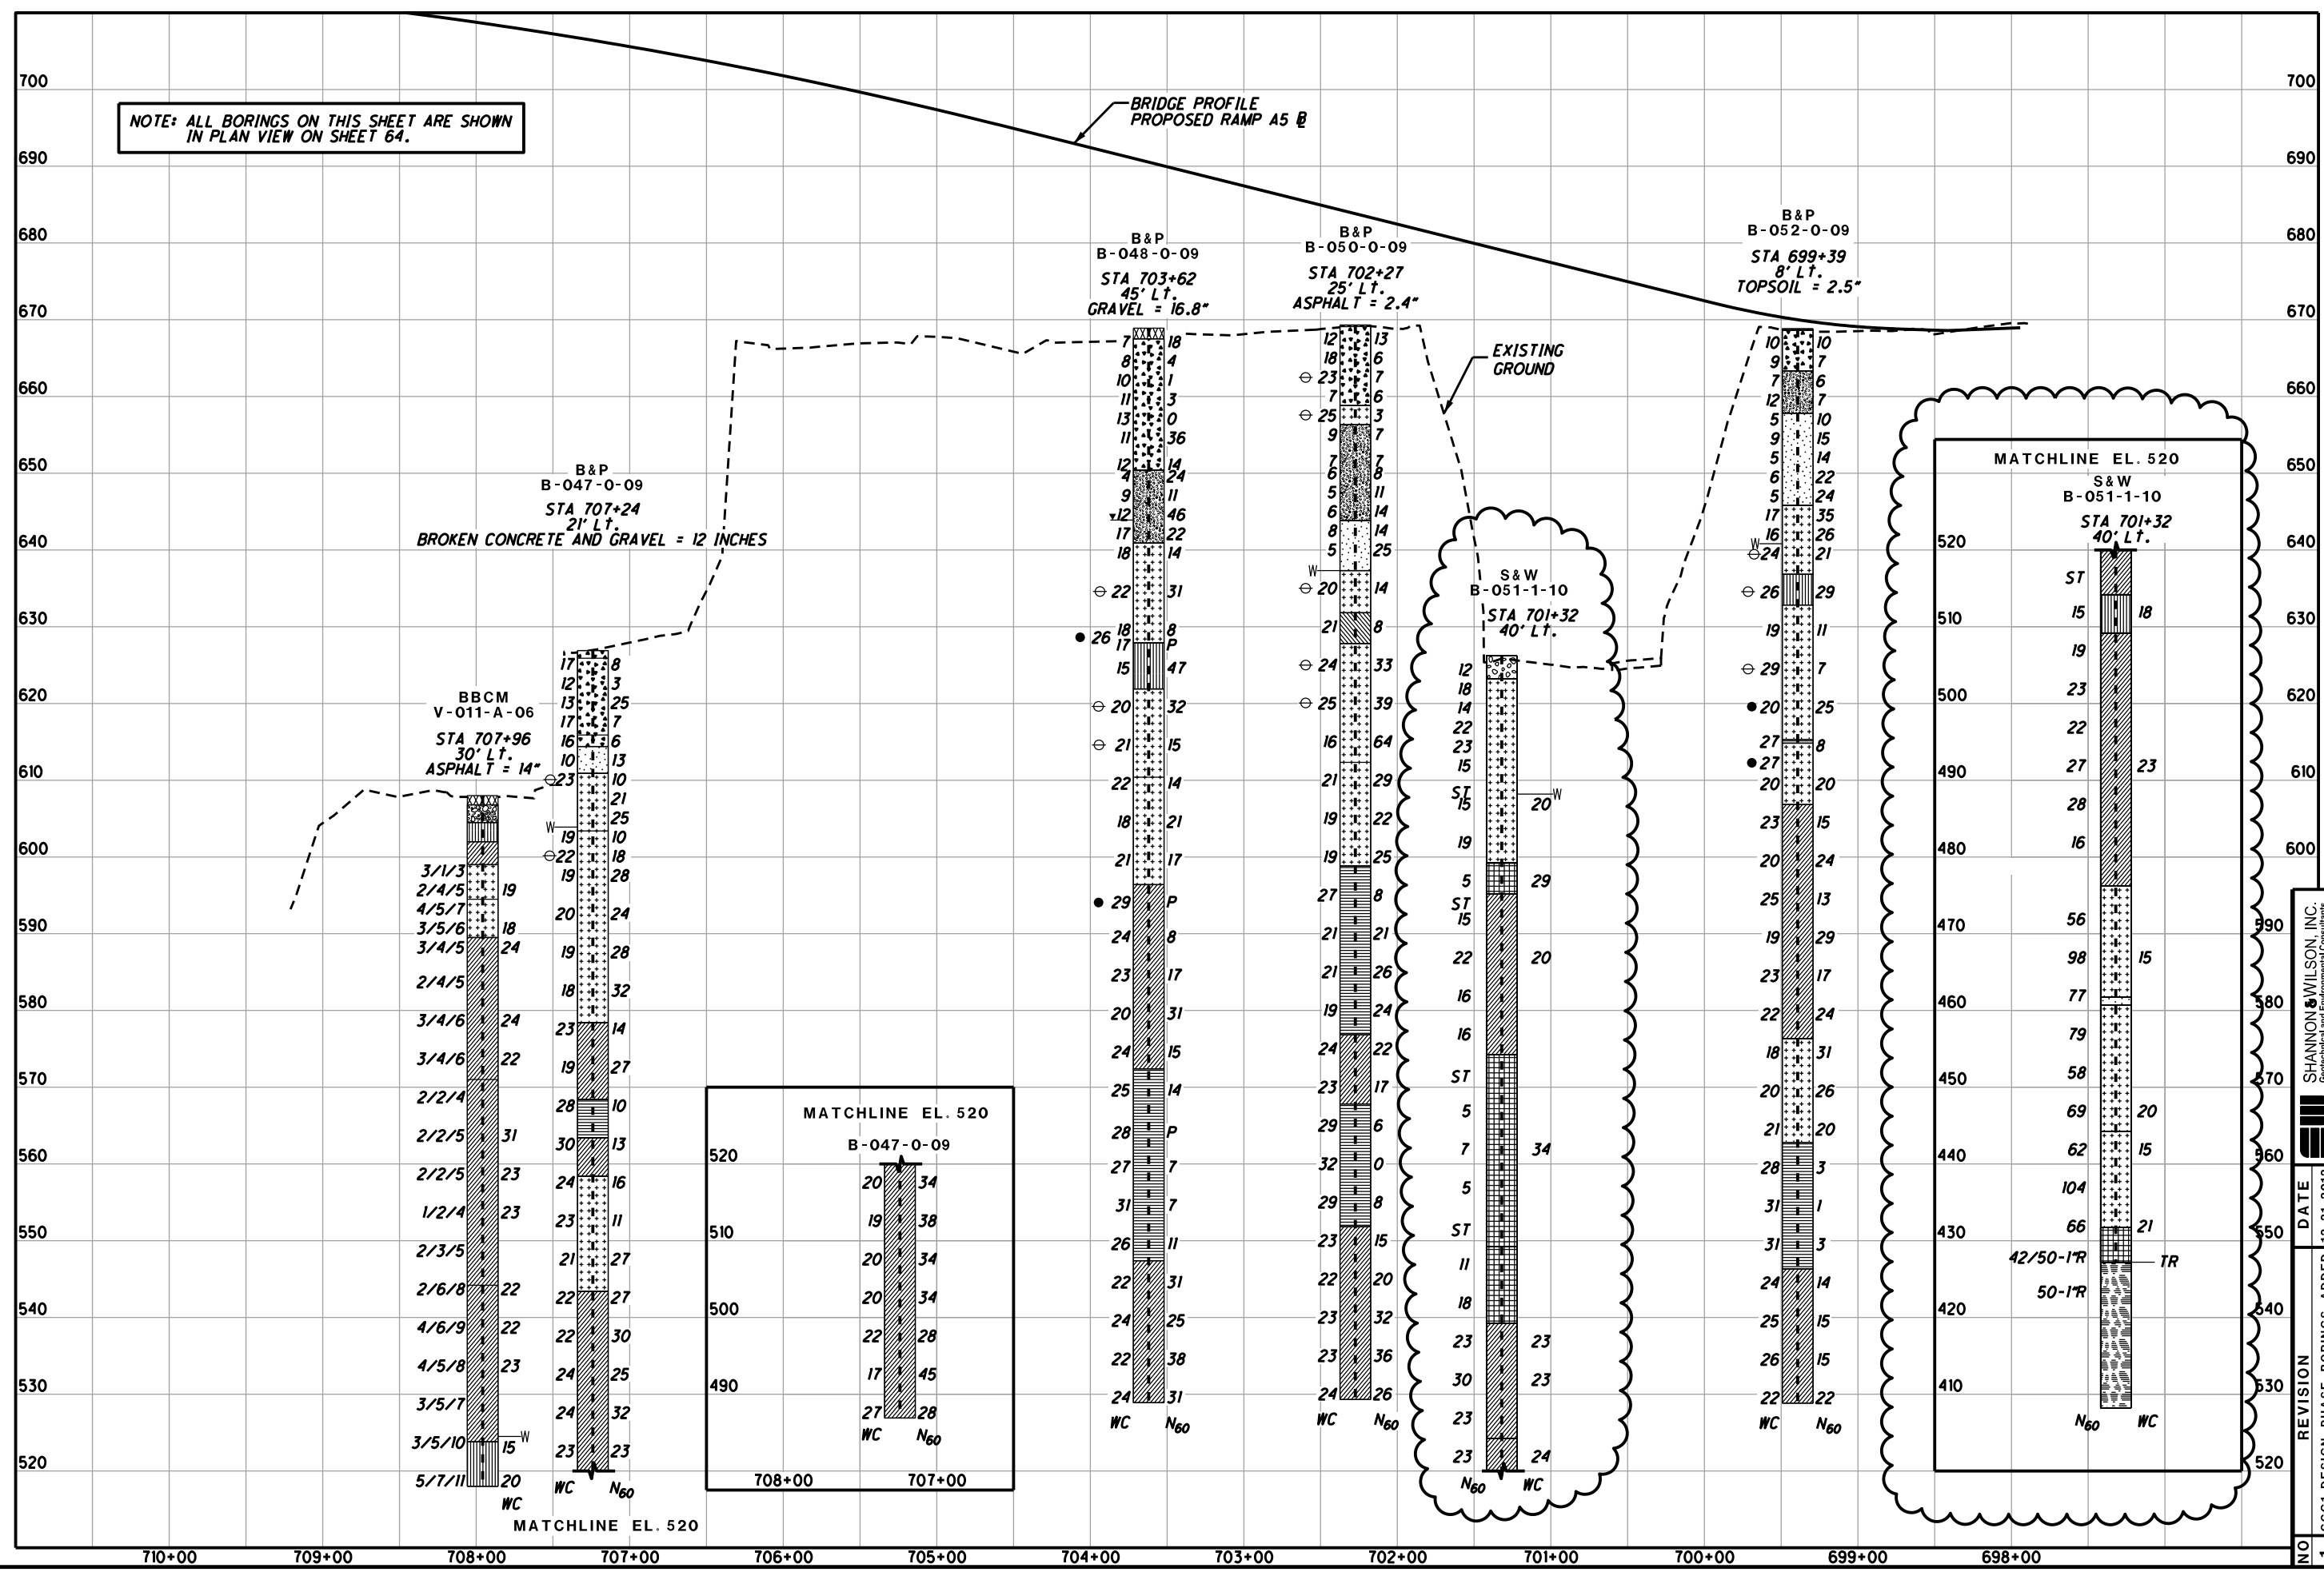

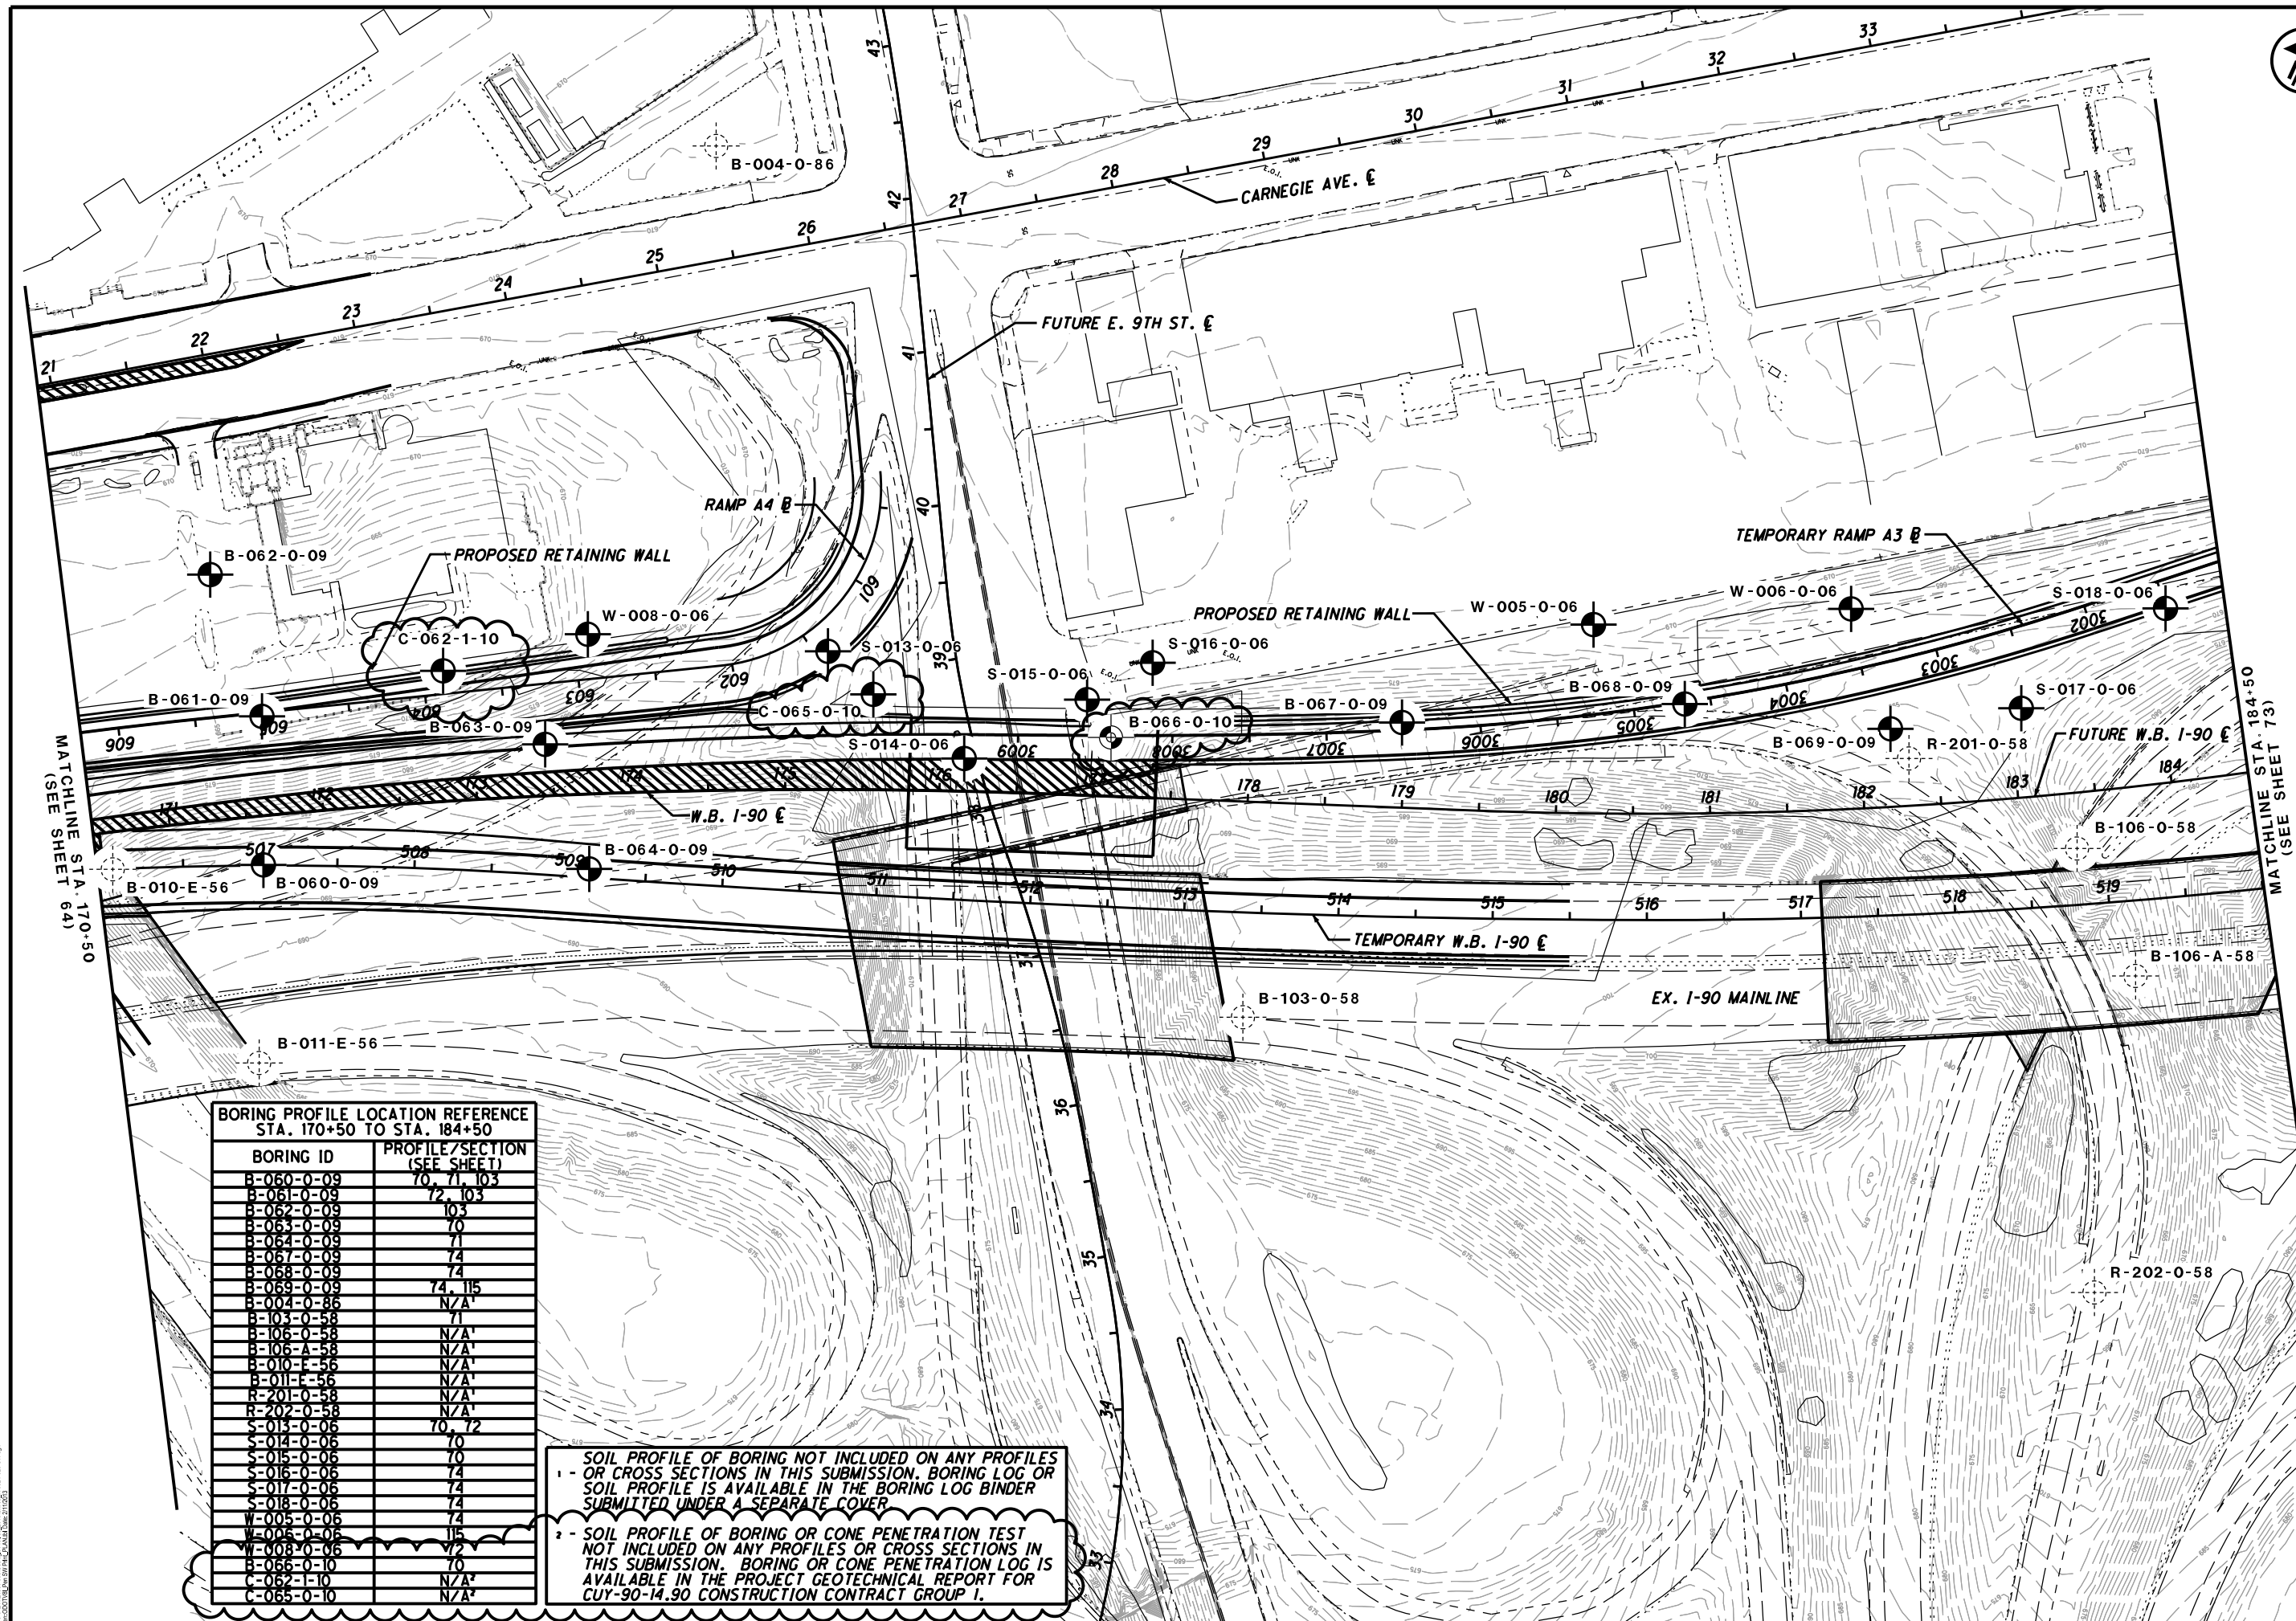


**BORING PROFILE LOCATION REFERENCE  
STA. 170+50 TO STA. 184+50**

BORING ID	PROFILE / SECTION (SEE SHEET)
B-060-0-09	70, 71, 103
B-061-0-09	72, 103
B-062-0-09	103
B-063-0-09	70
B-064-0-09	71
B-067-0-09	74
B-068-0-09	74
B-069-0-09	74, 115
B-004-0-86	N/A*
B-103-0-58	71
B-106-0-58	N/A*
B-106-A-58	N/A*
B-010-E-56	N/A*
B-011-E-56	N/A*
R-201-0-58	N/A*
R-202-0-58	N/A*
S-013-0-06	70, 72
S-014-0-06	70
S-015-0-06	70
S-016-0-06	74
S-017-0-06	74
S-018-0-06	74
W-005-0-06	74
W-008-0-06	72
C-062-1-10	N/A*
C-065-0-10	N/A*

1 - SOIL PROFILE OF BORING NOT INCLUDED ON ANY PROFILES OR CROSS SECTIONS IN THIS SUBMISSION. BORING LOG OR SOIL PROFILE IS AVAILABLE IN THE BORING LOG BINDER SUBMITTED UNDER A SEPARATE COVER

2 - SOIL PROFILE OF BORING OR CONE PENETRATION TEST NOT INCLUDED ON ANY PROFILES OR CROSS SECTIONS IN THIS SUBMISSION. BORING OR CONE PENETRATION LOG IS AVAILABLE IN THE PROJECT GEOTECHNICAL REPORT FOR CUY-90-14.90 CONSTRUCTION CONTRACT GROUP 1.

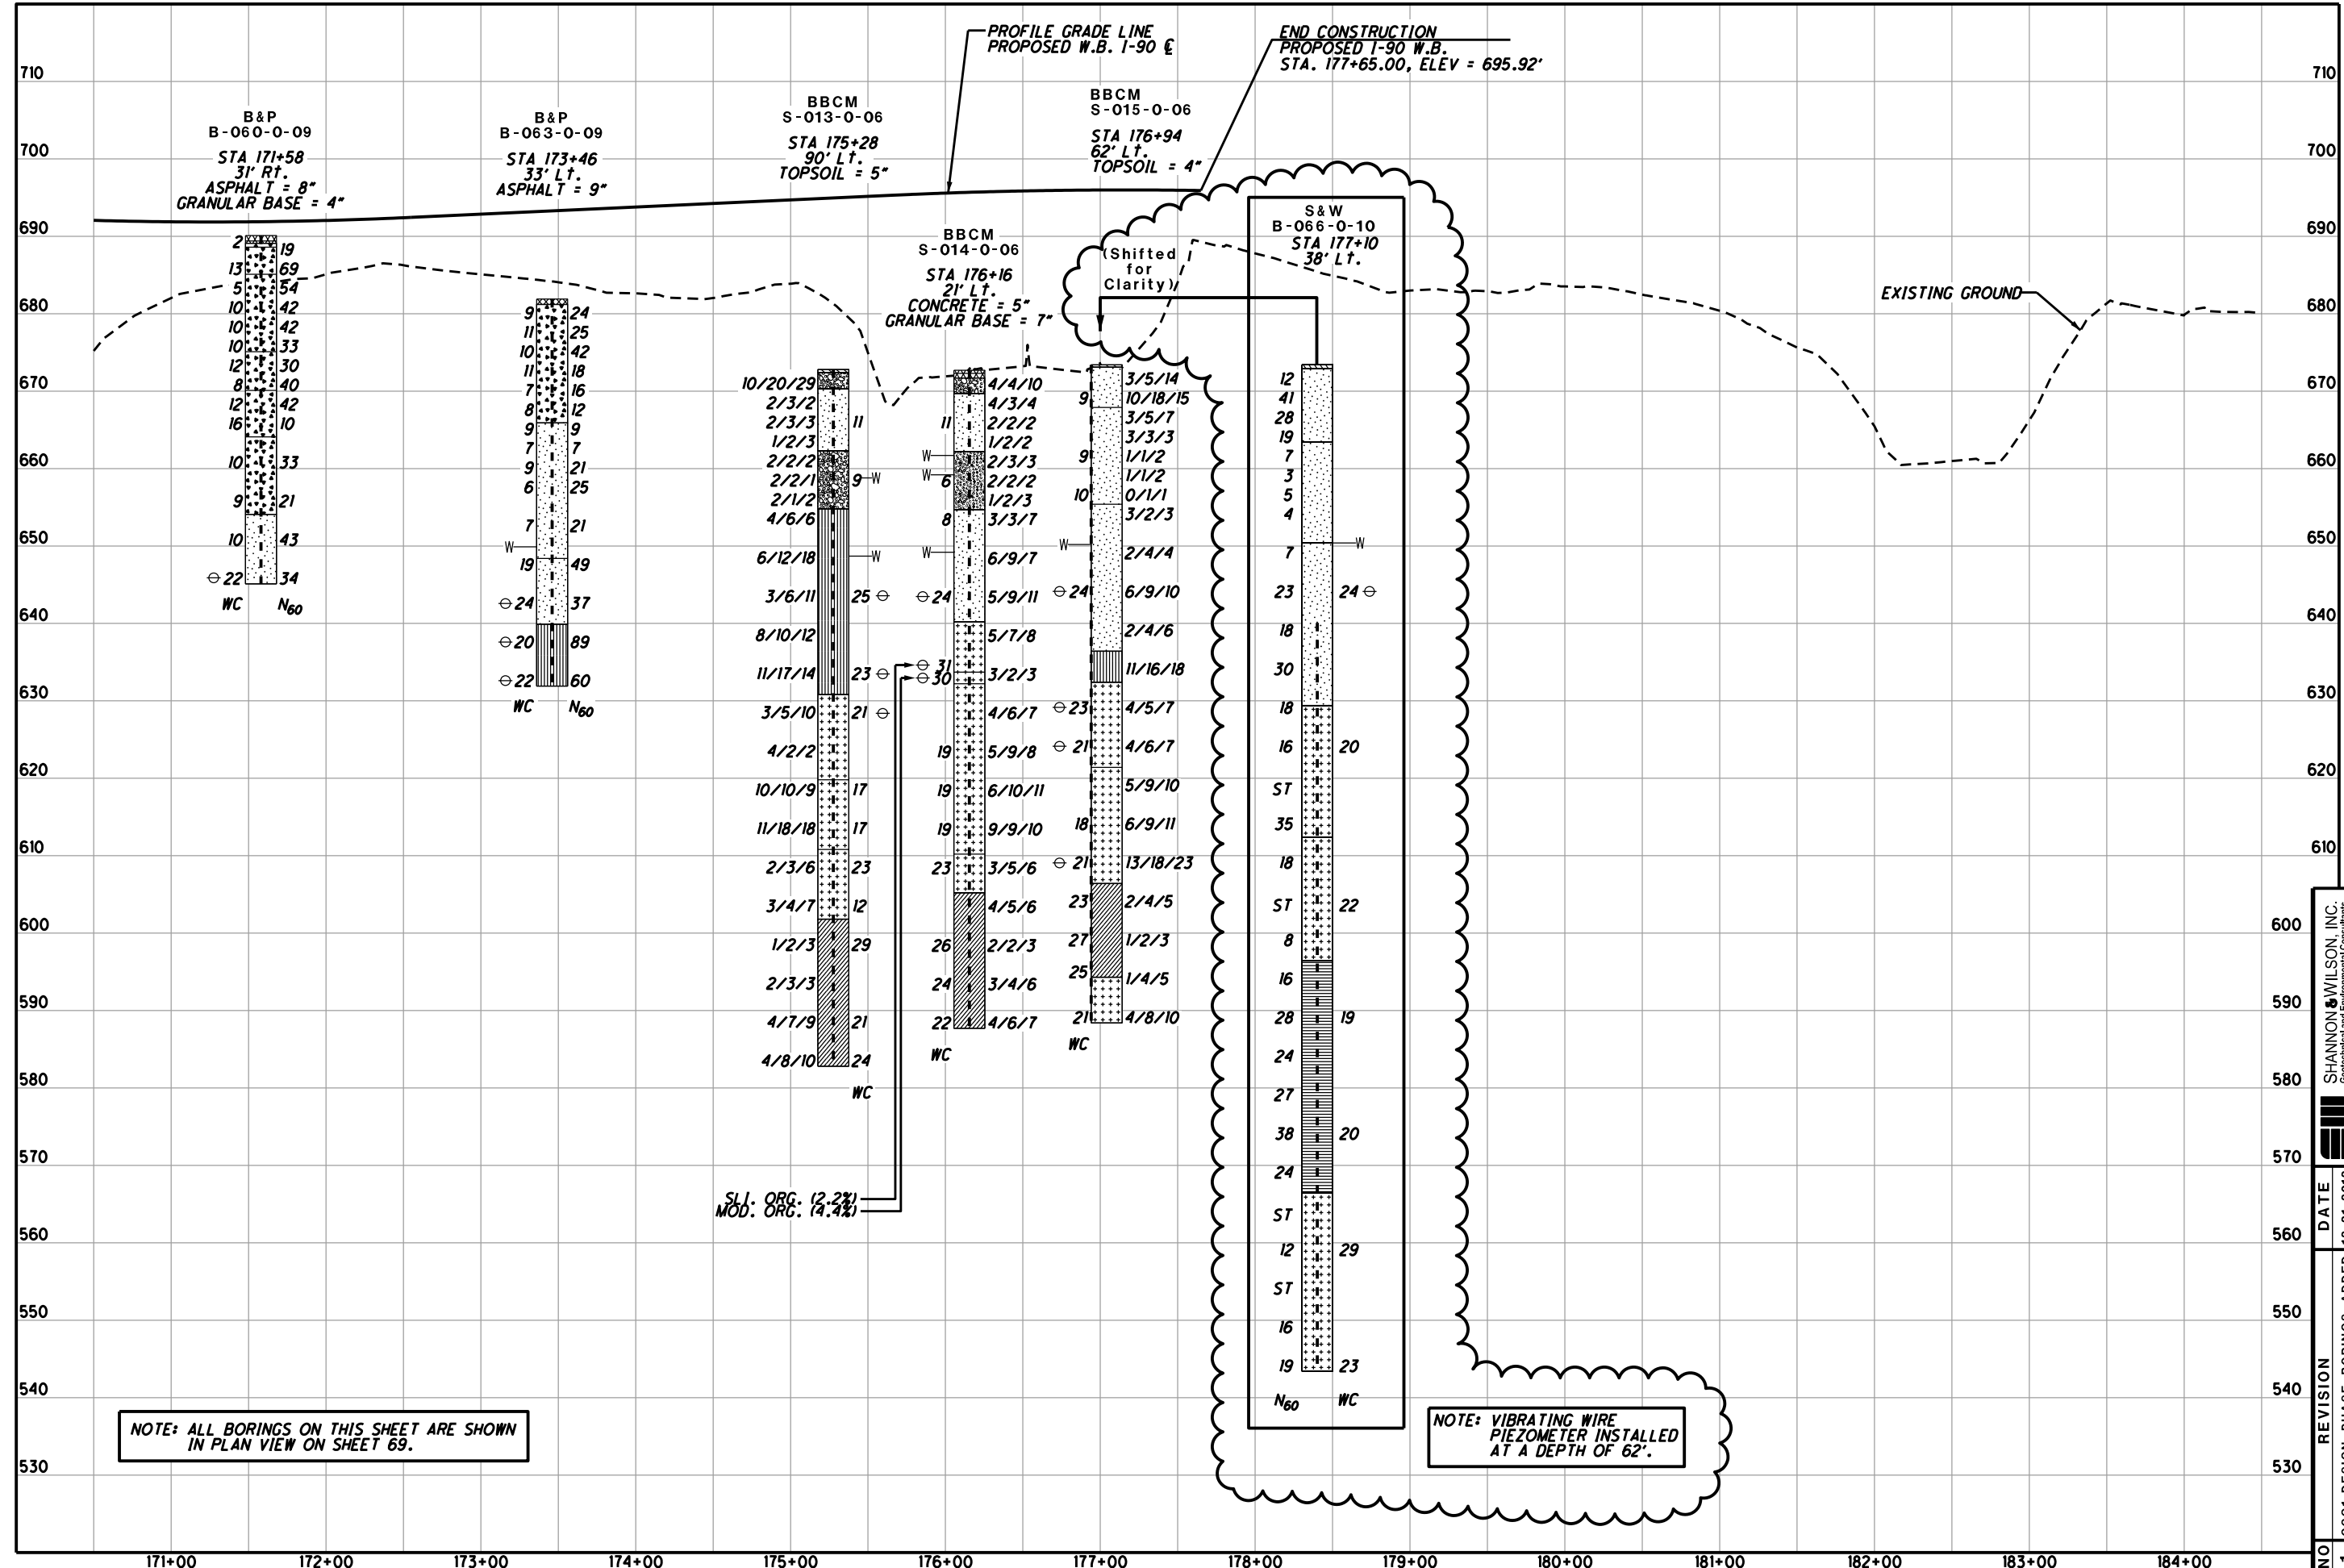

171+00 172+00 173+00 174+00 175+00 176+00 177+00 178+00 179+00 180+00 181+00 182+00 183+00 184+00

NO. 1

REVISION

DATE 12-21-2012

CCGT DESIGN PHASE BORINGS ADDED

SHANNON & WILSON, INC.

Geotechnical and Environmental Consultants

CUY-90-14.52

70 / 114

SOIL PROFILE - W.B. I-90


STA. 170+50 TO STA. 177+65

HORIZONTAL SCALE

IN FEET

0 50 100


BBCM

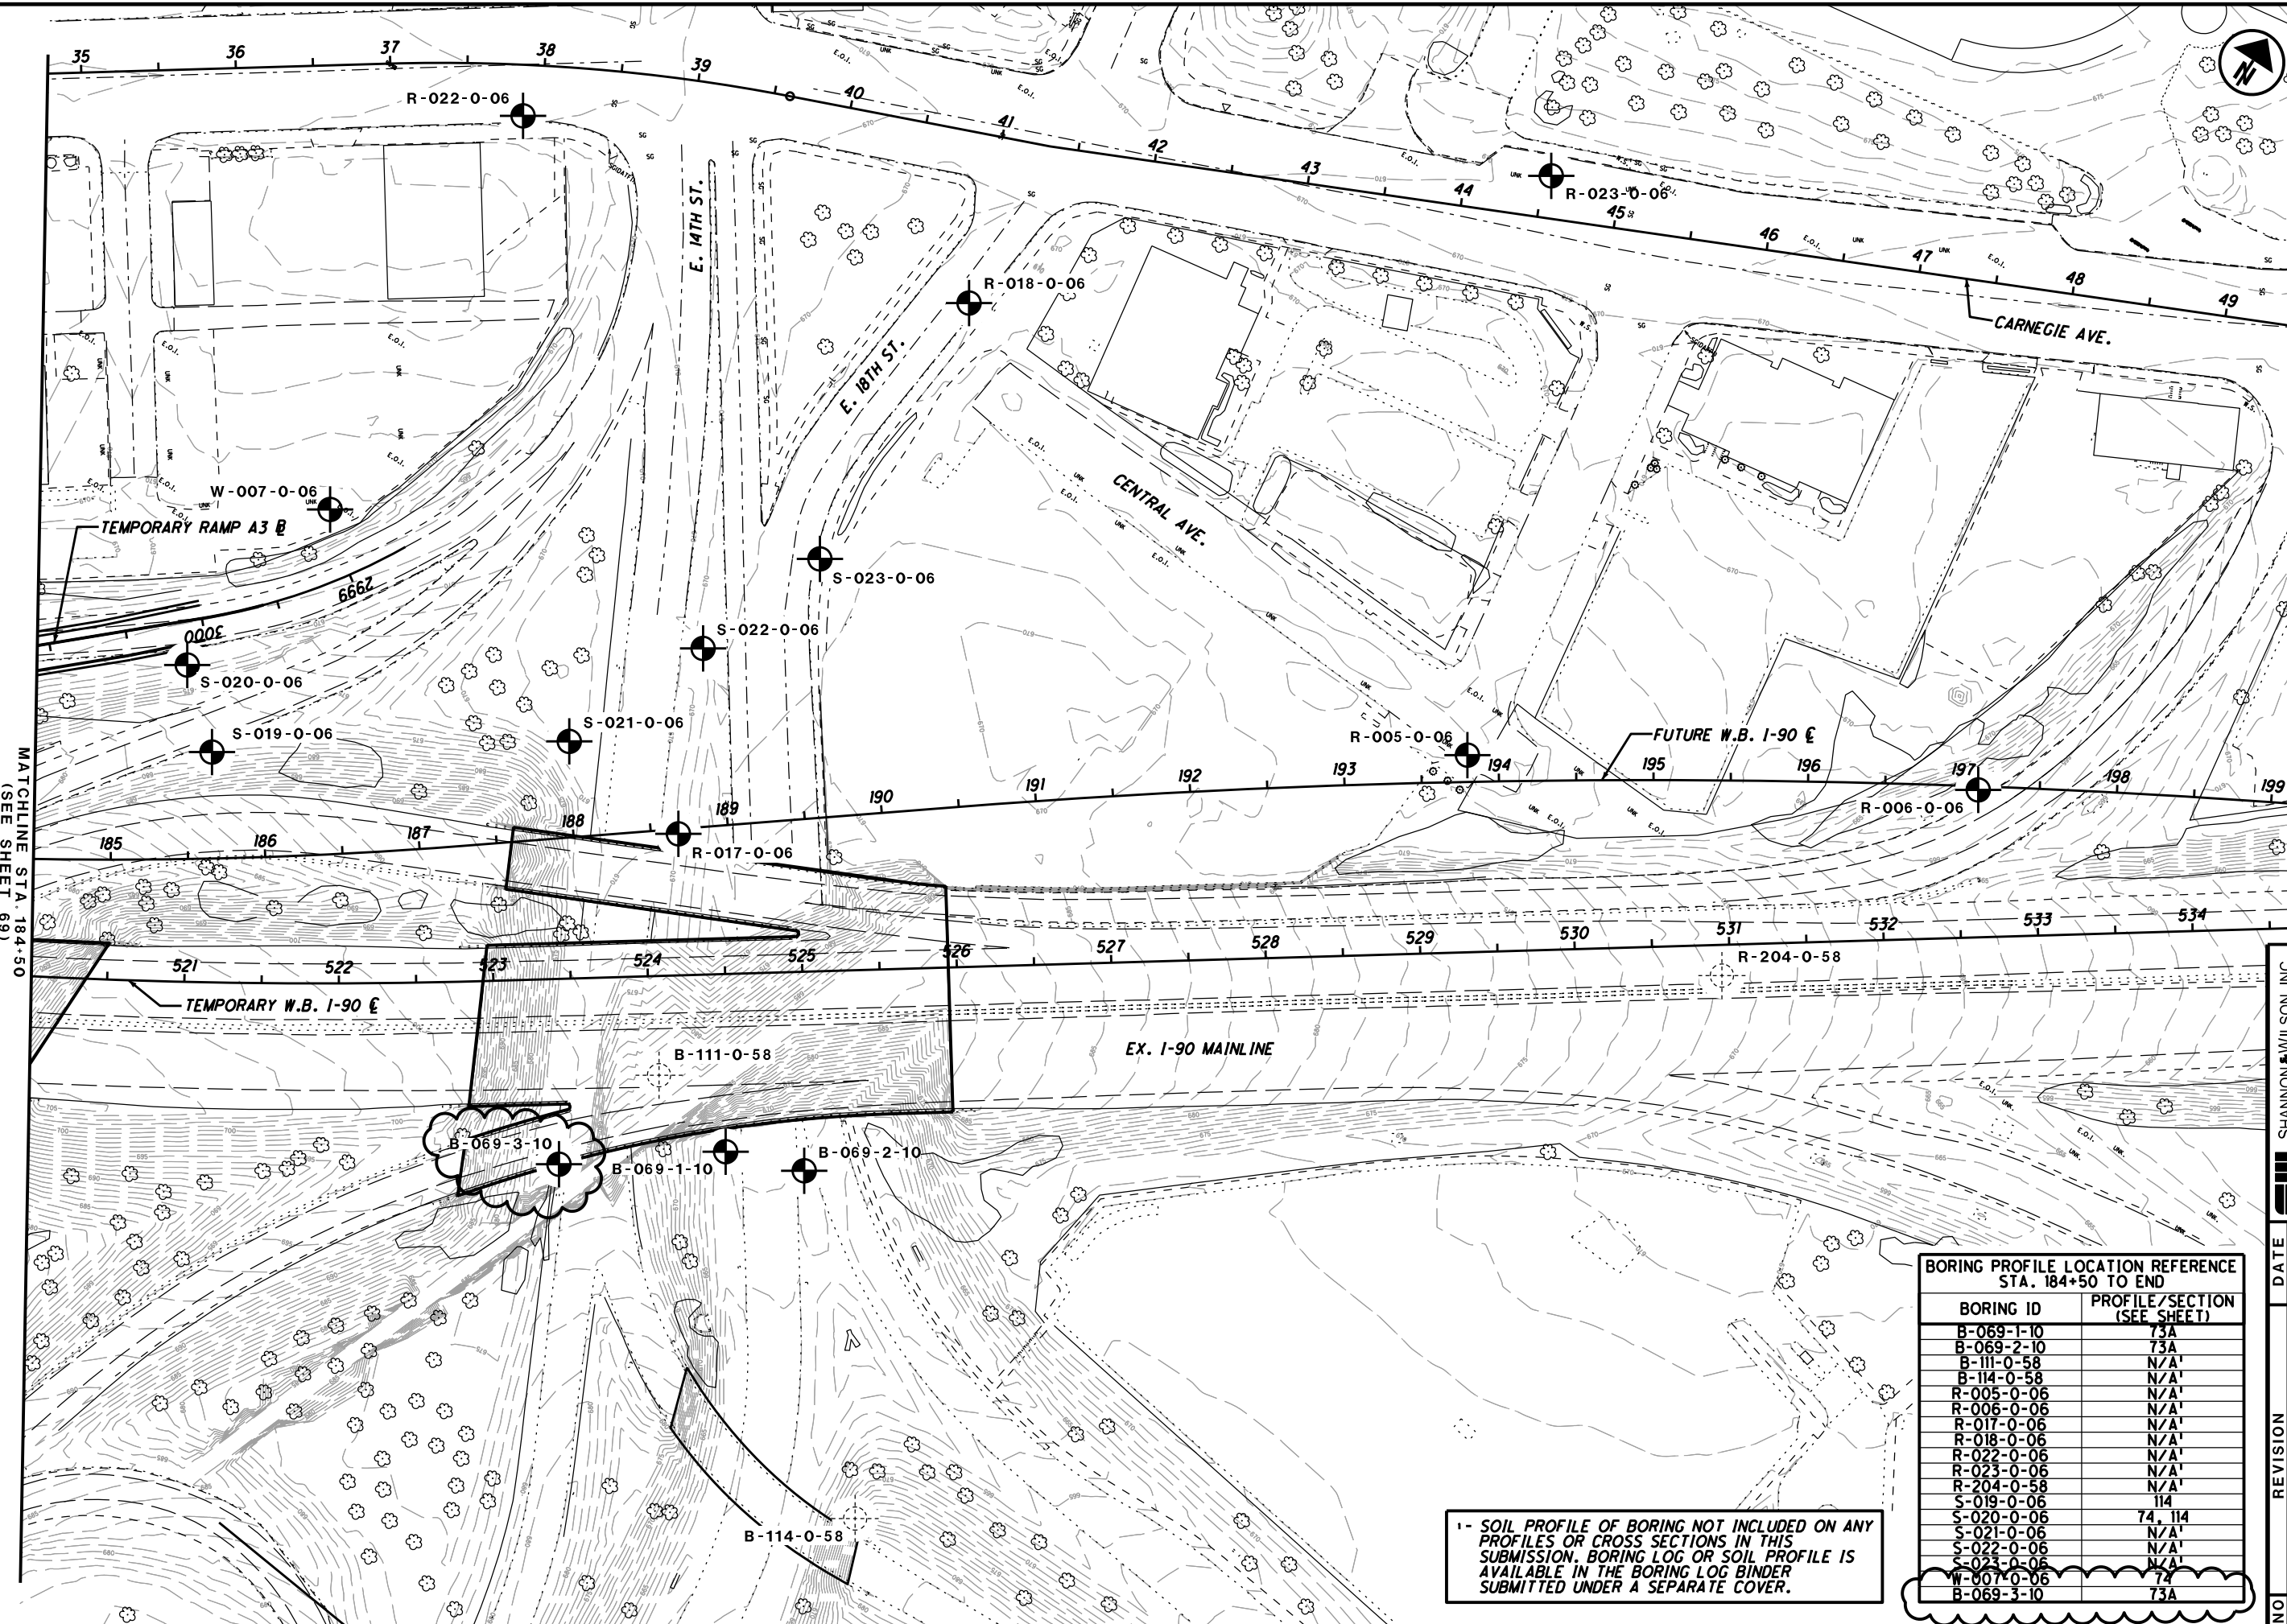

MATCHLINE STA. 184+50  
(SEE SHEET 69)

BORING PROFILE LOCATION REFERENCE STA. 184+50 TO END	
BORING ID	PROFILE / SECTION (SEE SHEET)
B-069-1-10	73A
B-069-2-10	73A
B-111-0-58	N/A
B-114-0-58	N/A
R-005-0-06	N/A
R-006-0-06	N/A
R-017-0-06	N/A
R-018-0-06	N/A
R-022-0-06	N/A
R-023-0-06	N/A
R-204-0-58	N/A
S-019-0-06	114
S-020-0-06	74, 114
S-021-0-06	N/A
S-022-0-06	N/A
S-023-0-06	N/A
W-007-0-06	74
B-069-3-10	73A

1 - SOIL PROFILE OF BORING NOT INCLUDED ON ANY PROFILES OR CROSS SECTIONS IN THIS SUBMISSION. BORING LOG OR SOIL PROFILE IS AVAILABLE IN THE BORING LOG BINDER SUBMITTED UNDER A SEPARATE COVER.

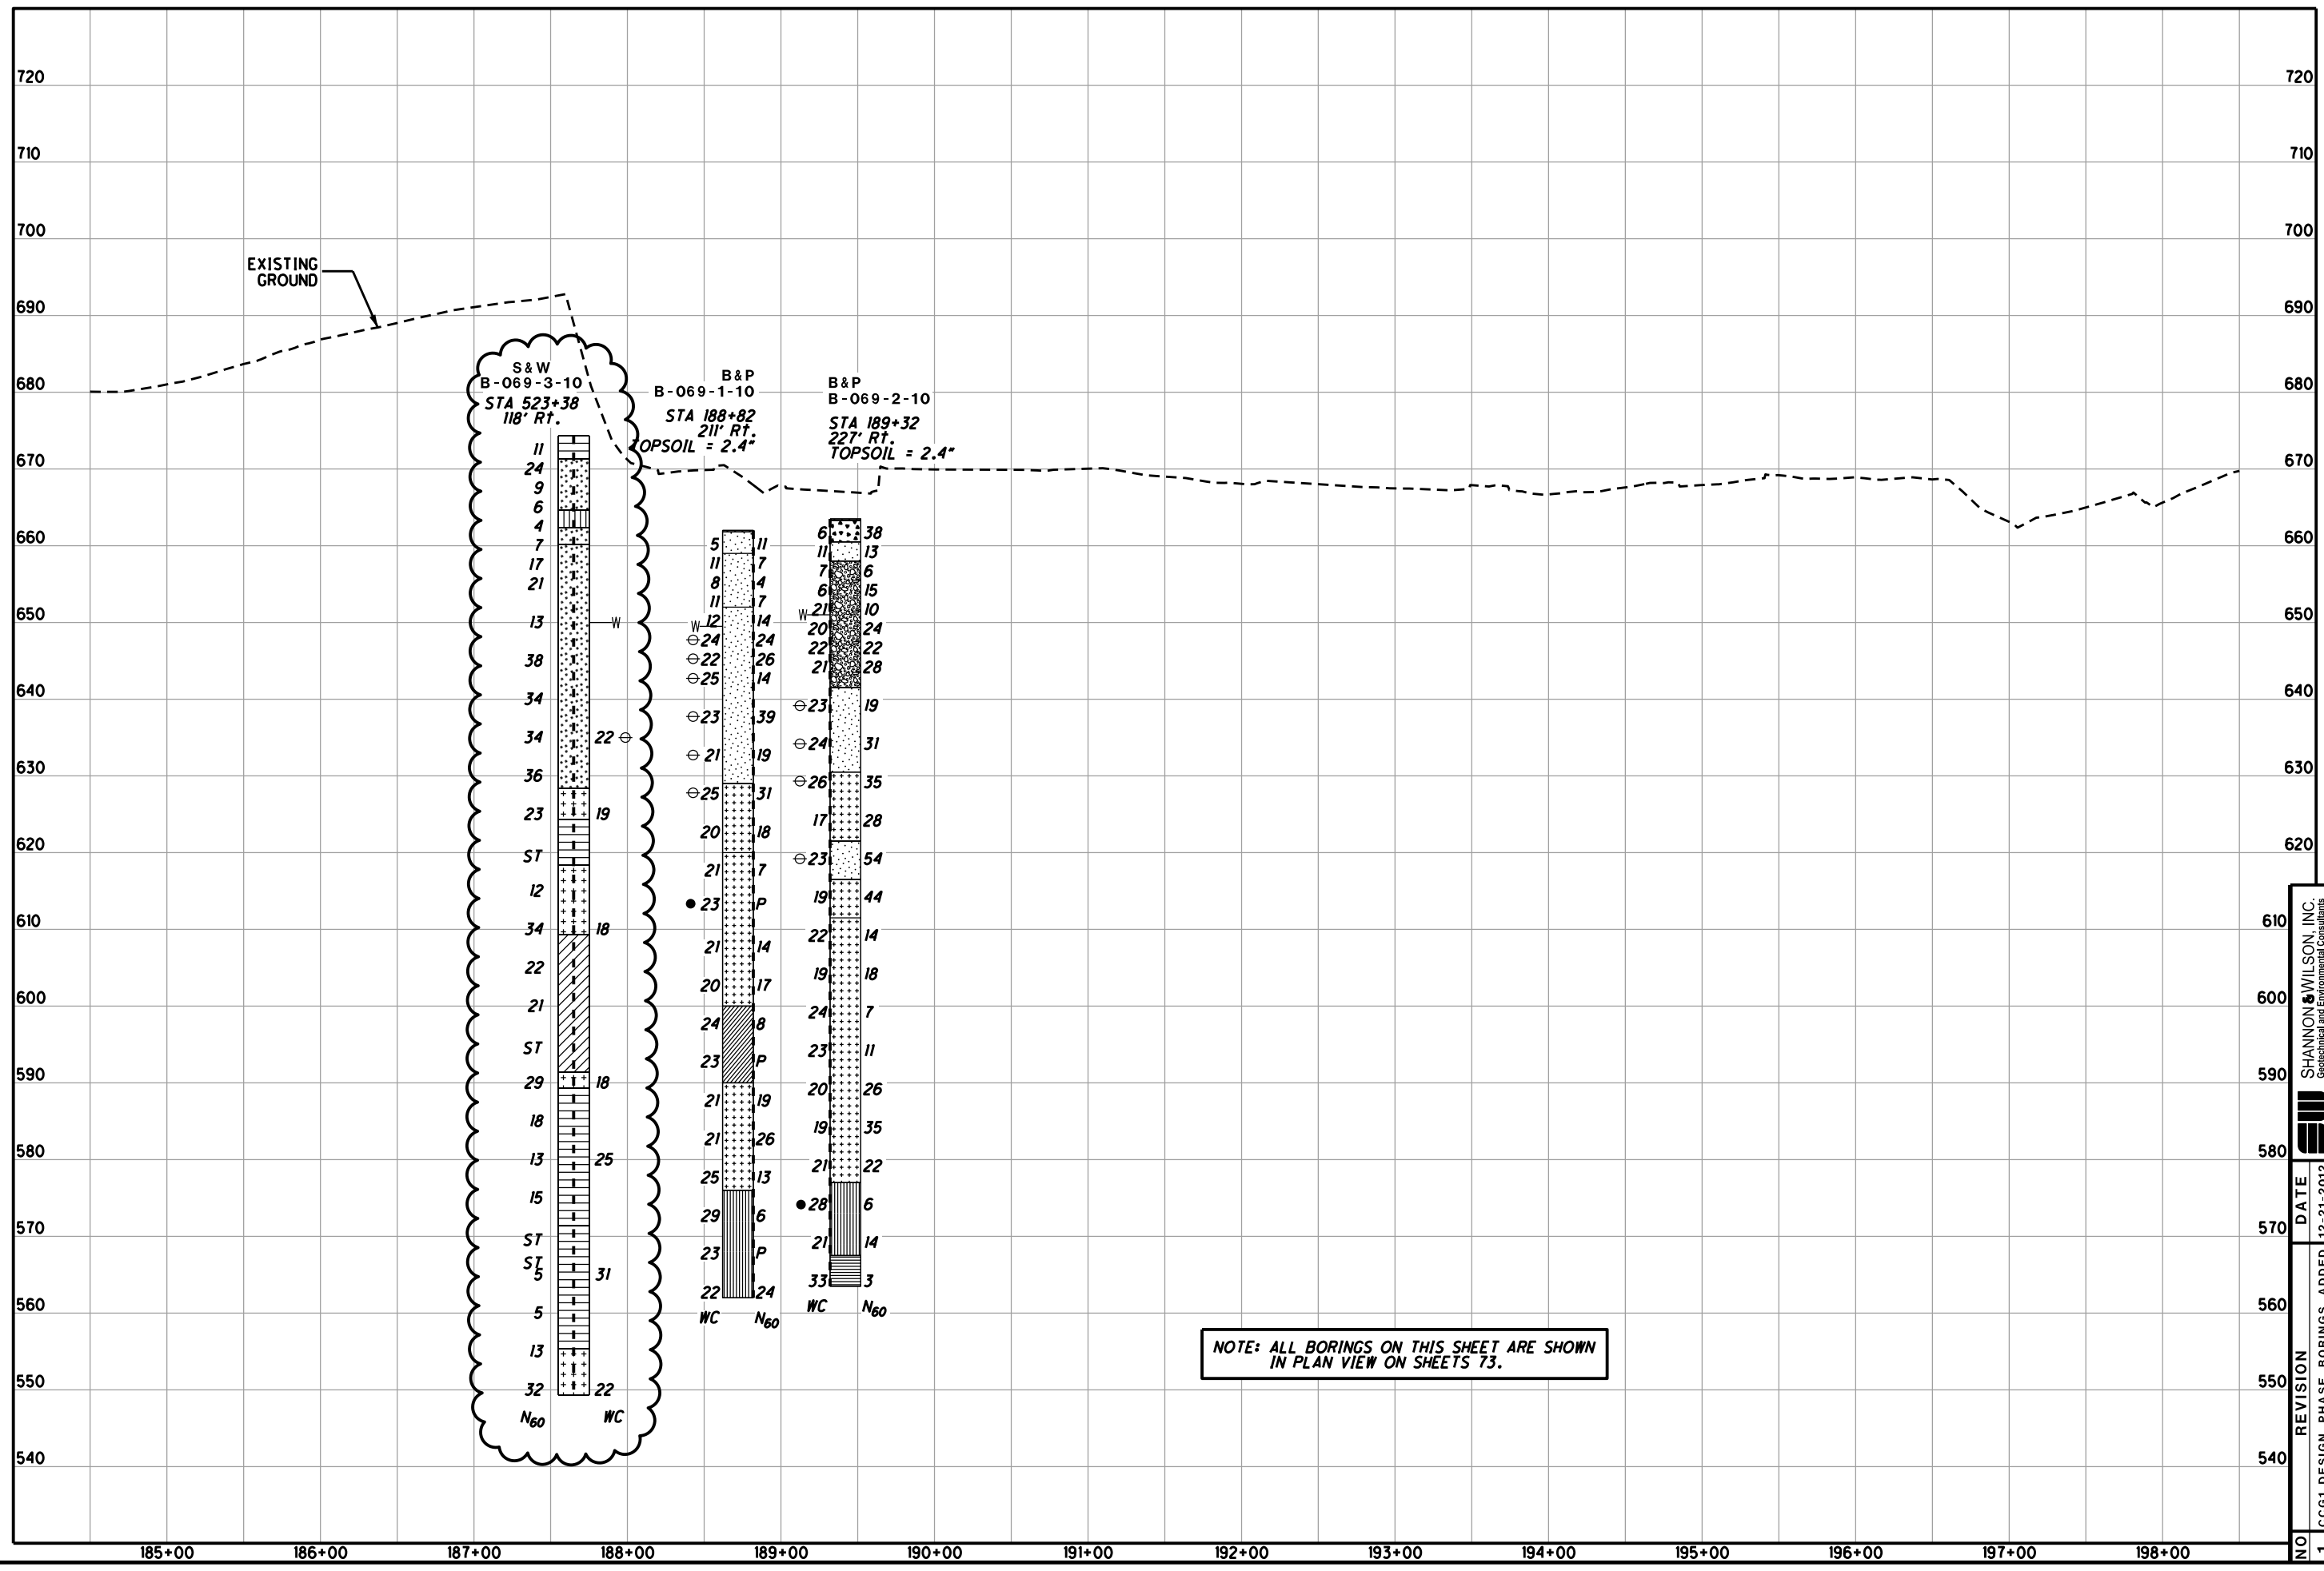

NOTE: ALL BORINGS ON THIS SHEET ARE SHOWN IN PLAN VIEW ON SHEETS 73.

SHANNON & WILSON, INC. 12/21/2012 12:00 PM  



HORIZONTAL SCALE  
IN FEET  
0 50 100


SOIL PROFILE - E. 9TH ST.  
STA. 11+54.79 TO STA 25+50

SHANNON & WILSON, INC.  
Geotechnical and Environmental Consultants

NO	REVISION	DATE
1	CCGT DESIGN PHASE BORINGS ADDED	12-21-2012

CUY-90-14.52


75 / 114

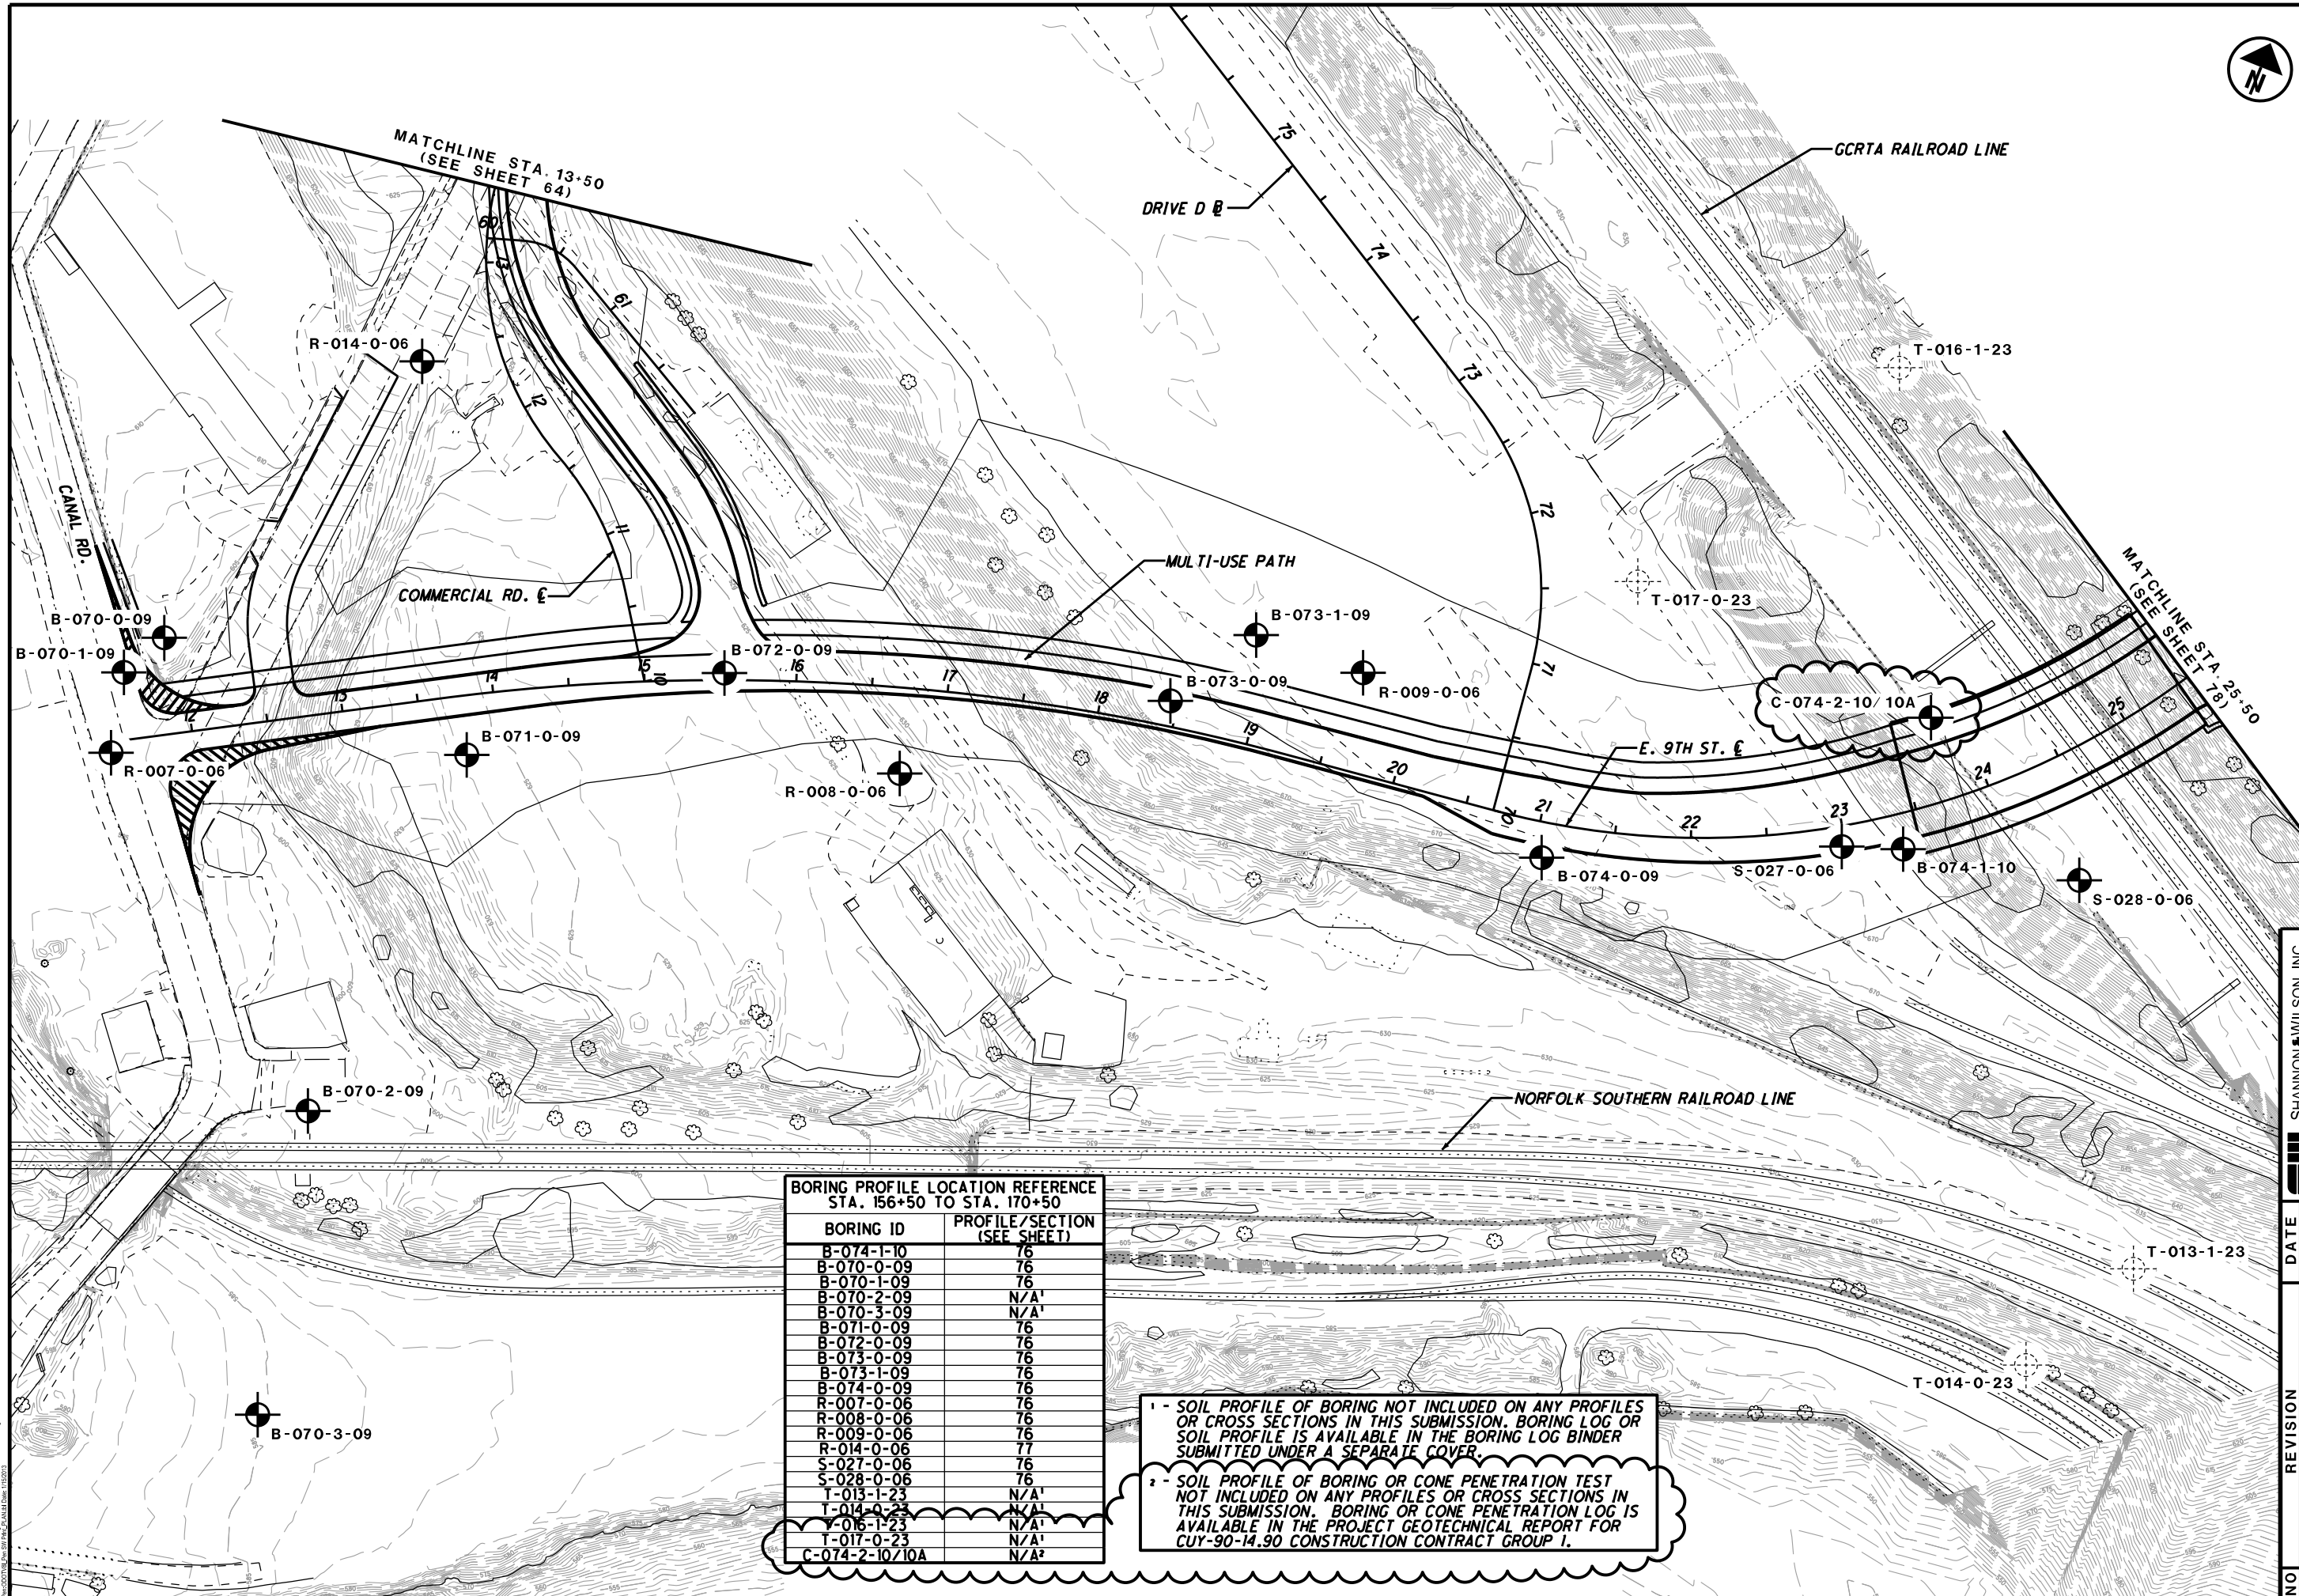

BORING PROFILE LOCATION REFERENCE STA. 156+50 TO STA. 170+50	
BORING ID	PROFILE/SECTION (SEE SHEET)
B-074-1-10	76
B-070-0-09	76
B-070-1-09	76
B-070-2-09	N/A <sup>1</sup>
B-070-3-09	N/A <sup>1</sup>
B-071-0-09	76
B-072-0-09	76
B-073-0-09	76
B-073-1-09	76
B-074-0-09	76
R-007-0-06	76
R-008-0-06	76
R-009-0-06	76
R-014-0-06	77
S-027-0-06	76
S-028-0-06	76
T-013-1-23	N/A <sup>1</sup>
T-014-0-23	N/A <sup>1</sup>
T-016-1-23	N/A <sup>1</sup>
T-017-0-23	N/A <sup>1</sup>
C-074-2-10/10A	N/A <sup>2</sup>

<sup>1</sup> - SOIL PROFILE OF BORING NOT INCLUDED ON ANY PROFILES OR CROSS SECTIONS IN THIS SUBMISSION. BORING LOG OR SOIL PROFILE IS AVAILABLE IN THE BORING LOG BINDER SUBMITTED UNDER A SEPARATE COVER.

<sup>2</sup> - SOIL PROFILE OF BORING OR CONE PENETRATION TEST NOT INCLUDED ON ANY PROFILES OR CROSS SECTIONS IN THIS SUBMISSION. BORING OR CONE PENETRATION LOG IS AVAILABLE IN THE PROJECT GEOTECHNICAL REPORT FOR CUY-90-14.90 CONSTRUCTION CONTRACT GROUP I.

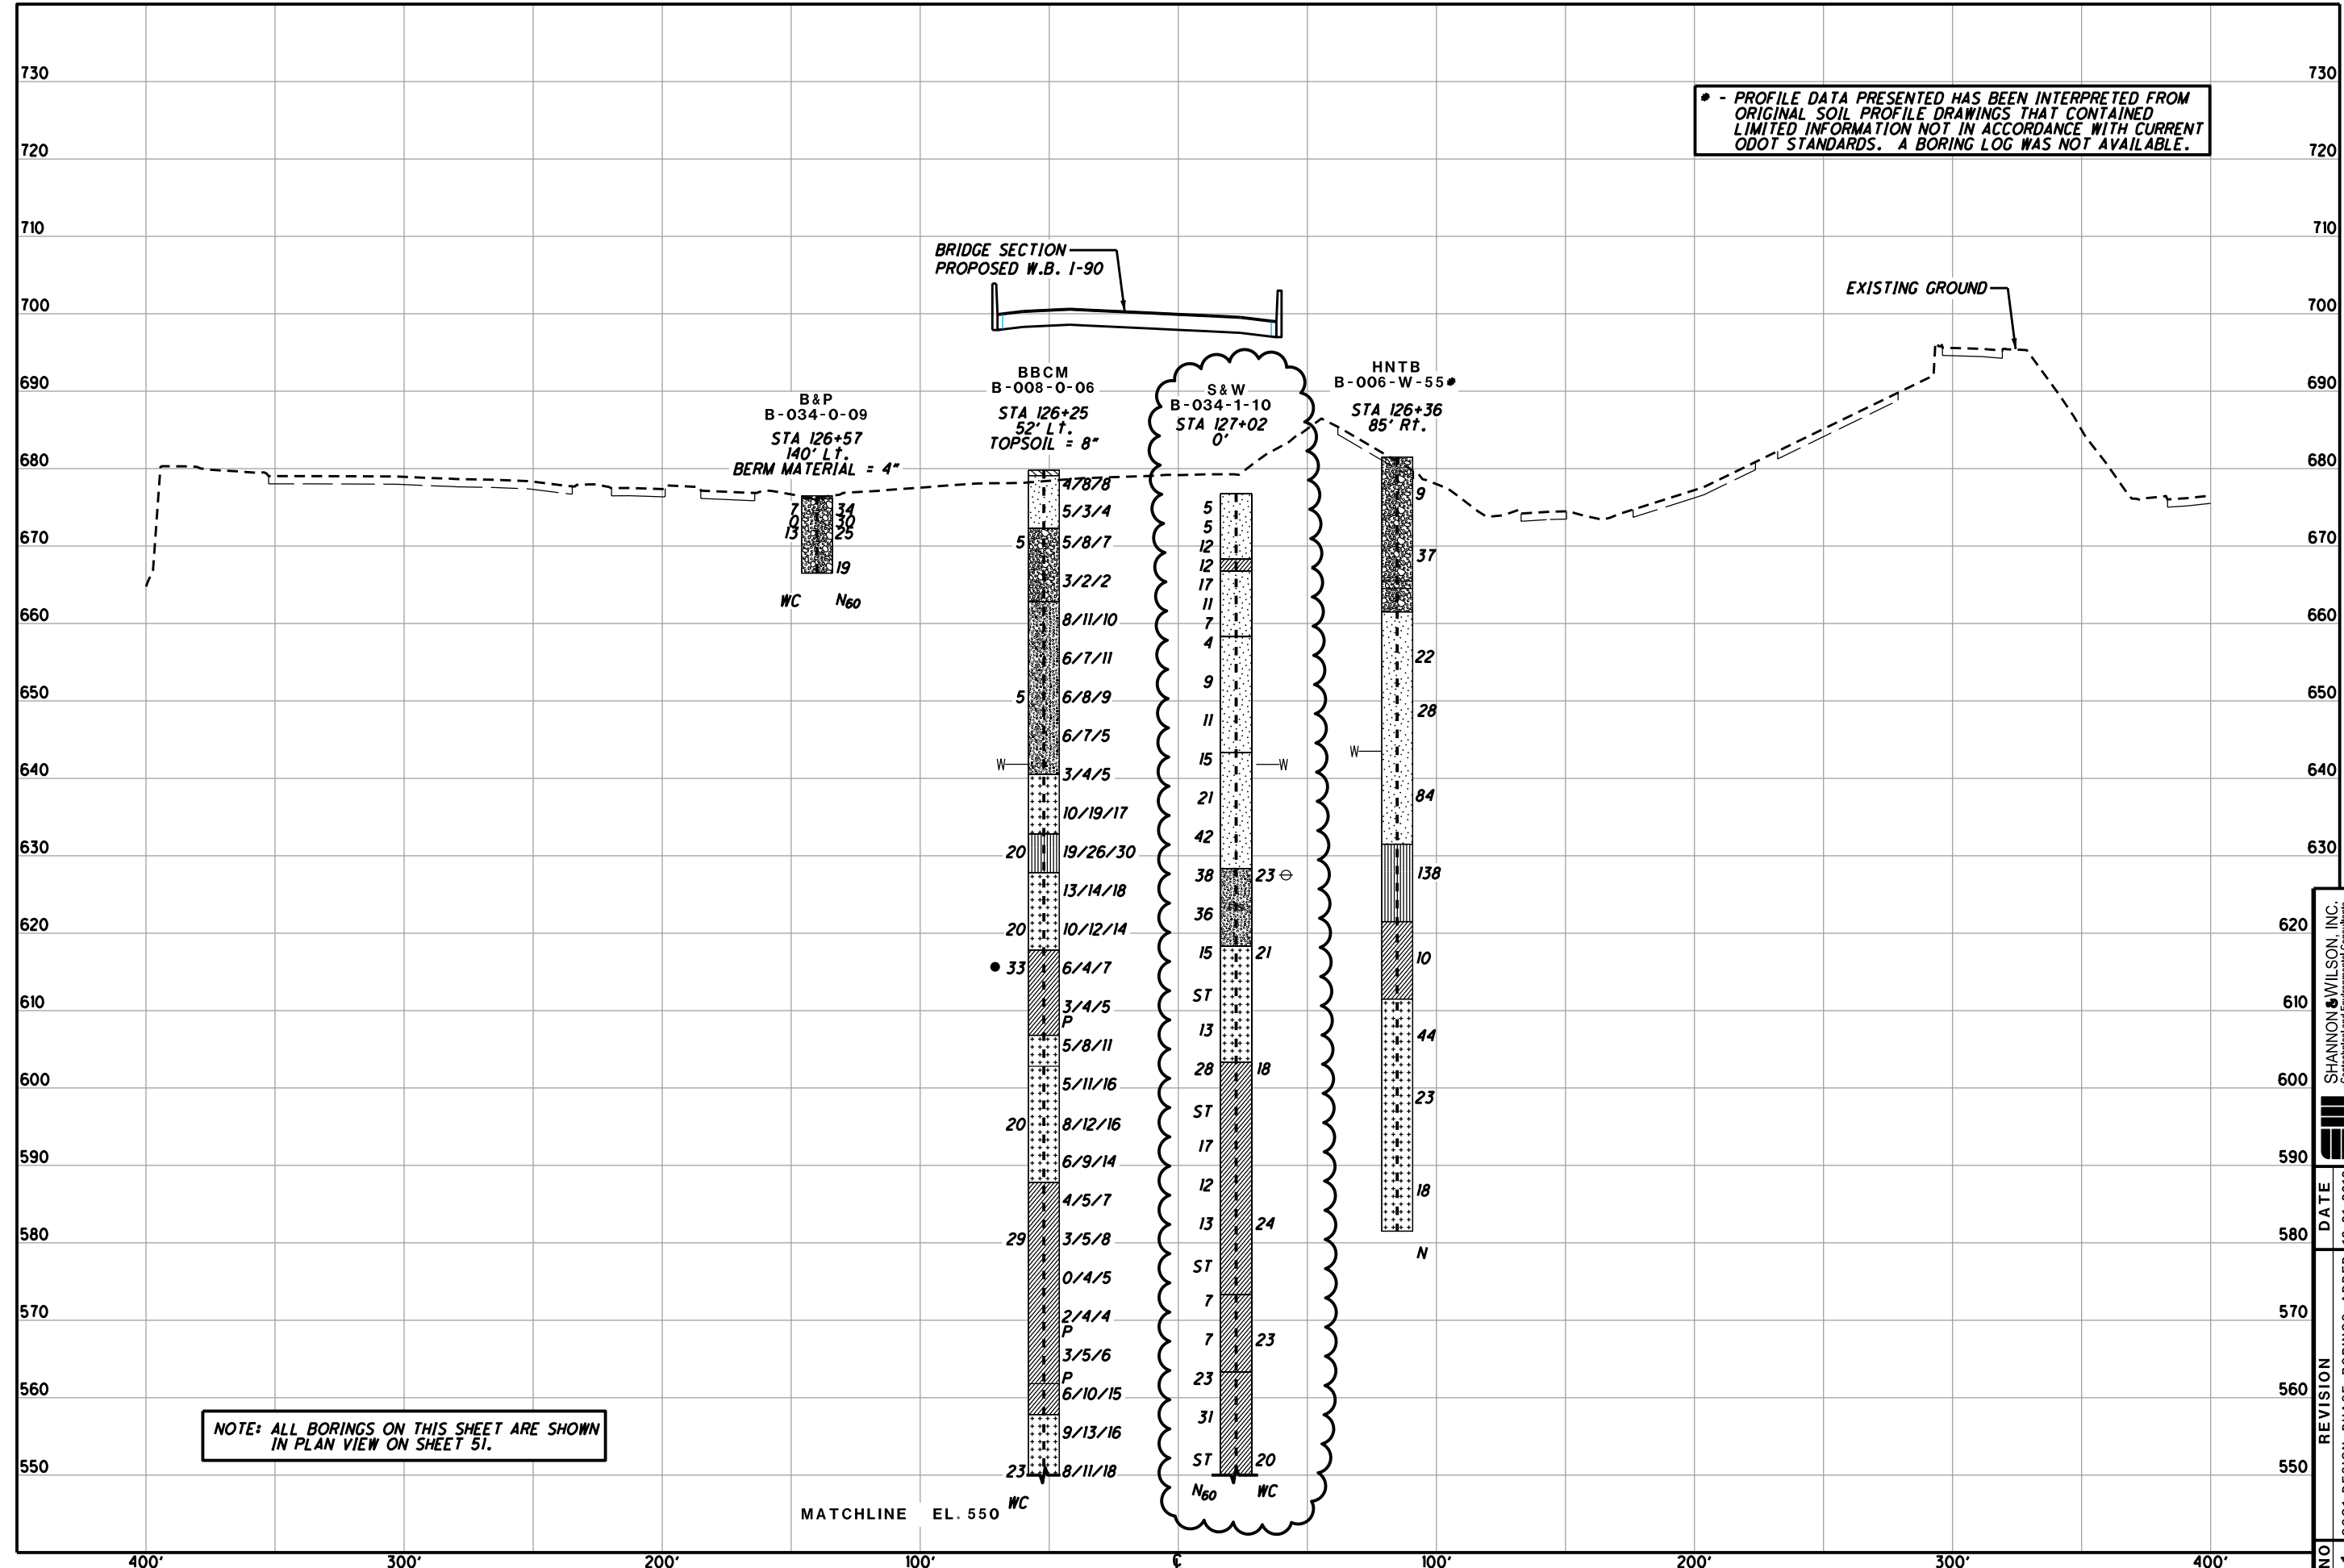




0 30 60  
HORIZONTAL SCALE  
IN FEET

SOIL PROFILE - W.B. I-90  
CROSS SECTION STA. 126+50


SHANNON & WILSON, INC.  
Geotechnical and Environmental Consultants  
**SW**

NO. 1  
REVISION  
1 CCGT DESIGN PHASE BORINGS ADDED  
DATE 12-21-2012  
CUY-90-14.90  
87/116

MATCHLINE EL. 550

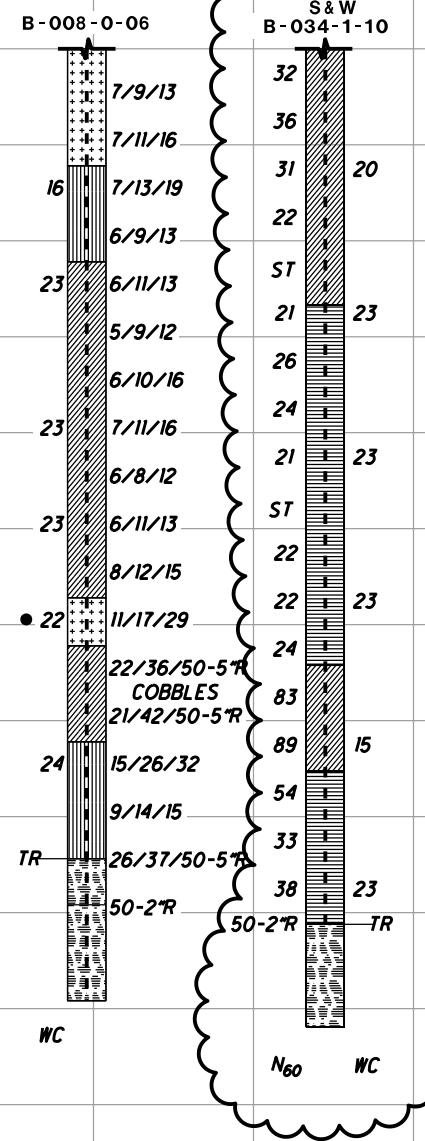



NOTE: INCLINOMETER INSTALLED TO A DEPTH OF 228'. VIBRATING WIRE PIEZOMETERS INSTALLED IN OFFSET HOLE AT DEPTHS OF 65.5' AND 110.5'.

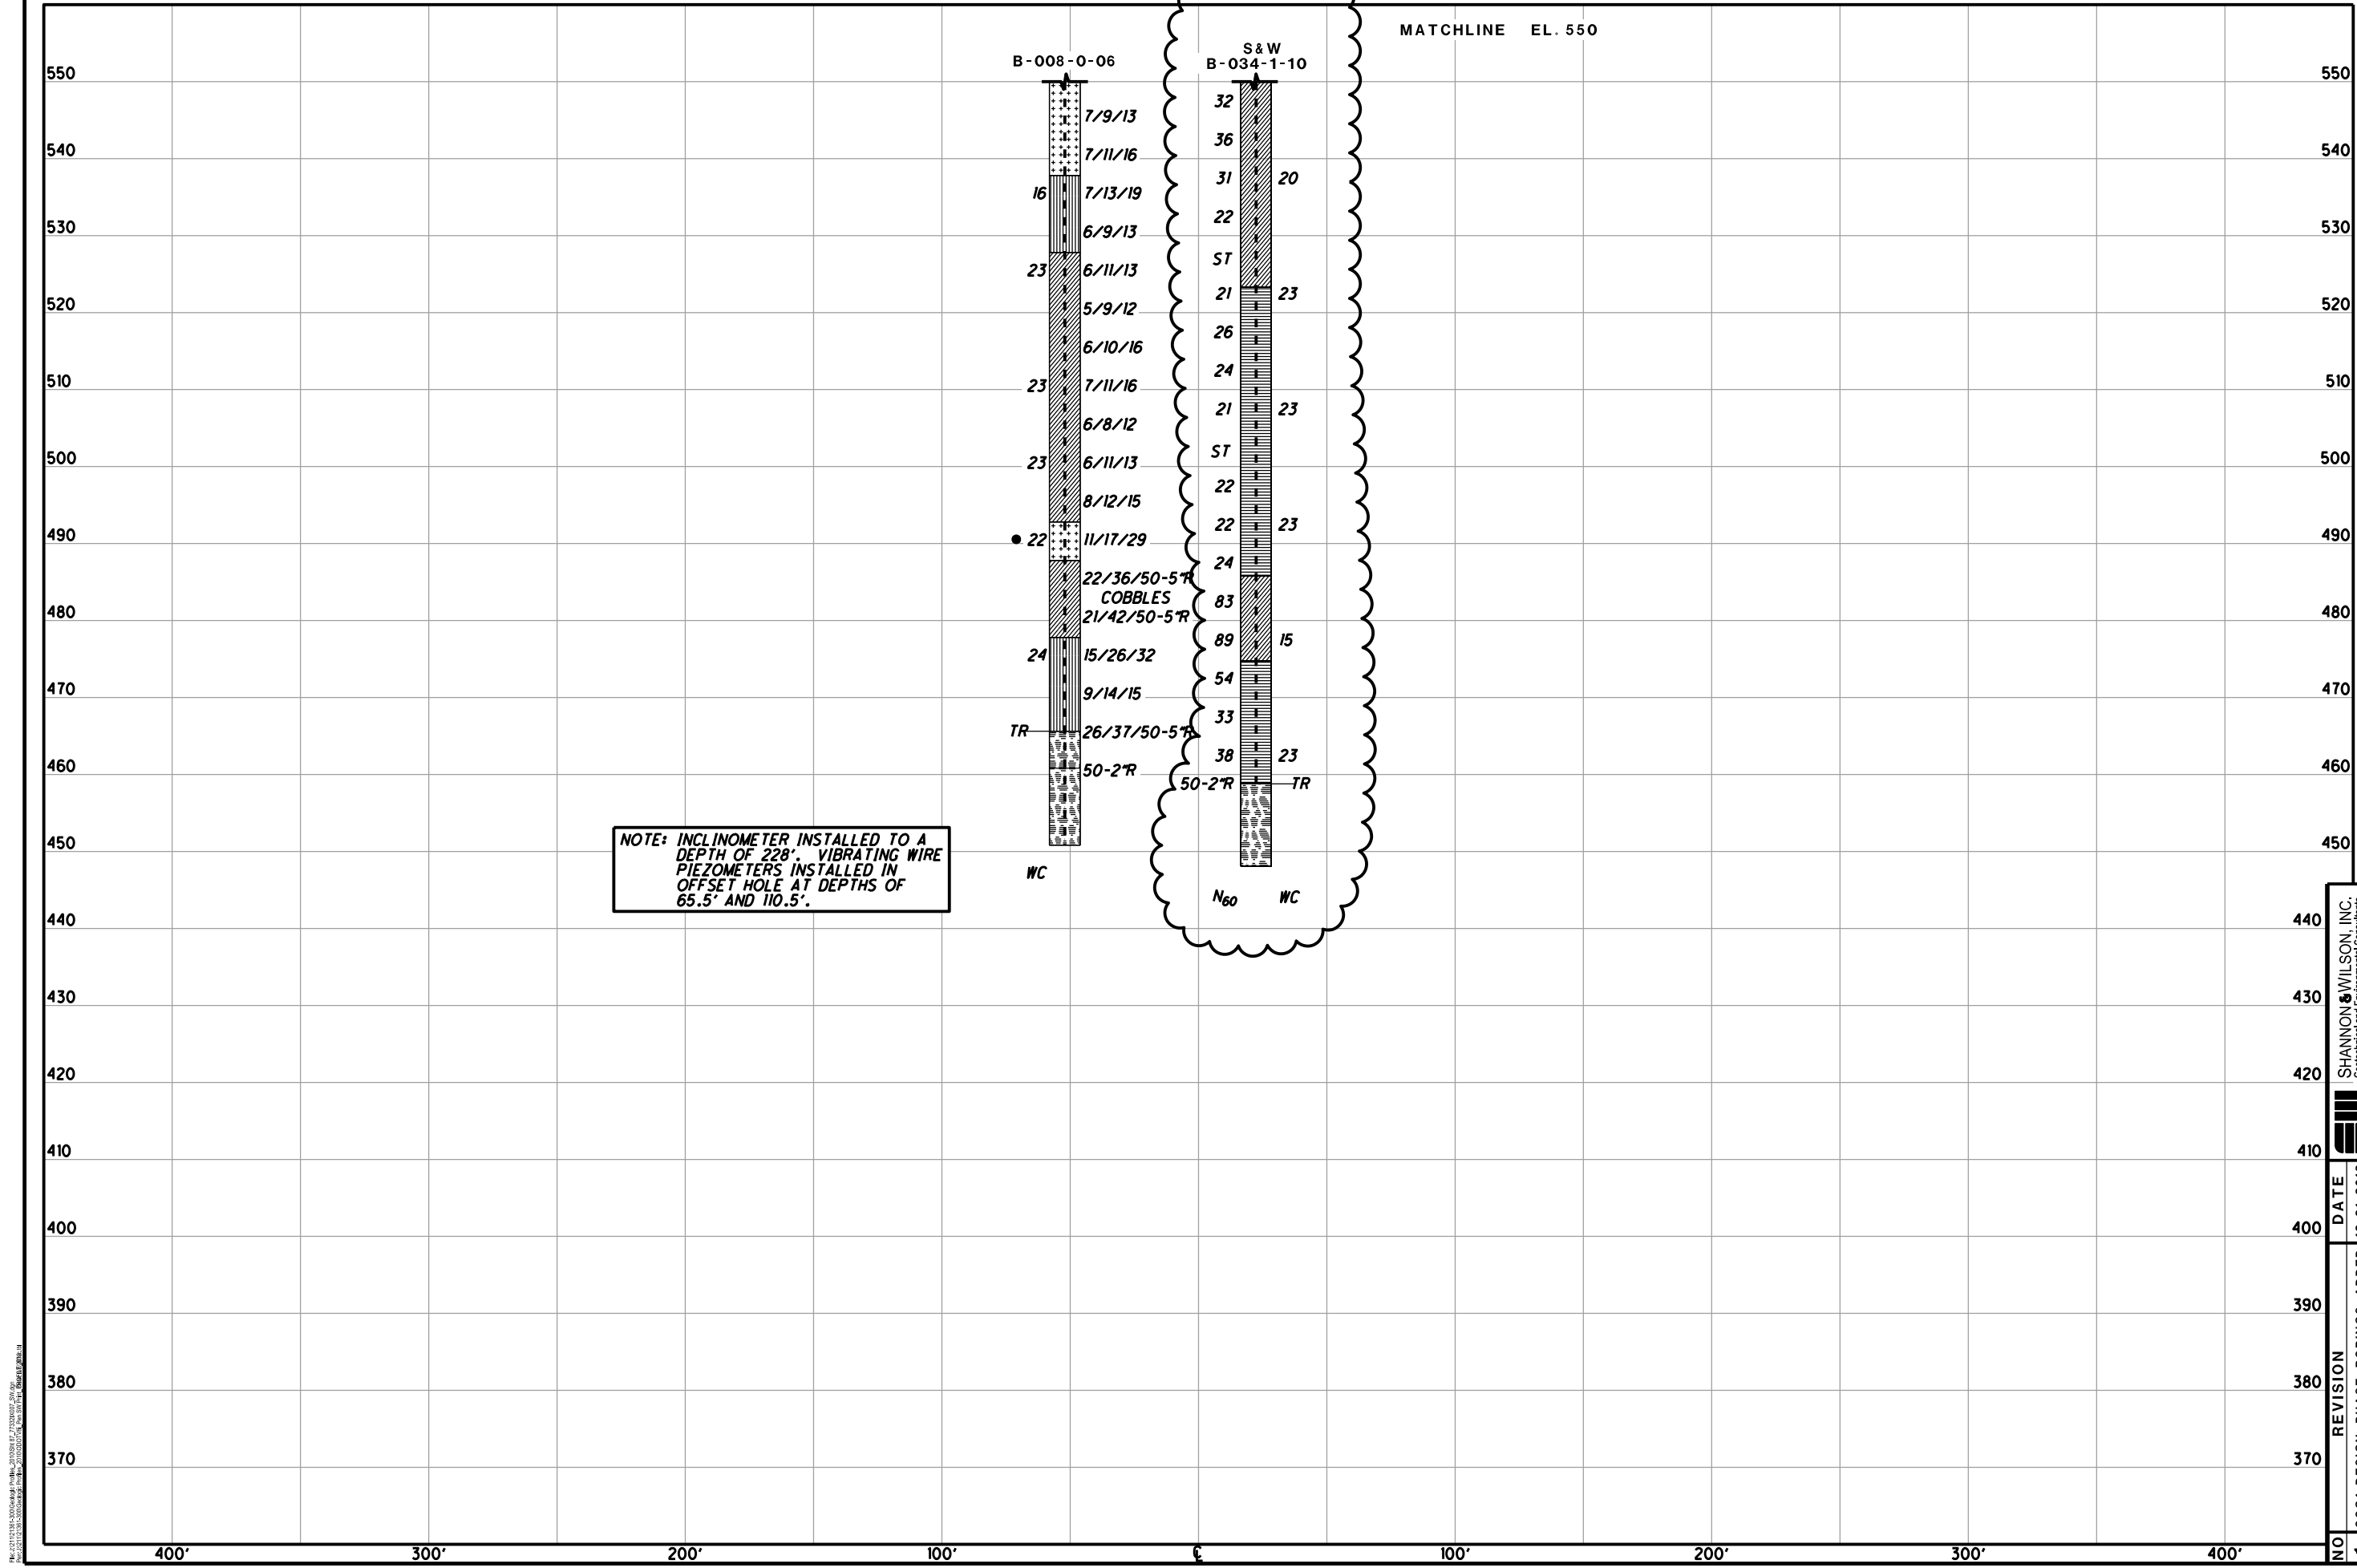

14-001713 10/16/2010 10:04:44 AM \\wms\011608\_01\_77324007\_001.dwg  
 2012/12/21 08:53:03 AM \\wms\011608\_01\_77324007\_001.dwg



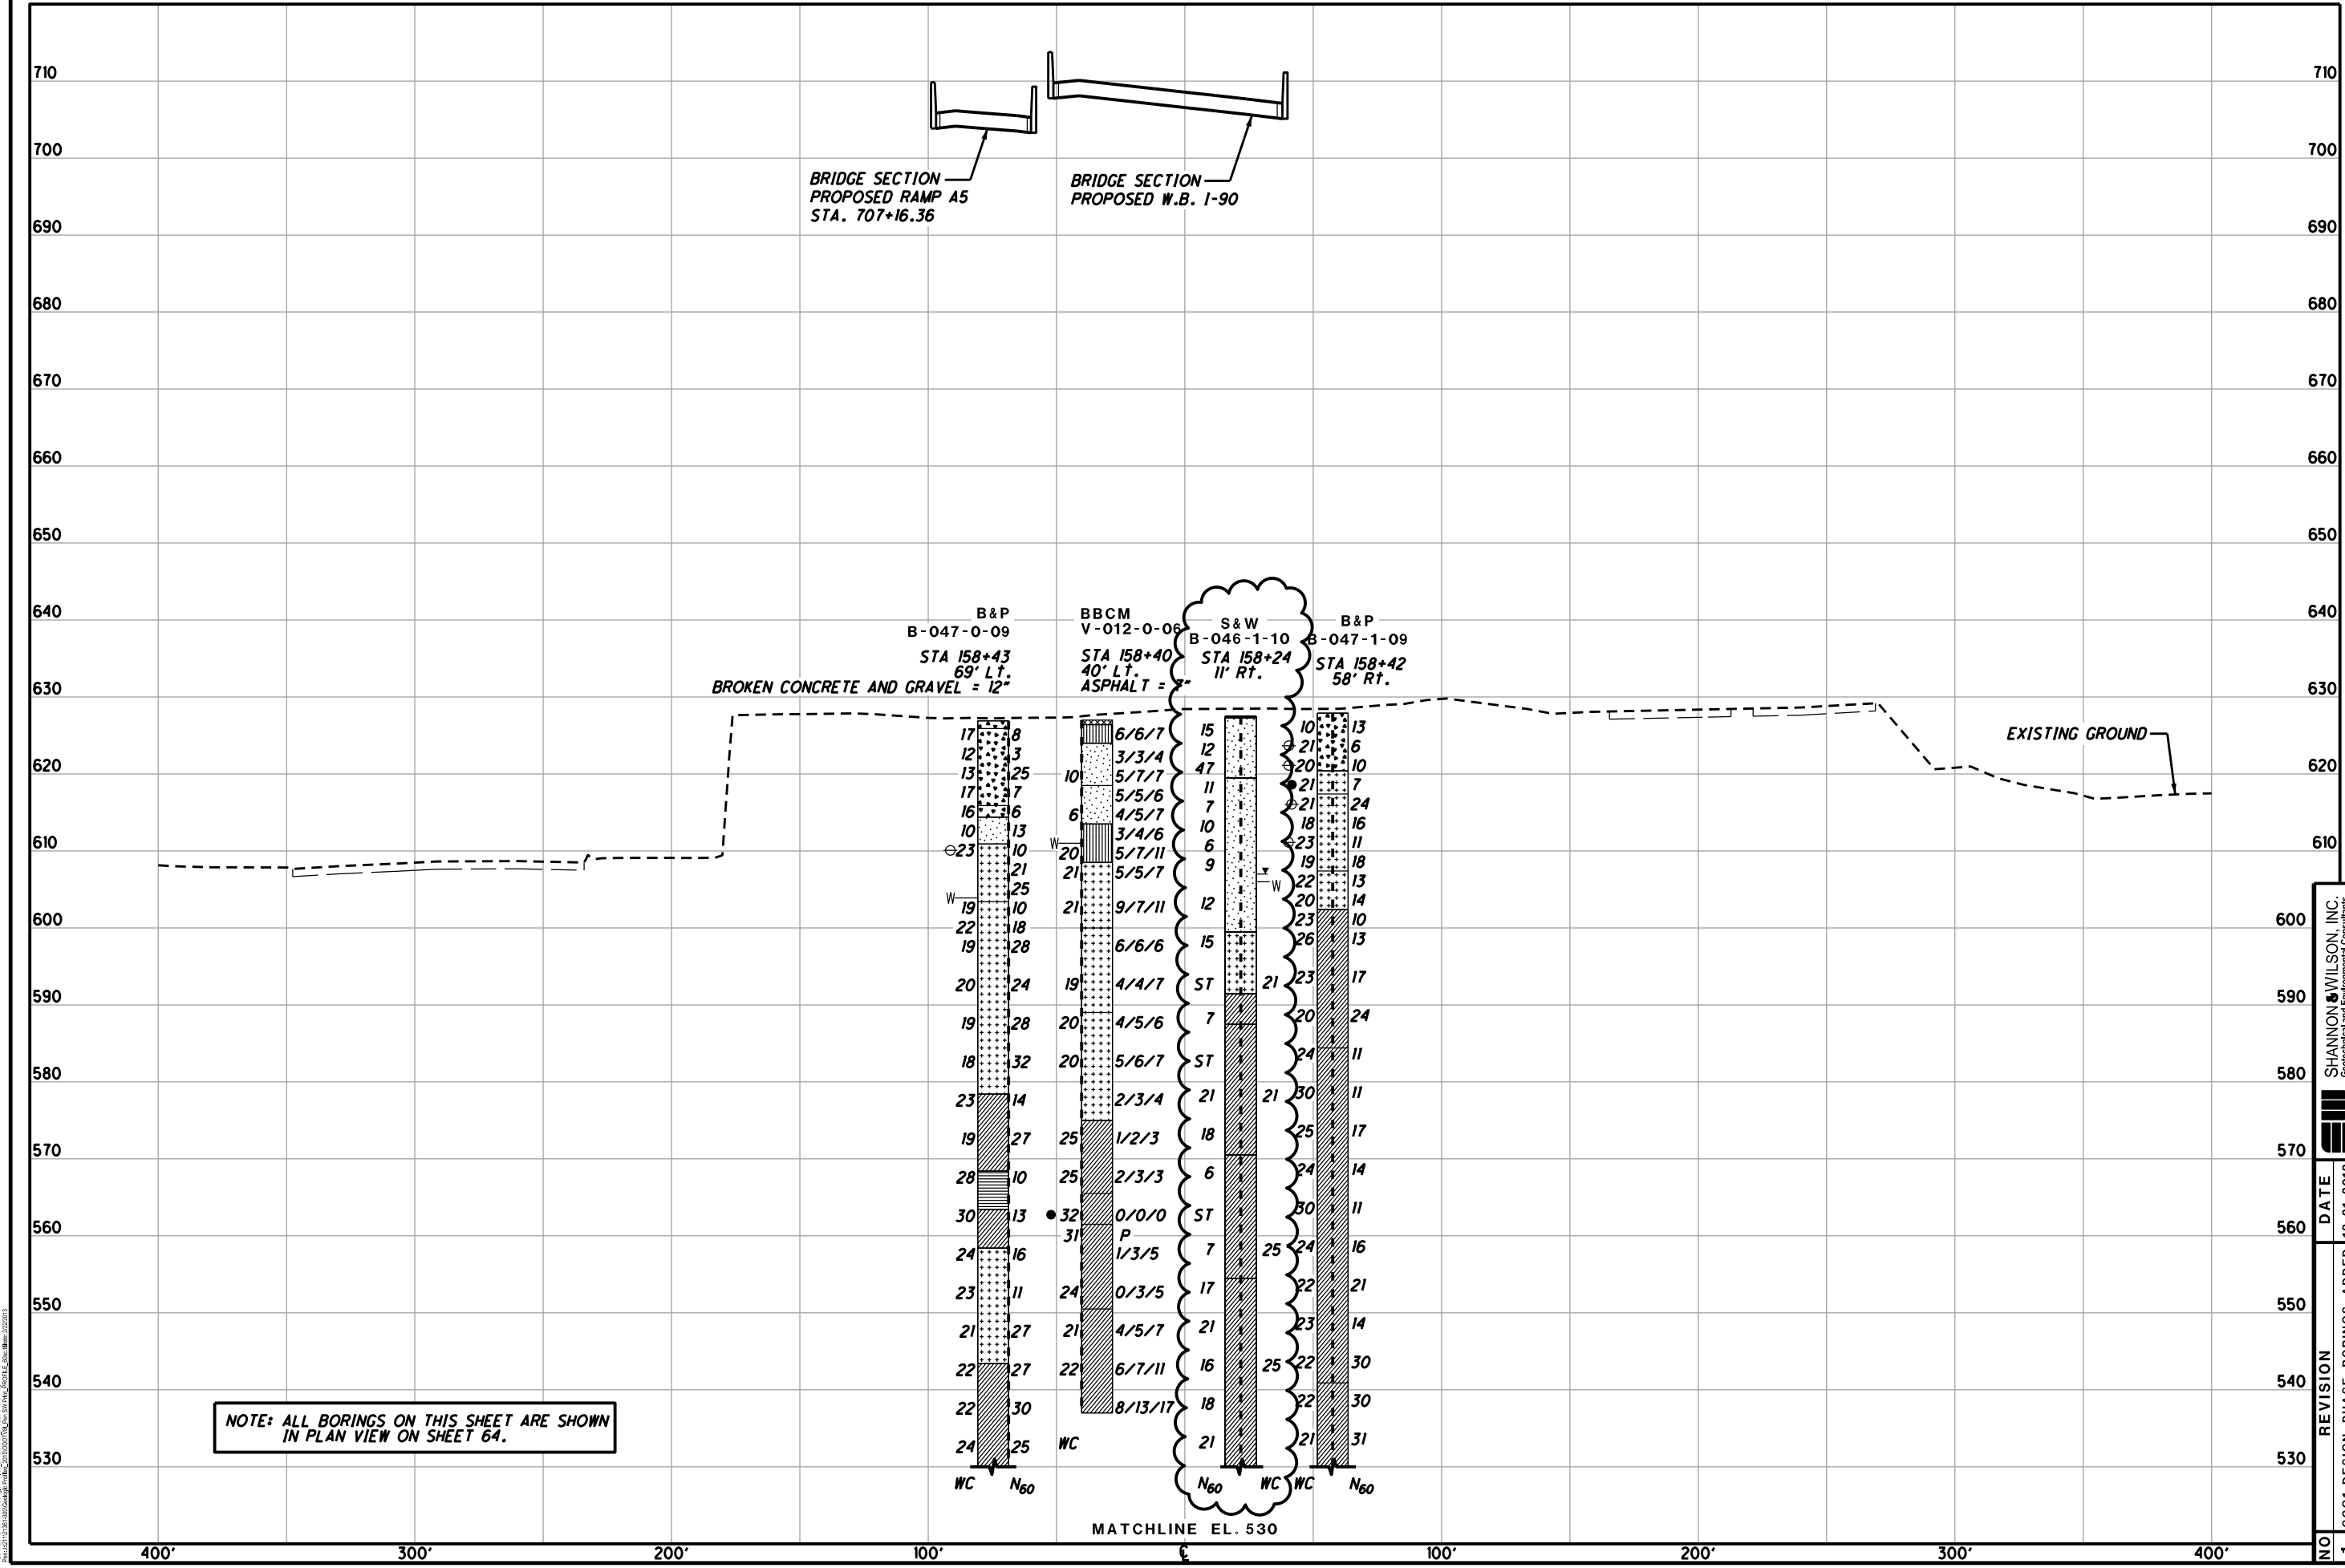

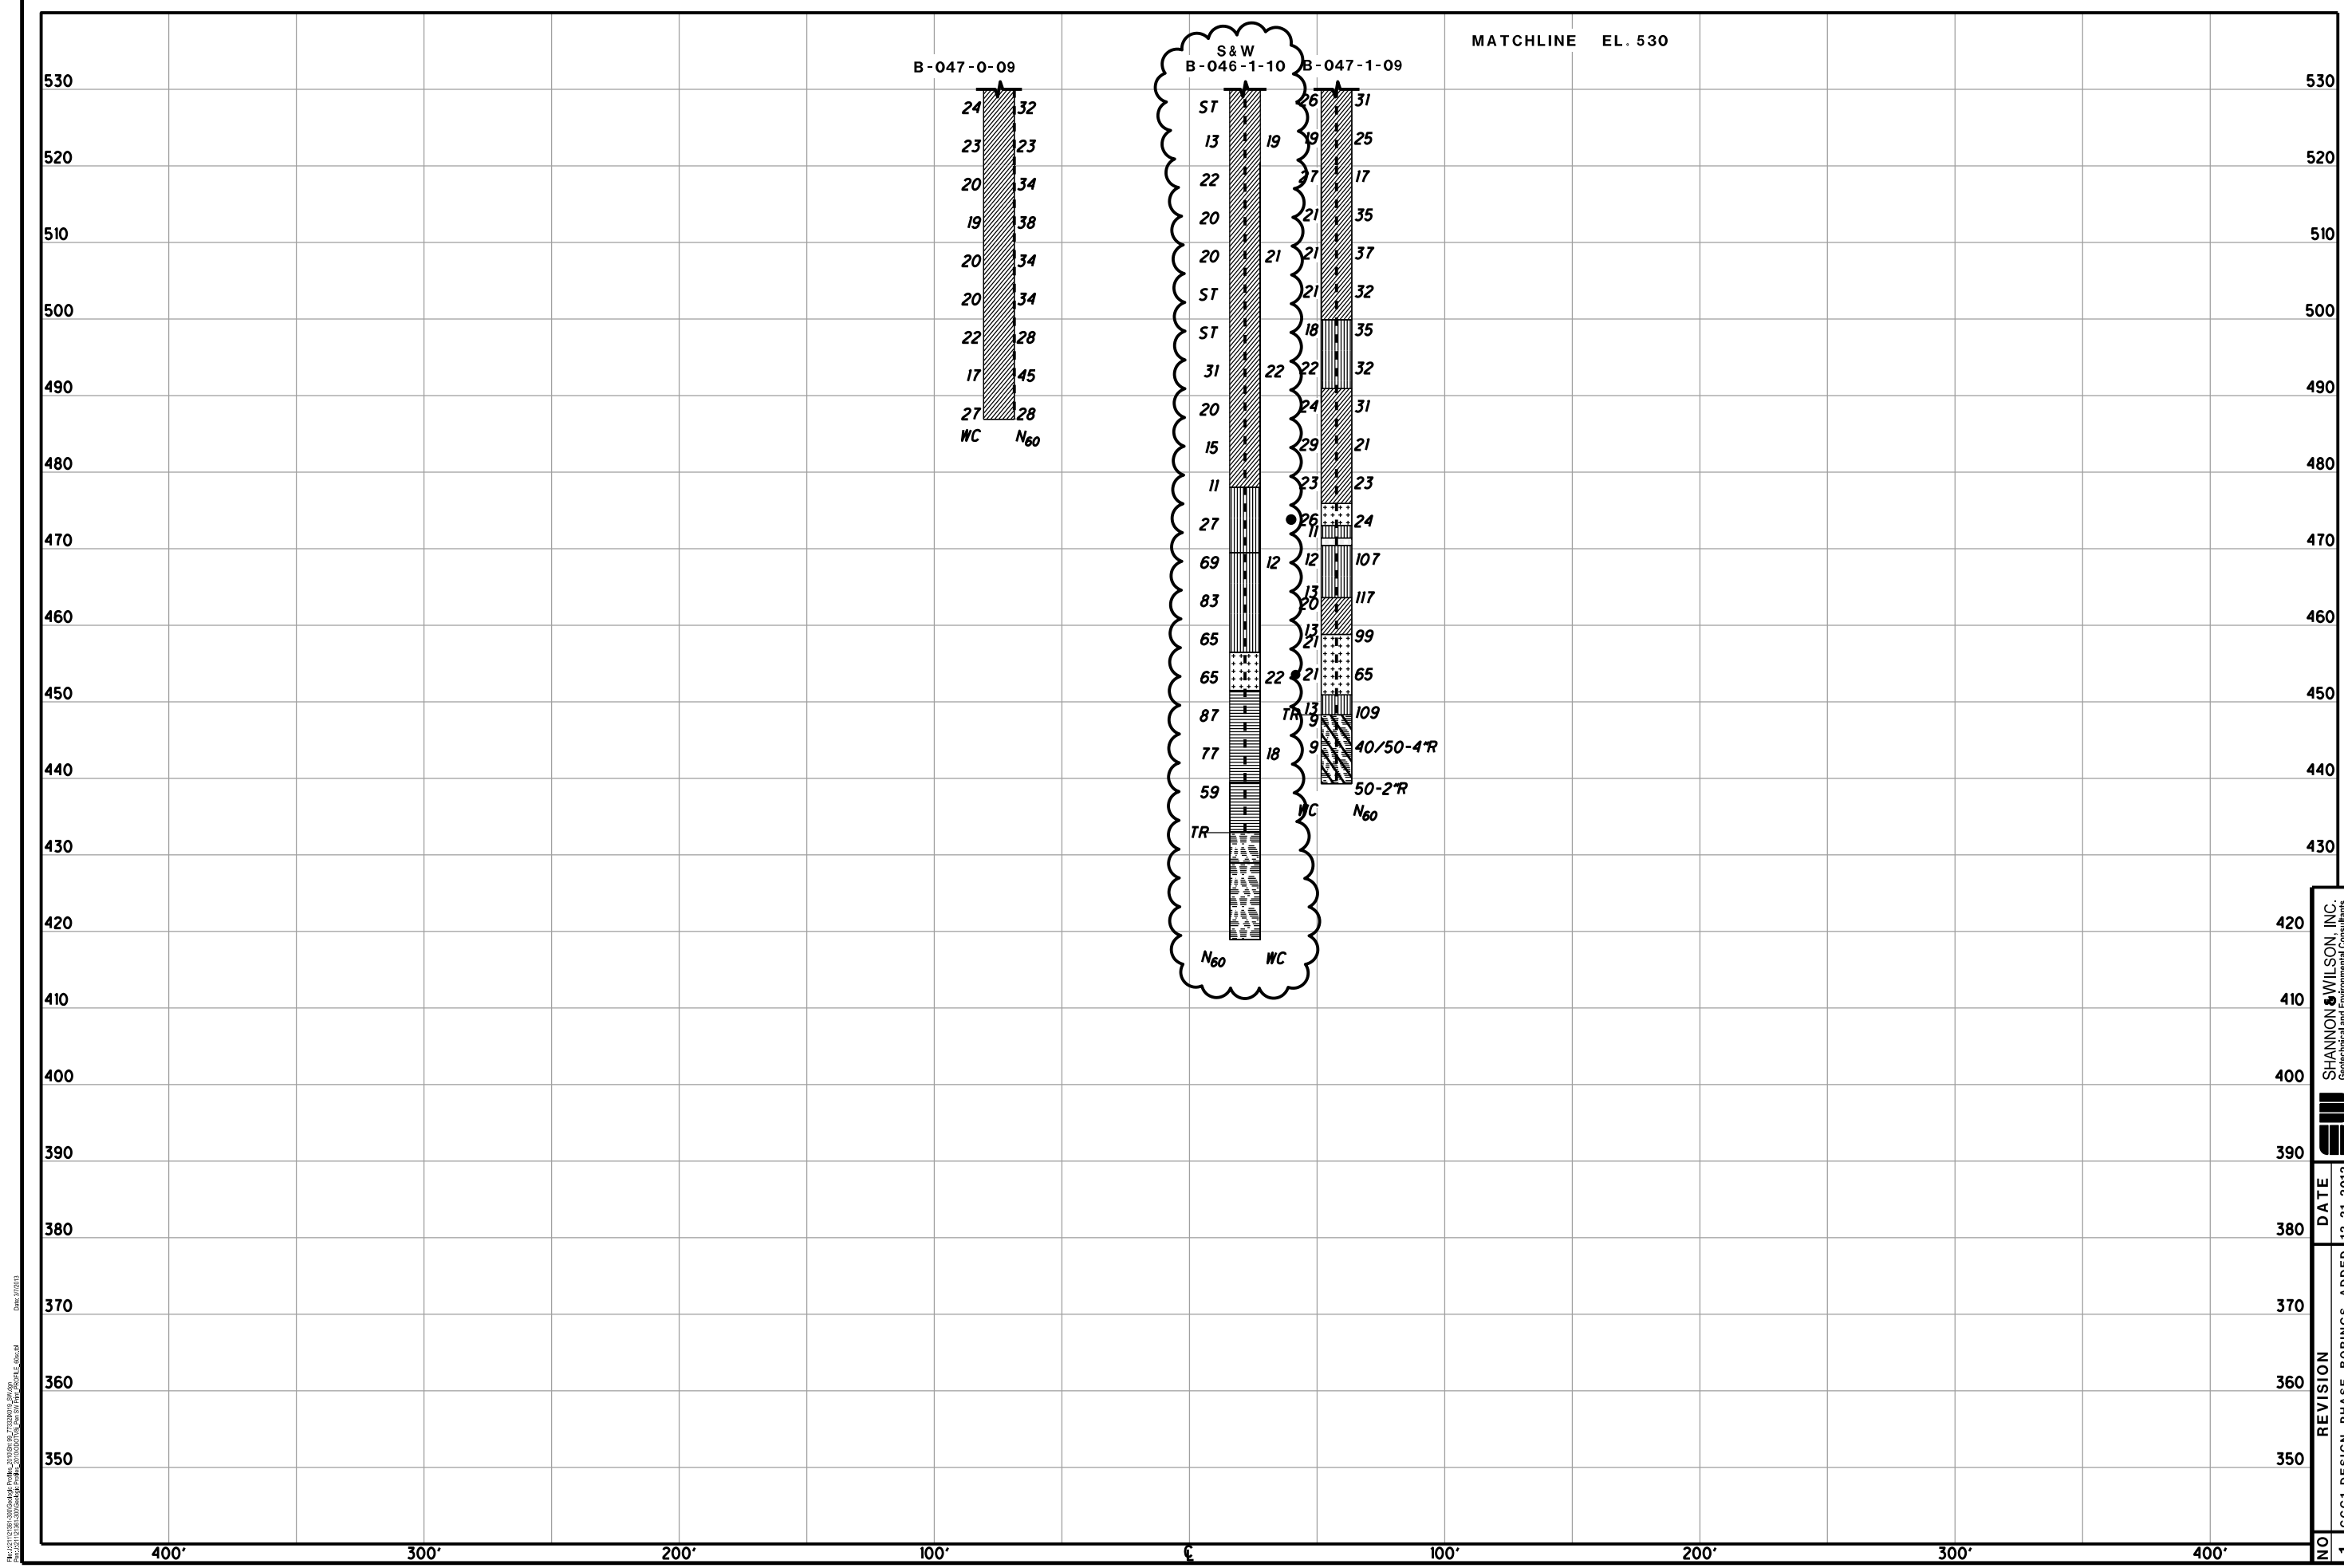

MATCHLINE EL. 530




SOIL PROFILE - W.B. I-90  
CROSS SECTION STA. 158+50

SHANNON & WILSON, INC.  
Geotechnical and Environmental Consultants

NO	REVISION	DATE
1	CCGT DESIGN PHASE BORINGS ADDED	12-21-2012

CUY-90-14.90

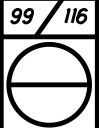

DATE: 12/21/12  
PROJECT: CUY-90-14.90  
DRAWN BY: [illegible]  
CHECKED BY: [illegible]  
DATE: 12/21/12