


SCHEMATIC GEOMETRIC PLAN

FED. RD. DIVISION	STATE	PROJECT
2	OHIO	

2
646

CUYAHOGA COUNTY
CUY-71-17.83
CUY-176-12.76

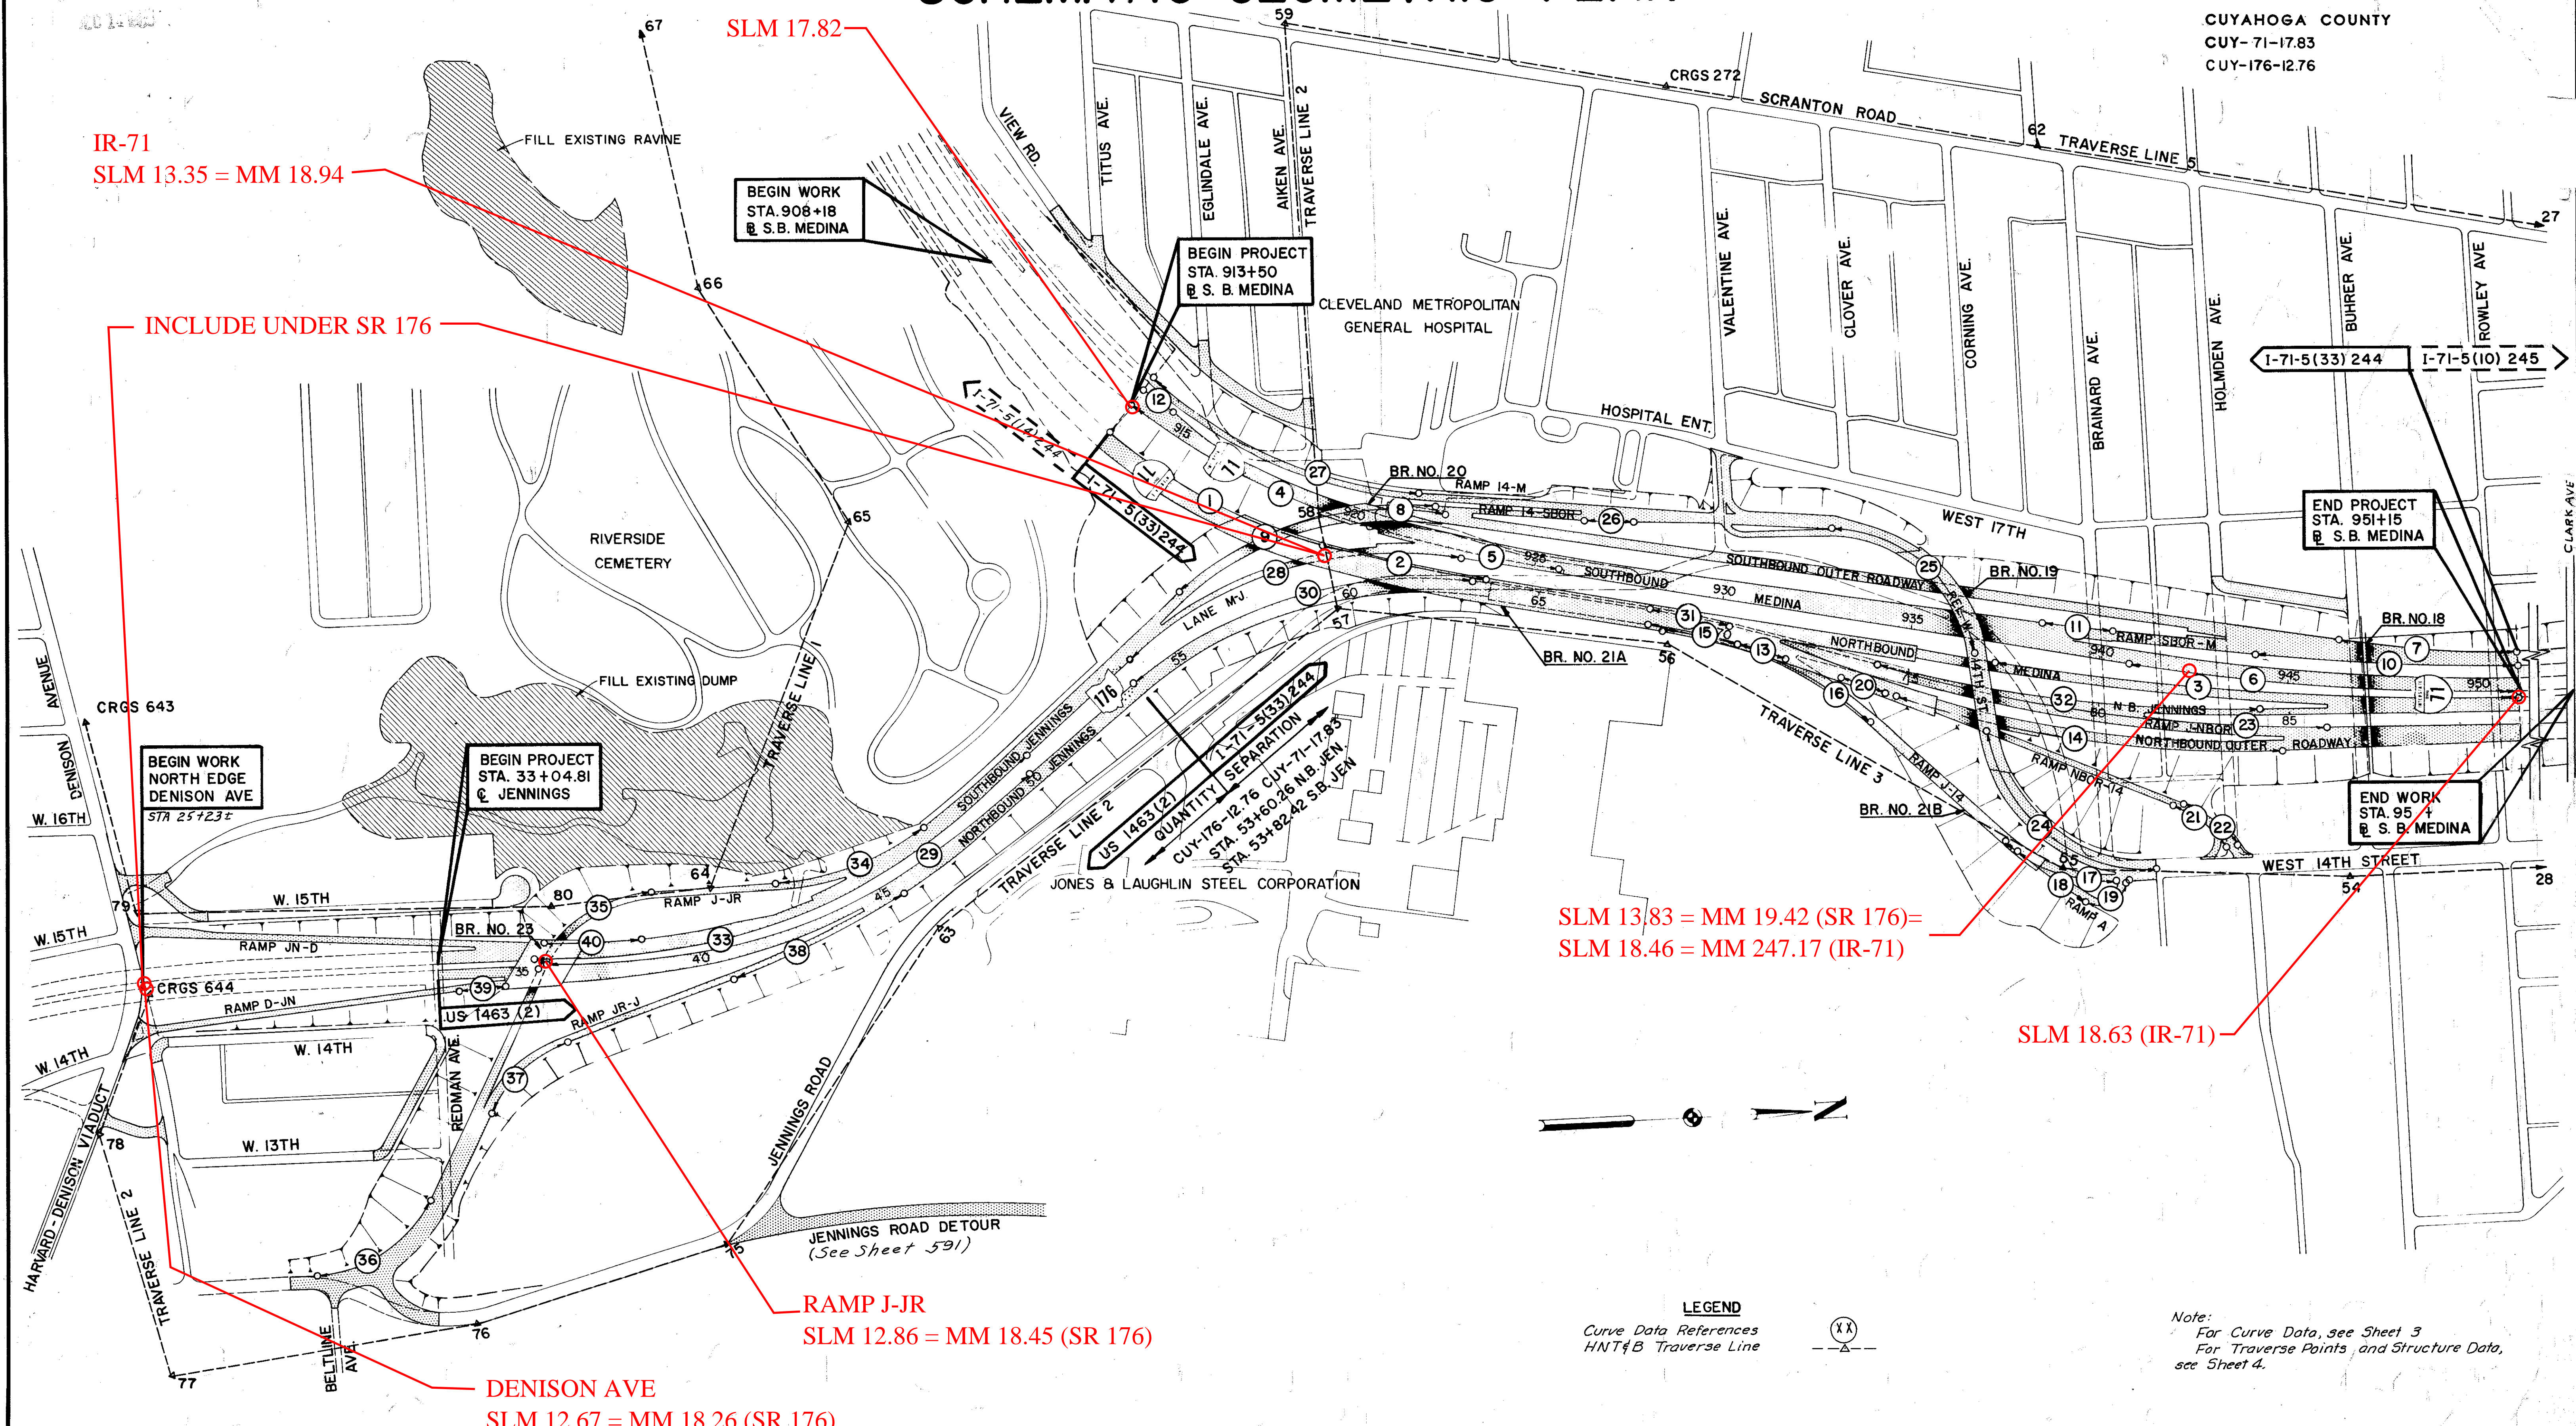

SLM 13.83 = MM 19.42 (SR 176)=
SLM 18.46 = MM 247.17 (IR-71)

SLM 18.63 (IR-71)

RAMP J-JR
SLM 12.86 = MM 18.45 (SR 176)

DENISON AVE
SLM 12.67 = MM 18.26 (SR 176)



LEGEND
Curve Data References
HNT&B Traverse Line

Note:
For Curve Data, see Sheet 3
For Traverse Points, and Structure Data,
see Sheet 4.

SCALE 1" = 200'
HOWARD, NEEDLES, TAMMEN & BERGENDOFF
CONSULTING ENGINEERS
MADE BY DATE 12-1-64
TRCD. R.L.K. DATE 4-12-64
CKD. R.P.R. DATE 12-2-64
KANSAS CITY CLEVELAND NEW YORK