


FED. RD. DIVISION	STATE	PROJECT
2	OHIO	

274  
646

CUYAHOGA COUNTY  
CUY-71-17.83  
CUY-176-12.76

23  
54

R.D. 8-5-64  
C.M.C. 10-19-64

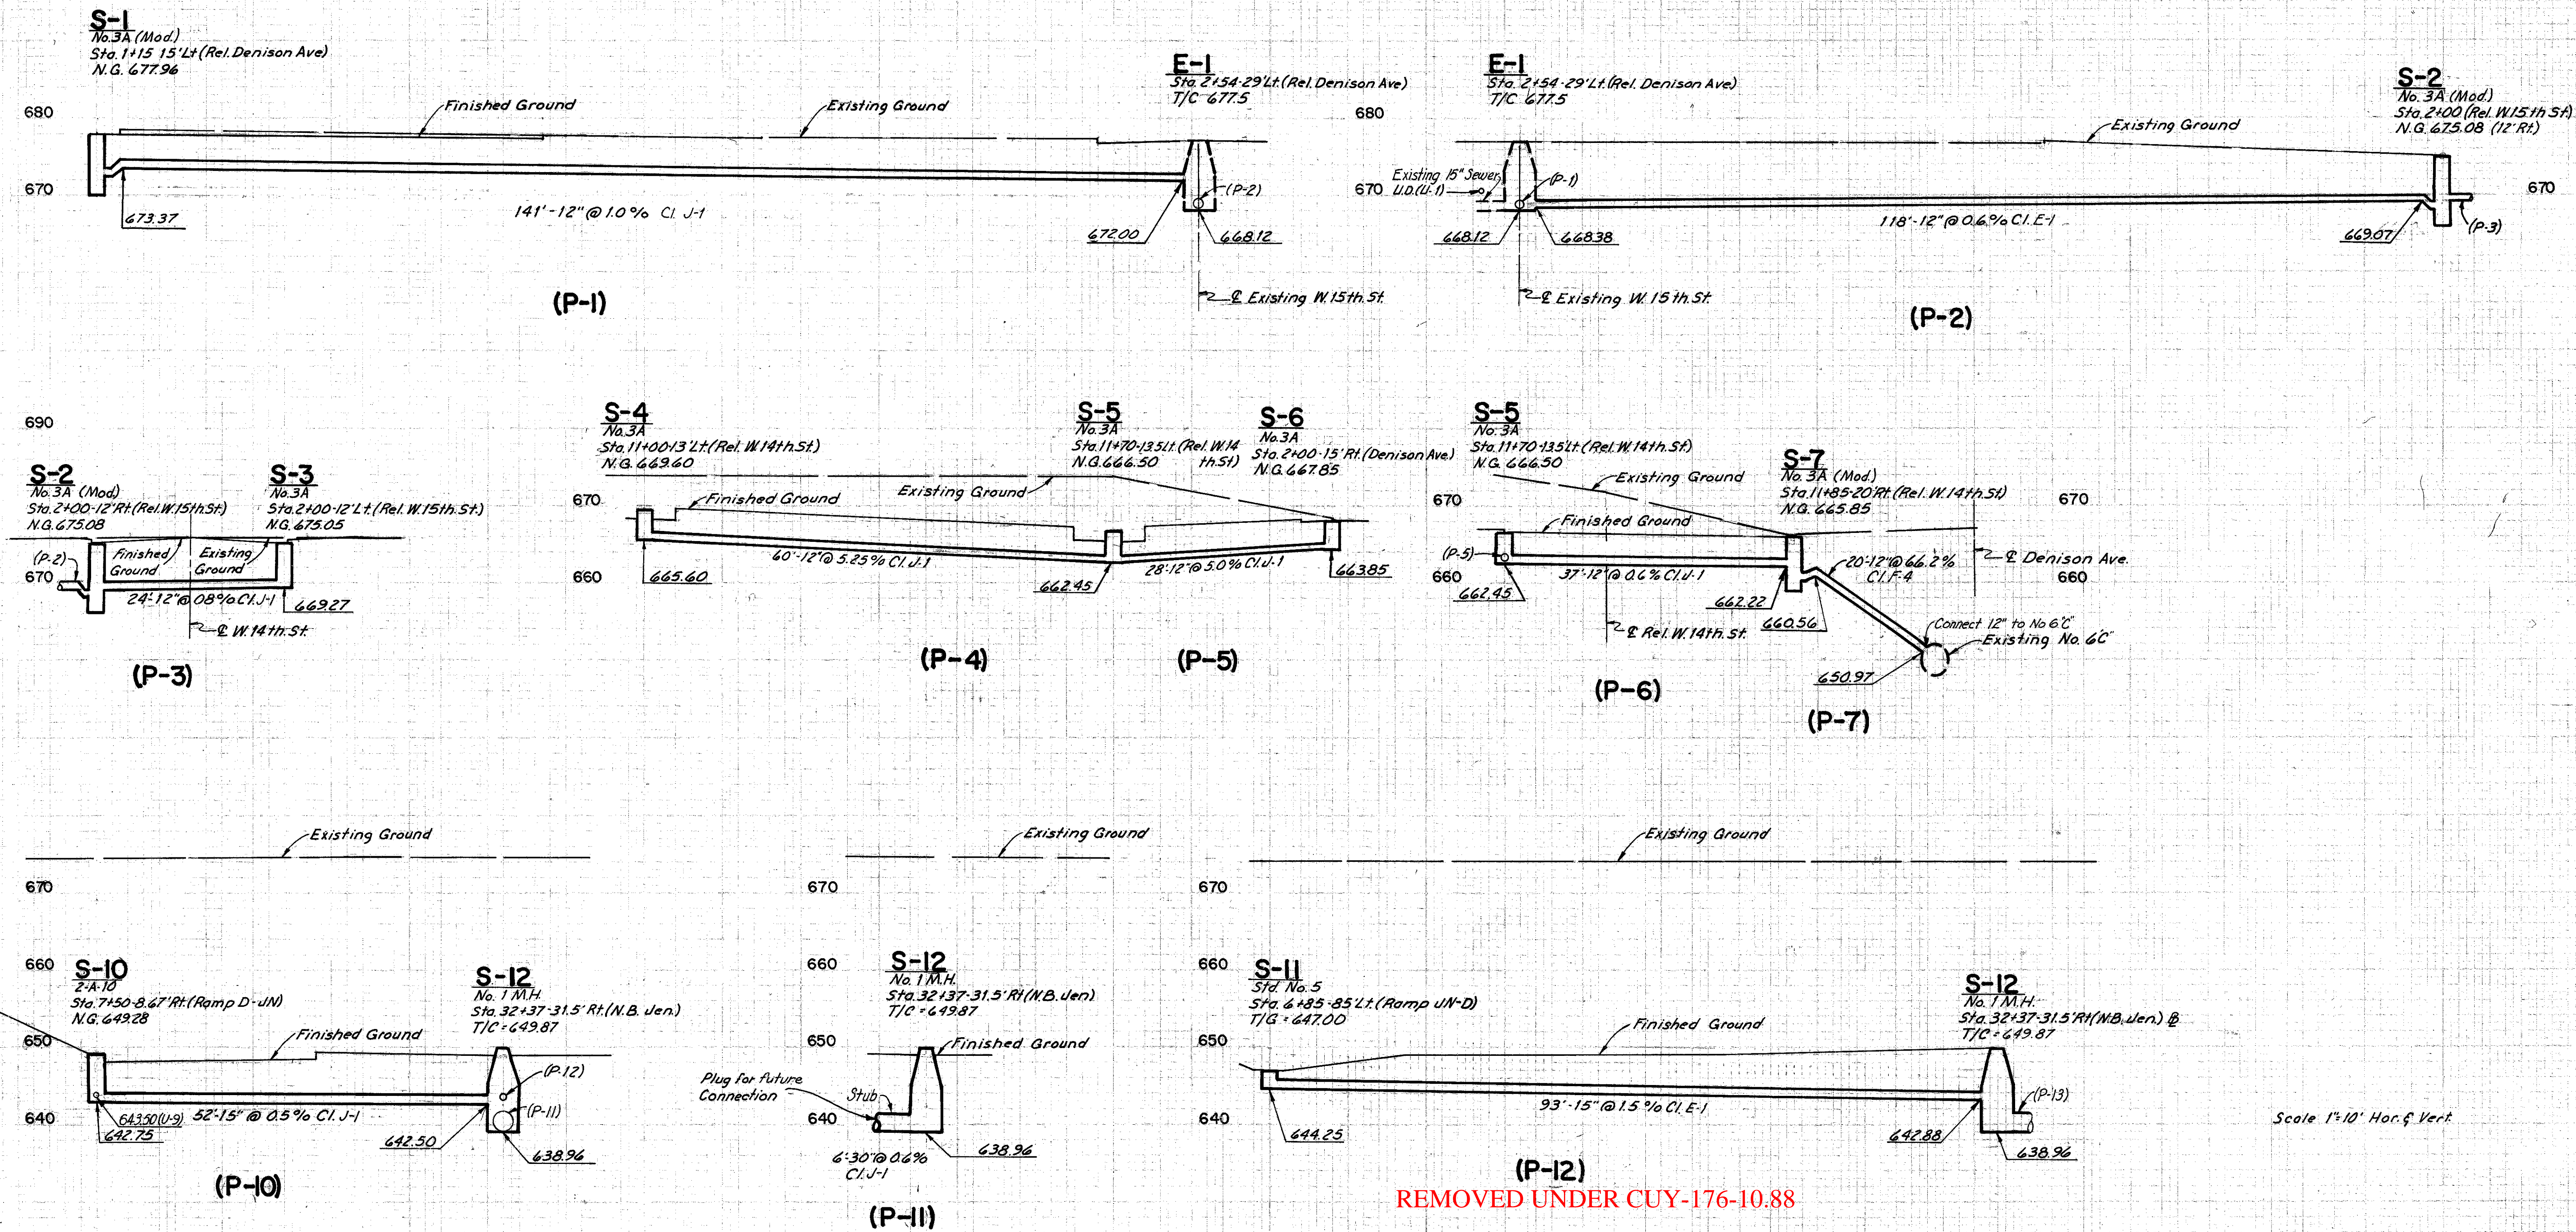

Scale 1"=10' Hor. & Vert.

P-8 & P-9 SEE SH. 24

HOWARD, NEEDLES, TAMMEN & BERGENDOFF  
CONSULTING ENGINEERS  
KANSAS CITY CLEVELAND NEW YORK