


FED. RD. DIVISION	STATE	PROJECT
2	OHIO	

290
646

CUYAHOGA COUNTY
CUY-71-17.83
CUY-176-12.76

39
54

RDJ 9-22-64
J.M.O. 10-13-64

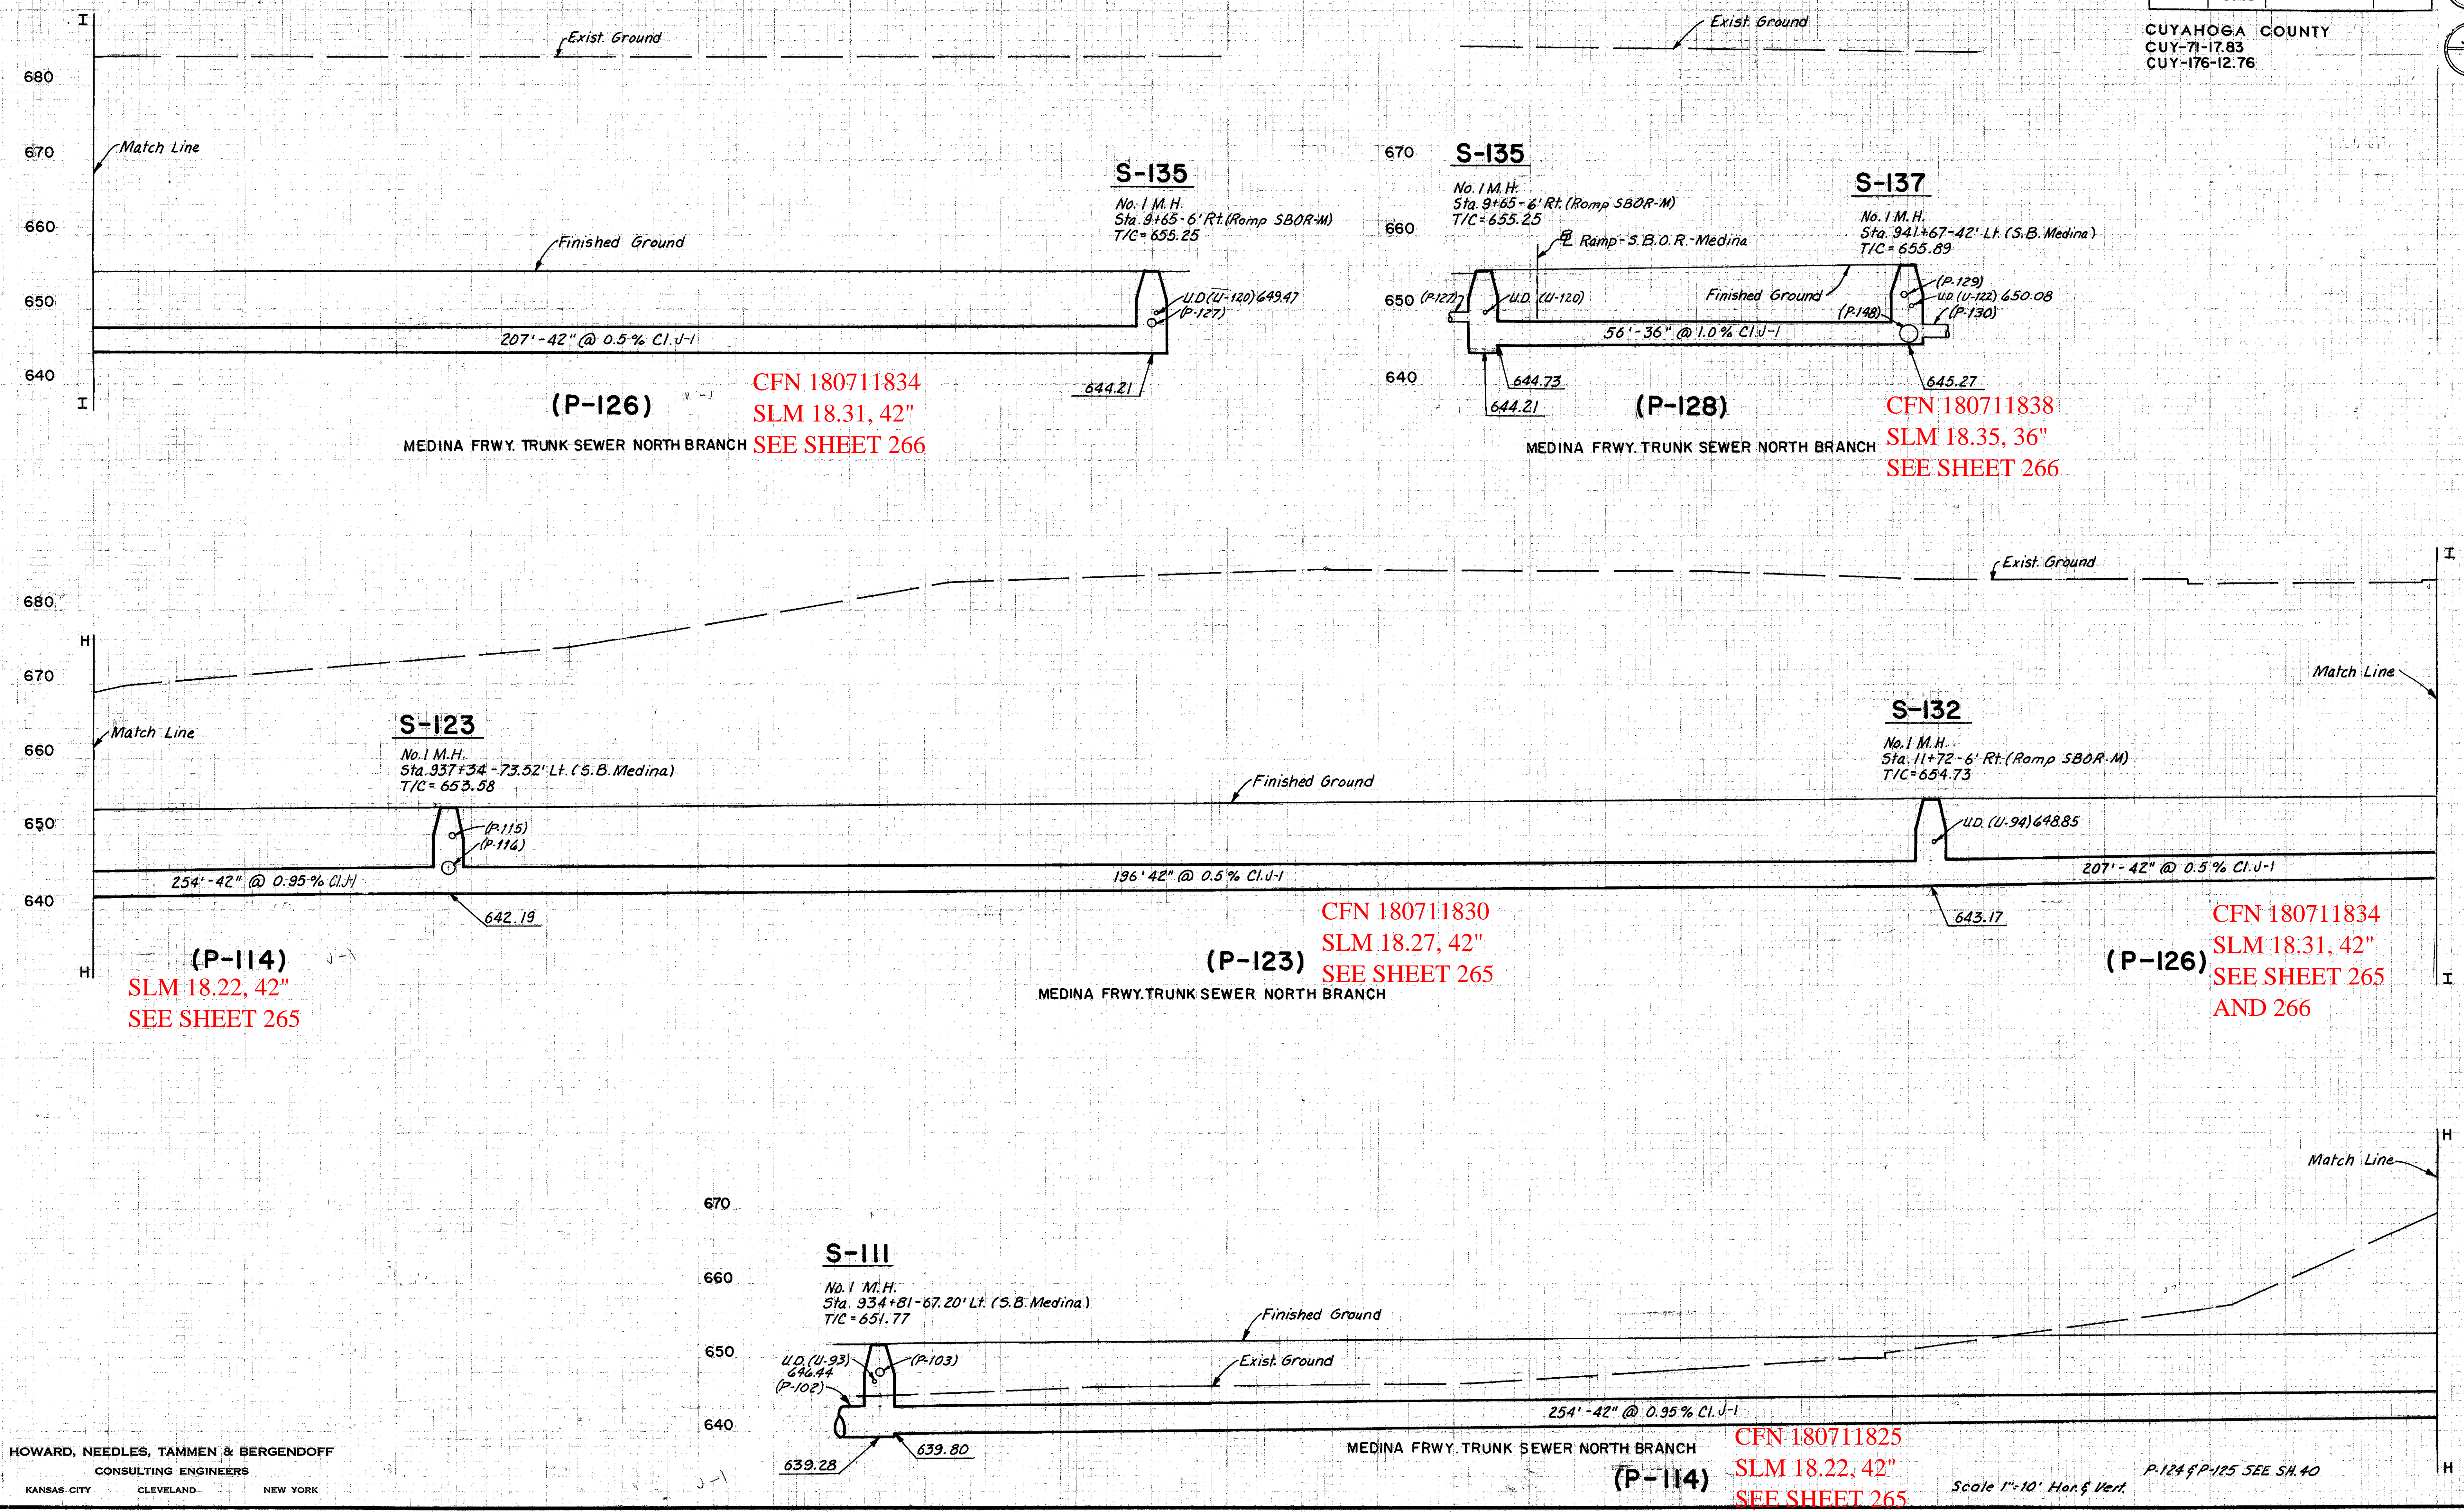

HOWARD, NEEDLES, TAMMEN & BERGENDOFF
CONSULTING ENGINEERS
KANSAS CITY CLEVELAND NEW YORK

CFN 180711825
SLM 18.22, 42"
SEE SHEET 265

Scale 1" = 10' Hor. & Vert. P-124 & P-125 SEE SH. 40

SEWER PROFILES P-114, P-123, P-126 & P-128